


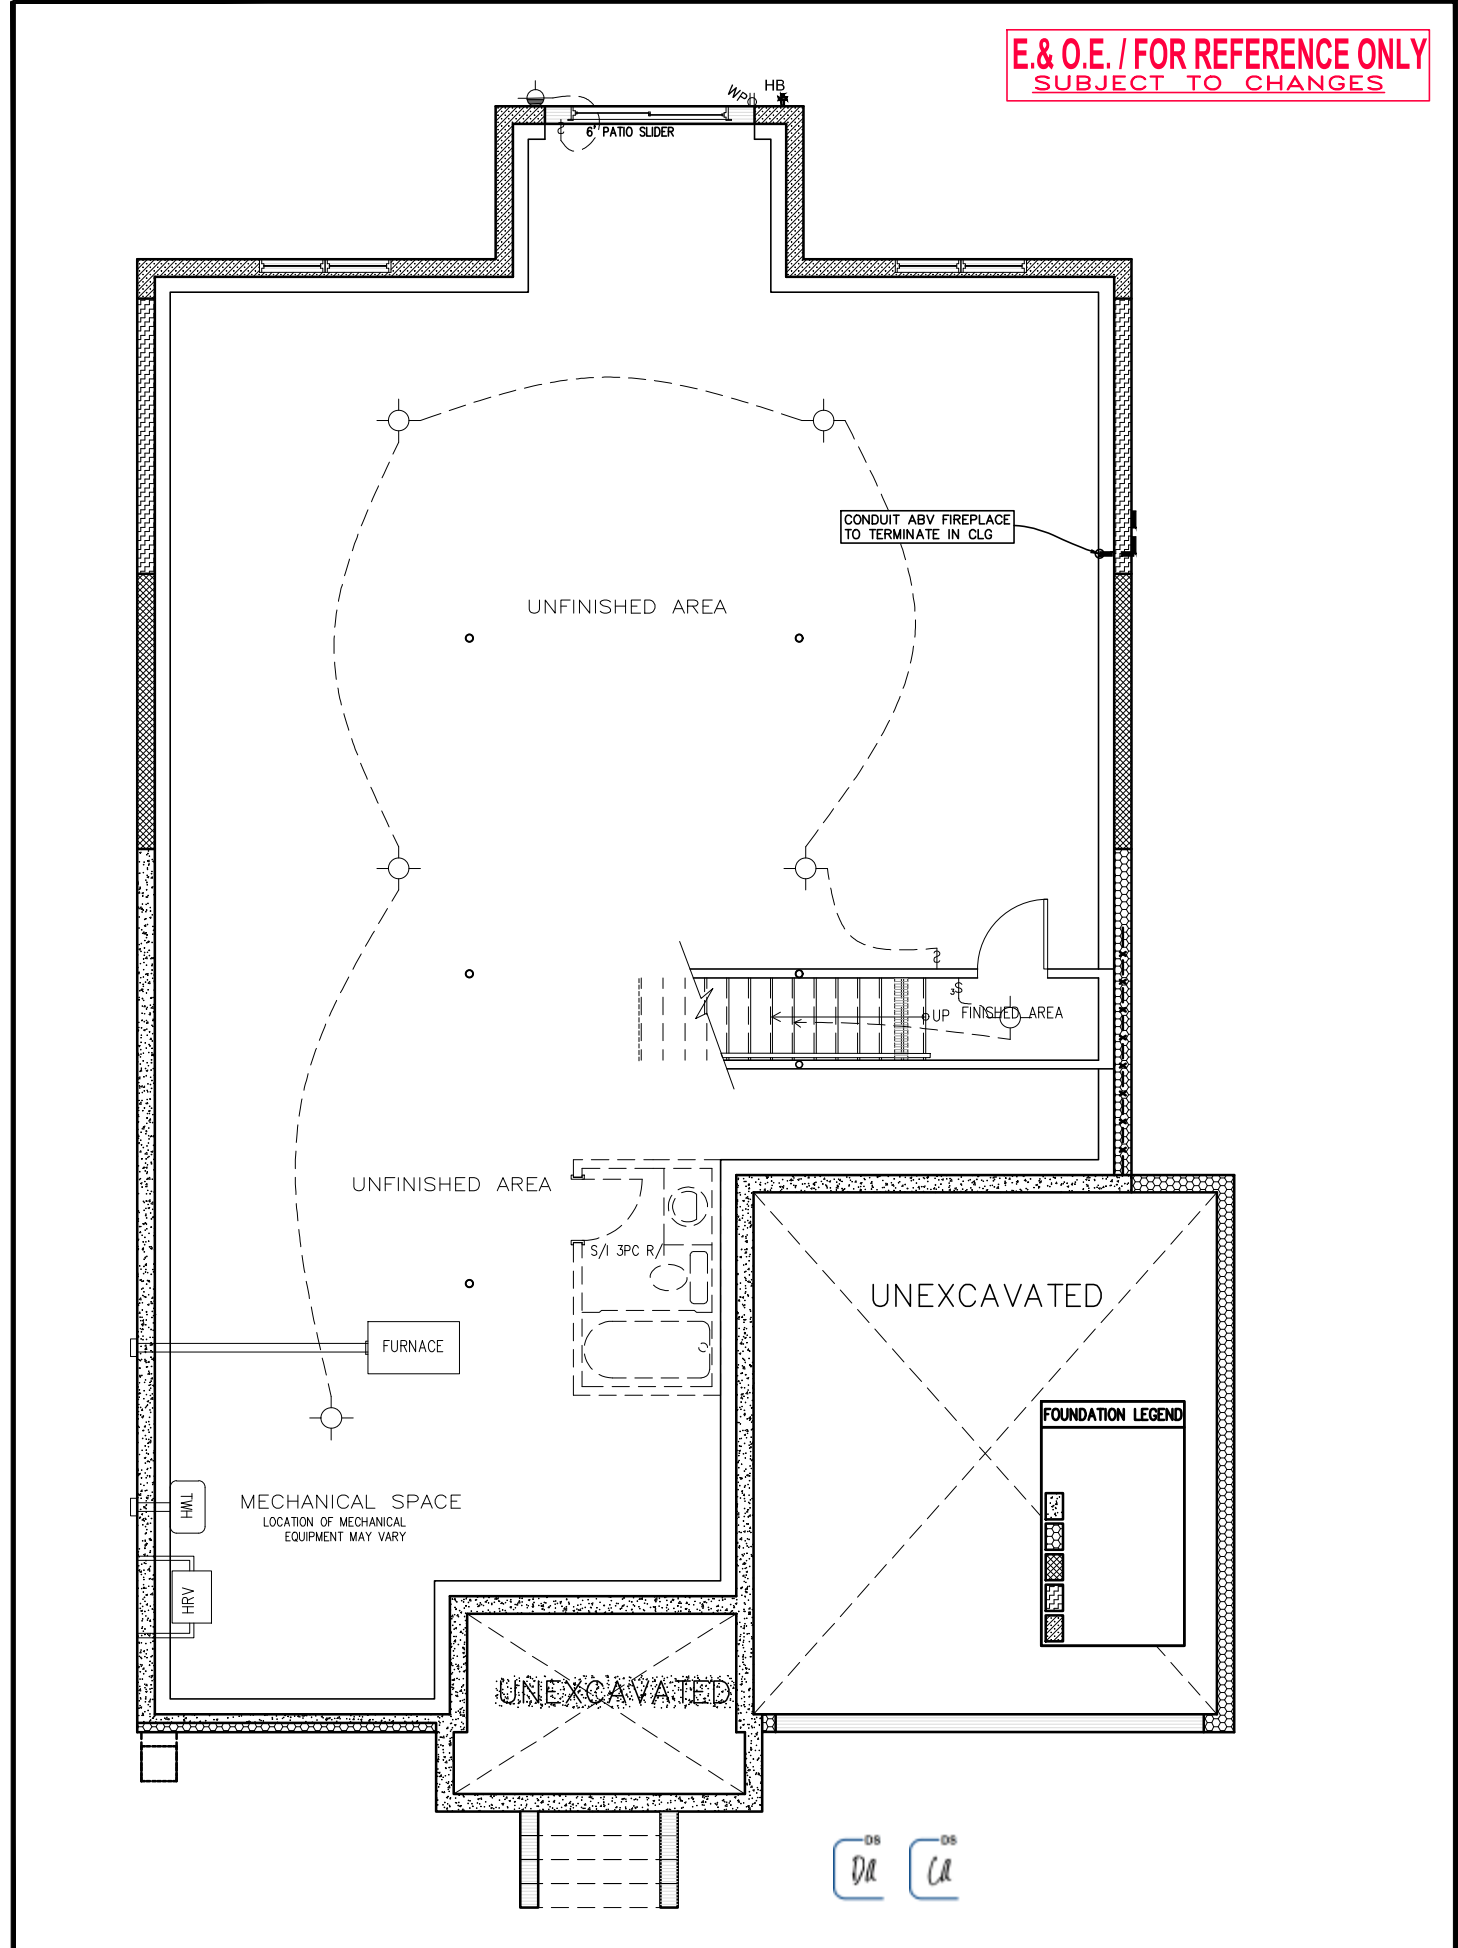

BASEMENT PLAN

-FLAT CEILINGS THROUGHOUT / NO STIPPLE
-BYPASS SLIDERS FOR ALL SLIDING CLOSET DOORS

SPRINGFIELD C




SPRINGFIELD C - 2022

SITE: WHITETAIL RIDGE PH.4

LOT NUMBER: 141
CIVIC ADDRESS: 127 FRANK FISHER CRESCENT

10	FINAL BLACKLINES REVISED	21/03/24	CB
9	FINAL BLACKLINES	20/03/24	SP
8	ISSUED FOR ENGINEERING	15/02/24	CB
7	ISSUED FOR JOIST LAYOUT	09/02/24	CB
6	BEP BLACKLINES	29/01/24	CB
5	B1 BLACKLINES	03/01/24	CB
No.	Description	dd/mm/yy	By
REVISIONS			

footprint:	B-24
drawn by:	SD
date:	SEP/12
scale:	3/16"=1'-0"
sheet no:	2
D.C.L.-A-9	9

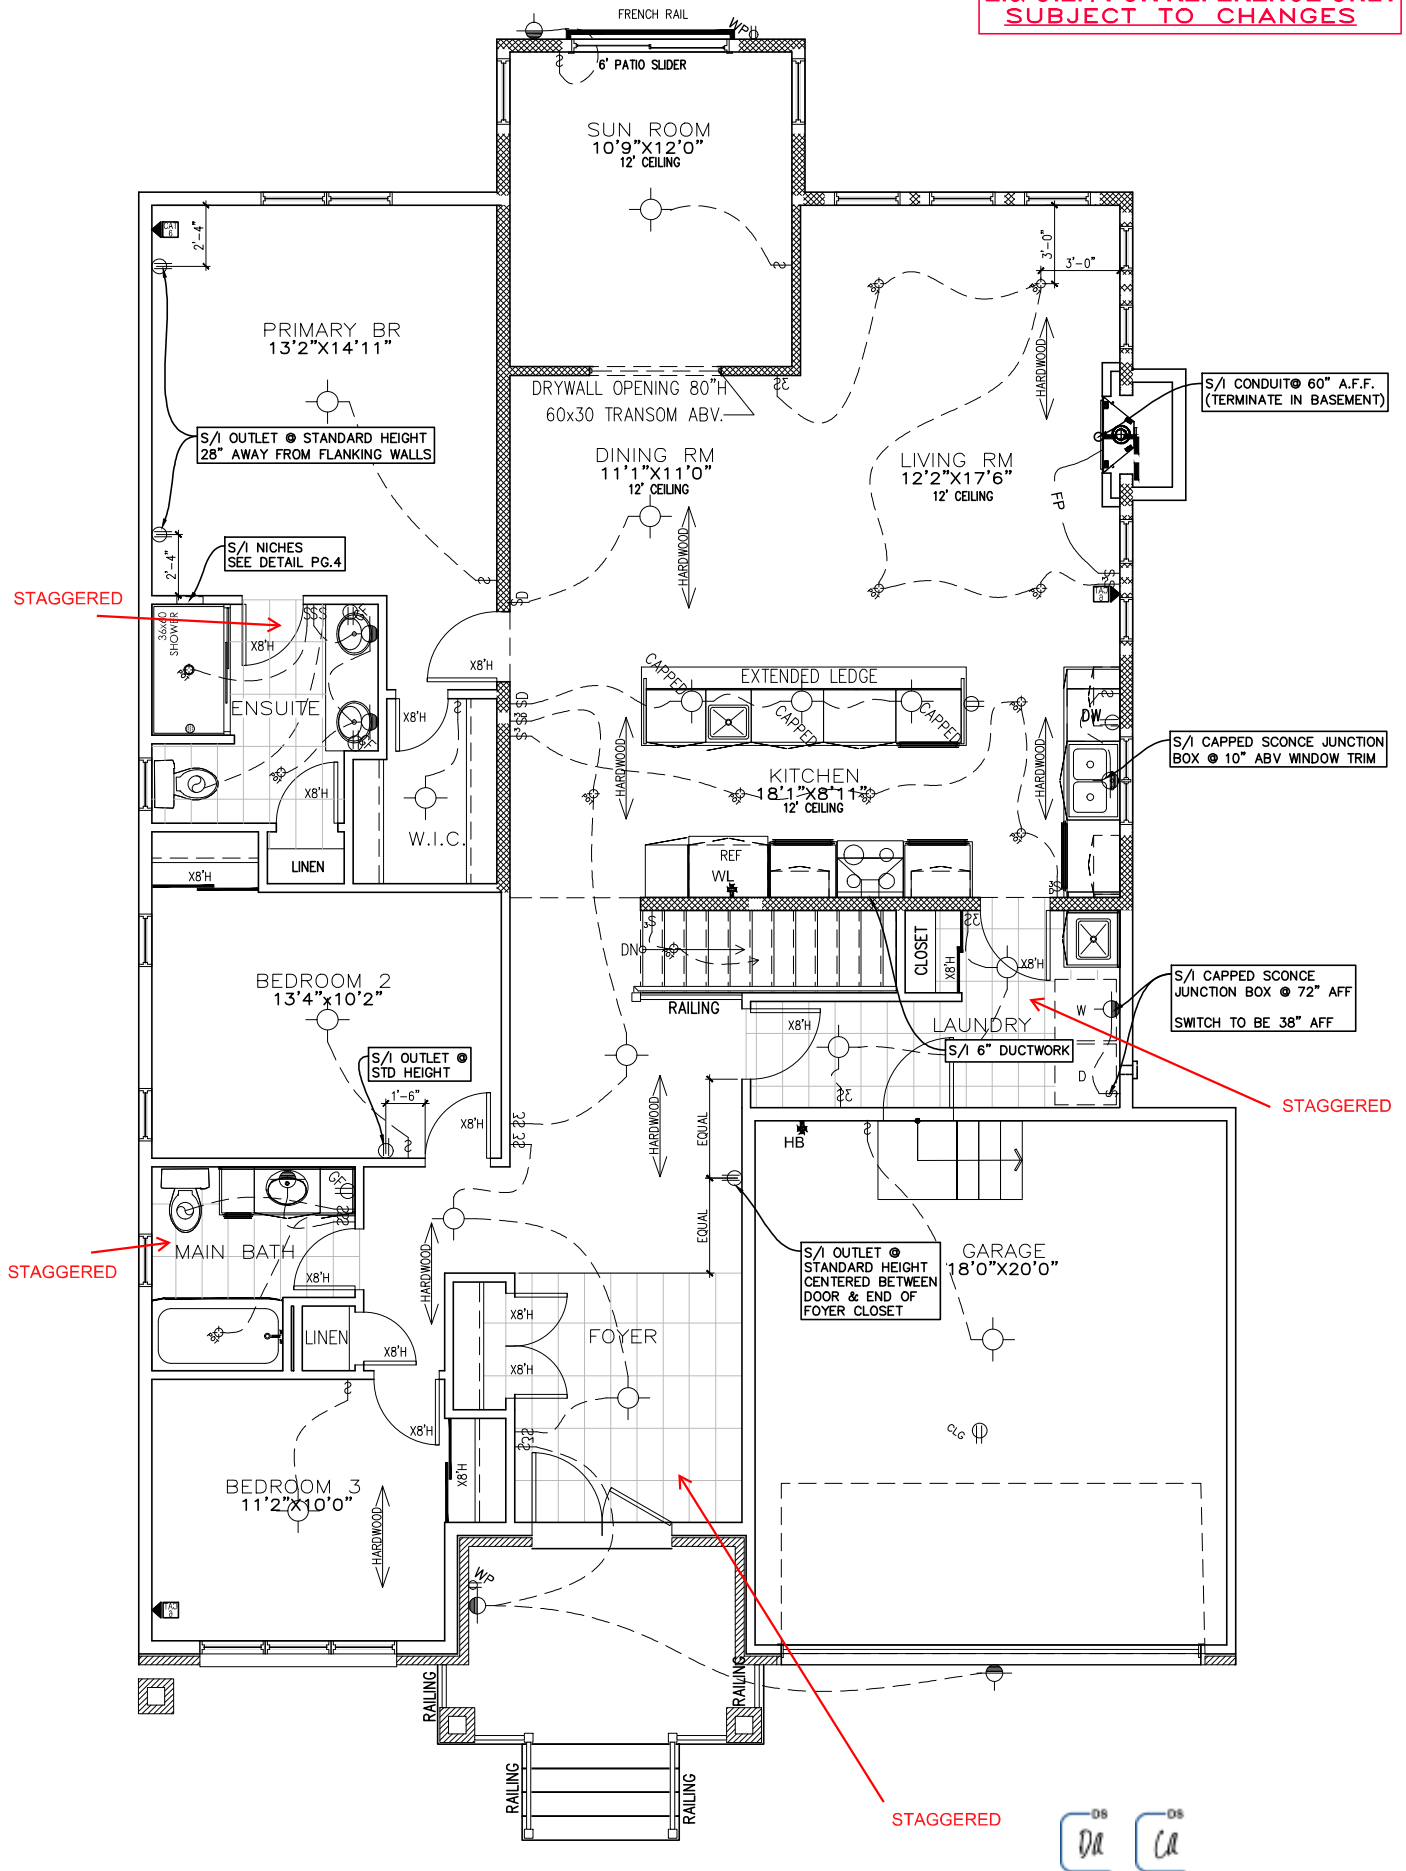

GROUND FLOOR

-FLAT CEILINGS THROUGHOUT / NO STIPPLE
-BYPASS SLIDERS FOR ALL SLIDING CLOSET DOORS

SPRINGFIELD C



PHOENIX HOMES

SPRINGFIELD C – 2022

SITE: WHITETAIL RIDGE PH.4

LOT NUMBER:


CIVIC ADDRESS:
127 FRANK FISHER CRESCENT

141

10	FINAL BLACKLINES REVISED	21/03/24	CB
9	FINAL BLACKLINES	20/03/24	SP
8	ISSUED FOR ENGINEERING	15/02/24	CB
7	ISSUED FOR JOIST LAYOUT	09/02/24	CB
6	BEP BLACKLINES	29/01/24	CB
5	B1 BLACKLINES	03/01/24	CB
No.	Description	dd/mm/yy	By
REVISIONS			


footprint: B-24	
drawn by: SD	
date: SEP/12	
scale: 3/16"=1'-0"	
sheet no:	
D.C.L.-A-9	

E.& O.E. / FOR REFERENCE ONLY
SUBJECT TO CHANGES

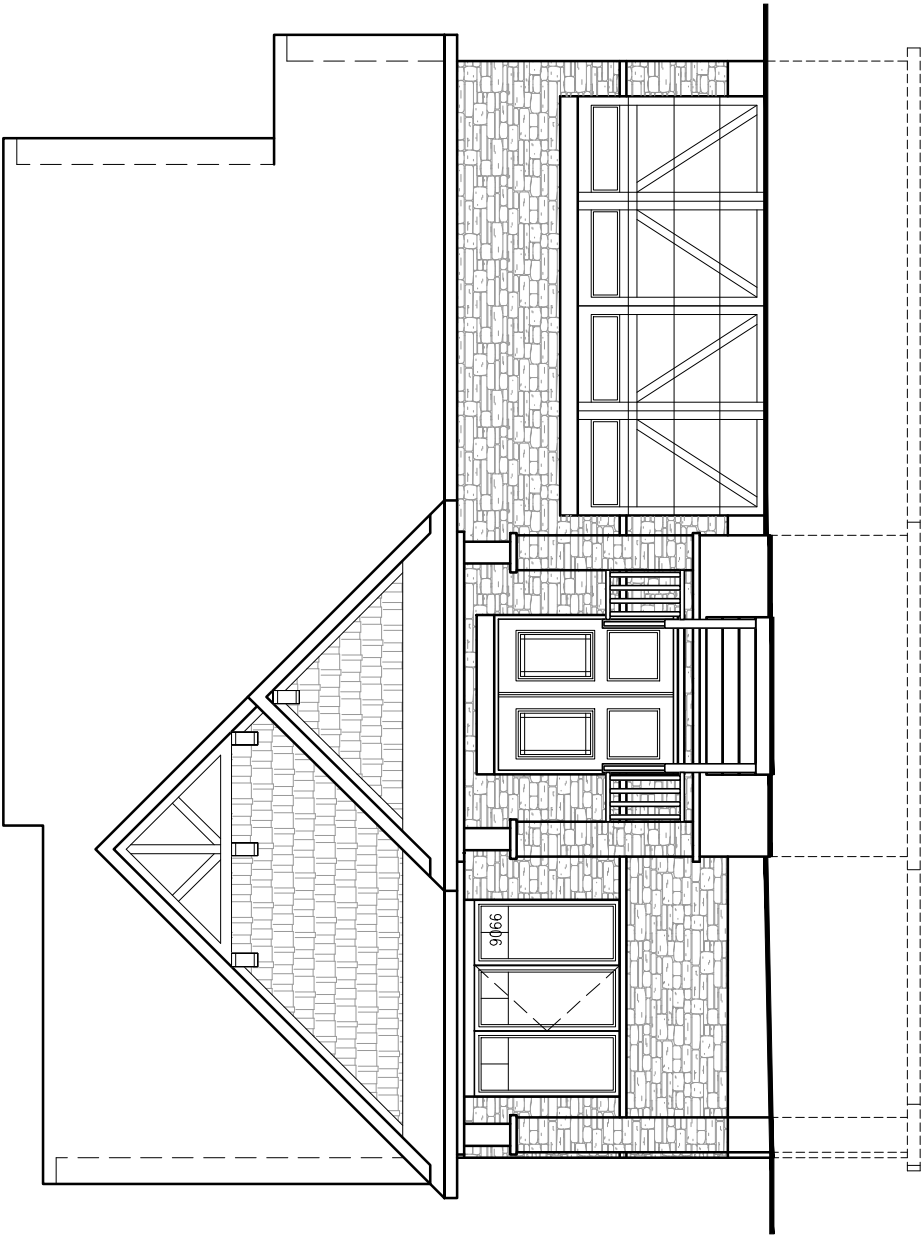

05 06

FRONT ELEVATION C

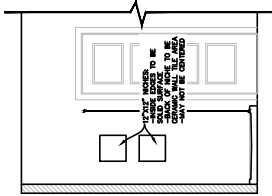

PHOENIX HOMES



SPRINGFIELD C – 2022

SITE: WHITETAIL RIDGE PH.4

LOT NUMBER:

CIVIC ADDRESS:
127 FRANK FISHER CRESCENT

141

No.	Description	dd/mm/yy	By
10	FINAL BLACKLINES REVISED	21/03/24	CB
9	FINAL BLACKLINES	20/03/24	SP
8	ISSUED FOR ENGINEERING	15/02/24	CB
7	ISSUED FOR JOIST LAYOUT	09/02/24	CB
6	BEP BLACKLINES	29/01/24	CB
5	B1 BLACKLINES	03/01/24	CB

footprint: B-24	drawn by: SD	date: SEP/12	scale: 3/16"=1'-0"	sheet no: D.C.L.-A-9	9/4
-----------------	--------------	--------------	--------------------	----------------------	-----

E & O.E. / FOR REFERENCE ONLY
SUBJECT TO CHANGES



05 06

REAR ELEVATION C

PHOENIX HOMES



SPRINGFIELD C – 2022

SITE: WHITE TAIL RIDGE PH.4

LOT NUMBER:

CIVIC ADDRESS:
127 FRANK FISHER CRESCENT

141

No.	Description	dd/mm/yy	By
10	FINAL BLACKLINES REVISED	21/03/24	CB
9	FINAL BLACKLINES	20/03/24	SP
8	ISSUED FOR ENGINEERING	15/02/24	CB
7	ISSUED FOR JOIST LAYOUT	09/02/24	CB
6	BEP BLACKLINES	29/01/24	CB
5	B1 BLACKLINES	03/01/24	CB

footprint: B-24	drawn by: SD	date: SEP/12	scale: 3/16"=1'-0"	sheet no: D.C.L.-A-9
5	9			

PHOENIX HOMES

SPRINGFIELD C – 2022

SITE: WHITE TAIL RIDGE PH.4

LOT NUMBER:
CIVIC ADDRESS:
127 FRANK FISHER CRESCENT

141

10	FINAL BLACKLINES REVISED	21/03/24	CB
9	FINAL BLACKLINES	20/03/24	SP
8	ISSUED FOR ENGINEERING	15/02/24	CB
7	ISSUED FOR JOIST LAYOUT	09/02/24	CB
6	BEP BLACKLINES	29/01/24	CB
5	B1 BLACKLINES	03/01/24	CB
REVISIONS			
No. Description		dd/mm/yy	By

footprint: B-24

drawn by: SD


date: SEP/12

scale: 3/16"=1'-0"

sheet no: D.C.L.-A-9

97

E.& O.E. / FOR REFERENCE ONLY
SUBJECT TO CHANGES

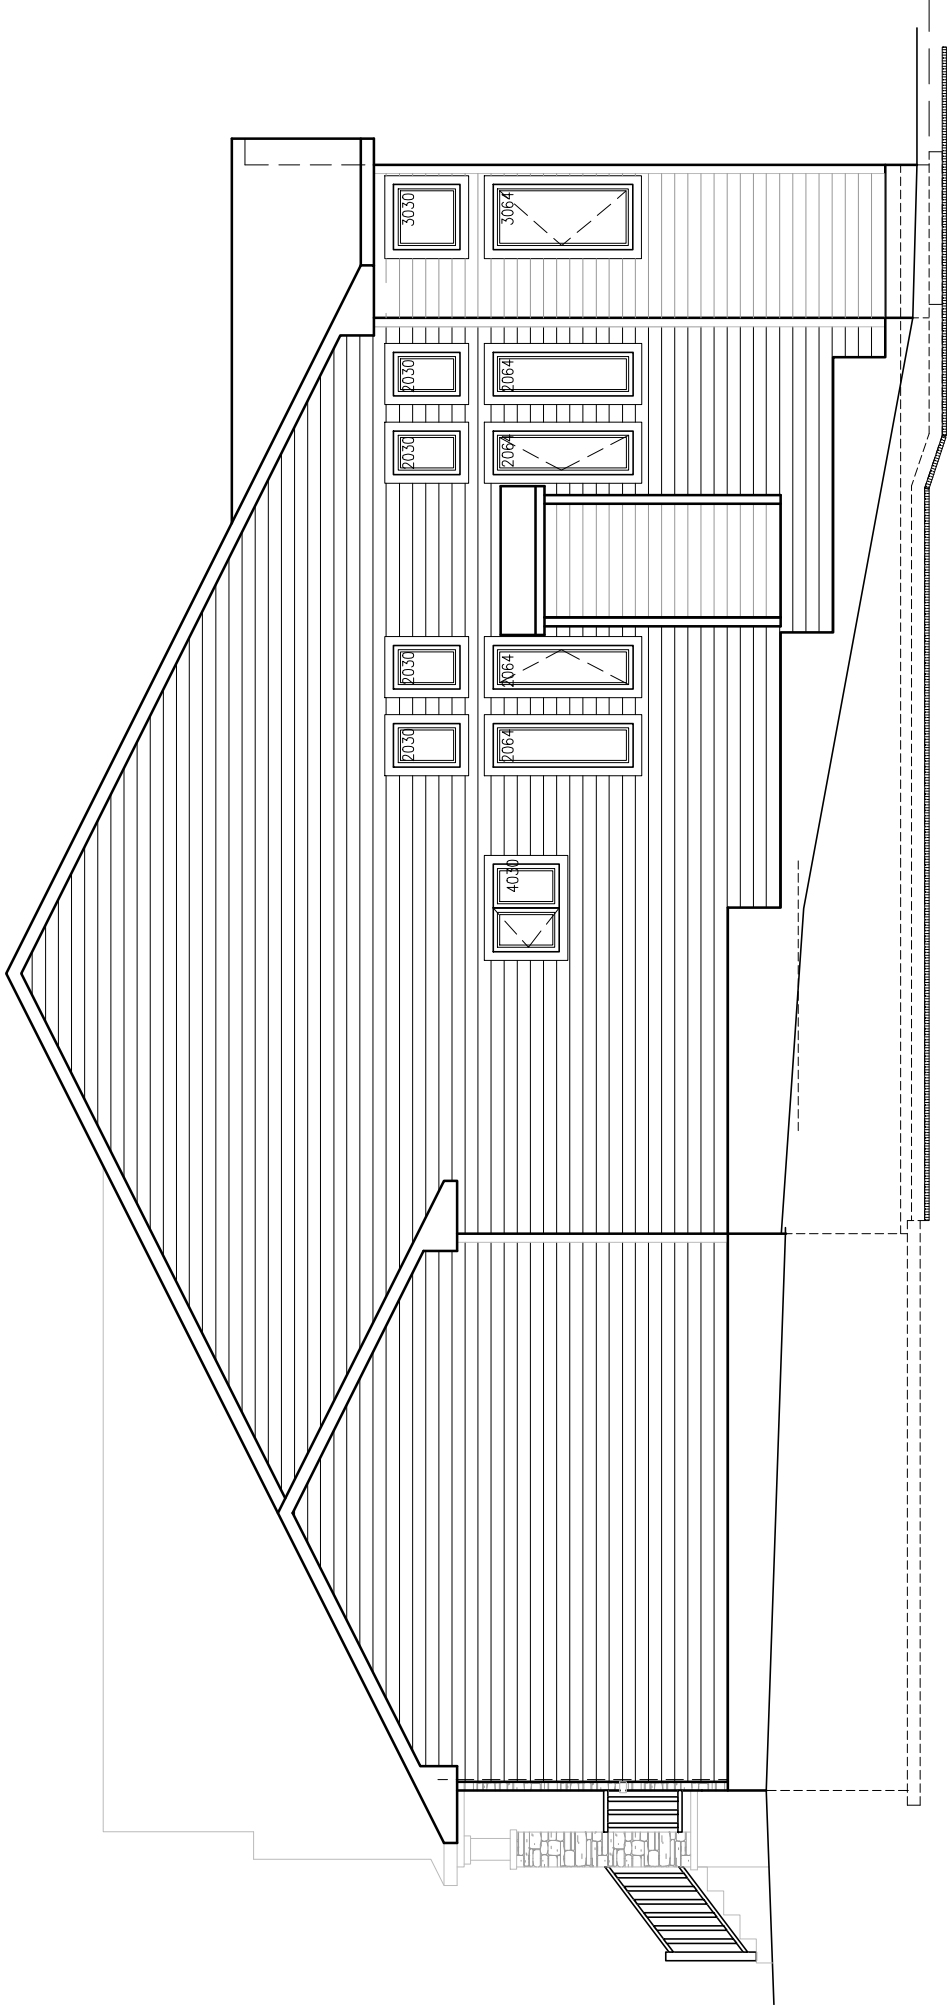

05 06

RIGHT SIDE ELEVATION C