


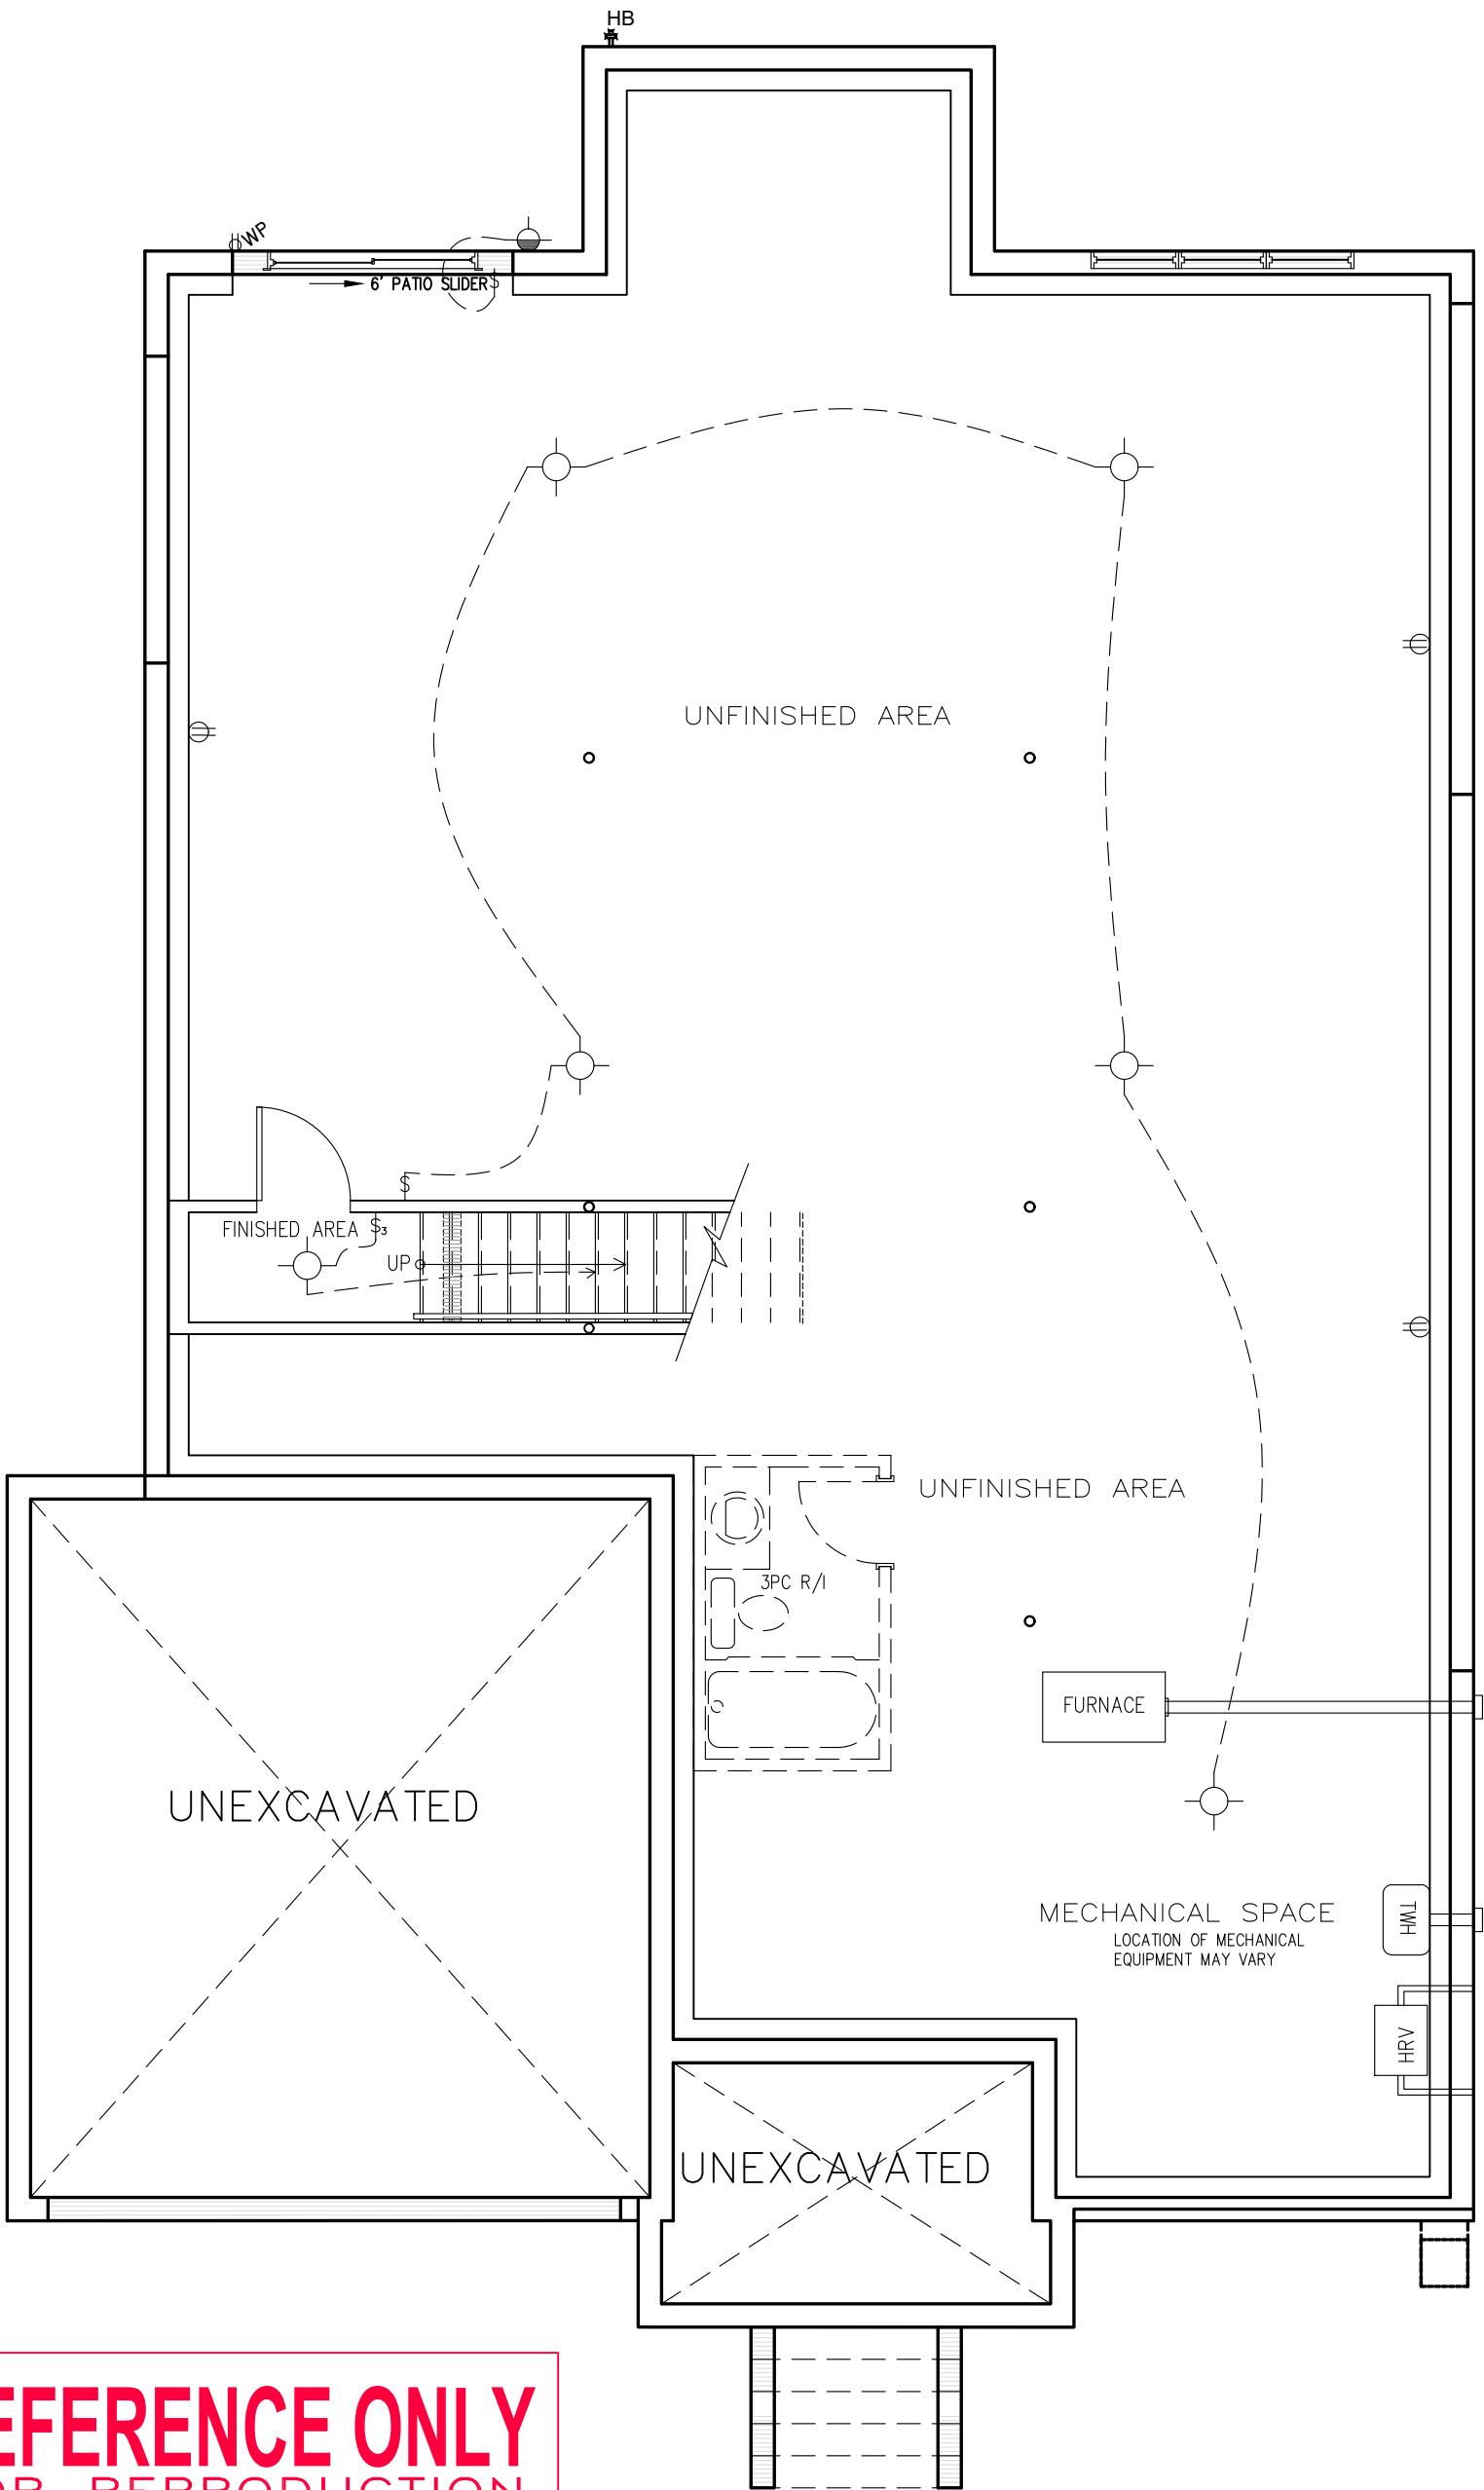


FOR REFERENCE ONLY  
NOT FOR REPRODUCTION

DS SB CL SPRINGFIELD C

BASEMENT PLAN



|                                             |  |  |  |                 |                               |          |    |                    |  |
|---------------------------------------------|--|--|--|-----------------|-------------------------------|----------|----|--------------------|--|
| SPRINGFIELD C – 2022                        |  |  |  | 8               | FINAL BLACKLINES REVISED      | 15/05/24 | CB | footprint: B–24    |  |
| SITE: WHITE TAIL RIDGE                      |  |  |  | 7               | FINAL BLACKLINES              | 25/04/24 | CB | drawn by: SD       |  |
|                                             |  |  |  | 6               | ISSUED FOR ENGINEERING        | 26/01/24 | CB | date: SEP/12       |  |
| LOT NUMBER: 142                             |  |  |  | 5               | BEP BLACKLINES                | 15/01/24 | CB | scale: 3/16"=1'-0" |  |
|                                             |  |  |  | 4               | B1 PRELIM BLACKLINES          | 20/11/23 | CB | sheet no:          |  |
| CIVIC ADDRESS:<br>131 FRANK FISHER CRESCENT |  |  |  | 3               | PRIMARY ENSUITE SHOWER UPDATE | 09/05/23 | SP | D.C.L.–A–9         |  |
|                                             |  |  |  | No. Description |                               | dd/mm/yy | By | 2<br>9             |  |
|                                             |  |  |  | REVISIONS       |                               |          |    |                    |  |

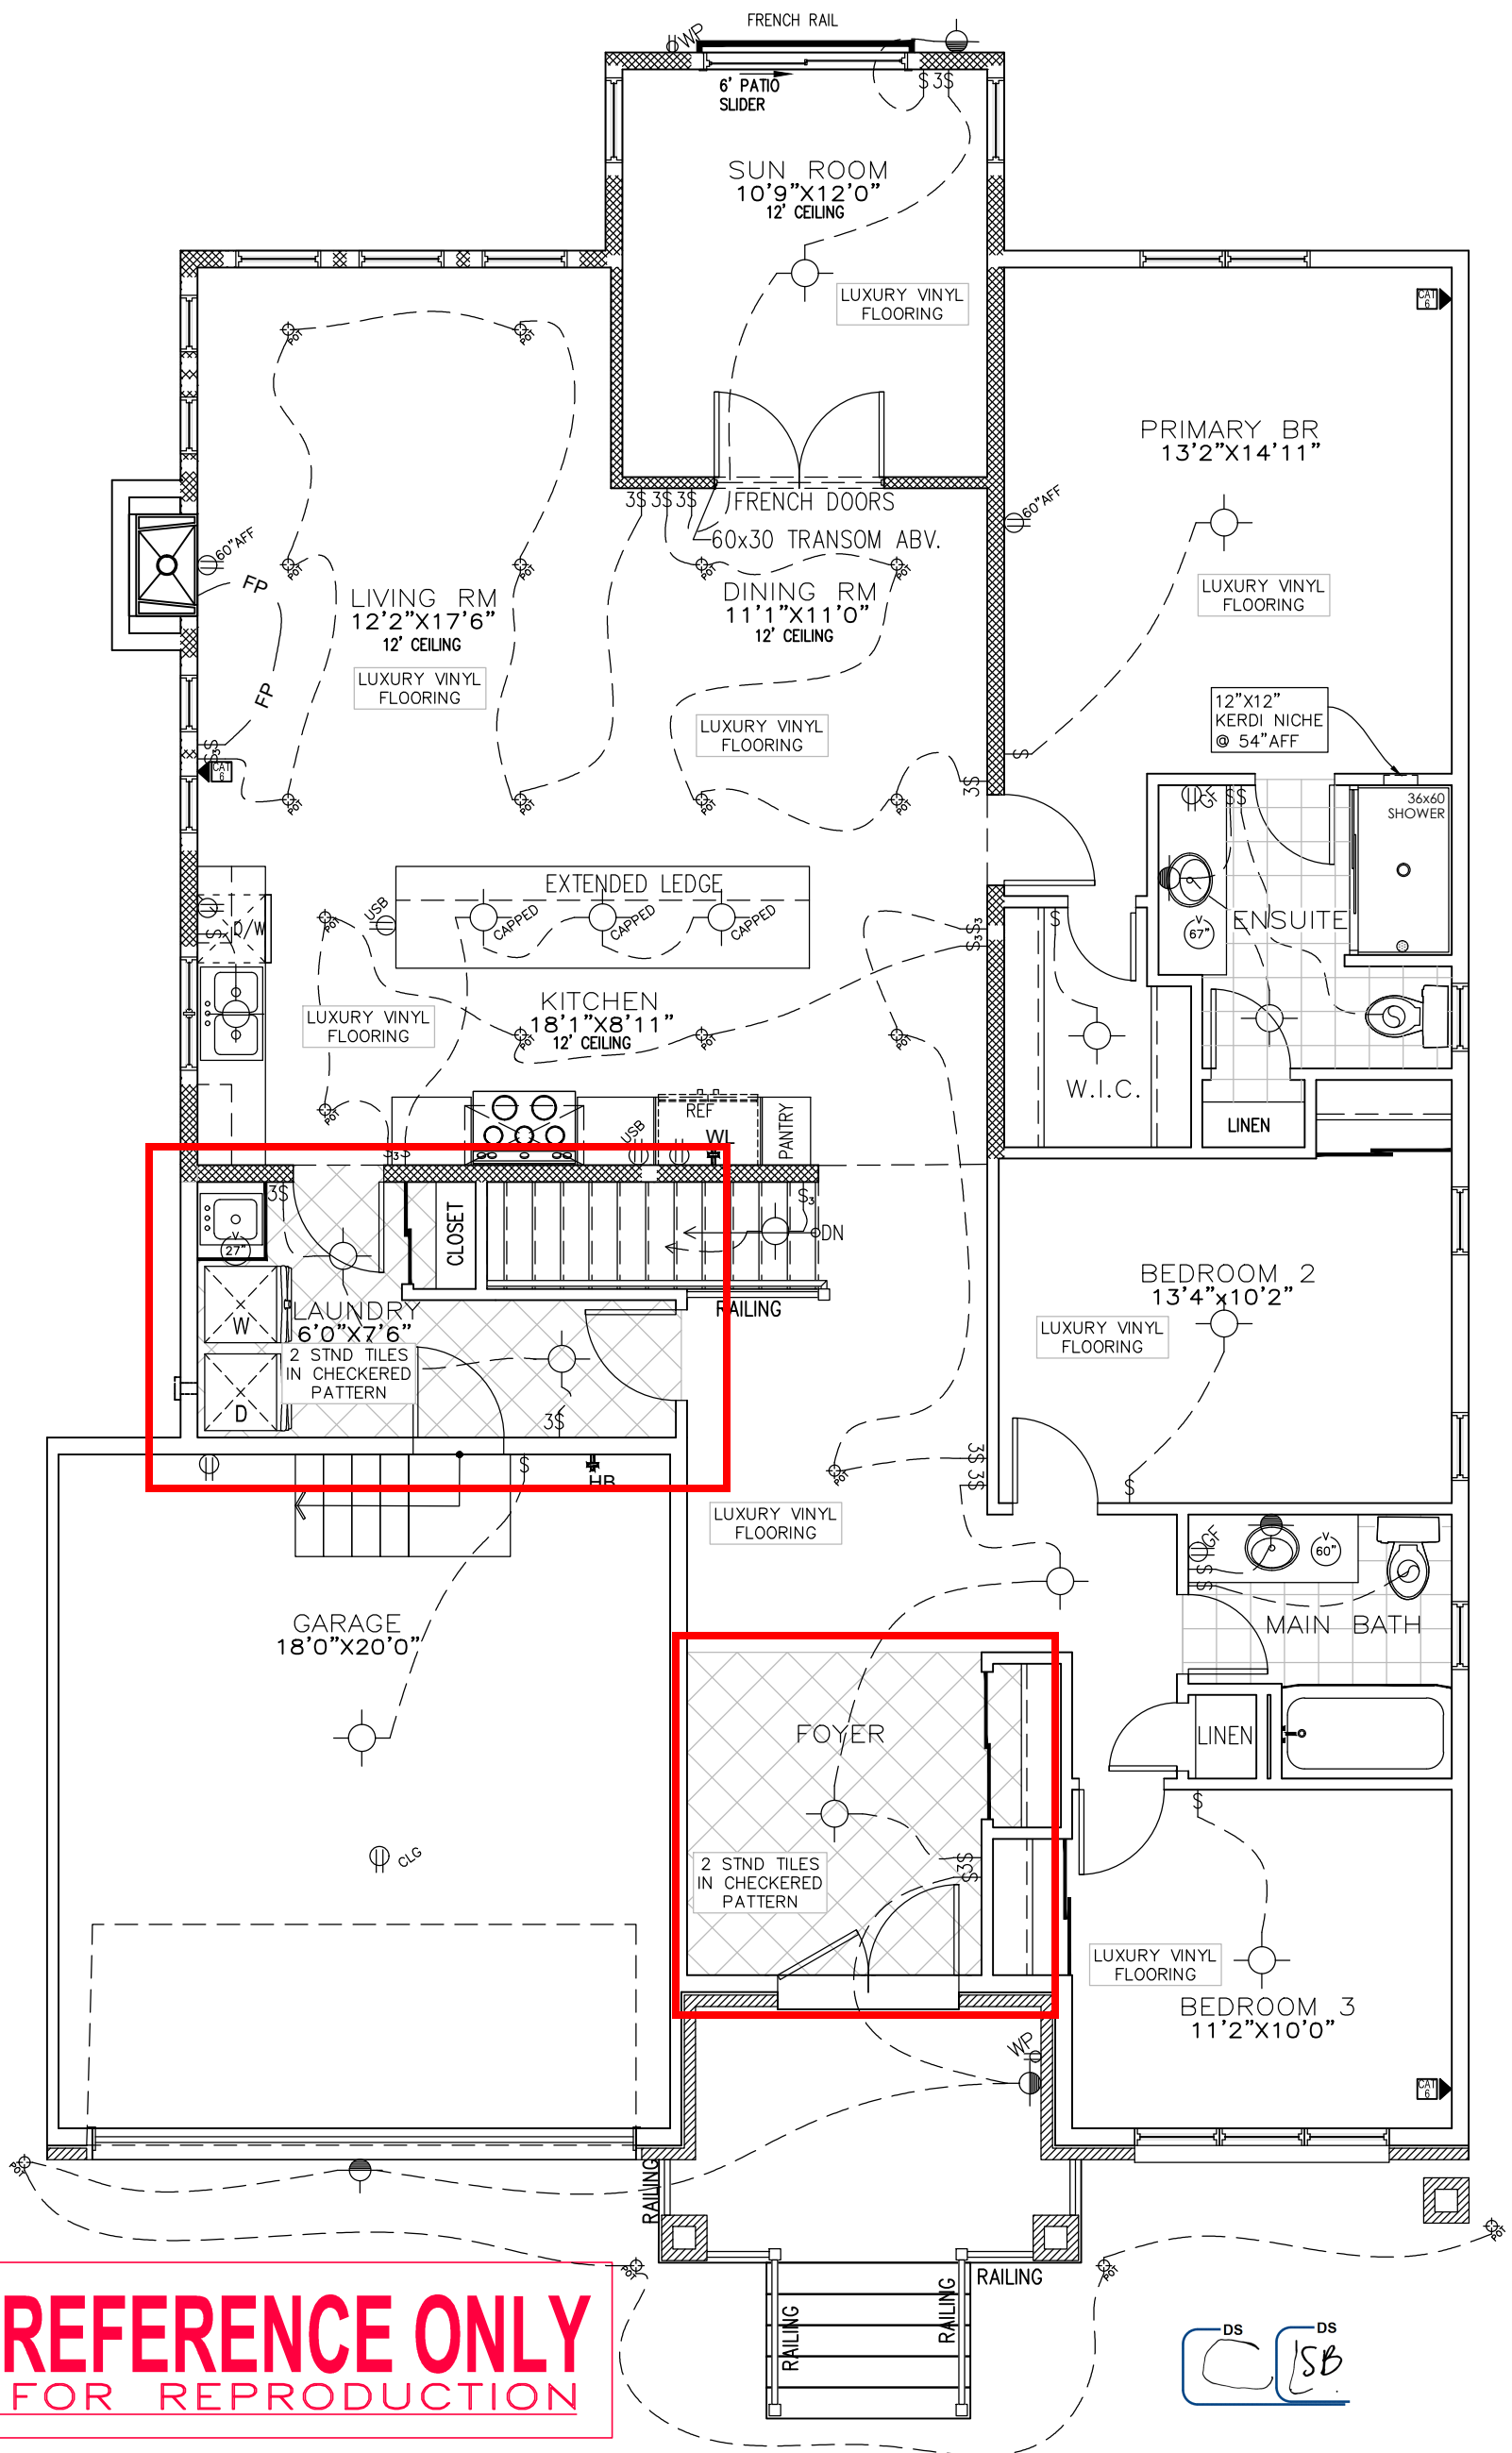


**FOR REFERENCE ONLY**  
NOT FOR REPRODUCTION

GROUND FLOOR

-FLAT CEILINGS THROUGHOUT / NO STIPPLE  
-BYPASS SLIDERS FOR ALL SLIDING CLOSET DOORS

SPRINGFIELD C

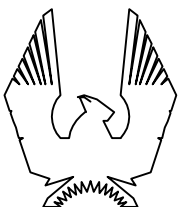

PHOENIX HOMES

SPRINGFIELD C – 2022

SITE: WHITE TAIL RIDGE

LOT NUMBER:


CIVIC ADDRESS:  
131 FRANK FISHER CRESCENT

142

|           |                               |          |    |
|-----------|-------------------------------|----------|----|
| 8         | FINAL BLACKLINES REVISED      | 15/05/24 | CB |
| 7         | FINAL BLACKLINES              | 25/04/24 | CB |
| 6         | ISSUED FOR ENGINEERING        | 26/01/24 | CB |
| 5         | BEP BLACKLINES                | 15/01/24 | CB |
| 4         | B1 PRELIM BLACKLINES          | 20/11/23 | CB |
| 3         | PRIMARY ENSUITE SHOWER UPDATE | 09/05/23 | SP |
| No.       | Description                   | dd/mm/yy | By |
| REVISIONS |                               |          |    |

|            |                                                                                       |
|------------|---------------------------------------------------------------------------------------|
| footprint: | B-24                                                                                  |
| drawn by:  | SD                                                                                    |
| date:      | SEP/12                                                                                |
| scale:     | 3/16"=1'-0"                                                                           |
| sheet no:  |  |
| D.C.L.-A-9 |                                                                                       |


FOR REFERENCE ONLY  
NOT FOR REPRODUCTION

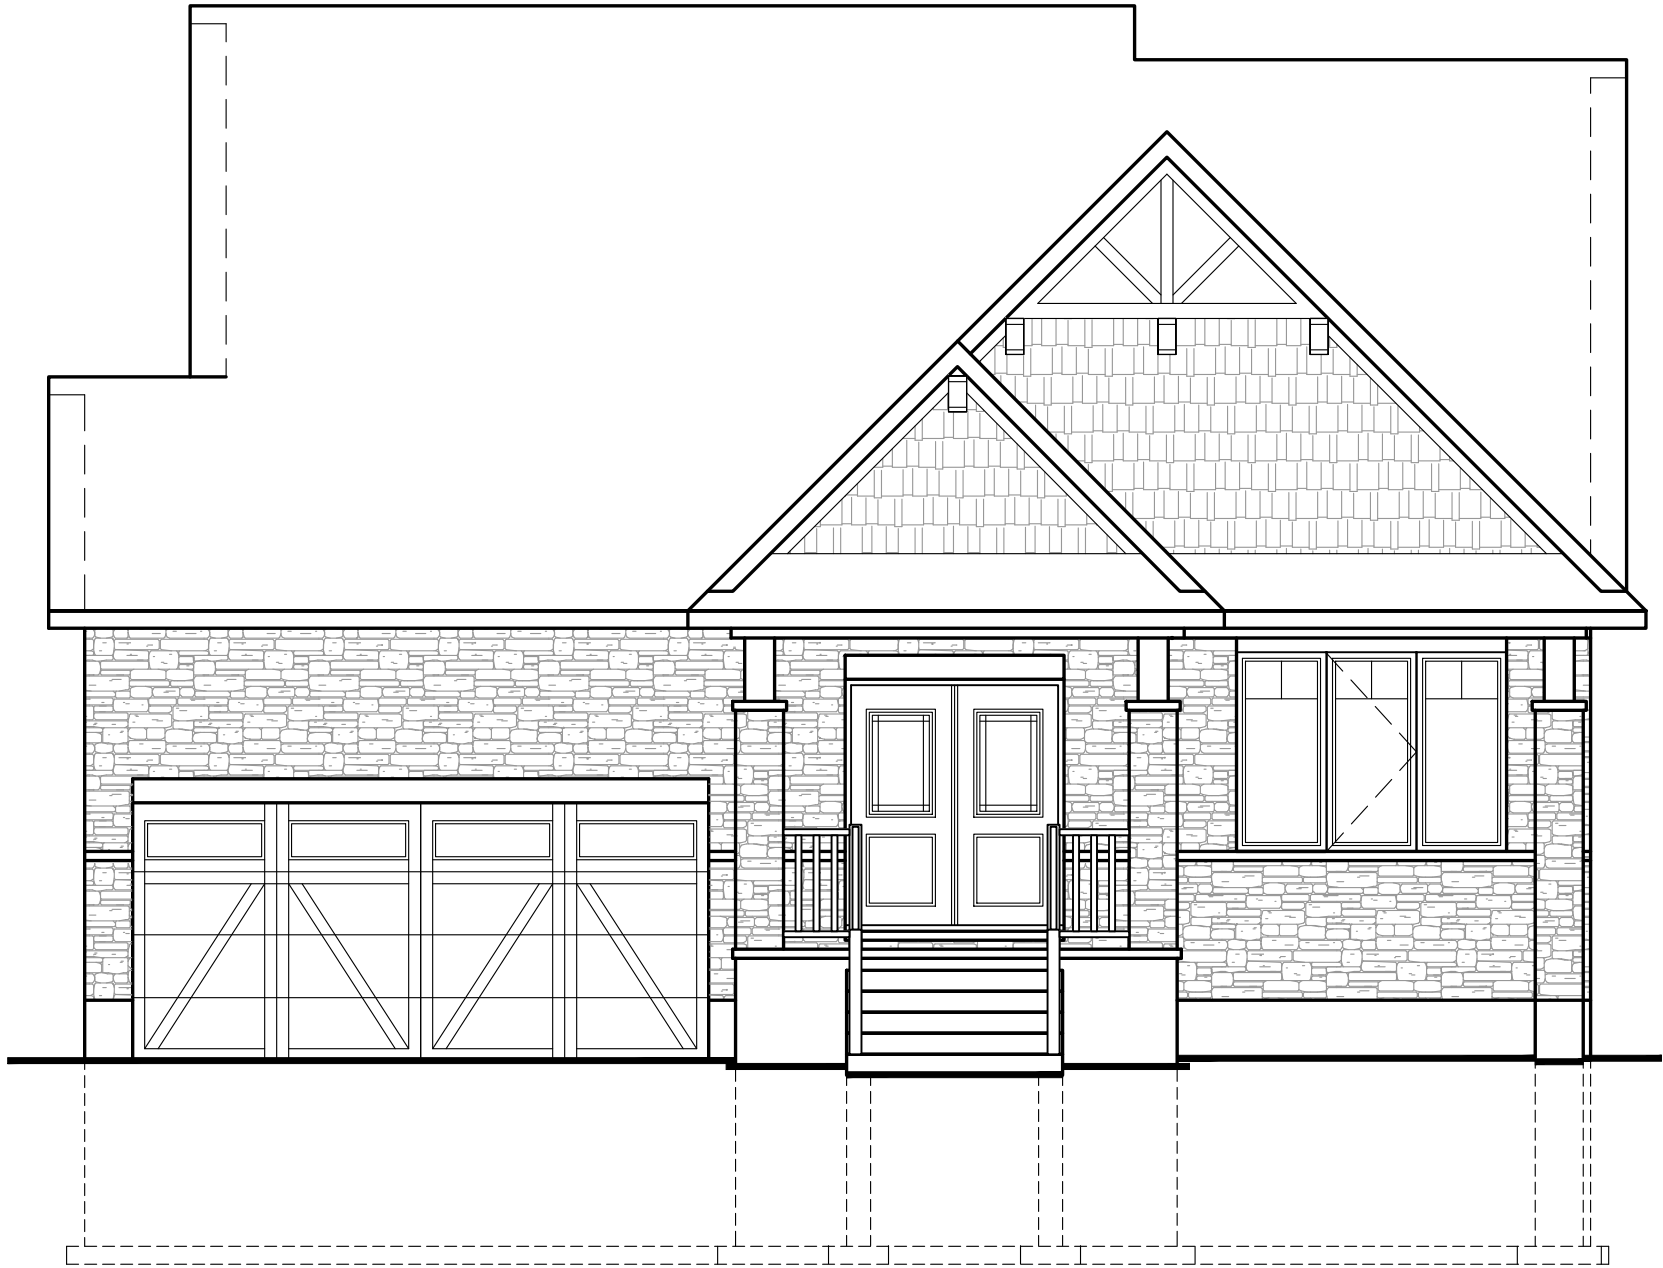

FRONT ELEVATION C

DS  
SB

DS  
CL

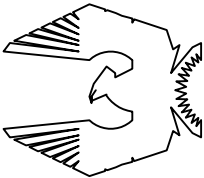

PHOENIX HOMES

SPRINGFIELD C – 2022

SITE: WHITE TAIL RIDGE

LOT NUMBER:

CIVIC ADDRESS:  
131 FRANK FISHER CRESCENT

142

|           |                               |          |    |
|-----------|-------------------------------|----------|----|
| 8         | FINAL BLACKLINES REVISED      | 15/05/24 | CB |
| 7         | FINAL BLACKLINES              | 25/04/24 | CB |
| 6         | ISSUED FOR ENGINEERING        | 26/01/24 | CB |
| 5         | BEP BLACKLINES                | 15/01/24 | CB |
| 4         | B1 PRELIM BLACKLINES          | 20/11/23 | CB |
| 3         | PRIMARY ENSUITE SHOWER UPDATE | 09/05/23 | SP |
| No.       | Description                   | dd/mm/yy | By |
| REVISIONS |                               |          |    |

|              |             |
|--------------|-------------|
| footprint:   | B-24        |
| drawn by:    | SD          |
| date:        | SEP/12      |
| scale:       | 3/16"=1'-0" |
| sheet no:    | 4<br>9      |
| D.C.L. – A-9 |             |


FOR REFERENCE ONLY  
NOT FOR REPRODUCTION



REAR ELEVATION C

DS  
SB

DS  
CL

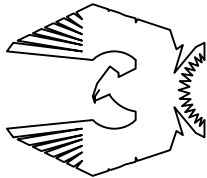

PHOENIX HOMES

SPRINGFIELD C – 2022

SITE: WHITE TAIL RIDGE

LOT NUMBER:

CIVIC ADDRESS:  
131 FRANK FISHER CRESCENT

142

|                 |                               |          |    |
|-----------------|-------------------------------|----------|----|
| 8               | FINAL BLACKLINES REVISED      | 15/05/24 | CB |
| 7               | FINAL BLACKLINES              | 25/04/24 | CB |
| 6               | ISSUED FOR ENGINEERING        | 26/01/24 | CB |
| 5               | BEP BLACKLINES                | 15/01/24 | CB |
| 4               | B1 PRELIM BLACKLINES          | 20/11/23 | CB |
| 3               | PRIMARY ENSUITE SHOWER UPDATE | 09/05/23 | SP |
| No. Description |                               | dd/mm/yy | By |
| REVISIONS       |                               |          |    |

|              |               |
|--------------|---------------|
| footprint:   | B-24          |
| drawn by:    | SD            |
| date:        | SEP/12        |
| scale:       | 3/16" = 1'-0" |
| sheet no:    | 5<br>9        |
| D.C.L. - A-9 |               |


FOR REFERENCE ONLY  
NOT FOR REPRODUCTION



RIGHT SIDE ELEVATION C

DS  
SB

DS  
CL

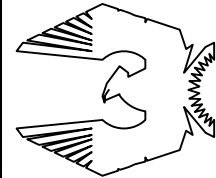

PHOENIX HOMES

SPRINGFIELD C – 2022

SITE: WHITE TAIL RIDGE

LOT NUMBER:

CIVIC ADDRESS:  
131 FRANK FISHER CRESCENT

142

|                 |                               |          |    |
|-----------------|-------------------------------|----------|----|
| 8               | FINAL BLACKLINES REVISED      | 15/05/24 | CB |
| 7               | FINAL BLACKLINES              | 25/04/24 | CB |
| 6               | ISSUED FOR ENGINEERING        | 26/01/24 | CB |
| 5               | BEP BLACKLINES                | 15/01/24 | CB |
| 4               | B1 PRELIM BLACKLINES          | 20/11/23 | CB |
| 3               | PRIMARY ENSUITE SHOWER UPDATE | 09/05/23 | SP |
| No. Description |                               | dd/mm/yy | By |
| REVISIONS       |                               |          |    |

|              |             |
|--------------|-------------|
| footprint:   | B–24        |
| drawn by:    | SD          |
| date:        | SEP/12      |
| scale:       | 3/16"=1'-0" |
| sheet no:    | 6<br>9      |
| D.C.L. – A–9 |             |


FOR REFERENCE ONLY  
NOT FOR REPRODUCTION



LEFT SIDE ELEVATION C

DS  
SB

DS  
CL

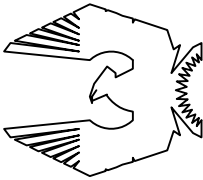

PHOENIX HOMES

SPRINGFIELD C – 2022

SITE: WHITE TAIL RIDGE

LOT NUMBER:

CIVIC ADDRESS:  
131 FRANK FISHER CRESCENT

142

|           |                               |          |    |
|-----------|-------------------------------|----------|----|
| 8         | FINAL BLACKLINES REVISED      | 15/05/24 | CB |
| 7         | FINAL BLACKLINES              | 25/04/24 | CB |
| 6         | ISSUED FOR ENGINEERING        | 26/01/24 | CB |
| 5         | BEP BLACKLINES                | 15/01/24 | CB |
| 4         | B1 PRELIM BLACKLINES          | 20/11/23 | CB |
| 3         | PRIMARY ENSUITE SHOWER UPDATE | 09/05/23 | SP |
| No.       | Description                   | dd/mm/yy | By |
| REVISIONS |                               |          |    |

|              |             |
|--------------|-------------|
| footprint:   | B-24        |
| drawn by:    | SD          |
| date:        | SEP/12      |
| scale:       | 3/16"=1'-0" |
| sheet no:    | 7<br>9      |
| D.C.L. - A-9 |             |