


Y VŨI ẦU VÁI GÁ

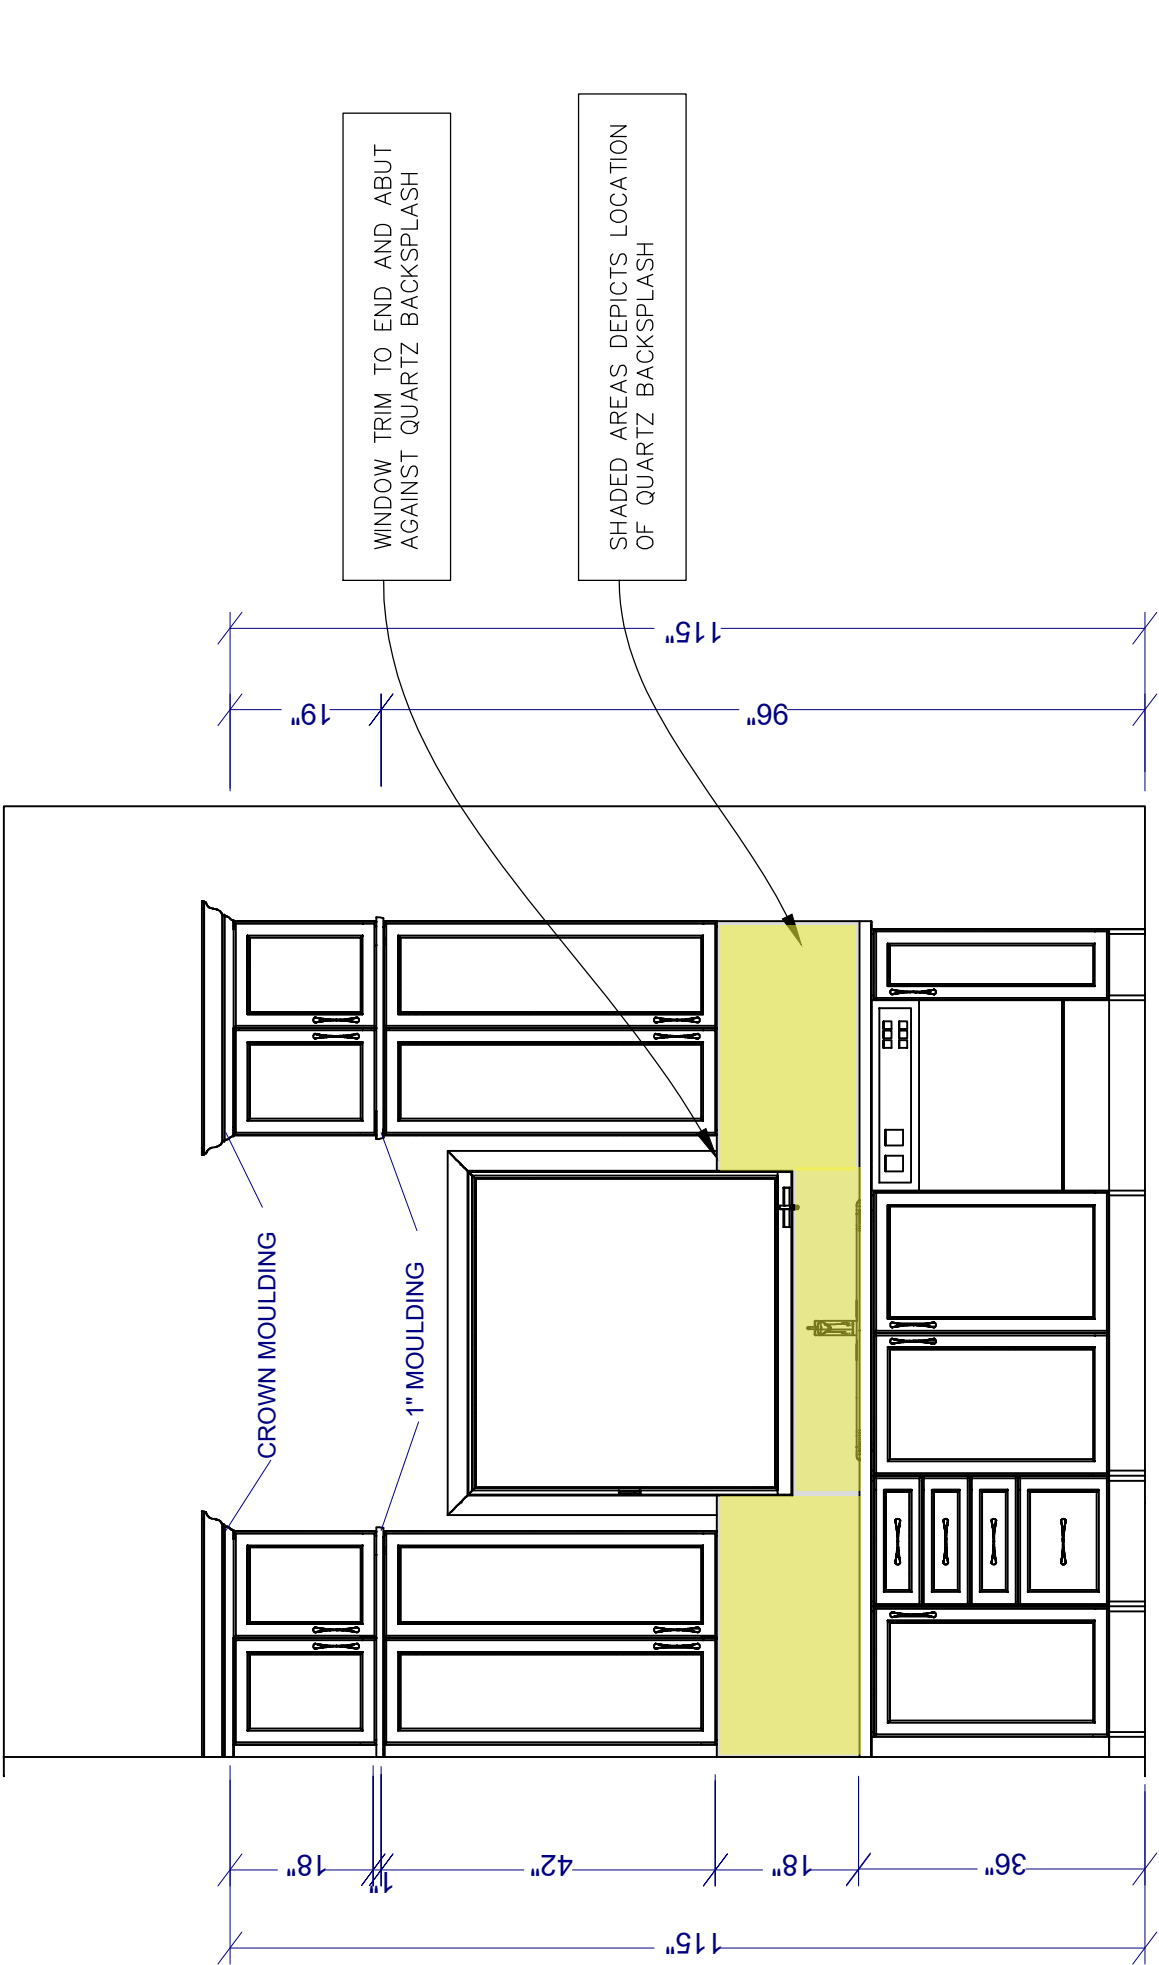

ELEVATION - SINK WALL

DS
SB

DS
CL

MILLWORK ELEVATION BY OTHERS SHOWN WITH NOTES ON QUARTZ BACKSPLASH ADDED



LOT NUMBER	4-142
SCALE	NTS
MODEL	SPRINGFIELD 'C'


WHITETAIL RIDGE

PRELIMINARY DESIGN ONLY – SUBJECT TO STRUCTURAL REVIEW AND FINAL APPROVALS – E.&O.E.

Y VÜI ŠUVÁFI GÁ

KITCHEN QUARTZ
BACKSPLASH
LOCATION

FILL DENOTES TILE AREA

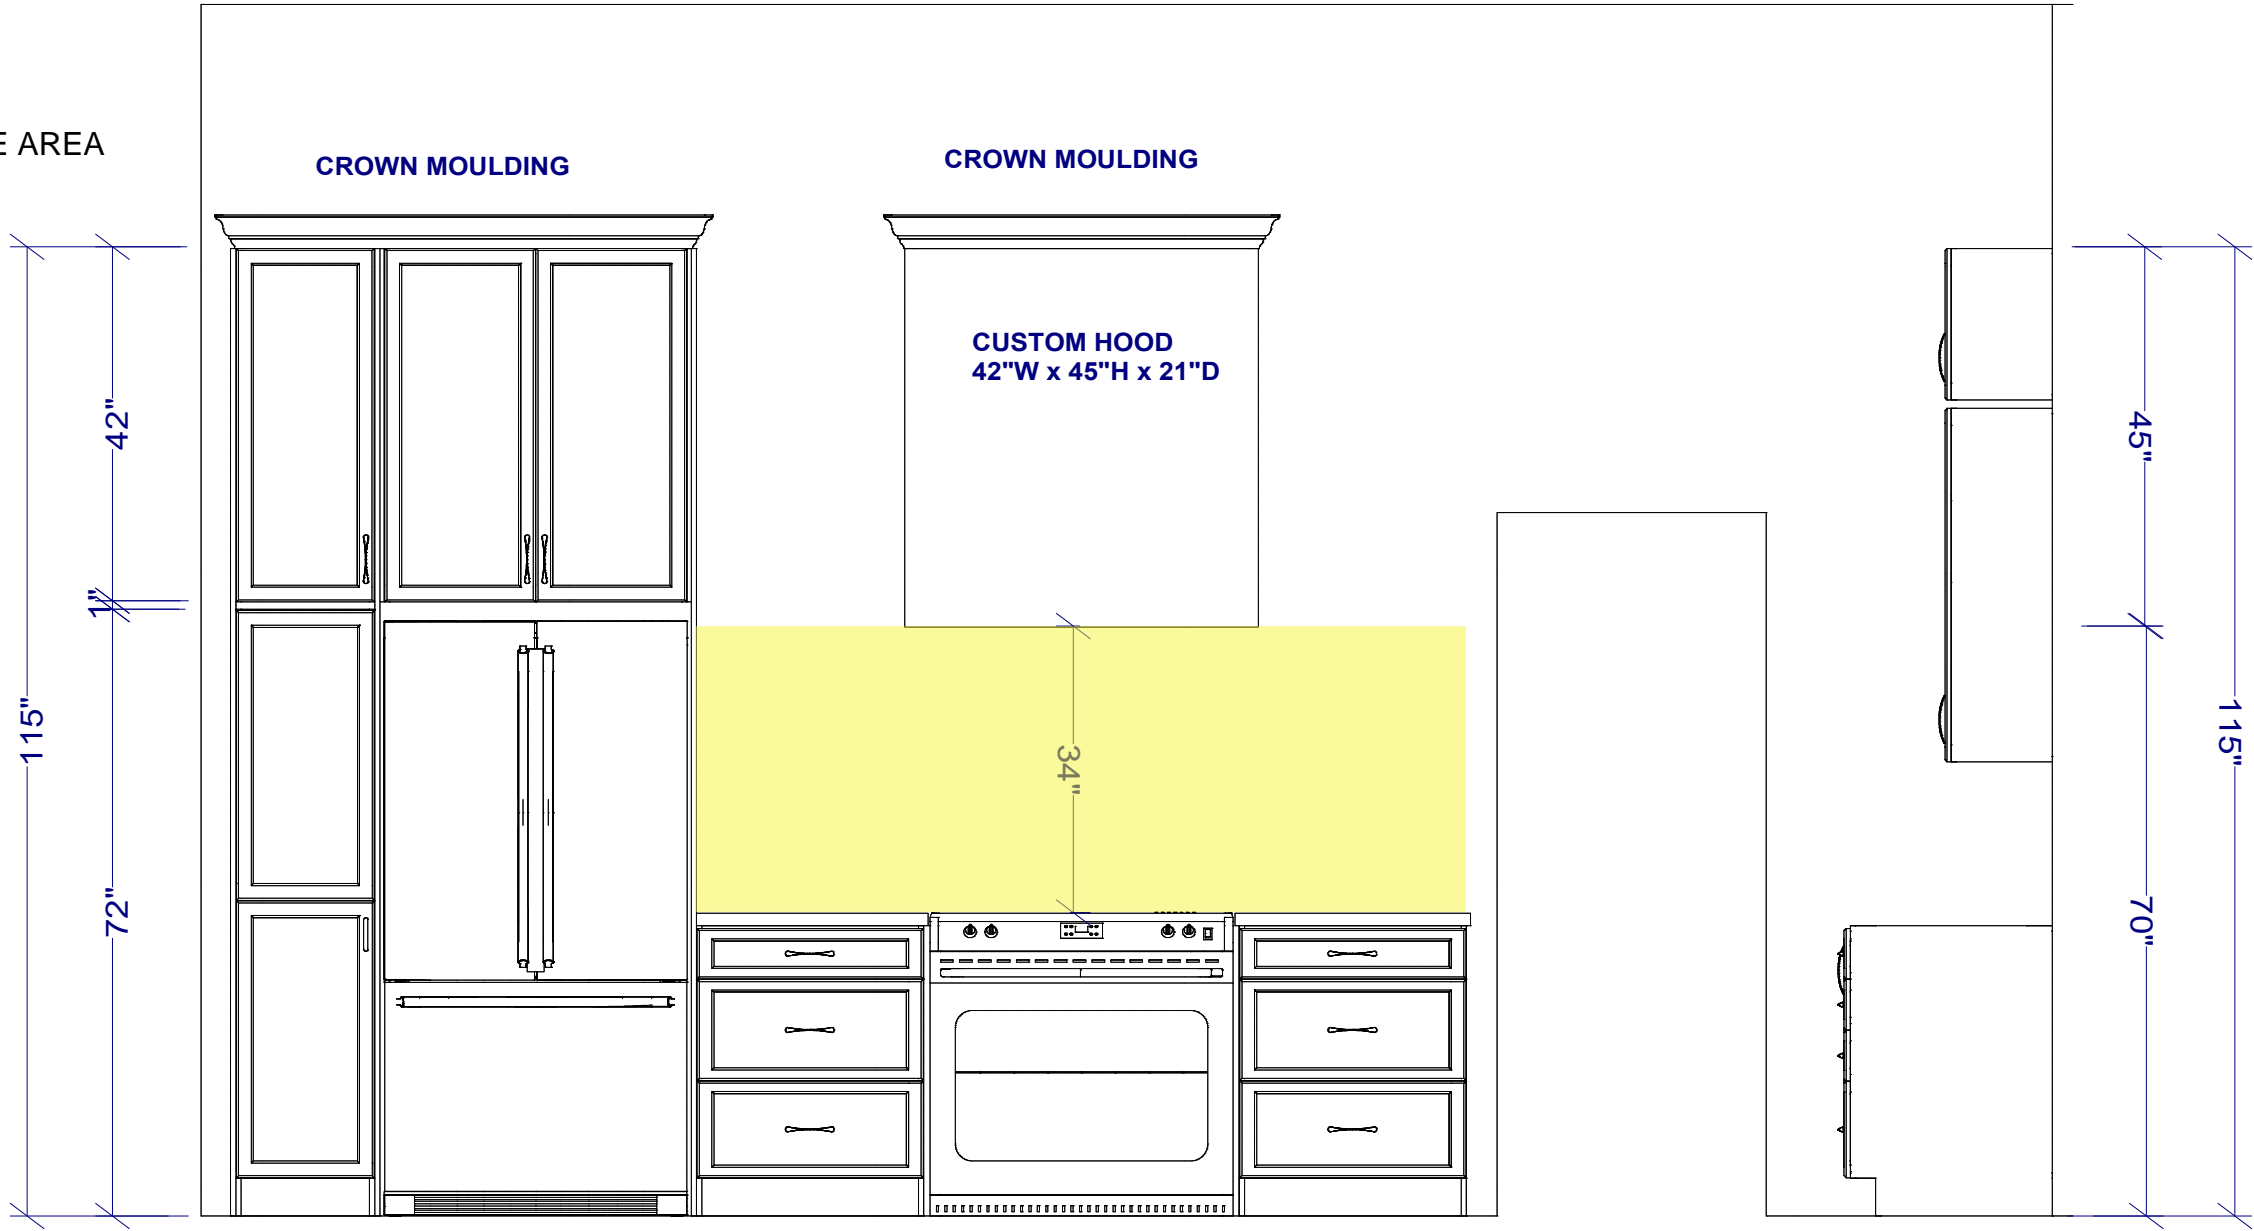

ELEVATION - FRIDGE / RANGE WALL

All dimensions _size designations given are subject to verification on job site and adjustment to fit job conditions.



This is an original design and must not be released or copied unless applicable fee has been paid or job order placed.

Designed: 4/1/2024
Printed: 4/1/2024

DS SB DS CL