


DCR PHOENIX HOMES

WHITE TAIL RIDGE 4
LOT# 4-142

27 AUG 2024
CLIENT ACCEPTED SEAM LOCATION
AS PER EMAIL

KITCHEN ISLAND SEAM
LOCATION

OPTION #2 A

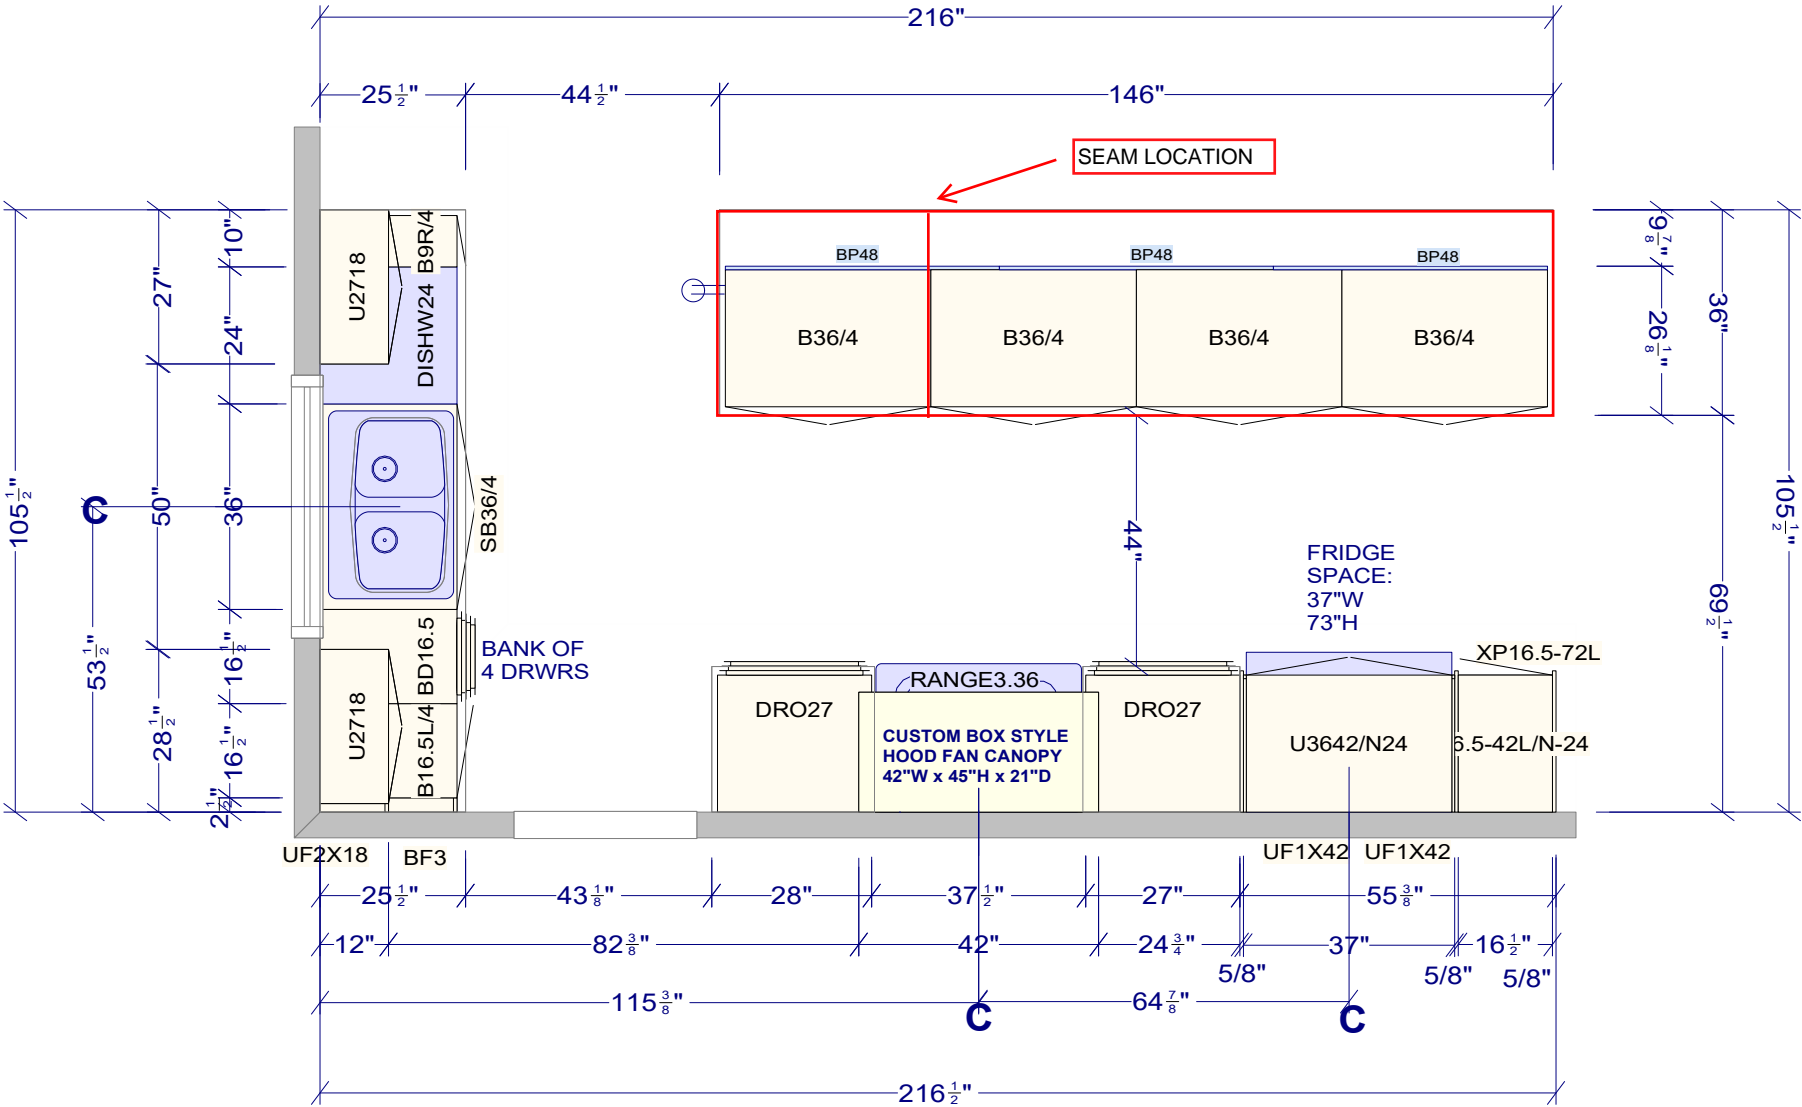

All dimensions _size designations given are subject to verification on job site and adjustment to fit job conditions.



This is an original design and must not be released or copied unless applicable fee has been paid or job order placed.

Designed: 4/1/2024
Printed: 4/1/2024