

DCR PHOENIX HOMES

CLIENT ACCEPTANCE - AS PER EMAIL 30 AUG 2024



PATHWAYS

NUVO - TERRACE HOMES


BLDG 6 - UPPER UNIT #231

33F SALAMANDER WAY


JULY 29, 2024
AS PER SITE MEASURE

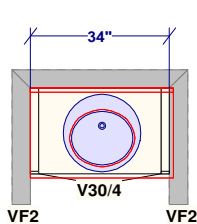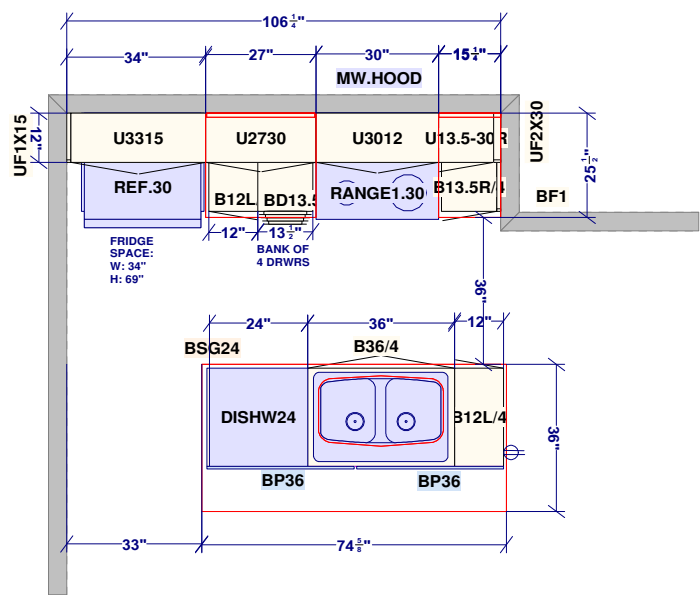

POWDER ROOM

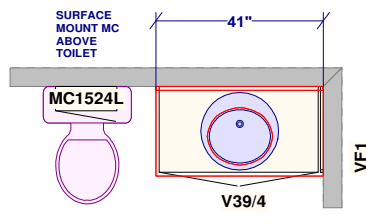

MAIN BATH

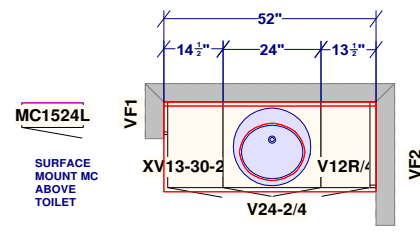

ENSUITE

All dimensions and size designations given are subject to verification on job site and adjustment to fit job conditions.

This is an original design and must not be released or copied unless applicable fee has been paid or job order placed.

Designed: 2024-02-20
Printed: 2024-07-30