


DCR PHOENIX HOMES


LOT #137
WHITE TAIL RIDGE 4
MODEL - SPRINGFIELD
GARAGE RIGHT

OPTION #2

CLIENT APPROVED VIA EMAIL 04 SEPT 2024
NOTE: SEAM TO BE LOCATED AT THE CONNECTION OF THE POT AND PAN DRAWER WITH THE BASE CABINET

KITCHEN
MOUNTING HEIGHT - 86"
30"H UPPERS @ 20" ABOVE THE COUNTER
LIGHT VALANCE

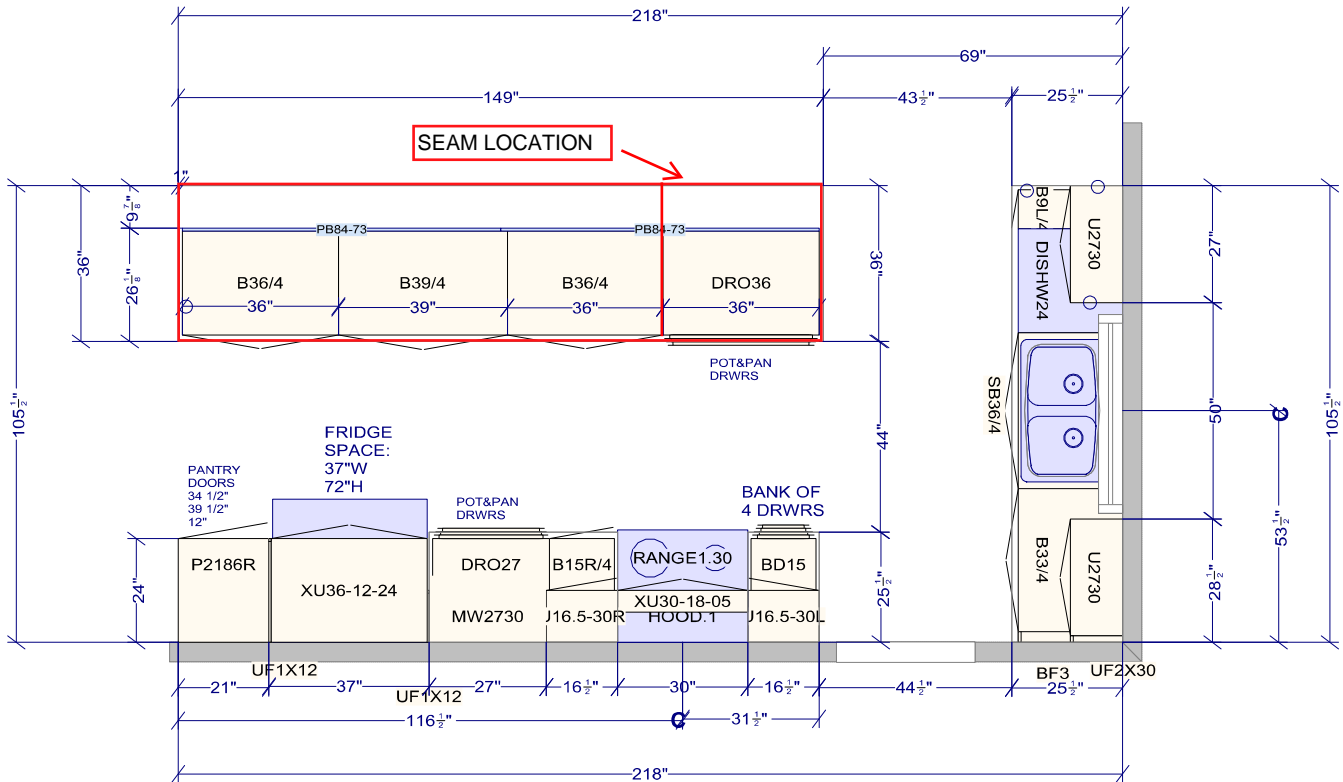

<div>CUSTOMER APPROVAL</div> <div>I have reviewed these drawings and understand the design and the Cartier Kitchens specifications.</div> <div>Signature _____</div> <div>Date _____</div>	<div>All dimensions, size designations given are subject to verification on job site and adjustment to fit job conditions.</div> <div>WT4 lot 137</div>	<div></div>	<div>This is an original design and must not be released or copied unless applicable fee has been paid or job order placed.</div>	Designed: 10/12/2023 Printed: 10/12/2023	
				All	Drawing #: 1 No Scale.