

DCR - PHOENIX HOMES

LOT #146

WHITE TAIL RIDGE 4

NEWINGTON (Left)

STANDARD KITCHEN

MOUNTING HEIGHT: 96

FILL TO CEILING WITH 1" MOULDING,
FURRING PANEL &
SHAKER STYLE CEILING CROWN

CABINETS -

HARDWARE -

STANDARD WHITE INTERIOR

METAL DRAWER BOX

4 PCS - 5/8" KICK - FIN. BOTH ENDS

3 PCS - LOOSE FILLER - 3 x 96


2 PCS - 90 DEG. CORNER MOULD

1 PCS - T-MOULD

5 PCS - FLAT MOULDING

LIGHT VALANCE

REVISÉ: AUG 14-23

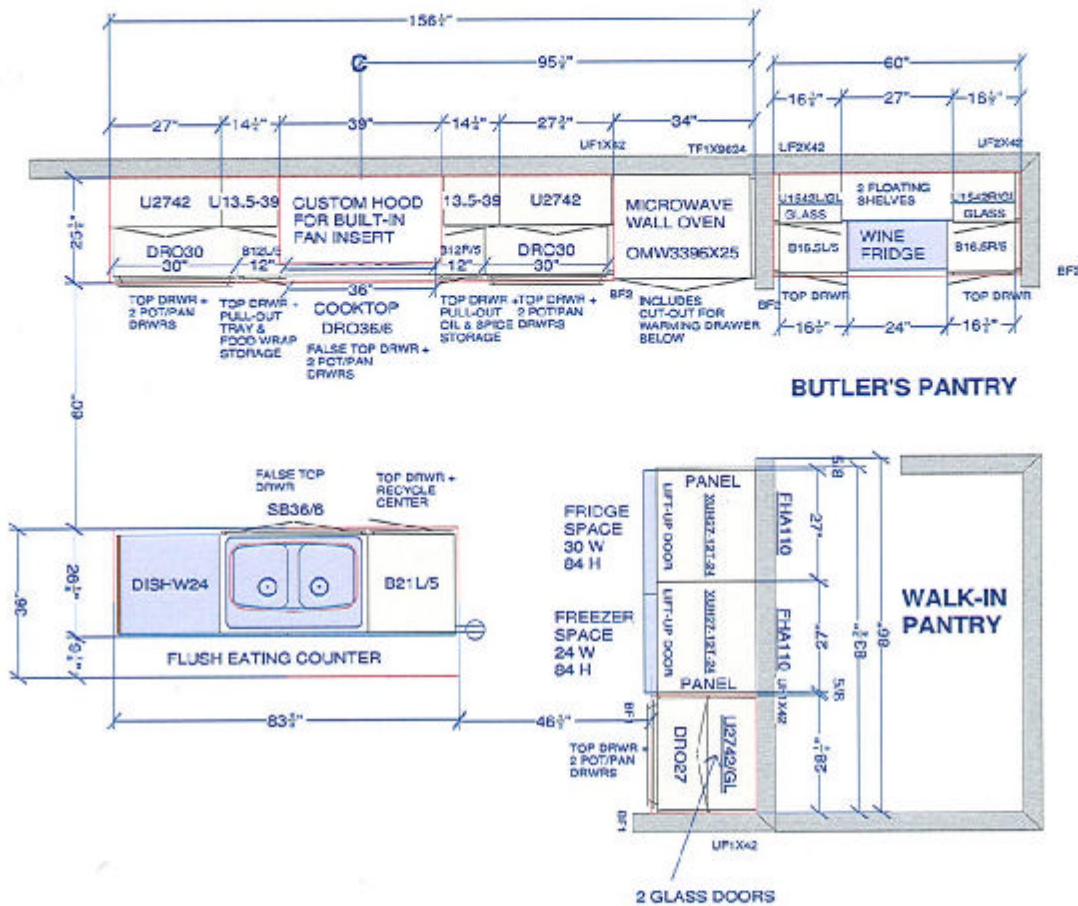

CUSTOMER SERVICE:

I have reviewed the drawings, and understand the details of the design and the CHARTER KITCHENS application.

Signature _____

Date _____

All dimensions size designations given are subject to verification on job site and adjustment to fit job conditions.



This is an original design and must not be released or copied unless applicable fee has been paid or job order placed.


Designed: 2023-08-14
Printed: 2023-08-14

DCR #146 WTR4 - NEWINGTON (Left) - Kitchen - rev Aug 14-23.kit

All

Drawing #: 1	No Scale.
--------------	-----------

DS

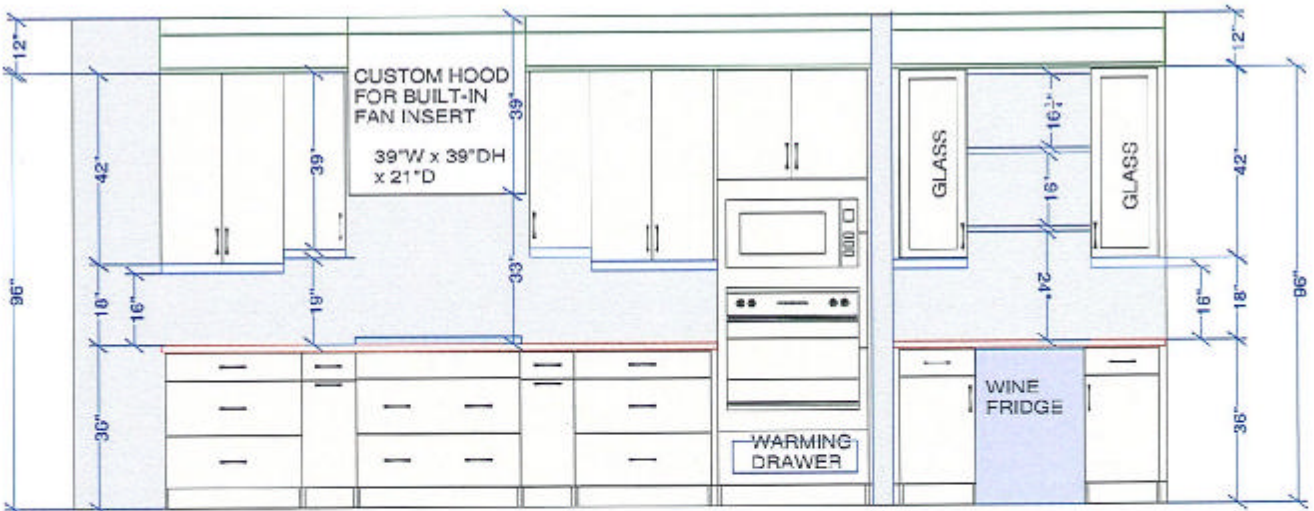

COOKTOP / OVEN WALL ELEVATION BUTLER'S PANTRY

REVISED: AUG 14-23

CUSTOMER APPROVAL

I have reviewed these drawings and understand the details of the design and the LIMITS OF DESIGN specifications.

Signature _____

Date _____


All dimensions and size designations given are subject to verification on job site and adjustment to fit job conditions.



This is an original design and must not be released or copied unless applicable fee has been paid or job order placed.

Designed: 2023-08-14
Printed: 2023-08-14

DS
DT

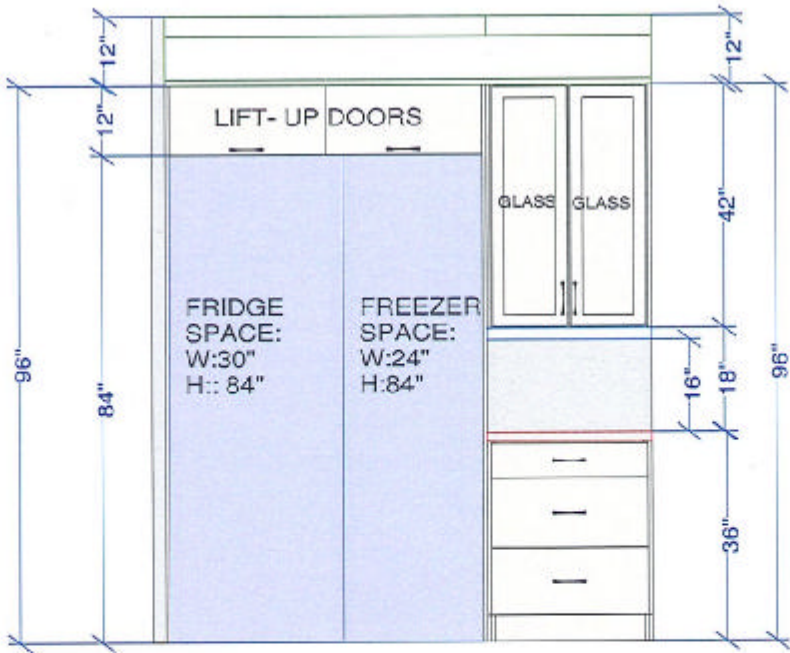

FRIDGE WALL ELEVATION


CUSTOMER APPROVAL I have reviewed these drawings and understand the details of the design and the materials to be used. Signature: _____ Date: _____
--

All dimensions, size designations given are subject to verification on job site and adjustment to fit job conditions.

This is an original design and must not be released or copied unless applicable fee has been paid or job order placed.

Designed: 2023-05-09
Printed: 2023-05-10

DS
DT

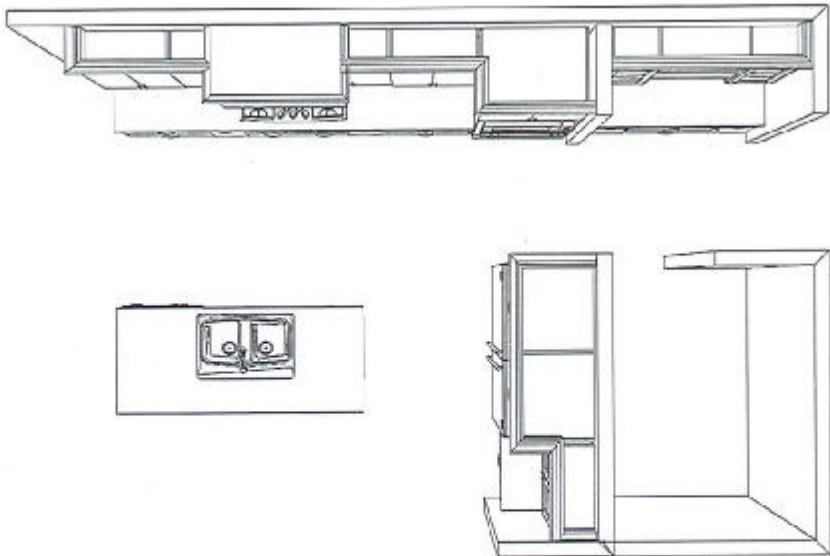


KITCHEN- TOP VIEW
REVISED: AUG 14-23

CUSTOMER APPROVAL I have reviewed these drawings and understand the details of the design and the CANYON KITCHENS specifications. Signature: _____ Date: _____

Note: This drawing is an artistic interpretation of the general appearance of the design. It is not meant to be an exact rendition.		Designed: 2023-08-14 Printed: 2023-08-14
		DCR #146 WTR4 - NEWINGTON (Left) - Kitchen - All Drawing #: 1

DS
DT

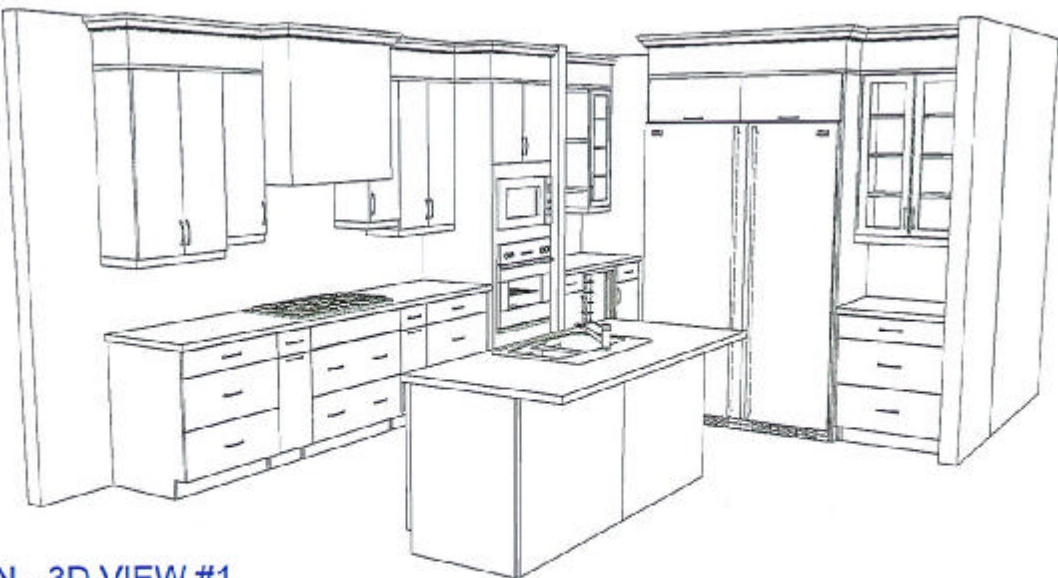

KITCHEN - 3D VIEW #1

REVISED: AUG 14-23


CUSTOMER APPROVAL	
I have reviewed these drawings and understand the details of the design and the CARTER KITCHENS specifications.	
Signature _____	
Date: _____	

Note: This drawing is an artistic interpretation of the general appearance of the design. It is not meant to be an exact rendition.



Designed: 2023-08-14
Printed: 2023-08-14

DS
DT

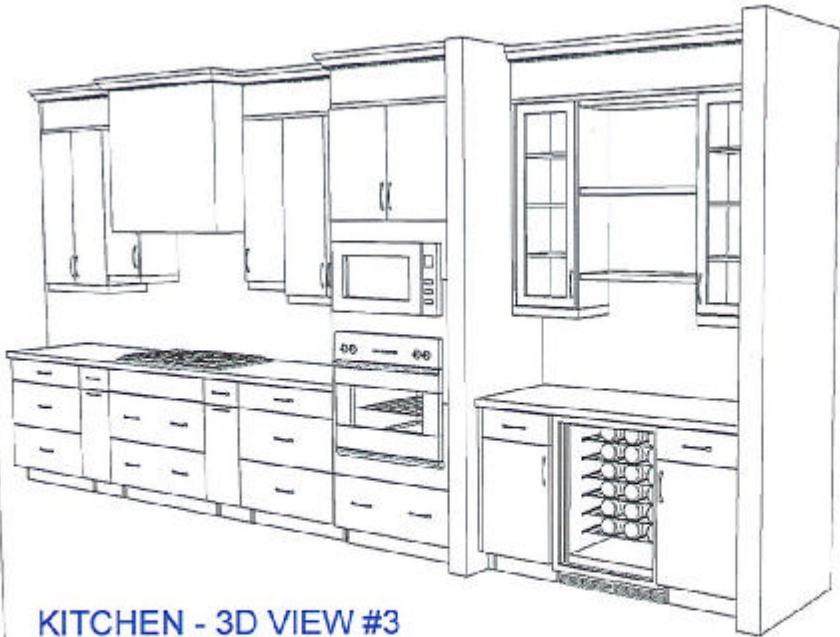

KITCHEN - 3D VIEW #3

REVISED: AUG 14-23


CUSTOMER APPROVAL I have reviewed these drawings and understand the details of the design and the CARTER KITCHENS specifications. Signature _____ Date _____

Note: This drawing is an artistic interpretation of the general appearance of the design. It is not meant to be an exact rendition.



Designed: 2023-08-14
Printed: 2023-08-14

DS
DT

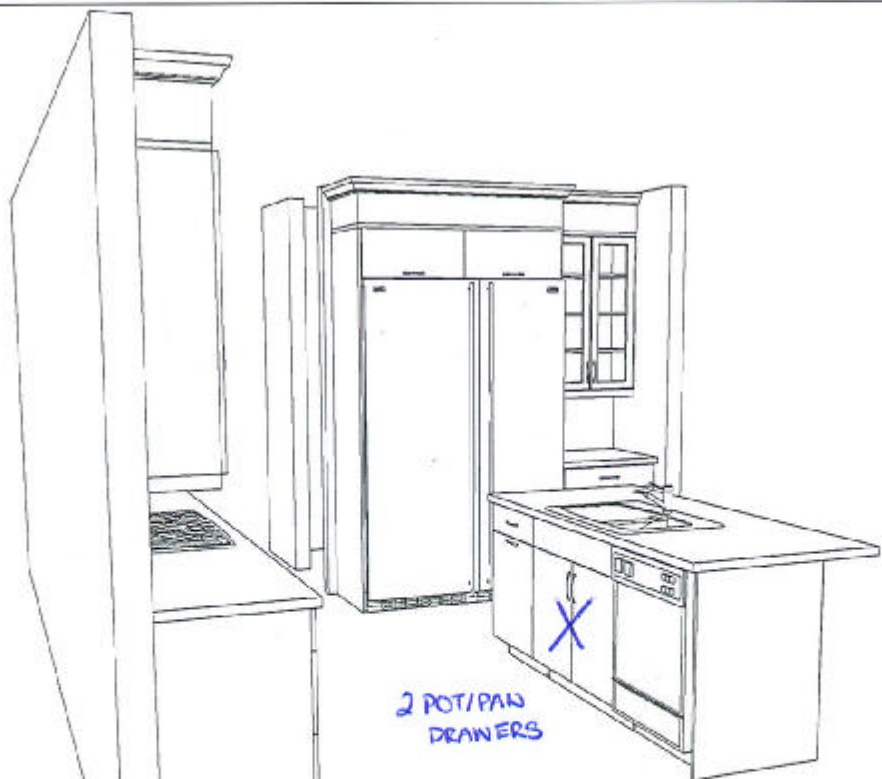

2 POT/PAN
DRAWERS

KITCHEN- 3D VIEW #2

CUSTOMER APPROVAL	
I have reviewed these drawings and understand the details of this design and the CARTIER KITCHENS specifications.	
Signature _____	
Date _____	

Note: This drawing is an artistic interpretation of the general appearance of the design. It is not meant to be an exact rendition.

Designed: 2023-05-09
Printed: 2023-05-10

DCR #146 WTR4 - NEWINGTON (Left) - STD

All

Drawing #: 1

DS
DT