


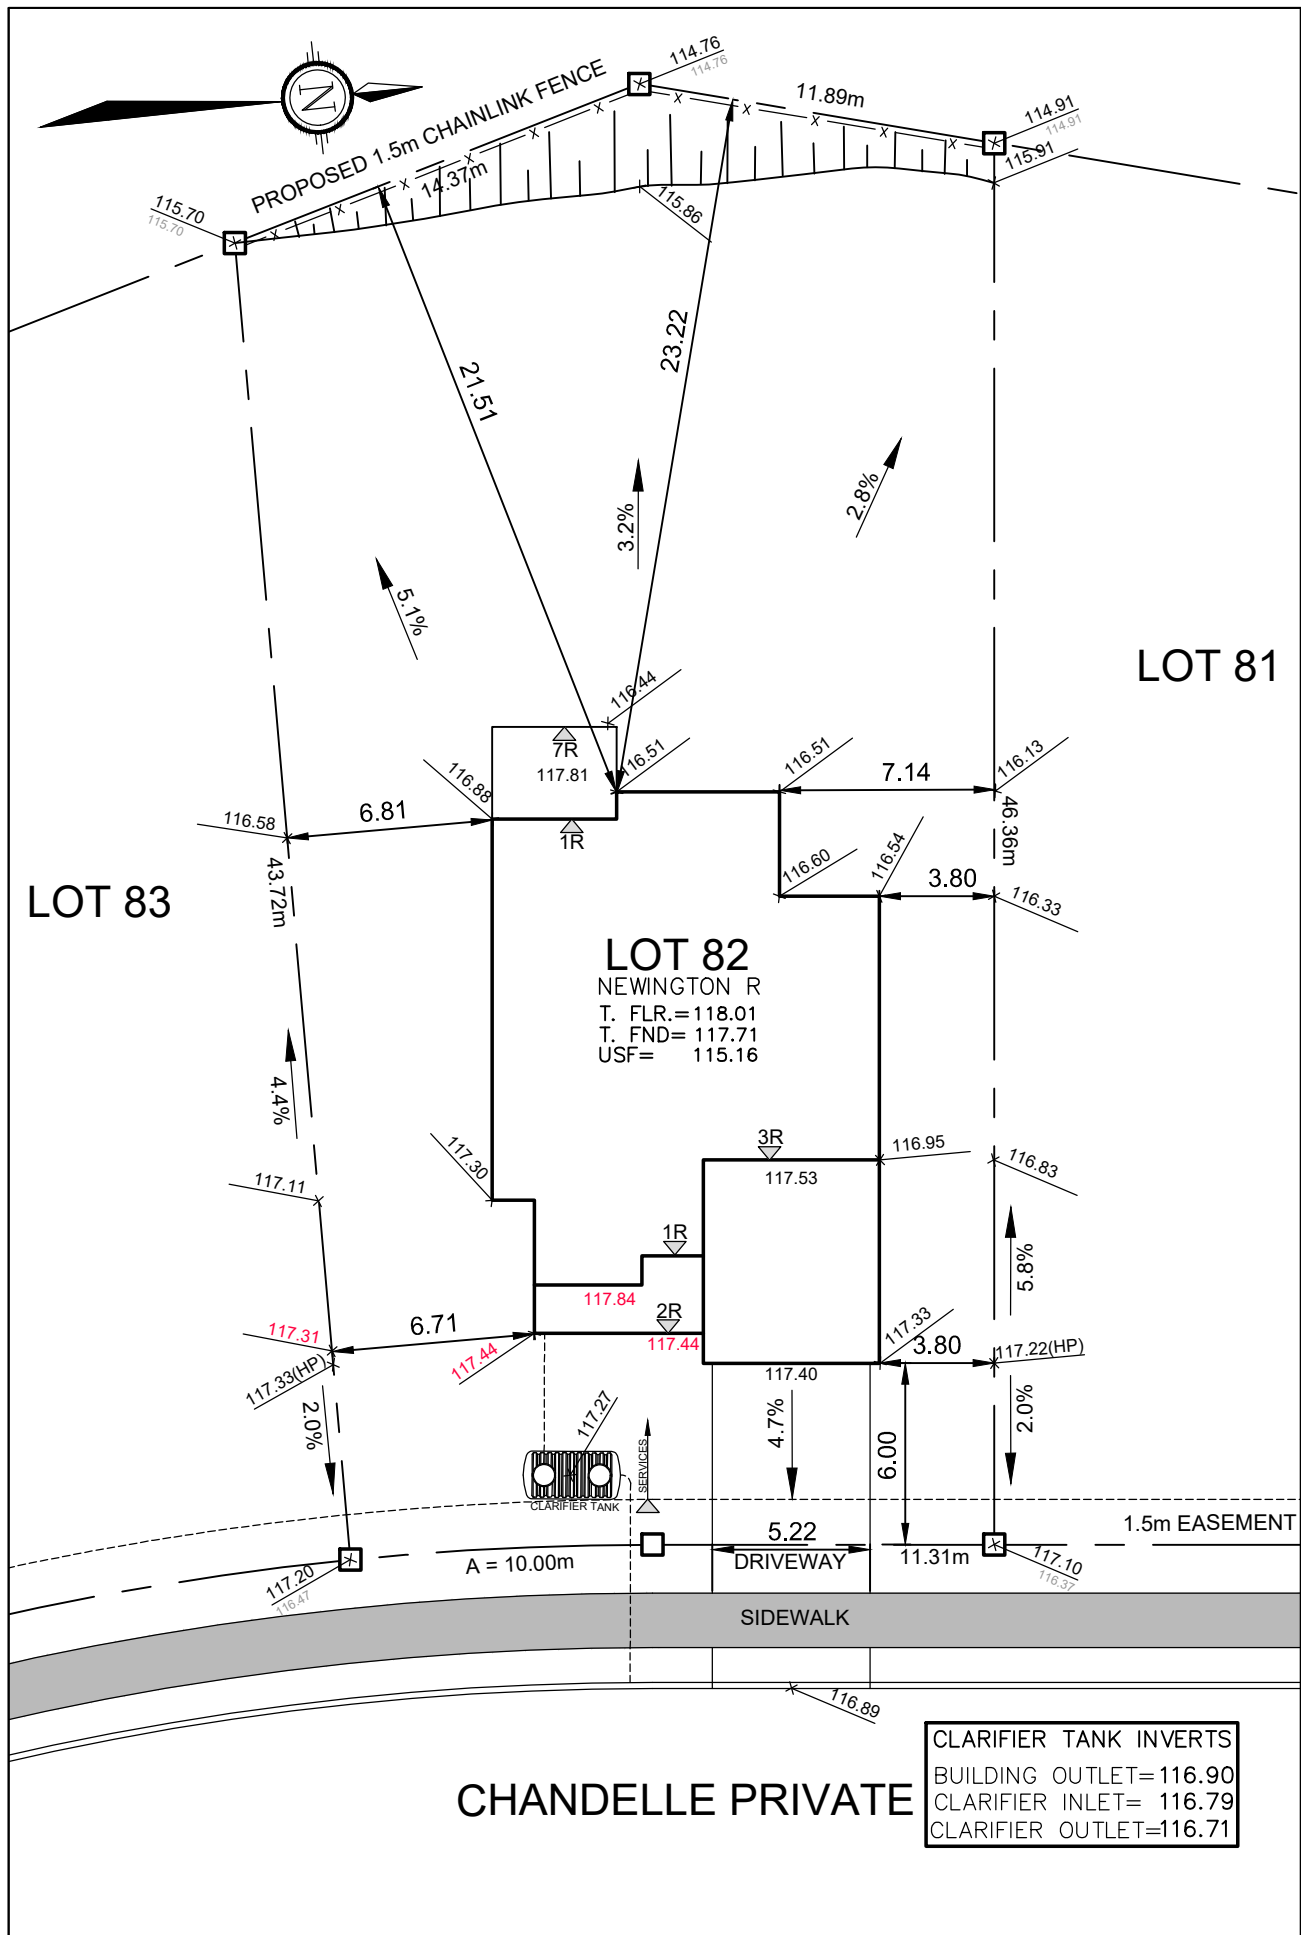

LOT  
82

SITE/GRADING PLAN  
DIAMONDVIEW PHASE 3

INDIVIDUAL LOT GRADING REVIEW SUMMARY FOR SITED  
HOUSE AS COMPARED WITH OVERALL SUBDIVISION PLAN

NOTE: THIS PLAN IS NOT A SURVEY PLAN OR SUBDIVISION  
PLAN WITHIN THE MEANING OF PLANNING ACT.  
THIS PLAN IS FOR REFERENCE ONLY AND IS PRELIMINARY IN  
NATURE, ALL DIMENSIONS SHOWN ARE APPROXIMATE. E,O&E.

Owner/Applicant  
**DCR/PHOENIX HOMES**  
Telephone # 723-9227  
Plan # 4M-1593  
Project name: DIAMONDVIEW  
Civic Address: 98 CHANDELLE PRIV.  
House model: NEWINGTON R

Bldg. Ht. \_\_\_\_\_ m  
Lot coverage \_\_\_\_\_ %  
Scale \_\_\_\_\_  
Sod Area \_\_\_\_\_ m<sup>2</sup>  
Asphalt Area \_\_\_\_\_ m<sup>2</sup>

CHECKED/APPROVED BY: T.L.MAK ENG.  
REVISION - NOV. 5/24 SP