

DCR PHOENIX HOMES

LOT #137

WHITE TAIL RIDGE 4

MODEL - SPRINGFIELD

GARAGE RIGHT

KITCHEN

MOUNTING HEIGHT - 86"

30"H UPPERS @ 20" ABOVE THE COUNTER

LIGHT VALANCE

AS BUILT

30"H UPPERS

PERIMETER - MISSION SATIN WHITE
ISLAND - MISSION TUXEDO

HW:
DOORS - KU66
DRWRS - HU120

STANDARD WHITE INTERIOR

SOFT CLOSE DRAWERS


SOFT CLOSE HINGES

5 PCS - 5/8" KICK - FIN. BOTH ENDS

6 PCS - FLAT SHOE MOULDING

2 PCS - 90 DEG. CORNER MOULD

1 PCS - T-MOULD

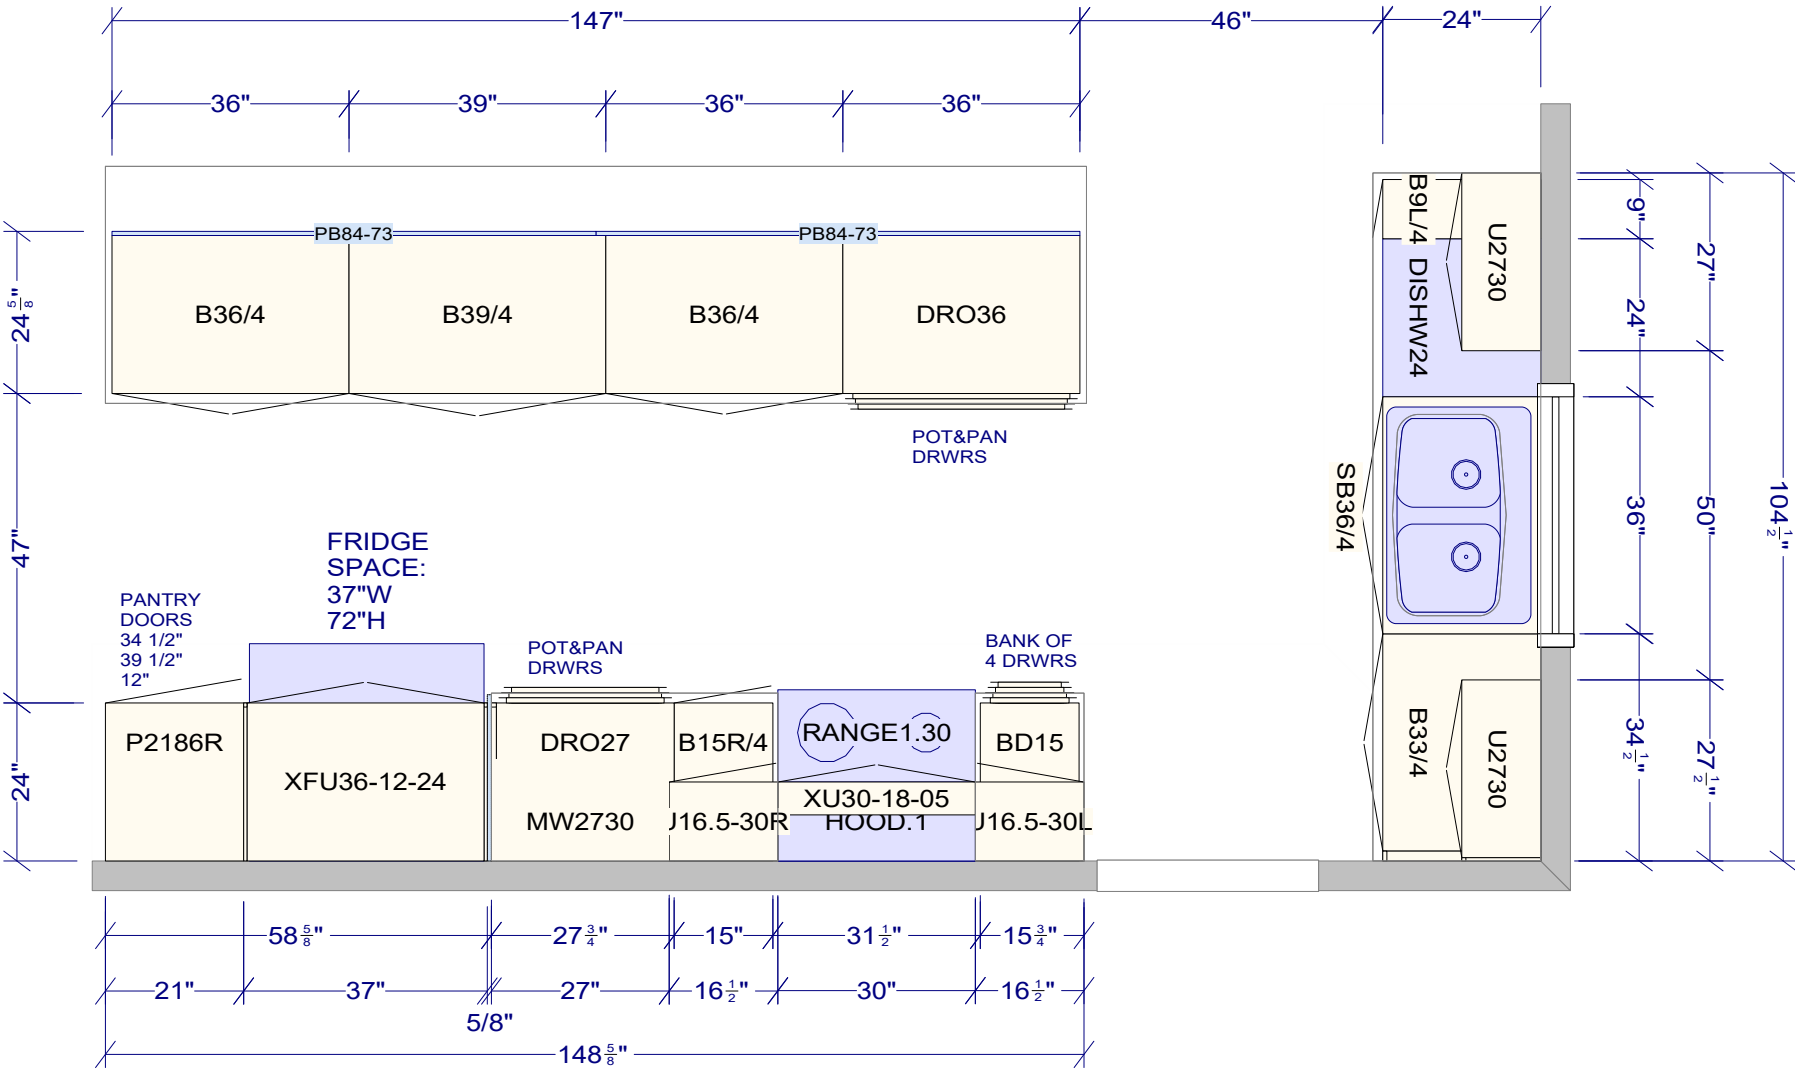

DCR PHOENIX HOMES

WHITE TAIL RIDGE - PHASE 4

LOT# 137

SPRINGFIELD (GARAGE RIGHT)

VANITIES / LAUNDRY

AS BUILT


MISSION - SATIN WHITE

HW:
DOORS - KU66
DRWRS - HU120


WHITE INTERIORS

METAL DRAWERS

STD HINGES

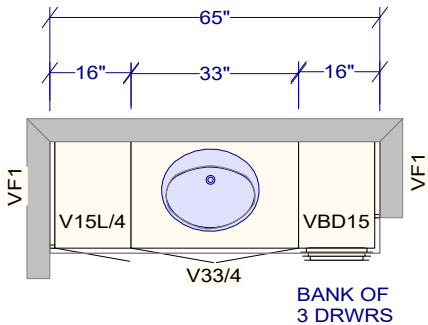

PRIMARY ENSUITE

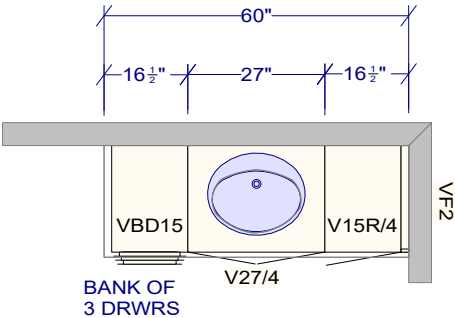

MAIN BATH

MISSION - SATIN WHITE

HW:
DOORS - KU66
DRWRS - HU120

WHITE INTERIORS

METAL DRAWERS

STD HINGES


MISSION - SATIN WHITE

HW: KU66

WHITE INTERIORS

METAL DRAWERS

STD HINGES

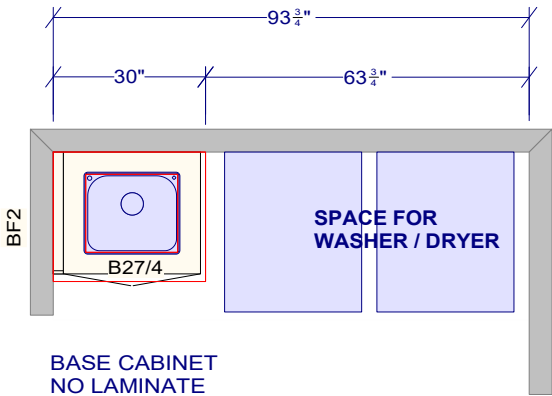

LAUNDRY ROOM

All dimensions _size designations given are subject to verification on job site and adjustment to fit job conditions.



This is an original design and must not be released or copied unless applicable fee has been paid or job order placed.

Designed: 5/29/2024
Printed: 11/14/2024