



DCR PHOENIX HOMES

NUVO - BACK TO BACK  
STACKED TERRACE HOMES

UPPER UNIT

REVISED: JANUARY 17, 2023

BUILDING 1 UNIT 206

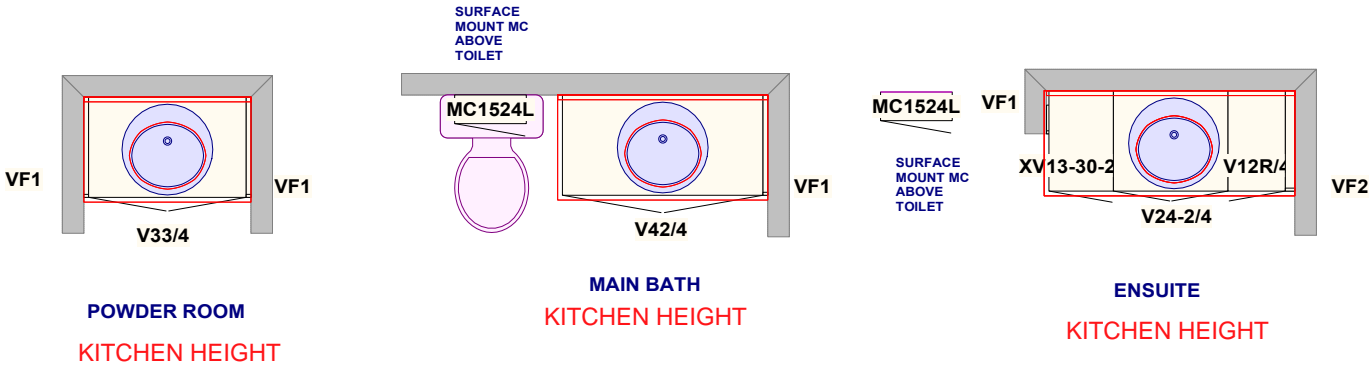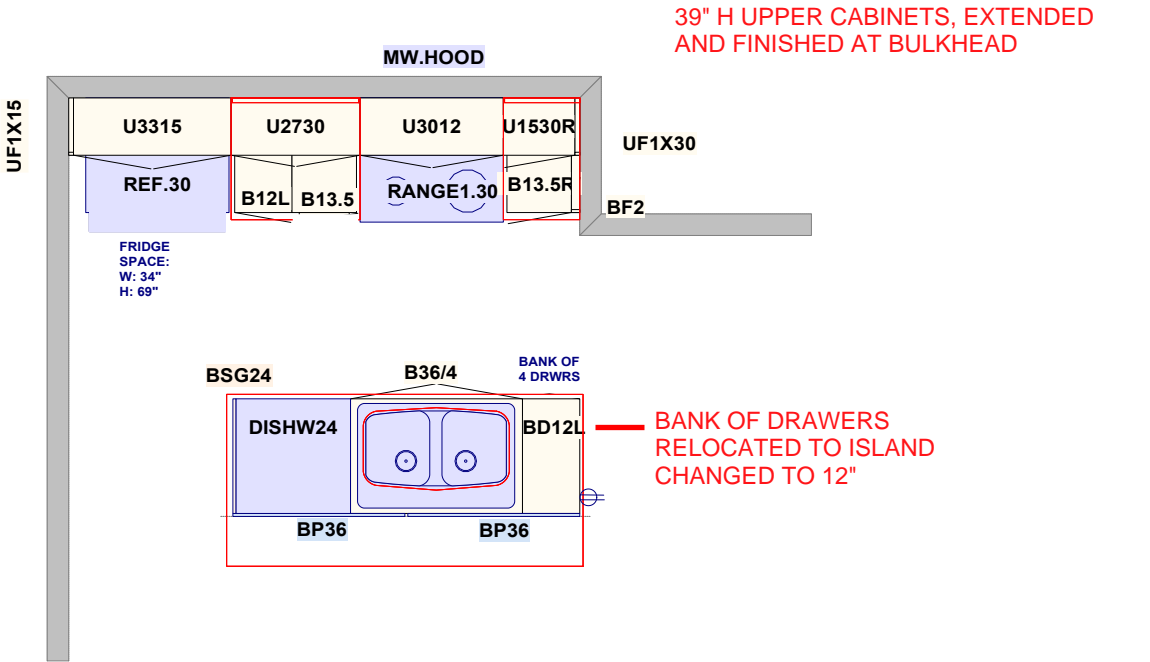


All dimensions .size designations  
given are subject to verification on  
job site and adjustment to fit job  
conditions.



This is an original design and must  
not be released or copied unless  
applicable fee has been paid or job  
order placed.

Designed: 9/30/2024  
Printed: 9/30/2024

Initial  
*VC*

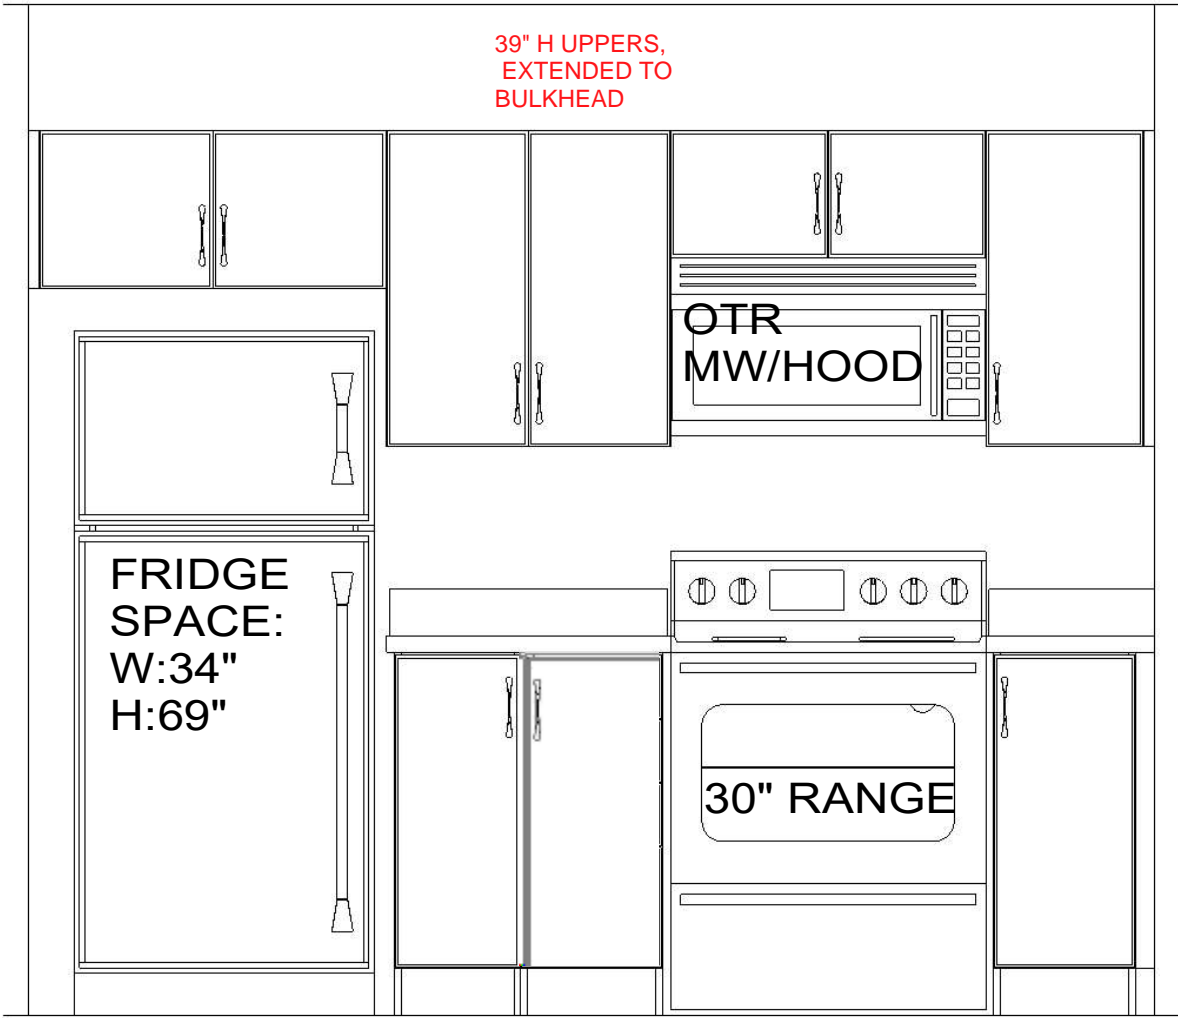

UPPER UNIT

FRIDGE/ RANGE WALL ELEVATION


All dimensions ,size designations given are subject to verification on job site and adjustment to fit job conditions.



This is an original design and must not be released or copied unless applicable fee has been paid or job order placed.

Designed: 9/30/2024  
Printed: 9/30/2024

Initial  
*KC*

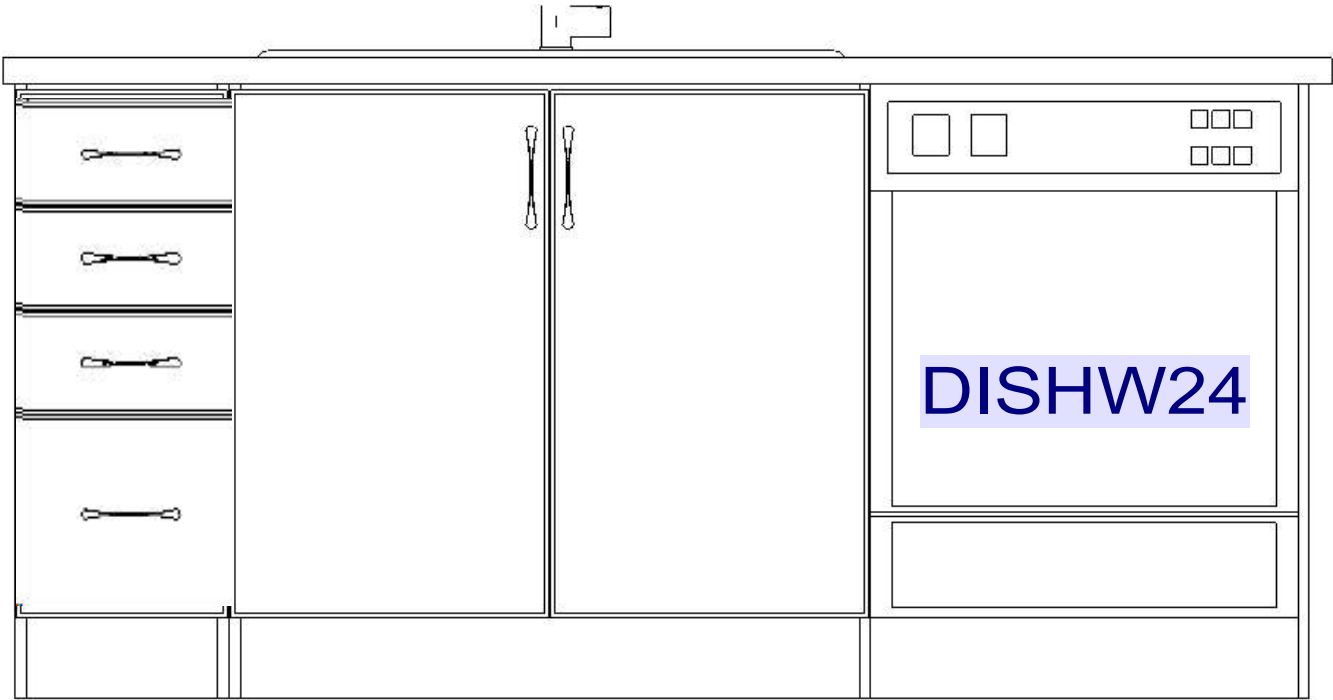


ISLAND ELEVATION

All dimensions ,size designations given are subject to verification on job site and adjustment to fit job conditions.




This is an original design and must not be released or copied unless applicable fee has been paid or job order placed.


Designed: 9/30/2024  
Printed: 9/30/2024  
Initial

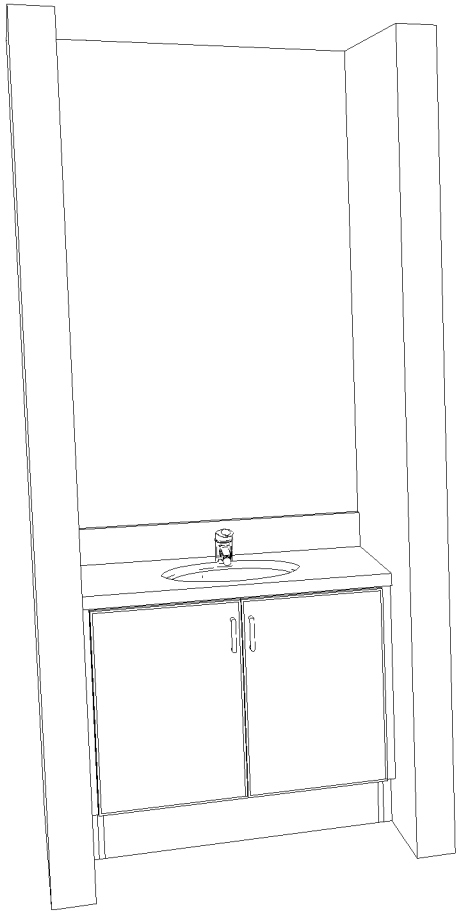

POWDER ROOM  
KITCHEN HEIGHT

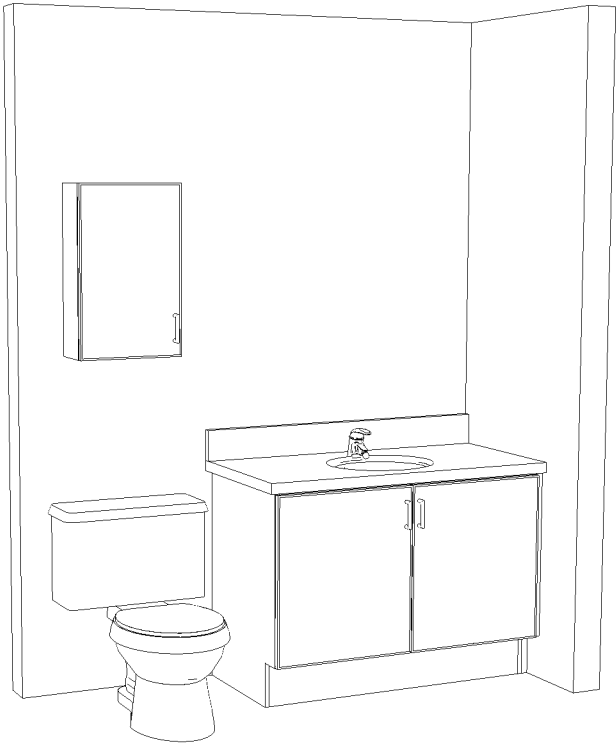

MAIN BATH  
KITCHEN HEIGHT

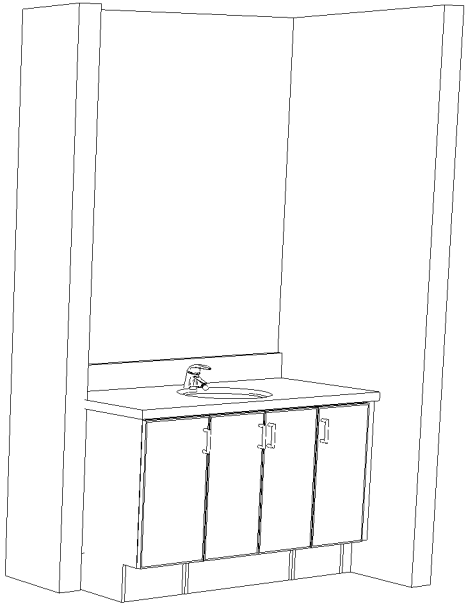

ENSUITE  
KITCHEN HEIGHT

UPPER UNIT - VANITIES - 3D VIEW

**CUSTOMER APPROVAL**

I have reviewed these drawings and understand the details of the design and the Cartier Kitchens specifications

Signature \_\_\_\_\_

Date \_\_\_\_\_

Note: This drawing is an artistic interpretation of the general appearance of the design. It is not meant to be an exact rendition.

SPECTRUM KITCHEN and BATH DESIGN

DCR - Terrace Homes - Upper unit



Designed: 2020-06-29  
Printed: 2020-08-09

Initial  
*KC*

All Drawing #: 1