


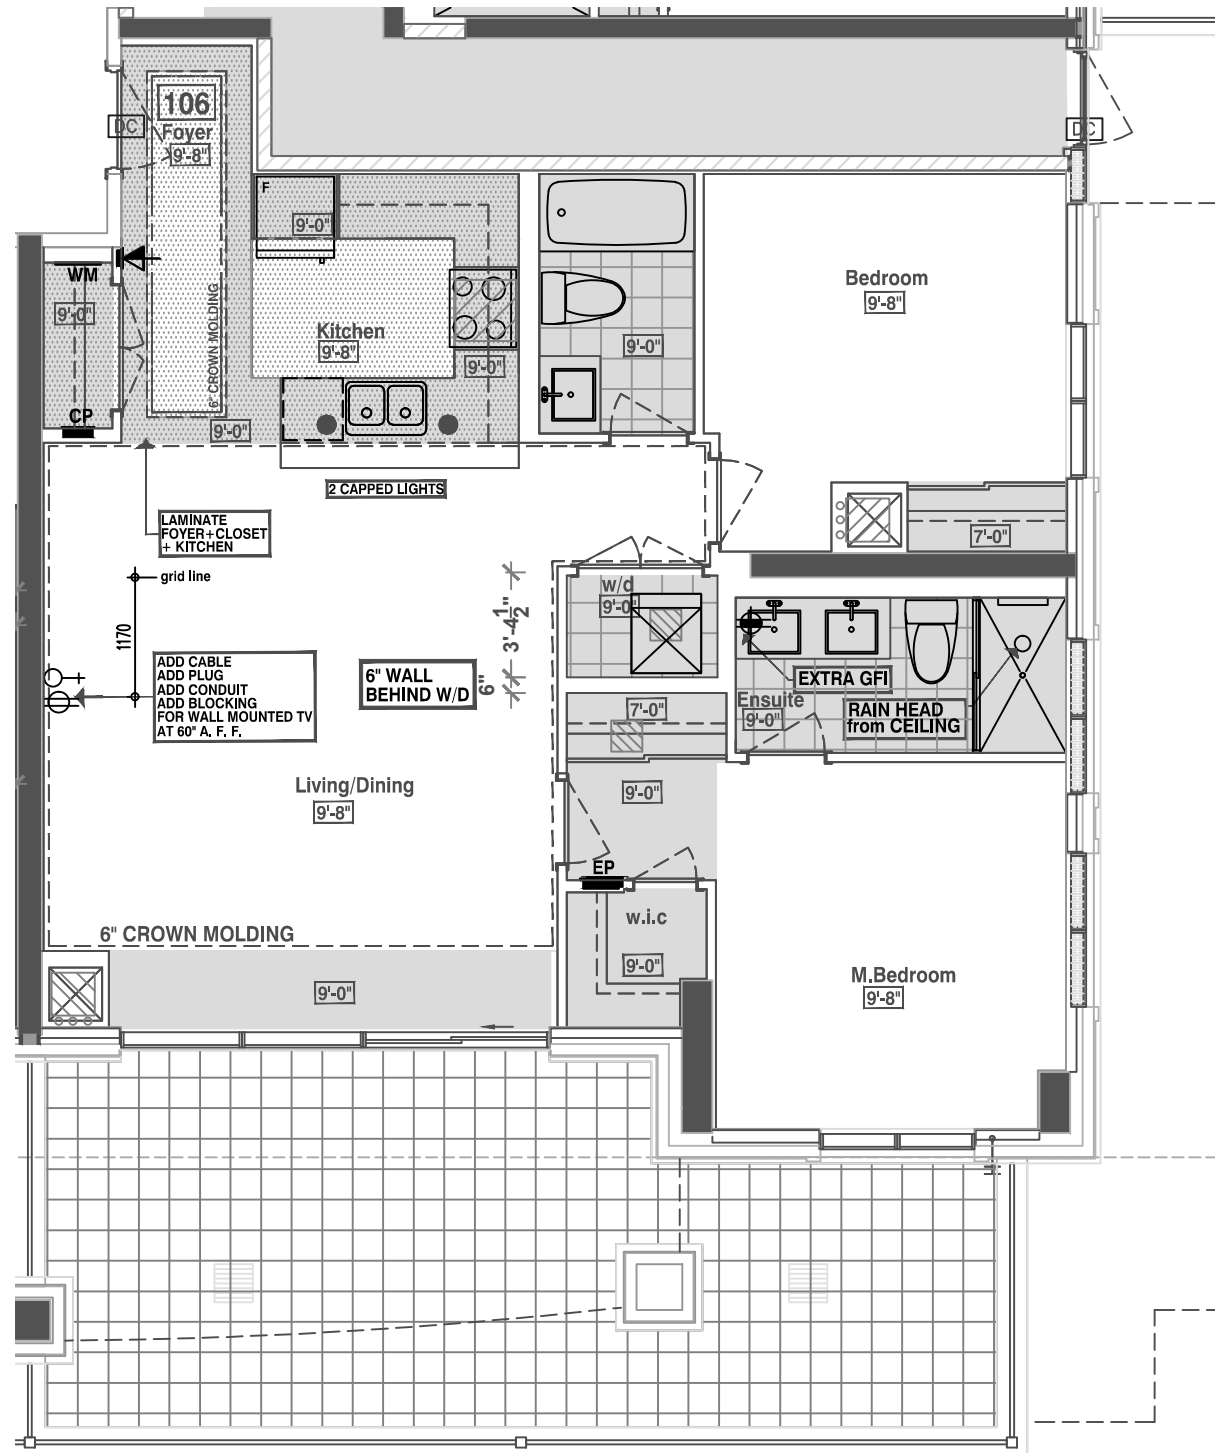

LEGEND:

- SECURITY PANEL
- ELECTRICAL PANEL
- COMMUNICATION PANEL
- WATER METER
- FRIDGE
- DROPPED AREA
- 6" CROWN MOLDING