


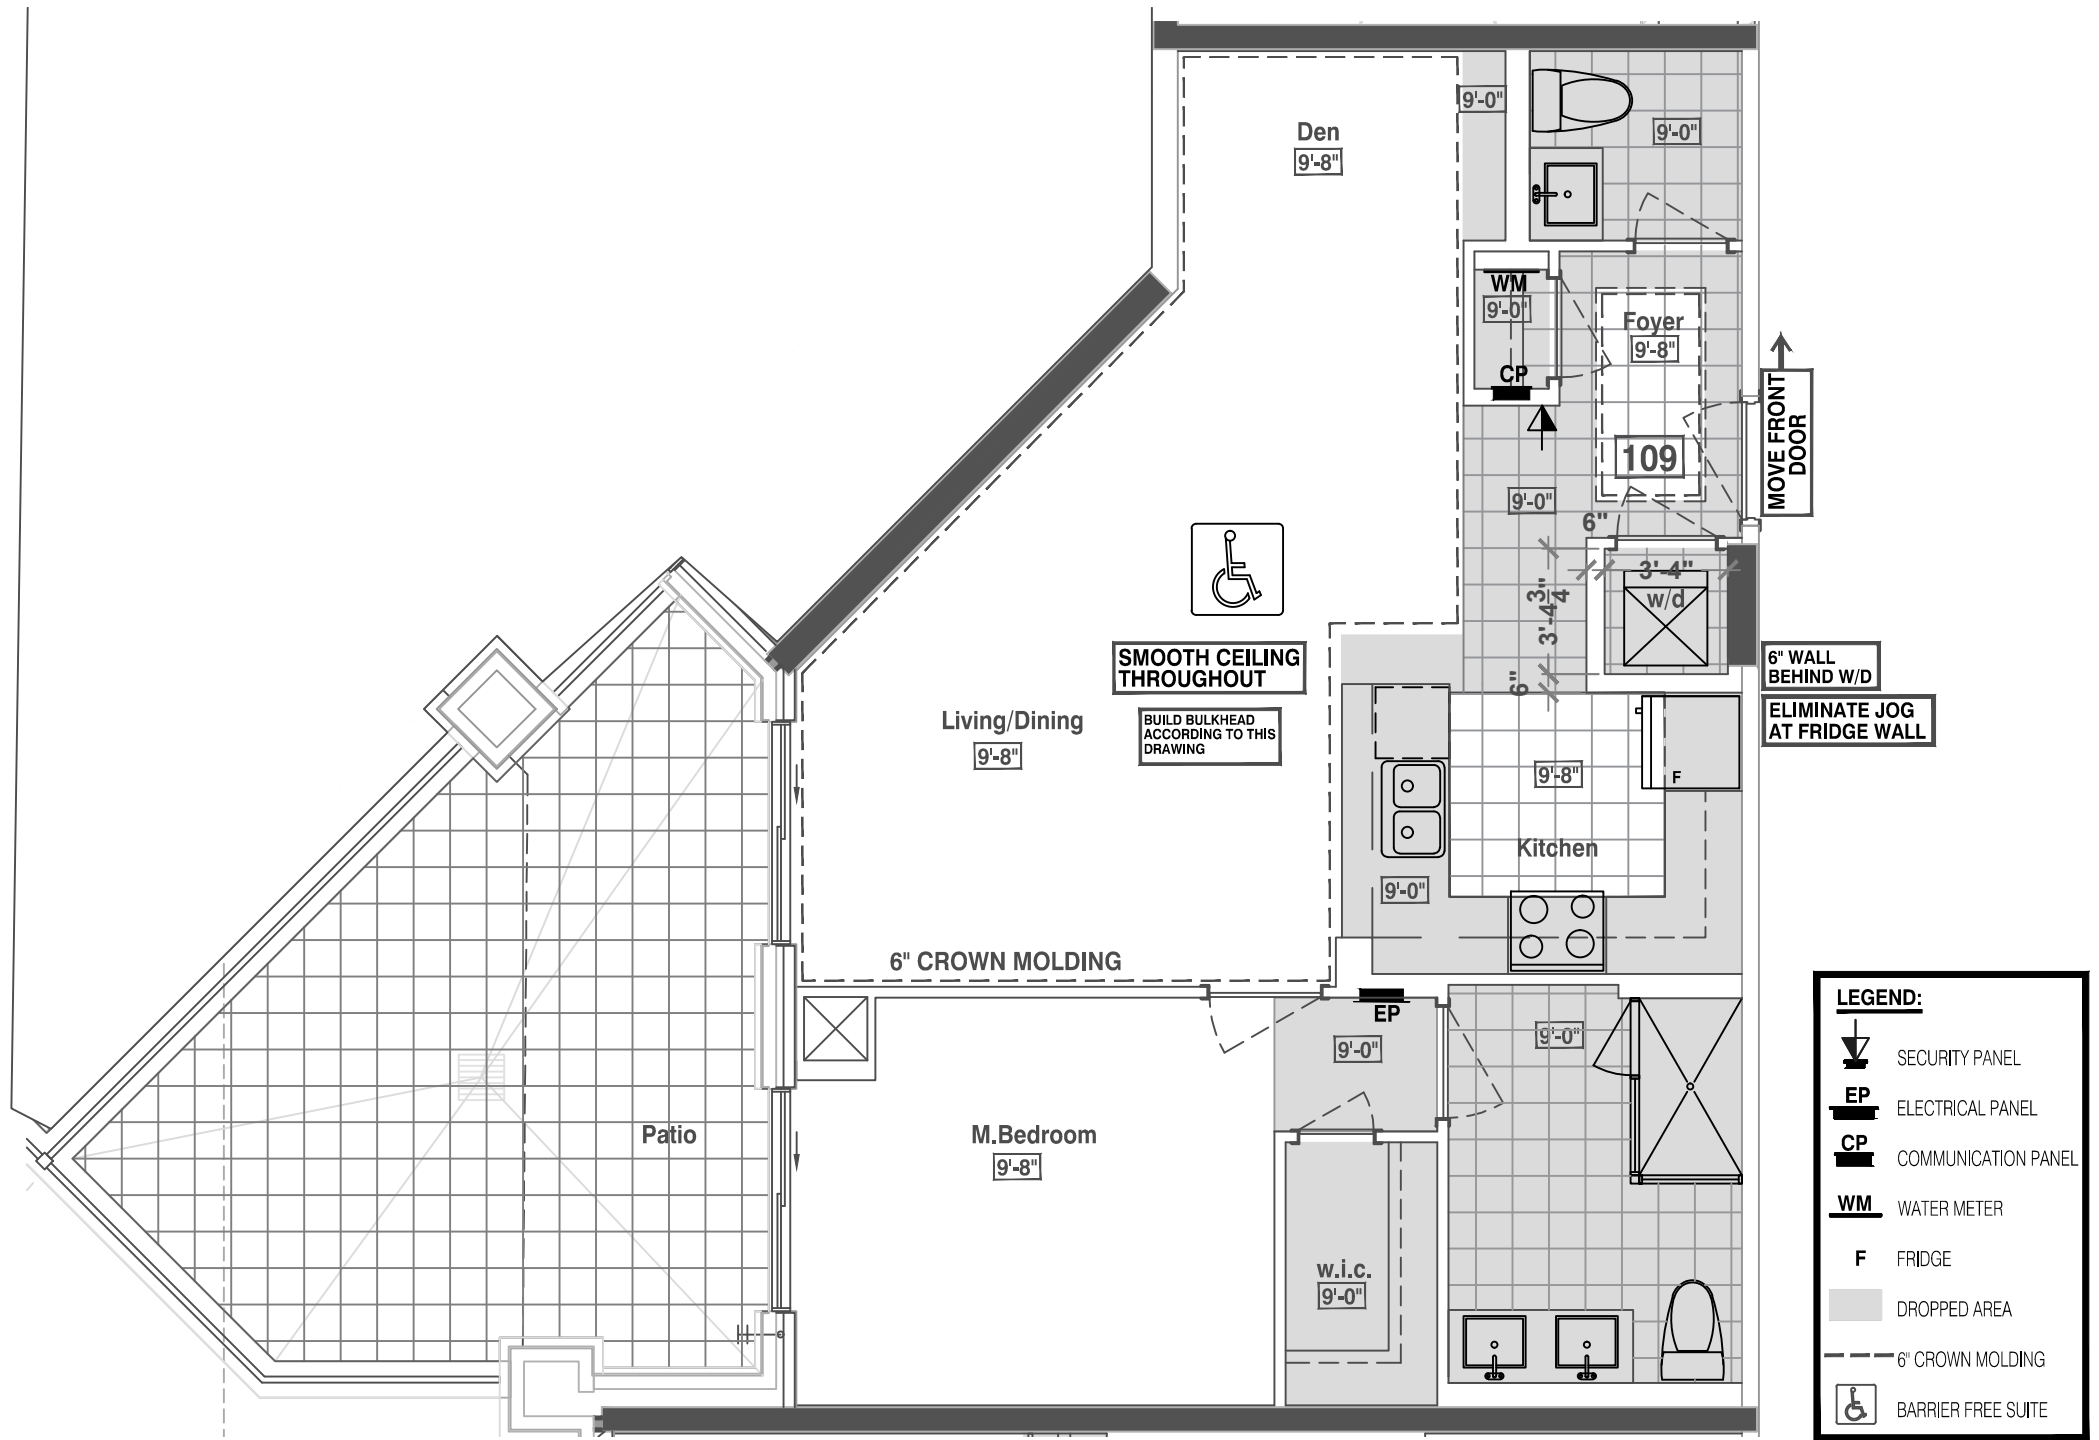

SUITE 109 – SAG HARBOUR – 1C + D – P
■ HAMPTON PLACE ■ 25 Baker Hill Blvd – Stouffville, ON ■ Jan 18, 2018

DRAWING AS PER AGREEMENT OF PURCHASE AND SALE (before decor appointment)