





Noyac Bay

1,121 SQ FT plus 81 sq. ft. of balcony area


Suite 211
Inventory

Suite.


ORIGINAL
Brochure

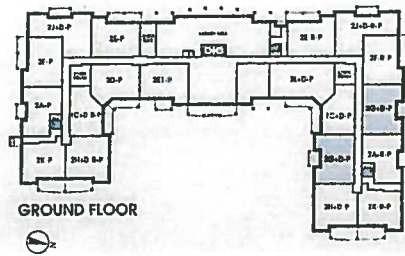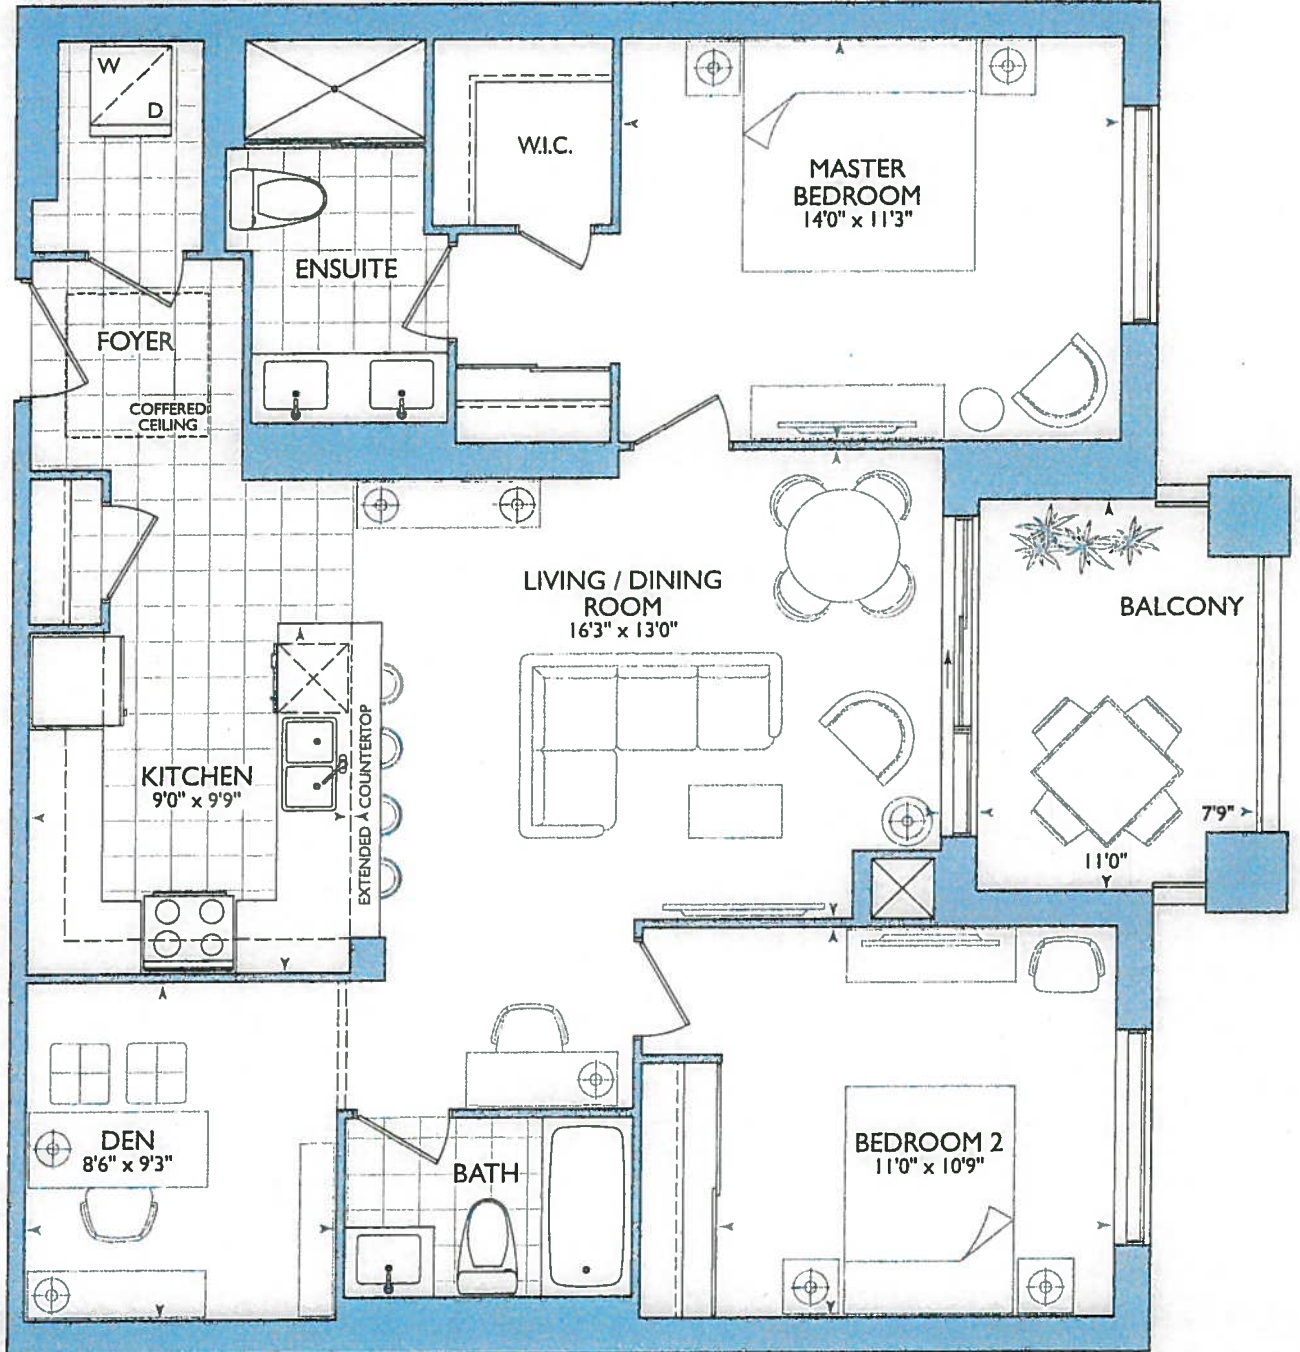

GROUND FLOOR

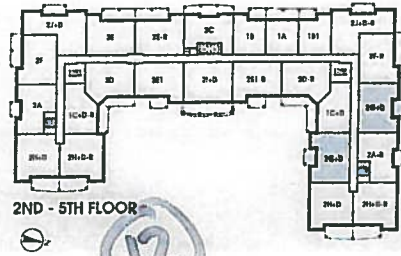

2ND - 5TH FLOOR

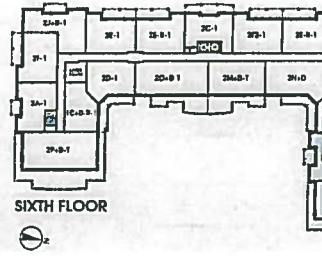

SIXTH FLOOR



Laundry Door Swing
Revised As Per This Brochure.

* ENSUITE WALL BACKING
ONTO LAUNDRY AND FOYER
REVISED AS PER
THIS LAYOUT

③ = Pung. Pennsylv. (STD)

- $(2x) = \text{Pendant Light (upg)}$
over Peninsula

- OPTION OF STANDARD OR UPG.#1 = APPLIANCE PACKAGE


(Inventory Suite)

SUITE 211 - NOVAC FV -

■ HAMPTON PLACE ■ 25 Baker Hill Bk

Uffville, ON - Jan 22, 2018

DRAWING AS PER AGREEMENT OF PU. CASE AND SALE (before decor appointment)

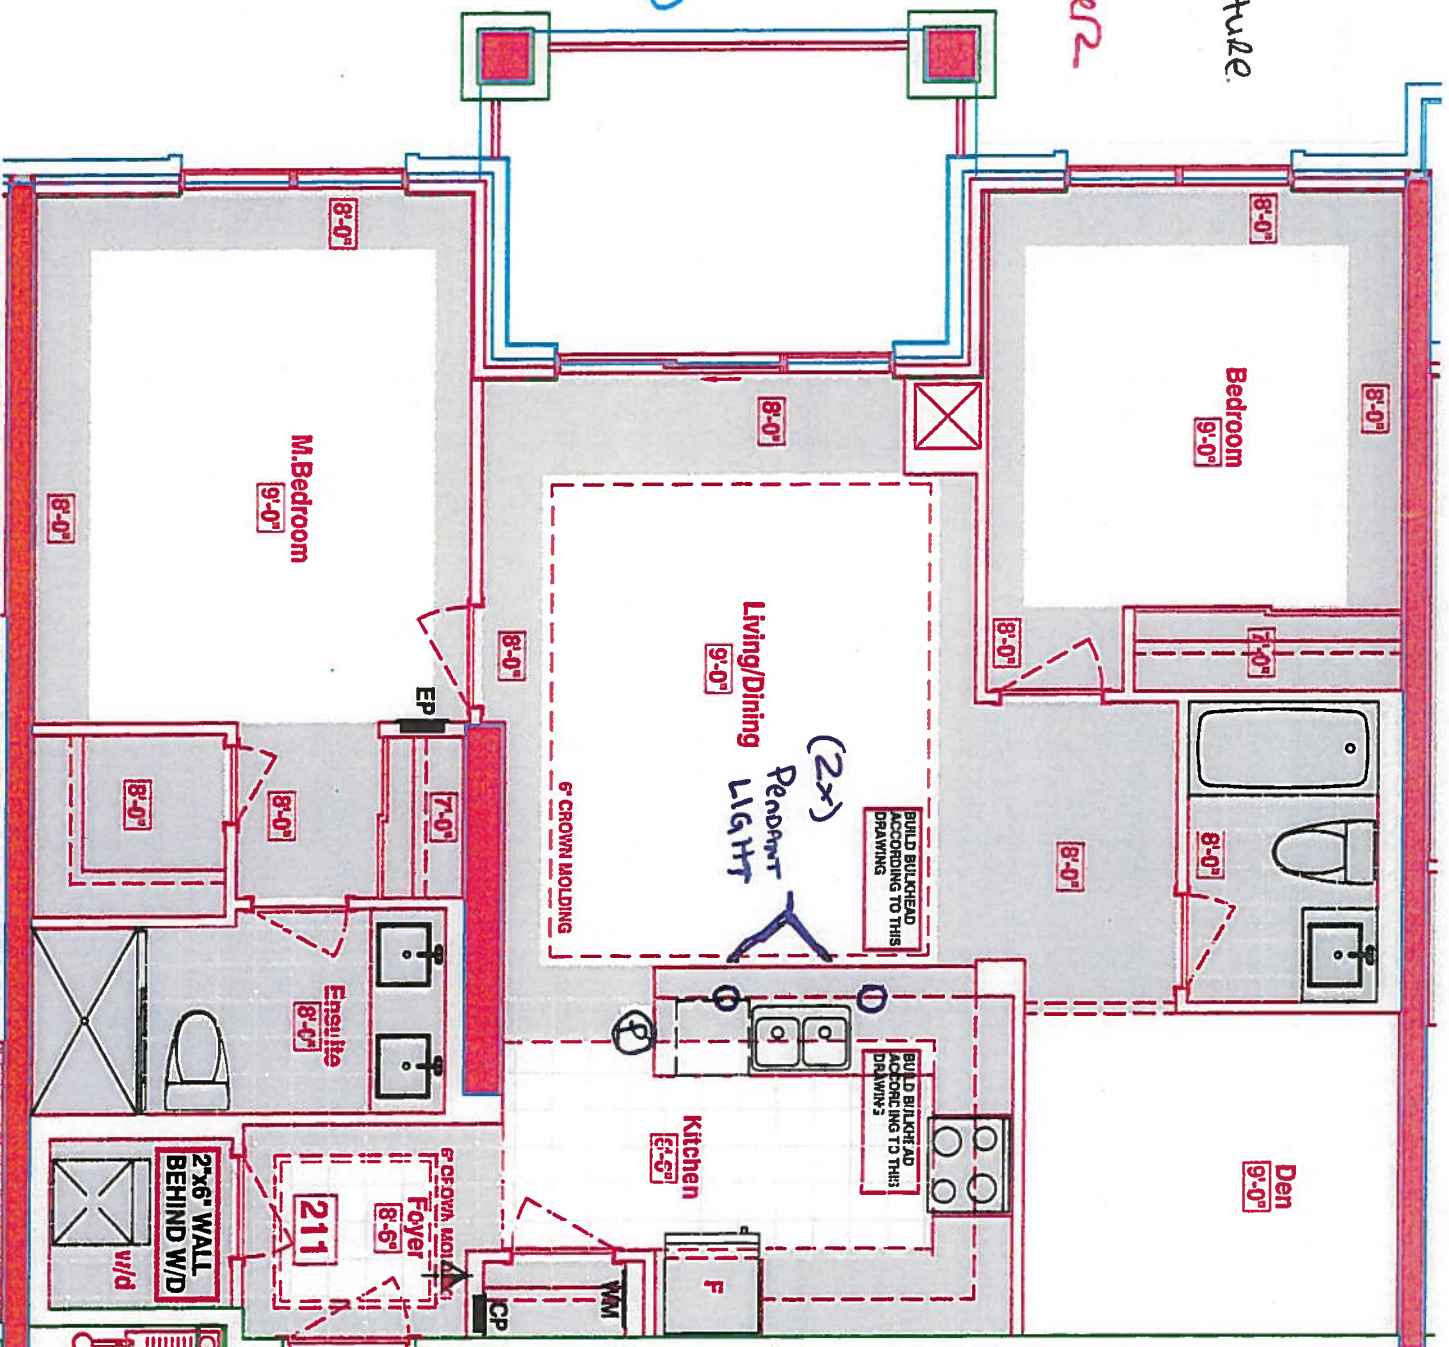

**6" WALL
BEHIND W/D**

**ELIMINATE JOG
AT FRIDGE WALL**

LEGEND:

 SECURITY PANEL

EP
ELECTRICAL PANEL

CP
COMMUNICATION PANEL


WMI WATER METER

F
FRIDGE
DROPPED AREA

6" CROWN MOLDING

INVENTORY SUITS

- Suite # 211- Kitchen LAYOUT
- STD APPLIANCE PACKAGE
- (2x) = PENDANT LIGHTS OVER PENINSULA
- (P) = PLUG PENINSULA

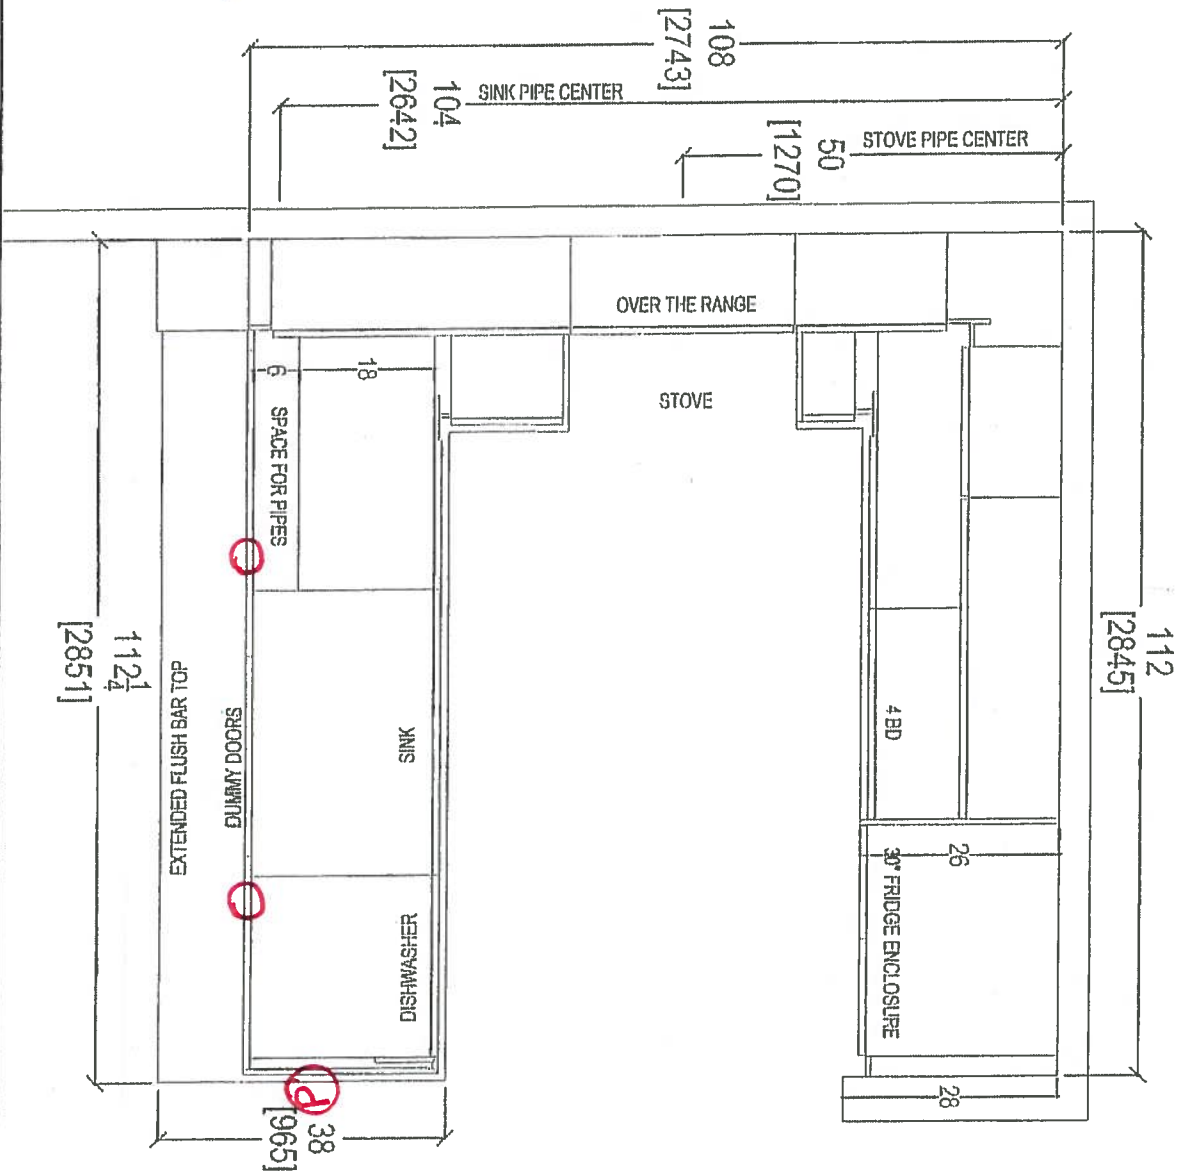

RECEIVED
AUG 17 2017



80 SANTE DRIVE, VAUGHAN, ON L4K 3C4
T. 416.748.1515

CLIENT: ROYAL PINE HOMES

JOB NAME: 2G+D

ROOM: KITCHEN FLOOR PLAN

DRAWN BY: SK

SITE: HAMPTON PLACE

DOOR STYLE: —

DOOR HANDLE: —

SCALE: 1/2" = 1'-0"

PHONE: —

FINISH: —

DRW HANDLE: —

DATE: AUG 4, 2017


EMAIL: —

SPECIES: —

TOP: —

PAGE: —

COMMENTS:
PLEASE NOTE ALL DIMENSIONS
ARE NOT FINAL AND ARE
SUBJECT TO CHANGE UPON
FINAL SITE MEASURE

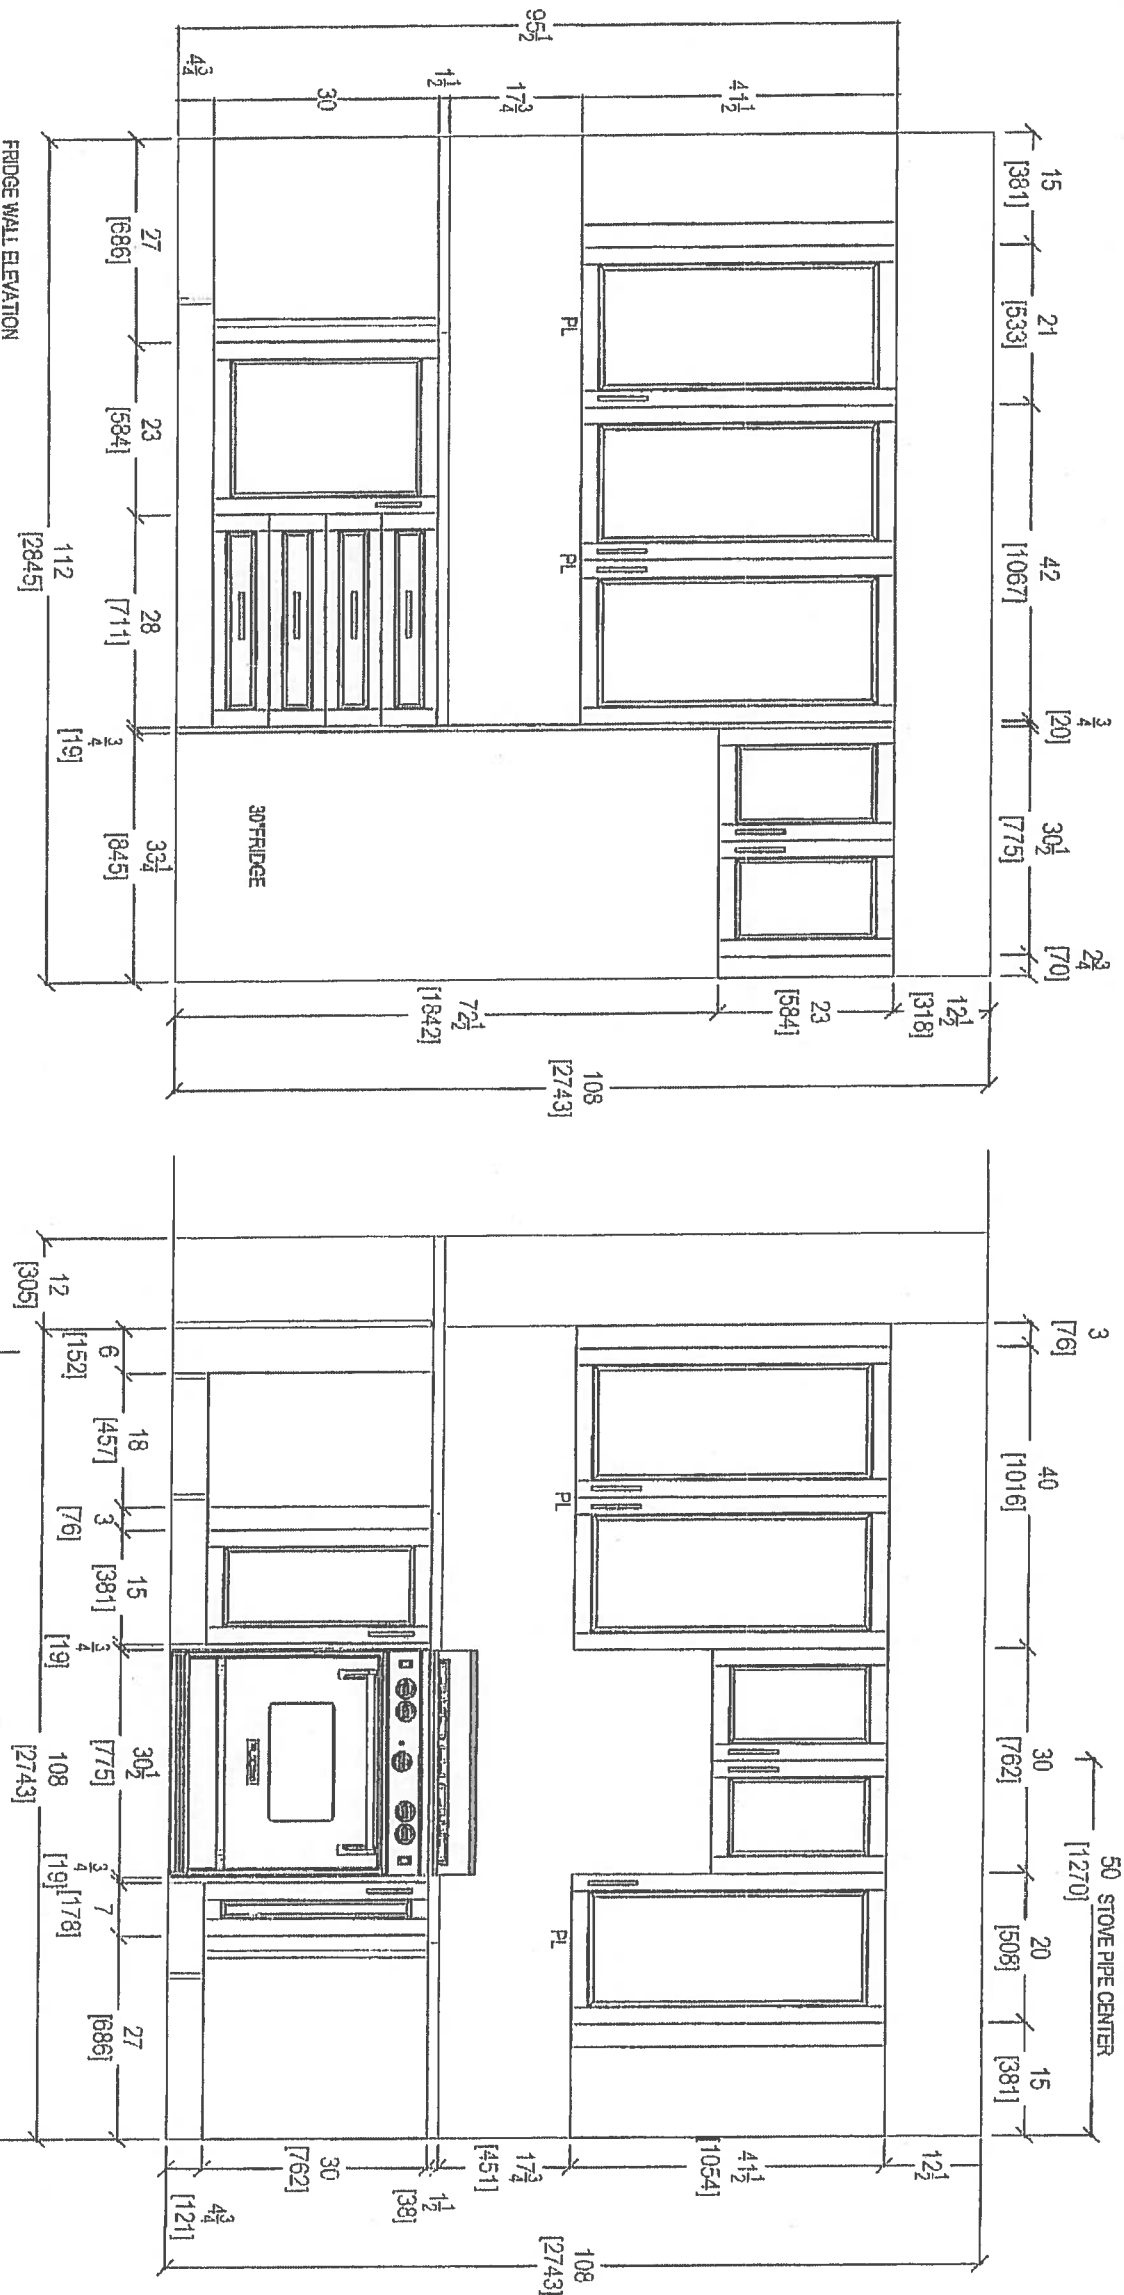

RECEIVED
11/26/17

CLIENT: ROYAL PINE HOMES	JOB NAME: 2G+ D	ROOM: KITCHEN	DRAWN BY: SK	COMMENTS
--------------------------	-----------------	---------------	--------------	----------



SITE: HAMPTON PLACE	DOOR STYLE: —	DOOR HANDLE: —	SCALE: 1/2" = 1' - 0"	PLEASE NOTE ALL DIMENSIONS
---------------------	---------------	----------------	-----------------------	----------------------------

PHONE: —	FINISH: —	DRW HANDLE: —	DATE: AUG 4, 2017
----------	-----------	---------------	-------------------

EMAIL: —	SPECIES: —	TOP: —	PAGE: —
----------	------------	--------	---------



80 SANTE DRIVE, VALENTIA, ON L4K 3C4,
T: 416.746.1871

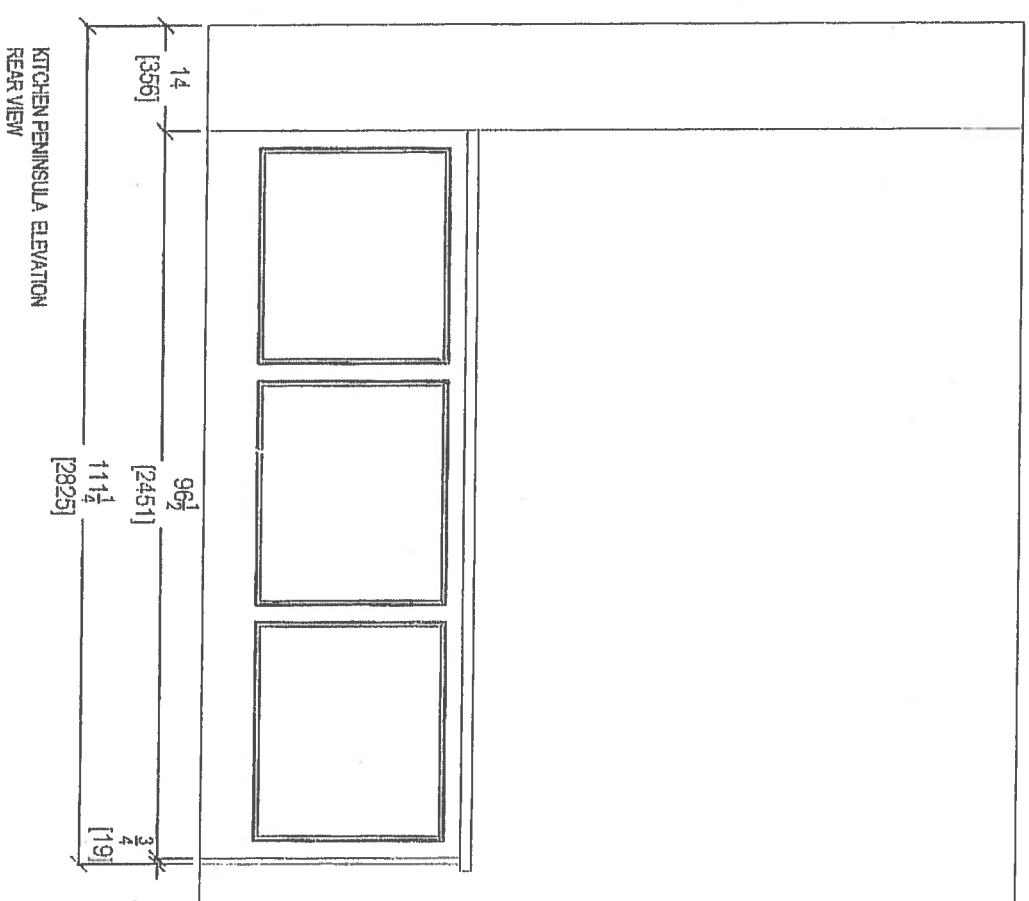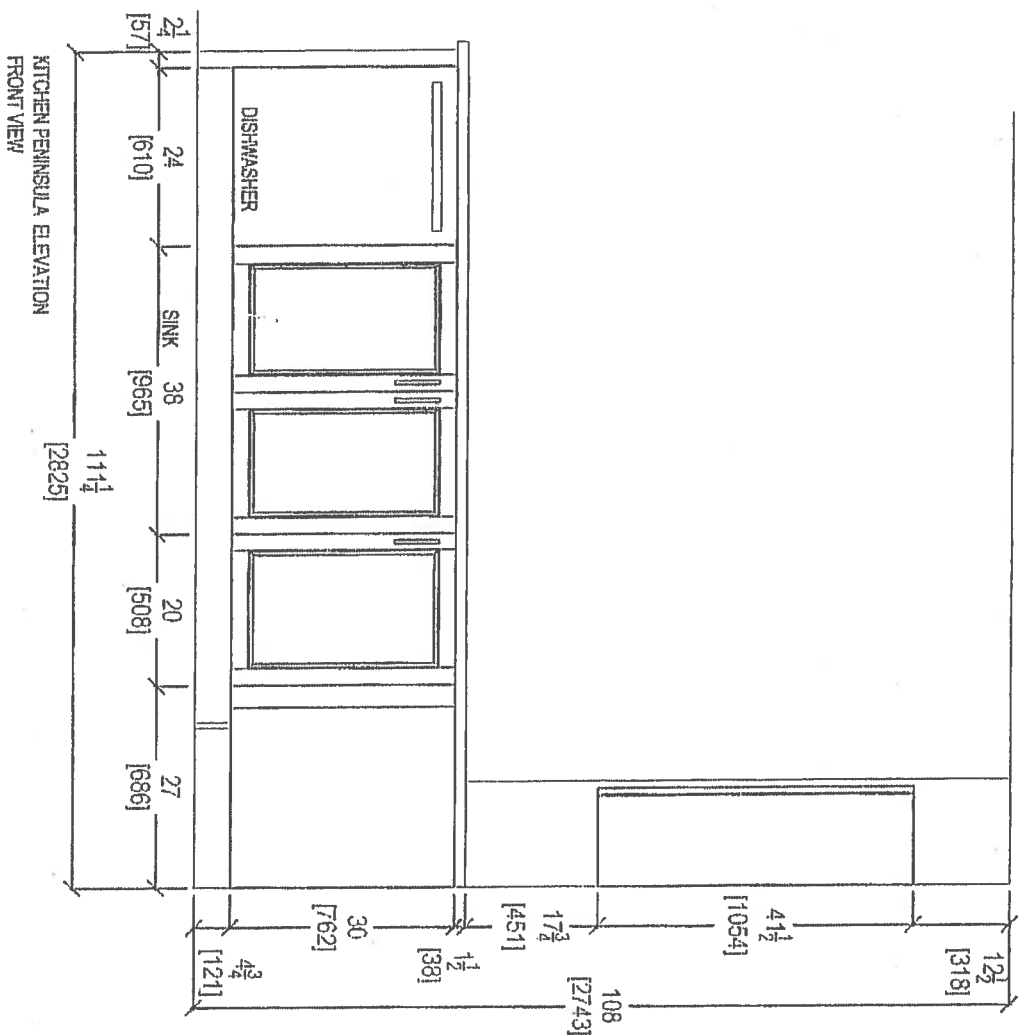





RECEIVED
R. G. G. (17)

CLIENT: ROYAL PINE HOMES	JOB NAME: 2G+D	ROOM: KITCHEN	DRAWN BY: SK
SITE: HAMPTON PLACE	DOOR STYLE: —	DOOR HANDLE: —	SCALE: 1/2" = 1'-0"
PHONE: —	FINISH: —	DRW HANDLE: —	DATE: AUG 4, 2017
EMAIL: —	SPECIES: —	TOP: —	PAGE: —

COMMENTS:

your kitchen, not ours.
80 SANTE DRIVE, VAUGHAN, ON L4K 3C4
T. 416.746.1816

PLEASE NOTE ALL DIMENSIONS
ARE NOT FINAL AND ARE
SUBJECT TO CHANGE UPON
FINAL SITE MEASURE

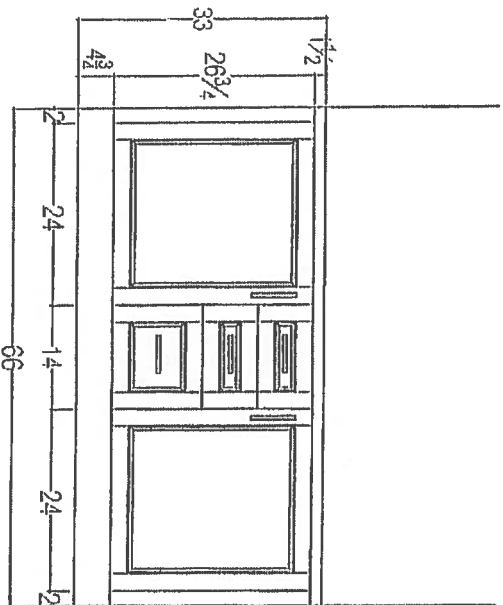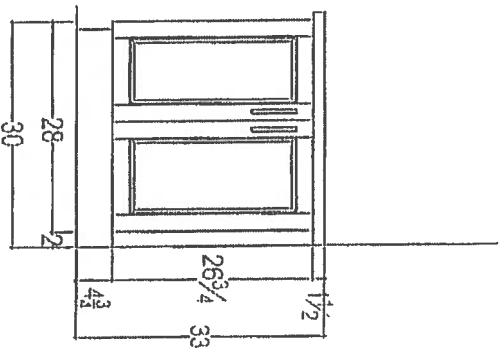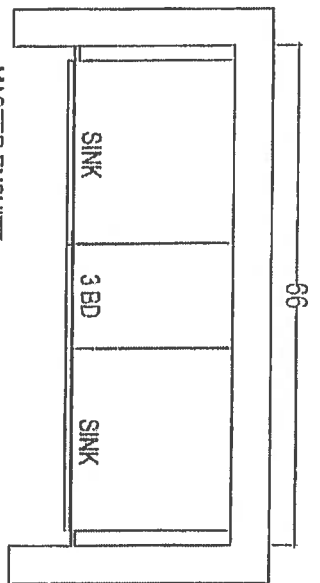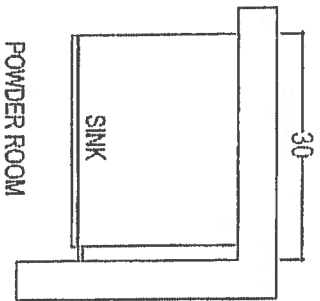

CLIENT: ROYAL FINE HOMES	JOB NAME: 2G+ D	ROOM: VANITIES	DRAWN BY: SK
SITE: HAMPTON PLACE	DOOR STYLE: —	DOOR HANDLE: —	SCALE: 1/2" = 1'-0"
PHONE: —	FINISH: —	DRW HANDLE: —	DATE: AUG 4, 2017
EMAIL: —	SPECIES: —	TOP: —	PAGE: —

RECEIVED
RSC 6/17

PLEASE NOTE ALL DIMENSIONS
ARE NOT FINAL AND ARE
SUBJECT TO CHANGE UPON
FINAL SITE MEASURE



80 SANTE DRIVE, VAUGHAN, ON L4K 3C4,
T: 416.746.1811

Inventory Suite


Suite #211- Kitchen LAYOUT

with - upgrade #1 - Appliance

PACKAGE

(2x) = PENDANT LIGHTS OVER Peninsula

(P) = PLUG Peninsula

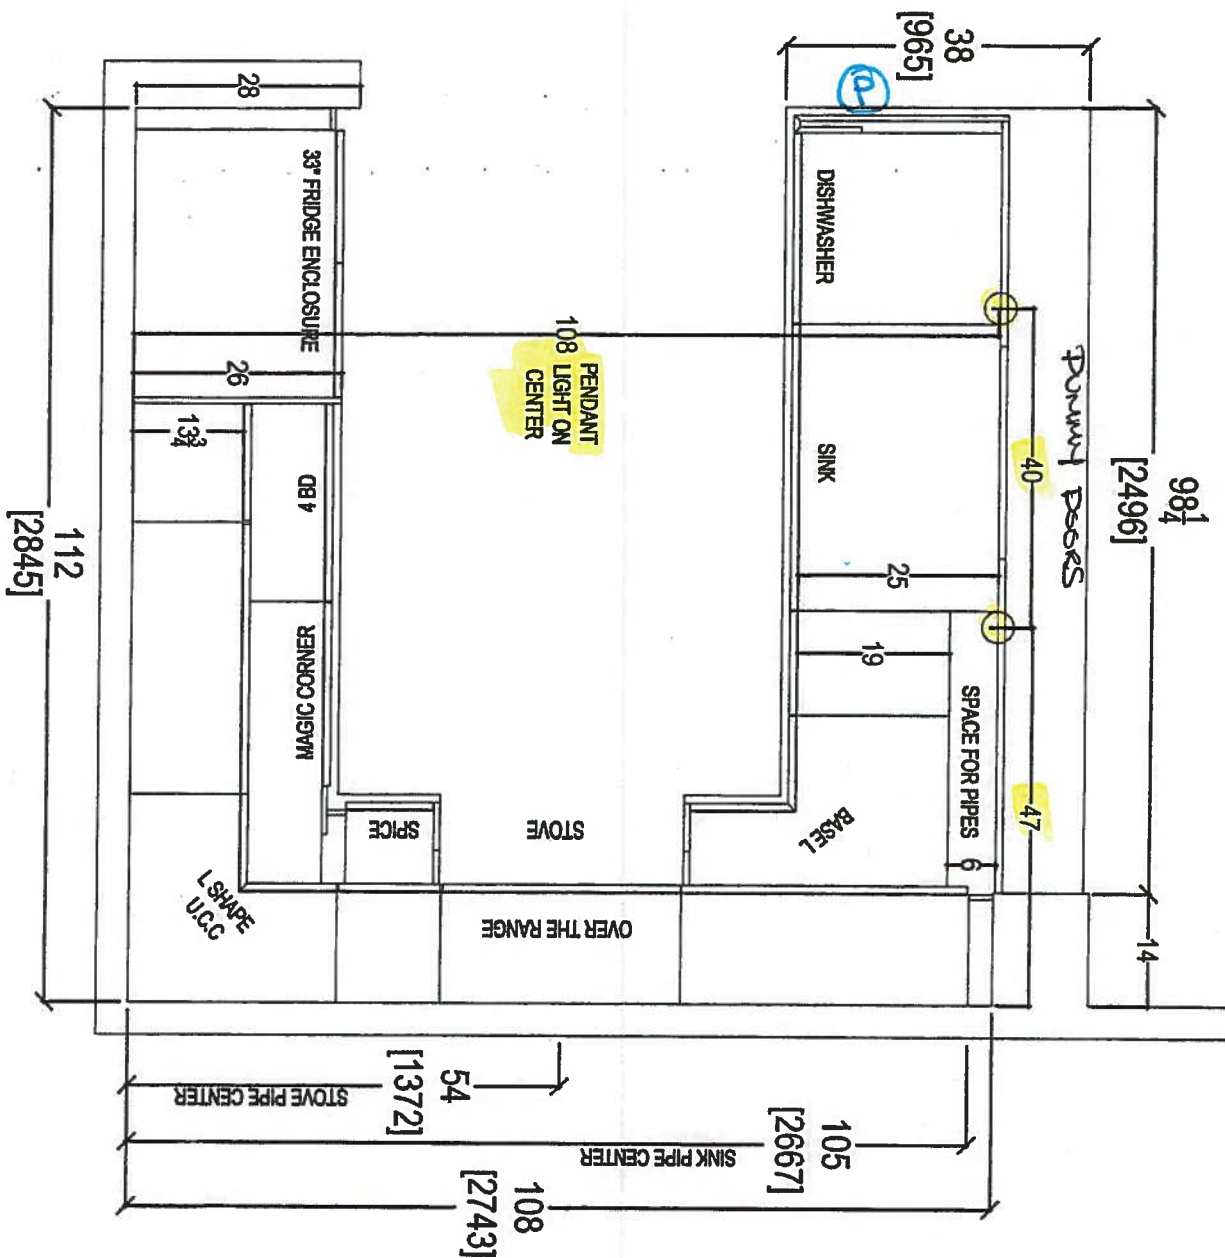

80 SANTE DRIVE, VAUGHAN, ONT. L4H 1P3
T: 416.746.1811 F: 416.746.1812
KSCA, 401


CLIENT: ROYAL PINE HOMES
SITE: HAMPTON PLACE
PHONE: ---
EMAIL: ---

UNIT 211 HMP
DOOR STYLE: ---
FINISH: ---
SPECIES: ---

ROOM: KITCHEN FLOOR PLAN
DOOR HANDLE: ---
DRAW HANDLE: ---
TOP: ---


DRAWN BY: SK
SCALE: 1/2" = 1'-0"
DATE: JAN 28, 2018
PAGE: ---

COMMENTS:
PLEASE NOTE ALL DIMENSIONS
ARE NOT FINAL AND ARE
SUBJECT TO CHANGE UPON
FINAL SITE MEASURE

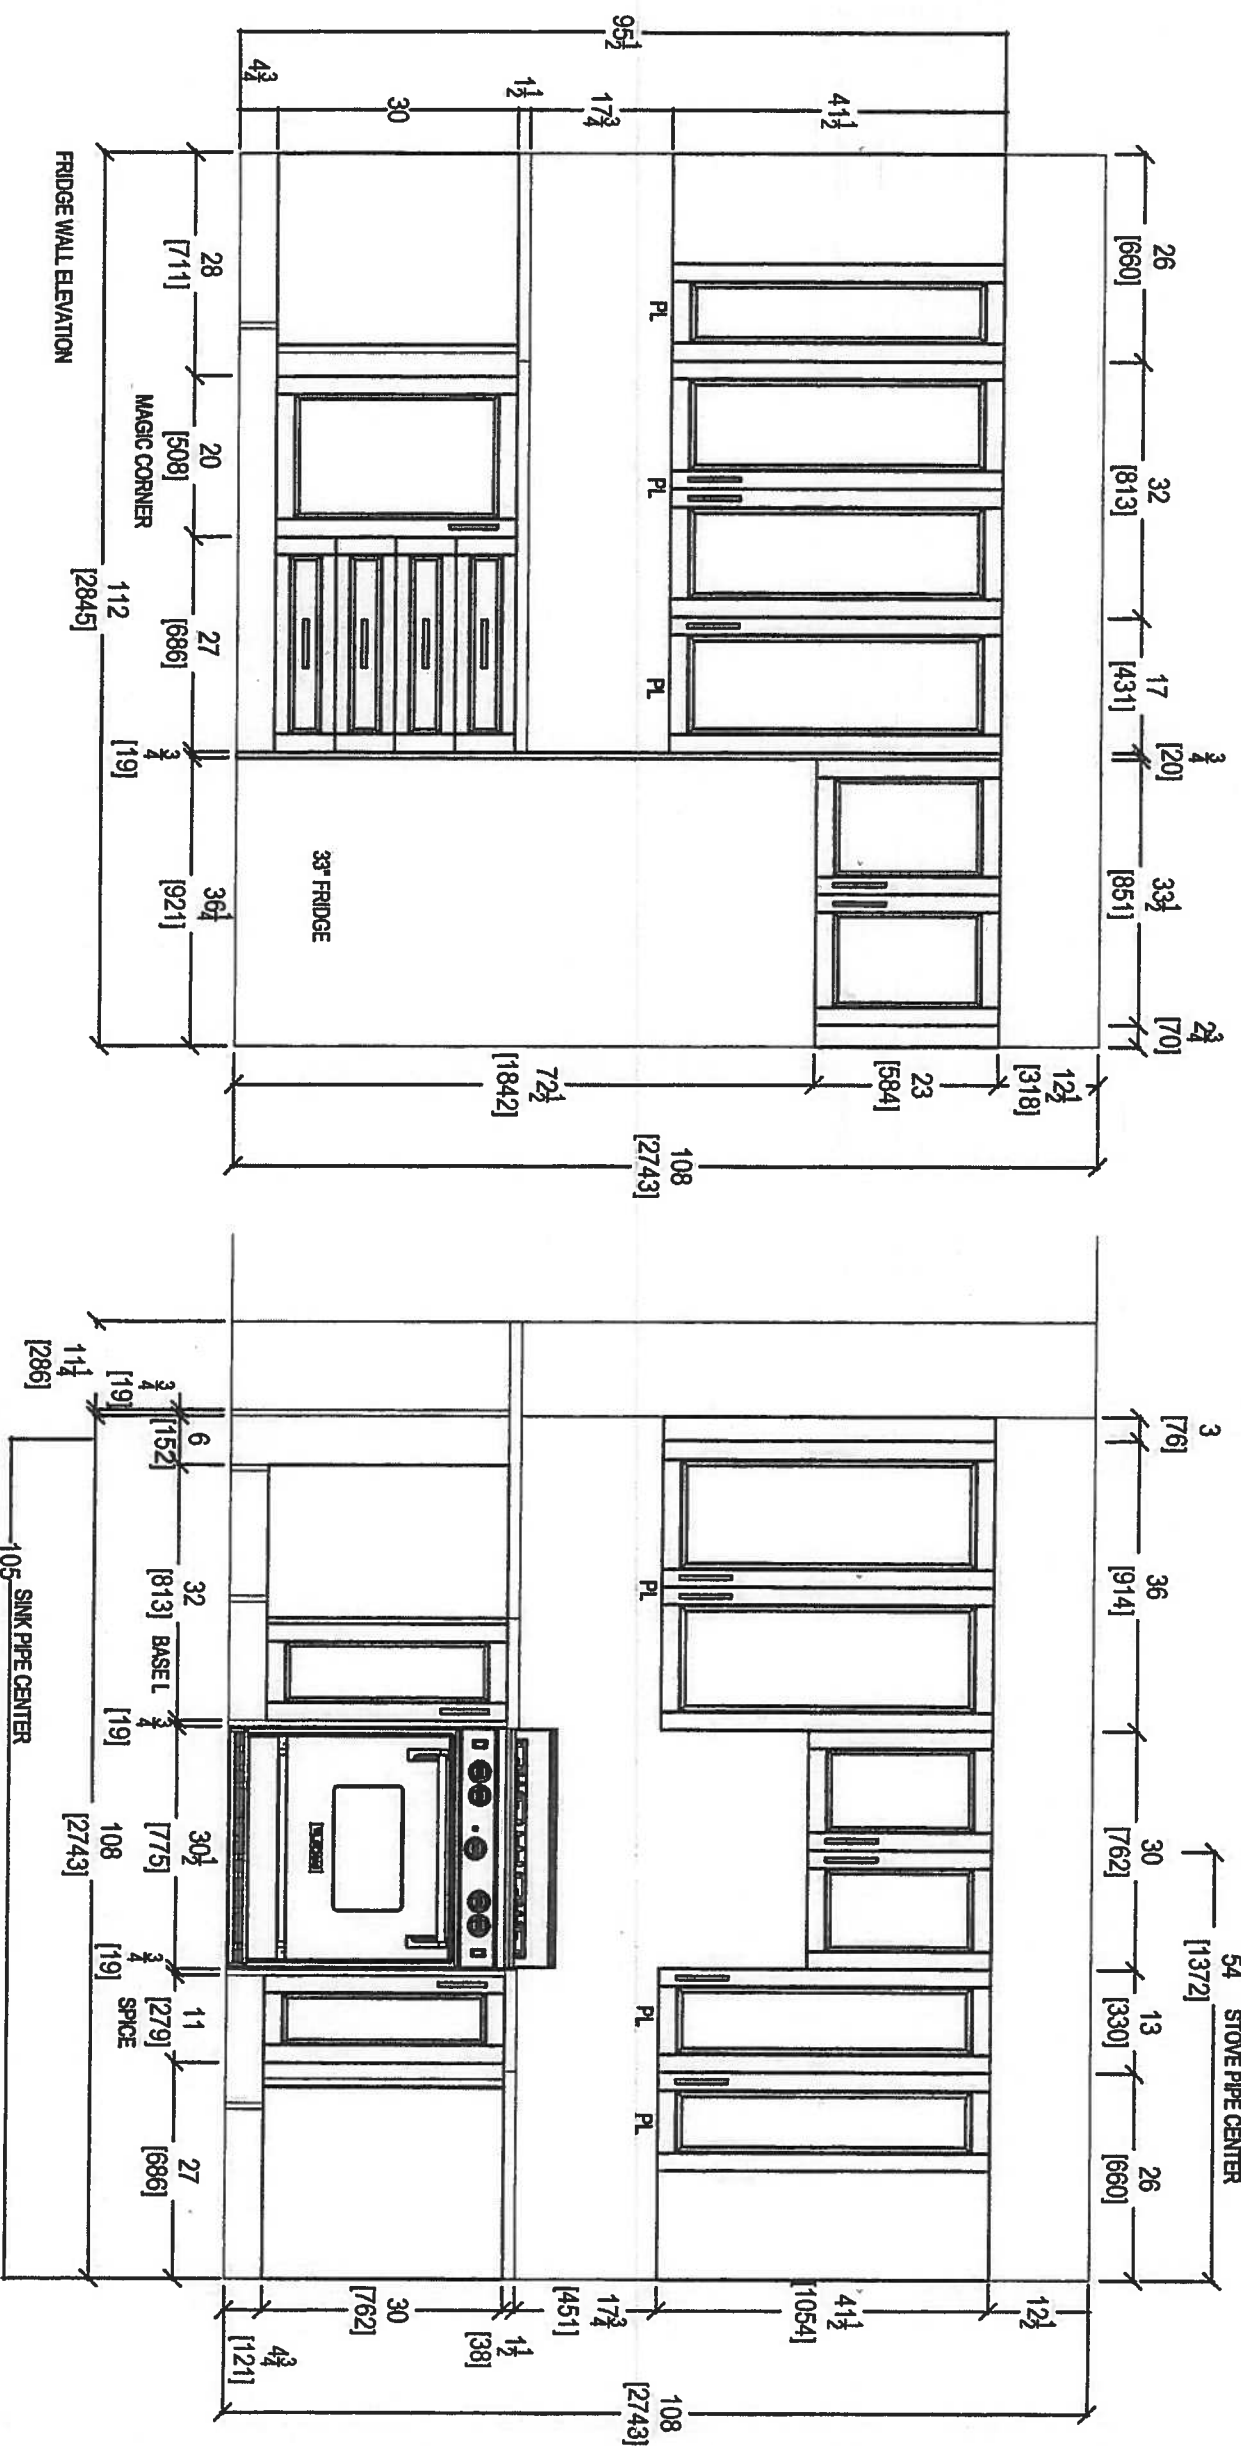


80 SANTE DRIVE, VAUGHAN, ONTARIO
T: 416.746.1811 F: 905.746.1811

CLIENT: ROYAL PINE HOMES		UNIT 211 HAMP		ROOM: KITCHEN		DRAWN BY: SK		COMMENTS: PLEASE NOTE ALL DIMENSIONS ARE NOT FINAL AND ARE SUBJECT TO CHANGE UPON FINAL SITE MEASURE
SITE: HAMPTON PLACE		DOOR STYLE: —		DOOR HANDLE: —		SCALE: 1/2" = 1'-0"		
PHONE: —		FINISH: —		DRW HANDLE: —		DATE: JAN 28, 2018		
EMAIL: —		SPECIES: —		TOP: —		PAGE: —		

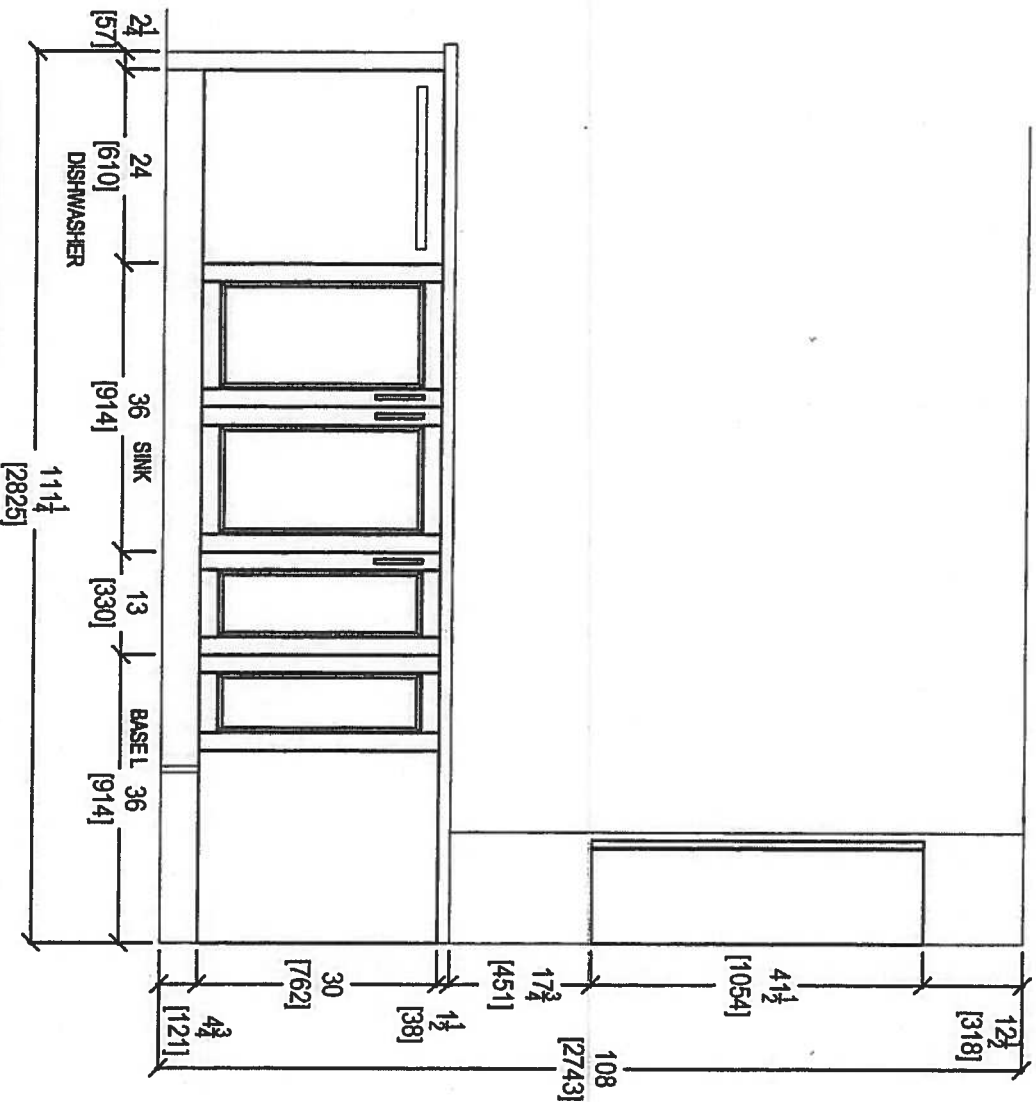

KITCHEN PENINSULA ELEVATION
FRONT VIEW

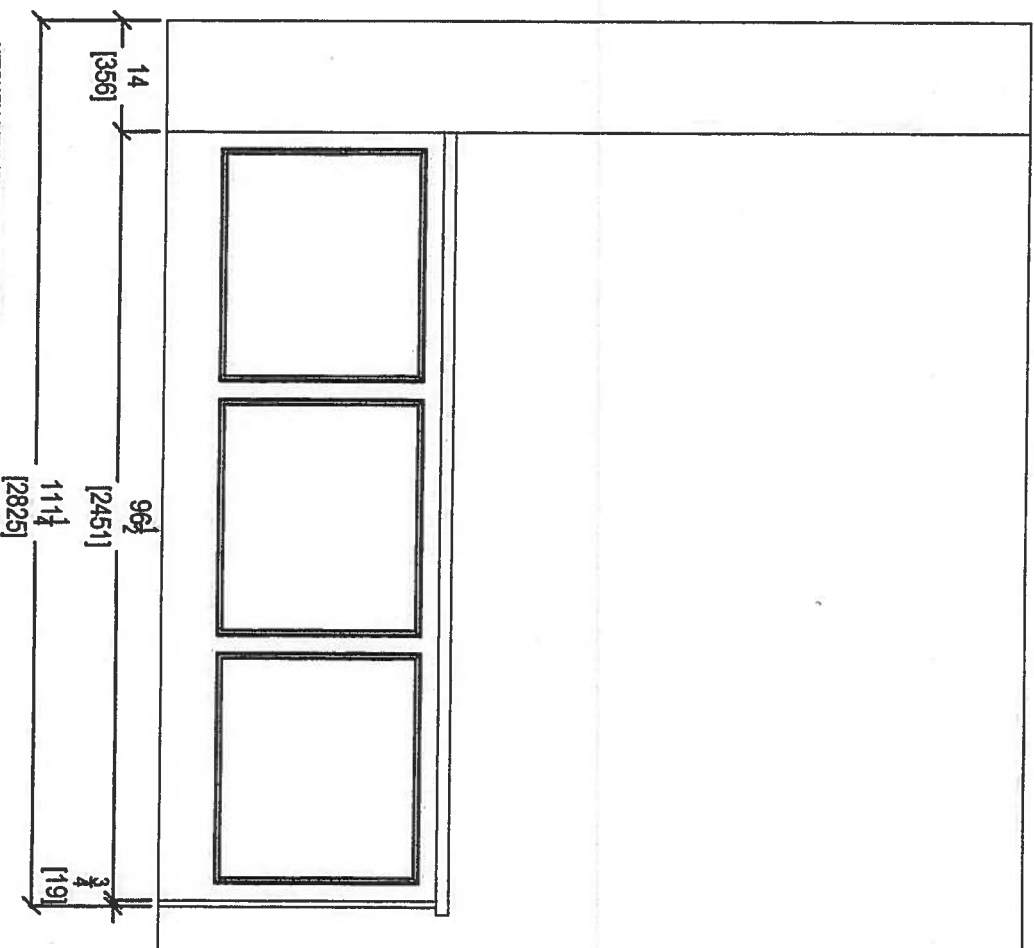

KITCHEN PENINSULA ELEVATION
REAR VIEW

CLIENT: ROYAL PINE HOMES

UNIT 211 HMP

ROOM: KITCHEN

COMMENTS:

SITE: HAMPTON PLACE

DOOR STYLE: —

DOOR HANDLE: —

SCALE: 1/2" = 1'-0"

PHONE: —

FINISH: —

DRW HANDLE: —

DATE: JAN 28, 2018

EMAIL: —

SPECIES: —


TOP: —

PAGE: —




80 SANTE DRIVE, VAUGHAN
T: 416.746.1811 F: 905.746.1811



PLEASE NOTE ALL DIMENSIONS
ARE NOT FINAL AND ARE
SUBJECT TO CHANGE UPON
FINAL SITE MEASURE

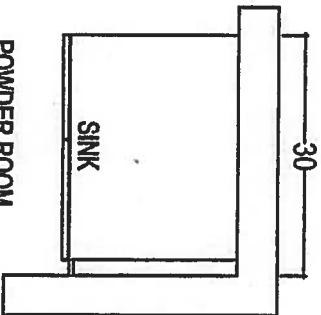

POWDER ROOM

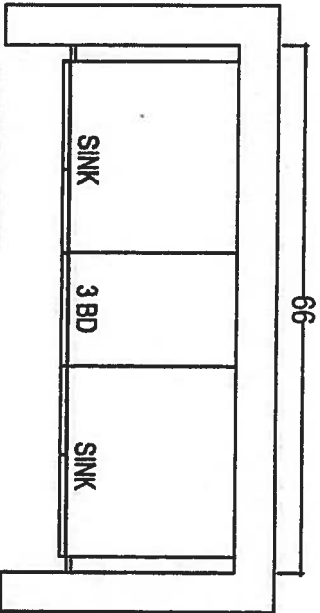

MASTER ENSUITE

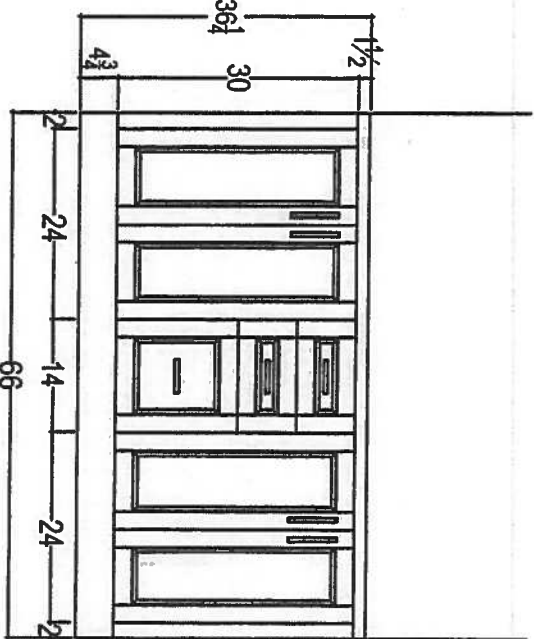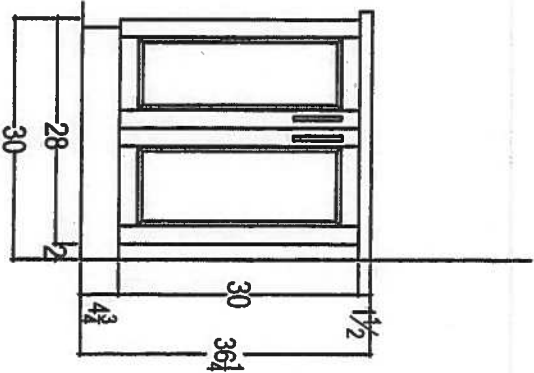

CLIENT: ROYAL PINE HOMES		UNIT 211 HMP		ROOM: VANITIES		DRAWN BY: SK	
SITE: HAMPTON PLACE		DOOR STYLE: --		DOOR HANDLE: --		SCALE: 1/2" = 1' - 0"	
PHONE: --		FINISH: --		DRW HANDLE: --		DATE: JAN 28, 2018	
EMAIL: --		SPECIES: --		TOP: --		PAGE: --	

COMMENTS:

PLEASE NOTE ALL DIMENSIONS ARE NOT FINAL AND ARE SUBJECT TO CHANGE UPON FINAL SITE MEASURE



304,
J1
Your kitchen, our
80 SANTE DRIVE, VAUGHAN
T: 416.746.1811 F: 80.