
SITE INSTRUCTION # 9**Project Name: Hampton Manor (25 Baker Hill Boulevard) - Stouffville****Project Number: 20140490****Vince Staffieri****February 16, 2018****Royal Pine Homes****3550 Langstaff Road, Suite 200****Woodbridge, Ontario L4L 9G3****via email: vince@royalpinehomes.com**

Distribution: Owner []; Contractor []; Consultant A []; M []; E []; L []; Other

-
1. Site instructions are issued only for the purpose of recording any clarification or interpretation of the contract documents or giving direction on problems resulting from field conditions.
 2. These instructions are subject to the provisions of the contract documents and unless stated herein and specifically co-authorized by the Client, will not affect the contract.
 3. Should the Contractor require a change in the contract price or project schedule, he shall submit an itemized proposal to the Architect within 14 calendar days of the date hereof.
 4. If the proposal is accepted by the Client, this site instruction will be superseded by a Change Order.
-

A. REFERENCE:

- .1 Drawings S1-02 and S1-05.

B. INSTRUCTION:

- .1 Follow Section GF11/S5-01 for detailing of slab reinforcement at location noted on Drawing S1-02.

C. REASON:

- .1 To suit slope of garage roof slab.

Yours very truly,
STEPHENSON ENGINEERING LIMITED

per 

Mauricio Nieto, MAsc., P.Eng.
Senior Engineer, Project Manager
mnieto@stephenson-eng.com


per 

Sandra Cullen, P.Eng.
Principal
scullen@stephenson-eng.com

Distribution cc:

Jeffrey Ellis	jellis@dineen.com
Gino Colangelo	gcolangelo@gc-architects.com
Carmen Taranu	CTaranu@gc-architects.com
Shari Grant	SGrant@gc-architects.com
Colin Hutson	chutson@stephenson-eng.com

1	MAR 18 2016	ISSUED FOR TENDER
2	DEC 28 2016	ISSUED FOR BUILDING PERMIT
3	MAY 09 2017	ISSUED FOR FOUNDATION PERMIT
4	JUN 15 2017	STRUCTURAL ACADEMY#M1
10	JUL 19 2017	HC - ABOVE GRADE LEVELS
12	AUG 24 2017	ISSUED FOR SITE INSTRUCTION #4
13	SEP 12 2017	ISSUED FOR SITE INSTRUCTION #5
15	DEC 14 2017	ISSUED FOR SITE INSTRUCTION #7
17	FEB 14 2018	ISSUED FOR SITE INSTRUCTION #9

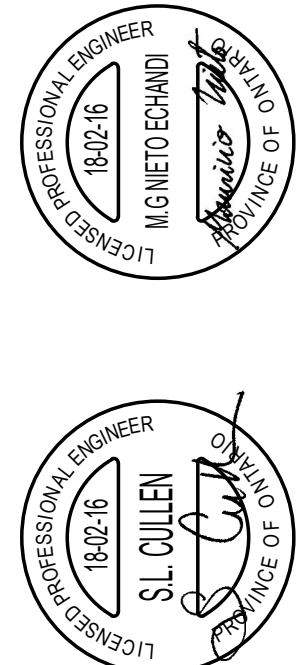

PROPOSED RESIDENTIAL DEVELOPMENT

25 BAKER HILL BLVD.


ROYAL PINES HOMES

STOUFFVILLE


ONTARIO

Drawn by	RS
Checked by	NH/PZ/AS
Plot Date:	DECEMBER 2016
Job #	201140490

GROUND FLOOR FRAMING PLAN

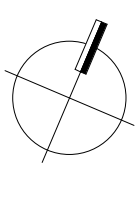

As indicated

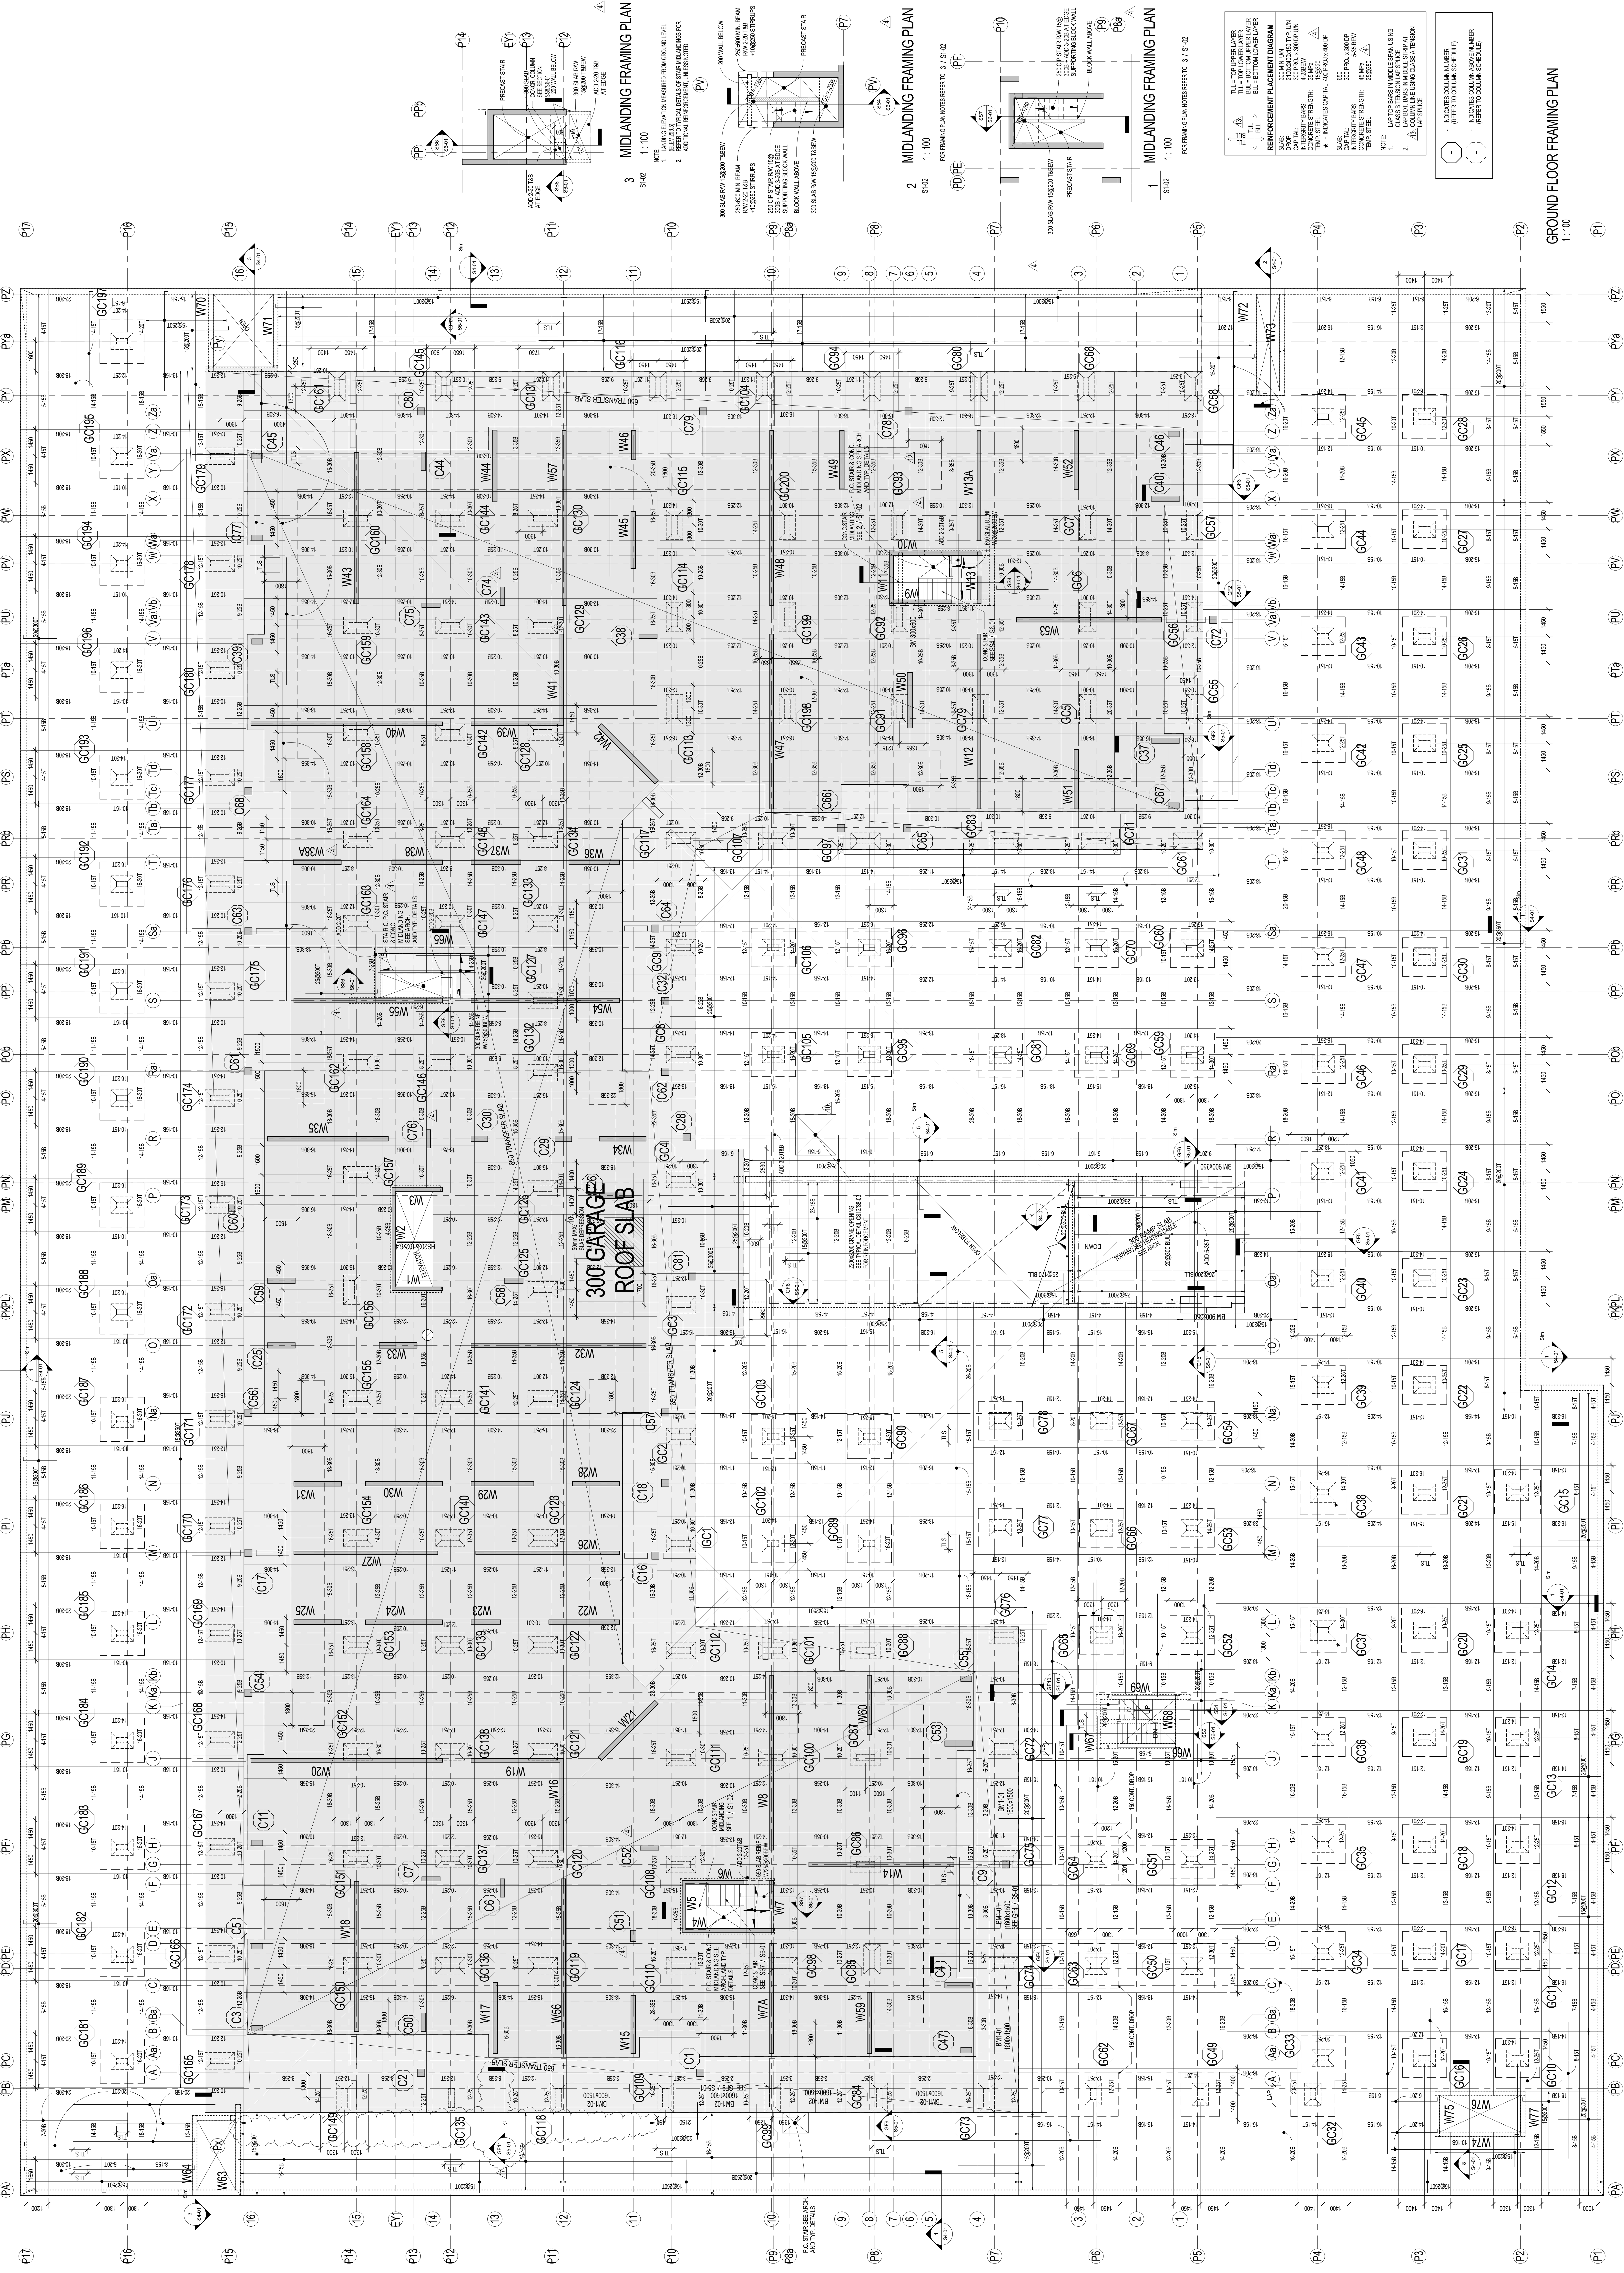

1	MAR 18 2016	ISSUED FOR TENDER
2	DEC 28 2016	ISSUED FOR BUILDING PERMIT
3	MAY 09 2017	ISSUED FOR FOUNDATION PERMIT
4	JUN 15 2017	STRUCTURAL ADDENDUM#1
10	JUL 19 2017	IFC - ABOVE GRADE LEVELS
12	AUG 24 2017	ISSUED FOR SITE INSTRUCTION #6
14	NOV 13 2017	ISSUED FOR SITE INSTRUCTION #6
17	FEB 16 2018	ISSUED FOR SITE INSTRUCTION #9

