



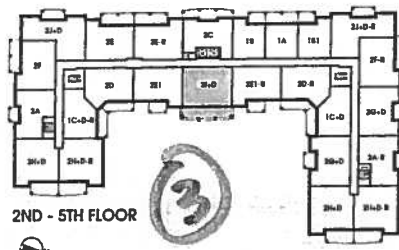

SUITE 415

# Calverton\*ORIGINAL LAYOUT\*

1,169 SQ FT *plus 260 sq. ft. of balcony area*

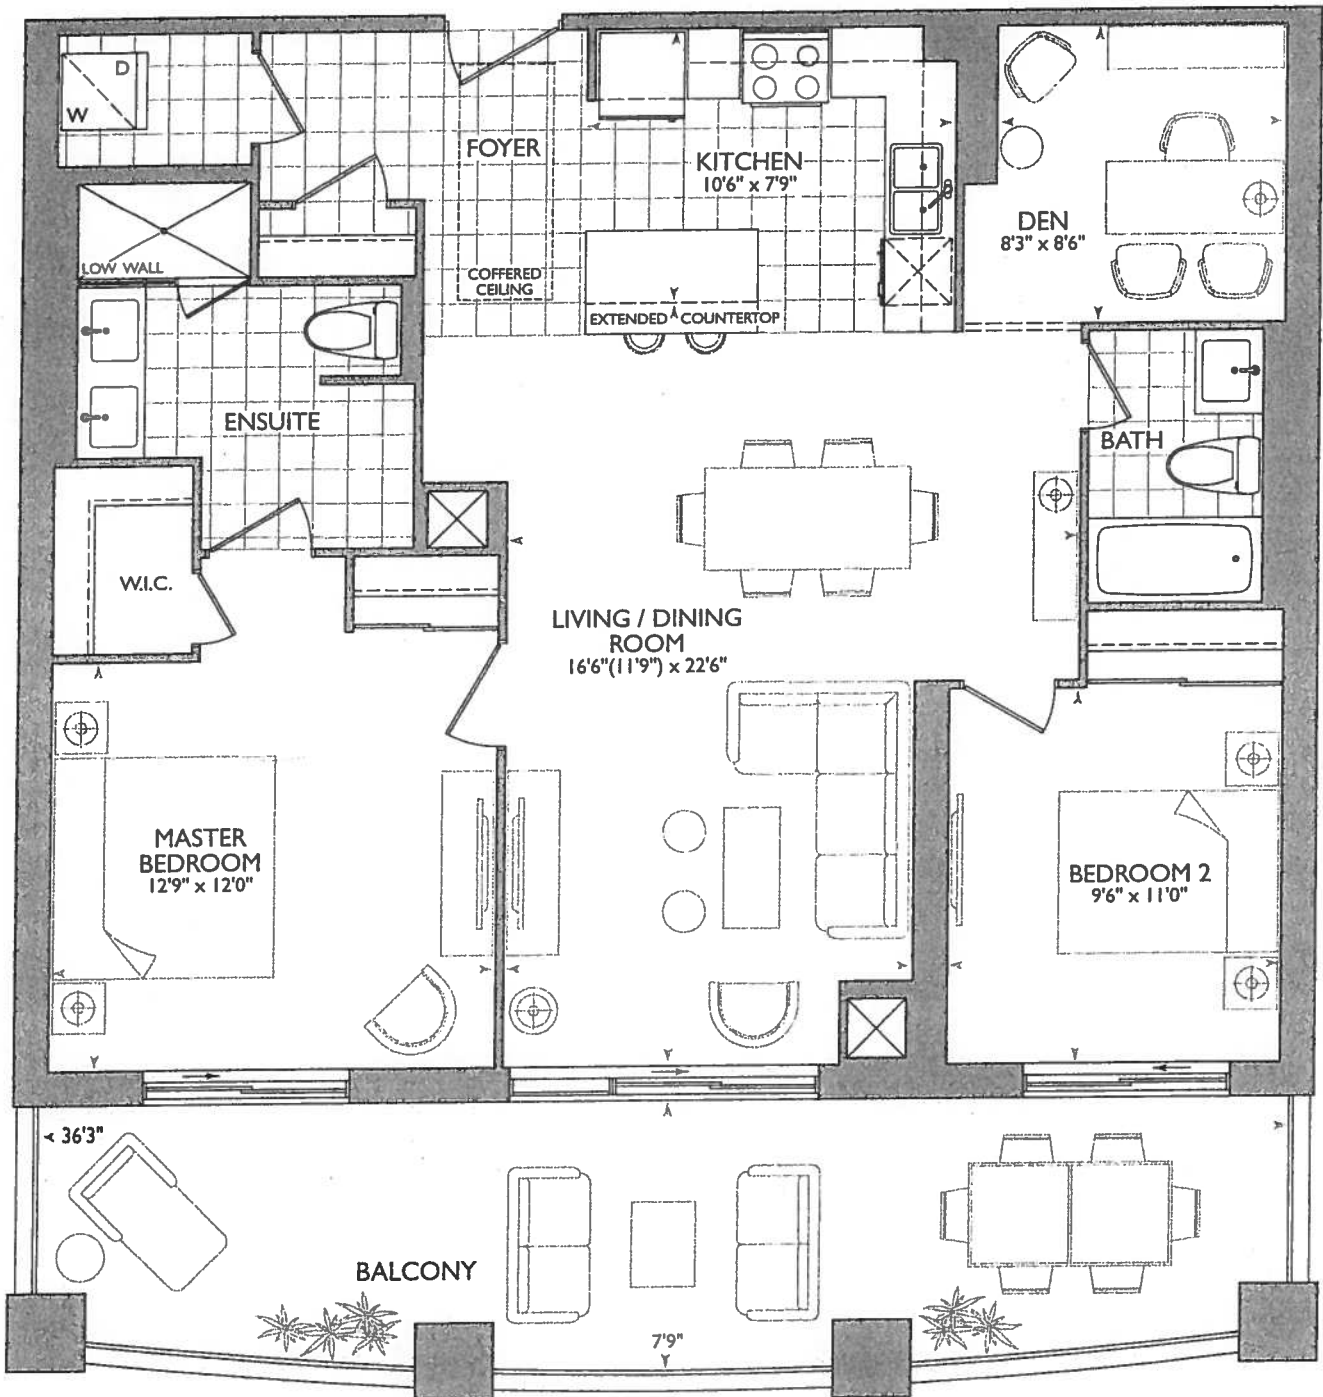

December 21, 2017



\* BARRIER FREE SUITE

\* KENSUITE - DELETE LOW WALL SHOWER @ KEEP VANITY 6" AWAY FROM SHOWER


KITCHEN

\* PURGE 1- APPLIANCE PACKAGE  
\* x 4 = PUCK LIGHTS.  
\* x 2 = PLUGS ISLAND.  
\* 53" STOVE PIPE CENTER  
\* 59" SINK PIPE CENTER

RECEIVED  
DEC 21 2017

SUITE 415-CALVERTON

Royal Pine Homes 25 Baker Hill Blvd - Stouffville, ON Dec 21, 2017

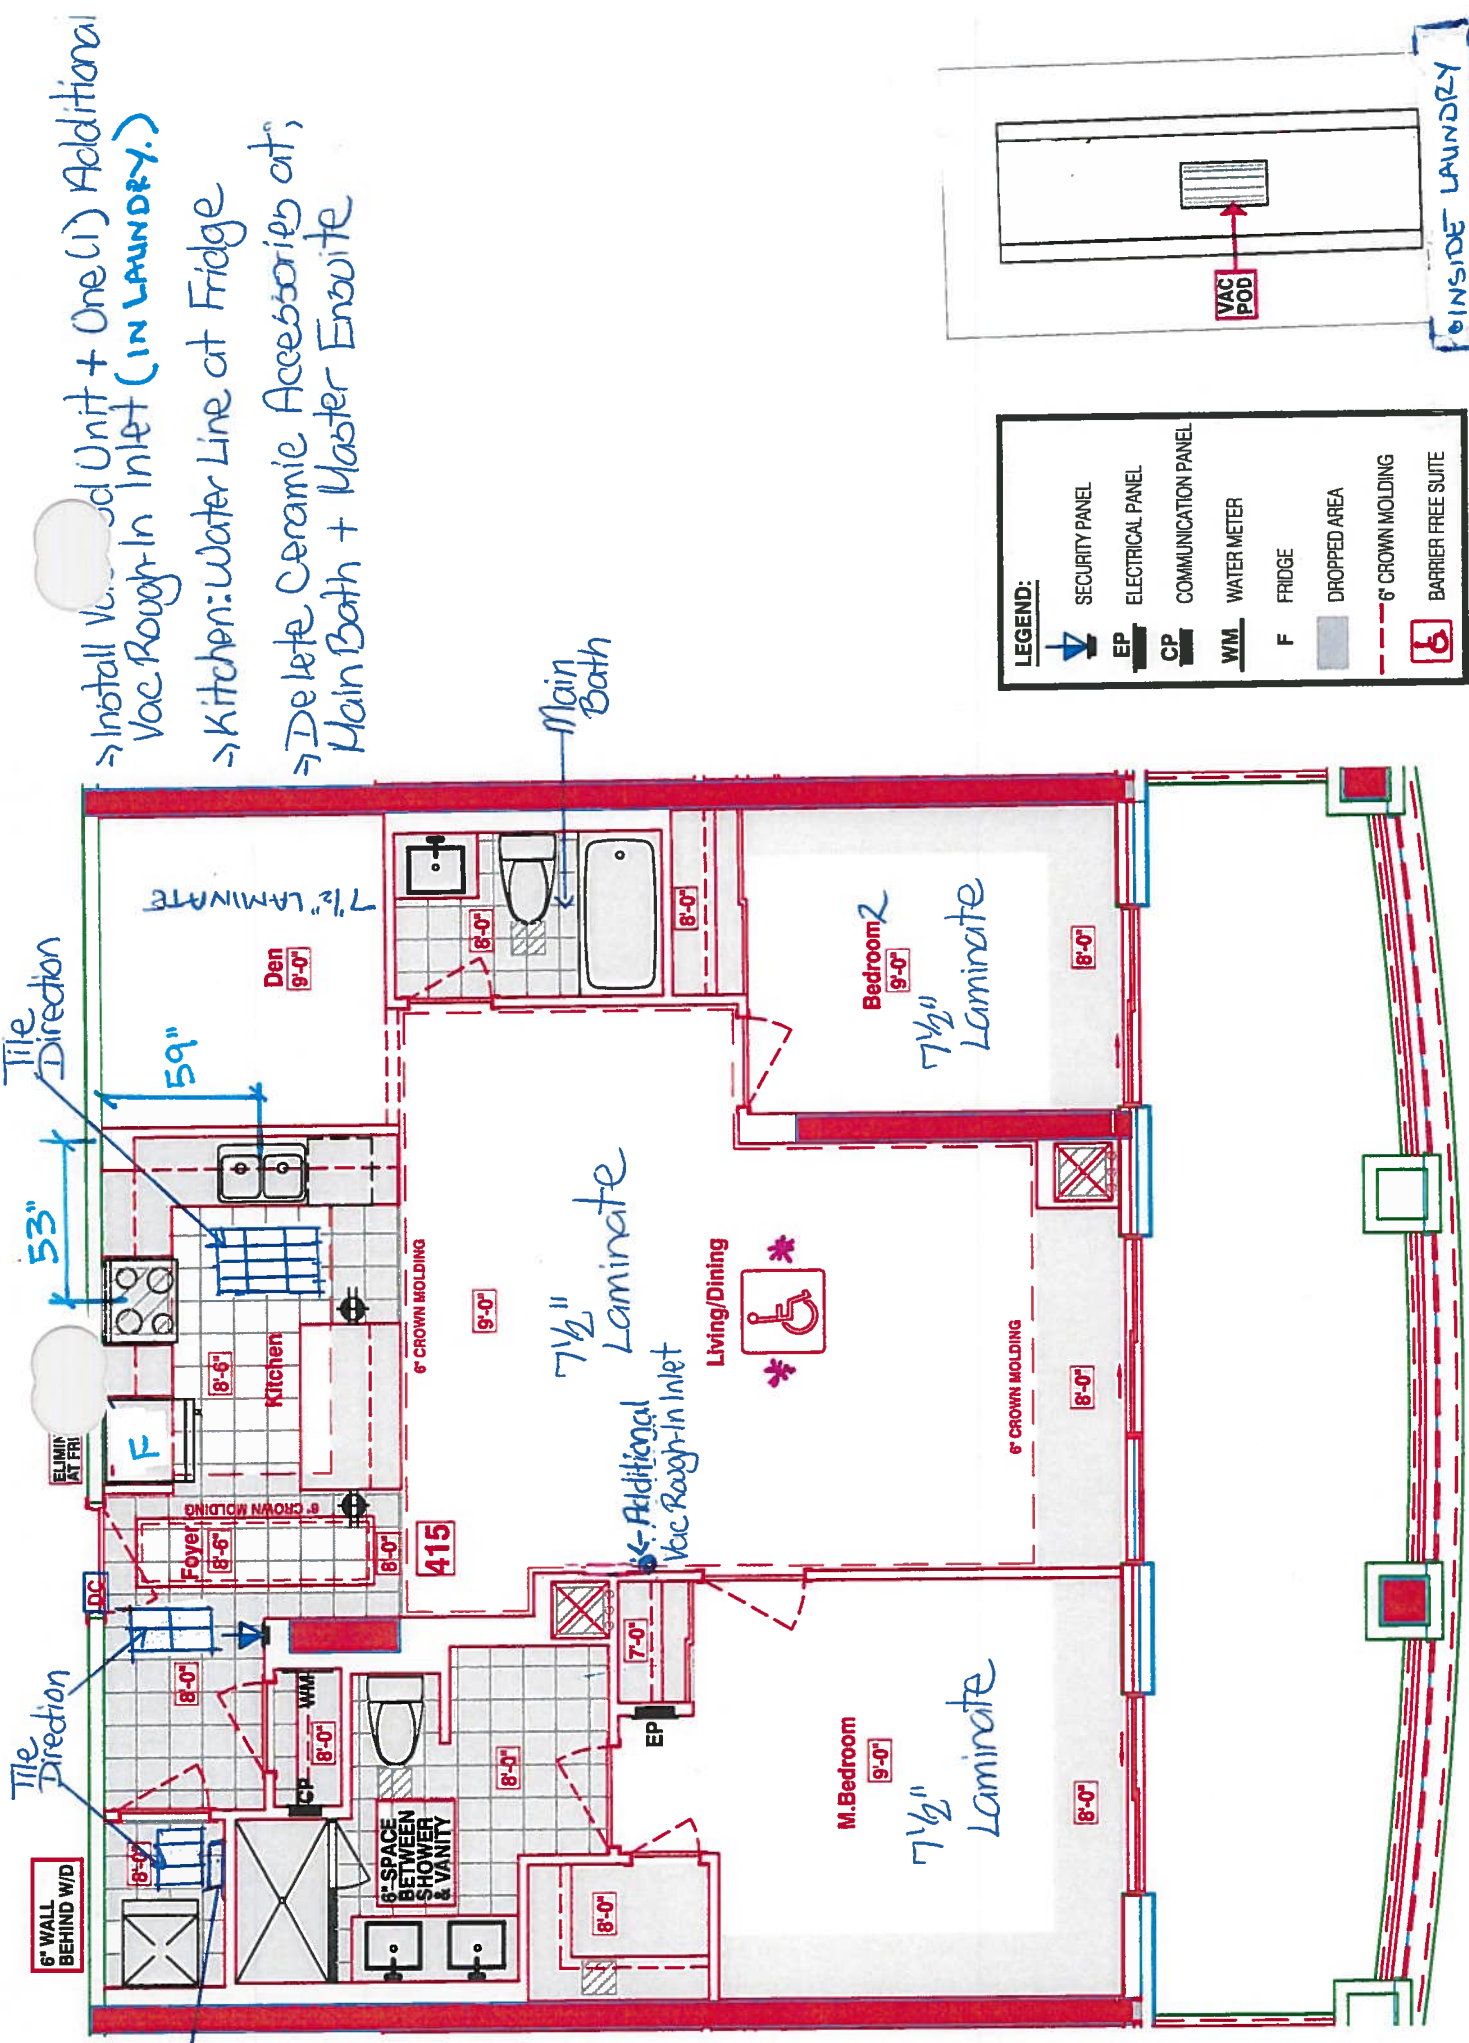

INSIDE LAUNDRY



CONSTRUCTION SUMMARY

Hampton Place

PURCHASERS: BERARDINO PORRETTA and ANNA O. PORRETTA

TEL: RES.: 905-770-9595 BUS.: 416-509-7692

| LOT NUMBER | PHASE | HOUSE TYPE | CLOSING DATE |
|------------|-------|------------|--------------|
| 415        | 1     | CALVERTON  | 01-Oct-18    |

Date Added: 21-Dec-17

Invoice Number: 7068

1 - LAUNDRY ROOM - Install VAC-POD at Laundry Room (Includes 30ft. air hose package)  
To include; ONE (1) Additional VAC ROUGH-IN INLET at living/dining room. (See Sketch)  
Locations Approved as per Vince at Head-Office

1 - KITCHEN & BATHROOMS - Purchaser has DECLINED All Upgrades offered during decor appointment at the decor centre for kitchen & bathroom cabinetry. Standard Kitchen Layout & Standard Bathroom Vanities to be installed as per standard plan. (See Sketch)  
Note:

1 - DISCLAIMER - STONE COUNTERTOP;  
KITCHEN - Stone slabs vary in size & all seams are visible & the fabricator reserves the right to position the seams as necessary.  
Note:

1 - KITCHEN - Kitchen Backsplash - Install 1ST UPGRADE BACKSPLASH - 3x12 CLOUD GLASS SUBWAY in UPGRADE BRICK PATTERN -  
To be installed throughout kitchen, where applicable. (does not include behind the fridge or stove) (See Sketch)  
Note:

1 - KITCHEN - Kitchen Sink - Install Standard Undermount Sink - BLANCO Horizon Plus U2 Undermount Sink (8") - Model # 401234  
Note:

1 - KITCHEN - Kitchen Faucet - Install Standard Faucet - DELTA Chrome Pull-Out Kitchen Faucet (Single Hole) - Model #469LF- Chrome  
Note:

1 - APPLIANCE PACKAGE - Install Upgrade Appliance Package - UPGRADE PACKAGE #1 - To be installed throughout suite, where applicable.  
(See Sketch)

1 - KITCHEN - Install WATER LINE ROUGH-IN ONLY To Fridge at Kitchen (See Sketch)  
Note:

28 - LAUNDRY ROOM - 2ND UPGRADE - PORCELAIN TILES - 12x24 H-STONE LIGHT GREY - To be installed throughout laundry room floor.  
(To be Installed Straight) (See Sketch)  
Note: Includes Larger Size

1 - MAIN BATH & MASTER ENSUITE - Install Standard Granite Countertop - BIANCO ANTICO - To be installed at Main Bath and Master Ensuite  
vanities, where applicable. (Includes 3" Splash) (See Sketch)  
Note:

1 - CLARIFICATION;  
MAIN BATH & MASTER ENSUITE - Install Standard 3" Splash at Main Bath and Master Ensuite vanity countertops, where applicable. (See Sketch)  
Note:

1 - DISCLAIMER - GRANITE COUNTERTOP;  
MAIN BATH & MASTER ENSUITE - Due to the many variables that can affect the pattern, colour and/or design and "pitting" of natural products,  
granite installed will not be identical to the samples displayed.  
Note: Every effort is made to provide granite countertops as close as possible but the vendor is not responsible for results which differ  
from the sample displayed. All countertop surfaces may have seams, and product pattern and shade can change in areas containing  
seams.

1 - DISCLAIMER - STONE COUNTERTOP;  
MAIN BATH & MASTER ENSUITE - Stone slabs vary in size & all seams are visible & the fabricator reserves the right to position the seams as  
necessary.  
Note:

1 - CLARIFICATION;  
MAIN BATH & MASTER ENSUITE - Install Standard Plumbing Fixtures throughout Main Bath and Master Ensuite where applicable. (See Sketch)  
Note:



SITE COPY

CONSTRUCTION SUMMARY

Hampton Place

PURCHASERS: BERARDINO PORRETTA and ANNA O. PORRETTA

TEL: RES.: 905-770-9595 BUS.: 416-509-7692

| LOT NUMBER | PHASE | HOUSE TYPE | CLOSING DATE |
|------------|-------|------------|--------------|
| 415        | 1     | CALVERTON  | 01-Oct-18    |

Date Added: 21-Dec-17

Invoice Number: 7068

1 - CLARIFICATION;  
MASTER ENSUITE - Purchaser accepts & acknowledges the standard frameless glass enclosure at master ensuite shower stall will NOT touch the  
and will receive a Standard Chrome Header. (See Sketch)

1 - CLARIFICATION;  
MAIN BATH & MASTER ENSUITE - DELETE Do Not Install / Supply / Credit Purchaser for builders standard ceramic bathroom accessories (toilet  
paper, towel bar & soap dish) throughout all bathrooms where applicable.  
Note: To Include; Main Bath & Master Ensuite (See Sketch)

1 - REFERRAL FEE - PURCHASER HAS APPLIED REFERRAL FEE OF; \$1,000.00 (Includes Taxes) HAS BEEN APPLIED TO UPGRADE  
COMPLETED AT THE DECOR CENTRE.  
Note:

1 - PURCHASER HAS ATTENDED A COLOR APPOINTMENT AT THE DECOR CENTRE AND HAS DECLINED ANY ADDITIONAL  
UPGRADES. Purchaser accepts and acknowledges that there will be no further changes/additions/deletions to be made upon signing on December 21,  
2017  
Note:

1 - PURCHASER AWARE AND ACCEPTS THAT ANY CHANGES MADE TO UPGRADES AFTER SIGNING THIS PURCHASERS EXTRA  
FORM ARE SUBJECT TO A MINIMUM ADMINISTRATION FEE OF \$1,000 PLUS A 10% HOLDBACK FEE.  
Note:

This Document is Extremely Time Sensitive - Printed 28 Feb 18 at 16:31



Purchasers

BERARDINO PORRETТА & ANNA O. PORRETТА

\* INTERIOR

OUR SCHEME \*

Decor Consultant

Melissa Di Marino

Model Type

CALVERTON

Telephone Res. / Bus

(905) 770-9595 / (416) 509-7692

Project

Hampton Place

Closing Date

01/10/2018

Unit

415


Page 1 of 3


|                   | Flooring                                               |      | Wall Tile                                |         | Accent/Insert | Pattern |
|-------------------|--------------------------------------------------------|------|------------------------------------------|---------|---------------|---------|
|                   | Description                                            | Main | Main                                     | Pattern |               |         |
| MASTER ENSUITE    | ✓ 13x13 RUSTIC GREY (STD)                              | ✓    | 8x10 NATURALE GRIGIO (STD)               | NONE    | NONE          |         |
| MAIN BATHROOM     | ✓ 13x13 RUSTIC GREY (STD)                              | ✓    | 8x10 NATURALE GRIGIO (STD)               | NONE    | NONE          |         |
| POWDER ROOM       | N/A                                                    |      | N/A                                      | N/A     | N/A           |         |
| KITCHEN / DINETTE | ✓ 12x24 H-STONE LIGHTGREY (STRAIGHT) (STD)             | ✓    | 3x12 CloudGlassSubway(BrickPattern)(Upg) | NONE    | NONE          |         |
| FOYER             | ✓ 12x24 H-STONE LIGHTGREY (STRAIGHT) (STD)             |      | N/A                                      | N/A     | N/A           |         |
| LAUNDRY           | ✓ 12x24 H-STONE LIGHTGREY (STRAIGHT)(UPG)              |      | N/A                                      | N/A     | N/A           |         |
| LIVING ROOM       | ✓ 7 1/2" TorleysForest - NorthernCordillera9687P (STD) |      |                                          |         |               |         |
| DINING ROOM       | ✓ 7 1/2" TorleysForest - NorthernCordillera9687P (STD) |      |                                          |         |               |         |
| DEN               | ✓ 7 1/2" TorleysForest - NorthernCordillera9687P (STD) |      |                                          |         |               |         |
| MASTER BEDROOM    | ✓ 7 1/2" TorleysForest - NorthernCordillera9687P (STD) |      |                                          |         |               |         |
| BEDROOM 2         | ✓ 7 1/2" TorleysForest - NorthernCordillera9687P (STD) |      |                                          |         |               |         |
| BEDROOM 3         | N/A                                                    |      |                                          |         |               |         |


Notes

Page 1 of 3

Consultant:   
Melissa Di Marino

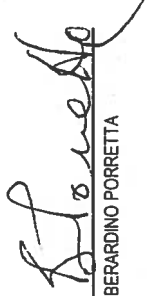Purchaser:   
BERARDINO PORRETТА

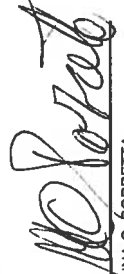Purchaser:   
ANNA O. PORRETТА

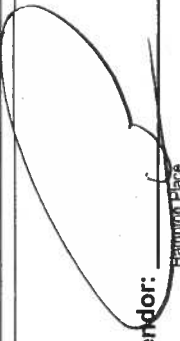Vendor:   
Hampton Place



\* INTERIOR

OUR SCHEME \*

|                                       |  |                   |            |                                 |               |              |      |
|---------------------------------------|--|-------------------|------------|---------------------------------|---------------|--------------|------|
| Purchasers                            |  | Decor Consultant  | Model Type | Telephone Res. / Bus            | Project       | Closing Date | Unit |
| BERARDINO PORRETTA & ANNA O. PORRETTA |  | Melissa Di Marino | CALVERTON  | (905) 770-9595 / (416) 509-7692 | Hampton Place | 01/10/2018   | 415  |

Page 2 of 3

CABINETS, VANITIES AND COUNTERTOPS

|                   | Style                                         | Countertop                                                      | Counter Edge                                       | Handle / Knob |
|-------------------|-----------------------------------------------|-----------------------------------------------------------------|----------------------------------------------------|---------------|
| MAIN BATHROOM     | CATEGORY 2 - MAPLE - PISTACHIO QT 2503 (STD)  | <input checked="" type="checkbox"/> BIANCO ANTICO GRANITE (STD) | <input checked="" type="checkbox"/> A " EDGE (STD) | 16338-195     |
| MASTER ENSUITE    | CATEGORY 2 - MAPLE - PISTACHIO QT 2503 (STD)  | <input checked="" type="checkbox"/> BIANCO ANTICO GRANITE (STD) | <input checked="" type="checkbox"/> A " EDGE (STD) | 16338-195     |
| POWDER ROOM       | N/A                                           | N/A                                                             | N/A                                                | N/A           |
| KITCHEN / DINETTE | CATEGORY 1 - FIBERBOARD - WHITE QT 1203 (STD) | <input checked="" type="checkbox"/> ASPEN CYRUS GREY (STD)      | <input checked="" type="checkbox"/> A " EDGE (STD) | 3487-128      |
| LAUNDRY ROOM      | N/A                                           | N/A                                                             | N/A                                                | N/A           |
|                   |                                               |                                                                 |                                                    |               |
|                   |                                               |                                                                 |                                                    |               |

APPLIANCE PACKAGE

Upgrade #1 Package

Std 3" In Opening

PLUMBING FIXTURES

|                             |                                              |
|-----------------------------|----------------------------------------------|
| KITCHEN                     |                                              |
| Sink Model                  | <input checked="" type="checkbox"/> STANDARD |
| Sink Faucet                 | <input checked="" type="checkbox"/> STANDARD |
| TOILETS                     |                                              |
| Master Ensuite              | <input checked="" type="checkbox"/> STANDARD |
| Main Bathroom               | <input checked="" type="checkbox"/> STANDARD |
| Powder Room                 | N/A                                          |
| VANITY FAUCETS              |                                              |
| Master Ensuite              | <input checked="" type="checkbox"/> STANDARD |
| Main Bathroom               | <input checked="" type="checkbox"/> STANDARD |
| Powder Room                 | N/A                                          |
| VANITY SINKS                |                                              |
| Master Ensuite              | <input checked="" type="checkbox"/> STANDARD |
| Main Bathroom               | <input checked="" type="checkbox"/> STANDARD |
| Powder Room                 | N/A                                          |
| SHOWER STALL / TUBS         |                                              |
| Master Ensuite Shower Stall | <input checked="" type="checkbox"/> STANDARD |
| Master Ensuite Tub          | N/A                                          |
| Main Bathroom Tub           | <input checked="" type="checkbox"/> STANDARD |

Trim

Baseboard & Casing ☒ STANDARD

Interior Doors ☒ STANDARD - CARRARA, SMOOTH

Levers ☒ STANDARD

Door Height ☒ STANDARD

Cornice Moulding / Medalion

Foyer ☒ STANDARD - #CTR-611

Living Room ☒ STANDARD - #CTR-611

Dining Room ☒ STANDARD - #CTR-611

Den NONE

Master Bedroom NONE

Bedroom 2 NONE

Bedroom 3 N/A

Fireplace

Fireplace N/A

Location Flooring N/A

Style N/A

Finish N/A

Marble N/A

Hearth N/A

Paint Throughout

Walls ☒ STANDARD - OYSTER WHITE

Trim ☒ STANDARD - WHITE

MISC. INSTALLATIONS

Ceramic Accessories (installed by Vendor) ☒ Yes ☒ No

Bathroom Mirrors (installed by Vendor) ☒ Yes ☒ No

Wire Shelving - Closet (installed by Vendor) ☒ Yes ☒ No

Page 2 of 3

Decor Consultant:


Purchaser:

Purchaser:

Vendor:



# Suite 415 Hampton

- UPG #1 - APPLIANCE PACKAGE
- x4 = PUCK LIGHTS
- x2 = PLUGS ISLAND.

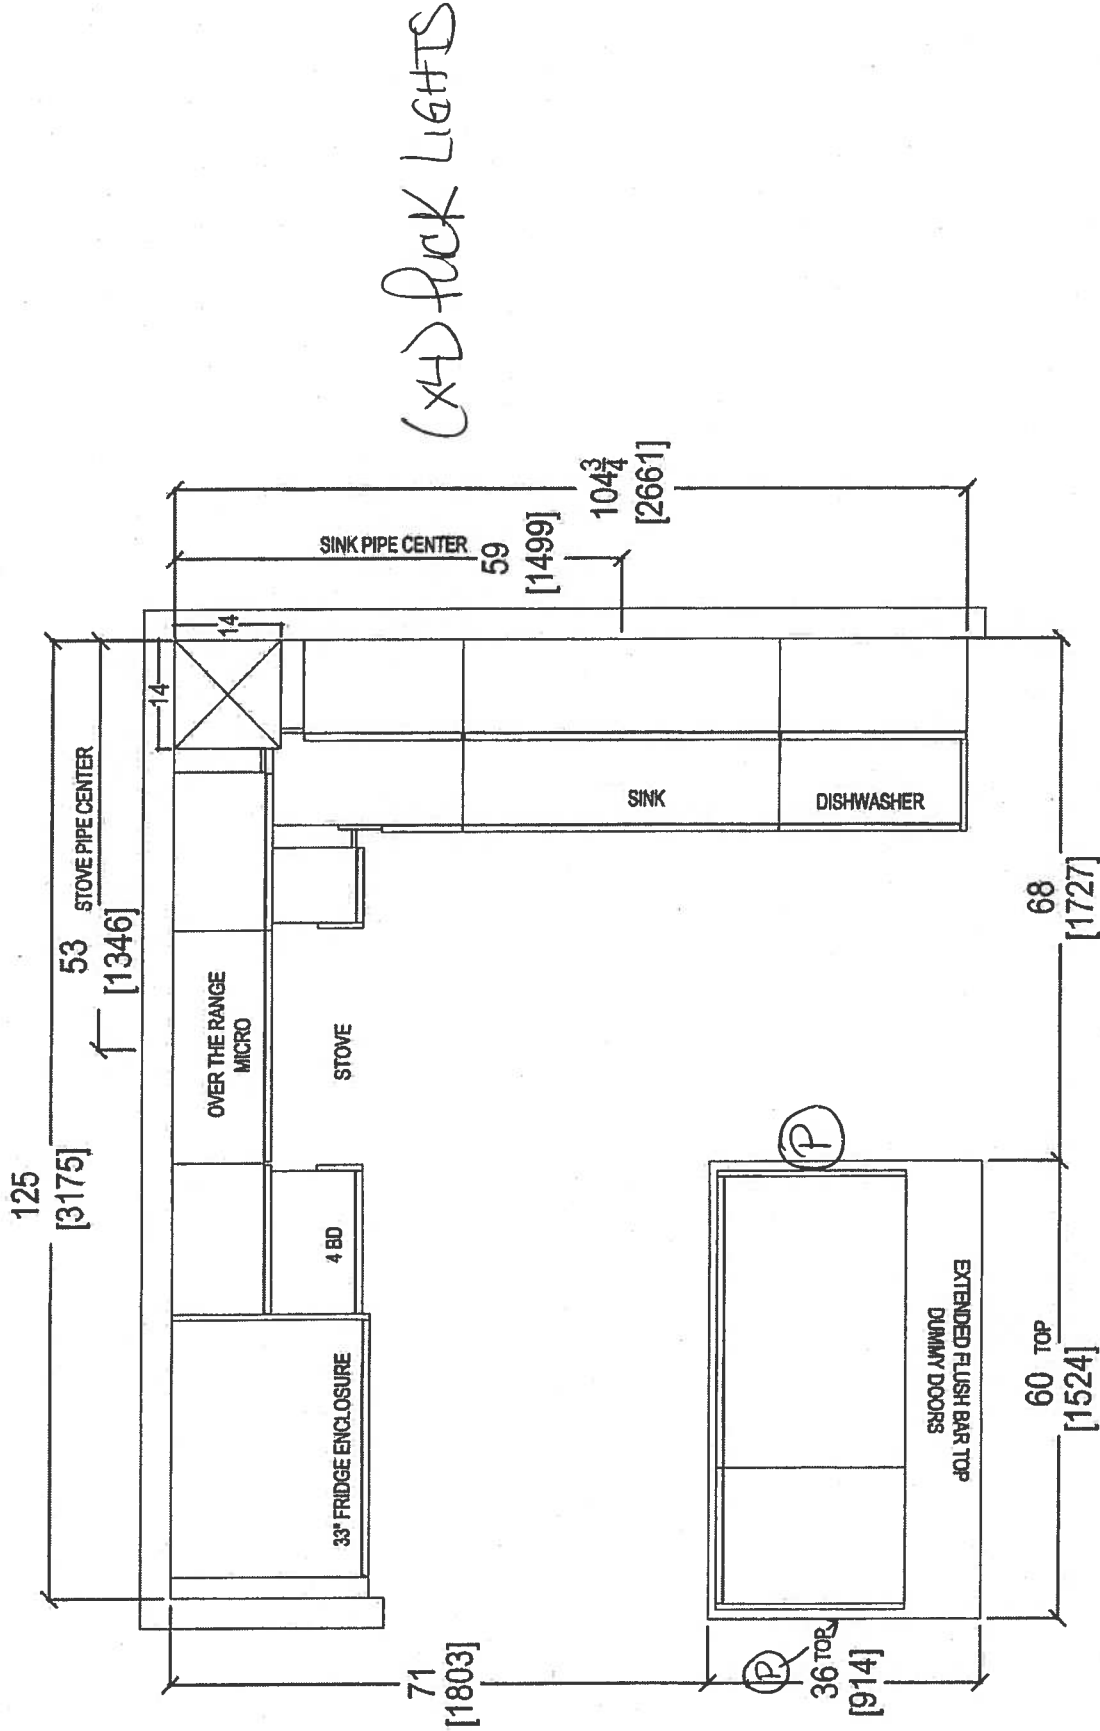


|                                                                                                                                                                                                      |                          |               |                |                       |                    |              |                                                                                                                      |
|------------------------------------------------------------------------------------------------------------------------------------------------------------------------------------------------------|--------------------------|---------------|----------------|-----------------------|--------------------|--------------|----------------------------------------------------------------------------------------------------------------------|
| <br><i>your kitchen, your taste.</i><br>80 SANTE DRIVE, VAUGHAN, ON L4K 3C4.<br>T: 416.748.1811 F: 905.781.5901 | CLIENT: ROYAL PINE HOMES |               | UNIT 415 HMP   | ROOM:                 | KITCHEN FLOOR PLAN | DRAWN BY: SK | COMMENTS:<br><br>PLEASE NOTE ALL DIMENSIONS<br>ARE NOT FINAL AND ARE<br>SUBJECT TO CHANGE UPON<br>FINAL SITE MEASURE |
|                                                                                                                                                                                                      | SITE: HAMPTON PLACE      | DOOR STYLE: — | DOOR HANDLE: — | SCALE: 1/2" = 1' - 0" |                    |              |                                                                                                                      |
|                                                                                                                                                                                                      | PHONE: —                 | FINISH: —     | DRW HANDLE: —  | DATE: JAN 24, 2018    |                    |              |                                                                                                                      |
|                                                                                                                                                                                                      | EMAIL: —                 | SPECIES: —    | TOP: —         | PAGE: —               |                    |              |                                                                                                                      |
|                                                                                                                                                                                                      |                          |               |                |                       |                    |              |                                                                                                                      |

# Swite 415 Hampton PL-Pick Light (x4)

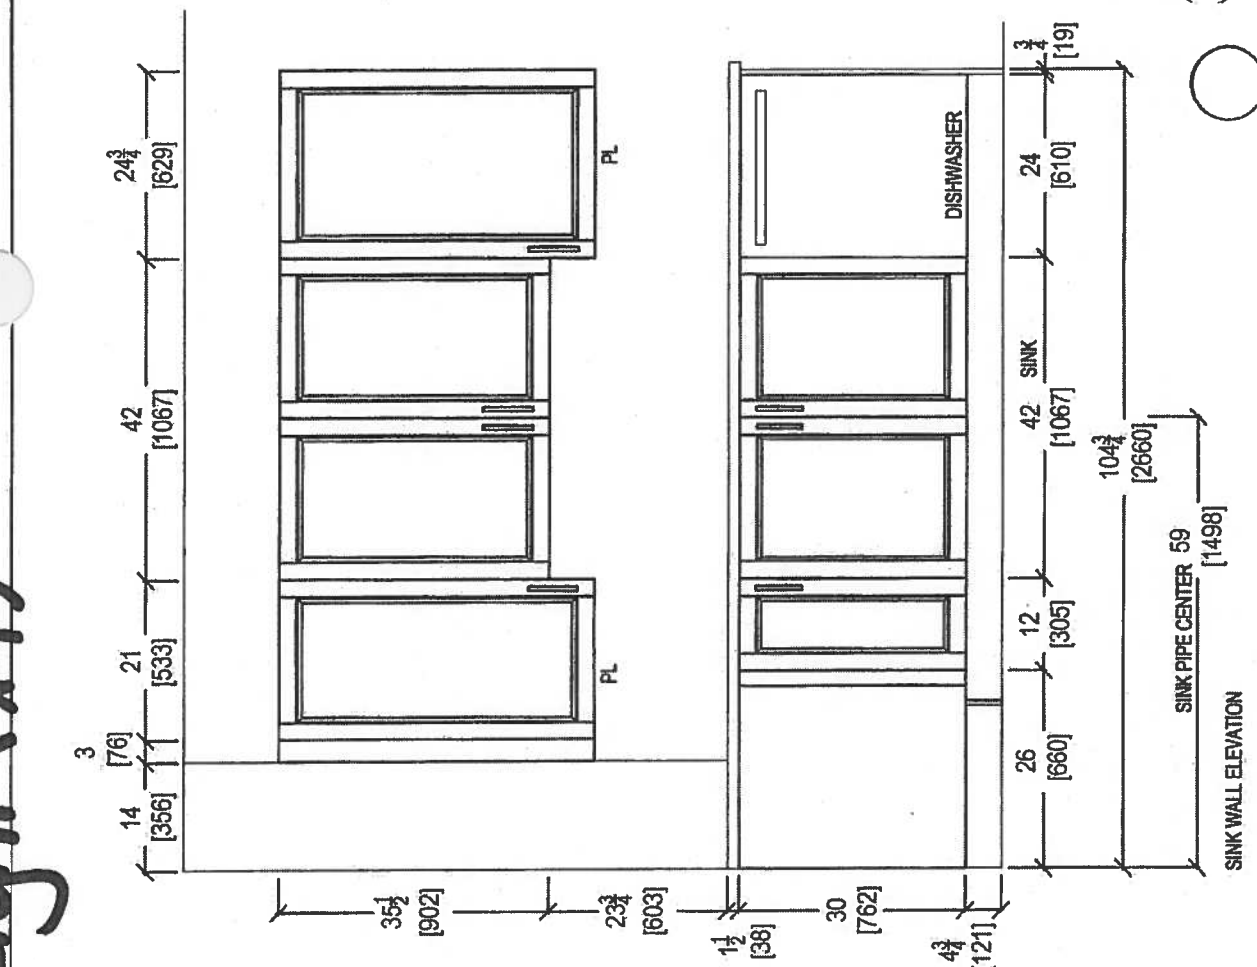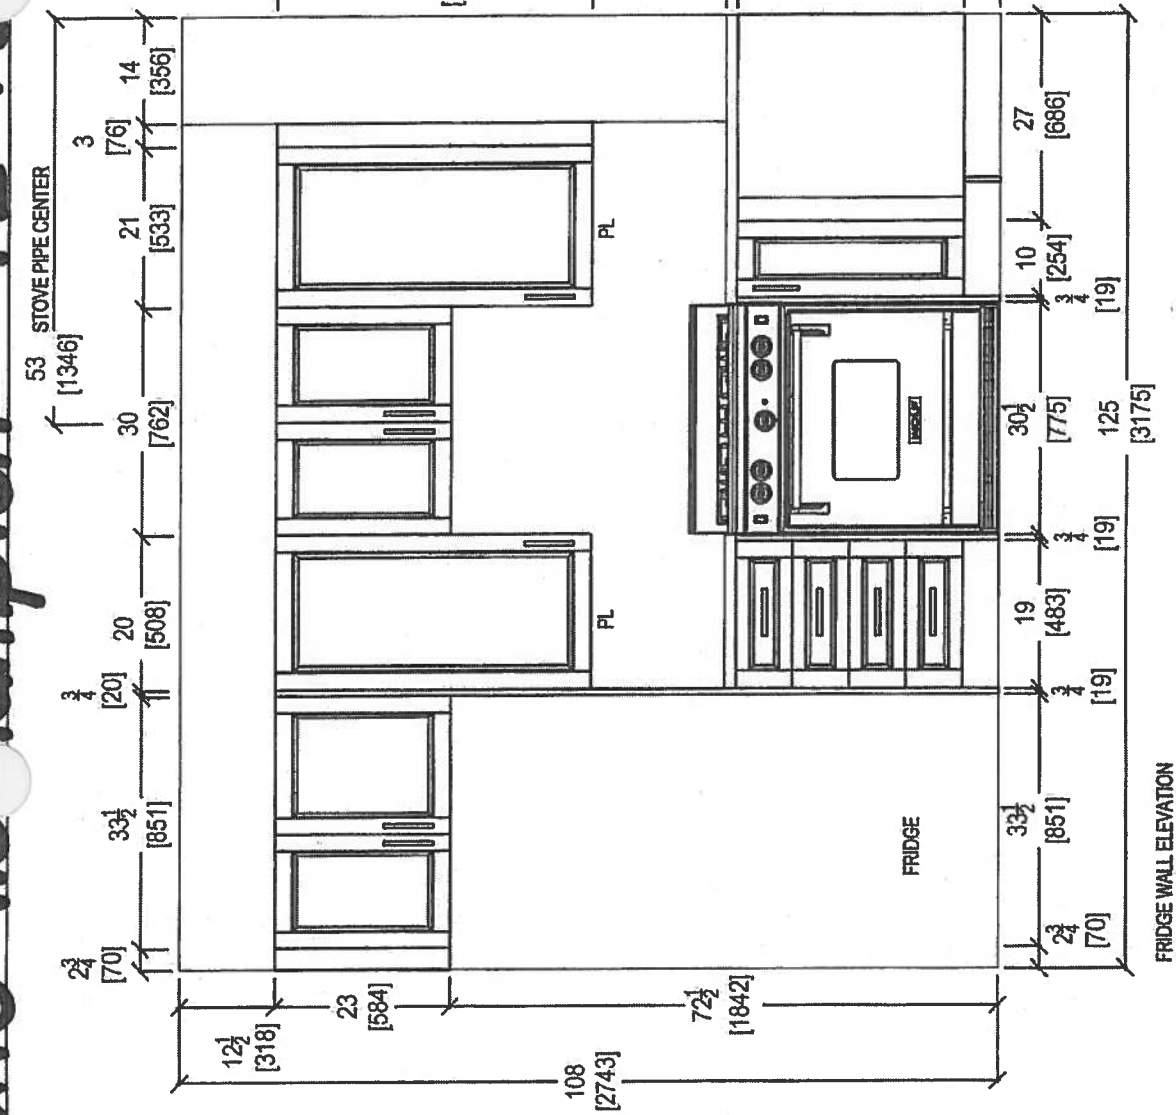

|                          |                |                |                       |                                                                                                                      |
|--------------------------|----------------|----------------|-----------------------|----------------------------------------------------------------------------------------------------------------------|
| CLIENT: ROYAL PINE HOMES |                | ROOM: KITCHEN  | DRAWN BY: SK          | COMMENTS:<br><br>PLEASE NOTE ALL DIMENSIONS<br>ARE NOT FINAL AND ARE<br>SUBJECT TO CHANGE UPON<br>FINAL SITE MEASURE |
| SITE: HAMPTON PLACE      | UNIT: 415/5AMP | DOOR HANDLE: — | SCALE: 1/2" = 1' - 0" |                                                                                                                      |
| PHONE: —                 | FINISH: —      | DRW HANDLE: —  | DATE: JAN 24, 2018    |                                                                                                                      |
| EMAIL: —                 | SPECIES: —     | TOP: —         | PAGE: —               |                                                                                                                      |




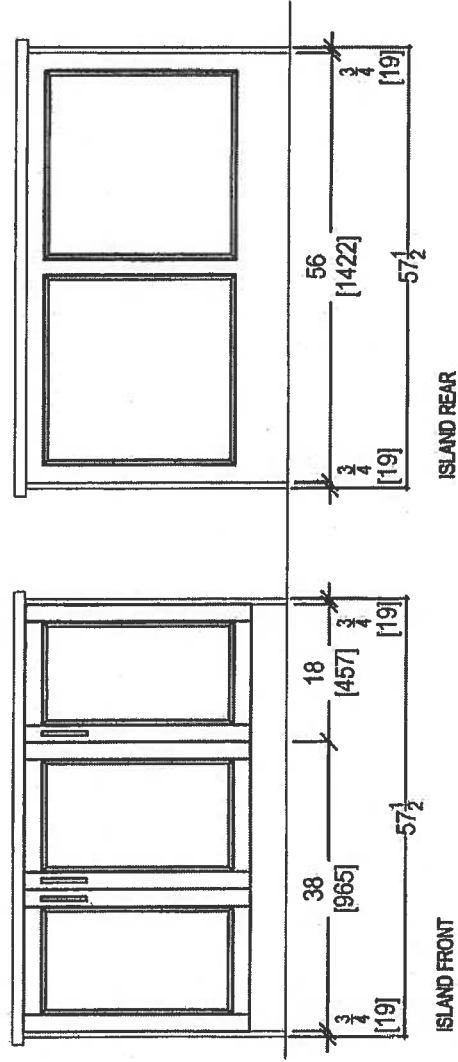


|                                                                                                                                                                                               |                          |  |               |                |                       |  |                                                                                                                      |
|-----------------------------------------------------------------------------------------------------------------------------------------------------------------------------------------------|--------------------------|--|---------------|----------------|-----------------------|--|----------------------------------------------------------------------------------------------------------------------|
| <br>your kitchen, your taste.<br>80 SANTE DRIVE, VAUGHAN, ON L4K 3C4,<br>T: 416.746.1811 F: 905.761.5901 | CLIENT: ROYAL PINE HOMES |  | UNIT 415 HMP  | ROOM: KITCHEN  | DRAWN BY: SK          |  | COMMENTS:<br><br>PLEASE NOTE ALL DIMENSIONS<br>ARE NOT FINAL AND ARE<br>SUBJECT TO CHANGE UPON<br>FINAL SITE MEASURE |
|                                                                                                                                                                                               | SITE: HAMPTON PLACE      |  | DOOR STYLE: — | DOOR HANDLE: — | SCALE: 1/2" = 1' - 0" |  |                                                                                                                      |
|                                                                                                                                                                                               | PHONE: —                 |  | FINISH: —     | DRW HANDLE: —  | DATE: JAN 24, 2018    |  |                                                                                                                      |
|                                                                                                                                                                                               | EMAIL: —                 |  | SPECIES: —    | TOP: —         | PAGE: —               |  |                                                                                                                      |
|                                                                                                                                                                                               |                          |  |               |                |                       |  |                                                                                                                      |

SUITE 415- HAMPTON



\* Install 3" Splash \*

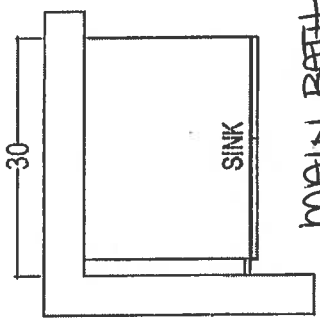

MAIN BATH

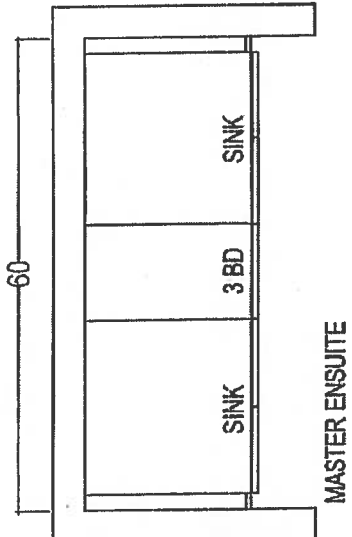

MASTER ENSUITE

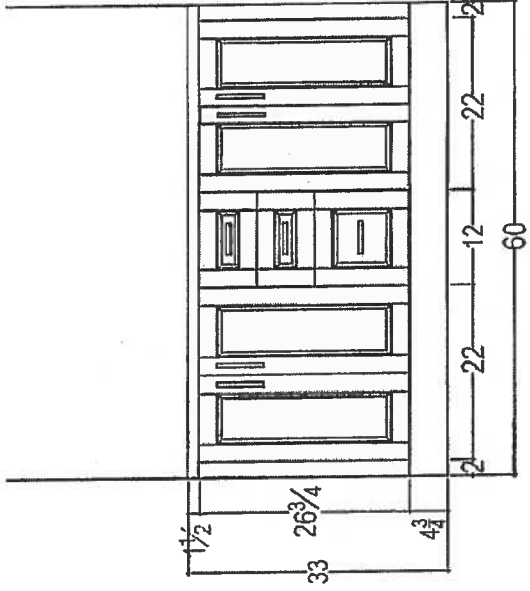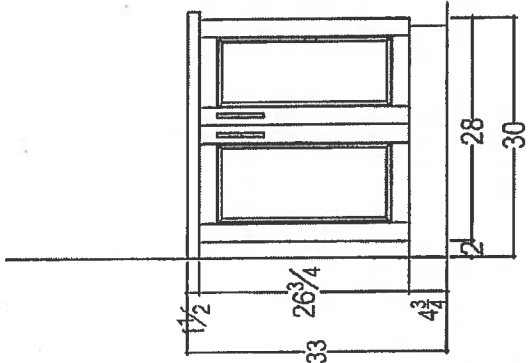

RECEIVED  
12-28-18



your kitchen. *is art.*  
80 SANTE DRIVE, VAUGHAN, ON L4K 3C4,  
T: 416.746.1811 F: 905.761.5901

|                          |               |                |          |                       |                                                                                                                      |
|--------------------------|---------------|----------------|----------|-----------------------|----------------------------------------------------------------------------------------------------------------------|
| CLIENT: ROYAL PINE HOMES | 21+D3         | ROOM:          | VANITIES | DRAWN BY: SK          | COMMENTS:<br><br>PLEASE NOTE ALL DIMENSIONS<br>ARE NOT FINAL AND ARE<br>SUBJECT TO CHANGE UPON<br>FINAL SITE MEASURE |
| SITE: HAMPTON PLACE      | DOOR STYLE: — | DOOR HANDLE: — |          | SCALE: 1/2" = 1' - 0" |                                                                                                                      |
| PHONE: —                 | FINISH: —     | DRW HANDLE: —  |          | DATE: AUG 4, 2017     |                                                                                                                      |
| EMAIL: —                 | SPECIES: —    | TOP: —         |          | PAGE: —               |                                                                                                                      |
|                          |               |                |          |                       |                                                                                                                      |

Suite 415  
Hampton

WRB322DMBM

## Upgrade Package I



Whirlpool®

<http://www.whirlpool.com>

33-inches wide Bottom-Freezer Refrigerator with  
SpillGuard™ Glass Shelves - 22 cu. ft

### Key Features:

- SpillGuard™ Glass Shelves
- Adaptive Defrost / *Factory Installed Icemaker*
- FreshFlow™ Produce Preserver
- LED Interior Lighting
- ENERGY STAR® Qualified

### Product Dimensions:

Height: 70

Width: 32 5/8

Depth: 33 3/8

### Electrical Requirements:

15


### Additional Information:

[Use And Care Guide](#)

[Dimension Guide](#)

[Energy Guide](#)

[Warranty Certificate](#)

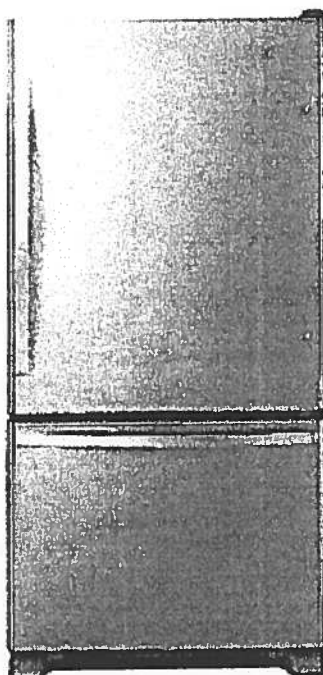

INVESTED  
IN  
AMERICA



©Registered trademark/TM Trademark of Whirlpool, U.S.A. © 2016 Whirlpool Corporation. All Rights Reserved.  
All other trademarks are owned by their respective companies.  
Because Whirlpool Corporation policy includes a continuous commitment to improve our products, we reserve  
the right to change materials and specifications without notice. We also reserve the right to discontinue or  
transition products without notice.  
Manufacturer's Suggested Retail Price (MSRP) and Minimum Advertised Price (MAP) provided for reference  
purposes only. Dealer alone determines advertised and retail prices.  
Created On: Tuesday, March 14, 2017 11:30:08

Suite 415  
Hampton

Upgrade  
Package I




WEE745H0FS

Whirlpool®

6.4 Cu. Ft. Slide-In Electric Range with True  
Convection

<http://www.whirlpool.com>

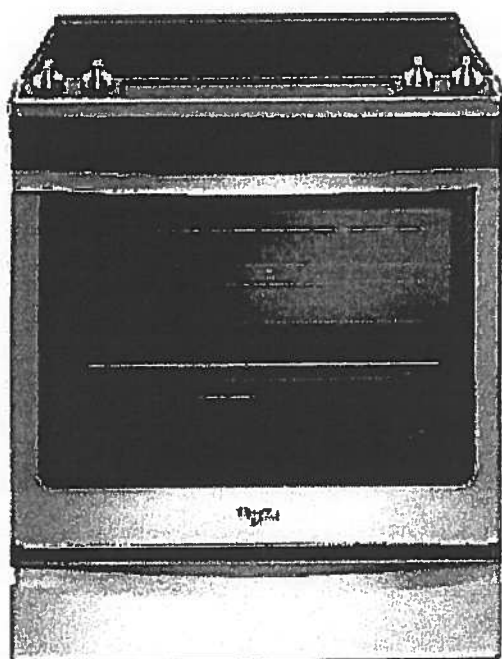

Key Features:

- Frozen Bake™ Technology
- True Convection Cooking
- FlexHeat™ Triple Radiant Element
- Convection Conversion
- AquaLift® Self-Cleaning Technology
- Temperature Sensor
- Rapid Preheat
- 6.4 Cu. Ft. Capacity
- Easy-Wipe Ceramic Glass Cooktop
- Large Oven Window
- Max Capacity Rack
- Hidden Bake Element

Product Dimensions:

Height: 36

Width: 29 7/8

Additional Information:

[Use And Care Guide](#)

[Dimension Guide](#)

[Installation Guide](#)

[Warranty Certificate](#)

INVESTED  
IN  
AMERICA



©Registered trademark/TM Trademark of Whirlpool, U.S.A. © 2016 Whirlpool Corporation. All Rights Reserved.  
All other trademarks are owned by their respective companies.  
Because Whirlpool Corporation policy includes a continuous commitment to improve our products, we reserve the right to change materials and specifications without notice. We also reserve the right to discontinue or transition products without notice.  
Manufacturer's Suggested Retail Price (MSRP) and Minimum Advertised Price (MAP) provided for reference purposes only. Dealer alone determines advertised and retail prices.  
Created On: Friday, January 27, 2017 10:46:47

Suite 415  
Hampton

Upgrade  
Package 1



YWMH76719CS

1.9 cu. ft. Microwave Hood Combination with  
TimeSaver™ Plus True Convection



<http://www.whirlpool.com>

**Key Features:**

- TimeSaver™ Plus True Convection Cooking System
- Steam Cooking
- Sensor Cooking
- AccuPop™ Cycle
- CleanRelease® Non-Stick Interior
- SteamClean Option
- Integrated Hidden Vent and Console
- Auto Adapt Fan
- Recessed, Stoppable Glass Turntable
- Universal Microwave Steamer
- 1.9 cu. ft. Capacity
- 1,100 Watts Cooking Power

**Product Dimensions:**

Height: 17 1/8

Width: 29 15/16

Depth: 18 1/2

**Electrical Requirements:**

15 or 20. 120 V.

**Additional Information:**

[Use And Care Guide](#)

[Installation Guide](#)

[Warranty Certificate](#)

Available in:

 Stainless Steel



©Registered trademark/TM Trademark of Whirlpool, U.S.A. © 2013 Whirlpool Corporation. All Rights Reserved.  
All other trademarks are owned by their respective companies.  
Because Whirlpool Corporation policy includes a continuous commitment to improve our products, we reserve the right to change materials and specifications without notice. We also reserve the right to discontinue or transition products without notice.  
Manufacturer's Suggested Retail Price (MSRP) and Minimum Advertised Price (MAP) provided for reference purposes only. Dealer alone determines advertised and retail prices.  
Created On: Monday, March 14, 2016 13:16:48

Suite 415  
Hampton

Upgrade  
Package 1



WDTA50SAHZ

Whirlpool®

<http://www.whirlpool.com>

Contemporary Design. Stainless Steel Tub  
Dishwasher with TotalCoverage Spray Arm

Key Features:


- Sensor Cycle
- TotalCoverage Spray Arm
- 1-Hour Wash Cycle
- Tap Touch Controls

Product Dimensions:

- Height: 34 1/2
- Width: 23 7/8
- Depth: 24 1/2

Additional Information:

- [Use And Care](#)
- [Dimension Guide](#)
- [Installation Guide](#)
- [Energy Guide](#)
- [Warranty](#)

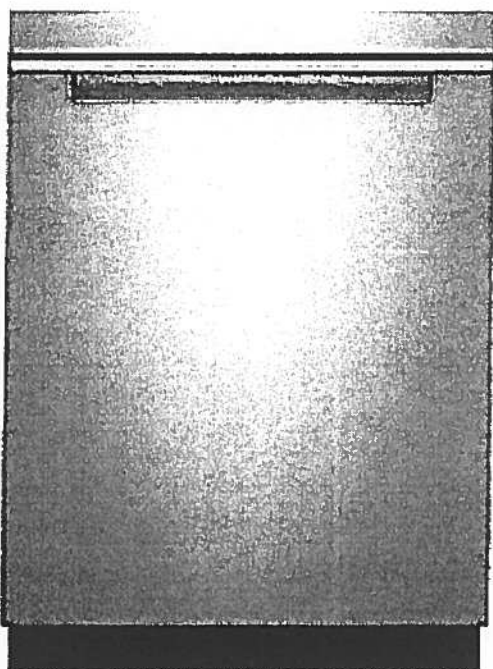

Available in:

● Black

Fingerprint Resistant Sunset Bronze

Fingerprint Resistant Black Stainless

○ White

Fingerprint Resistant Stainless Steel

INVESTED  
IN  
AMERICA



©Registered trademark/TM Trademark of Whirlpool, U.S.A. © 2016 Whirlpool Corporation. All Rights Reserved. All other trademarks are owned by their respective companies.

Because Whirlpool Corporation policy includes a continuous commitment to improve our products, we reserve the right to change materials and specifications without notice. We also reserve the right to discontinue or transition products without notice.

Manufacturer's Suggested Retail Price (MSRP) and Minimum Advertised Price (MAP) provided for reference purposes only. Dealer alone determines advertised and retail prices.

Suite 415  
Hampton

Upgrade  
Package I




WFW75HEFW

4.5 cu. ft. Front Load Washer with Precision  
Dispense



<http://www.whirlpool.com>

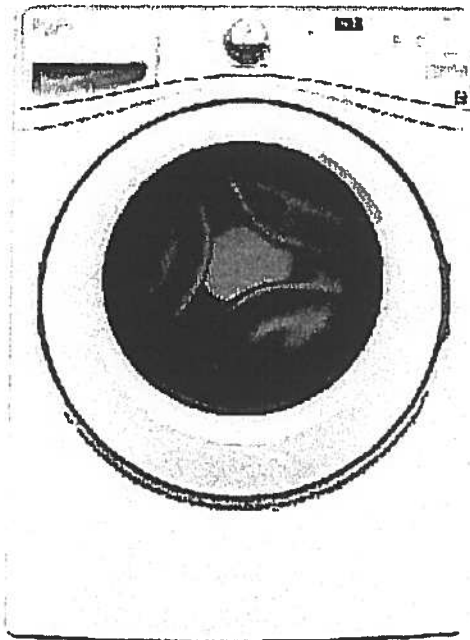

**Key Features:**

- Precision Dispense
- Adaptive Wash Technology
- Smooth Wave Stainless Steel Wash Basket
- 4.5 cu. ft. Capacity
- ENERGY STAR® Qualified

**Product Dimensions:**

Height: 39 3/4

Width: 27

Depth: 33 5/16

**Electrical Requirements:**

15 or 20. 120 V.

**Additional Information:**

[Use And Care Guide](#)

[Dimension Guide](#)

[Installation Guide](#)

[Energy Guide](#)

[Warranty Certificate](#)


INVESTED  
IN  
AMERICA



®Registered trademark/TM Trademark of Whirlpool, U.S.A. ©2013 Whirlpool Corporation All Rights Reserved.  
All other trademarks are owned by their respective companies.  
Because Whirlpool Corporation policy includes a continuous commitment to improve our products, we reserve the right to change materials and specifications without notice. We also reserve the right to discontinue or transition products without notice.  
Manufacturer's Suggested Retail Price (MSRP) and Minimum Advertised Price (MAP) provided for reference purposes only. Dealer alone determines advertised and retail prices.  
Created On: Wednesday, March 23, 2016 11:51:03

Suite 415  
Hampton

Upgrade  
Package 1

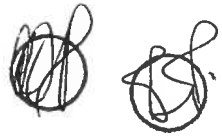


YWED75HEFW

8.5 cu. ft. Duet® High Efficiency Front Load Electric  
Dryer with ENERGY STAR®

MSRP: \$0.00

Whirlpool®

<http://www.whirlpool.com>

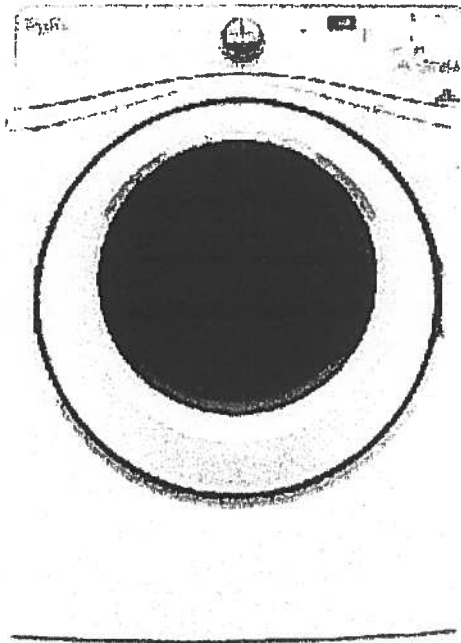

**Key Features:**

- Advanced Moisture Sensing System
- Quad Baffles
- Tap Touch Controls with Memory
- EcoBoost™ Option
- Wrinkle Shield™ Plus Option
- Undercounter Installation
- 7.4 Cu. Ft. Capacity
- ENERGY STAR® Qualified

**Product Dimensions:**

Height: 39

Width: 27

Depth: 31

**Additional Information:**

[Use And Care](#)

[Installation Guide](#)

[Warranty](#)

Available in:

☐ White

INVESTED  
IN  
AMERICA

ADA  
Compliant

®Registered trademark/TM Trademark of Whirlpool, U.S.A. © 2016 Whirlpool Corporation All Rights Reserved. All other trademarks are owned by their respective companies.

Because Whirlpool Corporation policy includes a continuous commitment to improve our products, we reserve the right to change materials and specifications without notice. We also reserve the right to discontinue or transition products without notice.

Manufacturer's Suggested Retail Price (MSRP) and Minimum Advertised Price (MAP) provided for reference purposes only. Dealer alone determines advertised and retail prices.

# Countertop Edges

Suite 415  
Hampton



**CONNOLLY** Marble & Granite Ltd.

EDGE  
DETAILS


004

A.




STRAIGHT EDGE  
(STANDARD - 3/4")

Standard:  
Kitchen  
Main Bath  
Master Ensuite

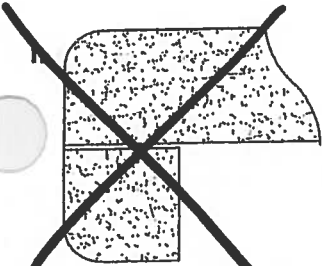

DOUBLE TOP "D" EDGE  
(STANDARD - 1 1/2")

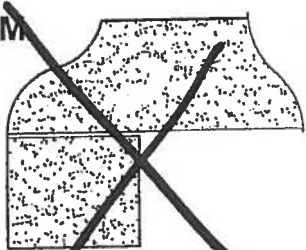

OEGEE - SQUARE EDGE  
(MED./HIGH - 1 1/2")

EDGING UP-GRADE OPTIONS