


SUITE 501/502 - INVENTORY SUITE

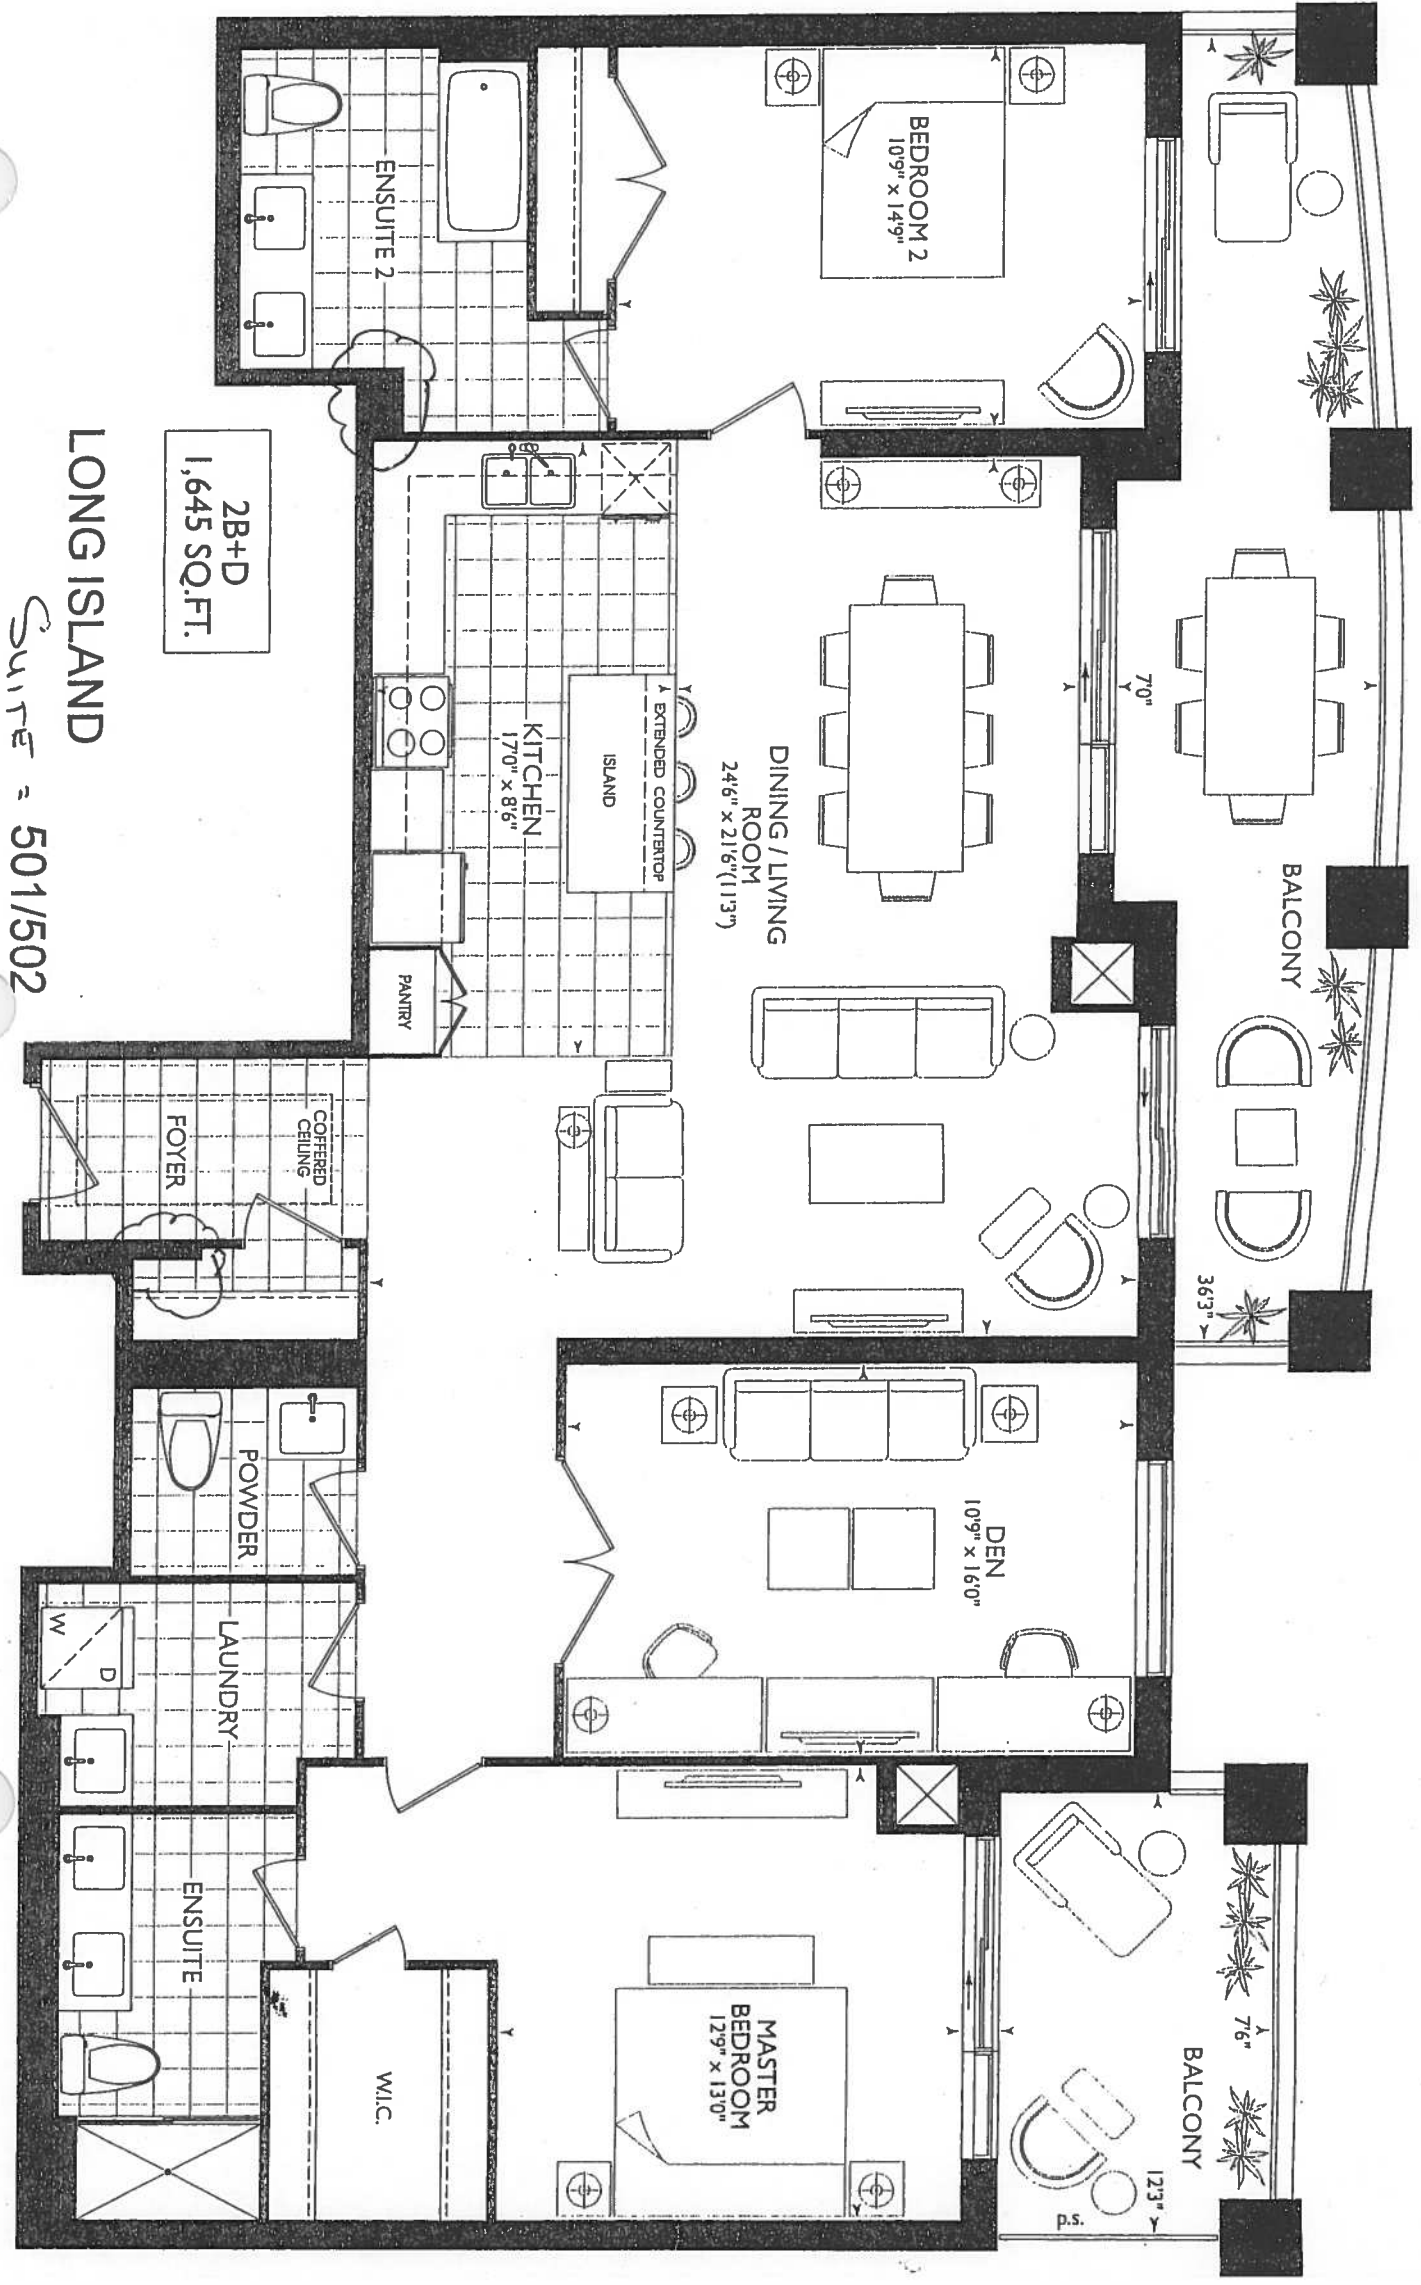

LONG ISLAND

Suite = 501/502

KITCHEN

OSTD KITCHEN LAYOUT

STD APPARANCE PKG.

• $(x^2) = \text{PLUGS}$ ISLAND

- $(x_2) = \text{PENDANT}$

ONEST
ISLAND

• (x5) Puck Lights

84" stove PIPE



• 58" sink pipe



- OPTIONAL

KITCHEN + Appliance
PVG.


(see upg KIT. layout)

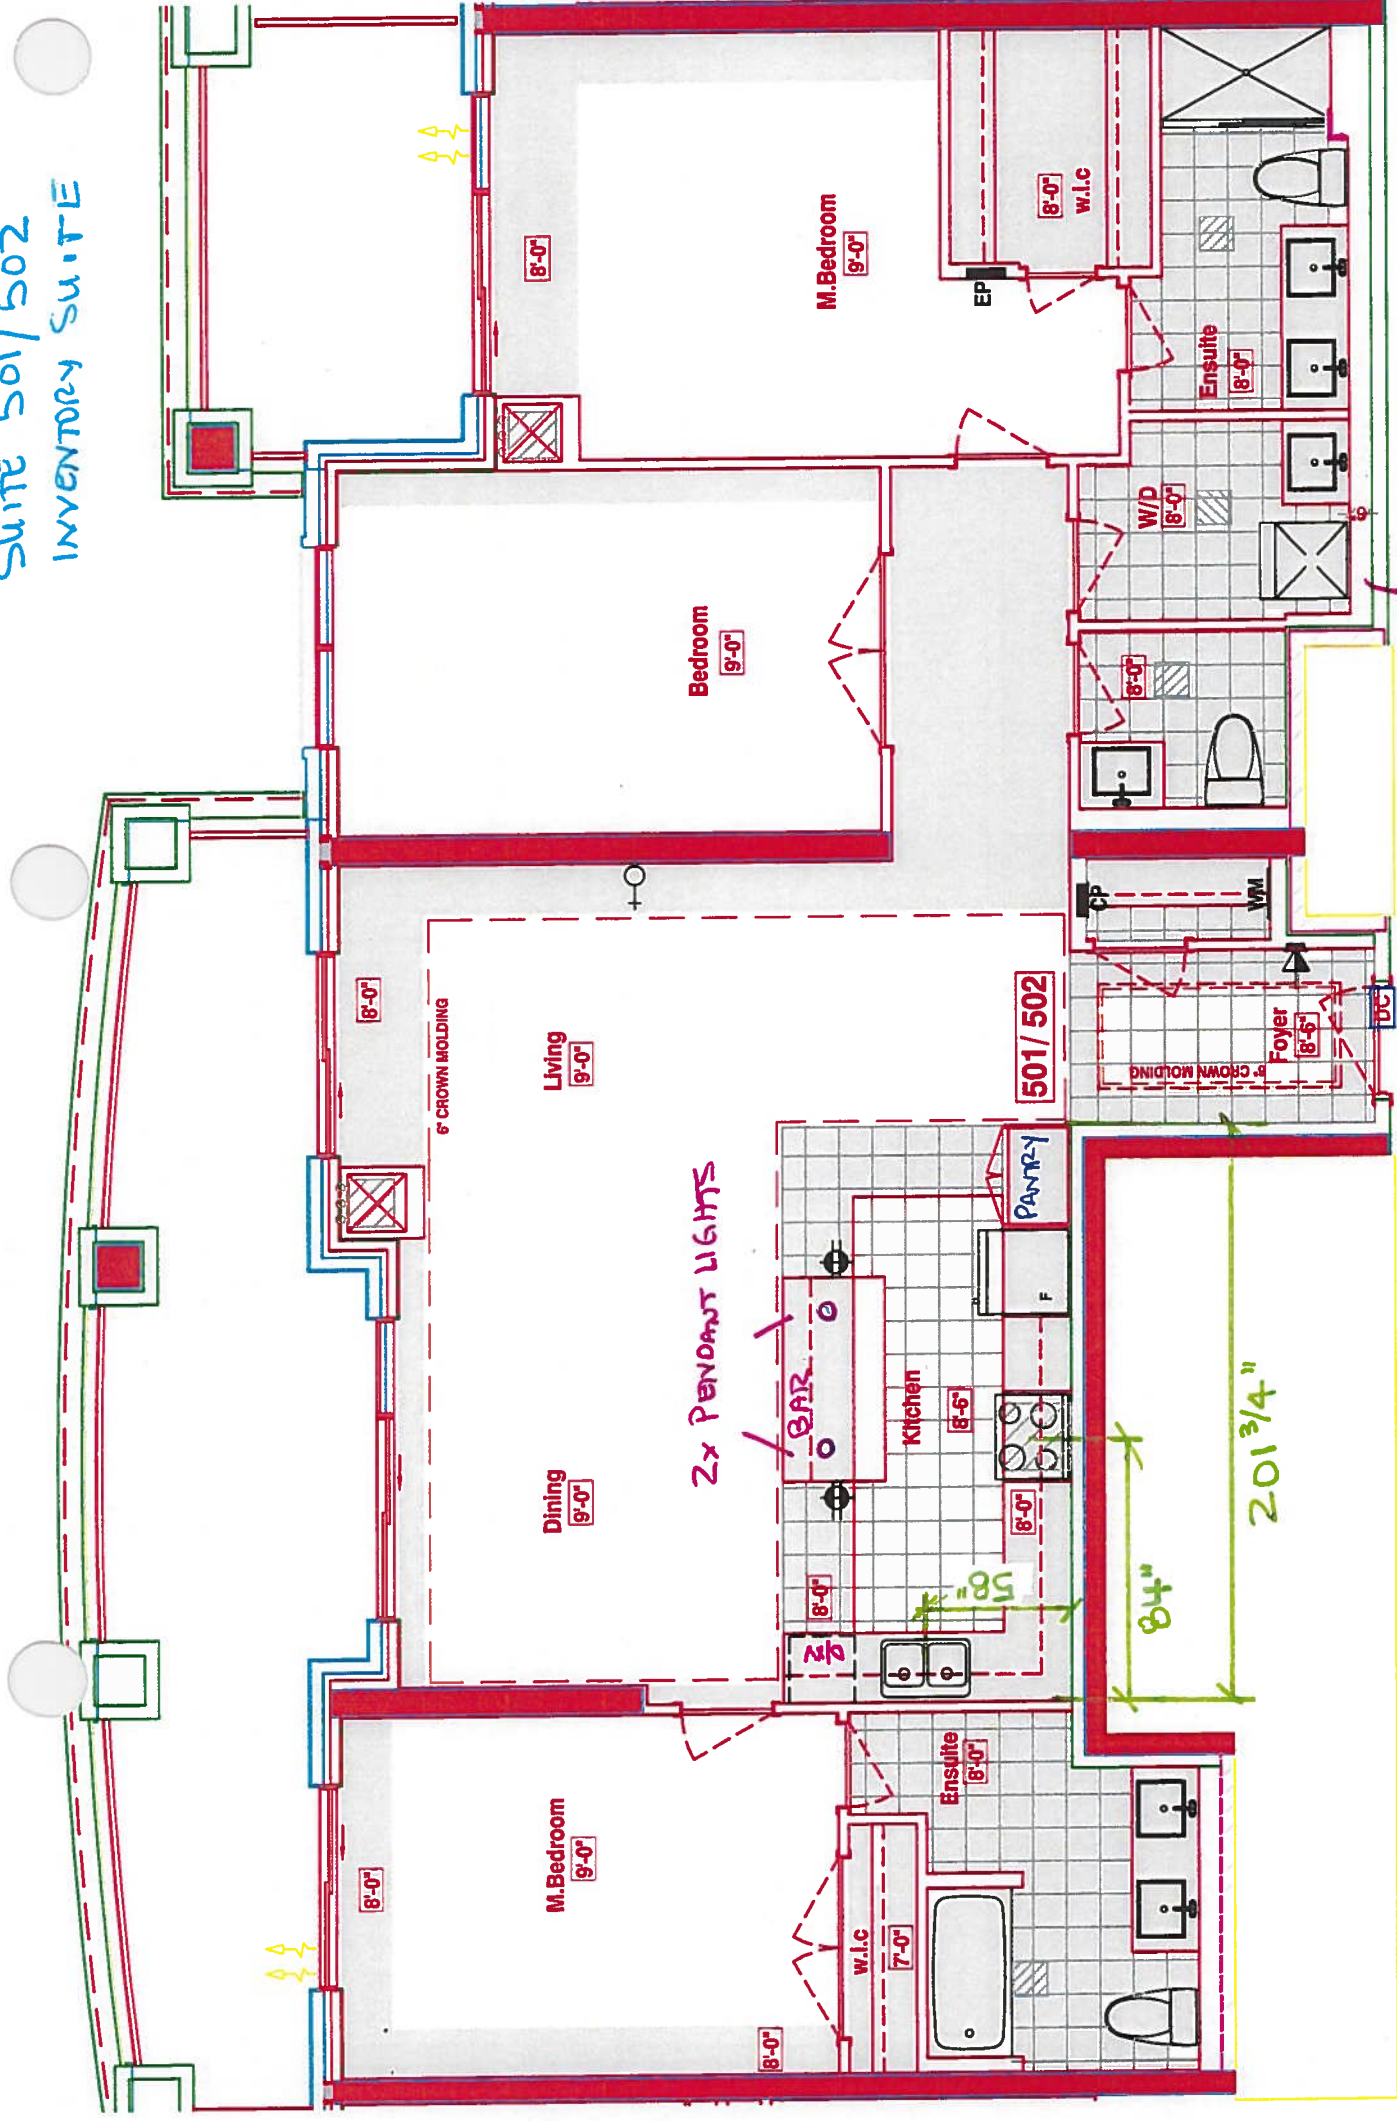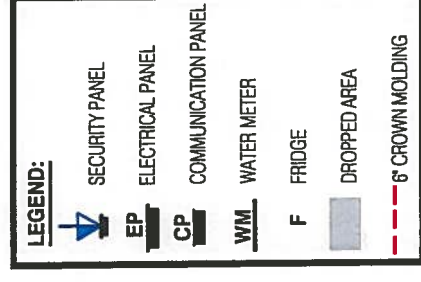

- 2x6 wall BEHIND WASH/DREYER


501/502 - INVENTORY SUITE

- STD KIT LAYOUT
- STD APPLIANCE PACKAGE
- (x2) - PLUGS ISLAND
- (x2) - PENDANT LIGHTS CAPPED OVER ISLAND
- (x5) - PUCK LIGHTS


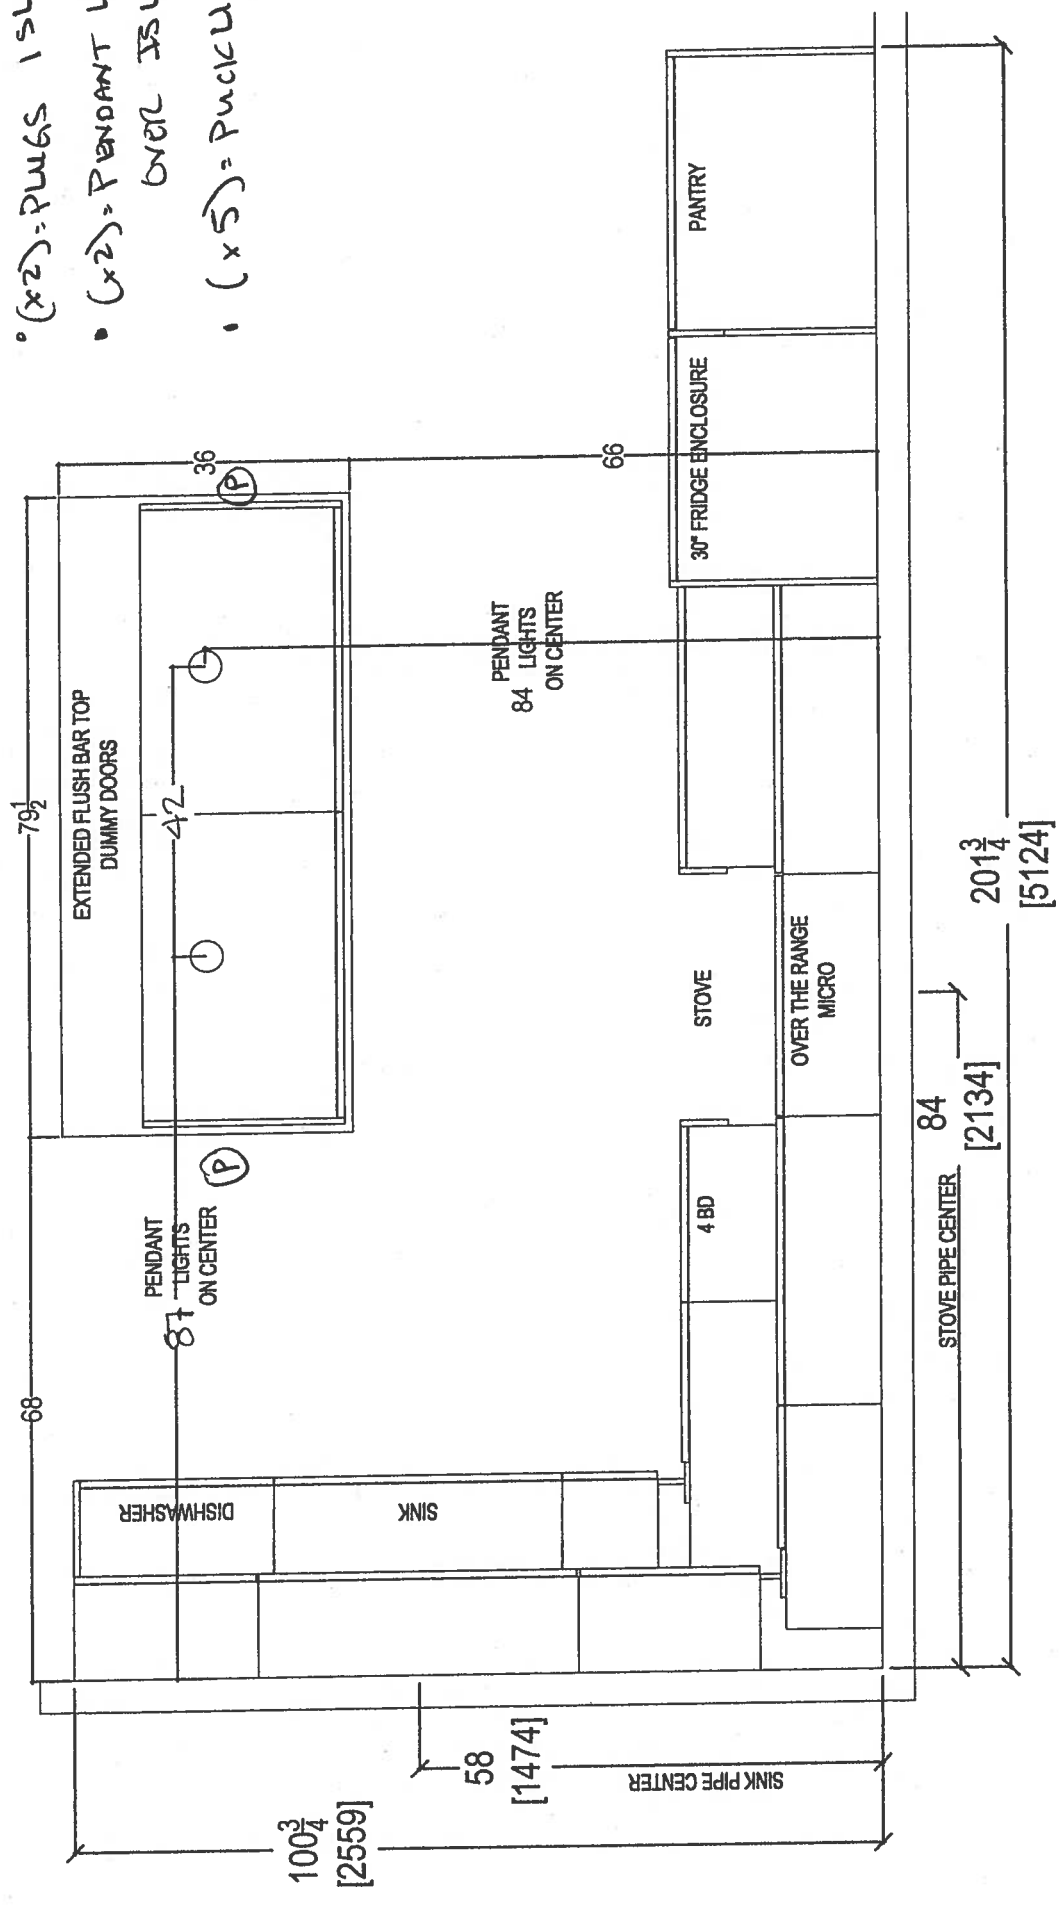


80 SANTE DRIVE, VAUGHAN, ON L4K 3C4,
T: 416.748.1811 F: 905.781.5901

CLIENT: ROYAL PINE HOMES		UNIT 501/502 HMP STD	ROOM:	KITCHEN FLOOR PLAN	DRAWN BY: SK	COMMENTS:	
SITE: HAMPTON PLACE	DOOR STYLE: --	DOOR HANDLE: --	SCALE: 1/2" = 1'-0"	PLEASE NOTE ALL DIMENSIONS ARE NOT FINAL AND ARE SUBJECT TO CHANGE UPON FINAL SITE MEASURE			
PHONE: --	FINISH: --	DRW HANDLE: --	DATE: MAR 7, 2018				
EMAIL: --	SPECIES: --	TOP: --	PAGE: --				

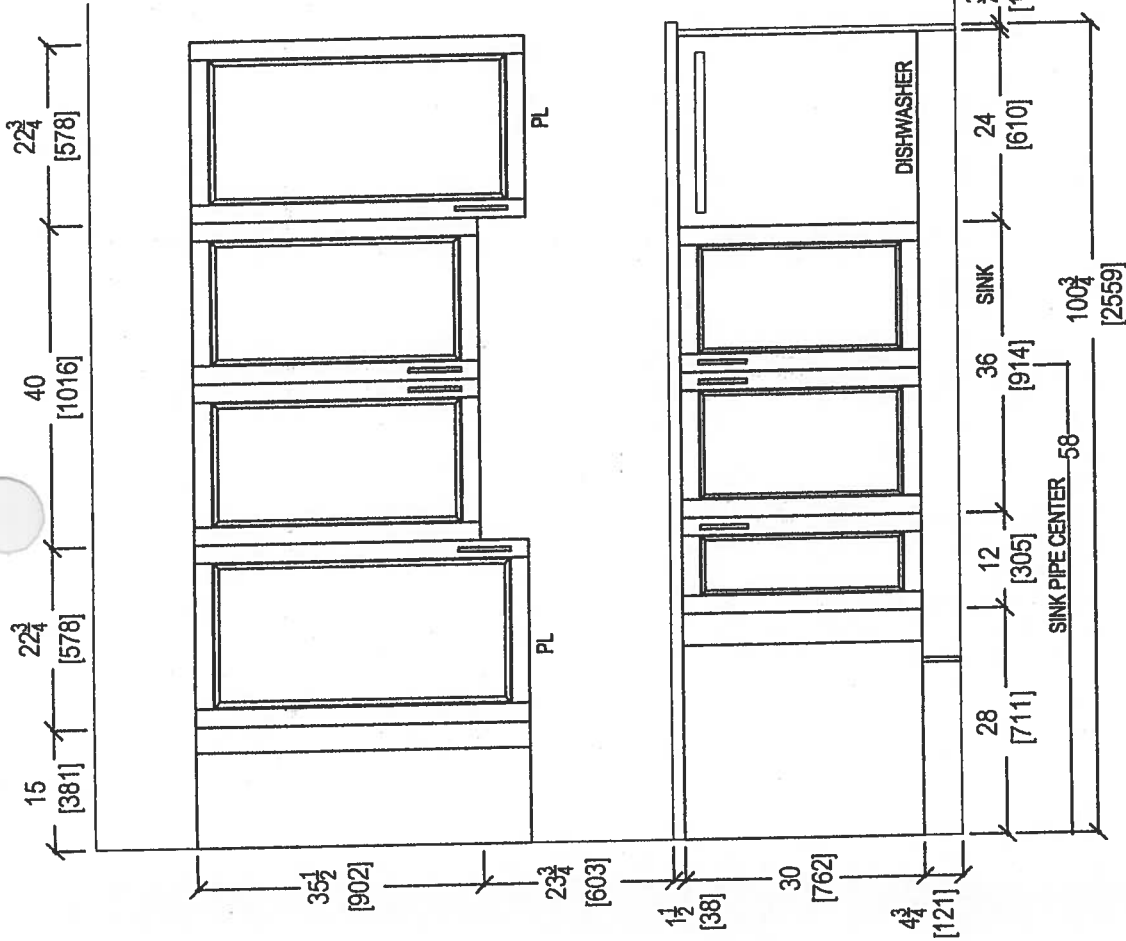


 QTK Your kitchen, your taste. 80 SANTE DRIVE, VAUGHAN, ON L4K 3C4, T: 416.748.1811 F: 905.761.5901		CLIENT: ROYAL PINE HOMES SITE: HAMPTON PLACE PHONE: — EMAIL: —	UNIT 501/502 HMP DOOR STYLE: — FINISH: — SPECIES: —	ROOM: KITCHEN FLOOR PLAN DOOR HANDLE: — DRW HANDLE: — TOP: —	DRAWN BY: SK SCALE: 1/2" = 1' - 0" DATE: MAR 7, 2018 PAGE: —	COMMENTS: PLEASE NOTE ALL DIMENSIONS ARE NOT FINAL AND ARE SUBJECT TO CHANGE UPON FINAL SITE MEASURE
---	--	--	---	--	--	--

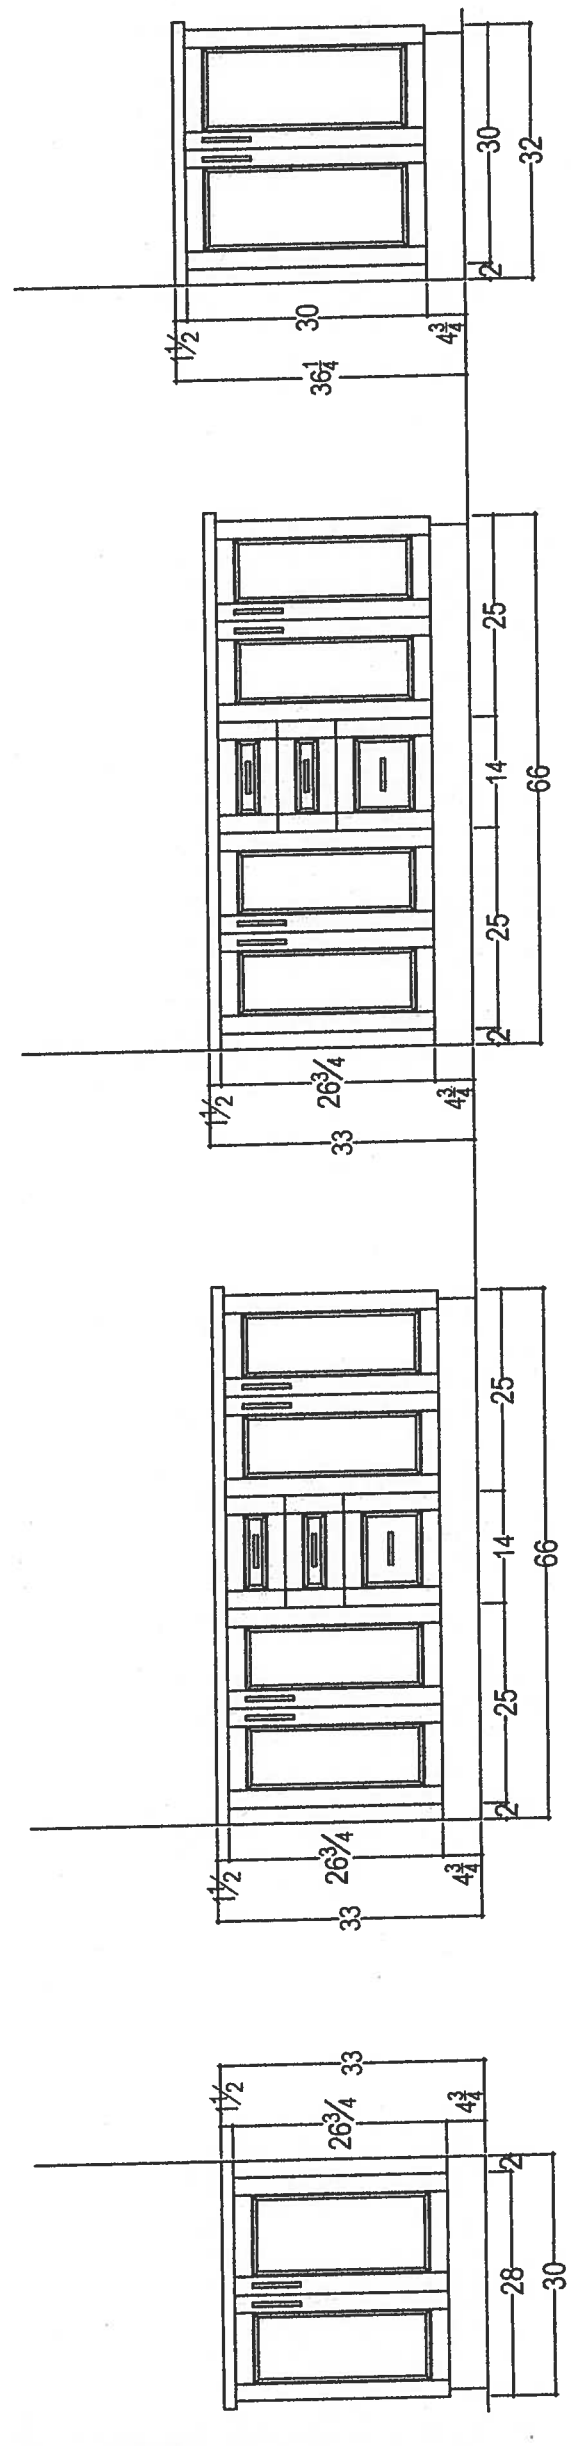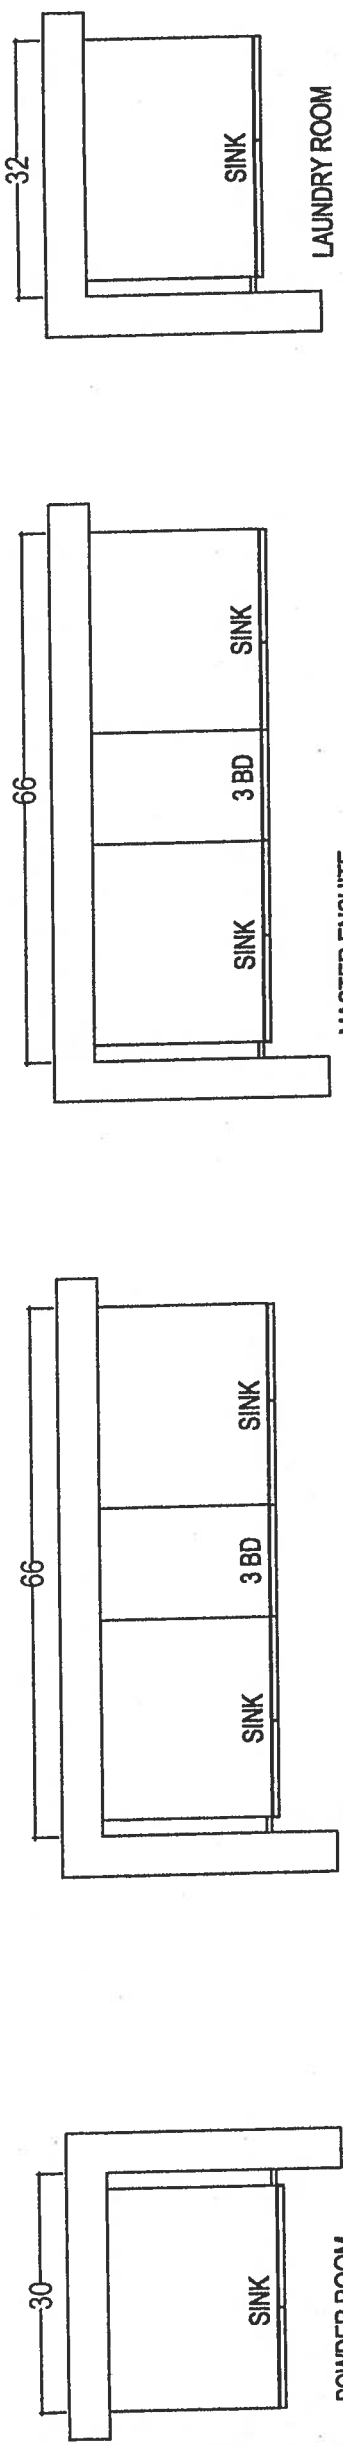


 your kitchen, your taste. 80 SANTE DRIVE, VAUGHAN, ON L4K 3C4. T: 416.746.1811 F: 905.761.5601	CLIENT: ROYAL PINE HOMES		UNIT 501/502 HMP	ROOM:	KITCHEN FLOOR PLAN	DRAWN BY: SK	COMMENTS: PLEASE NOTE ALL DIMENSIONS ARE NOT FINAL AND ARE SUBJECT TO CHANGE UPON FINAL SITE MEASURE
	SITE:	HAMPTON PLACE	DOOR STYLE: —	DOOR HANDLE: —		SCALE: 1/2" = 1' - 0"	
	PHONE: —		FINISH: —	DRW HANDLE: —		DATE: MAR 7, 2018	
	EMAIL: —		SPECIES: —	TOP: —		PAGE: —	

501/502 Inventory Suite

- UPG #1 - KITCHEN LAYOUT
- UPG #2 - APPLIANCE PKGS.
- (x2) = PLUGS ISLAND
- (x2) = CAPPED PENDANT LIGHTS OVER ISLAND
- (x6) = PUCK LIGHTS

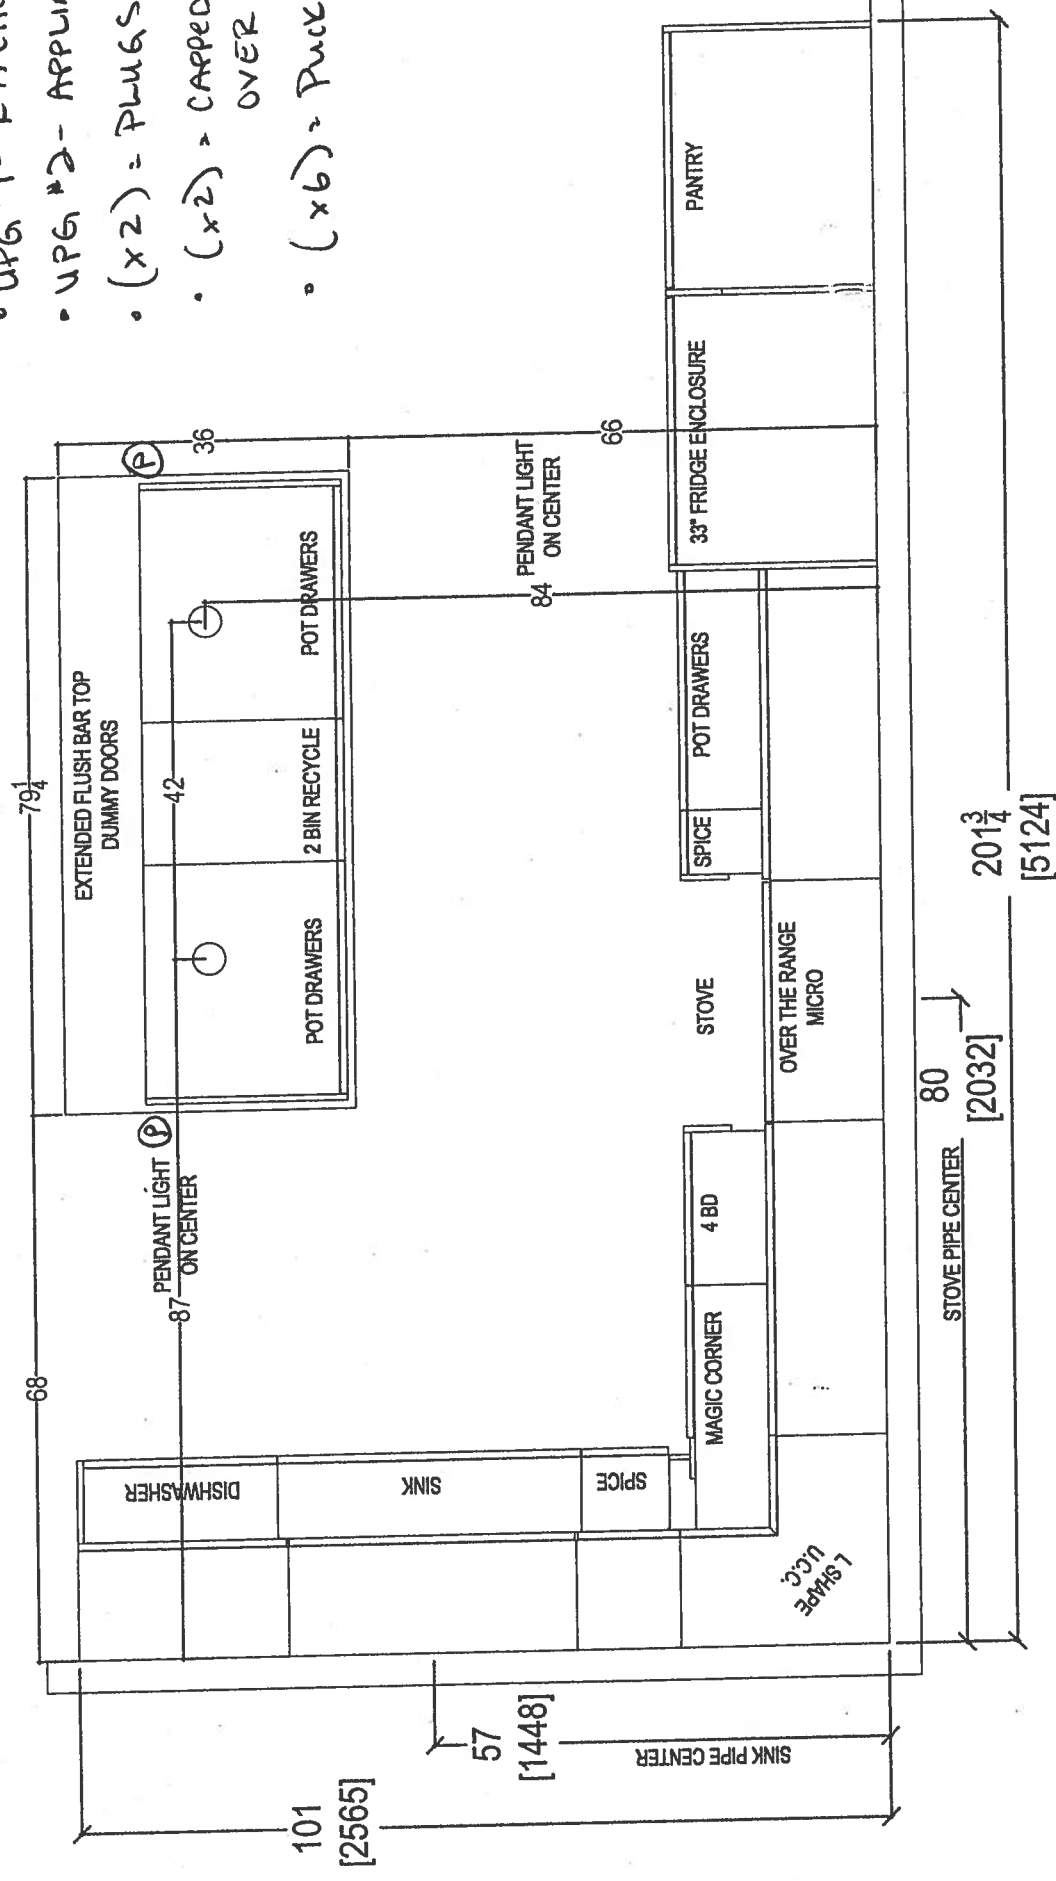

 <i>your kitchen. your taste.</i> 80 SANTE DRIVE, VAUGHAN, ON L4K 3C4, T: 416.746.1811 F: 905.781.5901	CLIENT: ROYAL PINE HOMES	UNIT 501/502 HMP <i>UPGRADE PKG</i>	ROOM:	KITCHEN FLOOR PLAN	DRAWN BY: SK	COMMENTS: PLEASE NOTE ALL DIMENSIONS ARE NOT FINAL AND ARE SUBJECT TO CHANGE UPON FINAL SITE MEASURE
	SITE: HAMPTON PLACE	DOOR STYLE: —	DOOR HANDLE: —	SCALE: 1/2" = 1' - 0"		
	PHONE: —	FINISH: —	DRW HANDLE: —	DATE: MAR 7, 2018		
	EMAIL: —	SPECIES: —	TOP: —	PAGE: —		








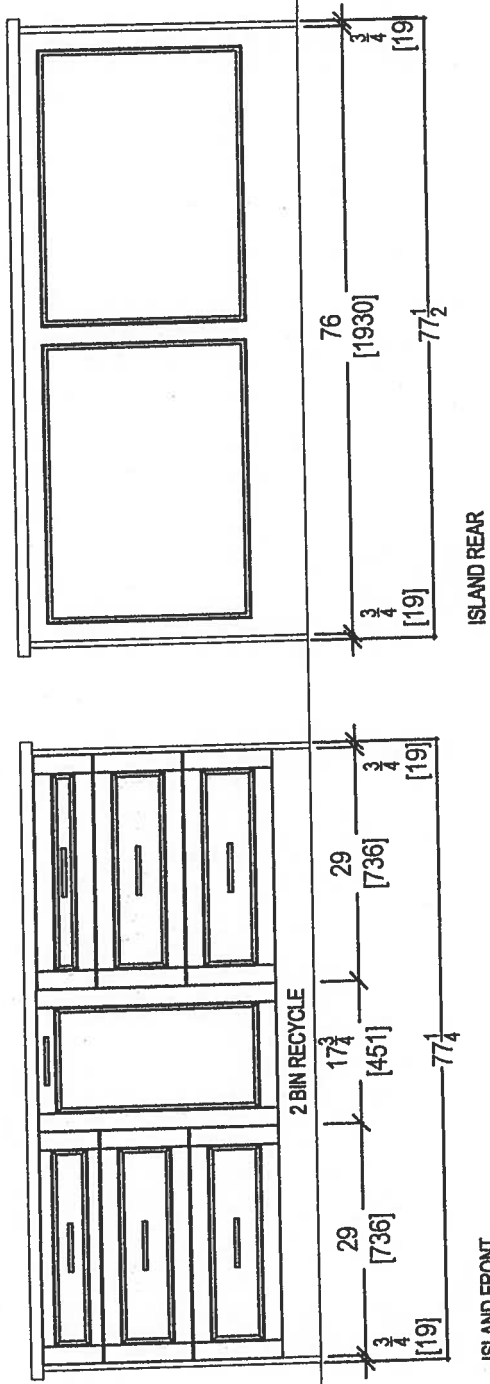




your kitchen. your taste.

80 SANTE DRIVE, VAUGHAN, ON L4K 3C4,
T: 416.746.1811 F: 905.761.5901

CLIENT: ROYAL PINE HOMES	UNIT 501/502 HMP UPGRADE PLS	ROOM:	KITCHEN FLOOR PLAN	DRAWN BY: SK	COMMENTS: PLEASE NOTE ALL DIMENSIONS ARE NOT FINAL AND ARE SUBJECT TO CHANGE UPON FINAL SITE MEASURE
SITE: HAMPTON PLACE	DOOR STYLE: ---	DOOR HANDLE: ---	SCALE: 1/2" = 1' - 0"		
PHONE: ---	FINISH: ---	DRW HANDLE: ---	DATE: MAR 7, 2018		
EMAIL: ---	SPECIES: ---	TOP: ---	PAGE: ---		

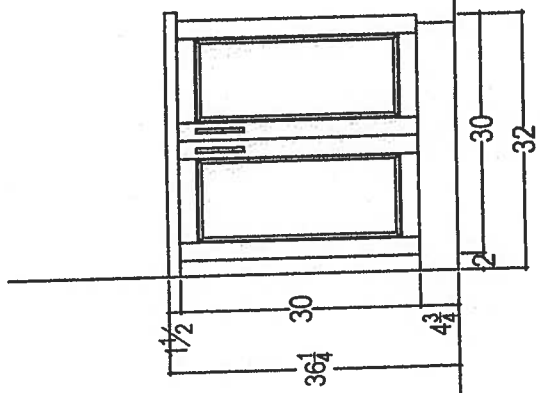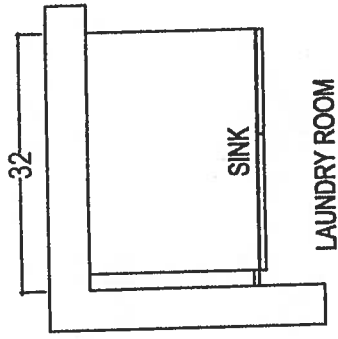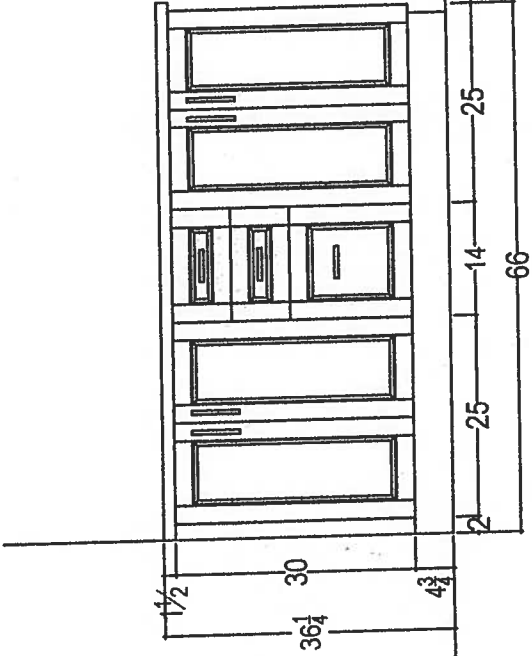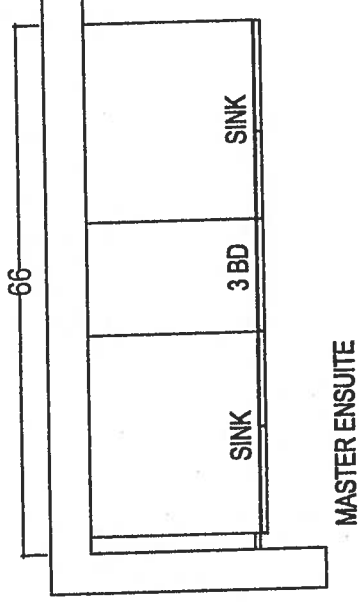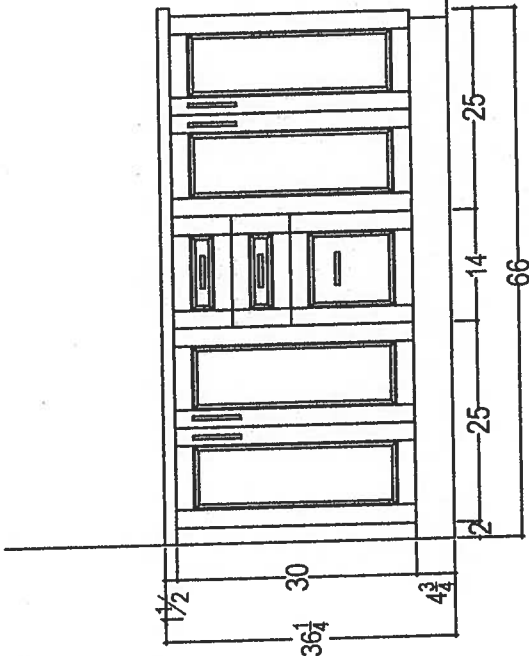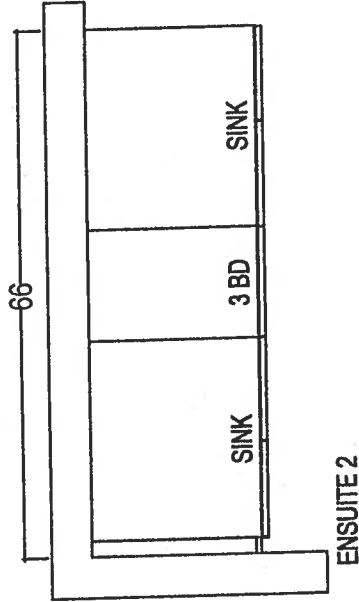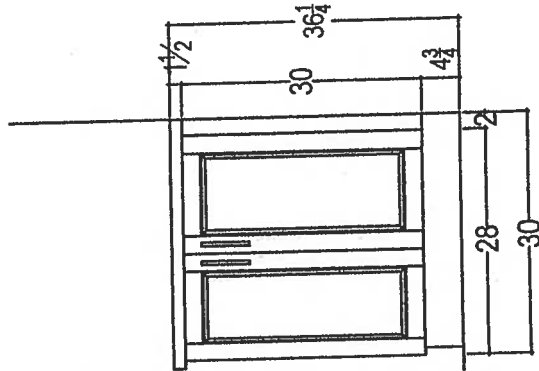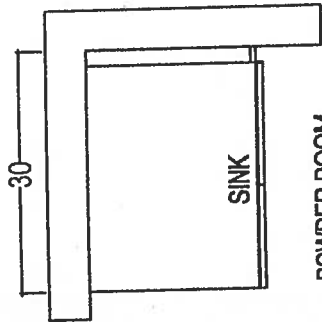

80 SANTE DRIVE, VAUGHAN, ON L4K 3C4,
T: 416.746.1811 F: 905.761.5801

CLIENT: ROYAL PINE HOMES		UNIT 501/502 HMP	UPPER FLS	ROOM:	VANITIES	DRAWN BY: SK	COMMENTS: PLEASE NOTE ALL DIMENSIONS ARE NOT FINAL AND ARE SUBJECT TO CHANGE UPON FINAL SITE MEASURE
SITE:	HAMPTON PLACE	DOOR STYLE:	—	DOOR HANDLE:	—	SCALE: 1/2" = 1' - 0"	
PHONE:	—	FINISH:	—	DRW HANDLE:	—	DATE: MARCH 7, 2018	
EMAIL:	—	SPECIES:	—	TOP:	—	PAGE: —	