



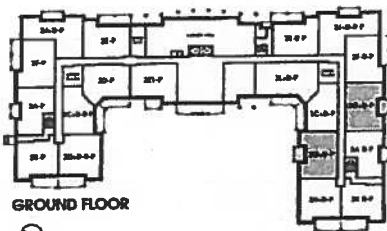


Noyac Bay

1,121 SQ FT *plus 81 sq. ft. of balcony area*


SUITE 511 - INVENTORY
OLD ORIGINAL
SUITE LAYOUT

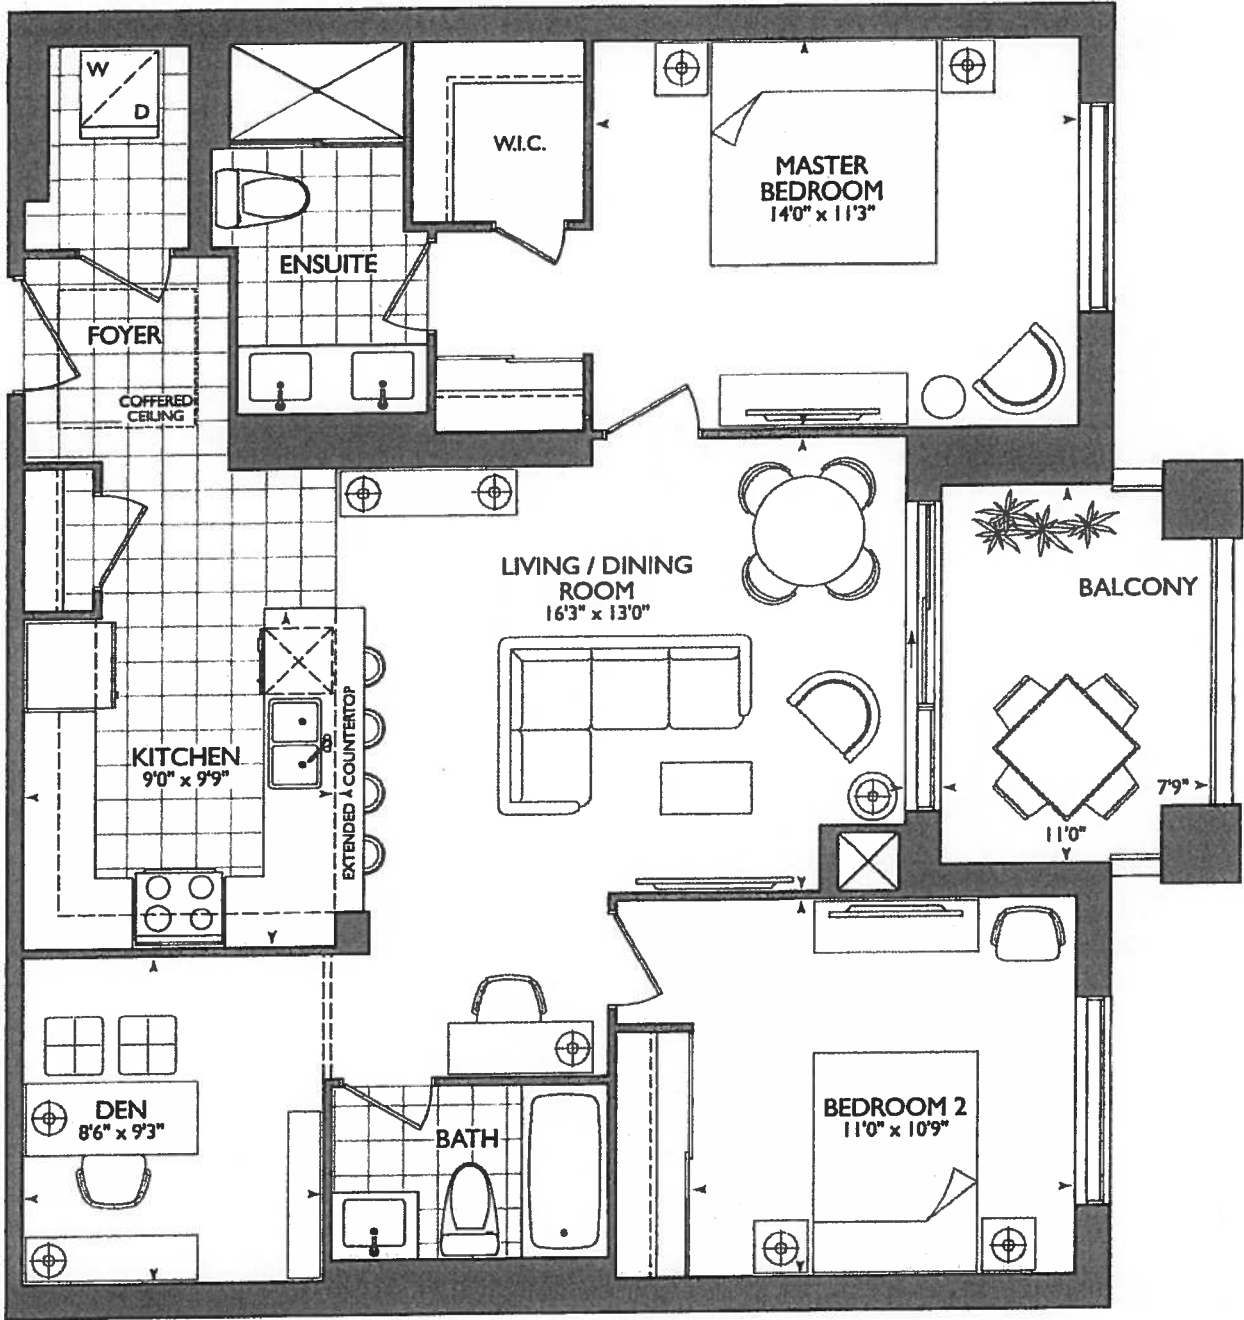

GROUND FLOOR

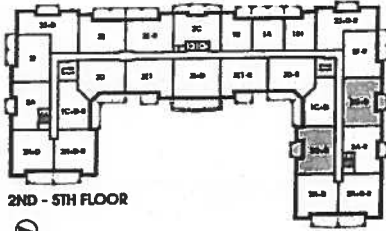

2ND - 5TH FLOOR

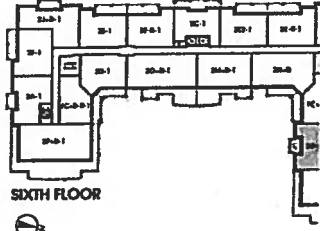

SIXTH FLOOR







Noyac Bay

1,121 SQ FT *plus* 76 sq. ft. of balcony area


SUITE 511
ORIGINAL LAYOUT
INVENTORY SUITE
NEXT LAYOUT

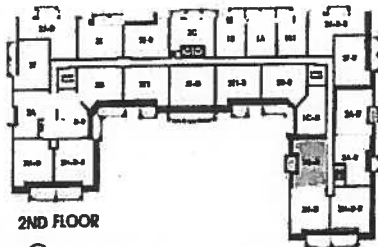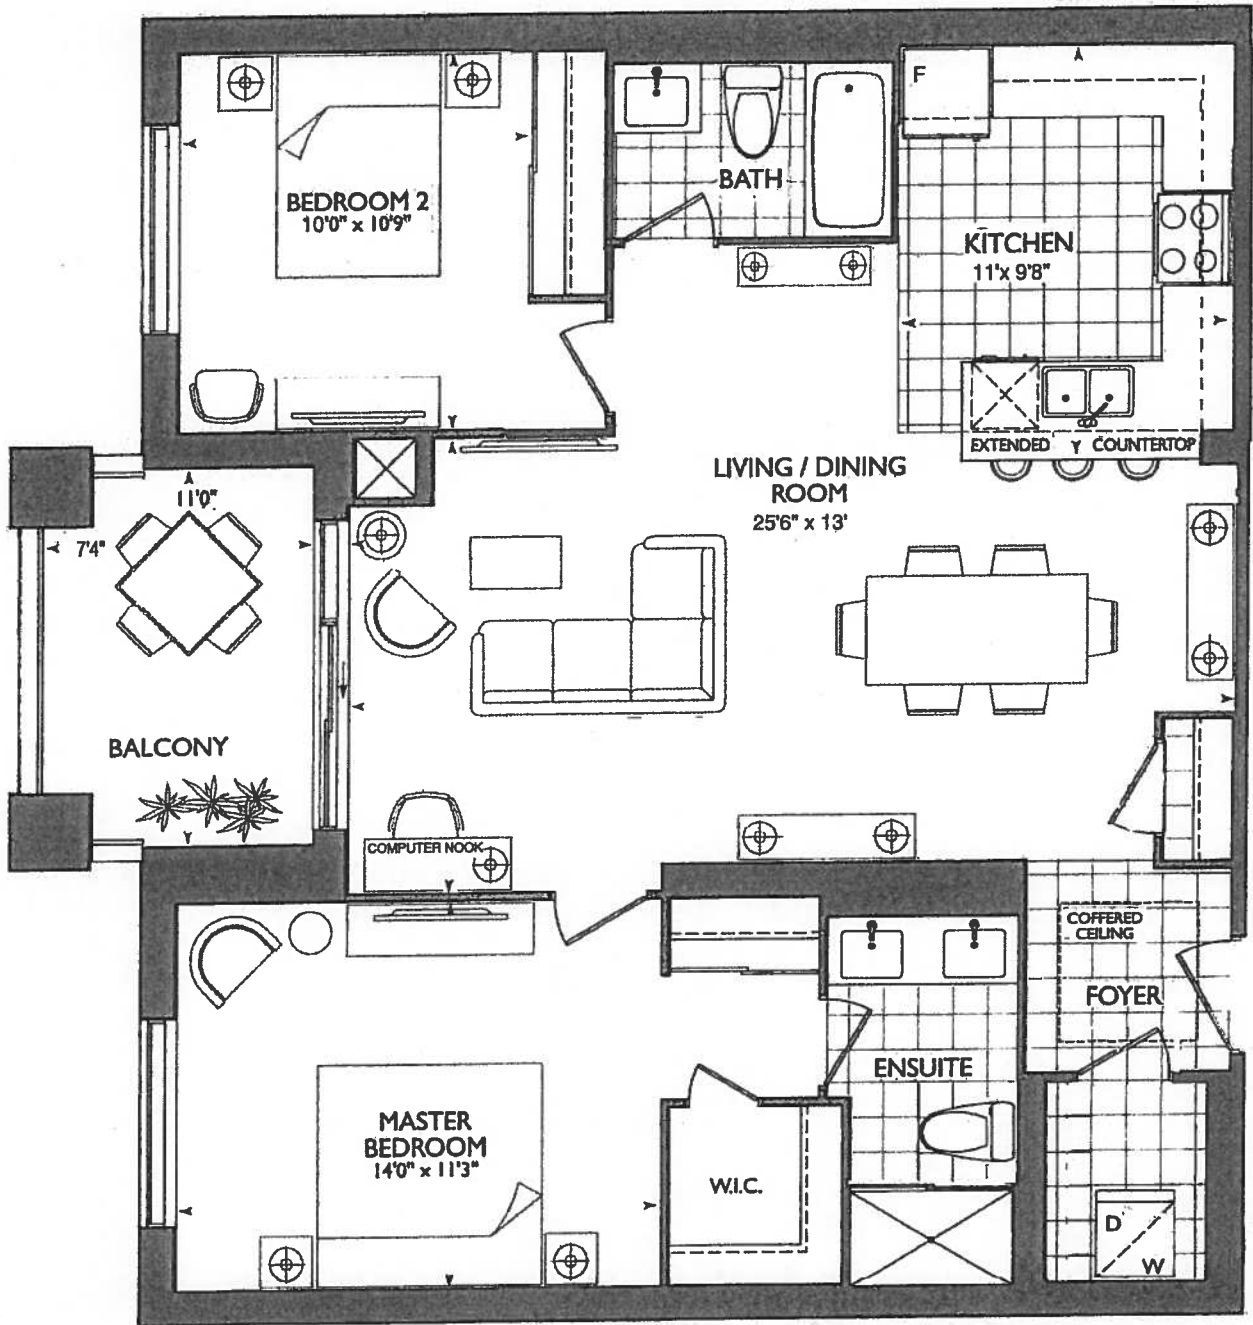

2ND FLOOR



3ND - 5TH FLOOR

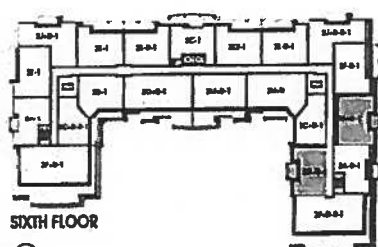

SIXTH FLOOR

Plans and specifications are subject to change without notice. Actual usable floor space may vary from the stated floor area. All renderings are artist's concept E. & O. E.



*** KITCHEN ***

CHOICE OF STD. KITCHEN LAYOUT, WITH
STD. APPLIANCE PACKAGE

OR

CAN UPGRADE AT DECOR CENTER

- (x2) CAPPED PENDANT
- (x1) PLUG PENINSULA
- (x) PUCK LIGHTS


***SEE ATTACHED UPG.**

**#1- KITCHEN LAYOUT WITH 1ST UPG.
APPLIANCE PACKAGE**

*** SUITE 511 * (INVENTORY SUITE)**

- NEW TUB
- REMOVED DEN
- REVISED KITCHEN


***REVISED LAUNDRY DOOR SWING &
ENSUITE WALL AS PER THIS BROCHURE**

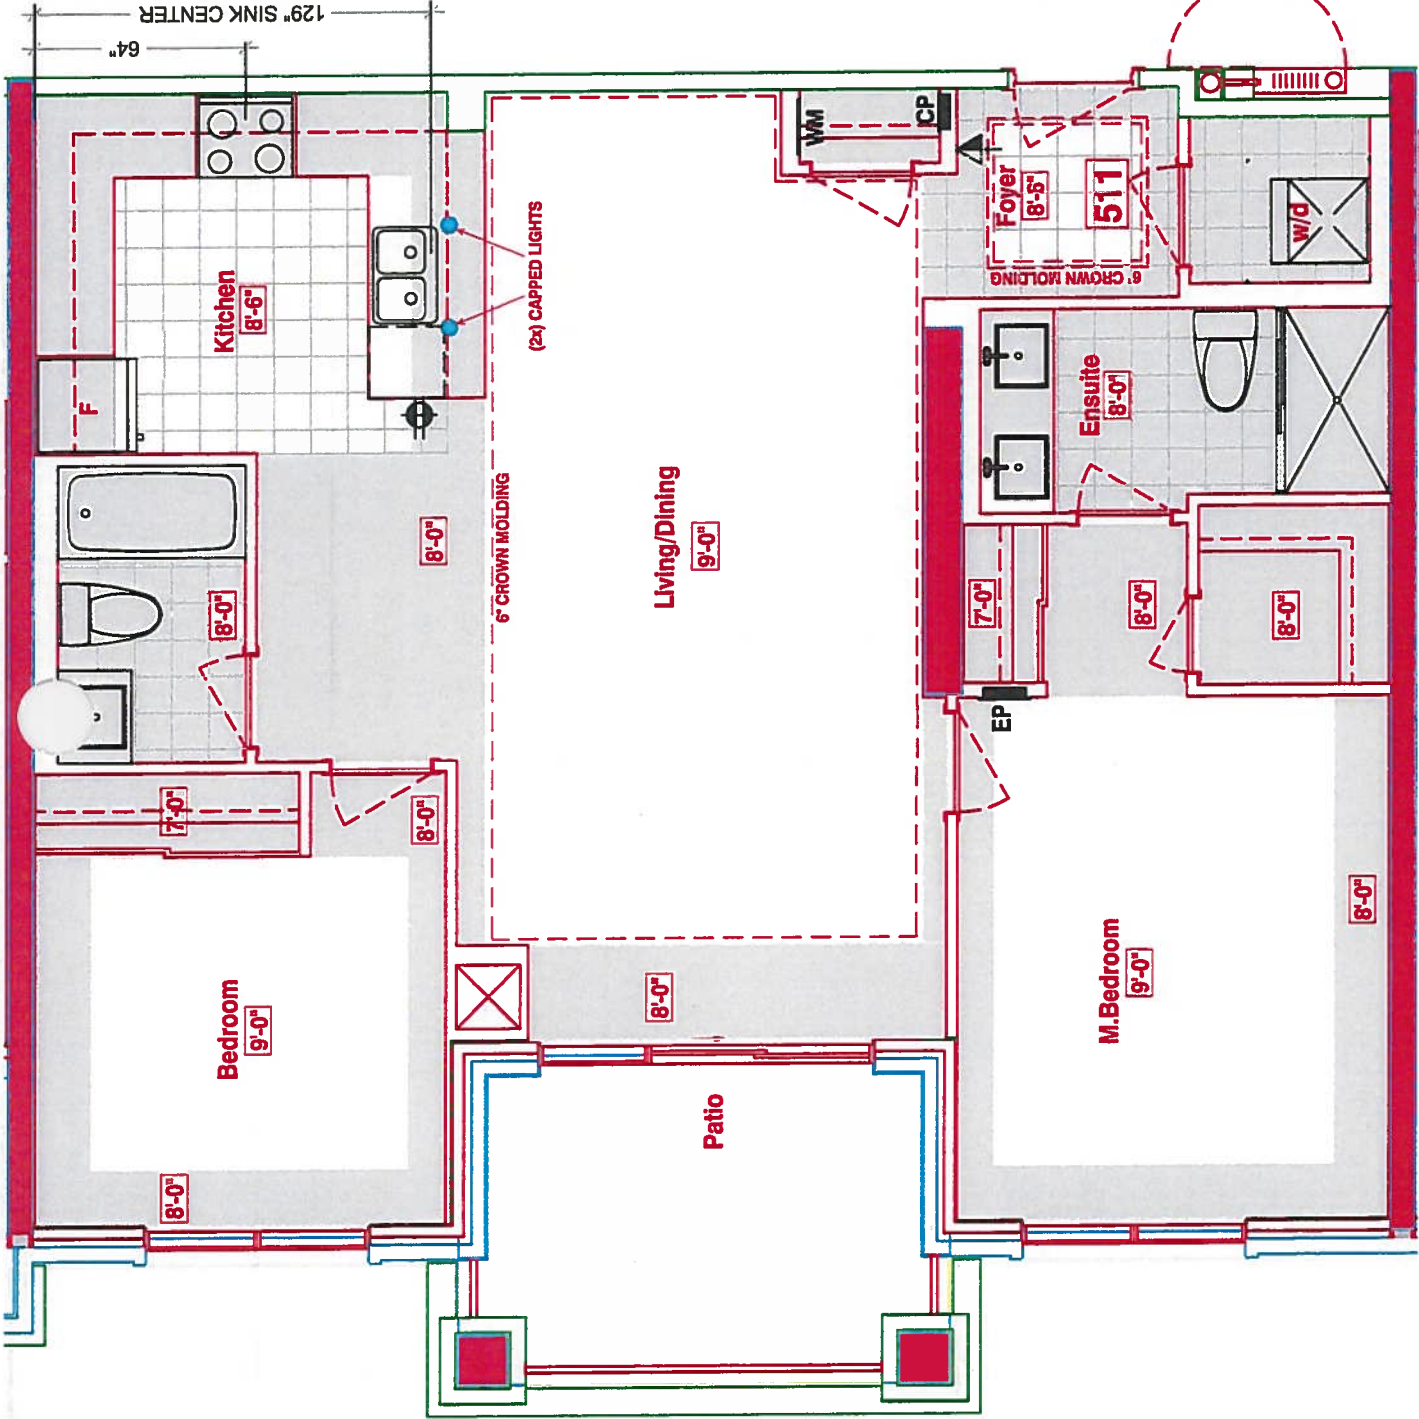

SUITES 511 - NOYAC BAY (Inventory Suite)

Royal Pine Homes 25 Baker Hill Blvd - Stouffville, ON Apr 04, 2018

116
[2946]

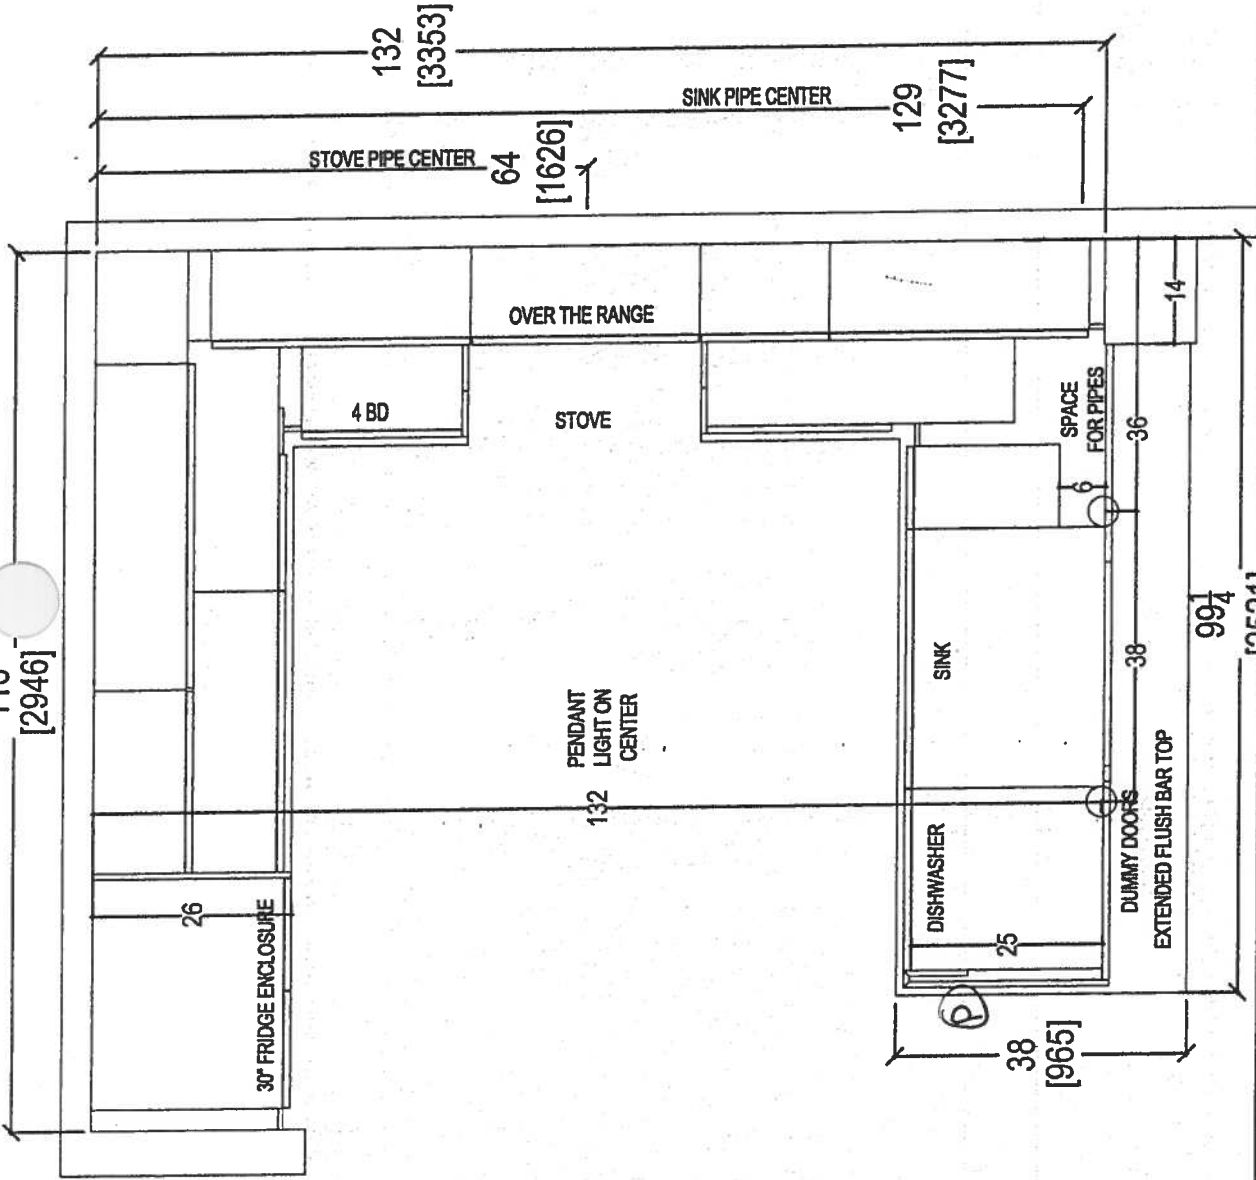


Suite 311- INVENTORY
Suite

- STO KITCHEN LAYOUT
- STO APPLIANCE PACKAGE
- (x1) = PLUG PENINSULA
- (x2) = CAPPED PENDANT LIGHTS
- (x5) = PUCK LIGHTS




80 SANTE DRIVE, VAUGHAN, ON L4K 3C4,
T: 416.748.1811 F: 905.781.5901

CLIENT: ROYAL PINE HOMES		NOYAC BAY (2G)	ROOM:	KITCHEN FLOOR PLAN	DRAWN BY: SK	COMMENTS: PLEASE NOTE ALL DIMENSIONS ARE NOT FINAL AND ARE SUBJECT TO CHANGE UPON FINAL SITE MEASURE
SITE: HAMPTON PLACE	DOOR STYLE: —	DOOR HANDLE: —	SCALE: 1/2" = 1' - 0"			
PHONE: —	FINISH: —	DRW HANDLE: —	DATE: MARCH 8, 2018			
EMAIL: —	SPECIES: —	TOP: —	PAGE: —			

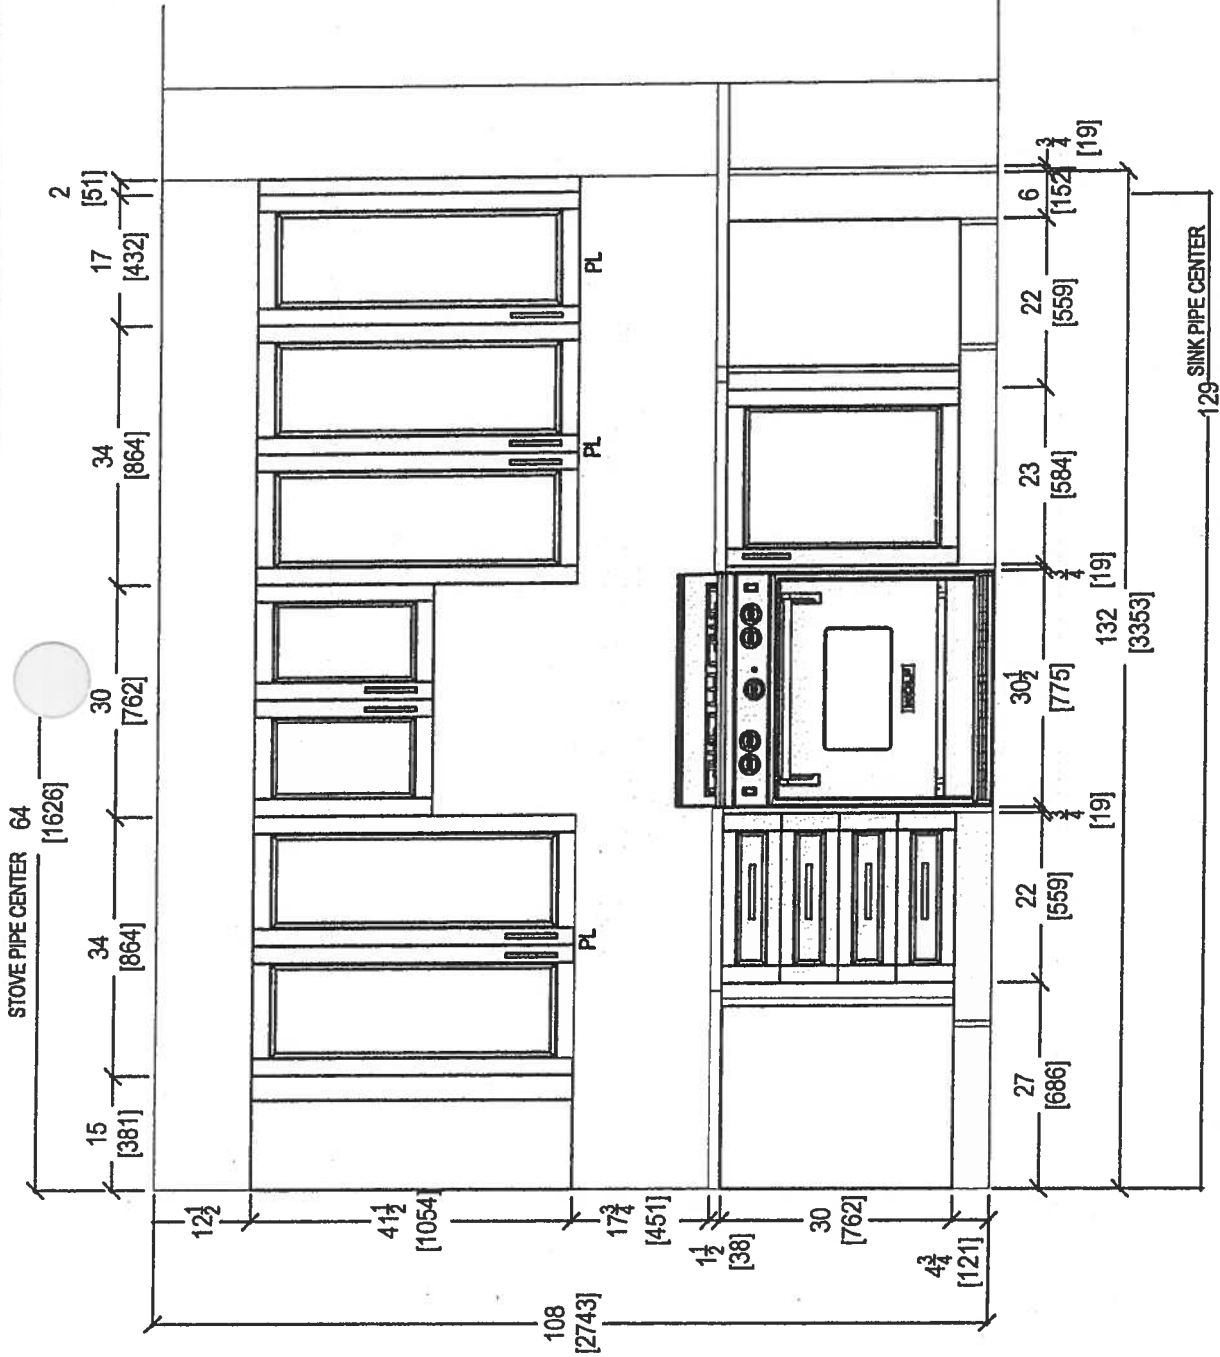

80 SANTE DRIVE, VAUGHAN, ON L4K 3C4,
T: 416.746.1811 F: 905.761.5901

CLIENT: ROYAL PINE HOMES		NOYAC BAY (2G)	ROOM: KITCHEN	DRAWN BY: SK	COMMENTS: PLEASE NOTE ALL DIMENSIONS ARE NOT FINAL AND ARE SUBJECT TO CHANGE UPON FINAL SITE MEASURE
SITE: HAMPTON PLACE	DOOR STYLE: —		DOOR HANDLE: —	SCALE: 1/2" = 1' - 0"	
PHONE: —	FINISH: —		DRW HANDLE: —	DATE: MARCH 8, 2018	
EMAIL: —	SPECIES: —		TOP: —	PAGE: —	

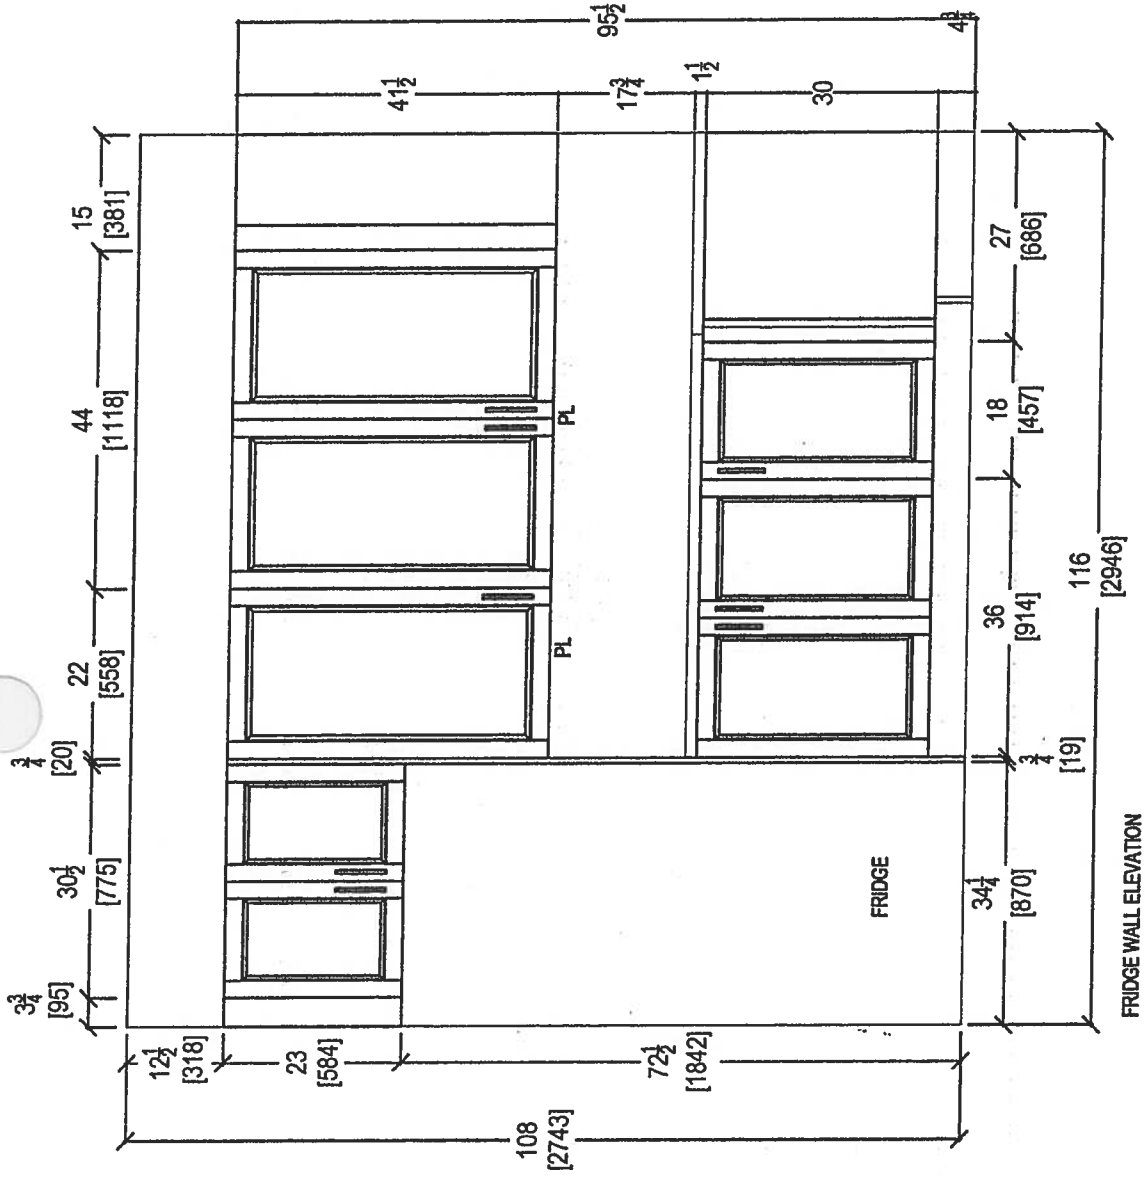

CLIENT: ROYAL PINE HOMES
SITE: HAMPTON PLACE
PHONE: —
EMAIL: —



NOYAC BAY (2G)
DOOR STYLE: —
FINISH: —
SPECIES: —

ROOM: KITCHEN
DOOR HANDLE: —
DRW HANDLE: —
TOP: —

DRAWN BY: SK
SCALE: 1/2" = 1' - 0"
DATE: MARCH 8, 2018
PAGE: —

COMMENTS:

PLEASE NOTE ALL DIMENSIONS
ARE NOT FINAL AND ARE
SUBJECT TO CHANGE UPON
FINAL SITE MEASURE

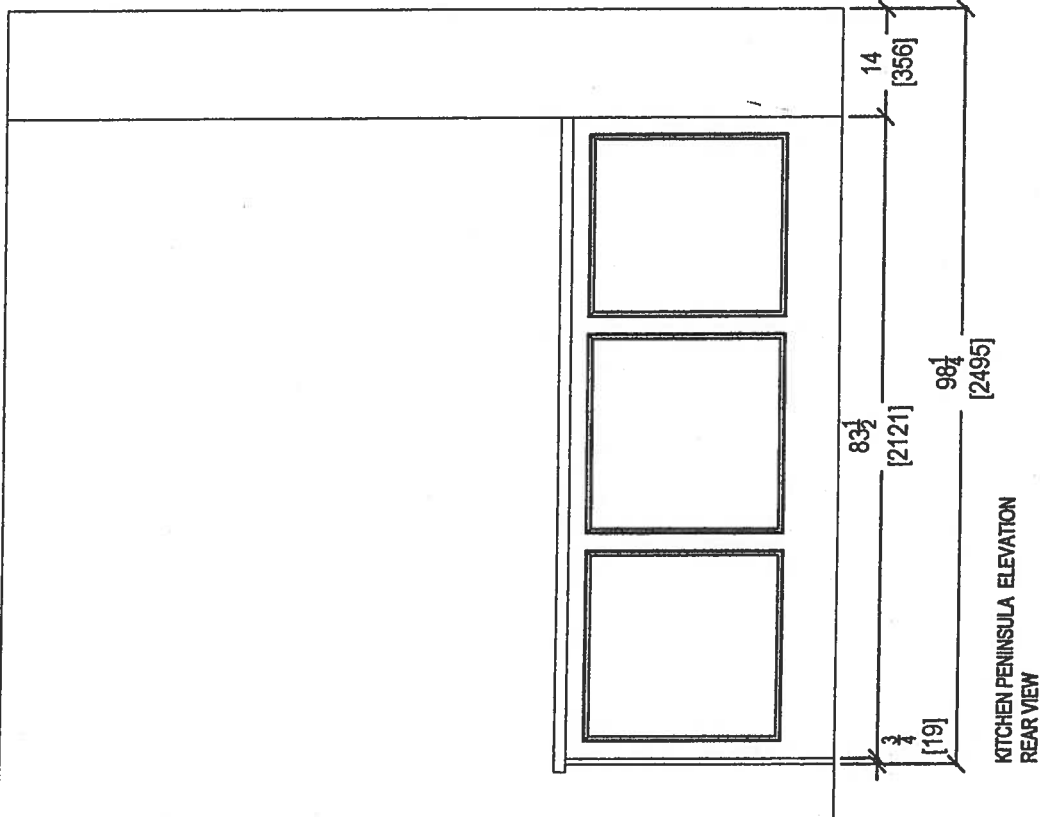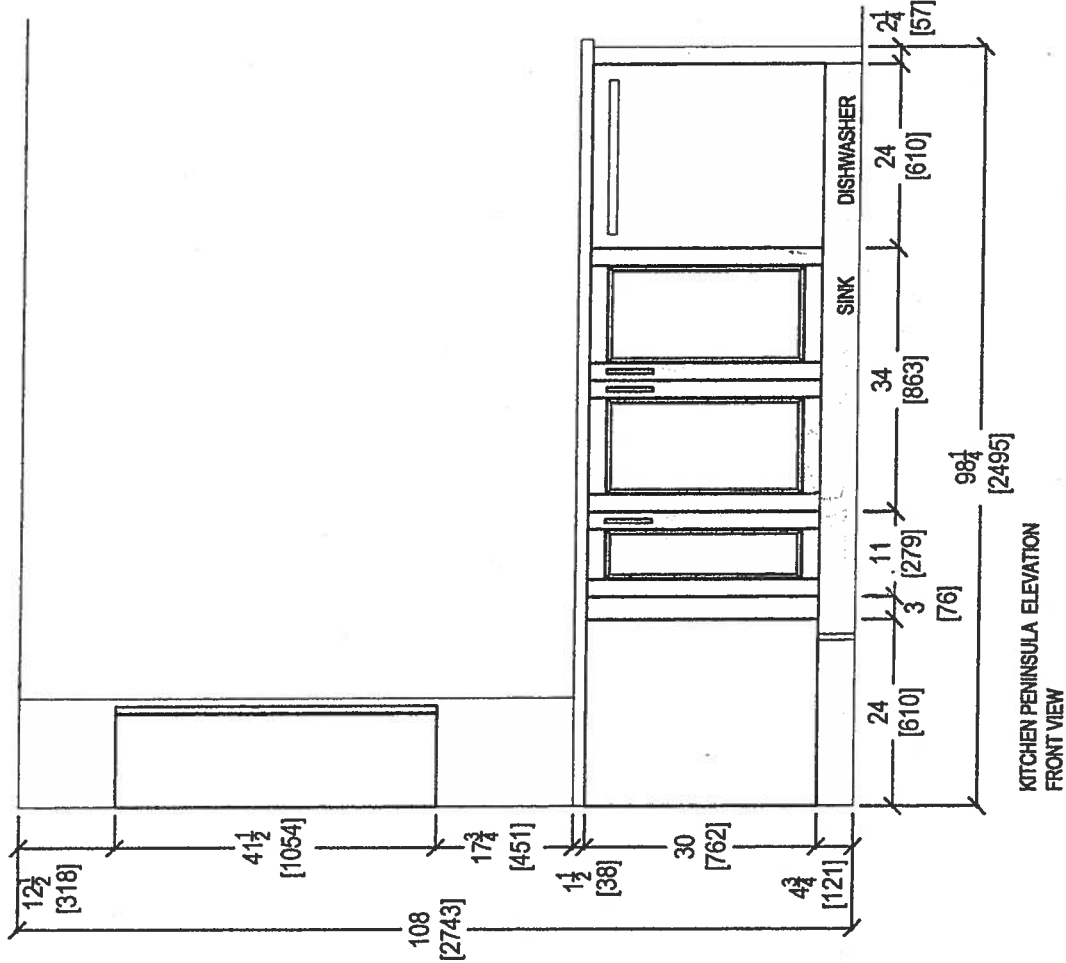

80 SANTE DRIVE, VAUGHAN, ON L4K 3C4,
T: 416.746.1811 F: 905.761.5901

CLIENT: ROYAL PINE HOMES		NOYAC BAY (2G)	ROOM: KITCHEN	DRAWN BY: SK	COMMENTS: PLEASE NOTE ALL DIMENSIONS ARE NOT FINAL AND ARE SUBJECT TO CHANGE UPON FINAL SITE MEASURE
SITE: HAMPTON PLACE	DOOR STYLE: —	DOOR HANDLE: —	SCALE: 1/2" = 1'-0"		
PHONE: —	FINISH: —	DRW HANDLE: —	DATE: MARCH 8, 2018		
EMAIL: —	SPECIES: —	TOP: —	PAGE: —		

116
[2946]

13 1/2

26

POT DRAWERS

MAGIC CORNER

L-SHAPE
UCC

4 BD

OVER THE RANGE

STOVE

SPICE

BASE L

PENDANT
132 LIGHT ON
CENTER

STOVE PIPE CENTER

132

[3353]

61

[1549]

SINK PIPE CENTER

129

[3277]

SINK

DISHWASHER

38

[965]

25

36

DUMMY DOORS
EXTENDED FLUSH BAR TOP

99 1/4

[2521]

14

6

SPACE
FOR PIPES

36

SUITE 511 INVENTORY
SUITE

- OPTIONAL = 1ST UPGRADE
KITCHEN LAYOUT
- OPT. 1ST UPG APPLIANCE
PACKAGE
- (x1) = PLUG PENINSULA
- (x2) = CAPPED PENDANT
LIGHTS
- (x7) = PUCK LIGHTS

CLIENT: ROYAL PINE HOMES

SITE: HAMPTON PLACE

PHONE: —

EMAIL: —

NOYAC BAY (2G) UPGRADE PACKAGE

DOOR STYLE: —

FINISH: —

SPECIES: —

ROOM:

KITCHEN FLOOR PLAN

DRAWN BY: SK

SCALE: 1/2" = 1'-0"

DATE: MARCH 8, 2018


PAGE: —

COMMENTS:

PLEASE NOTE ALL DIMENSIONS
ARE NOT FINAL AND ARE
SUBJECT TO CHANGE UPON
FINAL SITE MEASURE



60 SANTE DRIVE, VAUGHAN, ON L4K 3C4,
T: 416.746.1811 F: 905.761.5901

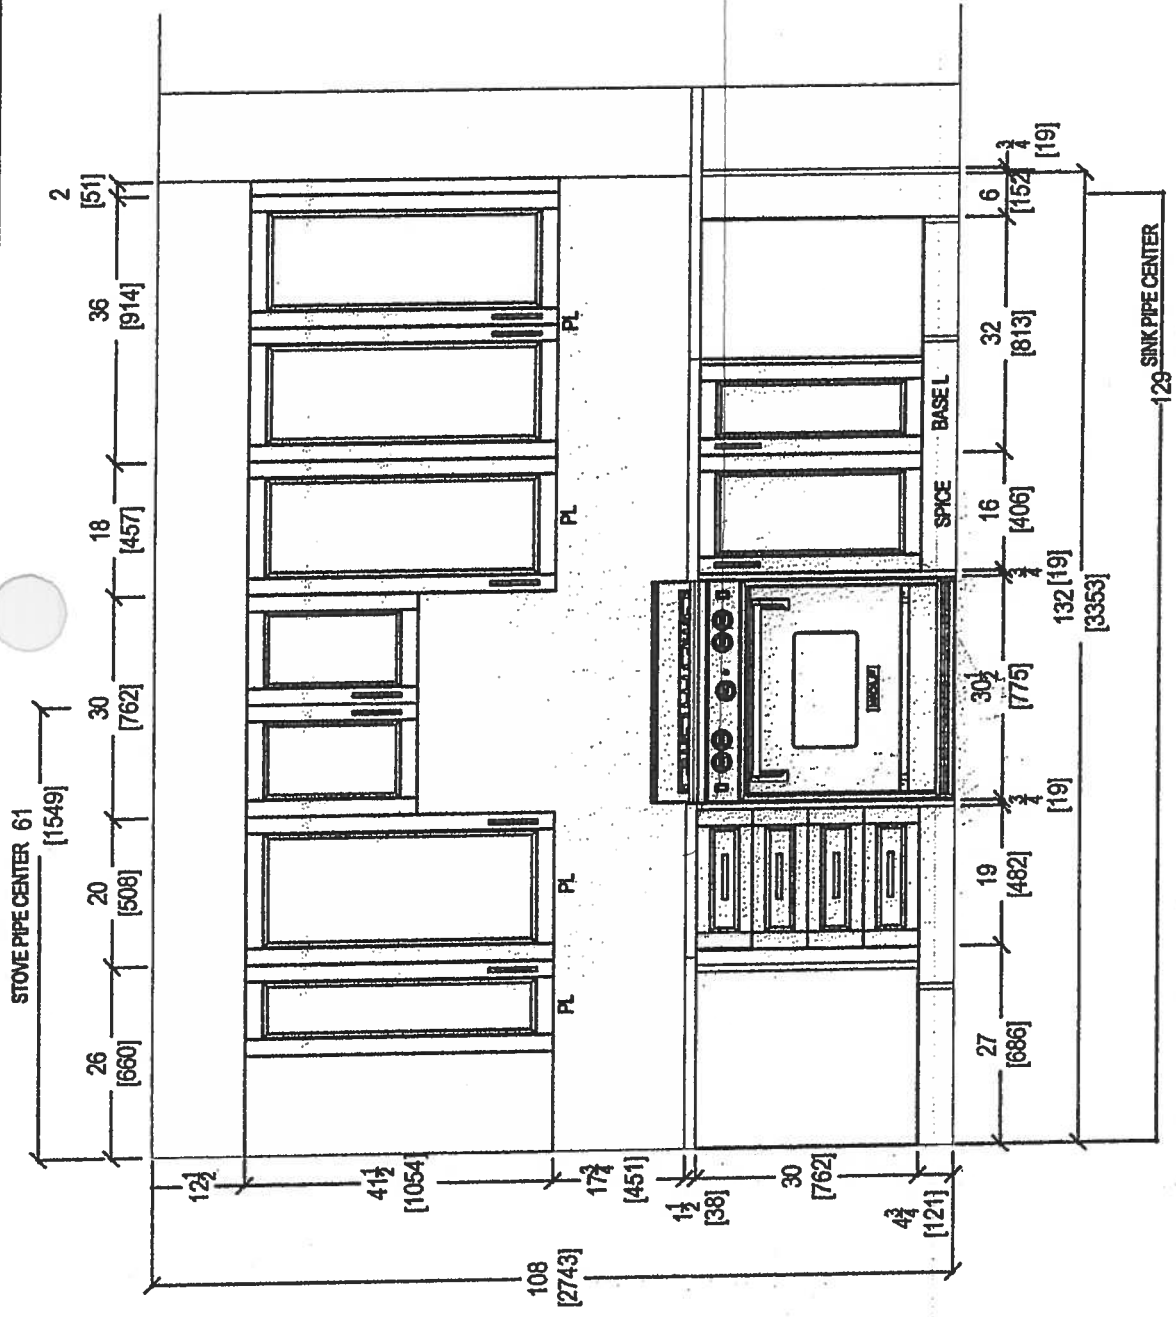

STOVE WALL ELEVATION

CLIENT: ROYAL PINE HOMES

SITE: HAMPTON PLACE

PHONE: —


EMAIL: —

NOYAC BAY (2G) UPGRADE PACKAGE	ROOM:	KITCHEN
DOOR STYLE: —	DOOR HANDLE: —	
FINISH: —	DRW HANDLE: —	
SPECIES: —	TOP: —	

DRAWN BY: SK	SCALE: 1/2" = 1'-0"	DATE: MARCH 8, 2018	PAGE: —
--------------	---------------------	---------------------	---------

COMMENTS:

PLEASE NOTE ALL DIMENSIONS ARE NOT FINAL AND ARE SUBJECT TO CHANGE UPON FINAL SITE MEASURE

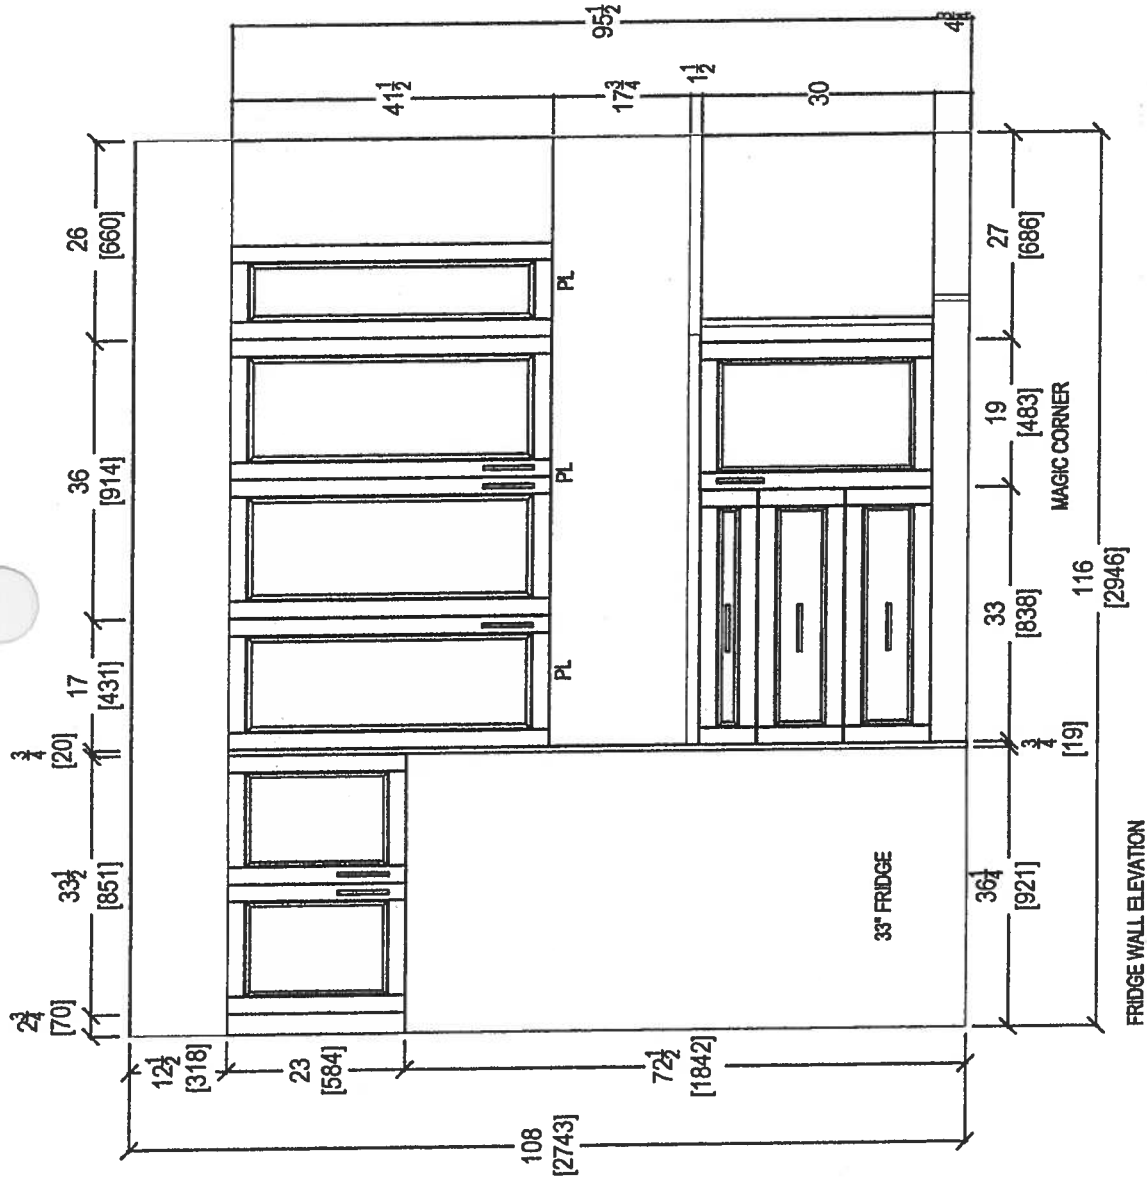

80 SANTE DRIVE, VAUGHAN, ON L4K 3C4,
T: 416.746.1811 F: 905.761.5901

CLIENT: ROYAL PINE HOMES

SITE: HAMPTON PLACE

PHONE: —

EMAIL: —

NOYAC BAY (26) UPGRADE PACKAGE

DOOR STYLE: —

FINISH: —

SPECIES: —

ROOM: KITCHEN

DOOR HANDLE: —

DRW HANDLE: —

TOP: —

DRAWN BY: SK



SCALE: 1/2" = 1' - 0"

DATE: MARCH 8, 2018

PAGE: —

COMMENTS:

PLEASE NOTE ALL DIMENSIONS
ARE NOT FINAL AND ARE
SUBJECT TO CHANGE UPON
FINAL SITE MEASURE

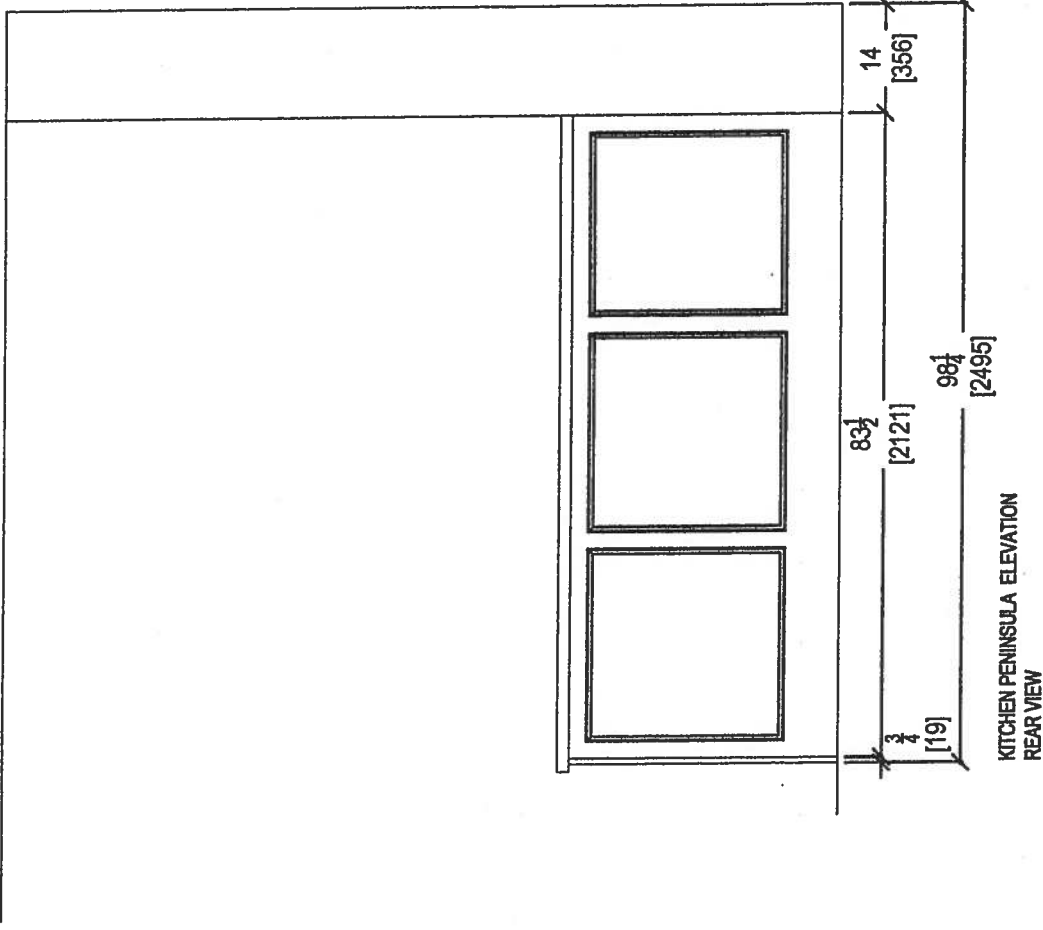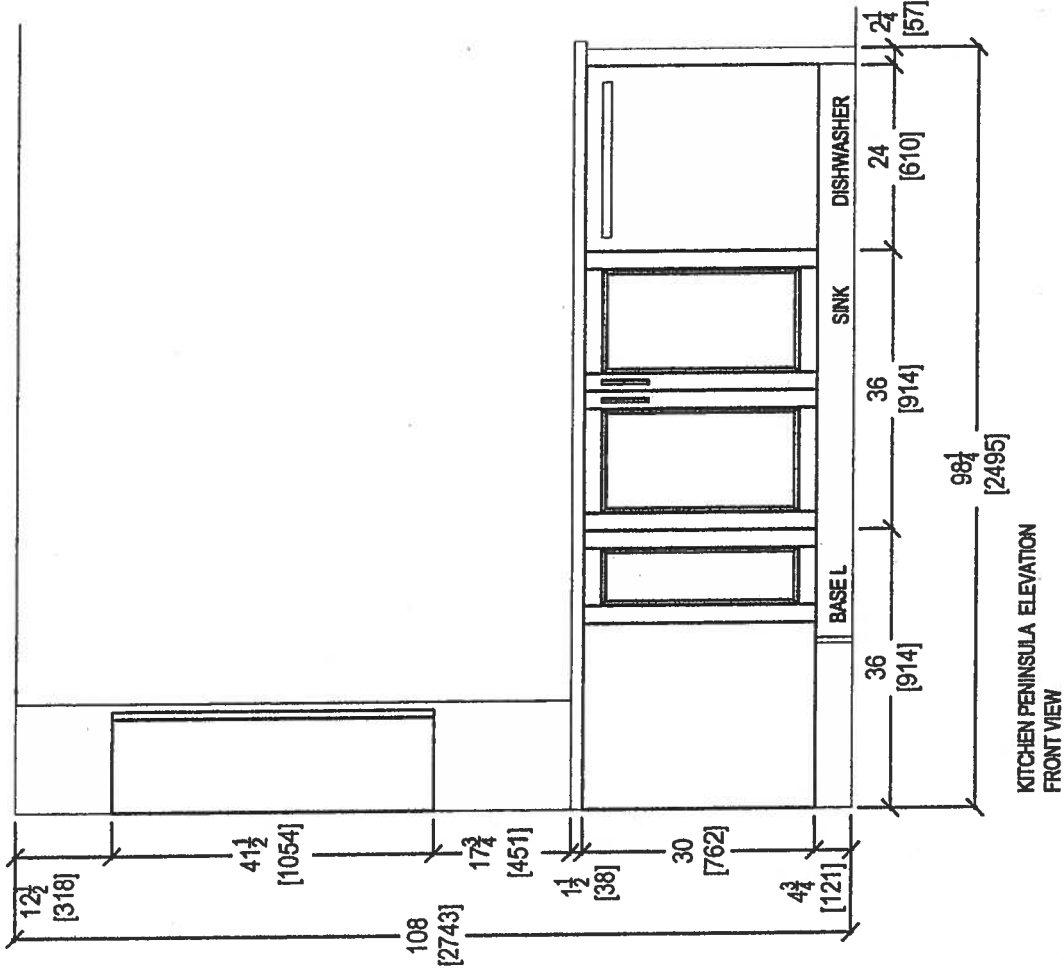

80 SANTE DRIVE, VAUGHAN, ON L4K 3C4,
T: 416.746.1611 F: 905.761.5901





CLIENT: ROYAL PINE HOMES
SITE: HAMPTON PLACE
PHONE: ---
EMAIL: ---

NOYAC BAY (2G) UPGRADE PACKAGE
DOOR STYLE: ---
FINISH: ---
SPECIES: ---

ROOM: KITCHEN
DOOR HANDLE: ---
DRW HANDLE: ---
TOP: ---

DRAWN BY: SK
SCALE: 1/2" = 1' - 0"
DATE: MARCH 8, 2018
PAGE: ---

COMMENTS:
PLEASE NOTE ALL DIMENSIONS
ARE NOT FINAL AND ARE
SUBJECT TO CHANGE UPON
FINAL SITE MEASURE

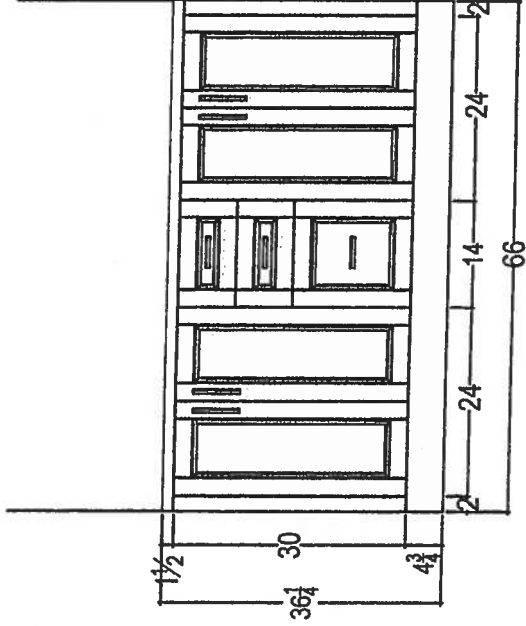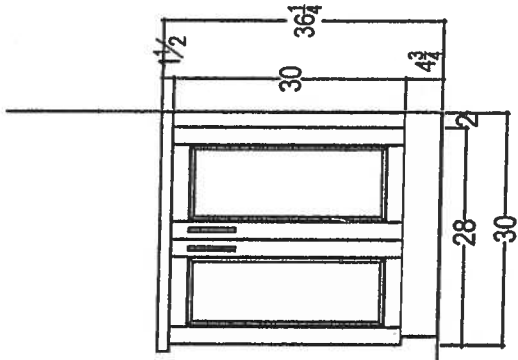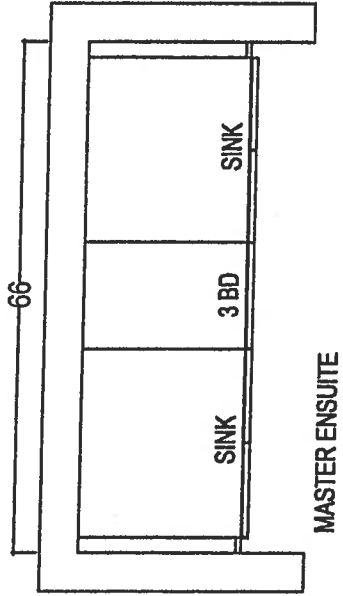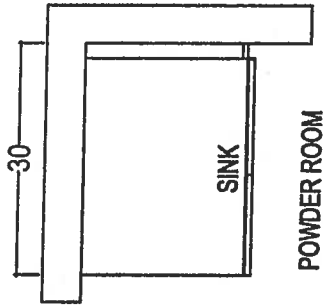

your kitchen, your taste.
 80 SANTE DRIVE, VAUGHAN, ON L4K 3C4,
 T: 416.746.1811 F: 905.781.5801

CLIENT: ROYAL PINE HOMES	NOYAC BAY (2G) UPGRADE PACKAGE	ROOM:	DRAWN BY: SK	COMMENTS: PLEASE NOTE ALL DIMENSIONS ARE NOT FINAL AND ARE SUBJECT TO CHANGE UPON FINAL SITE MEASURE
SITE: HAMPTON PLACE	DOOR STYLE: —	DOOR HANDLE: —	SCALE: 1/2" = 1' - 0"	
PHONE: —	FINISH: —	DRW HANDLE: —	DATE: MARCH 8, 2018	
EMAIL: —	SPECIES: —	TOP: —	PAGE: —	