


Laurel


1,230 SQ FT *plus 91 sq. ft. of balcony area*

ORIGINAL LAYOUT

Book
COPY

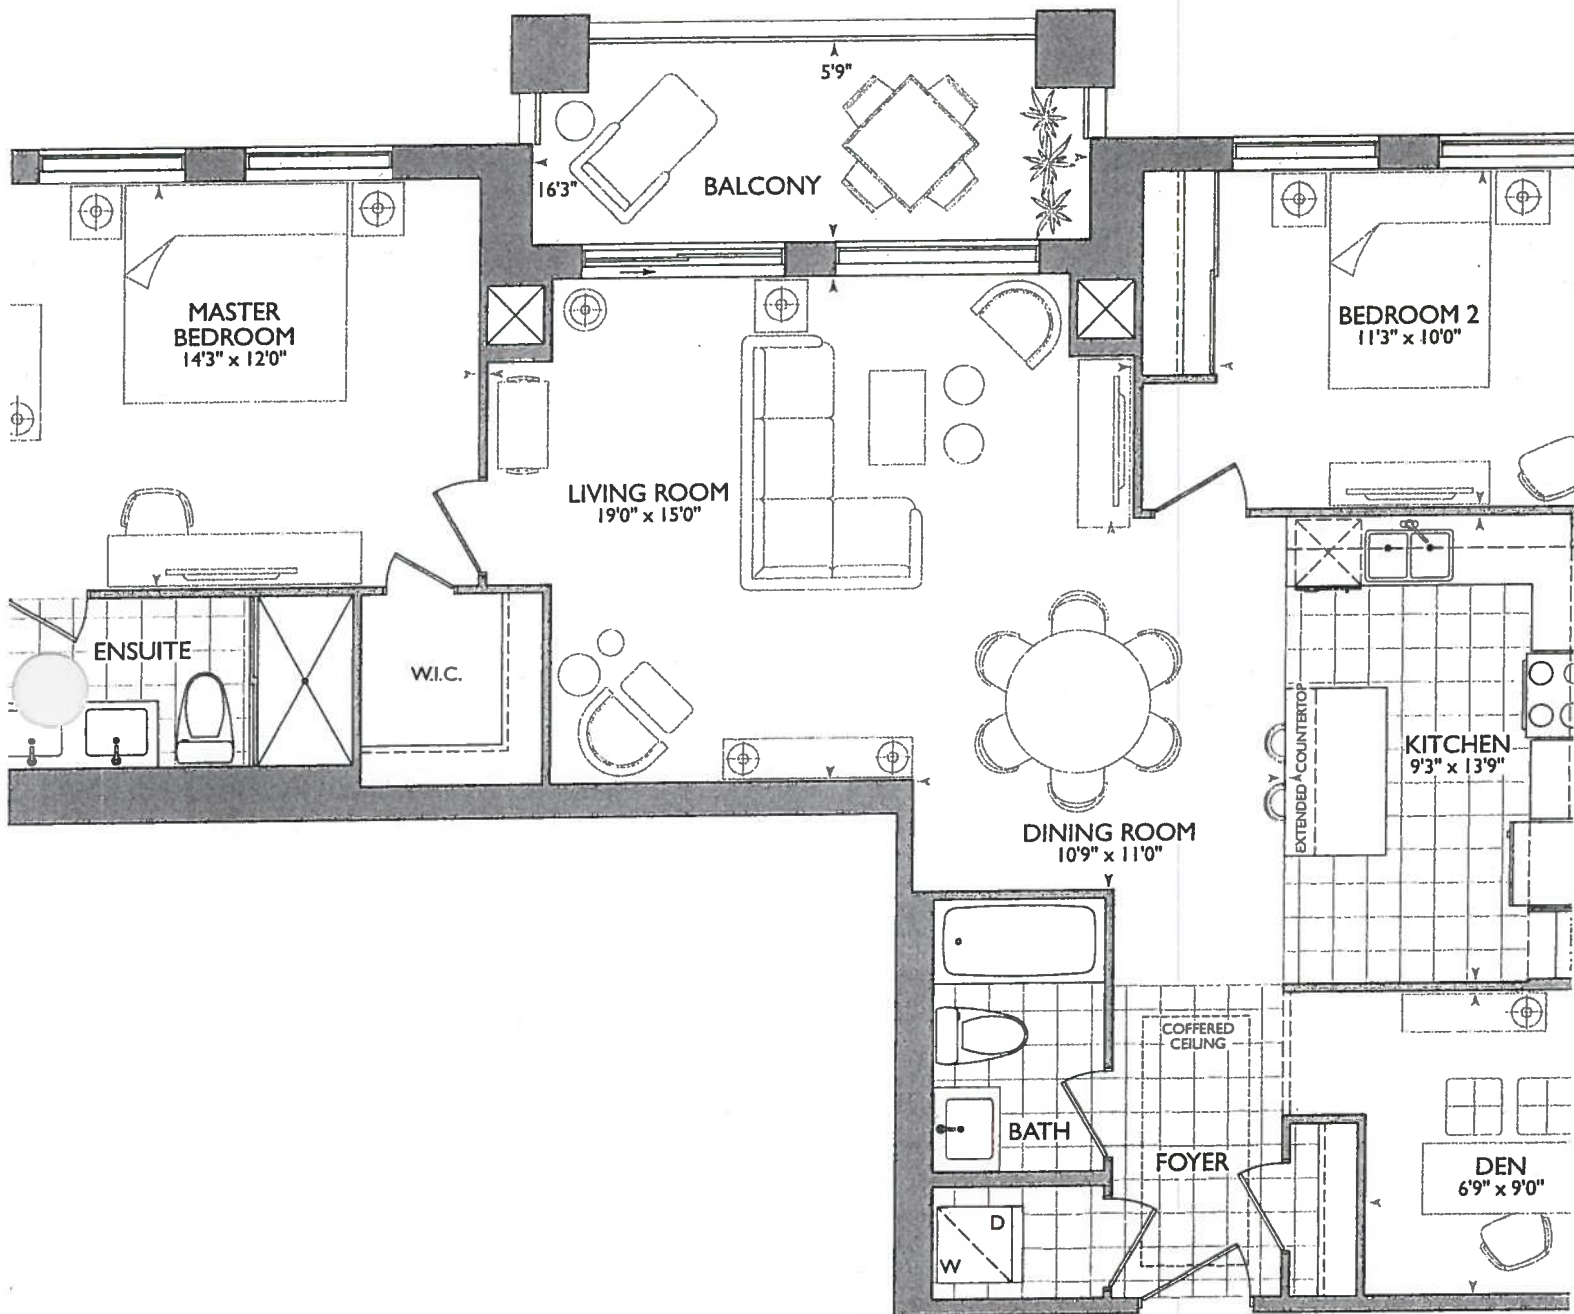

GROUND FLOOR

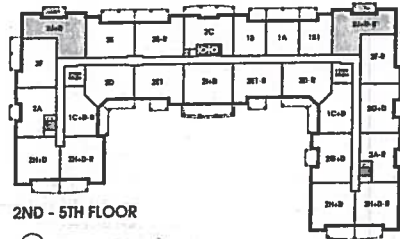

2ND - 5TH FLOOR




SIXTH FLOOR



March 20, 2018

55

Delete Mirrors Throughout Main Bath & Master Ensuite
Delete Ceramic Accents Throughout Main Bath & Master Ensuite

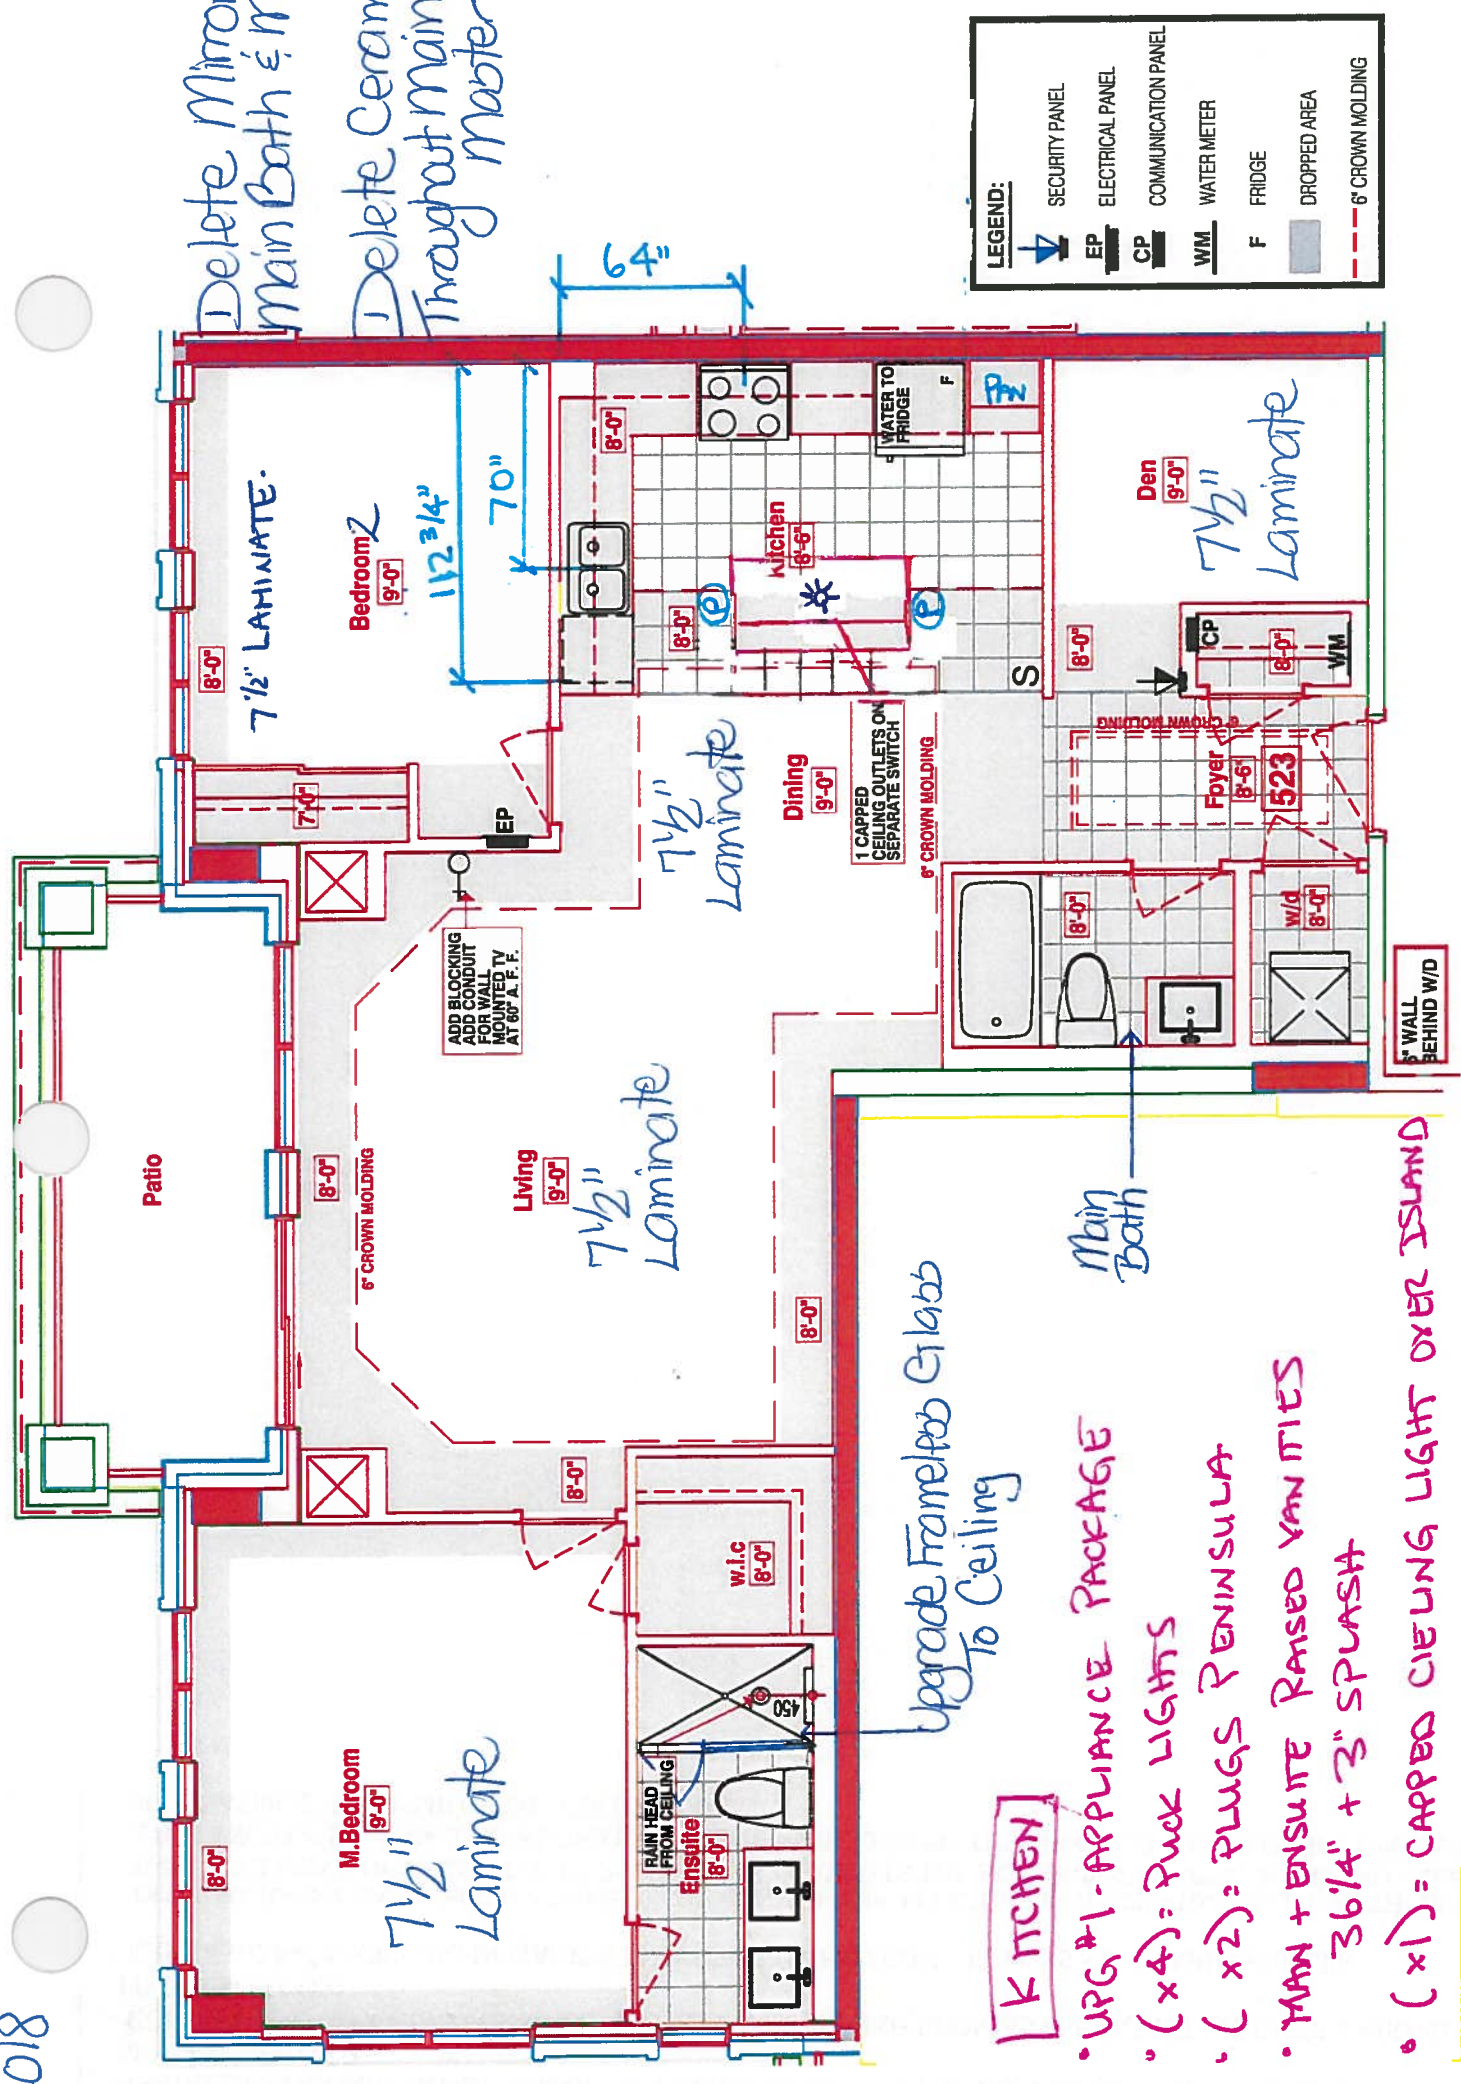

KITCHEN

- UPG #1 - APPLIANCE PACKAGE
- (x4): PUCK LIGHTS
- (x2): PLUGS PENINSULA
- MAIN + ENSUITE RAISED VANITIES 36 1/4" + 3" SPLASH
- (x1) = CAPPED CEILING LIGHT OVER ISLAND

RECEIVED
March 20, 2018

SUITE 523 - LAUREL



CONSTRUCTION SUMMARY

Hampton Place

PURCHASER: JEGATHEESAN JATHUNANTHANAN

TEL:

LOT NUMBER	PHASE	HOUSE TYPE	CLOSING DATE	
523	1	LAUREL	29-Oct-18	

Offer Workshee	PURCHASER TO RECEIVE \$5,000(INCLUDES APPLICABLE TAXES) WORTH OF UPGRADES AT THE DECOR CENTER AT TIME OF COLOUR CHART. Note:
-------------------	---

Workshee	TANDEM PARKING SPACE IN LIEU OF SINGLE PARKING SPACE Note:
----------	---

Offer Upgrade	WATER LINE FOR FRIDGE Note:
------------------	--------------------------------

Offer Upgrade	INSTALL EXTRA CEILING CAPPED OUTLET CENTERED ABOVE ISLAND, CENTERED IN BULKHEAD ON SEPARATE SWITCH. Note:
------------------	--

Offer Upgrade	CONDUIT AND BLOCKING FOR WALL MOUNTED TV IN LIVING ROOM AS PER SKETCH (60 INCHES ABOVE FINISHED FLOOR) Note:
------------------	---

Offer Upgrade	RAINHEAD FROM CEILING IN MASTER ENSUITE SHOWER, FROM VENDORS STANDARD SAMPLES Note:
------------------	--



SITE COPY

CONSTRUCTION SUMMARY
Hampton Place

PURCHASER: JEGATHEESAN JATHUNANTHANAN TEL:

LOT NUMBER	PHASE	HOUSE TYPE	CLOSING DATE	
523	1	LAUREL	29-Oct-18	

Date Added: 20-Mar-18 Invoice Number: 7088

1 - CLARIFICATION; REFER TO APAS;
LIVINGROOM - Standard electrical outlet to be installed at standard height beside conduit pipe Additional electrical outlet to be installed beside conduit pipe & standard cable rough-in Approx. 60" AFF (See Attached Sketch)
As per Vince at Head-Office

1 - KITCHEN & BATHROOMS - SEE QUALITY TOPS & KITCHENS FOR ALL KITCHEN & BATHROOMS UPGRADES / LAYOUTS. - Upgrade Package #1 (See Attached QTK Paperwork)
Note: Price Approved as per Gianni & Fonzie C.

1 - KITCHEN - CABINETRY HARDWARE - Install UPGRADE PACKAGE #1 HARDWARE - To be installed throughout kitchen cabinetry, where applicable. (See Sketch)
Note:

1 - KITCHEN - CABINETRY HARDWARE - MIX & MATCH UPGRADE HARDWARE throughout kitchen cabinetry (See Sketch)
HANDLE - Style # 527-160 - To be installed throughout kitchen drawers
KNOB - Style #S110-BN - To be installed throughout kitchen cabinetry
Note:

1 - KITCHEN - Install Standard Granite Countertop - BIANCO ANTICO - To be installed throughout kitchen, where applicable (does not include granite backsplash) (See Sketch)
Note:

1 - KITCHEN - COUNTERTOP EDGING - Install UPGRADE " M " EDGING - To be installed throughout kitchen countertop, where applicable. (See Sketch)
Note:

DISCLAIMER - GRANITE COUNTERTOP;
KITCHEN - Due to the many variables that can affect the pattern, colour and/or design and "pitting" of natural products, granite installed will not be identical to the samples displayed.
Note: Every effort is made to provide granite countertops as close as possible but the vendor is not responsible for results which differ from the sample displayed. All countertop surfaces may have seams, and product pattern and shade can change in areas containing seams.

1 - DISCLAIMER - STONE COUNTERTOP;
KITCHEN - Stone slabs vary in size & all seams are visible & the fabricator reserves the right to position the seams as necessary.
Note:

1 - KITCHEN - Kitchen Backsplash - Install 1ST UPGRADE KITCHEN BACKSPLASH - 12x12 MIST RANDOM STRIP GLASS MOSAICS - To be installed throughout kitchen, where applicable (does not include behind the fridge or stove) (See Sketch)
Note:

1 - KITCHEN - Kitchen Sink - Install Standard Undermount Sink - BLANCO Horizon Plus U2 Undermount Sink (8") - Model # 401234
Note:

1 - KITCHEN - Kitchen Faucet - Install Standard Faucet - DELTA Chrome Pull-Out Kitchen Faucet (Single Hole) - Model # 469LF - Chrome
Note:

1 - APPLIANCE PACKAGE - Install Upgrade Appliance Package - UPGRADE PACKAGE #1 - To be installed throughout suite, where applicable. (See Sketch)

1 - MAIN BATH & MASTER ENSUITE - Install RAISED VANITY HEIGHT at Main Bath and Master Ensuite Vanities, where applicable. (See Attached QTK Paperwork)
Note:

1 - CLARIFICATION;
MAIN BATH & MASTER ENSUITE - Install Standard 3" Splash throughout Main Bath and Master Ensuite Vanity Countertops, where applicable (See Sketch)
Note:



SITE COPY

CONSTRUCTION SUMMARY

Hampton Place

PURCHASER: JEGATHEESAN JATHUNANTHANAN

TEL:

LOT NUMBER	PHASE	HOUSE TYPE	CLOSING DATE	
523	1	LAUREL	29-Oct-18	

Date Added: 20-Mar-18 Invoice Number: 7088

1 - DISCLAIMER - STONE COUNTERTOP;
MAIN BATH & MASTER ENSUITE - Stone slabs vary in size & all seams are visible & the fabricator reserves the right to position the seams as necessary.

1 - MASTER ENSUITE - Install UPGRADE FRAMELESS GLASS SHOWER ENCLOSURE at Master Ensuite Shower Stall. Glass to Extend Up to TOUCH the ceiling (See Sketch)
Note:

1 - CLARIFICATION - REFER TO APAS;
MASTER ENSUITE - Install Rain Shower Head from Ceiling at Master Ensuite Shower Stall - DELTA - Shower Trim and Hansgrohe Slide Bar with Handheld and Ceiling Mount Showerhead
Note: Model # R10000 / T13020-CDN/27454002 / 277440 / RP52382 / RP46870 / RP6025 / R11000 / T11800 - Chrome (See Sketch)

1 - MAIN BATH - TOILET - Install Upgrade Toilet - CONTRAC CALI One Piece Elongated Toilet - Model # 4710-BOVU -White (See Sketch)
Note:

1 - MASTER ENSUITE - TOILET - Install Upgrade Toilet - CONTRAC CALI One Piece Elongated Toilet - Model # 4710-BOVU -White (See Sketch)
Note:

1 - CLARIFICATION;
MAIN BATH & MASTER ENSUITE - DELETE Do Not Install / Supply / Credit Purchaser for builders standard ceramic bathroom accessories (toilet paper, towel bar & soap dish) throughout all bathrooms where applicable.
Note: To Include; Main Bath & Master Ensuite (See Sketch)

1 - CLARIFICATION;
MAIN BATH & MASTER ENSUITE - DELETE Do Not Install / Supply / Credit Purchaser for builders standard Bathroom Mirrors, throughout all bathrooms, where applicable. To Include; Main Bath and Master Ensuite. (See Sketch)
Note:

1 - PURCHASER HAS ATTENDED A COLOR APPOINTMENT AT THE DECOR CENTRE AND HAS DECLINED ANY ADDITIONAL UPGRADES. Purchaser accepts and acknowledges that there will be no further changes/additions/deletions to be made upon signing on March 20,2018
Note:

1 - PURCHASER AWARE AND ACCEPTS THAT ANY CHANGES MADE TO UPGRADES AFTER SIGNING THIS PURCHASERS EXTRA FORM ARE SUBJECT TO A MINIMUM ADMINISTRATION FEE OF \$1,000 PLUS A 10% HOLDBACK FEE.
Note:

This Document is Extremely Time Sensitive - Printed 29 Mar 18 at 10:51





* INTERIOR COLOR SCHEME *

Purchaser JEGATHEESAN JATHUNANTHANAN		Decor Consultant Melissa Di Marino	Model Type LAUREL	Telephone Res. / Bus /	Project Hampton Place	Closing Date 29/10/2018	Unit 523
---	--	---------------------------------------	----------------------	---------------------------	--------------------------	----------------------------	-------------

	Flooring		Wall Tile			Notes
	Description	Main	Accent/Insert	Pattern		
✓ MASTER ENSUITE	✓ 13x13 SEAL GREY (STD)	✓	NONE	NONE		KITCHEN CABINETRY HARDWARE - Mix and Match Upgrade Hardware at Kitchen Cabinetry; Install Handle - Style #527-160 - throughout Kitchen Drawers Install Knob - Style #S110-BN - throughout Kitchen Cabinets
✓ MAIN BATHROOM	✓ 13x13 SEAL GREY (STD)	✓	NONE	NONE		
✓ POWDER ROOM	N/A		N/A	N/A		
✓ KITCHEN / DINETTE	✓ 20x20 PULPIS GRIS (STRAIGHT) (STD)	✓	NONE	NONE		
✓ HALLWAY	✓ 20x20 PULPIS GRIS (STRAIGHT) (STD)		N/A	N/A		
✓ LAUNDRY	✓ 8x8 BEHRAM PINK (STD)		N/A	N/A		
✓ LIVING ROOM	✓ 7 1/2" TorleysForest-NorthernCordillera 9687P (STD)					
✓ DINING ROOM	✓ 7 1/2" TorleysForest-NorthernCordillera 9687P (STD)					
✓ HALLWAY	✓ 7 1/2" TorleysForest-NorthernCordillera 9687P (STD)					
✓ MASTER BEDROOM	✓ 7 1/2" TorleysForest-NorthernCordillera 9687P (STD)					
✓ BEDROOM 2	✓ 7 1/2" TorleysForest-NorthernCordillera 9687P (STD)					
✓ BEDROOM 3	N/A					

Consultant: Purchaser: Vendor:

Melissa Di Marino
JEGATHEESAN JATHUNANTHANAN
Hampton Place



* INTERIOR COLOUR SCHEME *

Purchaser JEGATHEESAN JATHUNANTHANAN	Decor Consultant Melissa Di Marino	Model Type LAUREL	Telephone Res. / Bus /	Project Hampton Place	Closing Date 29/10/2018	Unit 523
---	---------------------------------------	----------------------	---------------------------	--------------------------	----------------------------	-------------

Page 2 of 3

- CABINETRY, VANITIES AND COUNTERTOPS

	Style	Countertop	Counter Edge	Handle / Knob	APPLIANCE PACKAGE
MAIN BATHROOM	CATEGORY 1 - LP LAMINATE - CHILL QT 1022 (STD)	☒ ASPEN CYRUS GREY (STD)	☒ A " EDGE (STD)	3487-128	Upgrade Package #1
MASTER ENSUITE	CATEGORY 1 - LP LAMINATE - CHILL QT 1022 (STD)	☒ ASPEN CYRUS GREY (STD)	☒ A " EDGE (STD)	3487-128	
POWDER ROOM	N/A	N/A	N/A	N/A	
KITCHEN / DINETTE	☒ CATEGORY 2 - MAPLE - BRAZILNUT QT 2101 (STD)	BIANCO ANTICO GRANITE (STD)	☒ M " EDGE (UPG)	* See Notes *	
LAUNDRY ROOM	N/A	N/A	N/A	N/A	Std 31in Opening




- PLUMBING FIXTURES

KITCHEN	Sink Model	☒ STANDARD	Trim	Baseboard & Casing	☒ STANDARD	Levers	☒ STANDARD
	Sink Faucet	☒ STANDARD		Interior Doors	☒ STANDARD - CARRARA SMOOTH	Door Height	☒ STANDARD
TOILETS	Master Ensuite	☒ UPGRADE - Contrac Cali #4710BOVU		Cornice Moulding / Medallion		Fireplace	N/A
	Main Bathroom	☒ UPGRADE - Contrac Cali #4710BOVU		Foyer	☒ STANDARD - #CTR-611	Location Flooring	N/A
	Powder Room	N/A		Living Room	☒ STANDARD - #CTR-611	Style	N/A
VANITY FAUCETS				Dining Room	☒ STANDARD - #CTR-611	Finish	N/A
	Master Ensuite	☒ STANDARD		Den	NONE	Marble	N/A
	Main Bathroom	☒ STANDARD		Master Bedroom	NONE	Hearth	N/A
	Powder Room	N/A		Bedroom 2	NONE		
VANITY SINKS				Bedroom 3	N/A		
	Master Ensuite	☒ STANDARD					
	Main Bathroom	☒ STANDARD					
	Powder Room	N/A					
SHOWER STALL / TUBS							
	Master Ensuite Shower Stall	☒ STANDARD					
	Master Ensuite Tub	N/A					
	Main Bathroom Tub	☒ STANDARD					

Paint Throughout	Trim
Walls	STANDARD - BIRCH WHITE
	STANDARD - WHITE

MISC. INSTALLATIONS
Ceramic Accessories (installed by Vendor)
☒ Yes ☒ No
Bathroom Mirrors (installed by Vendor)
☐ Yes ☒ No
Wire Shelving - Closet (installed by Vendor)
☒ Yes ☐ No

Page 2 of 3

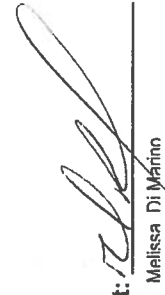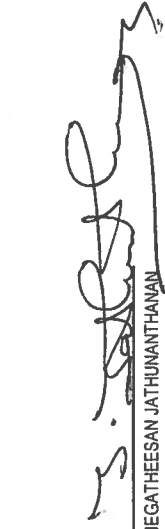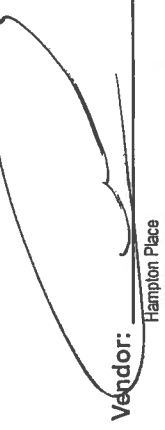Decor Consultant:  Purchaser:  Vendor: 

Suite 523 Hampton

• (x4) = PUCK LIGHTS


• (x2) = PLUGS
PENINSULA

• UPG #1 - APPLIANCE
PACKAGE

• MAIN + ENSUITE
RAISED VANITIES
36 1/4" + 3" SPLASH

• (x1) = CAPPED
PENDANT LIGHT
OVER ISLAND.


• KITCHEN ISLAND
SHIFTS TOWARDS
STOVE.

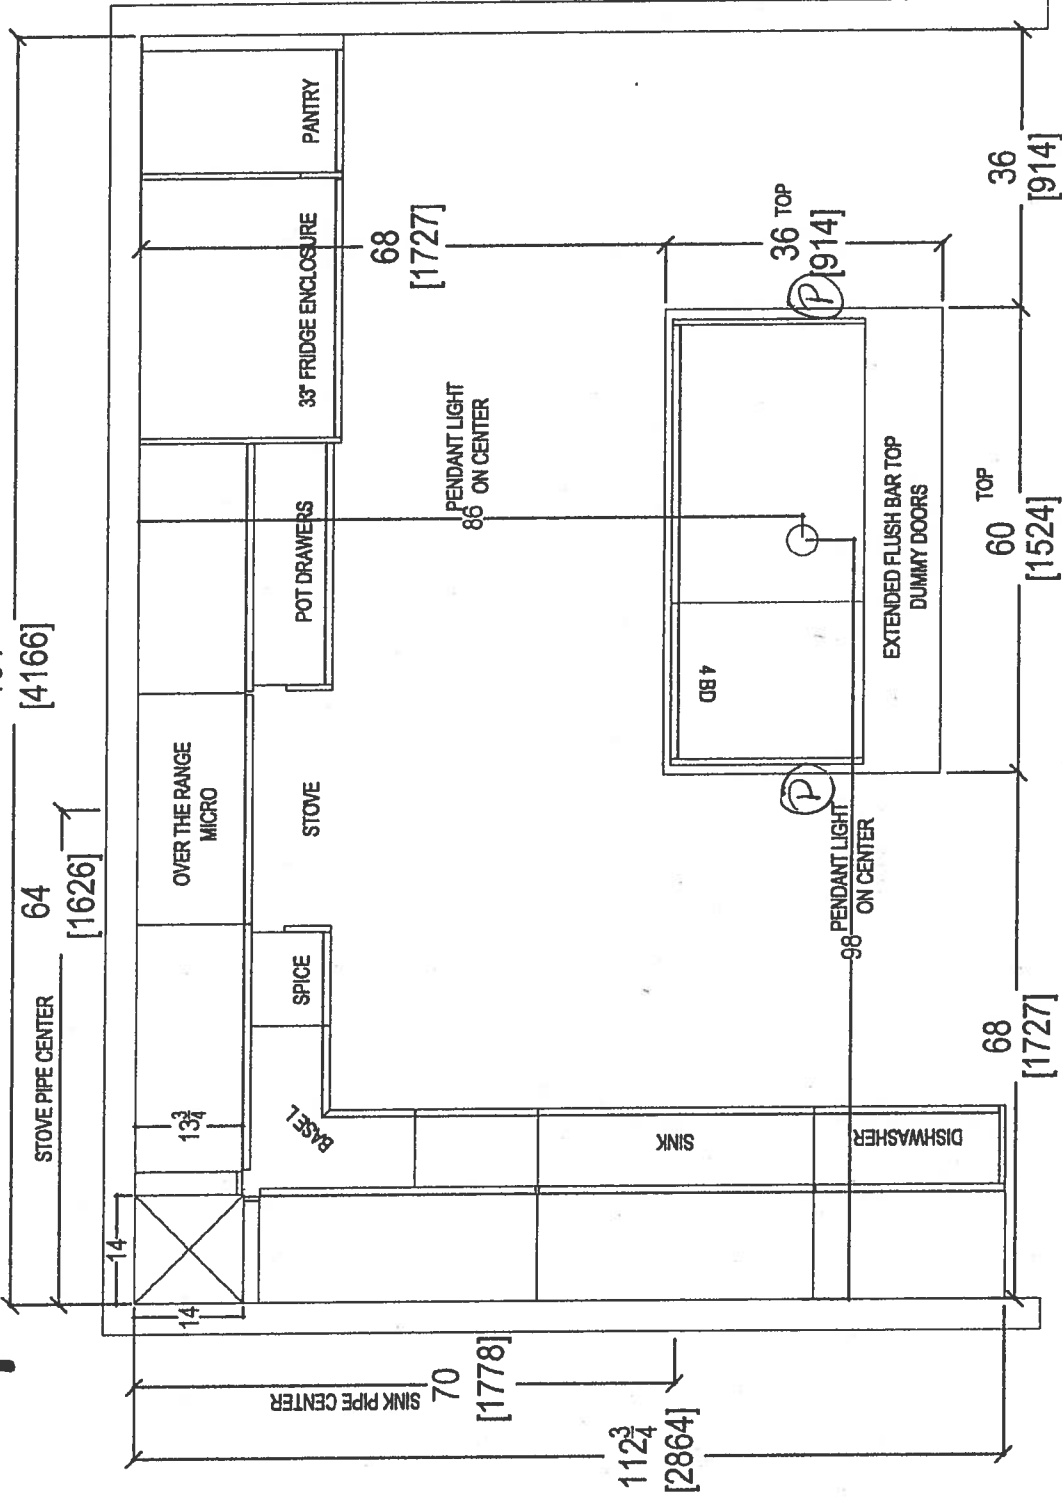

 your kitchen, your taste. 80 SANTE DRIVE, VAUGHAN, ON L4K 3C4, T: 416.746.1811 F: 905.761.5901	CLIENT: ROYAL PINE HOMES		UNIT 523 HMP	ROOM: KITCHEN FLOOR PLAN	DRAWN BY: SK		COMMENTS: PLEASE NOTE ALL DIMENSIONS ARE NOT FINAL AND ARE SUBJECT TO CHANGE UPON FINAL SITE MEASURE
	SITE: HAMPTON PLACE	DOOR STYLE: —	DOOR HANDLE: —	SCALE: 1/2" = 1' - 0"			
	PHONE: —	FINISH: —	DRW HANDLE: —	DATE: MARCH 23, 2018			
	EMAIL: —	SPECIES: —	TOP: —	PAGE: —			

Suite 523 Hampton


PL-Pack Light (x4)

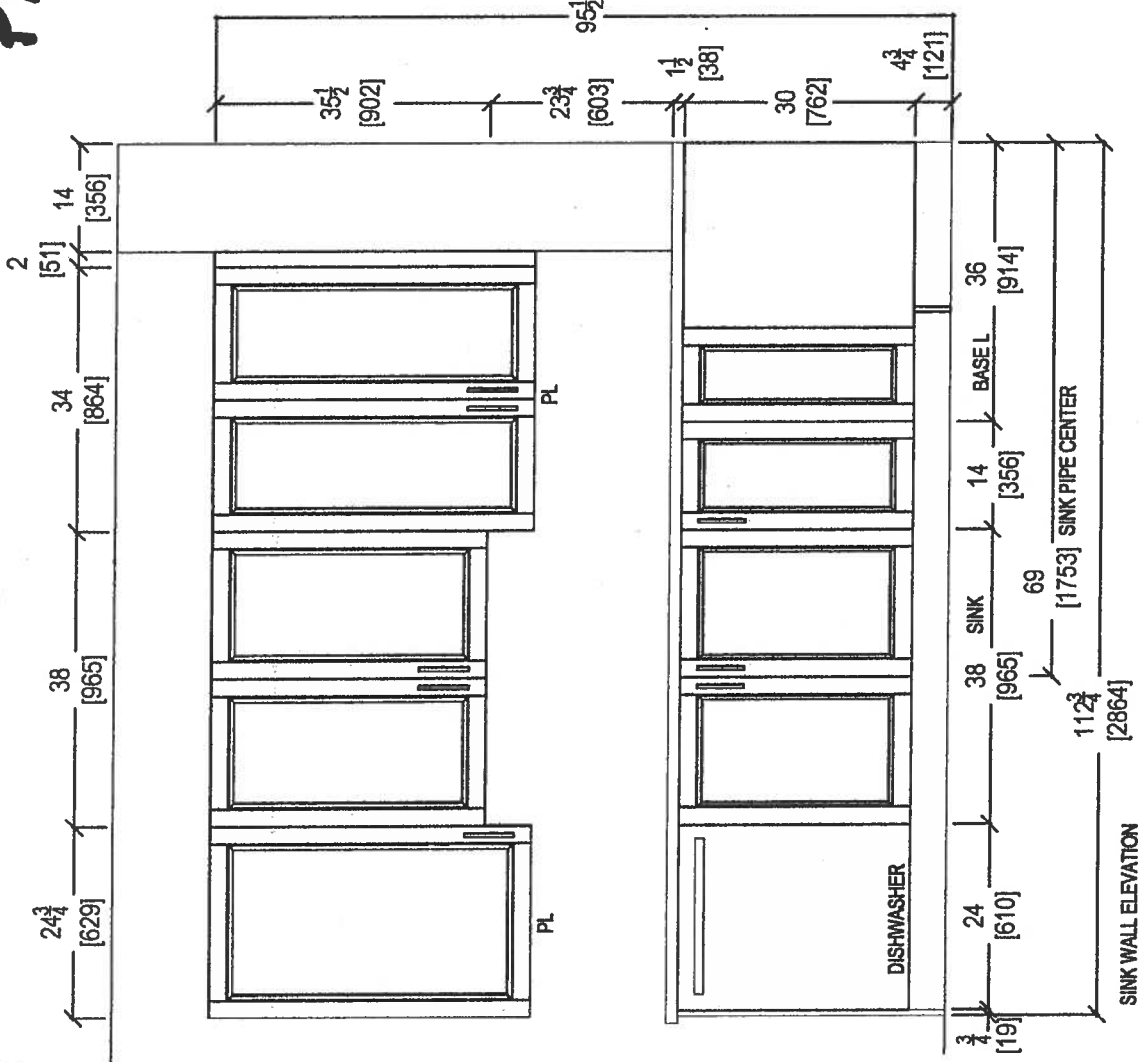

 your kitchen, your taste. 80 SANTE DRIVE, VAUGHAN, ON L4K 3C4, T: 416.746.1811 F: 905.781.5901	CLIENT: ROYAL PINE HOMES		UNIT 523 HMP	ROOM: KITCHEN	DRAWN BY: SK	COMMENTS: PLEASE NOTE ALL DIMENSIONS ARE NOT FINAL AND ARE SUBJECT TO CHANGE UPON FINAL SITE MEASURE
	SITE: HAMPTON PLACE	DOOR STYLE: —	DOOR HANDLE: —	SCALE: 1/2" = 1' - 0"		
	PHONE: —	FINISH: —	DRW HANDLE: —	DATE: MARCH 23, 2018		
	EMAIL: —	SPECIES: —	TOP: —	PAGE: —		


Suite 523
Hampton

PL - Pock Light (x4)

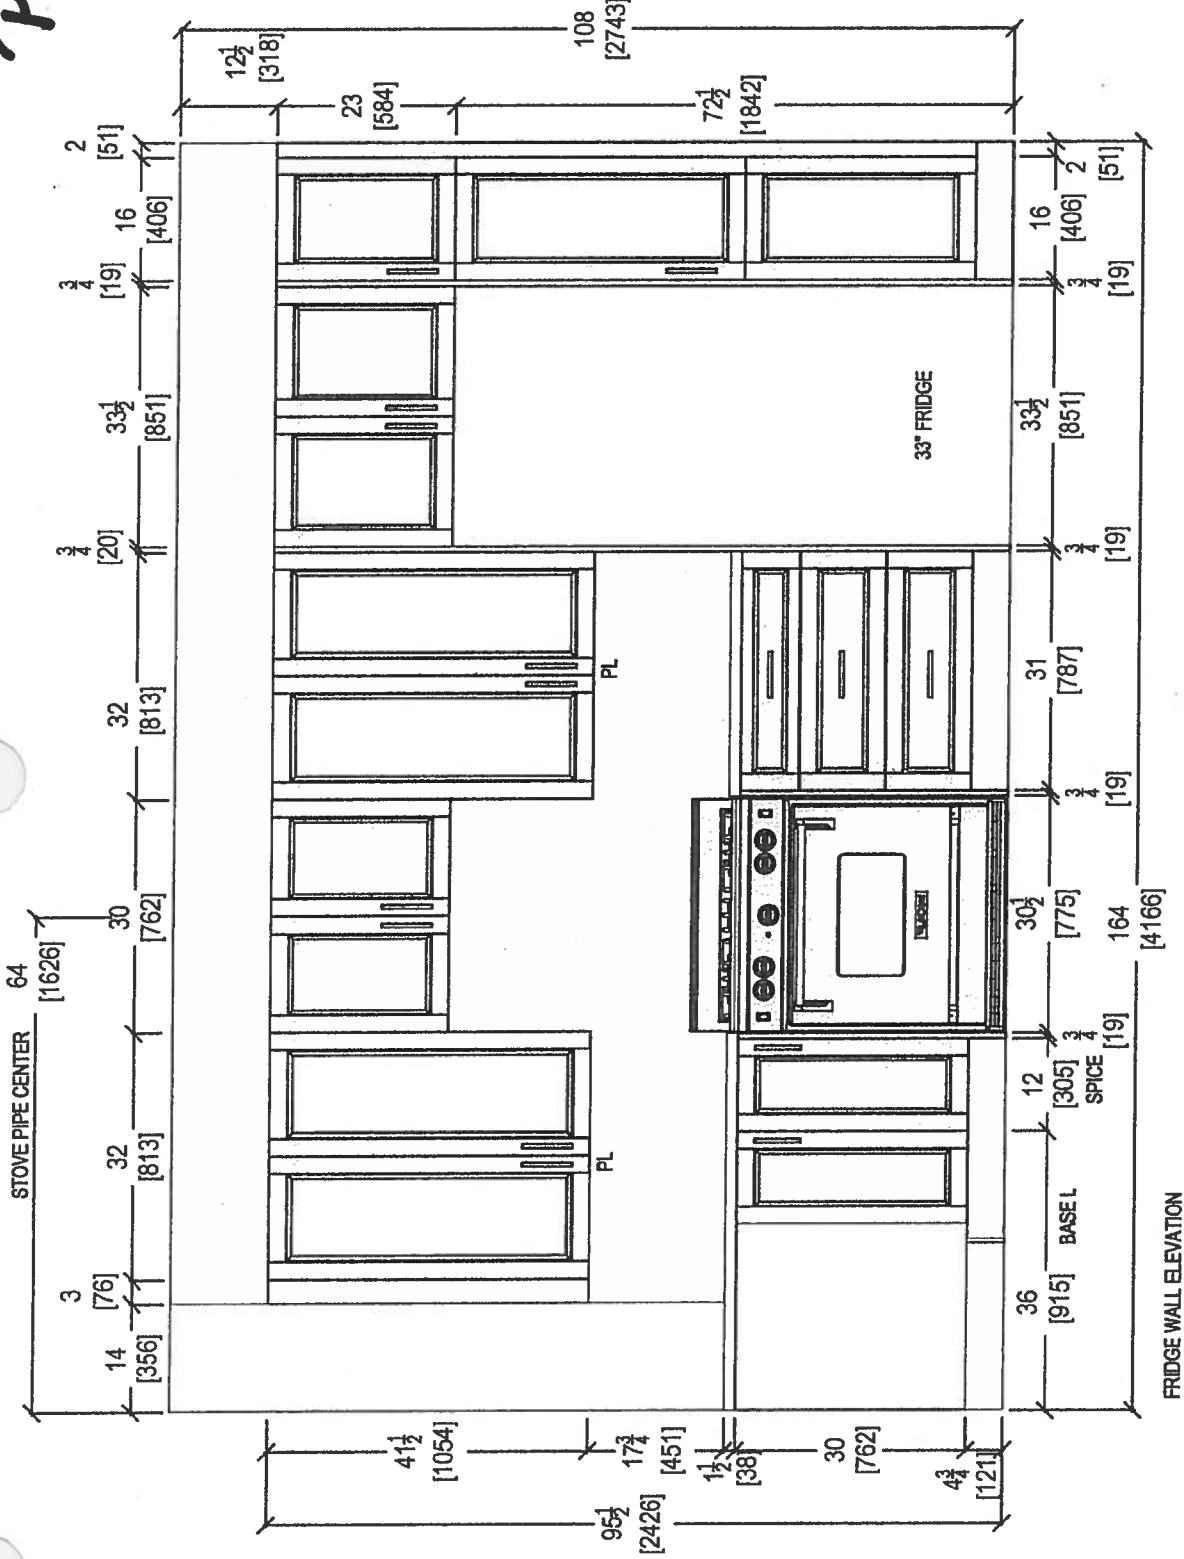

CLIENT: ROYAL PINE HOMES		UNIT 523 HMP	ROOM: KITCHEN	DRAWN BY: SK	COMMENTS: PLEASE NOTE ALL DIMENSIONS ARE NOT FINAL AND ARE SUBJECT TO CHANGE UPON FINAL SITE MEASURE
SITE: HAMPTON PLACE	DOOR STYLE: --	DOOR HANDLE: --	SCALE: 1/2" = 1' - 0"		
PHONE: --	FINISH: --	DRW HANDLE: --	DATE: MARCH 23, 2018		
EMAIL: --	SPECIES: --	TOP: --	PAGE: --		

Suite 52: Hampton

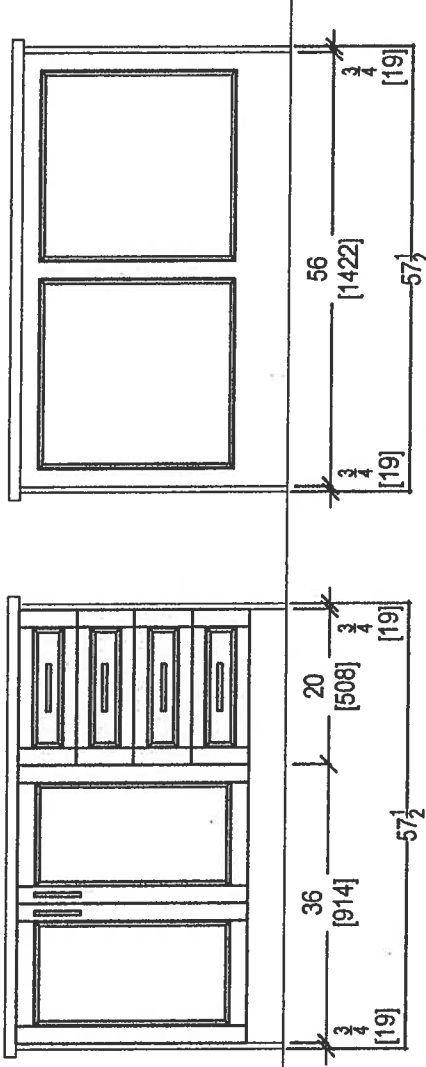


80 SANTE DRIVE, VAUGHAN, ON L4K 3C4,
T: 416.746.1811 F: 905.761.5901



CLIENT: ROYAL PINE HOMES		UNIT 523 HMP	ROOM: KITCHEN	DRAWN BY: SK		COMMENTS: PLEASE NOTE ALL DIMENSIONS ARE NOT FINAL AND ARE SUBJECT TO CHANGE UPON FINAL SITE MEASURE
SITE: HAMPTON PLACE	DOOR STYLE: —	DOOR HANDLE: —	SCALE: 1/2" = 1' - 0"			
PHONE: —	FINISH: —	DRW HANDLE: —	DATE: MARCH 23, 2018			
EMAIL: —	SPECIES: —	TOP: —	PAGE: —			

Suite 523 Hampton

* Install 3" Splash *

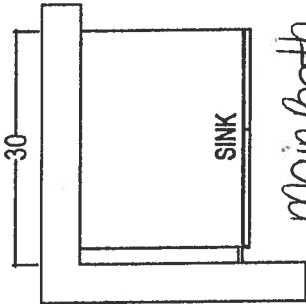


Main Bath
Raised
Height

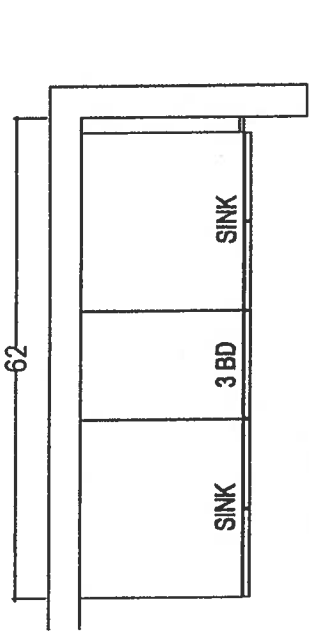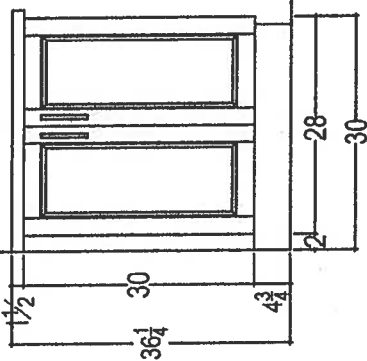

MASTER ENSUITE

Raised
Height

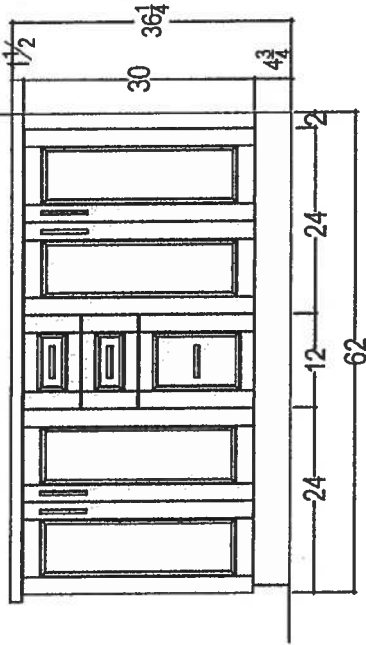

80 SANTE DRIVE, VAUGHAN, ON L4K 3C4.
T: 416.748.1811 F: 905.781.5901

CLIENT: ROYAL PINE HOMES	UNIT 523 HMP	ROOM:	VANITIES	DRAWN BY: SK	COMMENTS: PLEASE NOTE ALL DIMENSIONS ARE NOT FINAL AND ARE SUBJECT TO CHANGE UPON FINAL SITE MEASURE
SITE: HAMPTON PLACE	DOOR STYLE: —	DOOR HANDLE: —	SCALE: 1/2" = 1' - 0"		
PHONE: —	FINISH: —	DRW HANDLE: —	DATE: MARCH 23, 2018		
EMAIL: —	SPECIES: —	TOP: —	PAGE: —		

Suite 523

Hampton Upgrade Package I


WRB322DMBM



Whirlpool®

33-inches wide Bottom-Freezer Refrigerator with
SpillGuard™ Glass Shelves - 22 cu. ft

<http://www.whirlpool.com>

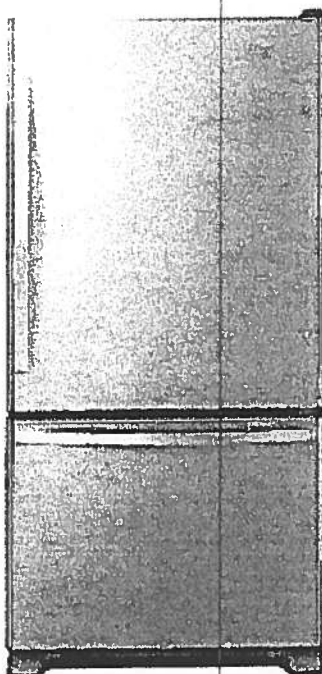

Key Features:

- SpillGuard™ Glass Shelves
- Adaptive Defrost / *Factory Installed Ice Maker*
- FreshFlow™ Produce Preserver
- LED Interior Lighting
- ENERGY STAR® Qualified

Product Dimensions:

Height: 70

Width: 32 5/8

Depth: 33 3/8

Electrical Requirements:

15

Additional Information:

[Use And Care Guide](#)

[Dimension Guide](#)

[Energy Guide](#)

[Warranty Certificate](#)

INVESTED
IN
AMERICA



©Registered trademark/TM Trademark of Whirlpool, U.S.A. © 2018 Whirlpool Corporation. All Rights Reserved.
All other trademarks are owned by their respective companies.
Because Whirlpool Corporation policy includes a continuous commitment to improve our products, we reserve the right to change materials and specifications without notice. We also reserve the right to discontinue or transition products without notice.
Manufacturer's Suggested Retail Price (MSRP) and Minimum Advertised Price (MAP) provided for reference purposes only. Dealer alone determines advertised and retail prices.
Created On: Tuesday, March 14, 2017 11:30:08

Suite 523

Hampton Upgrade Package I


WEE745H0FS

55

Whirlpool®

6.4 Cu. Ft. Slide-In Electric Range with True Convection

<http://www.whirlpool.com>

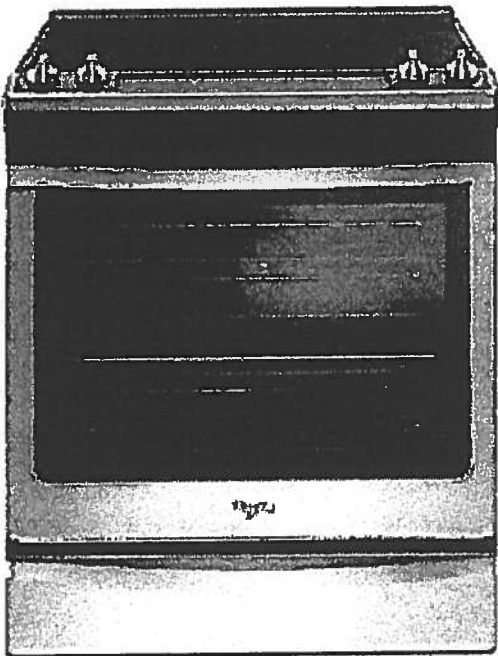

Key Features:

- Frozen Bake™ Technology
- True Convection Cooking
- FlexHeat™ Triple Radiant Element
- Convection Conversion
- AquaLift® Self-Cleaning Technology
- Temperature Sensor
- Rapid Preheat
- 6.4 Cu. Ft. Capacity
- Easy-Wipe Ceramic Glass Cooktop
- Large Oven Window
- Max Capacity Rack
- Hidden Bake Element

Product Dimensions:

Height: 36

Width: 29 7/8

Additional Information:

[Use And Care Guide](#)

[Dimension Guide](#)

[Installation Guide](#)

[Warranty Certificate](#)

INVESTED
IN
AMERICA

ADA
Compliant

®Registered trademark/TM Trademark of Whirlpool, U.S.A. © 2016 Whirlpool Corporation. All Rights Reserved.
All other trademarks are owned by their respective companies.
Because Whirlpool Corporation policy includes a continuous commitment to improve our products, we reserve the right to change materials and specifications without notice. We also reserve the right to discontinue or transition products without notice.
Manufacturer's Suggested Retail Price (MSRP) and Minimum Advertised Price (MAP) provided for reference purposes only. Dealer alone determines advertised and retail prices.
Created On: Friday, January 27, 2017 10:46:47

Suite 523 Hampton Upgrade Package 1



YWMH76719CS



1.9 cu. ft. Microwave Hood Combination with
meSavor™ Plus True Convection

<http://www.whirlpool.com>

Key Features:

- TimeSavor™ Plus True Convection Cooking System
- Steam Cooking
- Sensor Cooking
- AccuPop™ Cycle
- CleanRelease® Non-Stick Interior
- SteamClean Option
- Integrated Hidden Vent and Console
- Auto Adapt Fan
- Recessed, Stoppable Glass Turntable
- Universal Microwave Steamer
- 1.9 cu. ft. Capacity
- 1,100 Watts Cooking Power

Product Dimensions:

Height: 17 1/8

Width: 29 15/16

Depth: 18 1/2

Electrical Requirements:

15 or 20. 120 V.

Additional Information:

[Use And Care Guide](#)

[Installation Guide](#)

[Warranty Certificate](#)

Available in:

☒ Stainless Steel



©Registered trademark/TM Trademark of Whirlpool, U.S.A. © 2013 Whirlpool Corporation. All Rights Reserved.
All other trademarks are owned by their respective companies.
Because Whirlpool Corporation policy includes a continuous commitment to improve our products, we reserve the right to change materials and specifications without notice. We also reserve the right to discontinue or transition products without notice.
Manufacturer's Suggested Retail Price (MSRP) and Minimum Advertised Price (MAP) provided for reference purposes only. Dealer alone determines advertised and retail prices.
Created On: Monday, March 14, 2016 13:16:48

Suite 523 Hampton Upgrade Package 1

WDTA50SAHZ

Contemporary Design. Stainless Steel Tub
Dishwasher with TotalCoverage Spray Arm

Whirlpool®

<http://www.whirlpool.com>

Key Features:

- Sensor Cycle
- TotalCoverage Spray Arm
- 1-Hour Wash Cycle
- Tap Touch Controls

Product Dimensions:

Height: 34 1/2

Width: 23 7/8

Depth: 24 1/2

Additional Information:


[Use And Care](#)

[Dimension Guide](#)

[Installation Guide](#)

[Energy Guide](#)

[Warranty](#)

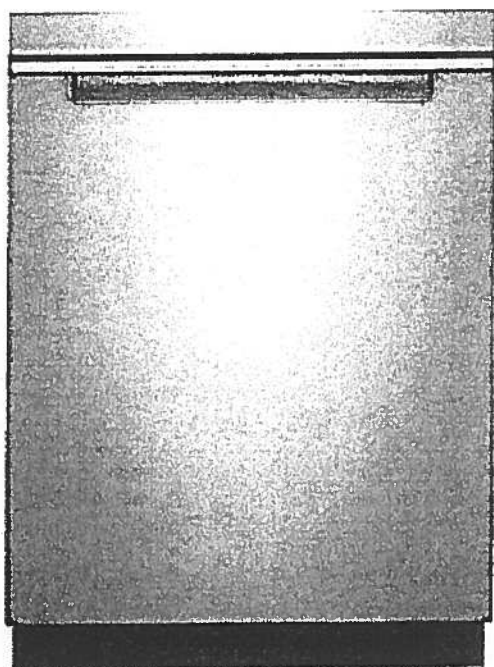

Available in:

● Black

Fingerprint Resistant Sunset Bronze

Fingerprint Resistant Black Stainless

○ White

Fingerprint Resistant Stainless Steel

INVESTED
IN
AMERICA



©Registered trademark/TM Trademark of Whirlpool, U.S.A. © 2016 Whirlpool Corporation. All Rights Reserved. All other trademarks are owned by their respective companies.

Because Whirlpool Corporation policy includes a continuous commitment to improve our products, we reserve the right to change materials and specifications without notice. We also reserve the right to discontinue or transition products without notice.

Manufacturer's Suggested Retail Price (MSRP) and Minimum Advertised Price (MAP) provided for reference purposes only. Dealer alone determines advertised and retail prices.

Suite 523 Hampton Upgrade Package I




WFW75HEFW

4.5 cu. ft. Front Load Washer with Precision
Dispense



<http://www.whirlpool.com>

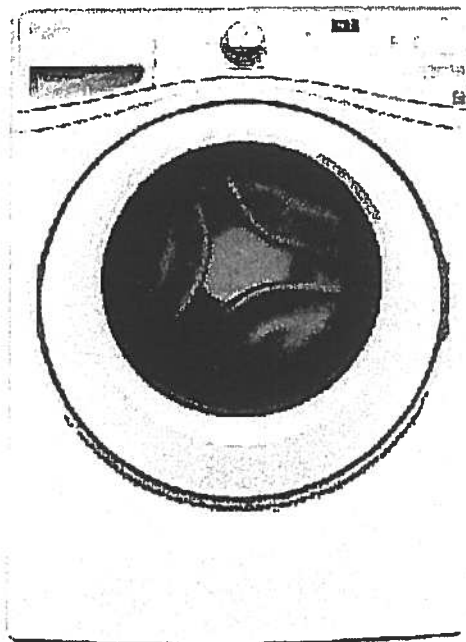

Key Features:

- Precision Dispense
- Adaptive Wash Technology
- Smooth Wave Stainless Steel Wash Basket
- 4.5 cu. ft. Capacity
- ENERGY STAR® Qualified

Product Dimensions:

Height: 39 3/4

Width: 27

Depth: 33 5/16

Electrical Requirements:

15 or 20. 120 V.

Additional Information:

[Use And Care Guide](#)

[Dimension Guide](#)

[Installation Guide](#)

[Energy Guide](#)

[Warranty Certificate](#)

INVESTED
IN
AMERICA



®Registered trademark/TM Trademark of Whirlpool, U.S.A. © 2013 Whirlpool Corporation All Rights Reserved.
All other trademarks are owned by their respective companies.
Because Whirlpool Corporation policy includes a continuous commitment to improve our products, we reserve the right to change materials and specifications without notice. We also reserve the right to discontinue or transition products without notice.
Manufacturer's Suggested Retail Price (MSRP) and Minimum Advertised Price (MAP) provided for reference purposes only. Dealer alone determines advertised and retail prices.
Created On: Wednesday, March 23, 2016 11:51:03

Suite 523 Hampton Upgrade Package 1




YWED75HEFW

Whirlpool®

8.5 cu. ft. Duet® High Efficiency Front Load Electric
Dryer with ENERGY STAR®

<http://www.whirlpool.com>

MSRP: \$0.00

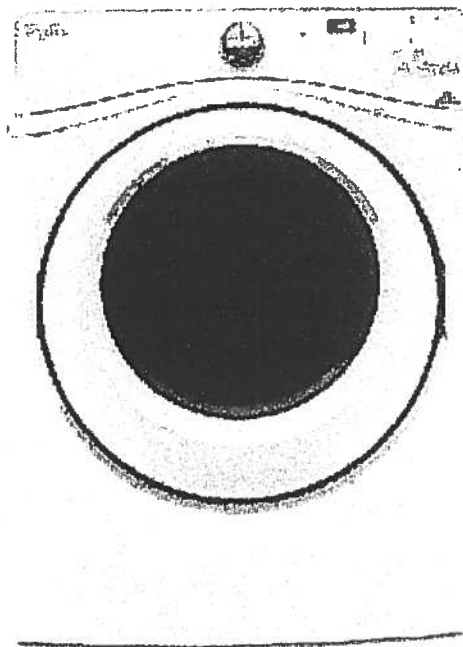

Key Features:

- Advanced Moisture Sensing System
- Quad Baffles
- Tap Touch Controls with Memory
- EcoBoost™ Option
- Wrinkle Shield™ Plus Option
- Undercounter Installation
- 7.4 Cu. Ft. Capacity
- ENERGY STAR® Qualified

Product Dimensions:

Height: 39

Width: 27

Depth: 31

Additional Information:

[Use And Care](#)

[Installation Guide](#)

[Warranty](#)

Available in:

☐ White

INVESTED
IN
AMERICA

ADA
Compliant

®Registered trademark/TM Trademark of Whirlpool, U.S.A. © 2016 Whirlpool Corporation All Rights Reserved. All other trademarks are owned by their respective companies.


Because Whirlpool Corporation policy includes a continuous commitment to improve our products, we reserve the right to change materials and specifications without notice. We also reserve the right to discontinue or transition products without notice.

Manufacturer's Suggested Retail Price (MSRP) and Minimum Advertised Price (MAP) provided for reference purposes only. Dealer alone determines advertised and retail prices.

Standard




Suite 523
Hampton

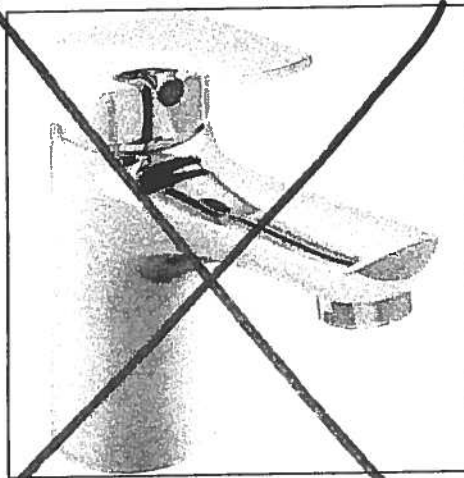


Delta Wynne Chrome Single Lever
Lavatory Faucet With Pop Up
#534LF

Master Ensuite
Shower Stall

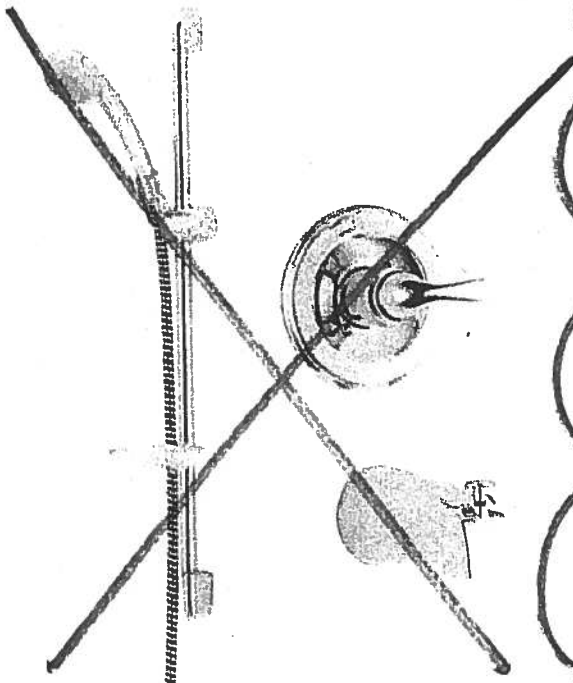

Delta Shower Trim with Tub Spout and
Hansgrohe Slide Bar with Handheld
#R10000/T13020-CDN/2001-TP/27454002/
27744000

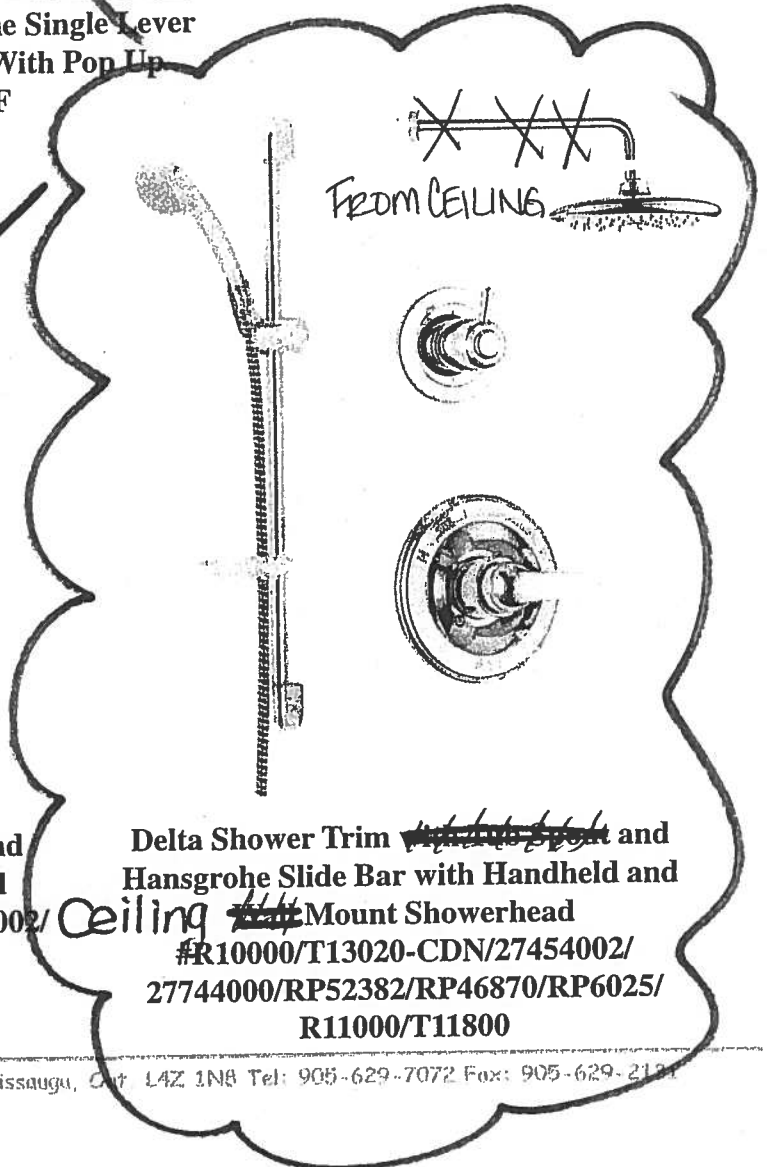

Delta Shower Trim ~~with Tub Spout~~ and
Hansgrohe Slide Bar with Handheld and
Ceiling ~~Mount~~ Showerhead
#R10000/T13020-CDN/27454002/
27744000/RP52382/RP46870/RP6025/
R11000/T11800

Suite 523
Hampton

Main Bath
Master Ensuite

CALI®

4.8Lpf / 1.28Gpf 1PC 16⁷/₈" HIGH ELONGATED

☐ 4710BOV Lined Tank

☐ 4710BOVU Unlined Tank

Product Specs:

- High efficiency toilet
- 4.8Lpf/1.28Gpf
- Elongated bowl with concealed skirted trapway
- Vitreous china
- 16⁷/₈" Plus Height bowl
- Soft white tank lever
- 12" (305mm) Rough-in
- 2" Fully glazed ball pass trapway
- 3" Flapper
- Siphon jet flush action
- Water surface (240mm x 170mm) 9¹/₂" x 6⁵/₈"
- Decorative chrome and soft white side caps included
- Smooth close toilet seat included

Overall Dimensions:

392mm (W) x 725mm (D) x 760mm (H)

15¹/₂" (W) x 28¹/₂" (D) x 29⁷/₈" (H)

Compliance Certifications:

Meets or exceeds the following:

- IAPMO cUPC
- US EPA WaterSense
- ASME A 12.19.2 / CSA B45.1-2013
- ADA Guidelines & ANSI A117.1
- MaP Tested 1000g
- LEED Compliant

Shipping:


Cube 9.39

GW 92.50lbs



Notes:

This toilet is designed to rough-in at a minimum dimension of 305mm (12") from finished wall to C/L of outlet. Supply line not included with fixture and must be ordered separately.
Important: Dimensions of fixtures are nominal and may vary within the range of tolerances established by ASME standard A112.19.2. These measurements are subject to change or cancellation. No responsibility is assumed for use of superseded or voided pages.
Products are designed to comply ADA/ANSI A117.1 Standard. It shall be the responsibility of the installer to comply with the local disability codes and standards prior to installing the product.

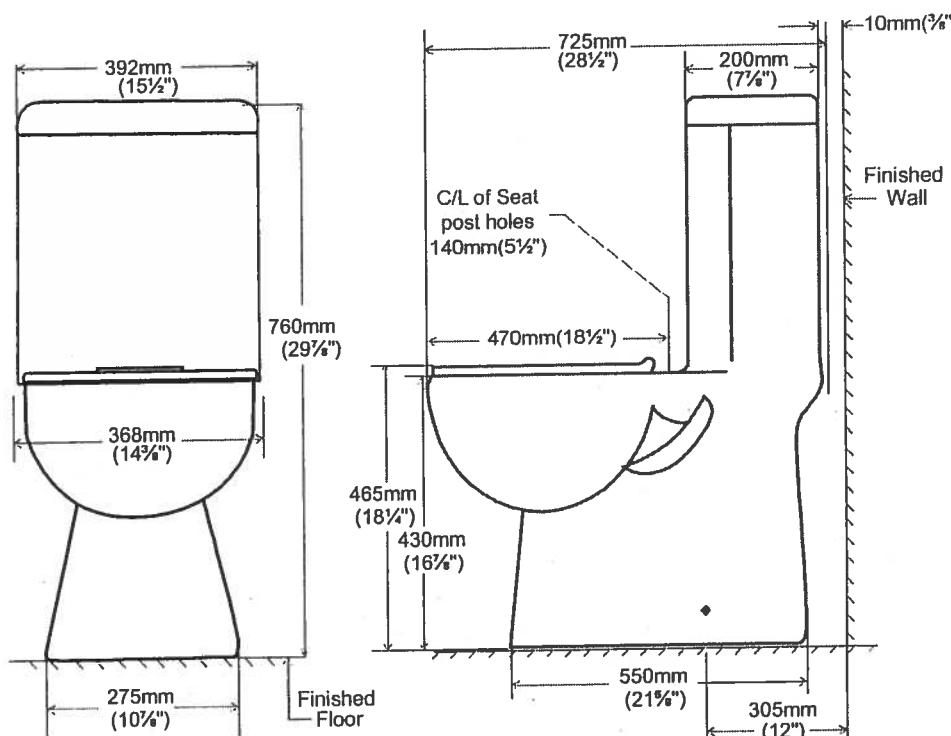

contrac.

5970 Chedworth Way, Unit A, Mississauga, ON, Canada L5R 3V5
www.contrac.ca

Revised: January 2016

Suite 523

Hampton

Living Room

→ CONDUIT =

CABLE/BELL

@ 60"

TV →

← PLUG

← conduit

BLANK
PLATE

PLUG

Countertop Edges

Suite 523

Hampton



CONNOLLY Marble & Granite Ltd.

EDGE
DETAILS

004


A.



STRAIGHT EDGE
(STANDARD - 3/4")

Standard:

Main Bath
Master Ensuite

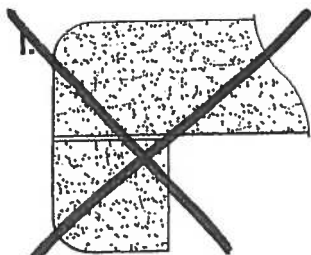

DOUBLE TOP "D" EDGE
(STANDARD - 1 1/2")

M.



OGEE - SQUARE EDGE
(MED./HIGH - 1 1/2")

Upgrade:
Kitchen

EDGING UP-GRADE OPTIONS