



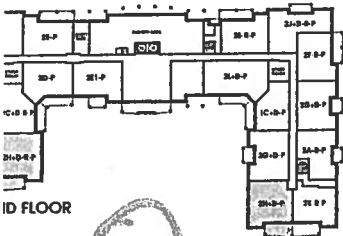

# Glen Cove

SUITE 410  
ORIGINAL LAYOUT

1,162 SQ FT *plus 168 sq. ft. of balcony area*

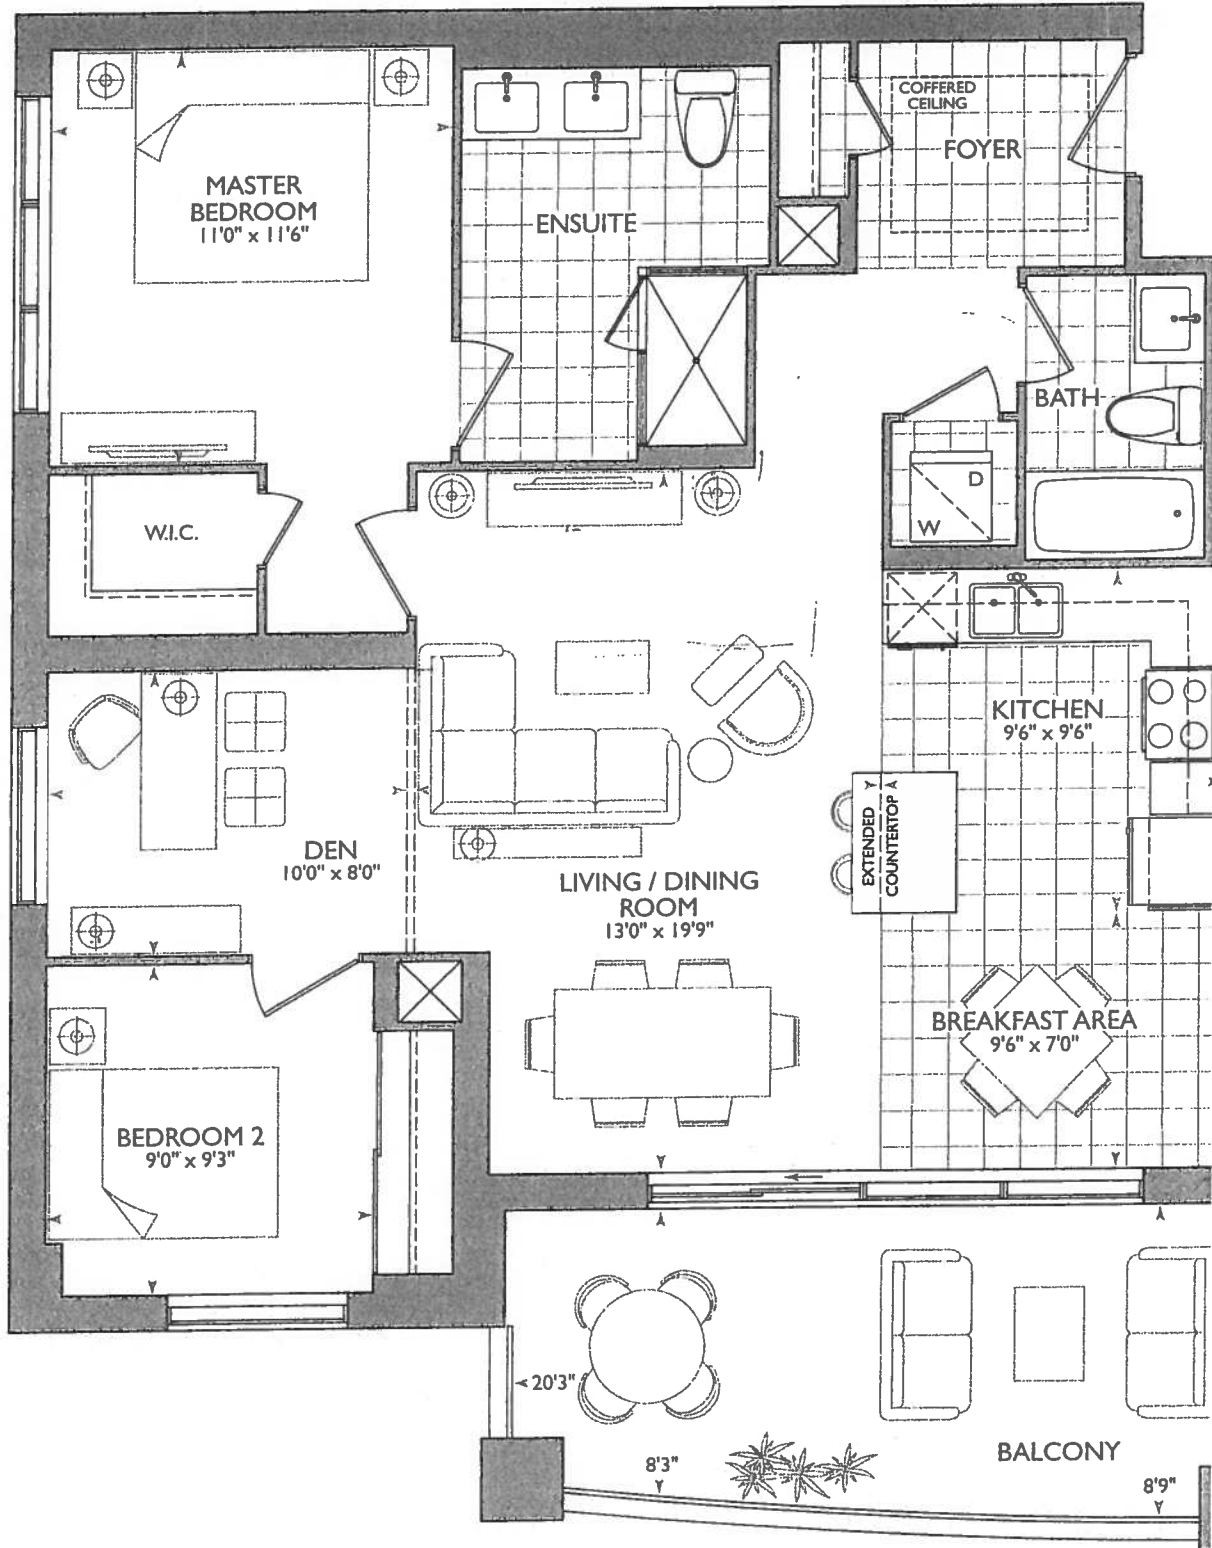

15

January 31, 2018

> Install Standard Laminate Throughout; Foyer + Kitchen / Breakfast


> Install Vac Pod Unit at Foyer Closet and (1) Additional Voe Rough-In Inlet at Den

\* BARRIER FREE SUITE \*

KITCHEN

- STD APPLIANCE PACKAGE
- (x6) = PUCK LIGHTS
- (x2) = PLUGS ISLAND
- 54" = STOVE PIPE CENTER
- 68" = SINK PIPE CENTER
- MAIN + ENSUITE RAISED VANITIES 36 1/4" + 3" SPLASH


RECEIVED  
Dec 19 2017

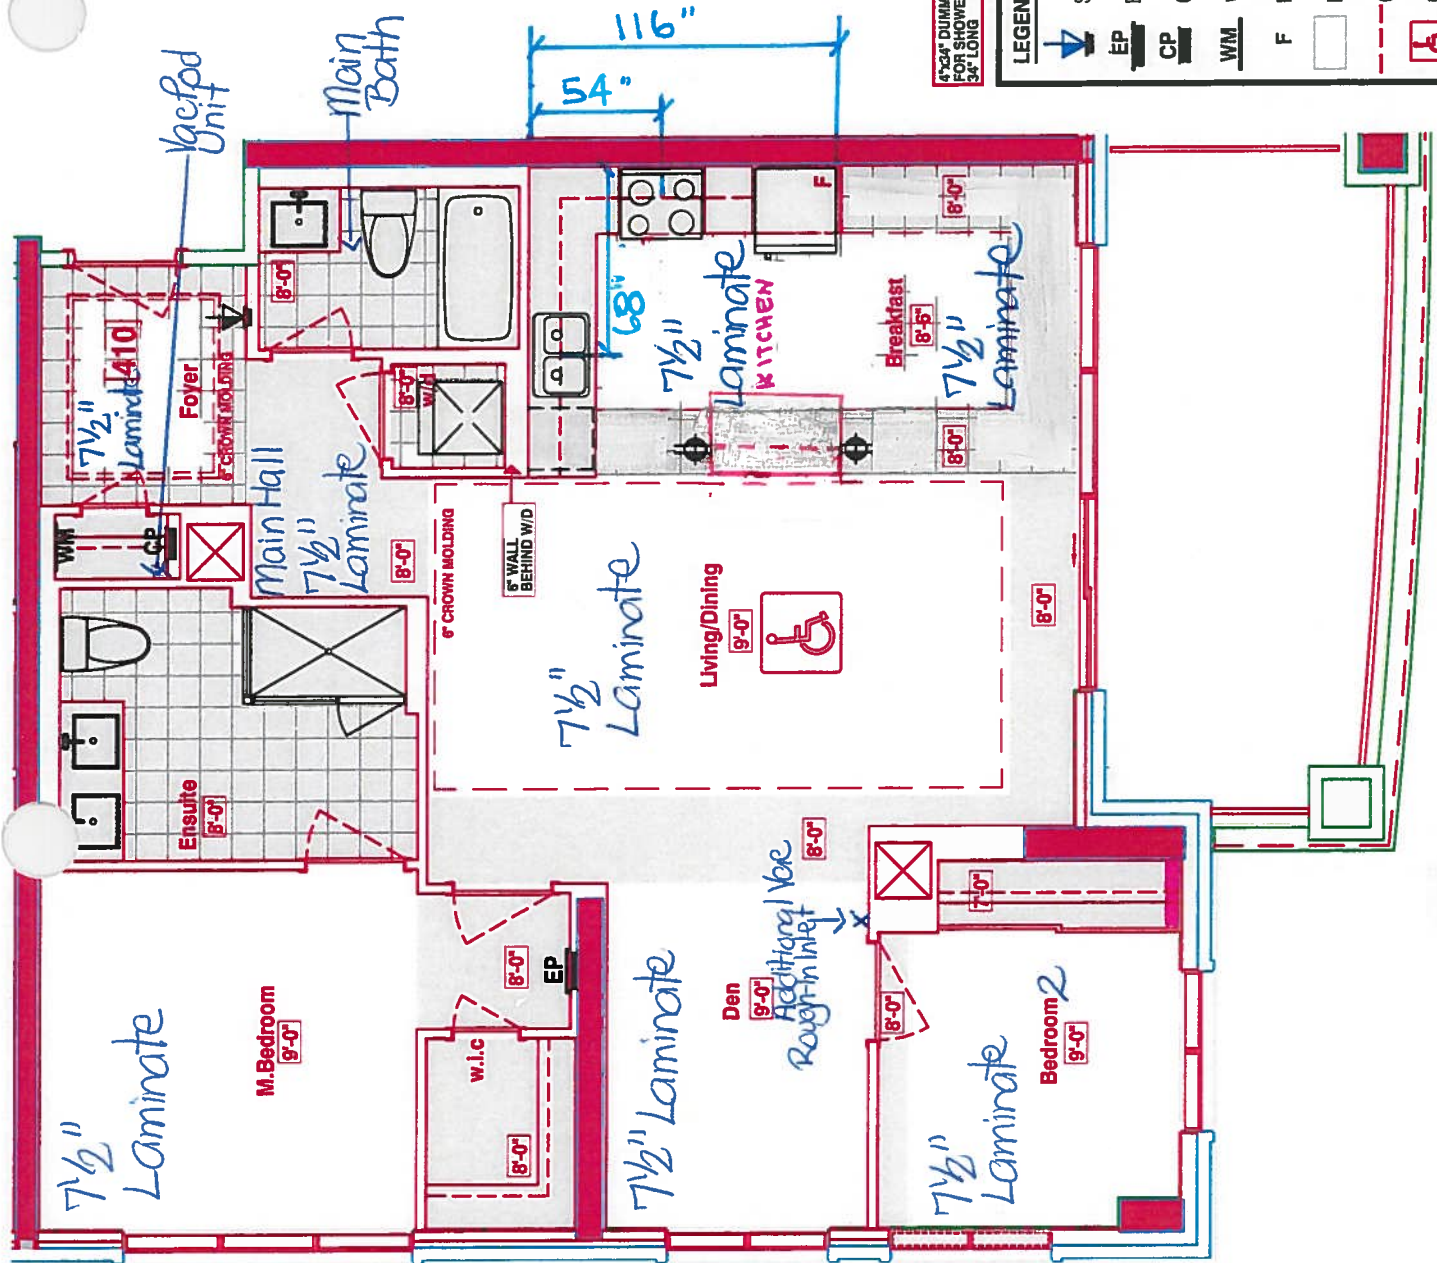

4"x24" DUMMY WALL FOR SHOWER FAUCET 34" LONG

LEGEND:

- SECURITY PANEL
- ELECTRICAL PANEL
- COMMUNICATION PANEL
- WATER METER
- FRIDGE
- DROPPED AREA
- 6" CROWN MOLDING
- BARRIER FREE SUITE

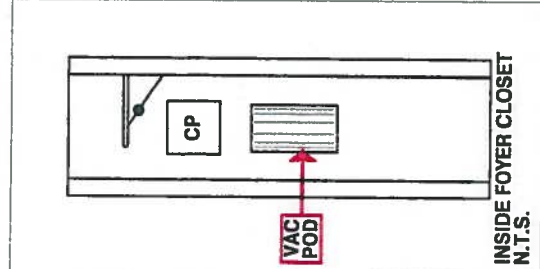



CONSTRUCTION SUMMARY

Hampton Place

PURCHASER: BRANISLAV STOJICIC TEL: RES.: 905-201-0998

| LOT NUMBER | PHASE | HOUSE TYPE | CLOSING DATE |
|------------|-------|------------|--------------|
| 410        | 1     | GLEN COVE  | 26-Oct-18    |

|          |                                                                                                                         |
|----------|-------------------------------------------------------------------------------------------------------------------------|
| Offer    | PURCHASER TO RECEIVE \$10,000(INCLUDES APPLICABLE TAXES) WORTH OF UPGRADES AT THE DECOR CENTER AT TIME OF COLOUR CHART. |
| Workshee | Note:                                                                                                                   |

|          |                                  |
|----------|----------------------------------|
| Offer    | ADDITIONAL - SINGLE PARKING UNIT |
| Workshee | Note:                            |

|          |                                                                                                                                                                                                             |
|----------|-------------------------------------------------------------------------------------------------------------------------------------------------------------------------------------------------------------|
| Offer    | PURCHASER TO HAVE THE OPTION AT THE TIME OF THE COLOUR CHART TO SUBSTITUE STANDARD LAMINATE FLOORING IN LIEU OF <del>TILES IN KITCHEN</del> , BREAKFAST AREA, MAIN FOYER AND MAIN CLOSET AT NO EXTRA CHARGE |
| Workshee | Note:                                                                                                                                                                                                       |



SITE COPY

CONSTRUCTION SUMMARY

Hampton Place

PURCHASER: BRANISLAV STOJICIC

TEL: RES.: 905-201-0998

|            |       |            |              |  |
|------------|-------|------------|--------------|--|
| LOT NUMBER | PHASE | HOUSE TYPE | CLOSING DATE |  |
| 410        | 1     | GLEN COVE  | 26-Oct-18    |  |

Date Added: 31-Jan-18      Invoice Number: 7104

1 - CLARIFICATION - REFER TO APAS;  
FOYER & KITCHEN/BREAKFAST - Install Standard Laminate Flooring in lieu of standard porcelain tiles throughout Foyer and Kitchen/Breakfast (See Sketch)

1 - LAUNDRY ROOM - 1ST UPGRADE - CERAMIC TILES - 13x13 RUSTIC GREY - To be installed throughout laundry room floor (See Sketch)  
Note:

1 - FOYER CLOSET - Install VAC-POD at Foyer Closet (Includes 30ft. air hose package)  
To Include; ONE (1) ADDITIONAL VAC-ROUGH-IN INLET at den. (See Sketch)  
Note:

1 - KITCHEN & BATHROOMS - SEE QUALITY TOPS & KITCHENS FOR ALL KITCHEN & BATHROOMS UPGRADES / LAYOUTS. - Upgrade Package #1 (See Attached QTK Paperwork)  
Note:

1 - KITCHEN - CABINETRY - Install UPGRADE PACKAGE #1 - Category 3 Fiberboard Cloud White QT 4801 - To be installed throughout kitchen, where applicable (See Sketch)  
Note:

2 - KITCHEN - Install TWO (2) ADDITIONAL PUCK LIGHTS (Same Switch as Standard Puck Lights) at kitchen. To be installed below kitchen cabinetry, where applicable. (See Attached QTK Layout for Locations)  
Note: Purchaser Paying Difference for Additional Puck Lights - Standard Kitchen to Receive Four (4) Puck Lights - Upgrade Kitchen Requires Six (6) Puck Lights

1 - KITCHEN - Install 1ST UPGRADE CAESARSTONE COUNTERTOP - 4030 STONE GREY - To be installed throughout kitchen, where applicable (Does not include backsplash) (See Sketch)  
Note:

1 - KITCHEN - COUNTERTOP EDGING - Install UPGRADE " I " EDGE - To be installed throughout kitchen countertop, where applicable (See Sketch)  
Note:

1 - DISCLAIMER - STONE COUNTERTOP;  
KITCHEN - Stone slabs vary in size & all seams are visible & the fabricator reserves the right to position the seams as necessary.  
Note:

1 - KITCHEN - Kitchen Backsplash - Install Standard 3x6 SUBWAY WHITE in UPGRADE BRICK PATTERN - To be installed throughout kitchen, where applicable (does not include behind the fridge or stove) (See Sketch)  
Note:

1 - KITCHEN - Kitchen Sink - Install Upgrade Undermount Sink - BLANCO Quatrus U Super Single Undermount Sink - Model # 401248 (See Attached)  
Note:

1 - KITCHEN - Kitchen Faucet - Install Standard Faucet - DELTA Chrome Pull-Out Kitchen Faucet (Single Hole) - Model # 469LF - Chrome  
Note:

1 - KITCHEN - APPLIANCE PACKAGE - Install STANDARD APPLIANCE PACKAGE - To be installed throughout suite, where applicable (See Sketch)  
Note:

1 - MAIN BATH & MASTER ENSUITE - Install RAISED VANITY HEIGHT at Main Bath and Master Ensuite Vanities, where applicable. (See Attached QTK Paperwork)  
Note:

1 - MAIN BATH - Install Standard Granite Countertop - BIANCO ANTICO - To be installed throughout main bath vanity where applicable (Includes 3" Splash) (See Sketch)  
Note:



SITE COPY

CONSTRUCTION SUMMARY

Hampton Place

PURCHASER: BRANISLAV STOJICIC TEL: RES.: 905-201-0998

|            |       |            |              |
|------------|-------|------------|--------------|
| LOT NUMBER | PHASE | HOUSE TYPE | CLOSING DATE |
| 410        | 1     | GLEN COVE  | 26-Oct-18    |

Date Added: 31-Jan-18 Invoice Number: 7104

1 - MASTER ENSUITE - Install Standard Granite Countertop - BIANCO ANTICO - To be installed throughout master ensuite vanity where applicable (Includes 3" Splash) (See Sketch)

1 - CLARIFICATION;  
MAIN BATH & MASTER ENSUITE - Install Standard 3" Splash throughout Main Bath and Master Ensuite Vanity Countertop where applicable (See Sketch)  
Note:

1 - DISCLAIMER - GRANITE COUNTERTOP;  
MAIN BATH & MASTER ENSUITE - Due to the many variables that can affect the pattern, colour and/or design and "pitting" of natural products, granite installed will not be identical to the samples displayed.  
Note: Every effort is made to provide granite countertops as close as possible but the vendor is not responsible for results which differ from the sample displayed. All countertop surfaces may have seams, and product pattern and shade can change in areas containing seams.

1 - DISCLAIMER - STONE COUNTERTOP;  
MAIN BATH & MASTER ENSUITE - Stone slabs vary in size & all seams are visible & the fabricator reserves the right to position the seams as necessary.  
Note:

1 - CLARIFICATION;  
MAIN BATH & MASTER ENSUITE - Install Standard Plumbing Fixtures throughout Main Bath and Master Ensuite where applicable. (See Sketch)  
Note:

1 - CLARIFICATION;  
MASTER ENSUITE - Purchaser accepts & acknowledges the standard frameless glass enclosure at master ensuite shower stall will NOT touch the wall and will receive a Standard Chrome Header. (See Sketch)

1 - BONUS PACKAGE - PURCHASER HAS APPLIED \$10,000.00 (Includes Taxes) WORTH OF UPGRADE PROMOTIONAL PACKAGE TOWARDS THE PURCHASE OF UPGRADES COMPLETED AT THE DECOR CENTRE.  
Note:

1 - PURCHASER HAS ATTENDED A COLOR APPOINTMENT AT THE DECOR CENTRE AND HAS DECLINED ANY ADDITIONAL UPGRADES. Purchaser accepts and acknowledges that there will be no further changes/additions/deletions to be made upon signing on January 31,2018  
Note:

1 - PURCHASER AWARE AND ACCEPTS THAT ANY CHANGES MADE TO UPGRADES AFTER SIGNING THIS PURCHASERS EXTRA FORM ARE SUBJECT TO A MINIMUM ADMINISTRATION FEE OF \$1,000 PLUS A 10% HOLDBACK FEE.  
Note:

This Document is Extremely Time Sensitive - Printed 27 Feb 18 at 15:45



410

Printed Jan 31, 2018 3:01 pm



\* INTERIOR COLOUR SCHEME \*

|                                        |                                              |                                |                                                 |                                 |                                   |                    |
|----------------------------------------|----------------------------------------------|--------------------------------|-------------------------------------------------|---------------------------------|-----------------------------------|--------------------|
| <b>Purchaser</b><br>BRANISLAV STOJICIC | <b>Decor Consultant</b><br>Melissa Di Marino | <b>Model Type</b><br>GLEN COVE | <b>Telephone Res. / Bus</b><br>(905) 201-0998 / | <b>Project</b><br>Hampton Place | <b>Closing Date</b><br>26/10/2018 | <b>Unit</b><br>410 |
|----------------------------------------|----------------------------------------------|--------------------------------|-------------------------------------------------|---------------------------------|-----------------------------------|--------------------|

Page 2 of 3

CABINETS, VANITIES AND COUNTERTOPS

|                   | Style                                                                                   | Countertop                                                            | Counter Edge                                         | Handle / Knob | APPLIANCE PACKAGE                      |
|-------------------|-----------------------------------------------------------------------------------------|-----------------------------------------------------------------------|------------------------------------------------------|---------------|----------------------------------------|
| MAIN BATHROOM     | CATEGORY 1 - LP LAMINATE - CHILL QT 1022 (STD)                                          | <input checked="" type="checkbox"/> BIANCO ANTICO GRANITE (STD)       | <input checked="" type="checkbox"/> 1" A" EDGE (STD) | 3487-128      | Standard Package ✓<br>Std 31in Opening |
| MASTER ENSUITE    | CATEGORY 1 - LP LAMINATE - CHILL QT 1022 (STD)                                          | <input checked="" type="checkbox"/> BIANCO ANTICO GRANITE (STD)       | <input checked="" type="checkbox"/> 1" A" EDGE (STD) | 3487-128      |                                        |
| POWDER ROOM       | N/A                                                                                     | N/A                                                                   | N/A                                                  | N/A           |                                        |
| KITCHEN / DINETTE | <input checked="" type="checkbox"/> CATEGORY 3 - FIBERBOARD - CLOUD WHITE QT 4801 (UPG) | <input checked="" type="checkbox"/> 4030 Stone Grey CaesarStone (UPG) | <input checked="" type="checkbox"/> 1" I" EDGE (UPG) | 3487-128      |                                        |
| LAUNDRY ROOM      | N/A                                                                                     | N/A                                                                   | N/A                                                  | N/A           |                                        |
|                   |                                                                                         |                                                                       |                                                      |               |                                        |
|                   |                                                                                         |                                                                       |                                                      |               |                                        |

PLUMBING FIXTURES

|             |                                                                      |
|-------------|----------------------------------------------------------------------|
| KITCHEN     |                                                                      |
| Sink Model  | <input checked="" type="checkbox"/> UPGRADE - Blanco Quattus #401248 |
| Sink Faucet | <input checked="" type="checkbox"/> STANDARD                         |

TOILETS

|                |                                              |
|----------------|----------------------------------------------|
| Master Ensuite | <input checked="" type="checkbox"/> STANDARD |
| Main Bathroom  | <input checked="" type="checkbox"/> STANDARD |
| Powder Room    | N/A                                          |

VANITY FAUCETS

|                |                                              |
|----------------|----------------------------------------------|
| Master Ensuite | <input checked="" type="checkbox"/> STANDARD |
| Main Bathroom  | <input checked="" type="checkbox"/> STANDARD |
| Powder Room    | N/A                                          |

VANITY SINKS

|                |                                              |
|----------------|----------------------------------------------|
| Master Ensuite | <input checked="" type="checkbox"/> STANDARD |
| Main Bathroom  | <input checked="" type="checkbox"/> STANDARD |
| Powder Room    | N/A                                          |

SHOWER STALL / TUBS

|                             |                                              |
|-----------------------------|----------------------------------------------|
| Master Ensuite Shower Stall | <input checked="" type="checkbox"/> STANDARD |
| Master Ensuite Tub          | N/A                                          |
| Main Bathroom Tub           | <input checked="" type="checkbox"/> STANDARD |

|                    |                                                                |
|--------------------|----------------------------------------------------------------|
| Trim               |                                                                |
| Baseboard & Casing | <input checked="" type="checkbox"/> STANDARD                   |
| Interior Doors     | <input checked="" type="checkbox"/> STANDARD - CARRARA, SMOOTH |

|                                                 |                                                                     |
|-------------------------------------------------|---------------------------------------------------------------------|
| MISC. INSTALLATIONS                             |                                                                     |
| Ceramic Accessories<br>(installed by Vendor)    | <input checked="" type="checkbox"/> Yes <input type="checkbox"/> No |
| Bathroom Mirrors<br>(installed by Vendor)       | <input checked="" type="checkbox"/> Yes <input type="checkbox"/> No |
| Wire Shelving - Closet<br>(installed by Vendor) | <input checked="" type="checkbox"/> Yes <input type="checkbox"/> No |

Cornice Moulding / Medallion

|                |                                                         |
|----------------|---------------------------------------------------------|
| Foyer          | <input checked="" type="checkbox"/> STANDARD - #CTR-611 |
| Living Room    | <input checked="" type="checkbox"/> STANDARD - #CTR-611 |
| Dining Room    | <input checked="" type="checkbox"/> STANDARD - #CTR-611 |
| Den            | NONE                                                    |
| Master Bedroom | NONE                                                    |
| Bedroom 2      | NONE                                                    |
| Bedroom 3      | N/A                                                     |

Fireplace

|                   |     |
|-------------------|-----|
| Fireplace         | N/A |
| Location Flooring | N/A |
| Style             | N/A |
| Finish            | N/A |
| Marble            | N/A |
| Hearth            | N/A |

Paint Throughout

|       |                        |
|-------|------------------------|
| Walls | STANDARD - BIRCH WHITE |
| Trim  | STANDARD - WHITE       |


Page 2 of 3

Decor Consultant:

Purchaser:

Vendor:

Hampton Place

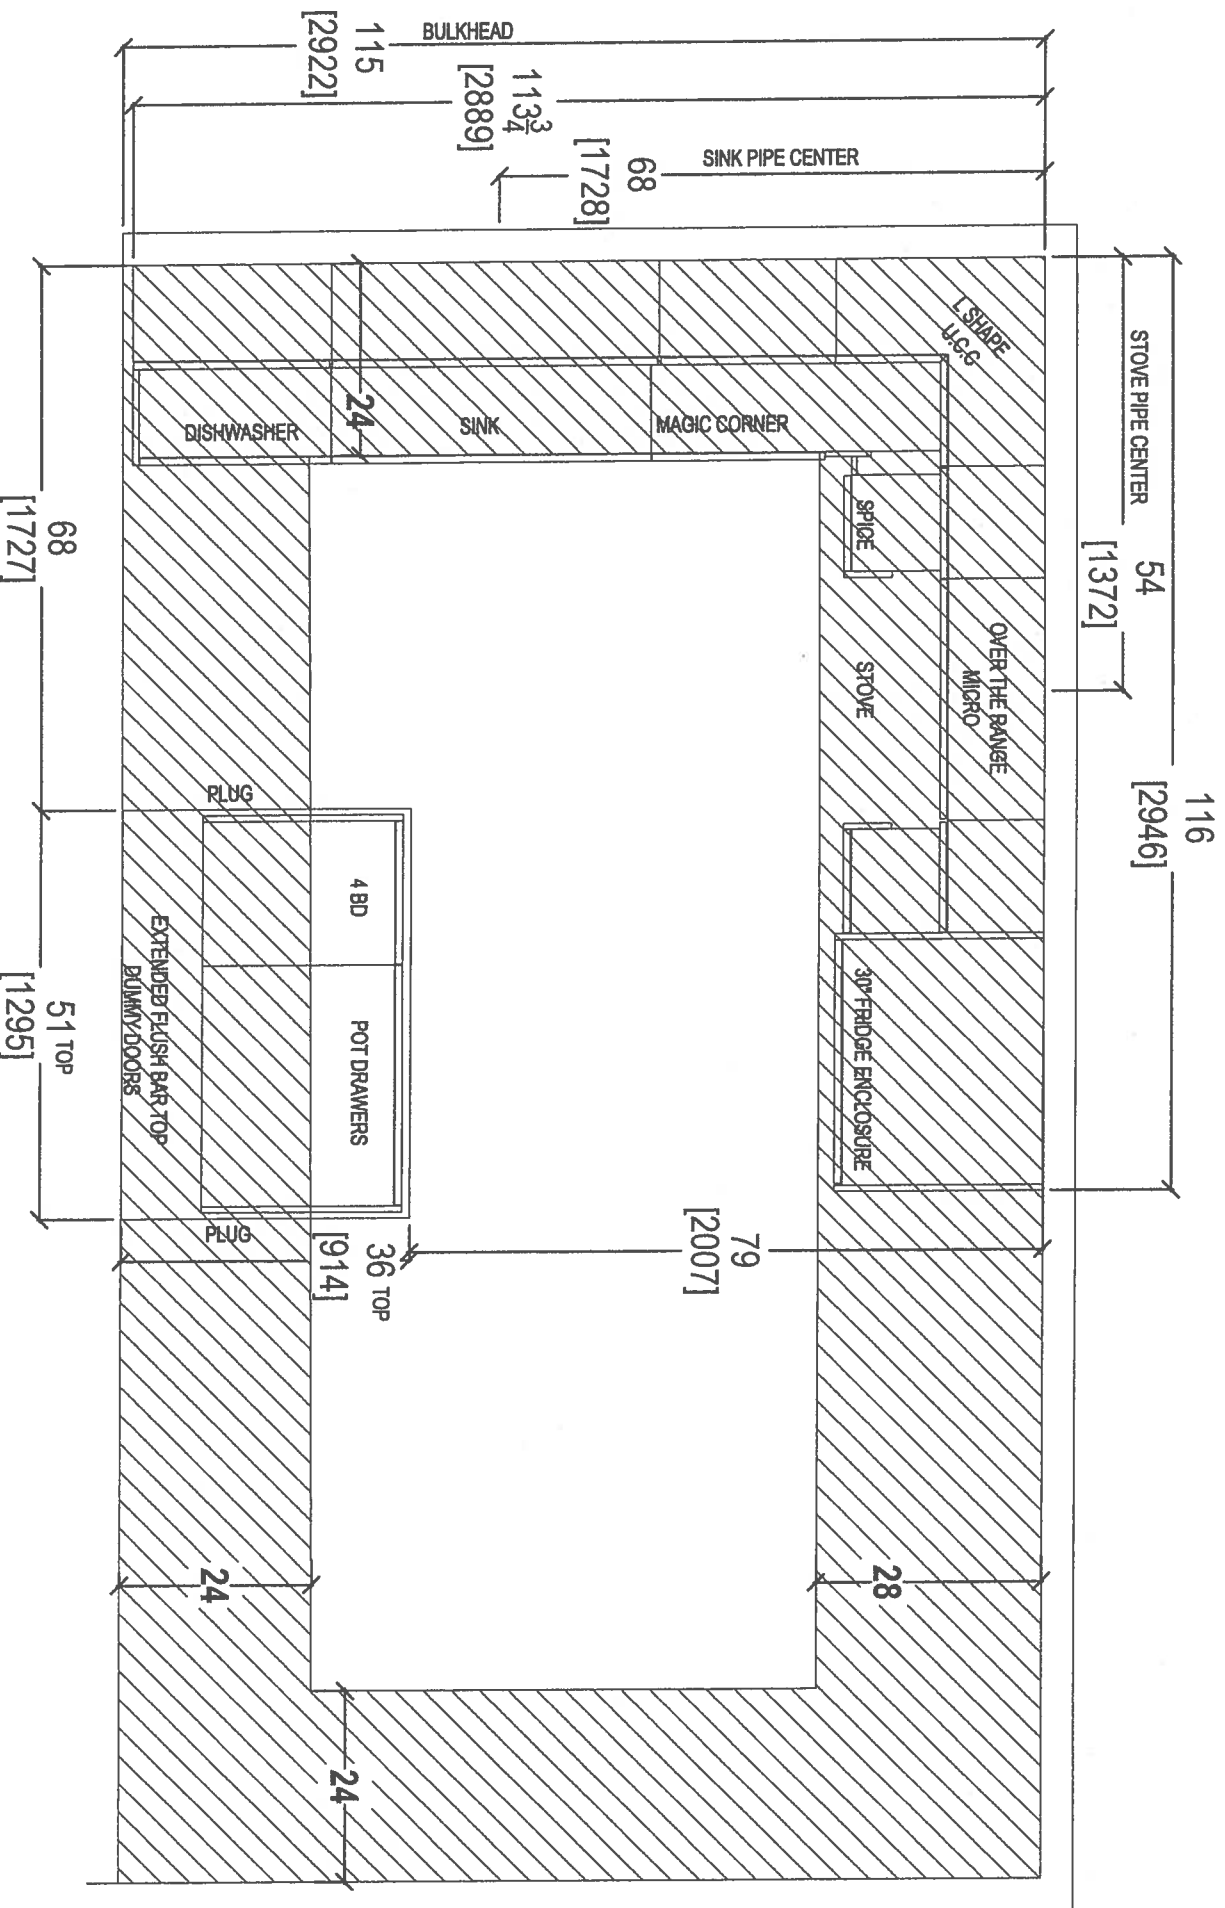

|                          |                        |                          |                     |
|--------------------------|------------------------|--------------------------|---------------------|
| CLIENT: ROYAL PINE HOMES | JOB NAME: UNIT 410 HMP | ROOM: KITCHEN FLOOR PLAN | DRAWN BY: SK        |
| SITE: HAMPTON PLACE      | DOOR STYLE: —          | DOOR HANDLE: —           | SCALE: 1/2" = 1'-0" |
| PHONE: —                 | FINISH: —              | DRW HANDLE: —            | DATE: MAY 1, 2018   |
| EMAIL: —                 | SPECIES: —             | TOP: —                   | PAGE: —             |




your kitchen, your taste

80 SANTE DRIVE, VAUCLIFF LAK 304,  
T. 416.746.1811

COMMENTS:

PLEASE NOTE ALL DIMENSIONS  
ARE NOT FINAL AND ARE  
SUBJECT TO CHANGE UPON  
FINAL SITE MEASURE


*6*

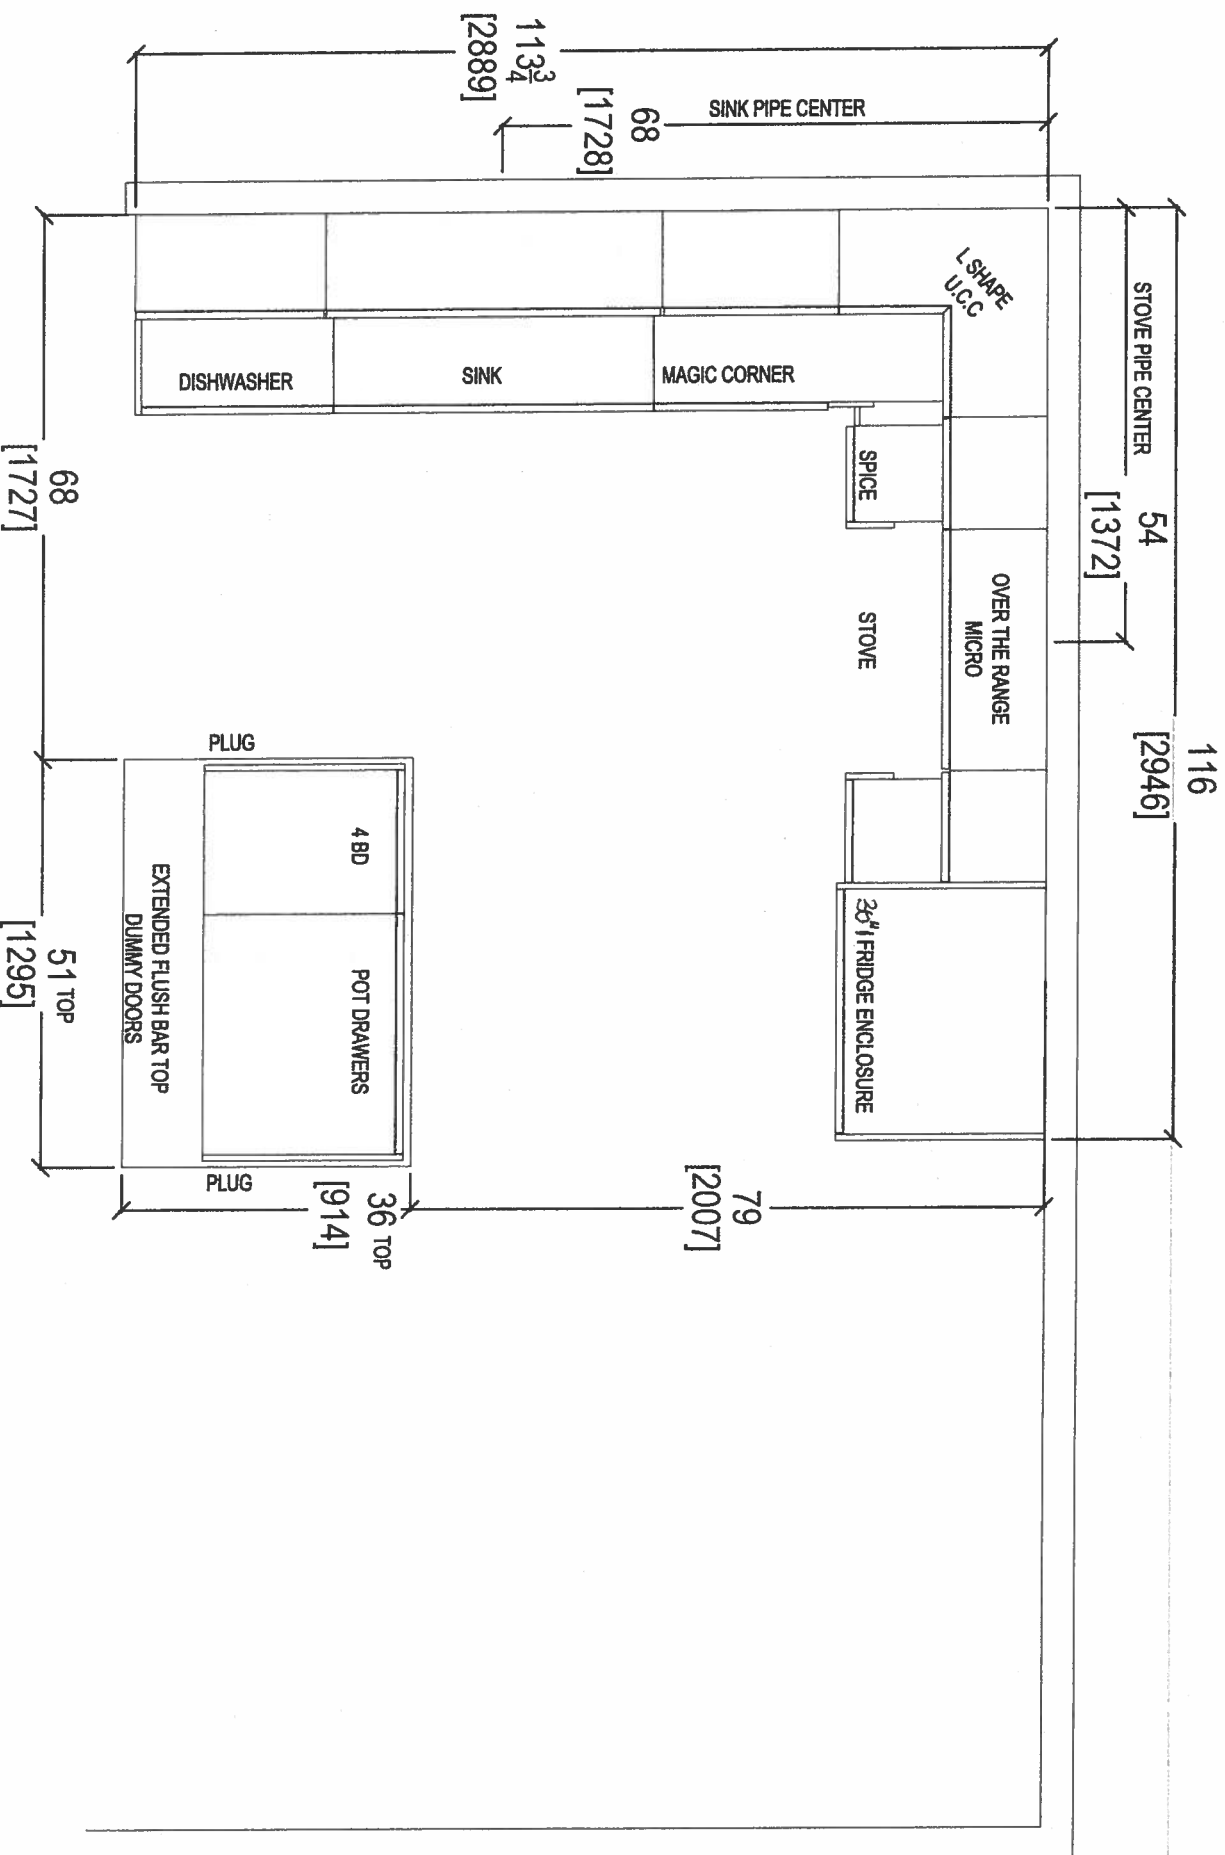

|                                                                                                         |                        |                          |                     |
|---------------------------------------------------------------------------------------------------------|------------------------|--------------------------|---------------------|
|                         |                        |                          |                     |
| 80 SANTE DRIVE, VAUGHAN, ON L4K 3C4, T: 416.746.1811                                                    |                        |                          |                     |
| CLIENT: ROYAL PINE HOMES                                                                                | JOB NAME: UNIT 410 HMP | ROOM: KITCHEN FLOOR PLAN | DRAWN BY: SK        |
| SITE: HAMPTON PLACE                                                                                     | DOOR STYLE: —          | DOOR HANDLE: —           | SCALE: 1/2" = 1'-0" |
| PHONE: —                                                                                                | FINISH: —              | DRW HANDLE: —            | DATE: MAY 1, 2018   |
| EMAIL: —                                                                                                | SPECIES: —             | TOP: —                   | PAGE: —             |
| COMMENTS:<br>PLEASE NOTE ALL DIMENSIONS ARE NOT FINAL AND ARE SUBJECT TO CHANGE UPON FINAL SITE MEASURE |                        |                          |                     |

69



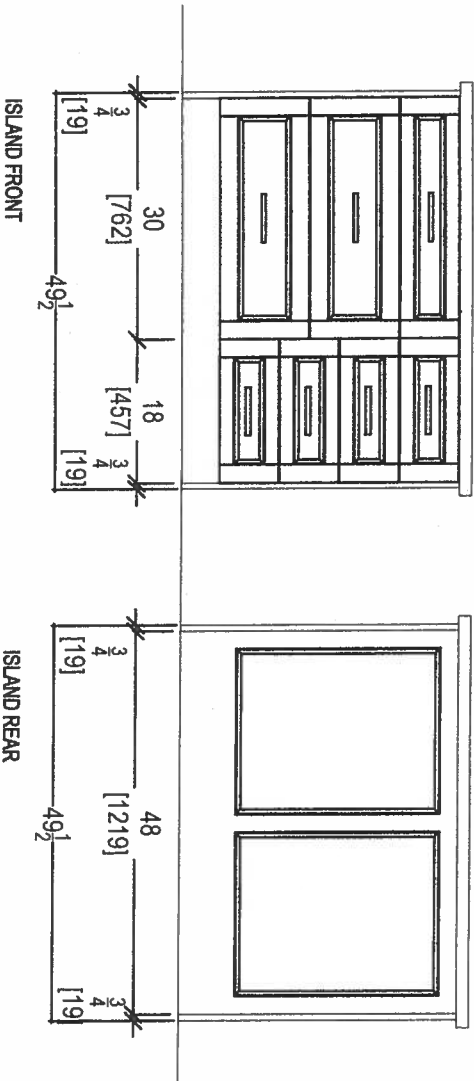





|                          |                        |                |                       |
|--------------------------|------------------------|----------------|-----------------------|
| CLIENT: ROYAL PINE HOMES | JOB NAME: UNIT 410 HMP | ROOM: KITCHEN  | DRAWN BY: SK          |
| SITE: HAMPTON PLACE      | DOOR STYLE: —          | DOOR HANDLE: — | SCALE: 1/2" = 1' - 0" |
| PHONE: —                 | FINISH: —              | DRW HANDLE: —  | DATE: MAY 1, 2018     |
| EMAIL: —                 | SPECIES: —             | TOP: —         | PAGE: —               |



80 SANTE DRIVE, VAUGHAN, ON L4K 3C4,  
T: 416.746.1811

COMMENTS:  
PLEASE NOTE ALL DIMENSIONS  
ARE NOT FINAL AND ARE  
SUBJECT TO CHANGE UPON  
FINAL SITE MEASURE

6

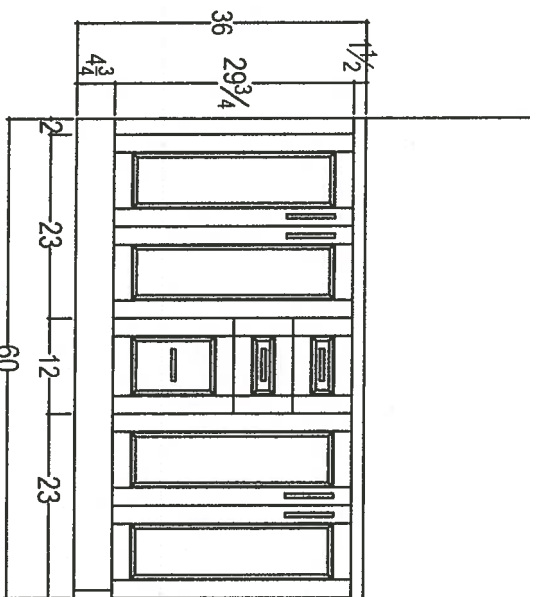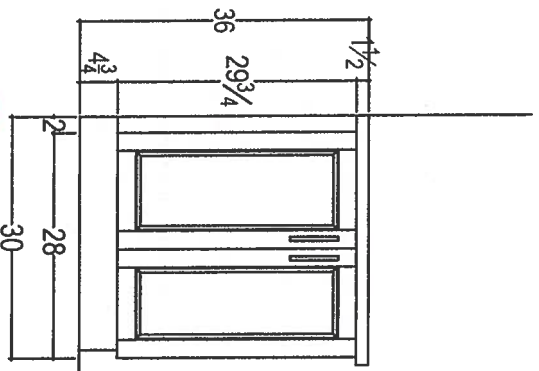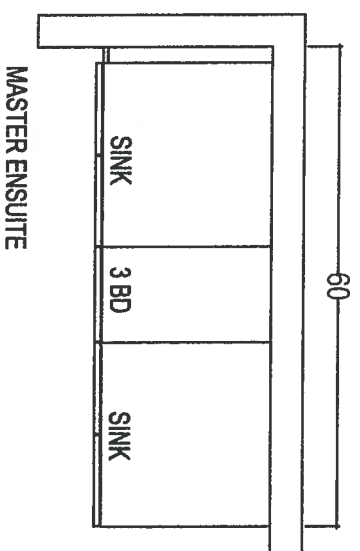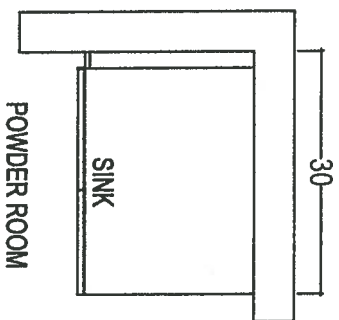

\*Raised Vanities\*  
+3" SPLASH

\*Raised Vanities\*  
+3" SPLASH



80 SANTE DRIVE, VICTORIA, BC V8N 1A4  
T: 416.746.5901

|                          |                        |                |                     |
|--------------------------|------------------------|----------------|---------------------|
| CLIENT: ROYAL PINE HOMES | JOB NAME: UNIT 410 HMP | ROOM: VANITIES | DRAWN BY: SK        |
| SITE: HAMPTON PLACE      | DOOR STYLE: —          | DOOR HANDLE: — | SCALE: 1/2" = 1'-0" |
| PHONE: —                 | FINISH: —              | DRW HANDLE: —  | DATE: MAY 1, 2018   |
| EMAIL: —                 | SPECIES: —             | TOP: —         | PAGE: —             |

COMMENTS:  
PLEASE NOTE ALL DIMENSIONS  
ARE NOT FINAL AND ARE  
SUBJECT TO CHANGE UPON  
FINAL SITE MEASURE

69

Suite 410  
Hampton



WRT318FZDM

Standard



<http://www.whirlpool.com>

30-inch Wide Top-Freezer Refrigerator with  
Flexi-Slide™ Bin - 18.2 cu. ft.

Key Features:

- Flexi-Slide™ Bin
- Frameless Glass Shelves
- Electronic Temperature Control
- Clear, Humidity Controlled Crispers

Product Dimensions:

Height: 65 7/8

Width: 29 3/4

Depth: 33 1/2


Additional Information:

[Use And Care Guide](#)

[Dimension Guide](#)

[Energy Guide](#)

[Warranty Certificate](#)

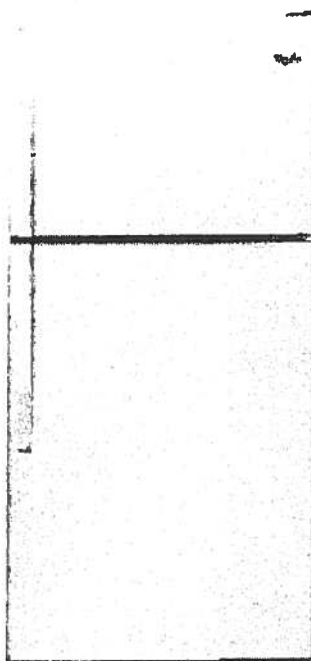

Available in:


- Black
- Monochromatic  
Stainless Steel
- White



©Registered trademark/TM Trademark of Whirlpool, U.S.A. © 2013 Whirlpool Corporation. All Rights Reserved  
All other trademarks are owned by their respective companies  
Because Whirlpool Corporation policy includes a continuous commitment to improve our products, we reserve  
the right to change materials and specifications without notice. We also reserve the right to discontinue or  
transition products without notice.  
Manufacturer's Suggested Retail Price (MSRP) and Minimum Advertised Price (MAP) provided for reference  
purposes only. Dealer alone determines advertised and retail prices.  
Created On: Monday, March 14, 2016 12:09:07

Suite 410  
Hampton

Standard

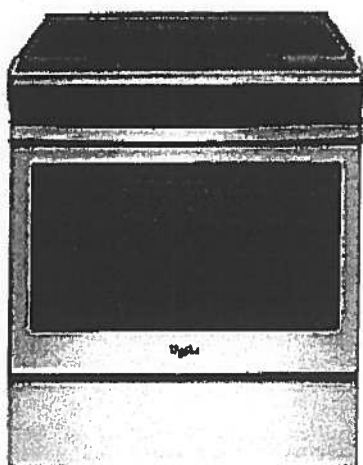

## WEE510S0FS

Whirlpool® 4.8 cu. ft. Guided Electric Front Control Range  
With The Easy-Wipe Ceramic Glass Cooktop

MSRP: \$1,149 00

| Available Colors                    |                                                            |
|-------------------------------------|------------------------------------------------------------|
| <input checked="" type="checkbox"/> | Black<br>Model: WEE510S0FB<br>MAJOR APPLIANCE              |
| <input checked="" type="checkbox"/> | Black-on-Stainless<br>Model: WEE510S0FS<br>MAJOR APPLIANCE |
| <input type="checkbox"/>            | White<br>Model: WEE510S0FW<br>MAJOR APPLIANCE              |

| Dimensions                                                                                                                    |                 |
|-------------------------------------------------------------------------------------------------------------------------------|-----------------|
| Depth                                                                                                                         | 28 15/16 Inches |
| Width                                                                                                                         | 29 7/8 Inches   |
| Gross Weight                                                                                                                  | 172 LB          |
| Dimensions shown are for planning purposes only. For complete information, see Installation Instructions packed with product. |                 |

| Specifications                    |                                                                                                                                          |
|-----------------------------------|------------------------------------------------------------------------------------------------------------------------------------------|
| Cooktop Features                  |                                                                                                                                          |
| Cooktop Element Style             | Smoothtop                                                                                                                                |
| Cooktop Surface Color             | Color Coordinated Black on Stainless                                                                                                     |
| Cooktop Surface Material          | Glass                                                                                                                                    |
| Number of Cooking Element-Burners | 4                                                                                                                                        |
| Left Front Element-Burner Power   | 3000W                                                                                                                                    |
| Left Front Element-Burner Size    | 9"/6"                                                                                                                                    |
| Left Front Element-Burner Type    | Dual                                                                                                                                     |
| Right Front Element-Burner Power  | 1200W                                                                                                                                    |
| Right Front Element-Burner Size   | 6"                                                                                                                                       |
| Right Front Element-Burner Type   | Radiant                                                                                                                                  |
| Left Rear Element-Burner Power    | 3000W                                                                                                                                    |
| Left Rear Element-Burner Size     | 9"/6"                                                                                                                                    |
| Left Rear Element-Burner Type     | Dual                                                                                                                                     |
| Right Rear Element-Burner Power   | 1200W                                                                                                                                    |
| Right Rear Element-Burner Size    | 6"                                                                                                                                       |
| Right Rear Element-Burner Type    | Radiant                                                                                                                                  |
| Oven Features                     |                                                                                                                                          |
| Number of Oven Lights             | 1                                                                                                                                        |
| Hot Surface Indicator Light       | Yes                                                                                                                                      |
| Power On Indicator Light          | Yes                                                                                                                                      |
| Light Type                        | Incandescent                                                                                                                             |
| Oven Rack Type                    | Standard (Both)                                                                                                                          |
| Controls                          |                                                                                                                                          |
| Drawer Type                       | Storage Drawer                                                                                                                           |
| Selections                        | Clock; Timer; Warm Hold; Delay Start; Cook Time Indicator; Control Lock; Automatic Door Latch; Audible Signal; Sabbath Mode; Frozen Bake |
| ADA Compliant                     | ADA Height and Operation Compliant                                                                                                       |
| Dimensions                        |                                                                                                                                          |
| Depth                             | 28 15/16 Inches                                                                                                                          |
| Width                             | 29 7/8 Inches                                                                                                                            |
| General                           |                                                                                                                                          |
| ADA Compliant                     | ADA Height and Operation Compliant                                                                                                       |

| Key Features                             |  |
|------------------------------------------|--|
| Frozen Bake™ Technology                  |  |
| Guided Cooktop Controls                  |  |
| FlexHeat™ Dual Radiant Elements          |  |
| Adjustable Self-Cleaning                 |  |
| Easy-Wipe Ceramic Glass Cooktop          |  |
| Temperature Sensor                       |  |
| 4.8 Cu. Ft. Capacity                     |  |
| Keep Warm Option                         |  |
| Closed Door Broiling                     |  |
| Delay Cook                               |  |
| Sabbath Mode                             |  |
| Star-K Certified                         |  |
| ADA Compliant                            |  |
| #1 Selling Appliance Brand in the U.S.A. |  |

| Product Literature                                                    |  |
|-----------------------------------------------------------------------|--|
| Warranty(33.12 KB)                                                    |  |
| Owners Manual(502.10 KB)                                              |  |
| Installation Instructions(995.40 KB)                                  |  |
| Dimension Guide(124.36 KB)                                            |  |
| You may need to install Adobe Acrobat Reader to view these documents. |  |

| UPC Listing                          |  |
|--------------------------------------|--|
| Model "WEE510S0FB" UPC: 883049391939 |  |
| Model "WEE510S0FS" UPC: 883049391946 |  |
| Model "WEE510S0FW" UPC: 883049391922 |  |

# Suite 410 Standard Hampton



WMH31017FS

**Whirlpool®**

1.7 cu. ft. Microwave Hood Combination with  
Electronic Controls

<http://www.whirlpool.com>

## Key Features:

- Microwave Presets
- Electronic Touch Controls
- Dishwasher-Safe Turntable Plate
- 2-Speed, 300 CFM Vent Fan
- Add 30 Seconds Option
- Adjustable Cooktop Lighting
- #1 Selling Appliance Brand in the U.S.A.

## Product Dimensions:

Height: 17 1/4

Width: 29 15/16

Depth: 17 7/8


## Additional Information:

[Use And Care Guide](#)

[Dimension Guide](#)

[Installation Guide](#)

[Warranty Certificate](#)

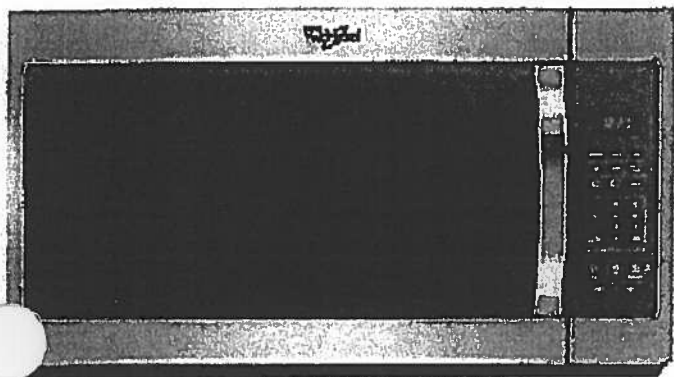

## Available in:

- ☒ Black
- ☒ Silver
- ☒ Stainless Steel
- ☐ White

©Registered trademark/TM Trademark of Whirlpool, U.S.A. © 2016 Whirlpool Corporation All Rights Reserved.  
All other trademarks are owned by their respective companies.  
Because Whirlpool Corporation policy includes a continuous commitment to improve our products, we reserve the right to change materials and specifications without notice. We also reserve the right to discontinue or transition products without notice.  
Manufacturer's Suggested Retail Price (MSRP) and Minimum Advertised Price (MAP) provided for reference purposes only. Dealer alone determines advertised and retail prices.  
Created On: Tuesday, February 07, 2017 12:20:03

Suite 410  
Hampton

Standard




WDF330PAHS

Whirlpool®

<http://www.whirlpool.com>

## Heavy-Duty Dishwasher with 1-hour Wash Cycle

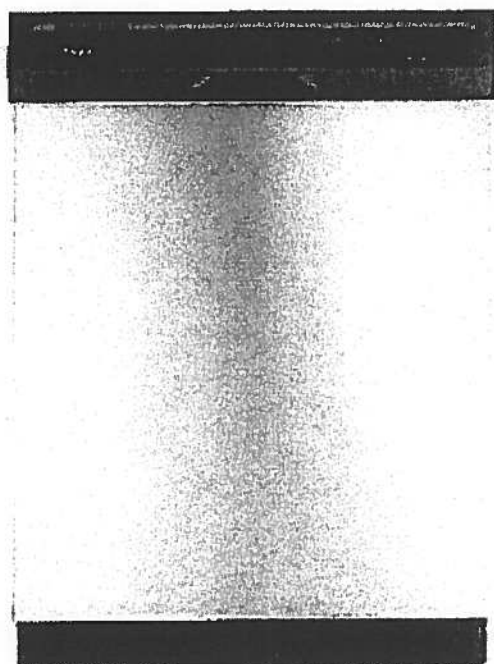

### Key Features:

- 1-Hour Wash Cycle
- No One Has Fewer Repairs 20 Years in a Row
- Soil Sensor
- Normal Cycle
- Heavy Cycle
- High Temperature Wash Option
- Heated Dry Option
- Designed, Engineered and Assembled in the U.S.A. with American Pride

### Product Dimensions:

Height: 34 1/2

Width: 23 7/8

Depth: 24 1/2

### Additional Information:

[Use And Care Guide](#)

[Dimension Guide](#)

[Installation Guide](#)

[Energy Guide](#)

[Warranty Certificate](#)

INVESTED  
IN  
AMERICA



©Registered trademark/TM Trademark of Whirlpool, U.S.A. © 2016 Whirlpool Corporation. All Rights Reserved.  
All other trademarks are owned by their respective companies.  
Because Whirlpool Corporation policy includes a continuous commitment to improve our products, we reserve the right to change materials and specifications without notice. We also reserve the right to discontinue or transition products without notice.  
Manufacturer's Suggested Retail Price (MSRP) and Minimum Advertised Price (MAP) provided for reference purposes only. Dealer alone determines advertised and retail prices.  
Created On: Wednesday, April 19, 2017 10:48:05

Suite 410  
Hampton


Standard

WET4027EW



<http://www.whirlpool.com>

Combination Washer/Electric Dryer

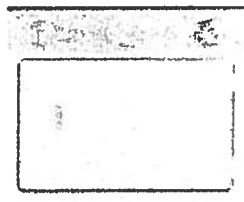

#### Key Features:

- HE Agitator with Fabric Softener Cap
- White Porcelain Basket
- AutoDry™ Drying System
- 3 Drying Temperatures
- 2.5 Cu. Ft. Washer Capacity
- 5.9 Cu. Ft. Dryer Capacity
- Fabric Softener Dispenser
- Bleach Dispenser

#### Product Dimensions:

Height: 71 3/4

Width: 27 1/2

Depth: 32

#### Electrical Requirements:

30.

#### Additional Information:

[Use And Care Guide](#)

[Dimension Guide](#)

[Installation Guide](#)

[Energy Guide](#)

[Warranty Certificate](#)

Available in:

☐ White

INVESTED  
IN  
AMERICA




©Registered trademark/TM Trademark of Whirlpool, U.S.A. © 2013 Whirlpool Corporation. All Rights Reserved.  
All other trademarks are owned by their respective companies.  
Because Whirlpool Corporation policy includes a continuous commitment to improve our products, we reserve the right to change materials and specifications without notice. We also reserve the right to discontinue or transition products without notice.  
Manufacturer's Suggested Retail Price (MSRP) and Minimum Advertised Price (MAP) provided for reference purposes only. Dealer alone determines advertised and retail prices.  
Created On: Friday, March 11, 2016 12:26:17

# Upgrade Kitchen Sinks




## BLANCO

Suite 410  
Hampton

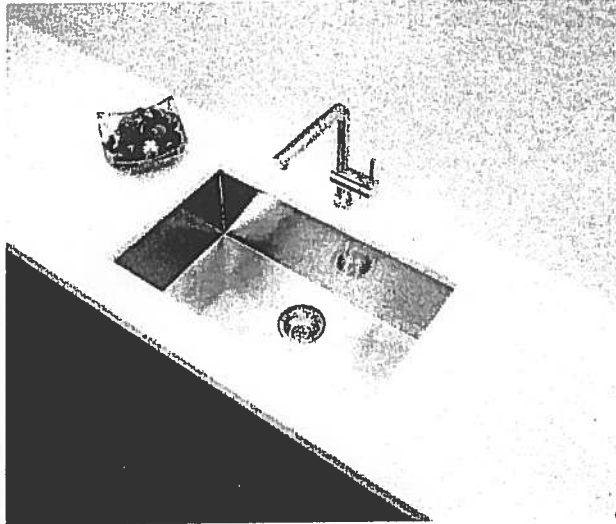

**Blanco Quatrus U Super Single  
Undermount Sink  
#401248**

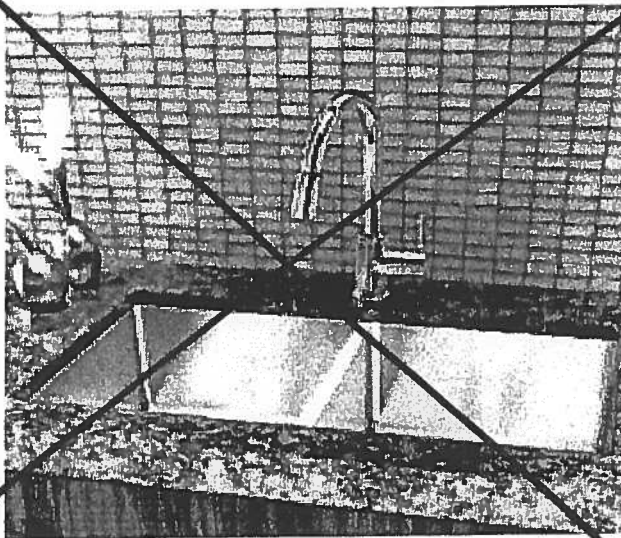

**Blanco Quatrus R15 Two Bowl  
Undermount Sink  
#401519**


Countertop Edges  
Suite 410  
Hampton




**CONNOLLY** Marble & Granite Ltd.

EDGE  
DETAILS


004

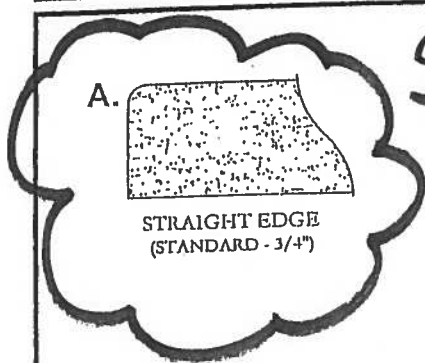

Standard:  
Main Bath  
Master Ensuite

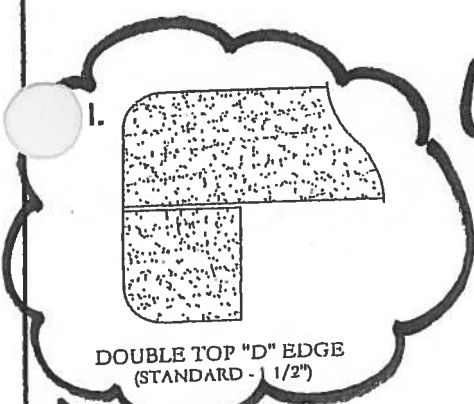

Upgrade:  
Kitchen

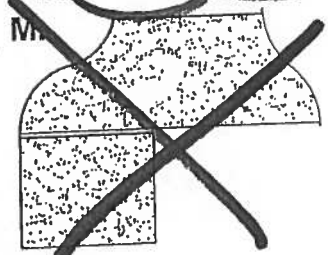

~~OGEE - SQUARE EDGE  
(MED./HIGH - 1 1/2")~~

EDGING UP-GRADE OPTIONS