




Aquebogue

SUITE 613


ORIGINAL LAYOUT.

1,497 SQ FT plus 338 sq. ft. of terrace area

SINGLE SINK.

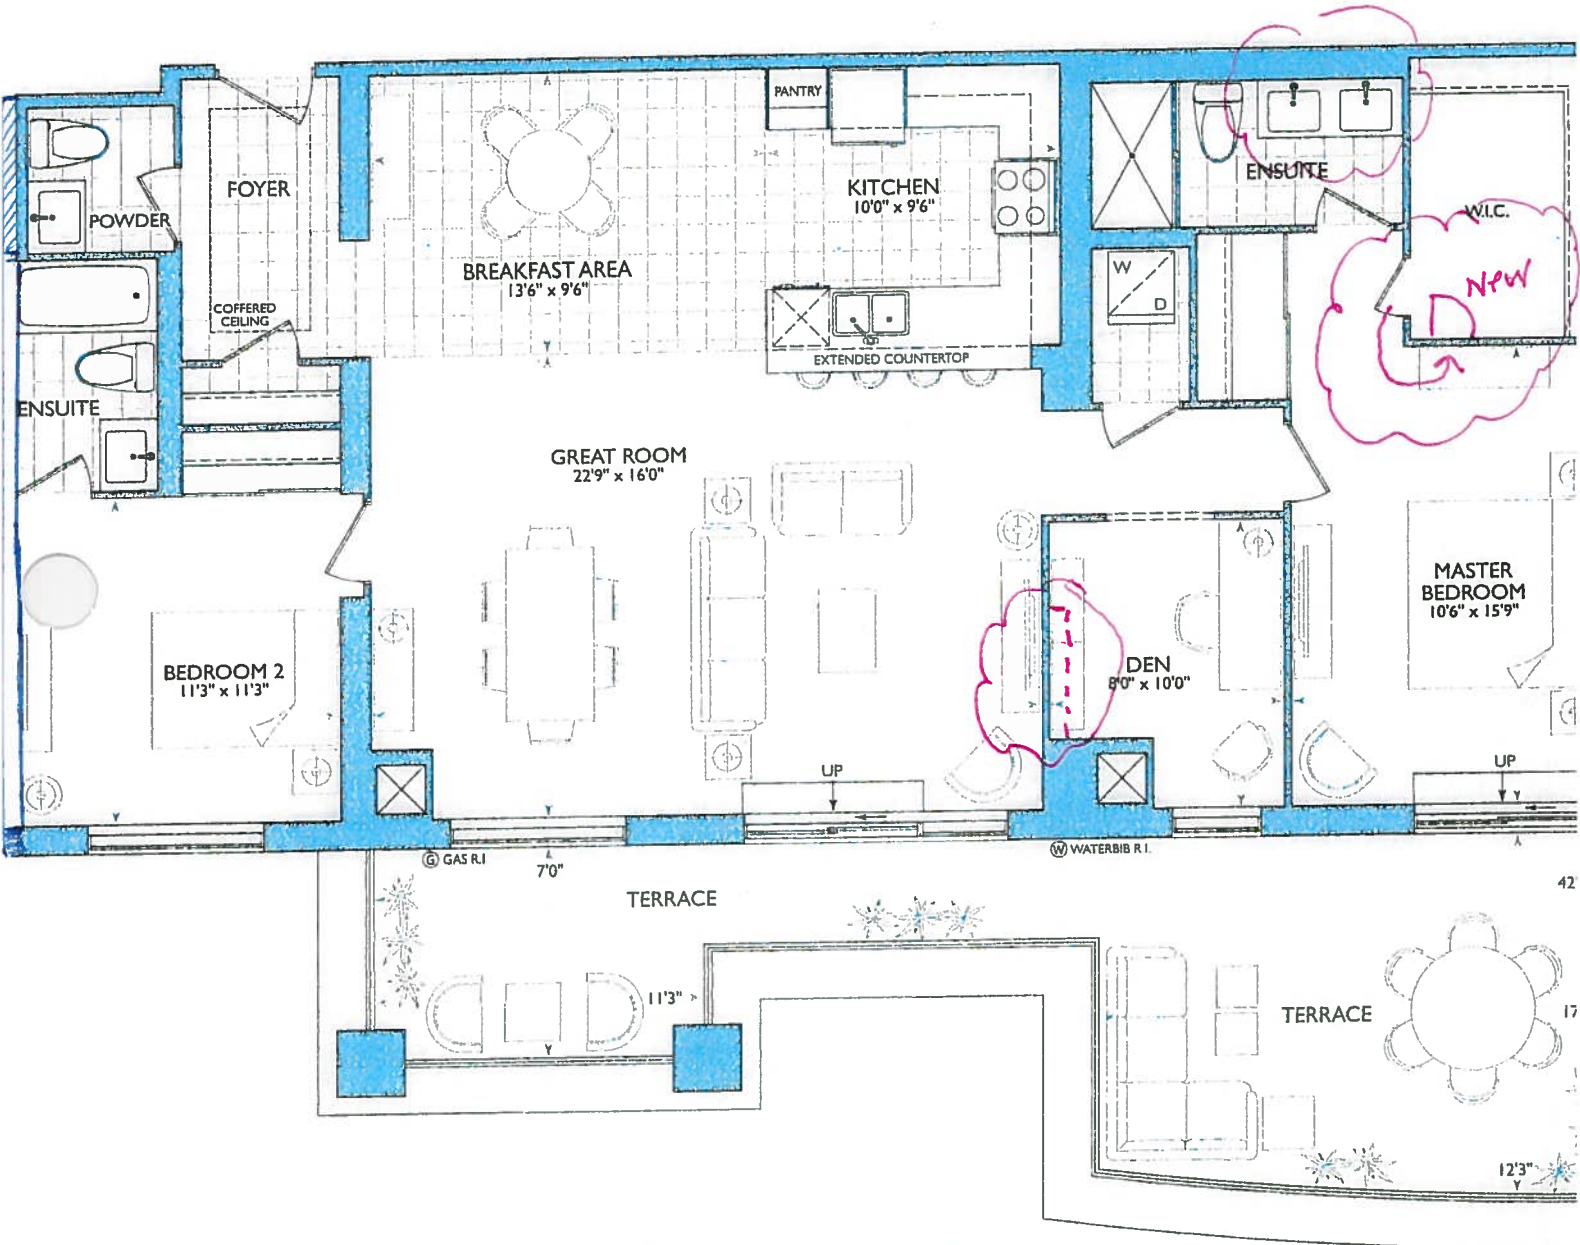

center

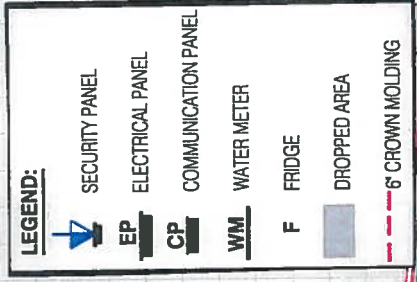

■ Royal Pine Homes ■ 25 Baker Hill Blvd - Stouffville, ON ■ May 07, 2018



CONSTRUCTION SUMMARY

Hampton Place

PURCHASERS: FRANCESCO STRAZZULLA and IRENE LIZOTTE

TEL: RES.: 905-927-1316

LOT NUMBER	PHASE	HOUSE TYPE	CLOSING DATE
613	1	AQUEBOGUE	05-Nov-18

Offer Worksheet	NO UPGRADES PURCHASED WITH AGREEMENT OF PURCHASE AND SALE. Note:
Offer Upgrade	DELETE TILE IN FOYER, BREAKFAST AREA AND KITCHEN AND INSTALL STANDARD LAMINATE AS PER VENDORS SAMPLES. Note:
Offer Upgrade	WATER LINE TO FRIDGE Note:
Offer Upgrade	DELETE ONE SINK IN MASTER ENSUITE INCLUDING ROUGH IN , CENTER SINK, ANY CHANGES TO STANDARD CABINETRY TO BE UPGRADED AT DECOR APPOINTMENT (ADMINISTRATION FEE ONLY) Note:
Offer Upgrade	CONDUIT AND BLOCKING FOR WALL MOUNTED TV , 60 INCHES ABOVE FINISHED FLOOR IN THE FAMILY ROOM AS PER PLAN. Note:
Offer Upgrade	3 CAPPED CEILING OUTLETS ON SEPARATE SWITCH TO BE CENTERED ABOVE PENINSULA, PURCHASER TO EXTEND PENNINSULA 3 FEET TO BE UPGRADED AND PAID FOR AT DECOR CENTER AT TIME OF COLOUR CHART Note:
Offer Upgrade	EXTRA DUPLEX RECPTACLE IN PENNINSULA IN FUTURE CABINETRY, NEXT TO DISHWASHER. (PURCHASER WILL BE ADDING 3 FEET OF CABINETS ON BOTH SIDES OF KITCHEN , PRICE TO BE DETERMINED AT DECOR CENTER AT TIME OF COLOR CHART) Note:
Offer Upgrade	DISCOUNT AS PER FRANK C. Note:



SITE COPY

CONSTRUCTION SUMMARY

Hampton Place

PURCHASERS: FRANCESCO STRAZZULLA and IRENE LIZOTTE

TEL: RES.: 905-927-1316

LOT NUMBER	PHASE	HOUSE TYPE	CLOSING DATE
613	1	AQUEBOGUE	05-Nov-18

Date Added: 20-Apr-18 Invoice Number: 7123

1 - CLARIFICATION; CLOSETS - DELETE - Do Not Install / Supply / Credit Purchasers for Builders Standard Wire Shelving and Hanging Rod throughout all closets, where applicable. To Include; Foyer Closet, Bedroom #2 Closet & Master Bedroom Walk-In Closets Note: (See Sketch)
1 - CLARIFICATION; REFER TO APAS; LIVINGROOM - Standard electrical outlet to be installed at standard height beside conduit pipe Additional electrical outlet to be installed beside conduit pipe & standard cable rough-in Approx. 60" AFF (See Attached Sketch) Note: As per Vince at Head-Office
28 - LAUNDRY ROOM - 2ND UPGRADE - PORCELAIN TILES - 20x20 CALACATA GRIS - To be installed throughout laundry room floor (To be Installed Straight) (See Sketch) Note: Includes Larger Size
28 - POWDER ROOM - 1ST UPGRADE - PORCELAIN TILES - 20x20 PULPIS GRIS - To be installed throughout powder room floor (To be Installed Straight) (See Sketch) Note: Includes Larger Size
30 - ENSUITE #2 - 1ST UPGRADE - PORCELAIN TILES - 20x20 CALACATA GRIS - To be installed throughout ensuite #2 floor (To be Installed Straight) (See Sketch) Note: Includes Larger Size
75 - ENSUITE #2 - CUSTOM UPGRADE - Install 3x6 SUBWAY WHITE in BRICK PATTERN - To be installed throughout ensuite #2 tub/shower enclosure (See Sketch) Note: Priced as per Fil at AV Tile
45 - MASTER ENSUITE - 2ND UPGRADE - PORCELAIN TILES - 12x24 CALACATA POLISH - To be installed throughout master ensuite floor (To be Installed Straight) (See Sketch) Note: Includes Rectified
95 - MASTER ENSUITE - 2ND UPGRADE - PORCELAIN TILES - 12x24 CALACATA POLISH - To be installed throughout master ensuite shower stall (To be Installed Vertically / Stacked) (See Sketch) Note: Includes Rectified
1 - KITCHEN & BATHROOMS - SEE QUALITY TOPS & KITCHENS FOR ALL KITCHEN & BATHROOMS UPGRADES/LAYOUT. Note:
1 - KITCHEN - CABINETRY - UPGRADE PACKAGE #1 - Category 3 Fiberboard Cloud White QT 4801 - To be installed throughout kitchen, where applicable (See Sketch) Note:
1 - KITCHEN - CABINETRY HARDWARE - UPGRADE PACKAGE #1 - STYLE # 53529-G10 - To be installed throughout kitchen cabinetry, where applicable (See Sketch) Note:
1 - KITCHEN - 2ND UPGRADE - CAESARSTONE COUNTERTOP - 5141 FROSTY CARRINA - To be installed throughout kitchen, where applicable (Does not include backsplash) (See Sketch) Note: Priced as per Orlando at Connolly
1 - DISCLAIMER - STONE COUNTERTOP; KITCHEN - Stone slabs vary in size & all seams are visible & the fabricator reserves the right to position the seams as necessary. Note:
1 - KITCHEN - Kitchen Backsplash - Install Standard 3x6 SUBWAY WHITE in UPGRADE BRICK PATTERN - To be installed throughout kitchen backsplash, where applicable (does not include behind the fridge or stove) (See Sketch) Note:



SITE COPY

CONSTRUCTION SUMMARY

Hampton Place

PURCHASERS: FRANCESCO STRAZZULLA and IRENE LIZOTTE

TEL: RES.: 905-927-1316

LOT NUMBER	PHASE	HOUSE TYPE	CLOSING DATE
613	1	AQUEBOGUE	05-Nov-18

Date Added: 20-Apr-18

Invoice Number: 7123

1 - KITCHEN - Kitchen Sink - Install Standard Undermount Sink - BLANCO Horizon Plus U2 Undermount Sink (8") - Model # 401234

1 - KITCHEN - Kitchen Faucet - Install Standard Faucet - DELTA Chrome Pull-Out Kitchen Faucet (Single Hole) - Model # 469LF - Chrome
Note:

2 - KITCHEN - Install TWO (2) ADDITIONAL PUCK LIGHTS (Same Switch as Standard Puck Lights) at kitchen. To be installed below kitchen cabinetry, where applicable. (See Attached QTK Layout for Locations)
Note: Purchaser Paying Difference for Additional Puck Lights - Standard Kitchen to Receive Four (4) Puck Lights - Upgrade Kitchen Requires Six (6) Puck Lights

1 - APPLIANCE PACKAGE - Install Upgrade Appliance Package - UPGRADE APPLIANCE PACKAGE #2 - To be installed throughout suite, where applicable (See Sketch)
Note: *Please Note: Purchaser to Supply and Install Own Wine Fridge at kitchen peninsula area AFTER CLOSING*
Approved as per Vince

1 - POWDER ROOM - 1ST UPGRADE - CAESARSTONE COUNTERTOP - 4141 MISTY CARRARA - To be installed throughout powder room vanity, where applicable (Includes 3" Splash) (See Sketch)
Note:

1 - ENSUITE #2 - 1ST UPGRADE - CAESARSTONE COUNTERTOP - 4141 MISTY CARRARA - To be installed throughout ensuite #2 vanity, where applicable (Includes 3" Splash) (See Sketch)
Note:

1 - MASTER ENSUITE - 1ST UPGRADE - CAESARSTONE COUNTERTOP - 4141 MISTY CARRARA - To be installed throughout master ensuite vanity, where applicable (Includes 3" Splash) (See Sketch)
Note:

1 - CLARIFICATION;
ALL BATHROOMS - Install Standard 3" Splash throughout all bathroom vanity countertops, where applicable To Include; Powder Room, Ensuite #2 and Master Ensuite (See Sketch)
Note:

1 - DISCLAIMER - STONE COUNTERTOP;
ALL BATHROOMS - Stone slabs vary in size & all seams are visible & the fabricator reserves the right to position the seams as necessary.
Note:

1 - CLARIFICATION;
MASTER ENSUITE - Purchaser accepts & acknowledges the standard glass at master ensuite shower stall will NOT touch the ceiling and will receive a Standard Chrome Header. (See Sketch)
Note:

1 - CLARIFICATION;
ALL BATHROOMS - Install Standard Plumbing Fixtures throughout all bathrooms where applicable. To Include; Powder Room, Ensuite #2 and Master Ensuite (See Sketch)
Note:

1 - CLARIFICATION;
ALL BATHROOMS - DELETE Do Not Install / Supply / Credit Purchaser for builders standard ceramic bathroom accessories (toilet paper, towel bar, soap dish) throughout all bathrooms where applicable.
Note: To Include; Powder Room, Ensuite #2 and Master Ensuite (See Sketch)

1 - CLARIFICATION;
ALL BATHROOMS - DELETE Do Not Install / Supply / Credit Purchaser for builders' standard Bathroom Mirrors, throughout all bathrooms, where applicable. To Include; Powder Room, Ensuite #2 and Master Ensuite. (See Sketch)
Note:

1 - PURCHASER HAS ATTENDED A COLOR APPOINTMENT AT THE DECOR CENTRE AND HAS DECLINED ANY ADDITIONAL UPGRADES. Purchaser accepts and acknowledges that there will be no further changes/additions/deletions to be made upon signing on April 19,2018
Note:



Printed Apr 19, 2018 2:46 pm



* INTERIOR SCHEME *

Purchasers

FRANCESCO STRAZZULLA & IRENE LIZOTTE

Decor Consultant

Melissa Di Marino

Model Type

AQUEBOGUE

Telephone Res. / Bus

(905) 927-1316 /

Project

Hampton Place

Closing Date

05/11/2018

Unit

613

Page 2 of 3

CABINETS, VANITIES AND COUNTERTOPS

Ensuite #2

MASTER ENSUITE

POWDER ROOM

KITCHEN / DINETTE

LAUNDRY ROOM

Style

CATEGORY 2 - MAPLE - CHESTNUT QT 2503 (STD)

CATEGORY 2 - MAPLE - PISTCHIO QT 2503 (STD)

CATEGORY 2 - MAPLE - PISTCHIO QT 2503 (STD)

CATEGORY 3 - FIBERBOARD - CLOUD WHITE QT 4801 (UPG)

N/A

Countertop

#1411 MistyCarrara CaesarStone (Upg)

#1411 MistyCarrara CaesarStone (Upg)

#1411 MistyCarrara CaesarStone (Upg)

#1411 FrostyCarina CaesarStone (Upg)

N/A

Counter Edge

"A" EDGE (STD)

"A" EDGE (STD)

"A" EDGE (STD)

"A" EDGE (STD)

N/A

Handle / Knob

16338-195

16338-195

B603-SC

53529-G10

N/A

Std 31in Opening

APPLIANCE PACKAGE

Upgrade Package #2

PLUMBING FIXTURES

KITCHEN

Sink Model

Sink Faucet

TOILETS

Master Ensuite

Ensuite #2

Powder Room

VANITY FAUCETS

Master Ensuite

Ensuite #2

Powder Room

VANITY SINKS

Master Ensuite

Ensuite #2

Powder Room

SHOWER STALL / TUBS

Master Ensuite Shower Stall

Master Ensuite Tub

Ensuite #2 Tub

Trim

Baseboard & Casing

Interior Doors

STANDARD

STANDARD - CARRARA, SMOOTH

Levers

Door Height

STANDARD

STANDARD

Cornice Moulding / Medallion

Foyer

Great Room

Dining Room

Den

Master Bedroom

Bedroom 2

Bedroom 3

STANDARD - #CTR-611

STANDARD - #CTR-611

N/A

NONE

NONE

NONE

N/A

Fireplace

Location

Flooring

Style

Finish

Marble

Hearth

N/A

N/A

Paint Throughout

Walls

STANDARD - BIRCH WHITE

Trim

STANDARD - WHITE

MISC. INSTALLATIONS

Ceramic Accessories (installed by Vendor)

Yes No

Bathroom Mirrors (installed by Vendor)

Yes No

Wire Shelving - Closet (installed by Vendor)

Yes No

Page 2 of 3

Decor Consultant:

Melissa Di Marino

Purchaser:

FRANCESCO STRAZZULLA

Purchaser:


IRENE LIZOTTE

Vendor:

Hampton Place

Suite 613 Hampton
* Bolk Head Drawing *

- UPG #1 - KITCHEN PKG
- UPG #2 - APPLIANCE PKG. (PURCHASER INSTALL OWN WINE FRIDGE)
- (x6) = PUCK LIGHTS
- (x1) = PLUG PENINSULA
- (x1) = EXTRA PLUG PENINSULA FOR WINE FRIDGE
- (x3) = CAPPED CIEUNG LIGHTS OVER PENINSULA

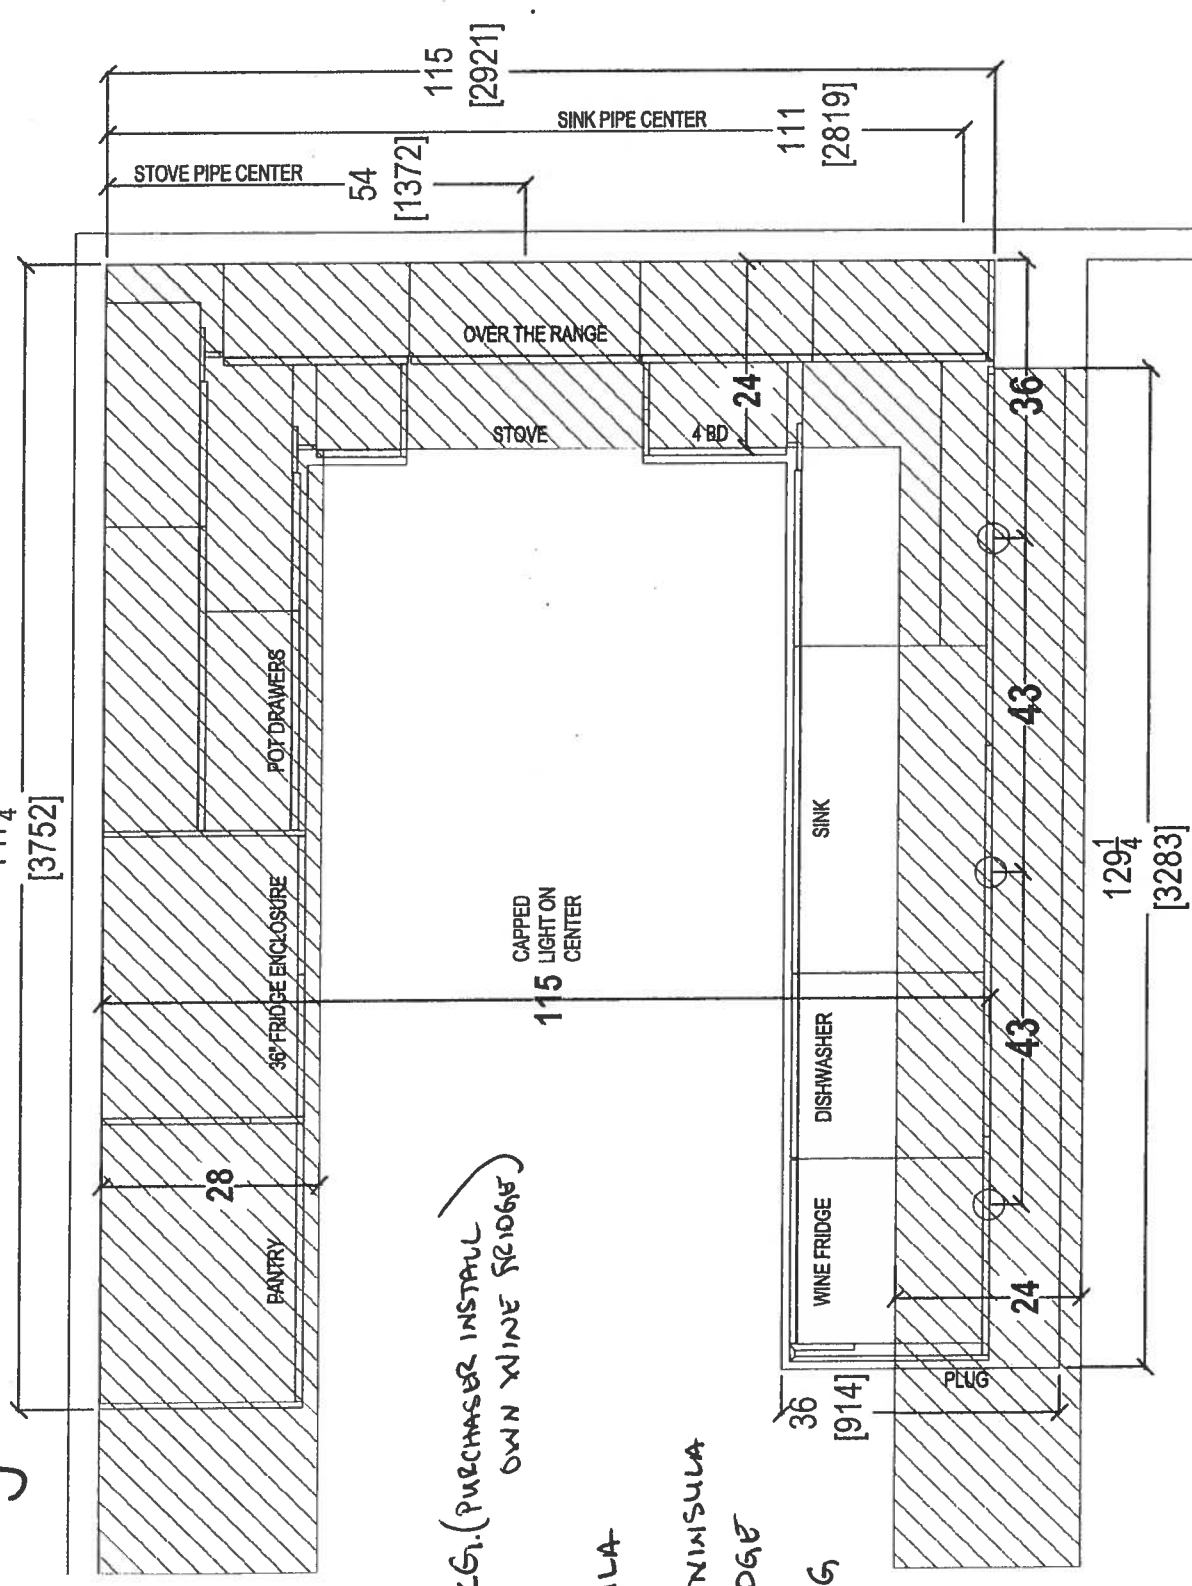


80 SANTE DRIVE, VAUGHAN, ON L4K 3C4.
T: 416.746.1811 F: 905.761.5901

CLIENT: ROYAL PINE HOMES		UNIT 613 HMP	ROOM:	KITCHEN FLOOR PLAN	DRAWN BY: SK	COMMENTS: PLEASE NOTE ALL DIMENSIONS ARE NOT FINAL AND ARE SUBJECT TO CHANGE UPON FINAL SITE MEASURE
SITE: HAMPTON PLACE	DOOR STYLE: --		DOOR HANDLE: --	SCALE: 1/2" = 1' - 0"		
PHONE: --	FINISH: --		DRW HANDLE: --	DATE: MAY 1, 2018		
EMAIL: --	SPECIES: --		TOP: --	PAGE: --		

61

Suite 613 Hampton

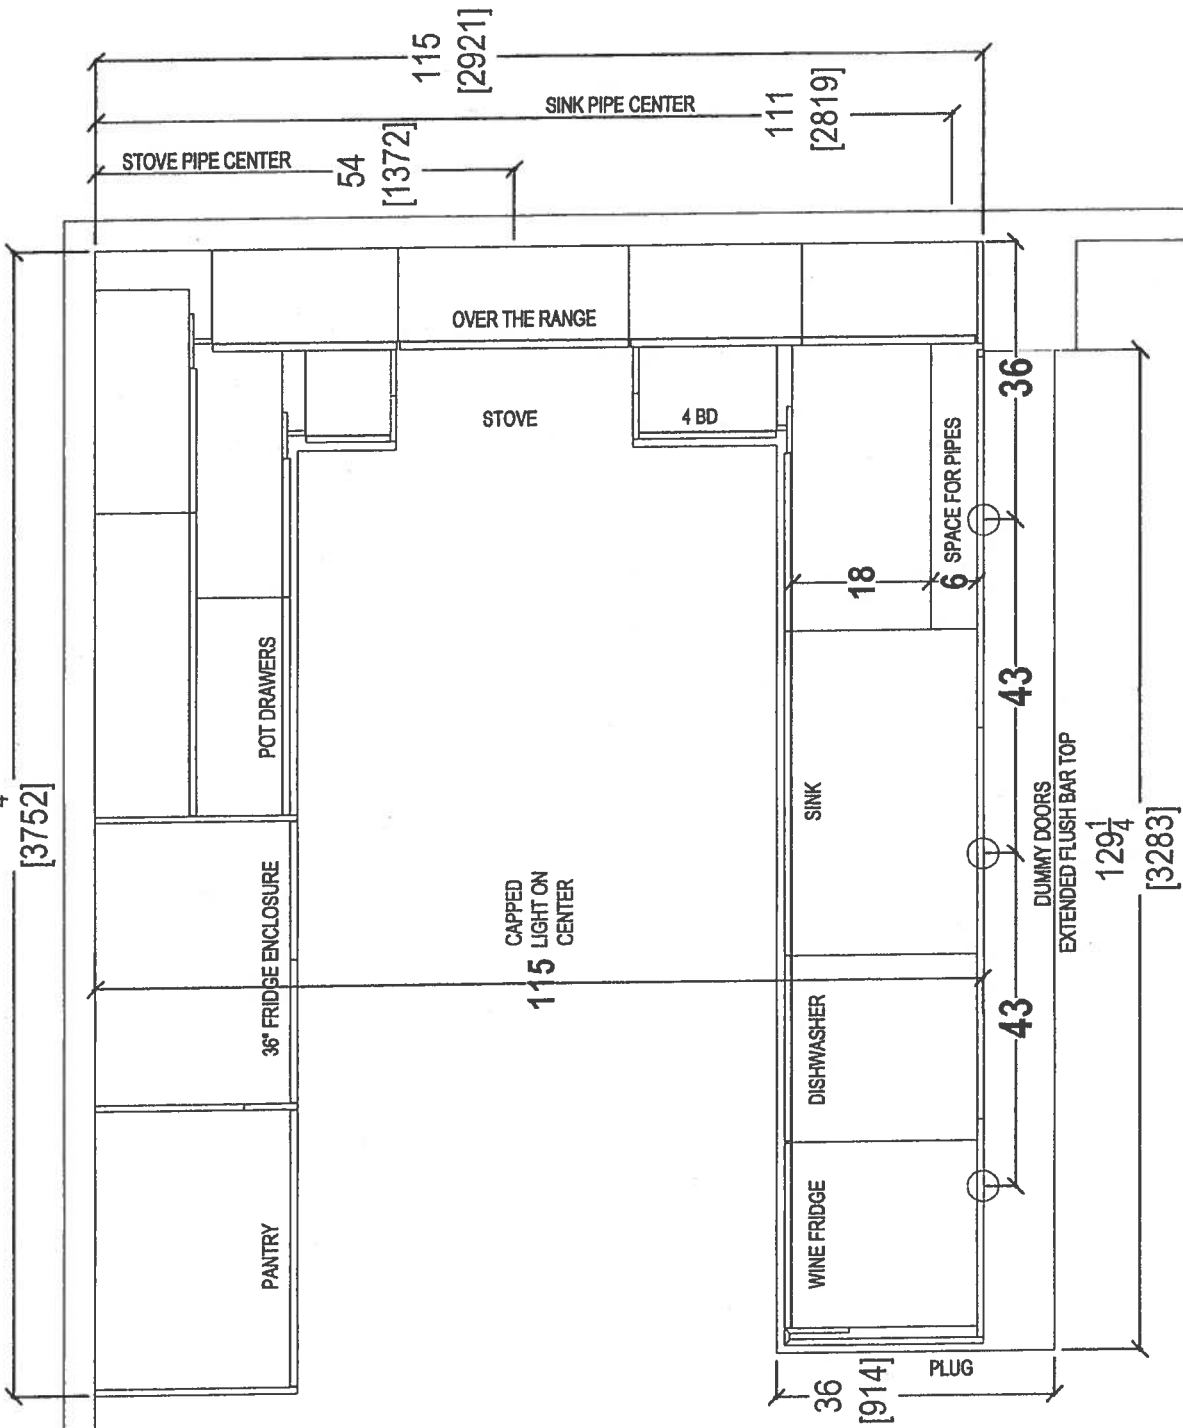

 <i>your kitchen, your taste.</i> 80 SANTE DRIVE, VAUGHAN, ON L4K 3C4, T: 416.748.1811 F: 905.761.5901				CLIENT: ROYAL PINE HOMES		UNIT 613 HMP		ROOM: KITCHEN FLOOR PLAN		DRAWN BY: SK		COMMENTS: PLEASE NOTE ALL DIMENSIONS ARE NOT FINAL AND ARE SUBJECT TO CHANGE UPON FINAL SITE MEASURE	
SITE: HAMPTON PLACE		DOOR STYLE: —		DOOR HANDLE: —		SCALE: 1/2" = 1' - 0"							
PHONE: —		FINISH: —		DRW HANDLE: —		DATE: MAY 1, 2018							
EMAIL: —		SPECIES: —		TOP: —		PAGE: —							




80 SANTE DRIVE, VAUGHAN, ON L4K 3C4,
T: 416.748.1811 F: 905.761.5901

9

Suite 613
Hampton

PL - Pock Light
(x6)

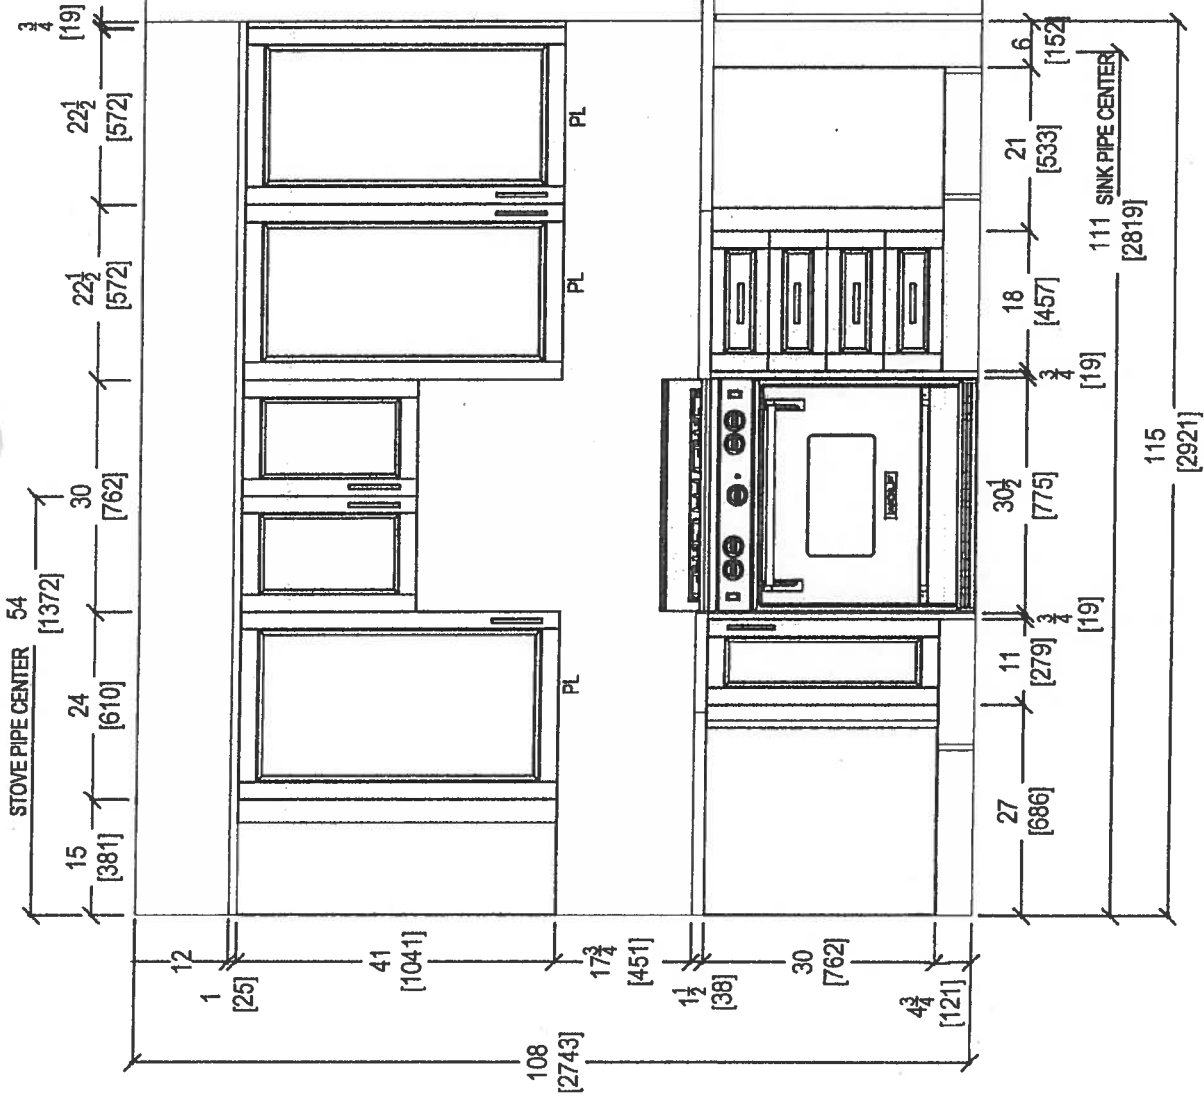


 your kitchen, your taste. 80 SANTE DRIVE, VAUGHAN, ON L4K 3C4, T: 416.740.1811 F 903.761.5901	CLIENT: ROYAL PINE HOMES		UNIT 613 HMP	ROOM: KITCHEN	DRAWN BY: SK	COMMENTS: PLEASE NOTE ALL DIMENSIONS ARE NOT FINAL AND ARE SUBJECT TO CHANGE UPON FINAL SITE MEASURE
	SITE: HAMPTON PLACE	DOOR STYLE: —	DOOR HANDLE: —	SCALE: 1/2" = 1'-0"		
	PHONE: —	FINISH: —	DRW HANDLE: —	DATE: MAY 1, 2018		
	EMAIL: —	SPECIES: —	TOP: —	PAGE: —		

1

Suite 613
Hampton

PL-Puck Light
(x6)

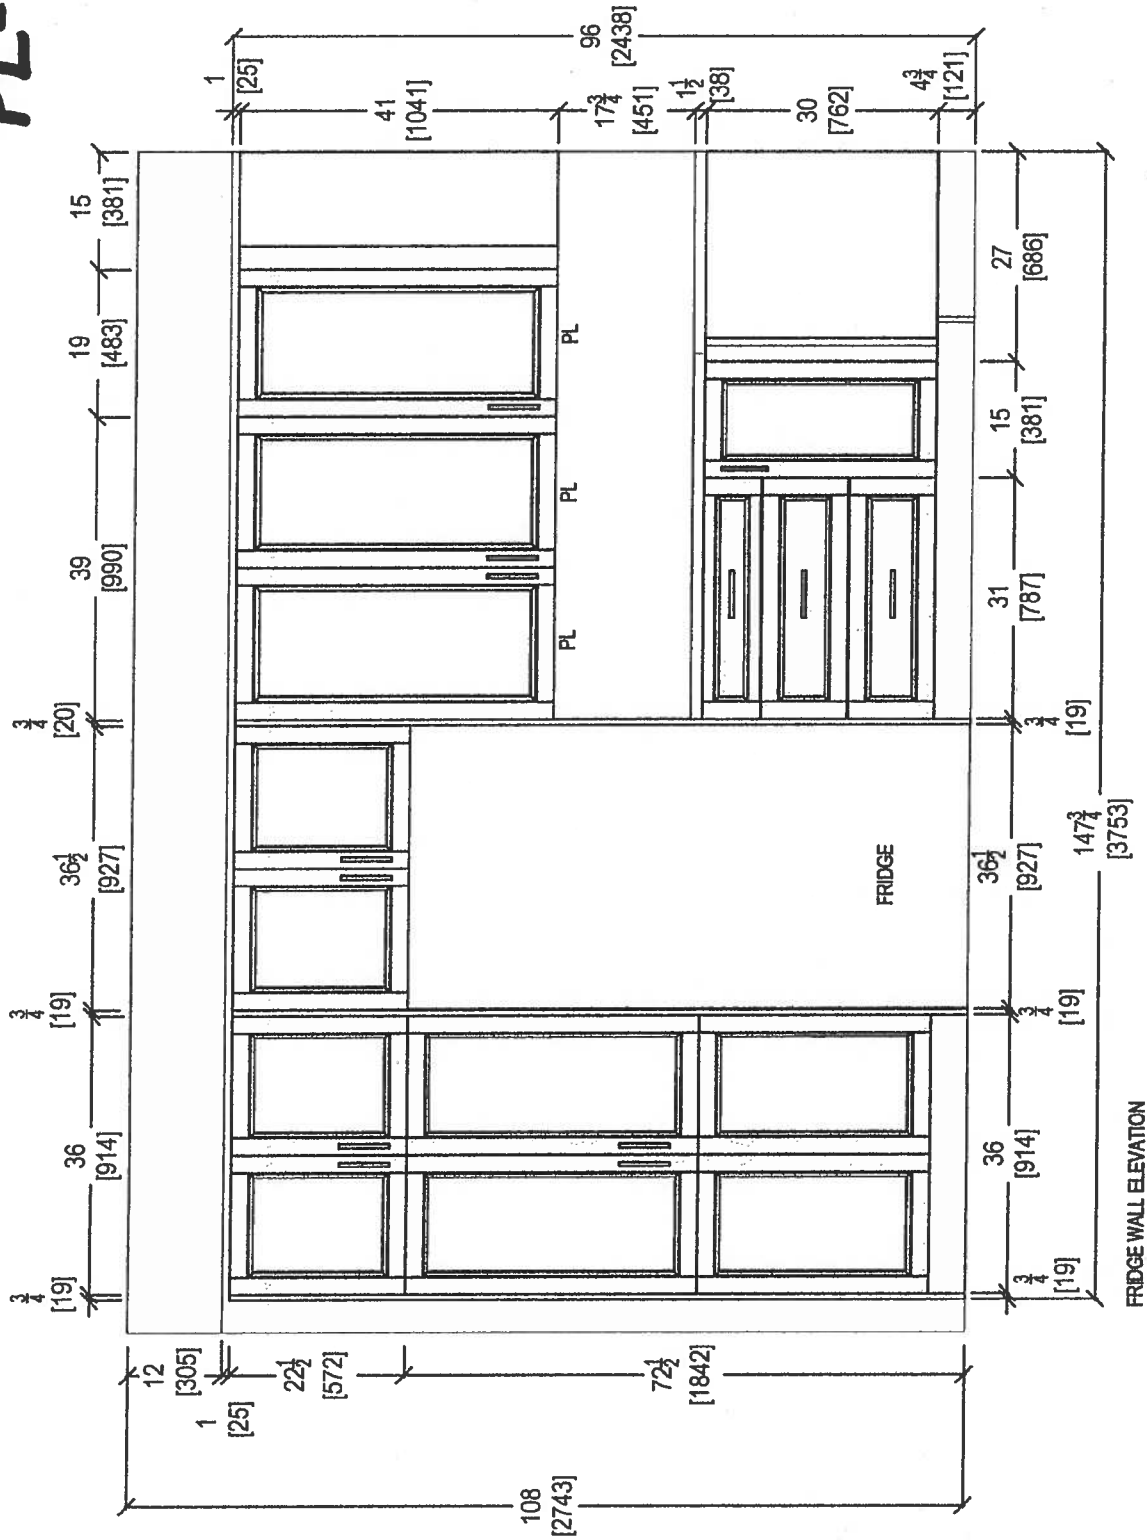


80 SANTE DRIVE, VAUGHAN, ON L4K 3C4,
T: 416.746.1811 F: 905.761.5801

CLIENT: ROYAL PINE HOMES		UNIT 613 HMP	ROOM: KITCHEN	DRAWN BY: SK	COMMENTS: PLEASE NOTE ALL DIMENSIONS ARE NOT FINAL AND ARE SUBJECT TO CHANGE UPON FINAL SITE MEASURE
SITE: HAMPTON PLACE	DOOR STYLE: —	DOOR HANDLE: —	SCALE: 1/2" = 1' - 0"		
PHONE: —	FINISH: —	DRW HANDLE: —	DATE: MAY 1, 2018		
EMAIL: —	SPECIES: —	TOP: —	PAGE: —		

6

Suite 613
Hampton

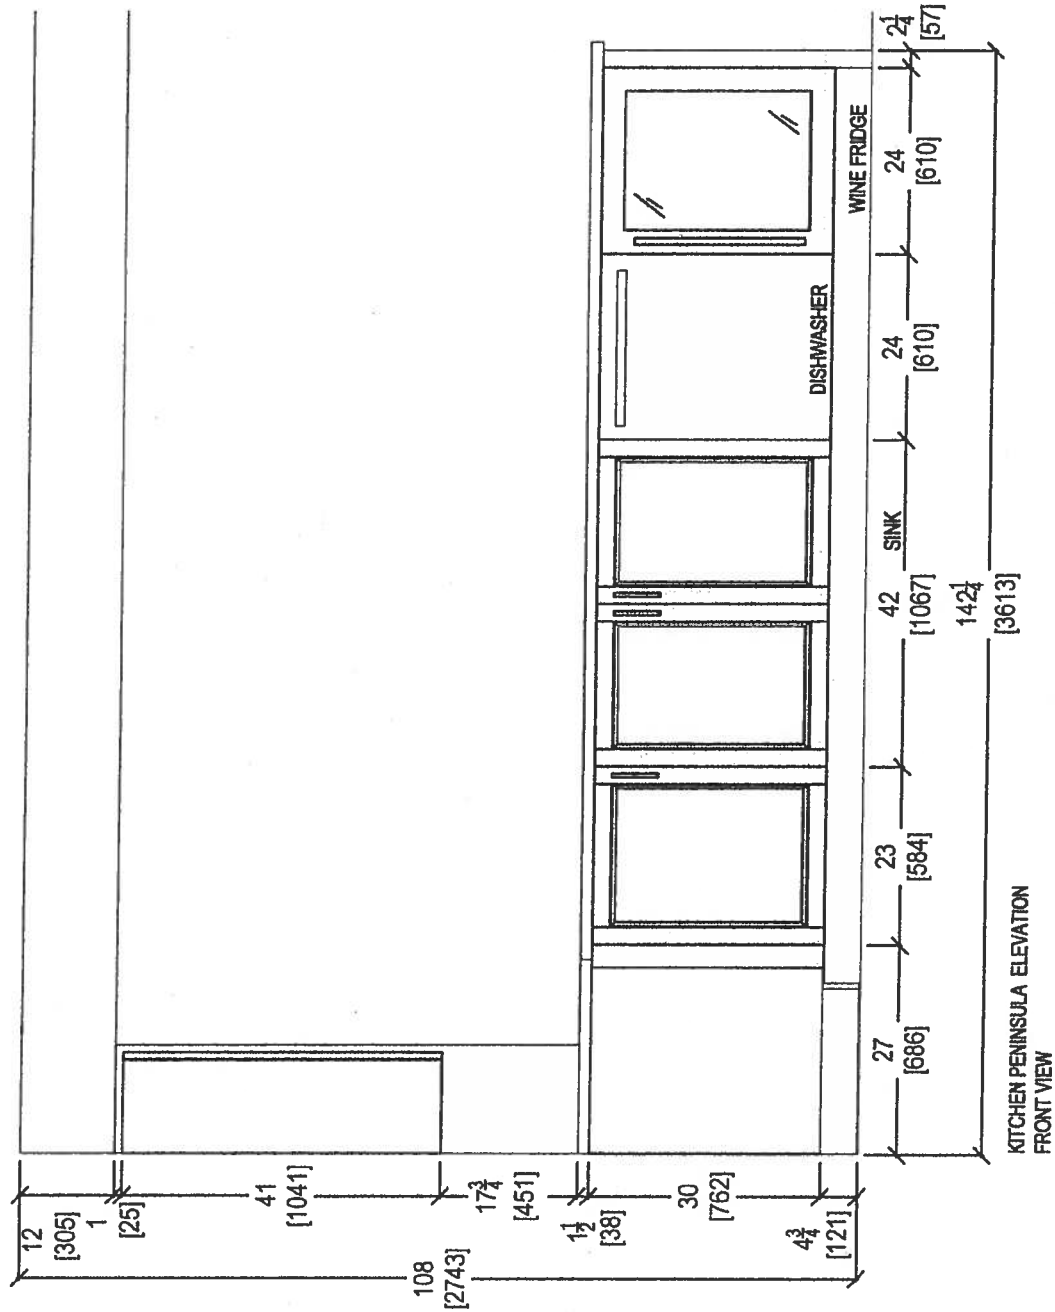


KITCHEN PENINSULA ELEVATION
FRONT VIEW



80 SANTE DRIVE, VAUGHAN, ON L4K 3C4,
T: 416.746.1811 F: 905.761.5901

CLIENT: ROYAL PINE HOMES	UNIT 613 HMP	ROOM: KITCHEN	DRAWN BY: SK	COMMENTS: PLEASE NOTE ALL DIMENSIONS ARE NOT FINAL AND ARE SUBJECT TO CHANGE UPON FINAL SITE MEASURE
SITE: HAMPTON PLACE	DOOR STYLE: —	DOOR HANDLE: —	SCALE: 1/2" = 1' - 0"	
PHONE: —	FINISH: —	DRW HANDLE: —	DATE: MAY 1, 2018	
EMAIL: —	SPECIES: —	TOP: —	PAGE: —	

Suite 613
Hampton






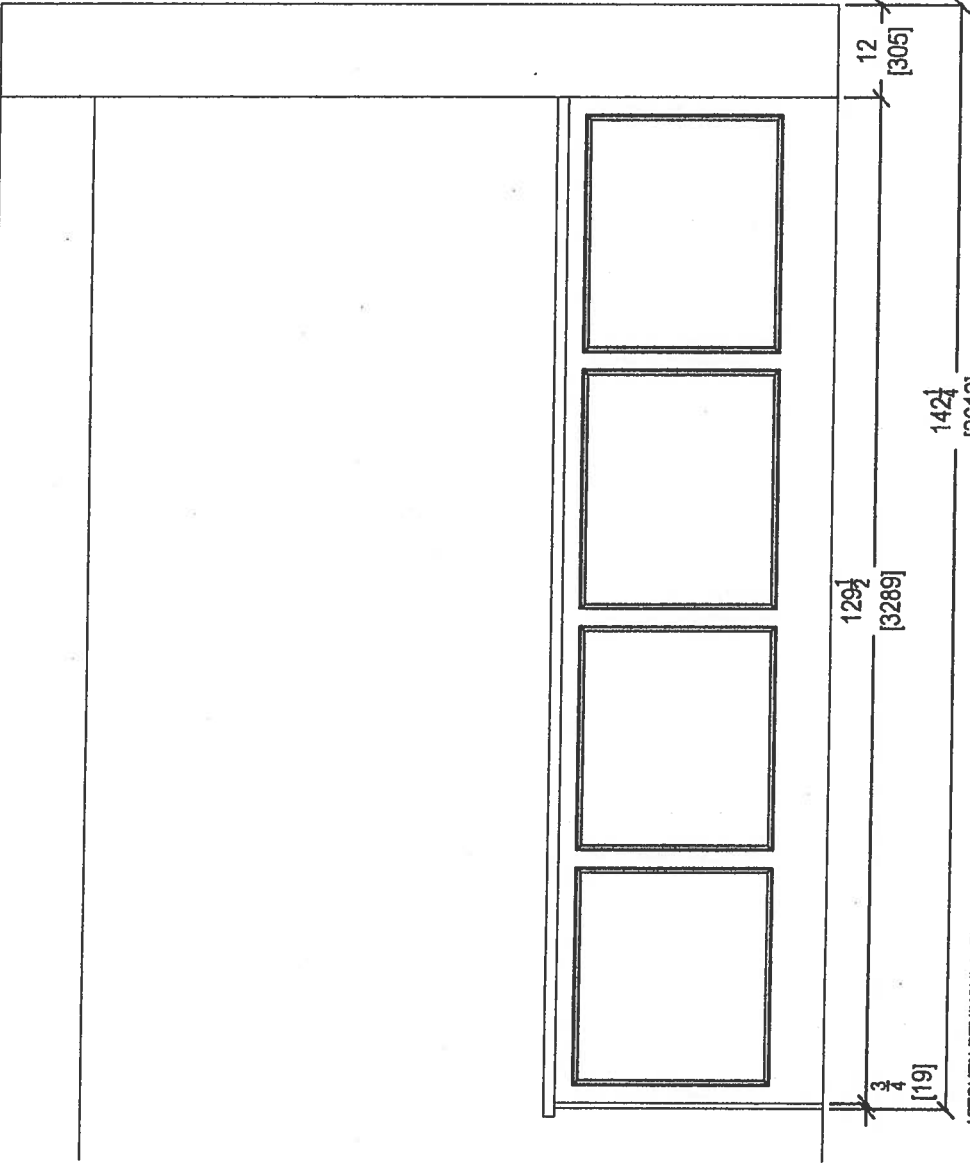


80 SANTE DRIVE, VAUGHAN, ON L4K 3C4,
T: 416.746.1811 F: 905.761.5901

CLIENT: ROYAL PINE HOMES		UNIT 613 HMP	ROOM:	KITCHEN	DRAWN BY: SK		COMMENTS: PLEASE NOTE ALL DIMENSIONS ARE NOT FINAL AND ARE SUBJECT TO CHANGE UPON FINAL SITE MEASURE
SITE:	HAMPTON PLACE	DOOR STYLE: —	DOOR HANDLE: —		SCALE:	1/2" = 1'-0"	
PHONE: —	FINISH: —	DRW HANDLE: —		DATE:	MAY 1, 2018		
EMAIL: —	SPECIES: —	TOP: —		PAGE:	—		

Suite 613 Hampton

* Install 3" Splash *

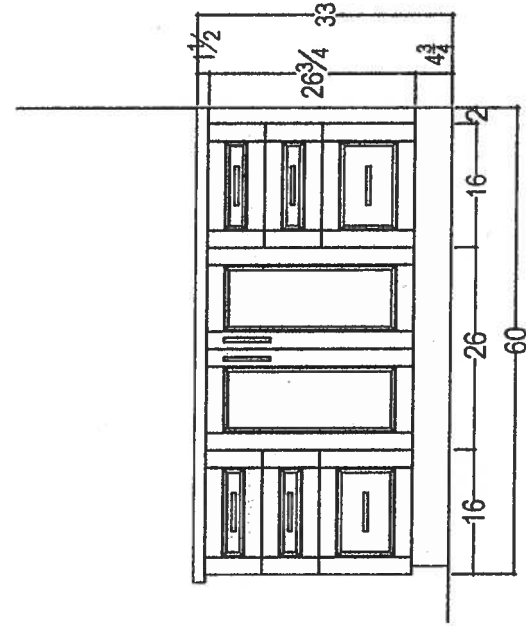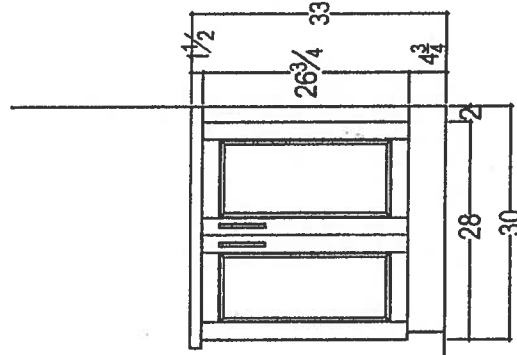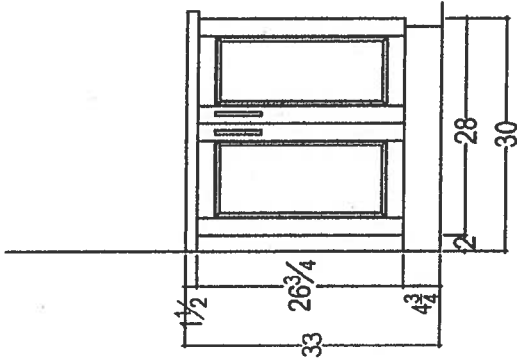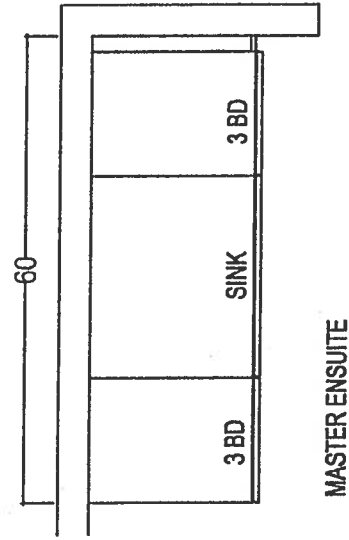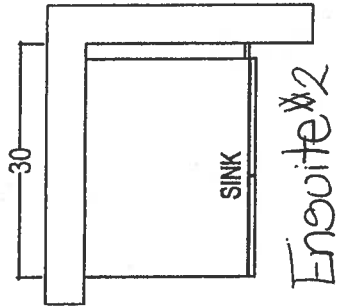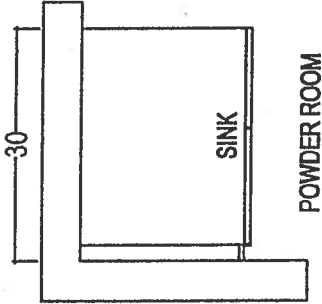

your kitchen, your taste
80 SANTE DRIVE, VAUGHAN, ON L4K 3C4,
T: 416.746.1811 F 905.761.5801

CLIENT: ROYAL PINE HOMES

SITE: HAMPTON PLACE

PHONE: ---

EMAIL: ---

UNIT 613 HMP

DOOR STYLE: ---

FINISH: ---

SPECIES: ---

ROOM:

VANITIES

DOOR HANDLE: ---

DRW HANDLE: ---

TOP: ---

DRAWN BY: SK

SCALE: 1/2" = 1' - 0"

DATE: MAY 1, 2018

PAGE: ---


COMMENTS:

PLEASE NOTE ALL DIMENSIONS
ARE NOT FINAL AND ARE
SUBJECT TO CHANGE UPON
FINAL SITE MEASURE

61

KRFC302ESS

22 cu.ft. 36-Inch Width Counter Depth French Door Refrigerator
with Interior Dispense

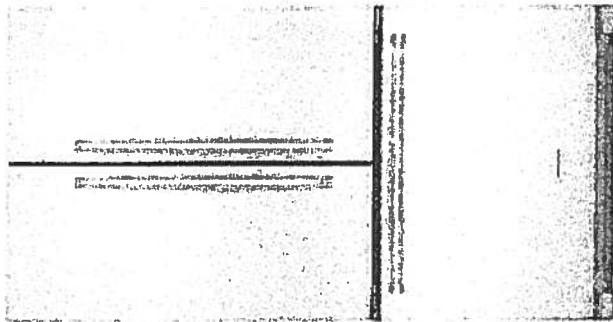

MADE IN AMERICA

KitchenAid®

<http://www.kitchenaid.com>

Product Dimensions:

Height: 72
Width: 35 3/4
Depth: 30 1/4

Electrical Requirements:

15 Amps.

Available In:

☒ Stainless Steel
☒ Black
☐ White

KRFC302ESS

Key Features:

- ExtendFresh™ Temperature Management System
- Interior Water Dispenser
- Professionally-Inspired Design
- Produce Preserver
- Humidity-Controlled Crispers
- FreshChill™ Temperature-Controlled Full-Width Pantry
- Pull-Out Tri-Level Freezer Drawer
- SatinGlide® System
- LED Lighting
- Star-K Certified
- Automatic Ice Maker
- Max Cool

Upgrade
Package 2

(PURCHASER TO supply +
INSTALL OWN
WINE FRIDGE)



Because Whirlpool Corporation policy includes a continuous commitment to improve our products, we reserve the right to change materials and specifications without notice. We also reserve the right to discontinue or transition products without notice.

® reg. Registered trademark/™ Trademark of Whirlpool® U.S.A. © 2013 Whirlpool Corporation All Rights Reserved. All other trademarks are owned by their respective companies.

Created On: Wednesday, April 22, 2015 15:51:04

Suite 613 Hampton

Upgrade Package 2




KSEB900ESS

30-Inch 5-Element Electric Convection Slide-In
Range with Baking Drawer

KitchenAid®

<http://www.kitchenaid.com>

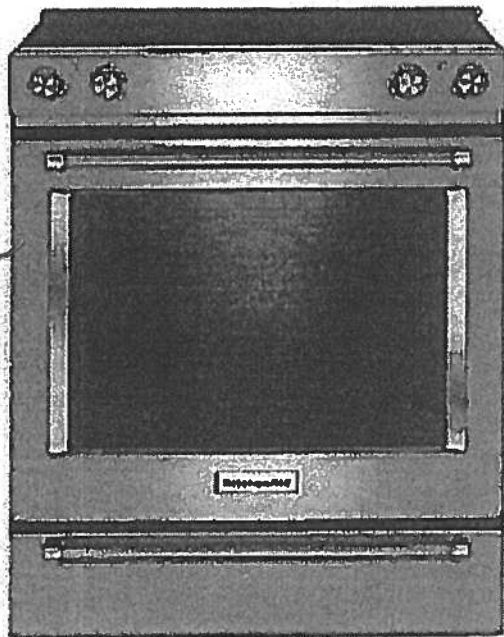

Key Features:

- Baking Drawer
- Even-Heat™ True Convection
- Wireless Probe
- Steam Rack
- 7.1 Cu Ft. Total Capacity
- 5 Cooking Elements Including a Warm Zone
- EasyConvect™ Conversion
- FIT Guarantee
- Aqualift®
- Glass Touch Controls
- Side Trim Accessory Kit

Product Dimensions:

Height: 36

Width: 29 7/8

Electrical Requirements:

40 Amps.

Additional Information:

[Use And Care Guide](#)

[Dimension Guide](#)

[Installation Guide](#)

[Warranty Certificate](#)

Available in:

- Black
- Stainless Steel
- White

INVESTED
IN
AMERICA



©Registered trademark/TM Trademark of Whirlpool, U.S.A. © 2013 Whirlpool Corporation. All Rights Reserved.
All other trademarks are owned by their respective companies.
Because Whirlpool Corporation policy includes a continuous commitment to improve our products, we reserve the right to change materials and specifications without notice. We also reserve the right to discontinue or transition products without notice.
Manufacturer's Suggested Retail Price (MSRP) and Minimum Advertised Price (MAP) provided for reference purposes only. Dealer alone determines advertised and retail prices.
Created On: Tuesday, December 22, 2015 14:04:50

Suite 613 Hampton Upgrade Package 2



KMHP519ESS

1200-Watt Convection Microwave with High-Speed
Cooking - 30"

KitchenAid®

<http://www.kitchenaid.com>

Key Features:

- High-Speed Cooking
- Convection Cooking
- Professionally-Inspired Design Including Handle, Badge, Graphics, Chrome Chamfer.
- Cookshield Finish
- Crispwave™ Technology and Crisper Pan
- 1200 Watts Power
- 1.9 Cu. Ft. Capacity
- Halogen Cavity Lights and Task Light
- Steam Cleaning Function
- Keep Warm Function
- Sound-Based Popcorn Function

Product Dimensions:

Height: 17 1/8"

Width: 30"

Depth: 17"

Electrical Requirements:

15A


Additional Information:

[Use And Care](#)

[Dimension Guide](#)

[Installation Guide](#)

[Warranty](#)

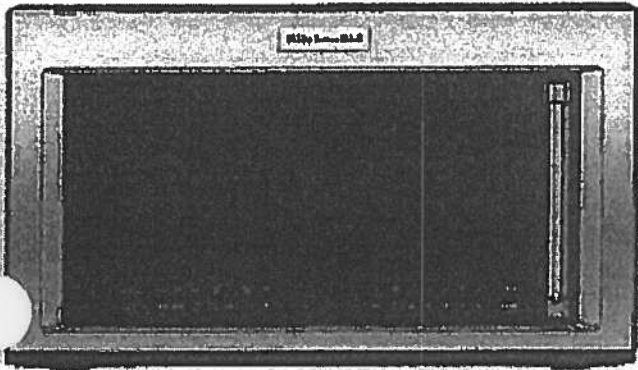

Available In:

☒ Stainless Steel

©Registered trademark/TM Trademark of Whirlpool, U.S.A. ©2016 Whirlpool Corporation. All Rights Reserved. All other trademarks are owned by their respective companies.

Because Whirlpool Corporation policy includes a continuous commitment to improve our products, we reserve the right to change materials and specifications without notice. We also reserve the right to discontinue or transition products without notice.

Manufacturer's Suggested Retail Price (MSRP) and Minimum Advertised Price (MAP) provided for reference purposes only. Dealer alone determines advertised and retail prices.

Suite 613 Hampton Upgrade Package 2




KDTM354ESS

KitchenAid®

4 dBA Dishwasher with Clean Water Wash System

<http://www.kitchenaid.com>

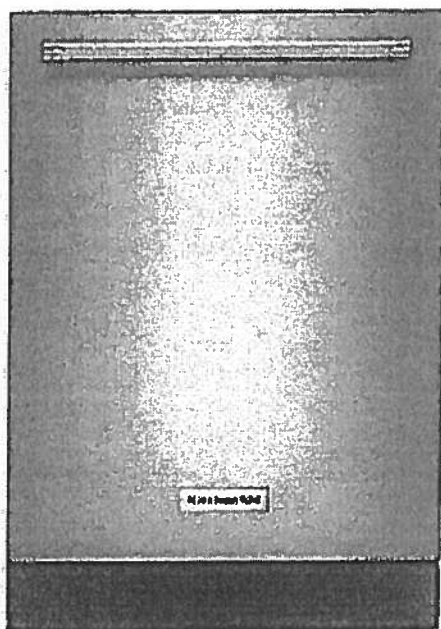

Key Features:

- Clean Water Wash System
- ProScrub® Option
- Professionally-Inspired Design
- Advanced ProDry™ System
- ProWash™ Cycle
- SatinGlide® Max Rails (Upper Rack)
- Sliding Tines in the Lower Rack
- 2 Rows Fold-Down Tines in Upper Rack
- Fold-Down Tines in the Lower Rack
- 2 Fold-Down Cup Shelves with Integrated Stemware Holders
- Utility Basket (Upper Rack)
- Express Wash

Product Dimensions:

Height: 34 1/2

Width: 23 7/8

Depth: 24 3/4

Electrical Requirements:

15 Amps.

Additional Information:

[Use And Care Guide](#)

[Dimension Guide](#)

[Installation Guide](#)

[Energy Guide](#)

[Warranty Certificate](#)

Available in:

☒ Stainless Steel

INVESTED
IN
AMERICA

®Registered trademark/TM Trademark of Whirlpool, U.S.A. © 2013 Whirlpool Corporation. All Rights Reserved.
All other trademarks are owned by their respective companies.

Because Whirlpool Corporation policy includes a continuous commitment to improve our products, we reserve the right to change materials and specifications without notice. We also reserve the right to discontinue or transition products without notice.

Manufacturer's Suggested Retail Price (MSRP) and Minimum Advertised Price (MAP) provided for reference purposes only. Dealer alone determines advertised and retail prices.

Created On: Friday, March 04, 2016 16:36:55

Suite 613 Hampton Upgrade Package 2




WFW85HEFC



<http://www.whirlpool.com>

4.5 cu. ft. Front Load Washer with TumbleFresh™
option

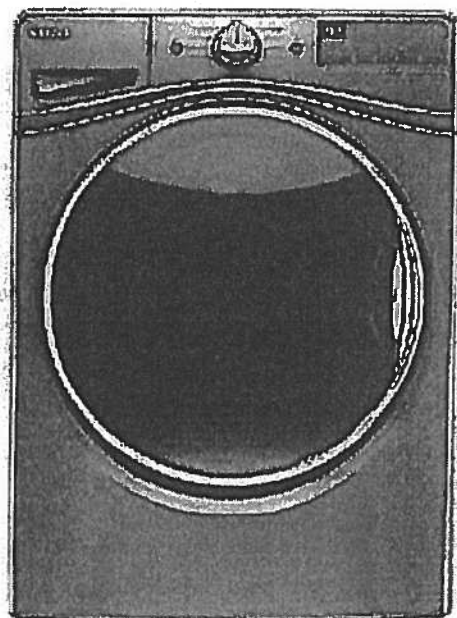

Key Features:

- TumbleFresh™ Option
- ColorLast™ Cycle
- Presoak Option
- EcoBoost™ Option
- Precision Dispense
- Steam Clean Option
- Adaptive Wash Technology
- Smooth Wave Stainless Steel Wash Basket
- 4.5 cu. ft. Capacity
- Undercounter Installation
- Add-A-Garment
- ENERGY STAR® Certified

Product Dimensions:

Height: 39 3/4

Width: 27

Depth: 33 5/16

Additional Information:

[Use And Care Guide](#)

[Dimension Guide](#)

[Installation Guide](#)

[Energy Guide](#)

[Warranty Certificate](#)

Available in:

- ☒ Chrome Shadow
☐ White

INVESTED
IN
AMERICA



®Registered trademark/TM Trademark of Whirlpool, U.S.A. © 2016 Whirlpool Corporation. All Rights Reserved.
All other trademarks are owned by their respective companies.
Because Whirlpool Corporation policy includes a continuous commitment to improve our products, we reserve the right to change materials and specifications without notice. We also reserve the right to discontinue or transition products without notice.
Manufacturer's Suggested Retail Price (MSRP) and Minimum Advertised Price (MAP) provided for reference purposes only. Dealer alone determines advertised and retail prices.
Created On: Wednesday, December 14, 2016 18:12:43

Suite 613
Hampton

Upgrade
Package 2




WED85HEFC

Whirlpool®

7.4 cu. ft. Electric Dryer with Quick Dry Cycle

<http://www.whirlpool.com>

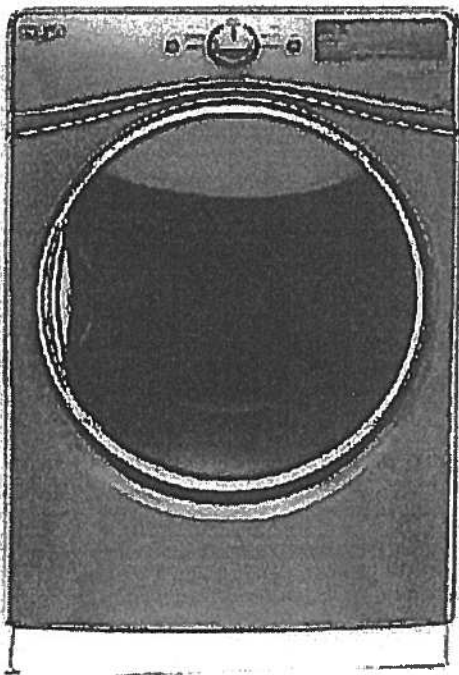

Key Features:

- Advanced Moisture Sensing System
- Tap Touch Controls with Memory
- EcoBoost™ Option
- Steam Refresh Cycle
- Wrinkle Shield™ Option
- Quad Baffles
- 7.4 Cu. Ft. Capacity
- Undercounter Installation
- ENERGY STAR® Qualified
- Sanitize Cycle
- Quick Dry Cycle

Product Dimensions:

Height: 39

Width: 27

Depth: 31

Additional Information:

[Use And Care Guide](#)

[Dimension Guide](#)

[Installation Guide](#)

[Warranty Certificate](#)

INVESTED
IN
AMERICA



©Registered trademark/TM Trademark of Whirlpool, U.S.A. © 2018 Whirlpool Corporation. All Rights Reserved.
All other trademarks are owned by their respective companies.
Because Whirlpool Corporation policy includes a continuous commitment to improve our products, we reserve the right to change materials and specifications without notice. We also reserve the right to discontinue or transition products without notice.
Manufacturer's Suggested Retail Price (MSRP) and Minimum Advertised Price (MAP) provided for reference purposes only. Dealer alone determines advertised and retail prices.
Created On: Thursday, March 23, 2017 17:33:37

 Français


Search by keyword or model #

HOMEPRODUCTSACCESSORIESKITCHEN GALLERYINSIDE KITCHENAIDCUSTOMER CARESHOP

REFRIGERATIONVIEW ALL ▶

OVERVIEWFEATURES & SPECSPrintEmail

Architect® Series II
BASE MODEL: KUWS24LSBS | *

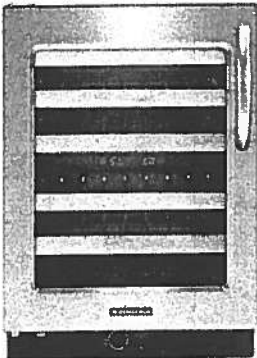

PRODUCT FEATURES

- Dual temperature zones for proper wine storage
- Maximum Capacity of 46 Standard Bottles
- 24" (61cm) deep - fits in the space of a standard base cabinet
- Left Hand Door Swing
- Can Be Installed Built-In or Freestanding

PRODUCT LITERATURE

 Use & Care Guide

 Dimension Guide

ELECTRICAL REQUIREMENTS

DIMENSIONS

PRODUCT SUPPORT

WARRANTY

*Purchaser To Supply & Install
After Closing*

When storing wines for any length of time, maintaining their texture and flavor is essential. With distinct temperature zones, KitchenAid® wine cellars allow you to keep wines at their appropriate temperatures.

Download Adobe® Reader®
To view and print documents on this site, you need to download Adobe® Reader®.

HOTTEST PRODUCTS ▼

Shop | Select Another Country Site | Contact Us | Site Map | Privacy Policy | Terms of Use | Product Recalls

® Registered Trademark ™ Trademark/the shape of the stand mixer is a trademark of KitchenAid, Canada. ©2009. All Rights Reserved. All other trademarks are owned by their respected companies.



KitchenAid® Wine Cellar


PRODUCT MODEL NUMBER

KUWS24LS
KUWS24RS

Electrical: A 115-volt, 60-Hz, AC-only 15- or 20-amp fused, grounded electrical supply is required. A time-delay fuse or circuit breaker and separate circuit is recommended.

** Purchaser To Supply & Install
After Closing **

OVERALL DIMENSIONS

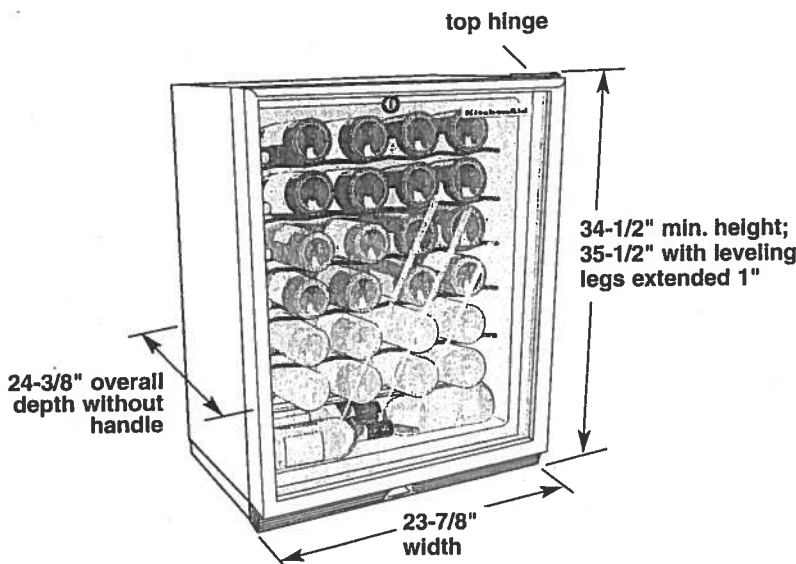

To ensure proper ventilation for your wine cellar, allow for a 1/4" (6.35 mm) space on each side and at the top. When installing your wine cellar next to a fixed wall, leave 2-1/2" (6.35 cm) minimum clearance on each side to allow for the door to swing open.


NOTE: It is recommended that you do not install the wine cellar near an oven, radiator, or other heat source. Do not install in a location where the temperature will fall below 55°F (13°C). For best performance, do not install the wine cellar behind a cabinet door or block the base grille.

Because Whirlpool Corporation policy includes a continuous commitment to improve our products, we reserve the right to change materials and specifications without notice.

Dimensions are for planning purposes only. For complete details, see Installation Instructions packed with product. Specifications subject to change without notice.

Ref. 2300272
06-16-06

→ CONDUIT:

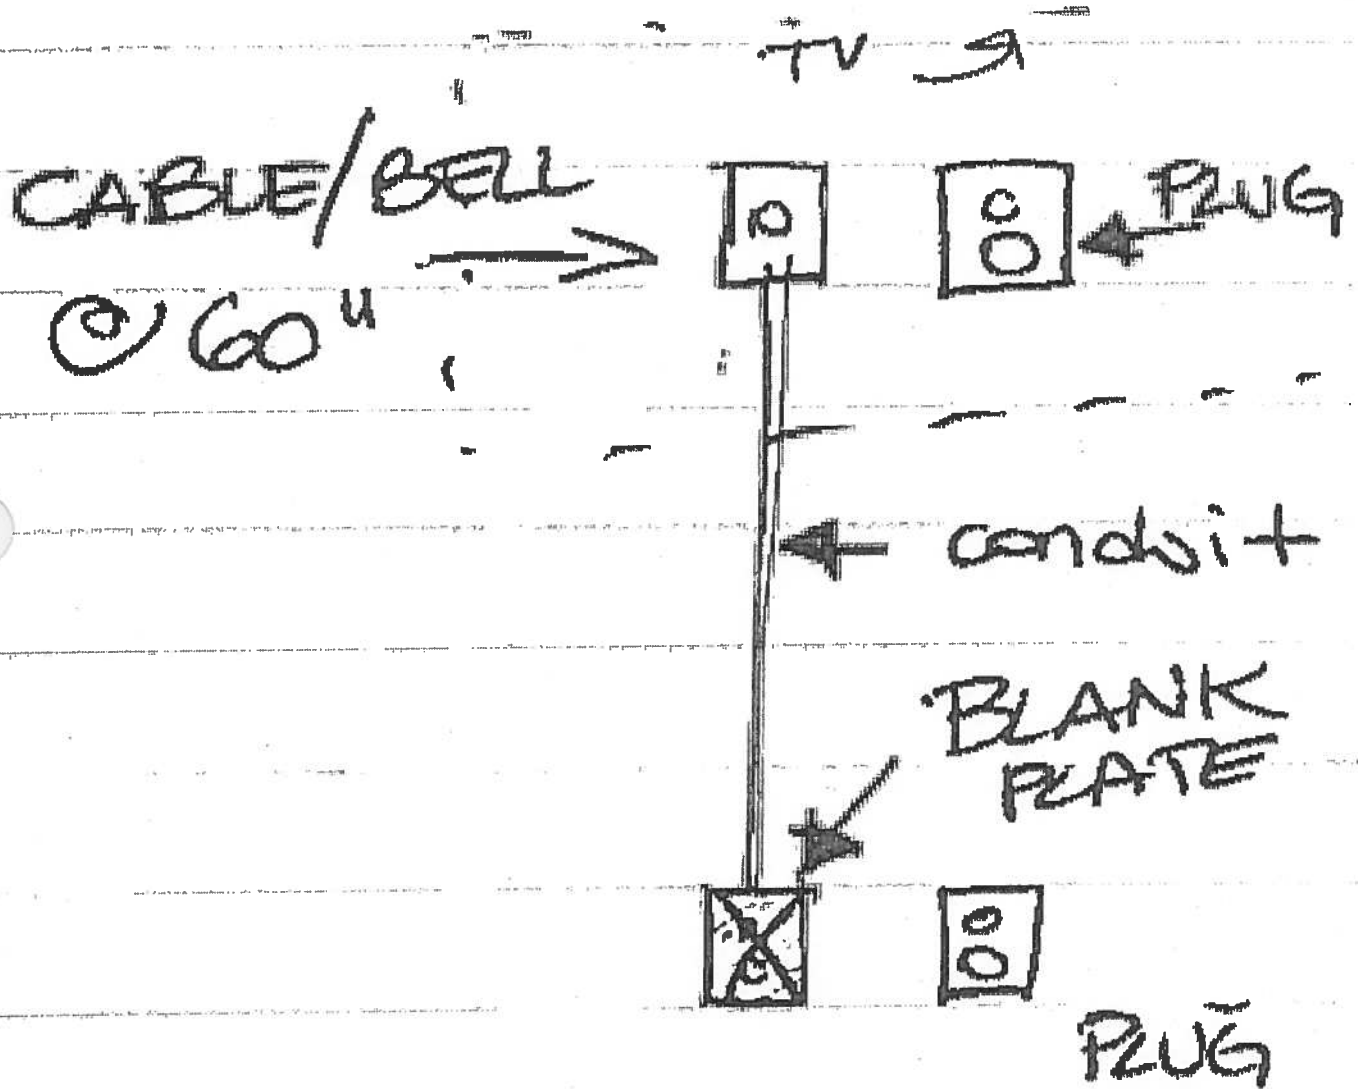

Countertop Edges

Suite 613

Hampton




CONNOLLY

Marble & Granite Ltd.

EDGE
DETAILS


004

A.

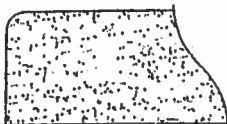


STRAIGHT EDGE
(STANDARD - 3/4")

Standard:
Kitchen
Powder Room
Ensuite #2
Master Ensuite

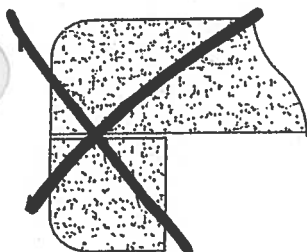

DOUBLE TOP "D" EDGE
(STANDARD - 1 1/2")

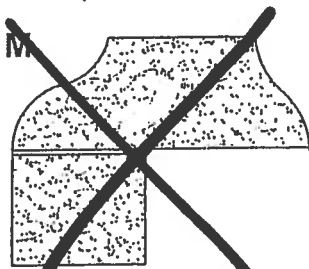

OGEE - SQUARE EDGE
(MED./HIGH - 1 1/2")

EDGING UP-GRADE OPTIONS