



**UNITED ENGINEERING INC**  
Mechanical and Electrical Consulting Engineers

3645 Keele St. #105  
Toronto, ON, M3J 1M6  
Email: info@u-eng.ca  
T: (416) 398-1999  
F: (416) 398-1933

## SITE INSTRUCTION

PROJECT: HAMPTON MANOR  
25 BAKER HILL BLVD  
STOUFFVILLE, ONTARIO

PROJECT NO #: 14-016

CONTRACT: Electrical

DATE July 12, 2018

SITE INSTRUCTION NO.: E-27

THIS SITE INSTRUCTION IS NOT TO BE CONSTRUED AS A CHANGE IN THE CONTRACT PRICE, BUT IS ISSUED FOR CLARIFICATION ONLY. IF A CHANGE IN CONTRACT PRICE IS PERCEIVED, PROVIDE AN ITEMIZED BREAKDOWN OF ANY EXTRAS OR CREDITS WITHIN SEVEN (7) WORKING DAYS.

**PURPOSE:** Revise suite 716 to match Arch drawing changes.

### 1.0 Reference Drawings E-7A (7<sup>th</sup> Floor A - Electrical) Issued

- 1.1 Revise: Electrical layout for suite 716 as shown.  
Confirm exact mechanical equipment location on site prior to rough in.

PREPARED BY:

Susan Pan

Susan Pan  
Electrical Department

ISSUED TO ROYAL PINE HOMES,  
Cinzia Caruso, Cinzia@royalpinehomes.com;  
Vince Staffieri, vince@royalpinehomes.com  
FOR DISTRIBUTION TO ALL AFFECTED PARTIES.

16

15

EY1

14

13

12

11

10

8

7

5

4

3

1

A

Aa

Ba

C

E

F

G

H

J

K

Kb

P

Ta

Tb


Td

U

FOR CONTINUATION REFER TO DWG. E-7B

## GENERAL KEY NOTES:

- ◆ JUNCTION BOX FOR TRI-SORT GARBAGE SYSTEM
- ◆ TOP OF STAIR SMOKE DETECTOR AND SPEAKER C/W FIRE ALARM ZONE
- ◆ FOR ALL BALCONY RECEPTACLES ON 6TH AND 7TH FLOOR TO BE 1.0M AWAY FROM GAS CONNECTION.
- ◆ DOOR HOLD OPEN DEVICE INTERCONNECTED TO FIRE ALARM SYSTEM TO RELEASE UPON ACTIVATION OF FIRE ALARM SYSTEM INTERCONNECTED TO LOCALIZED SMOKE DETECTORS.
- ◆ CONFIRM ALL DIMENSIONS OF LIGHTING FIXTURES ON SITE WITH CLIENT PRIOR TO ROUGH-IN.

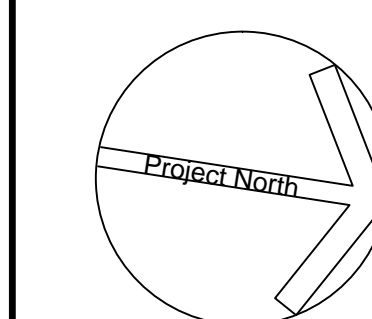

**United Engineering Inc.**  
Mechanical Electrical Consulting Engineers  
3345 Reele Street, Suite 105,  
Toronto, Ontario, M3J 1W6  
Tel: (416) 398 1999, Fax: (416) 398 1933

TITLE  
**7TH FLOOR PLAN - A  
ELECTRICAL**

PROJECT  
**PROPOSED RESIDENTIAL DEVELOPMENT  
25 BAKER HILL BLVD.**

**ROYAL PINE HOMES  
STOUFFVILLE, ONTARIO**

DRAWN CM	CHECKED MG	SCALE 1:75
DATE SEPT. 2015	PROJECT 14-016	DRAWING E-7A OF 12

NO.	BY	DESCRIPTION	DATE
12	SP	REVISED AS PER SI E-27	2018-07-12
11	CM	REVISED AS PER SI E-14	2017-11-17
10	CM	REVISED AS PER SI E-10	2017-09-12
09	CM	REVISED AS PER SI E-4	2017-08-17
08	CM	REVISED AS PER SI E-3	2017-08-11
07	CM	ISSUED FOR CONSTRUCTION	2017-08-09
06	CM	PROGRESS FOR CONSTRUCTION	2017-07-18
05	CM	ISSUED FOR PERMIT	2016-12-28
04	CM	REVISED AS PER ADD E-1	2016-12-12
03	CM	REVISED AS PER SI E-2	2016-10-04
02	CM	REVISED AS PER ESA COMMENTS AND FOR CLARIFICATION	2016-05-19
01	CM	ISSUED FOR TENDER	2016-03-15