





Remsenburg

Suite #216


ORIGINAL
Brochure

1,031 SQ FT *plus 124 sq. ft. of balcony area*


(Inventory Suite)

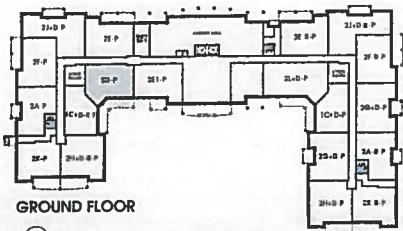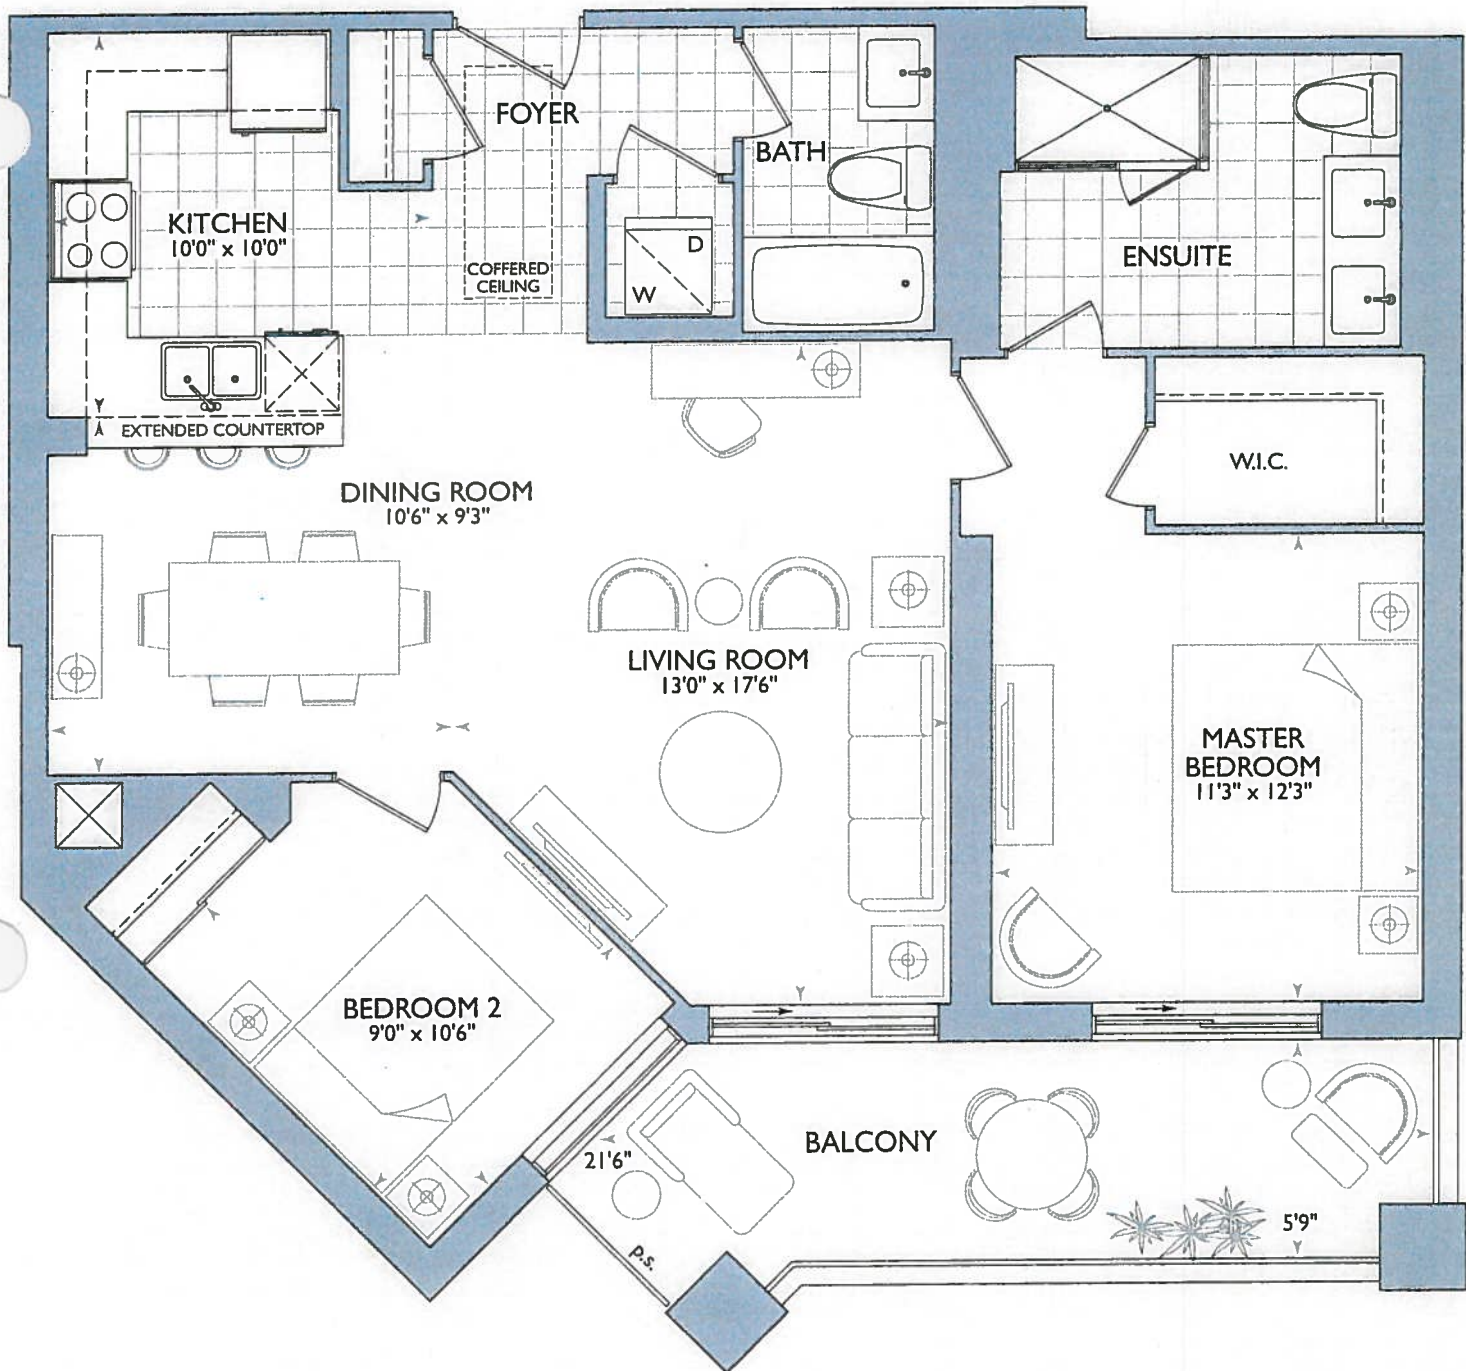

GROUND FLOOR

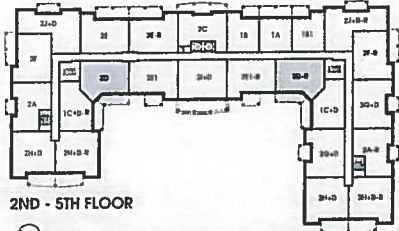


2ND - 5TH FLOOR

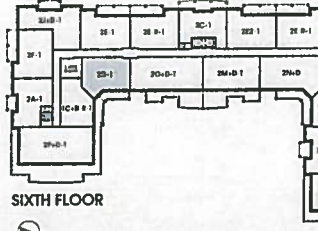

SIXTH FLOOR



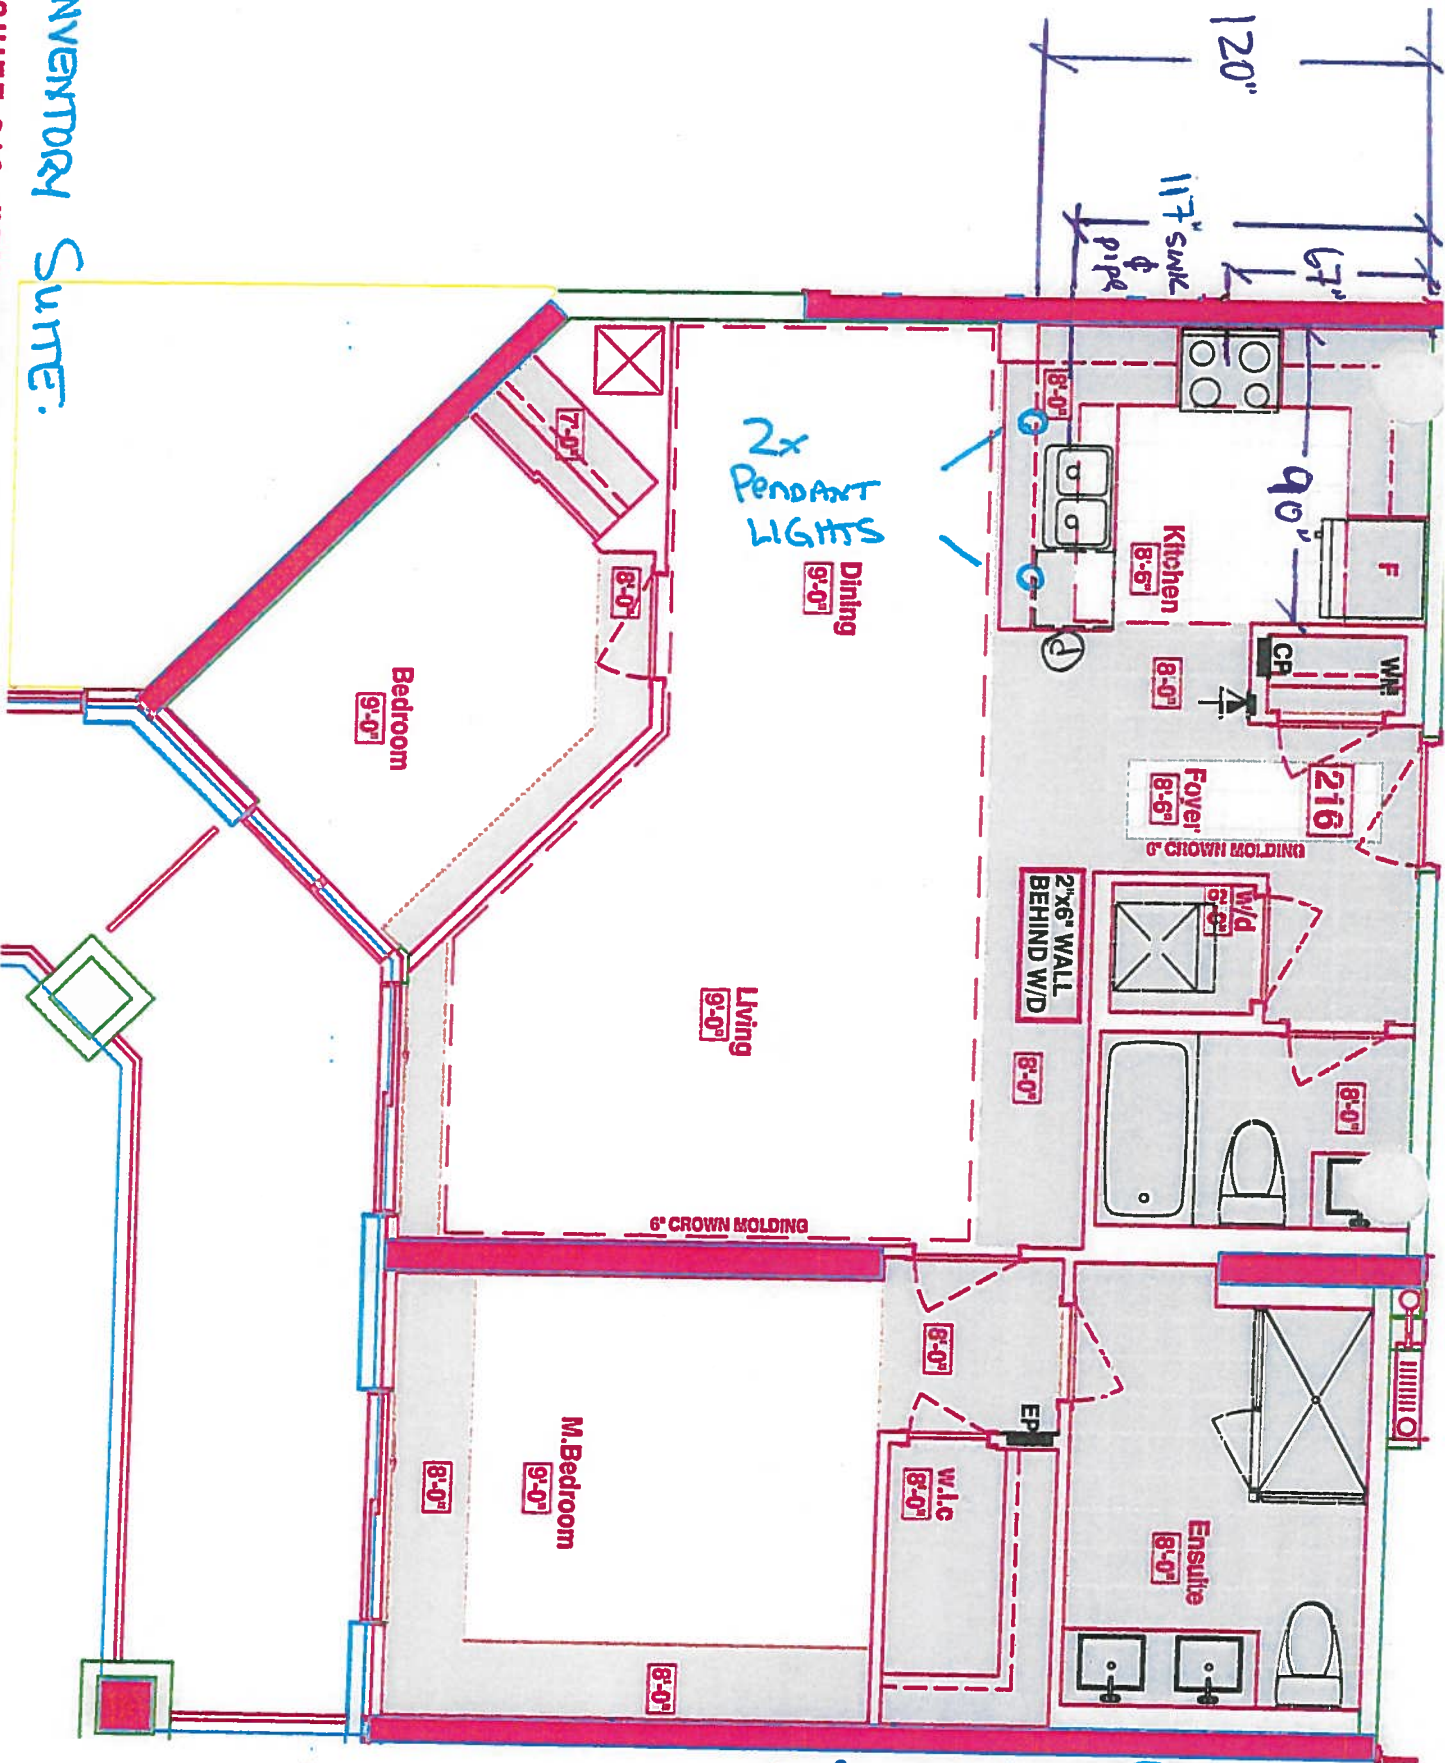

Inventory Suite.

SUITE 216- REMSENBURG - 2D-R

HALETON PLACE

25 Baker Hill Blvd - Stoughton, ON Jan 23, 2018

DRAWING AS PER AGREEMENT OF PURCHASE AND SALE (before decor appointment)

KITCHEN:

(P) = Plug Peninsula

(2x) = Pendant Lights

over Peninsula

STO KITCHEN LAYOUT

1ST UPG APPLIANCE PKG. w/

UPG 36" FRIDGE

(3x) = Plug Lights

(1x) = Plug Peninsula


- 66" stove fire center
- 117" sink fire center

LEGEND:	
	SECURITY PANEL
	ELECTRICAL PANEL
	COMMUNICATION PANEL
	WATER METER
	FRIDGE
	DROPPED AREA
	6" CROWN MOLDING

Suite 216


Inventory Suite
Revised

- ① 1st URG APPLIANCE
PKG w URG 36"1
FRIDGE.
- ② (x2) = CAPPS Pendant
LIGHTS over
Peninsula
- ③ (x3) PUCK LIGHTS
Peninsula
- ④ (x1) PUCK
Peninsula
- ⑤ SMO KITCHEN
LAYOUT
- ⑥ Raised Powder Room +
bathsuite YHUNITIES
36 1/4" @ 3" splash.

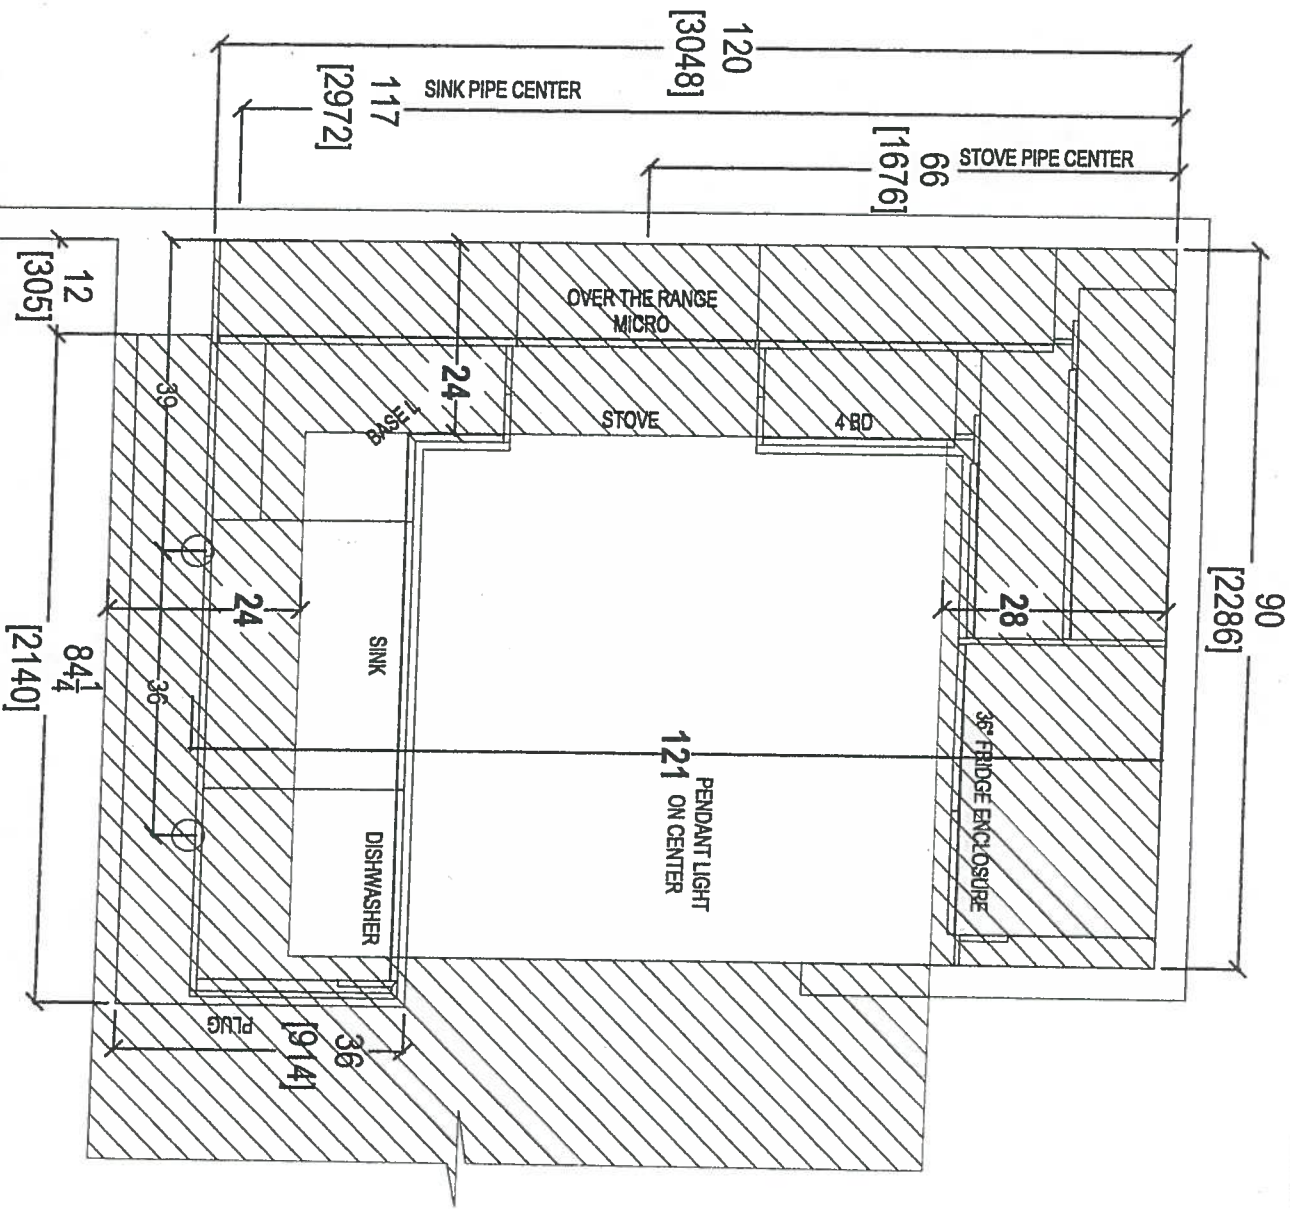

your kitchen, your taste.
80 SANTE DRIVE, VAUGHAN, ON L4K 3C4,
T: 416.746.1811 F: 905.761.5901

CLIENT: ROYAL PINE HOMES	JOB NAME: UNIT 216 HMP	ROOM: KITCHEN	DRAWN BY: SK	COMMENTS:
SITE: HAMPTON PLACE	DOOR STYLE: —	DOOR HANDLE: —	SCALE: 1/2" = 1'-0"	PLEASE NOTE ALL DIMENSIONS ARE NOT FINAL AND ARE SUBJECT TO CHANGE UPON FINAL SITE MEASURE
PHONE: —	FINISH: —	DRW HANDLE: —	DATE: JAN 22, 2019	
EMAIL: —	SPECIES: —	TOP: —	PAGE: —	


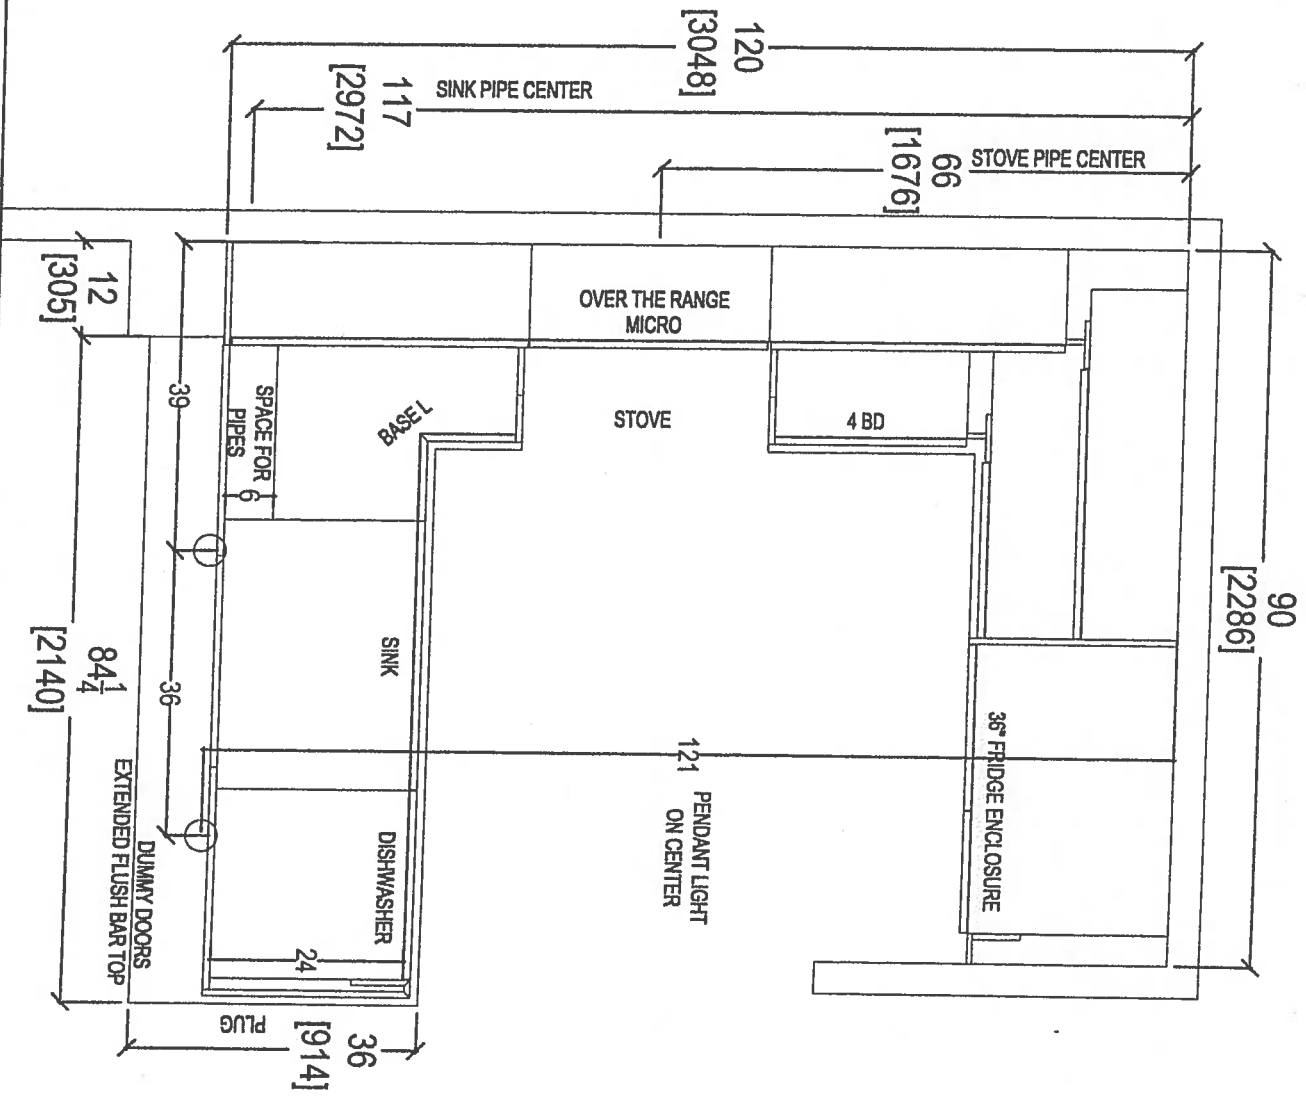


80 SANTE DRIVE, VAUGHAN, ON L4K 3C4,
T: 416.746.1811 F: 905.761.5801

CLIENT: ROYAL PINE HOMES		JOB NAME: UNIT 216 HMP		ROOM: KITCHEN		DRAWN BY: SK	
SITE: HAMPTON PLACE		DOOR STYLE: —		DOOR HANDLE: —		SCALE: 1/2" = 1'-0"	
PHONE: —		FINISH: —		DRW HANDLE: —		DATE: JAN 22, 2019	
EMAIL: —		SPECIES: —		TOP: —		PAGE: —	


COMMENTS:

PLEASE NOTE ALL DIMENSIONS
ARE NOT FINAL AND ARE
SUBJECT TO CHANGE UPON
FINAL SITE MEASURE

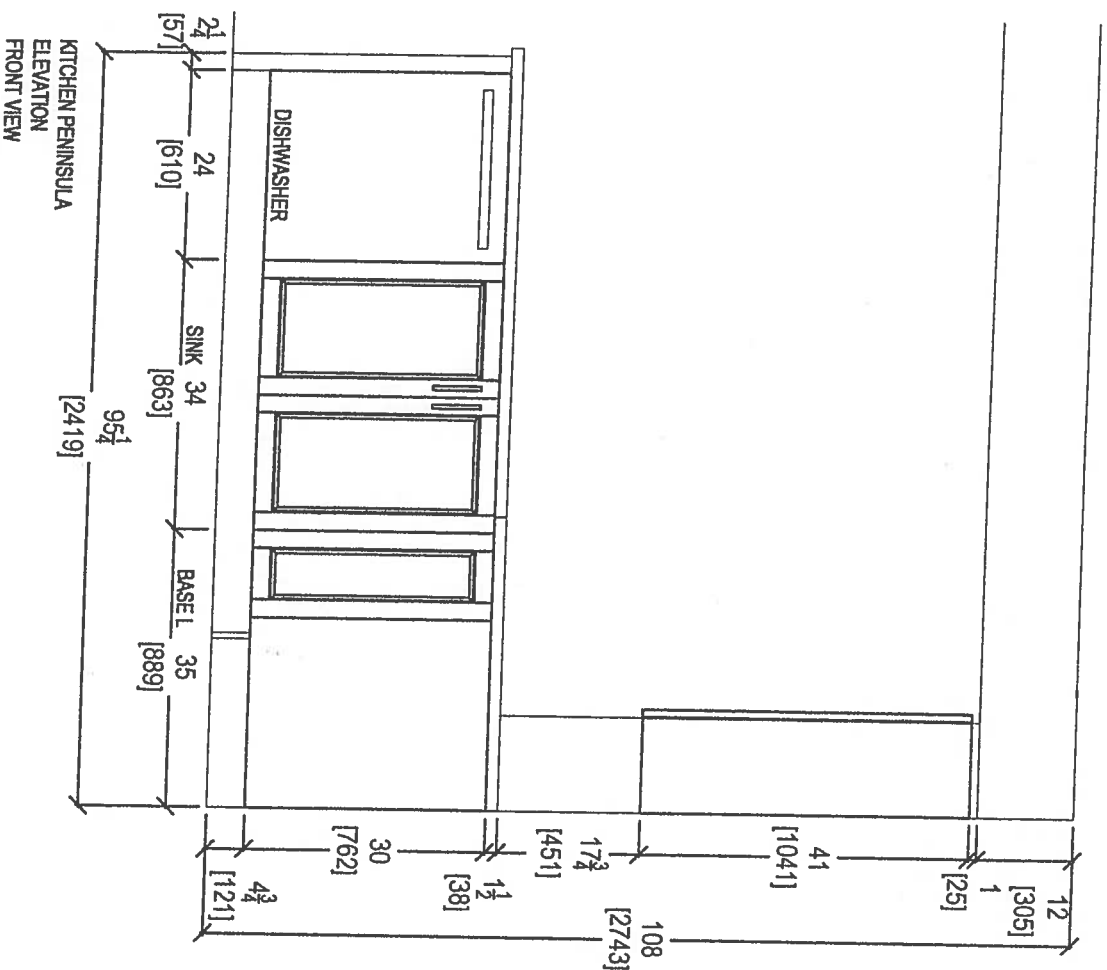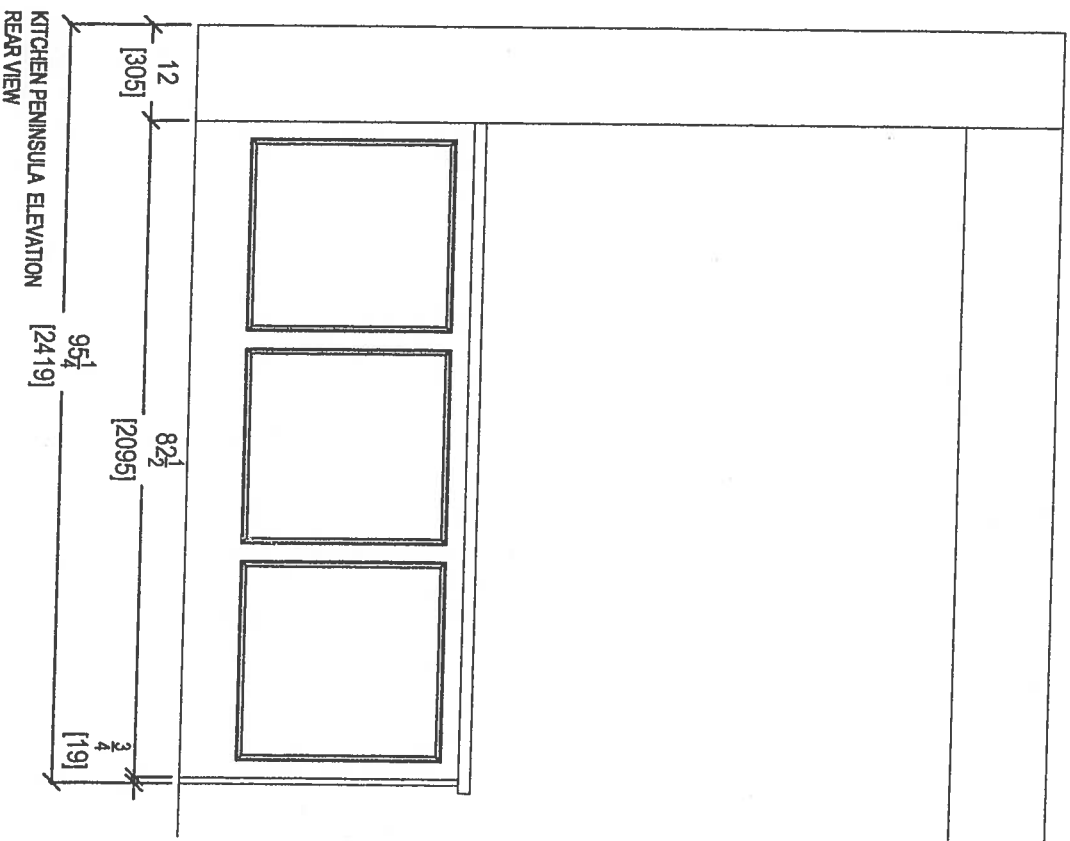


your kitchen, your taste
80 SANTE DRIVE, VAUGHAN, ON L4K 3C4,
T: 416.746.1811 F: 905.761.5901



CLIENT: ROYAL PINE HOMES	JOB NAME: UNIT 216 HMP	ROOM: KITCHEN	DRAWN BY: SK	COMMENTS: PLEASE NOTE ALL DIMENSIONS ARE NOT FINAL AND ARE SUBJECT TO CHANGE UPON FINAL SITE MEASURE
SITE: HAMPTON PLACE	DOOR STYLE: —	DOOR HANDLE: —	SCALE: 1/2" = 1' - 0"	
PHONE: —	FINISH: —	DRW HANDLE: —	DATE: JAN 22, 2019	
EMAIL: —	SPECIES: —	TOP: —	PAGE: —	

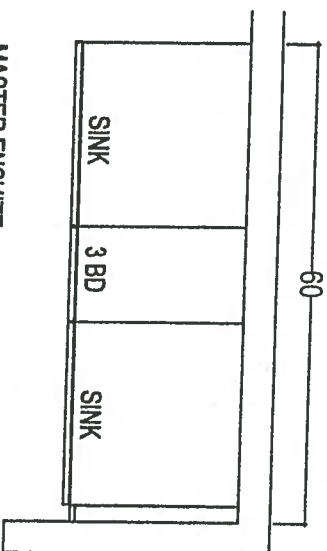

MASTER ENSUITE

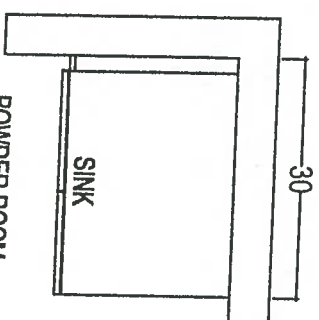

POWDER ROOM

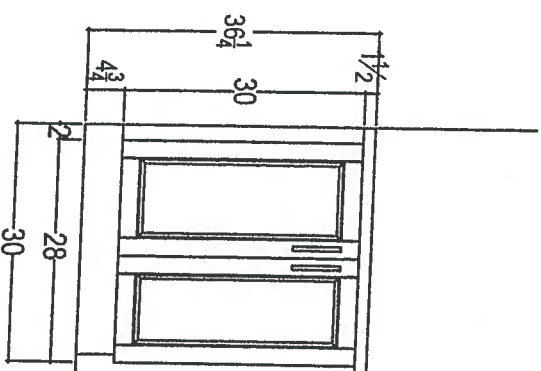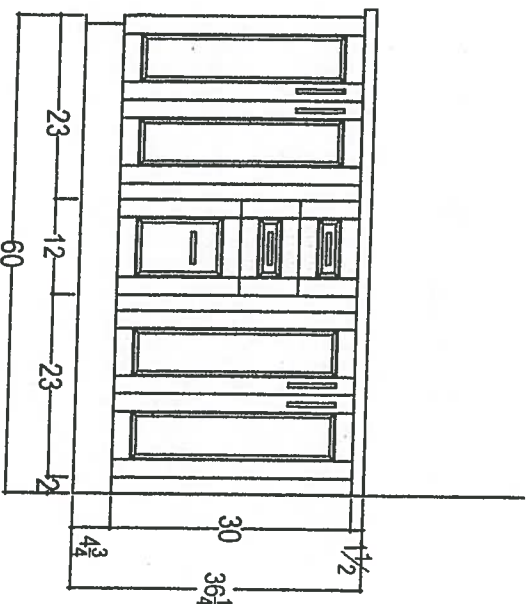

Raised VANITIES Powder Room + Ensuite (+) 3" splash

N/c as per Fengue



your kitchen, your taste.
80 SANTE DRIVE, VAUGHAN, ON L4K 3C4,
T: 416.746.1811 F: 905.761.5901

CLIENT: ROYAL PINE HOMES	JOB NAME: UNIT 218 HMP	ROOM: VANITIES	DRAWN BY: SK
SITE: HAMPTON PLACE	DOOR STYLE: —	DOOR HANDLE: —	SCALE: 1/2" = 1' - 0"
PHONE: —	FINISH: —	DRW HANDLE: —	DATE: JAN 22, 2018
EMAIL: —	SPECIES: —	TOP: —	PAGE: —

COMMENTS:
PLEASE NOTE ALL DIMENSIONS
ARE NOT FINAL AND ARE
SUBJECT TO CHANGE UPON
FINAL SITE MEASURE