

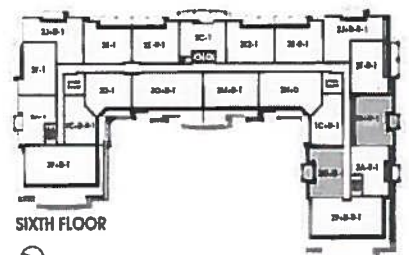


Suite 507
Original Layout
Inventory Suite.

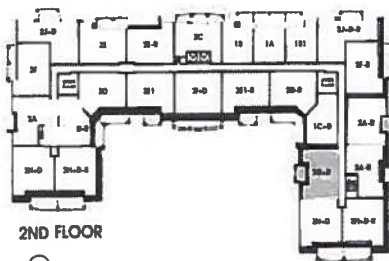

Noyac Bay

1,121 SQ FT *plus* 76 sq. ft. of balcony area

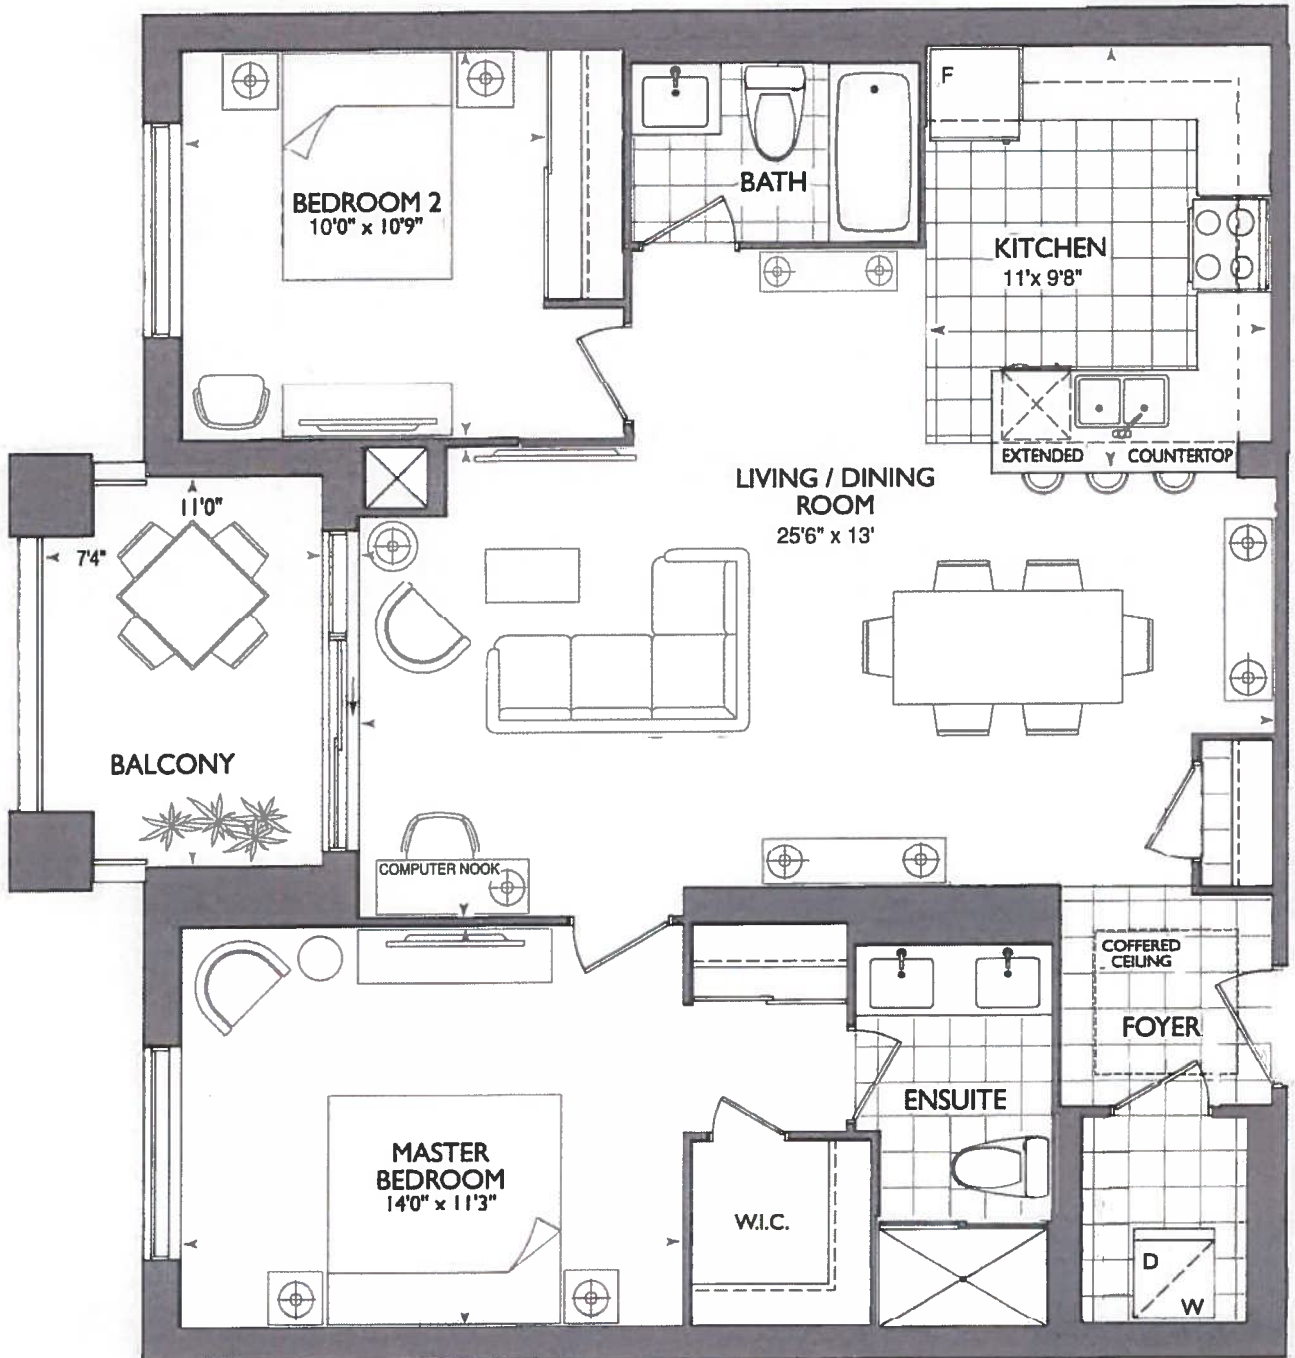


Plans and specifications are subject to change without notice. Actual usable floor space may vary from the stated floor area. All renderings are artist's concept E. & O. E.



*** KITCHEN ***

- STD Kitchen LAYOUT:
w/ OPTIMUM MAGIC
CORNER, opt upper
L-SHAPE CORNER
CABINET AND STD
MICRO SHELF w/
Dinner Below
- 1ST UPGRADE APPLIANCE
PKG w/ 36" REFRIDGE
(+) CHIMNEY HOOD FAN (+)
MICRO IN BASE
SIDE
- (x6) = PUCK LIGHTS ?? OPT
- 61" STOVE PIPE CENTER
- 129" SINK PIPE CENTER
- (x2) = CAPPED PENDANTS
- * MAIN / ENSUITE RANCO
- RANCO VARNISH w/
3" SPLASH

* LIVING Room
Conduit / Plug / Blocking
w/ main to T.V

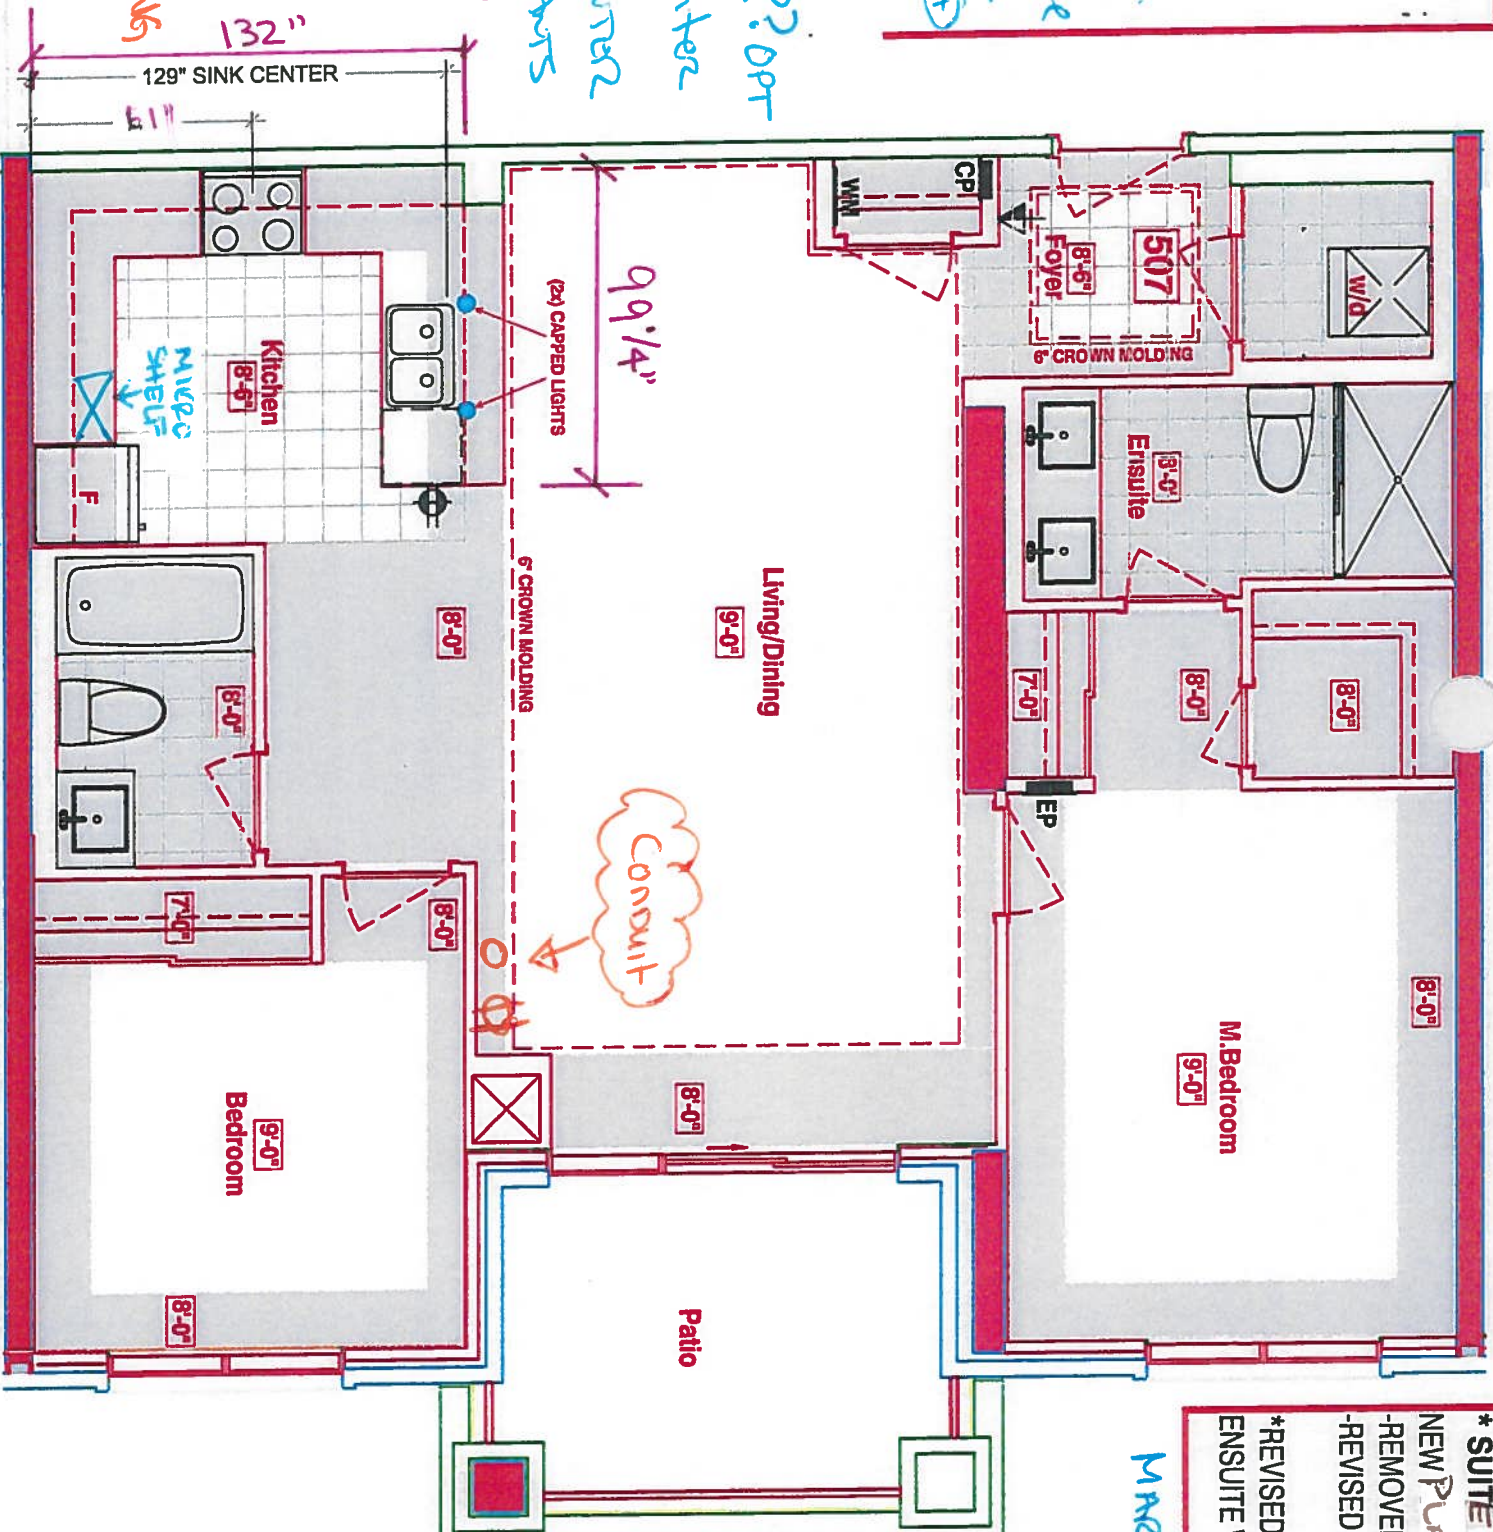

*** SUITE 507 (INVENTORY SUITE)**

NEW PLAN
- REMOVED DEN
- REVISED KITCHEN

* REVISED LAUNDRY DOOR SWING &
ENSUITE WALL AS PER THIS BROCHURE

MAR 4 19


LEGEND:

- SP SECURITY PANEL
- EP ELECTRICAL PANEL
- CP COMMUNICATION PANEL
- WM WATER METER
- F FRIDGE
- DROPPED AREA
- - - 6" CROWN MOLDING

Suite Hampton

Living Room

→ CONDUIT =

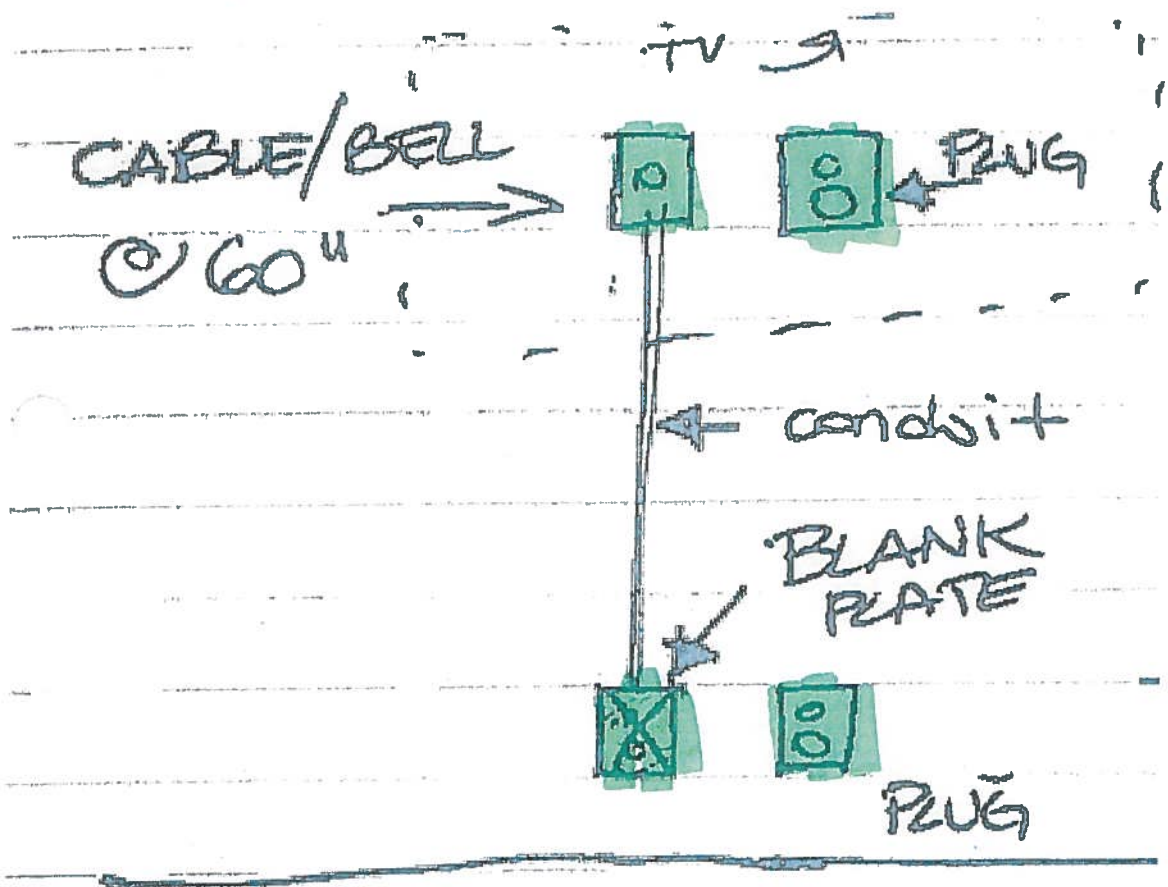

Suite 507. Mar 4. 19
Inventory Suite


- STD Kitchen LAYOUT WITH OPTIONAL MAGIC CORNER, OPT UPPER L-SHAPED CORNER, STD BASE CABINET MICRO SHELF w/ DRAWER BELOW
- 1st UP6 APPLIANCE PKG.

- w/ 36" FRIDGE @ CHIMNEY HOOD FAN @ MICRO
- (x6) Puck LIGHTS ??
- (x2) PENDANT CAPPED LIGHTS OVER PENINSULA

* Powder Room @ ENSUITE
RANSO VANITY 36 1/4 + 3" SQUASH

RECEIVED 3" SQUASH

FEB 06 2019

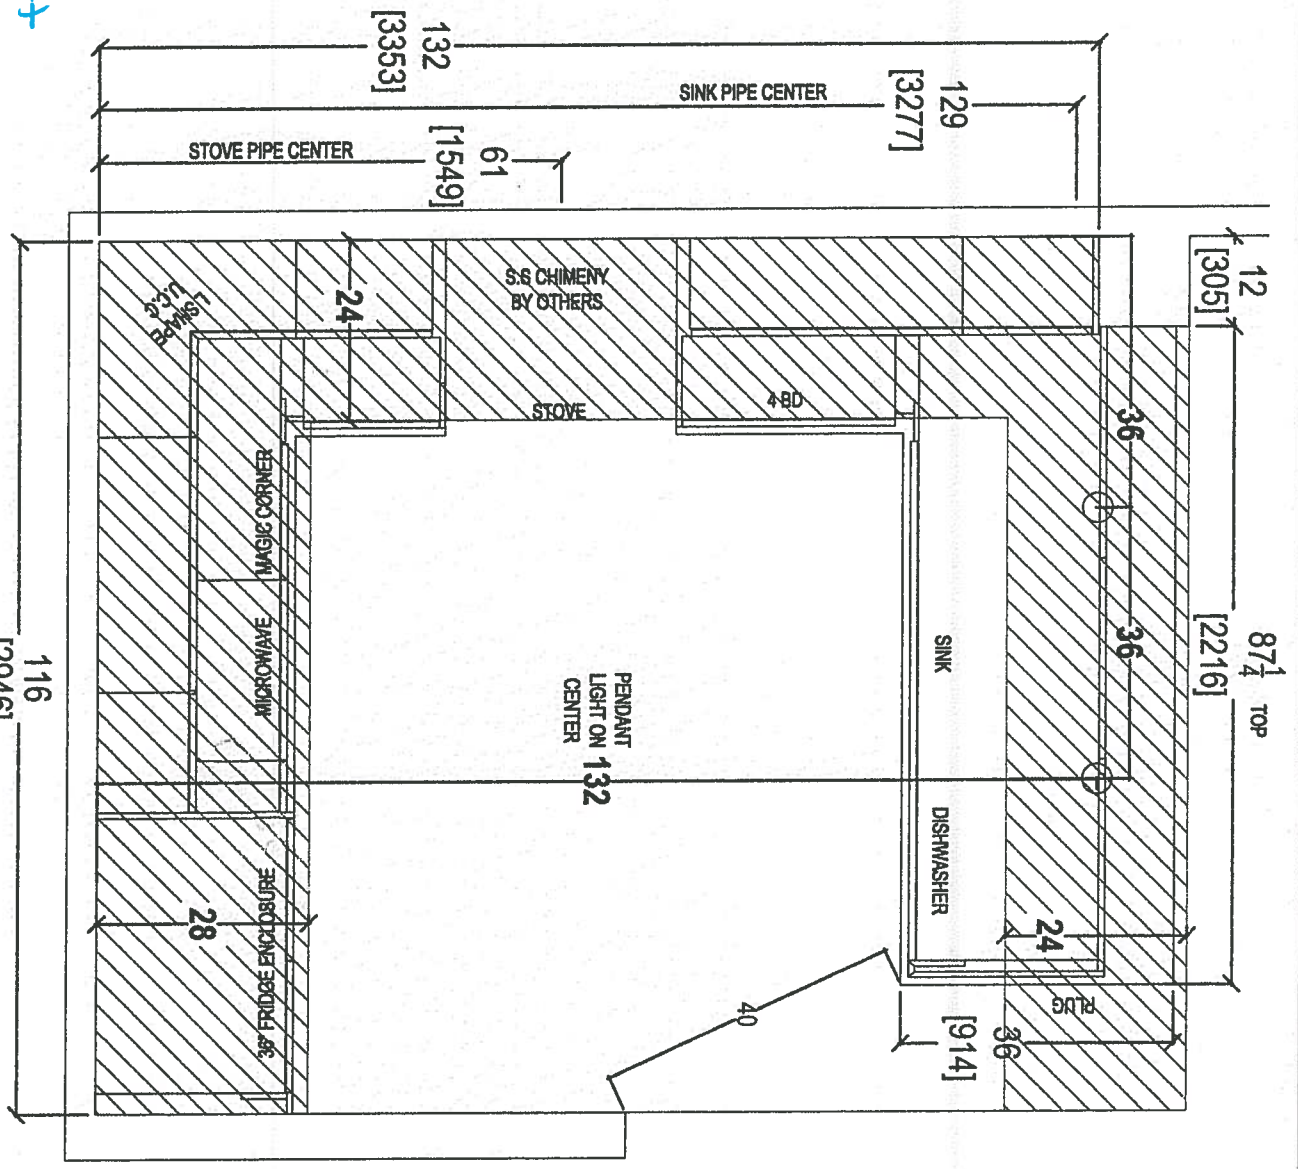


QTH
your kitchen, your taste.
80 SANTE DRIVE, VAUGHAN, ON L4K 3C4,
T: 416.748.1811 F: 905.761.5901

CLIENT: ROYAL PINE HOMES	JOB NAME: UNIT 507 HMP	ROOM: KITCHEN	DRAWN BY: SK	COMMENTS:
SITE: HAMPTON PLACE	DOOR STYLE: ---	DOOR HANDLE: ---	SCALE: 1/2" = 1'-0"	PLEASE NOTE ALL DIMENSIONS ARE NOT FINAL AND ARE SUBJECT TO CHANGE UPON FINAL SITE MEASURE
PHONE: ---	FINISH: ---	DRW HANDLE: ---	DATE: FEB 8, 2019	
EMAIL: ---	SPECIES: ---	TOP: ---	PAGE:	


RECEIVED
FEB 06 2019



your kitchen, your taste.
80 SANTE DRIVE, VAUGHAN, ON L4K 3C4,
T: 416.748.1811 F: 905.761.5901

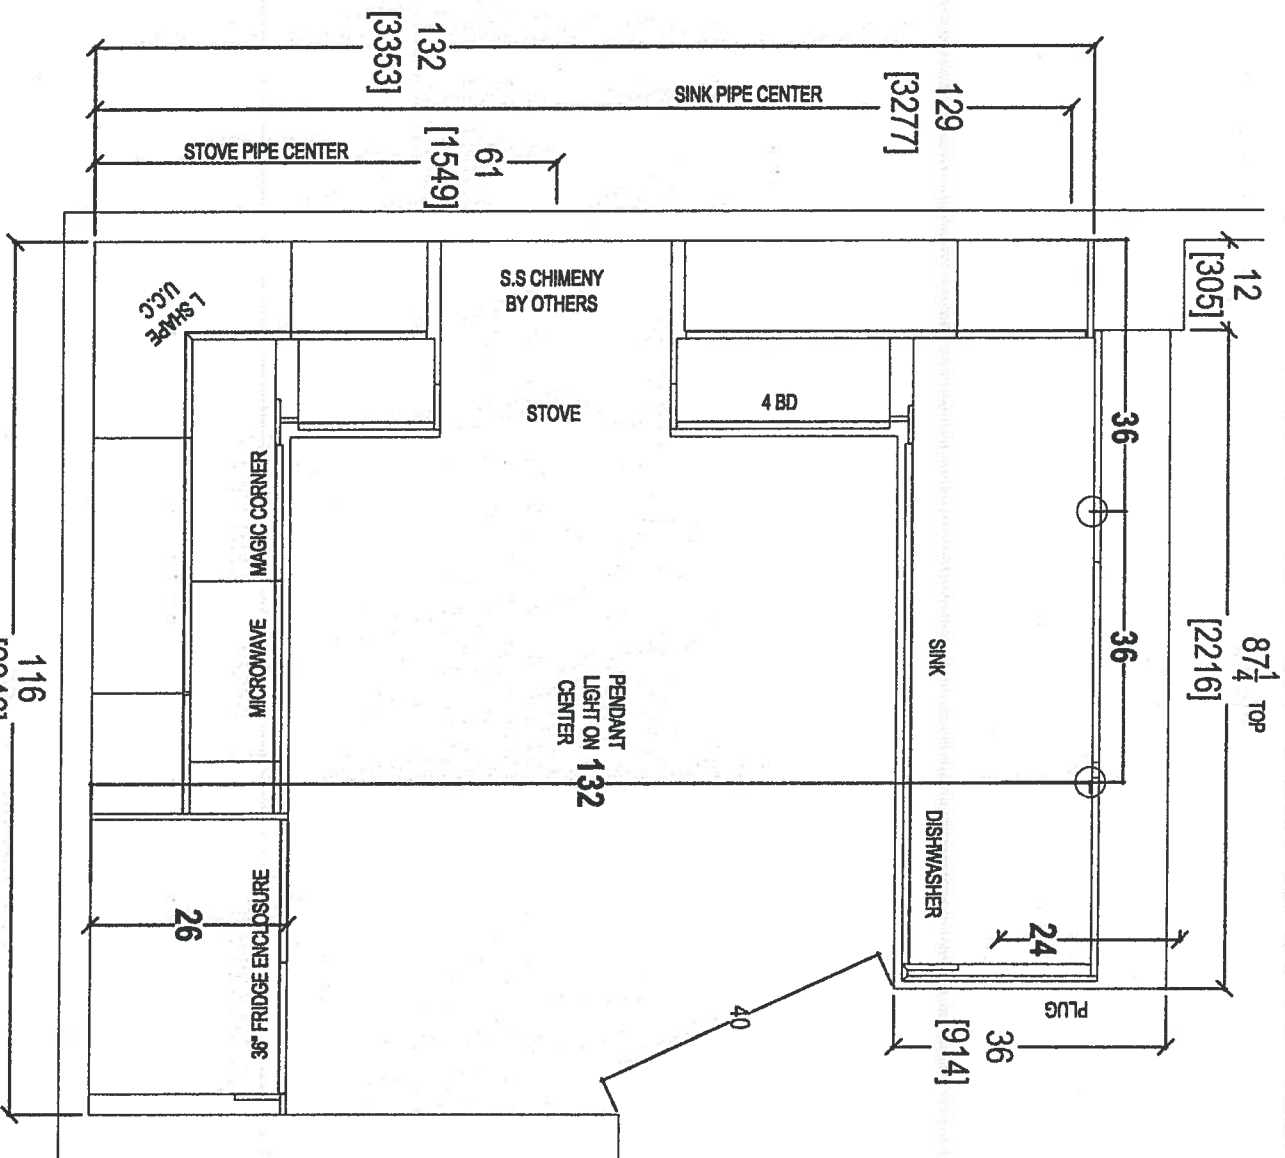

CLIENT: ROYAL PINE HOMES	JOB NAME: UNIT 507 HMP	ROOM: KITCHEN	DRAWN BY: SK	COMMENTS:
SITE: HAMPTON PLACE	DOOR STYLE: --	DOOR HANDLE: --	SCALE: 1/2" = 1' - 0"	PLEASE NOTE ALL DIMENSIONS ARE NOT FINAL AND ARE SUBJECT TO CHANGE UPON FINAL SITE MEASURE
PHONE: --	FINISH: --	DRW HANDLE: --	DATE: FEB 6, 2019	
EMAIL: --	SPECIES: --	TOP: --	PAGE:	

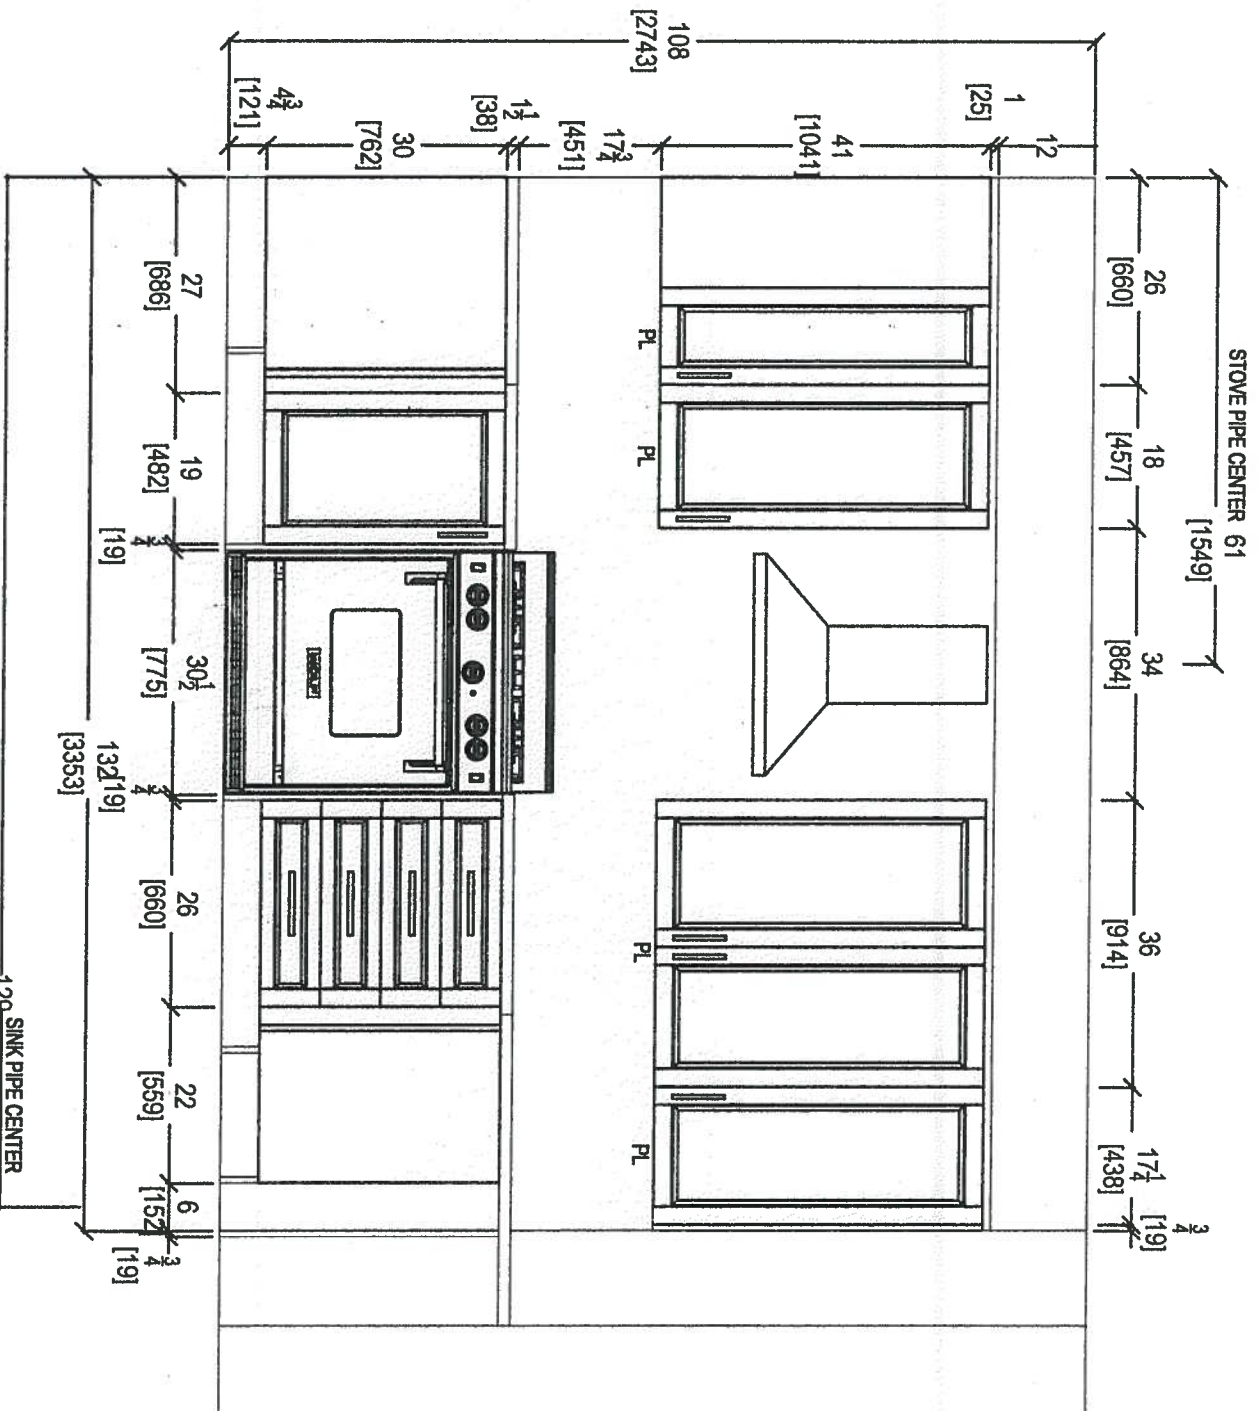


RECEIVED
FEB 06 2019



your kitchen, your taste.
80 SANTE DRIVE, VAUGHAN, ON L4K 3C4,
T: 416.746.1811 F: 905.761.5901

CLIENT: ROYAL PINE HOMES	JOB NAME: UNIT 507 HMP	ROOM: KITCHEN	DRAWN BY: SK	COMMENTS:
SITE: HAMPTON PLACE	DOOR STYLE: —	DOOR HANDLE: —	SCALE: 1/2" = 1'-0"	PLEASE NOTE ALL DIMENSIONS ARE NOT FINAL AND ARE SUBJECT TO CHANGE UPON FINAL SITE MEASURE
PHONE: —	FINISH: —	DRW HANDLE: —	DATE: FEB 6, 2019	
EMAIL: —	SPECIES: —	TOP: —	PAGE:	

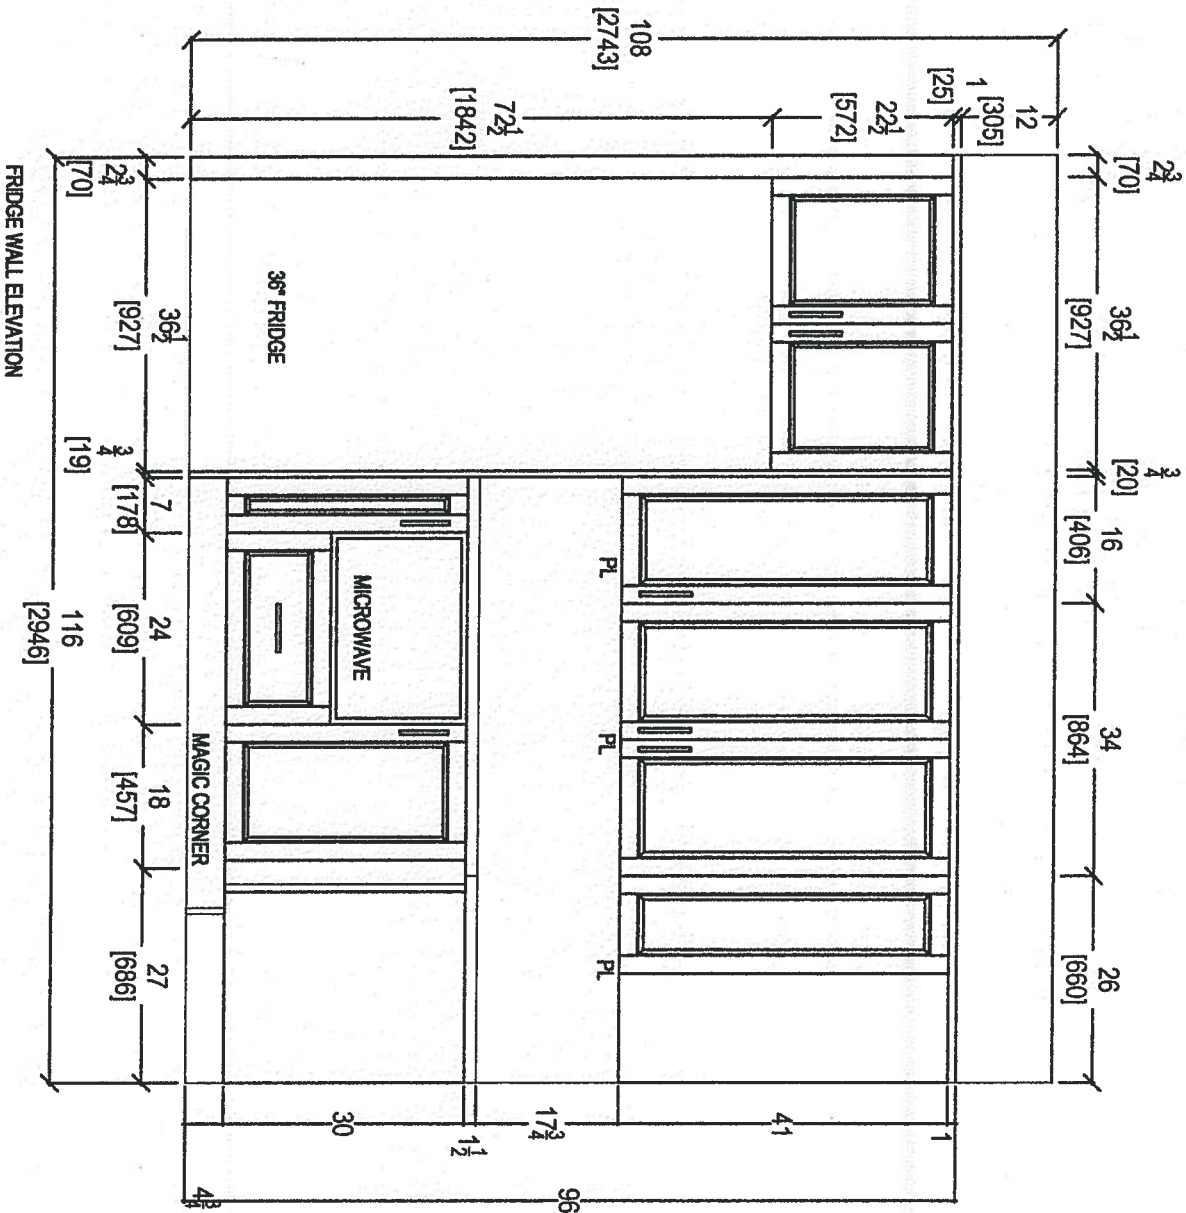

FRIDGE WALL ELEVATION

RECEIVED
FEB 06 2019



80 SANTE DRIVE, VAUGHAN, ON L4K 3C4,
T: 416.748.1811 F: 905.761.5801

CLIENT: ROYAL PINE HOMES	JOB NAME: UNIT 507 HMP	ROOM: KITCHEN	DRAWN BY: SK	COMMENTS:
SITE: HAMPTON PLACE	DOOR STYLE: —	DOOR HANDLE: —	SCALE: 1/2" = 1' - 0"	PLEASE NOTE ALL DIMENSIONS ARE NOT FINAL AND ARE SUBJECT TO CHANGE UPON FINAL SITE MEASURE
PHONE: —	FINISH: —	DRW HANDLE: —	DATE: FEB 6, 2019	
EMAIL: —	SPECIES: —	TOP: —	PAGE:	







**KITCHEN PENINSULA ELEVATION
REAR VIEW**

FEB 06 2019



PLEASE NOTE ALL DIMENSIONS
ARE NOT FINAL AND ARE
SUBJECT TO CHANGE UPON
FINAL SITE MEASURE

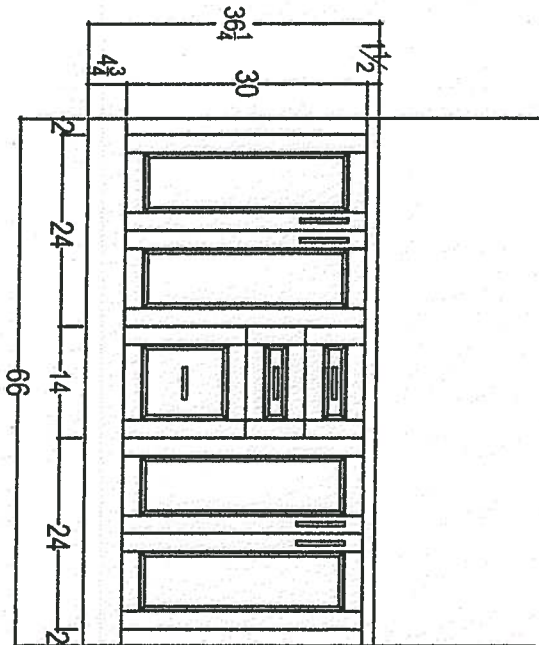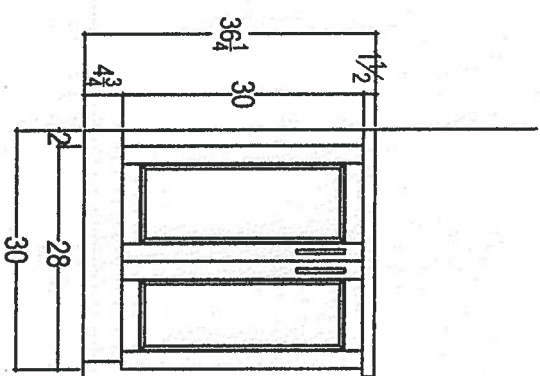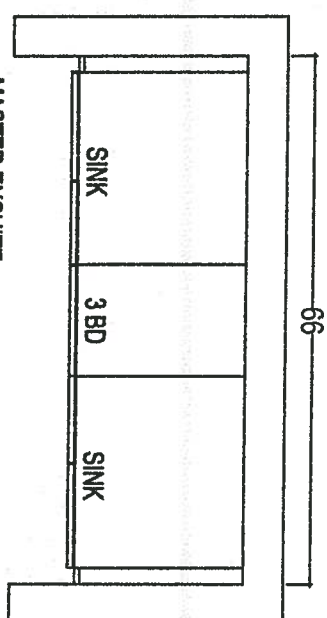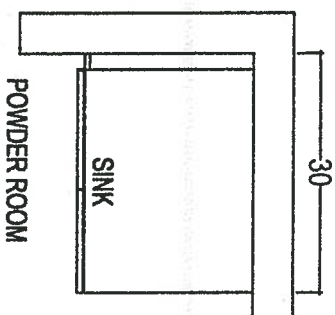

Raised Vanities 36 1/4" w 3" splash

RECEIVED
FEB 06 2019



your kitchen, your taste
80 SANTE DRIVE, VAUGHAN, ON L4K 3C4,
T: 416.746.1811 F: 905.761.5901

CLIENT: ROYAL PINE HOMES	JOB NAME: UNIT 507 HMP	ROOM: VANITIES	DRAWN BY: SK	COMMENTS:
SITE: HAMPTON PLACE	DOOR STYLE: —	DOOR HANDLE: —	SCALE: 1/2" = 1'-0"	PLEASE NOTE ALL DIMENSIONS ARE NOT FINAL AND ARE SUBJECT TO CHANGE UPON FINAL SITE MEASURE
PHONE: —	FINISH: —	DRW HANDLE: —	DATE: MAY 1, 2018	
EMAIL: —	SPECIES: —	TOP: —	PAGE:	