

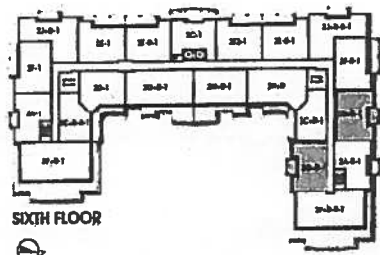


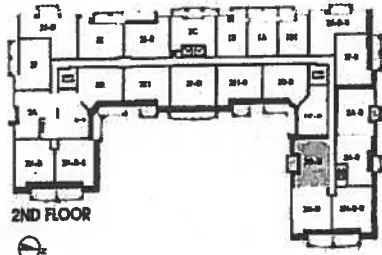

Noyac Bay

1,121 SQ FT *plus* 76 sq. ft. of balcony area

Suite 606
NEW ORIGINAL LAYOUT
INVENTORY SUITE

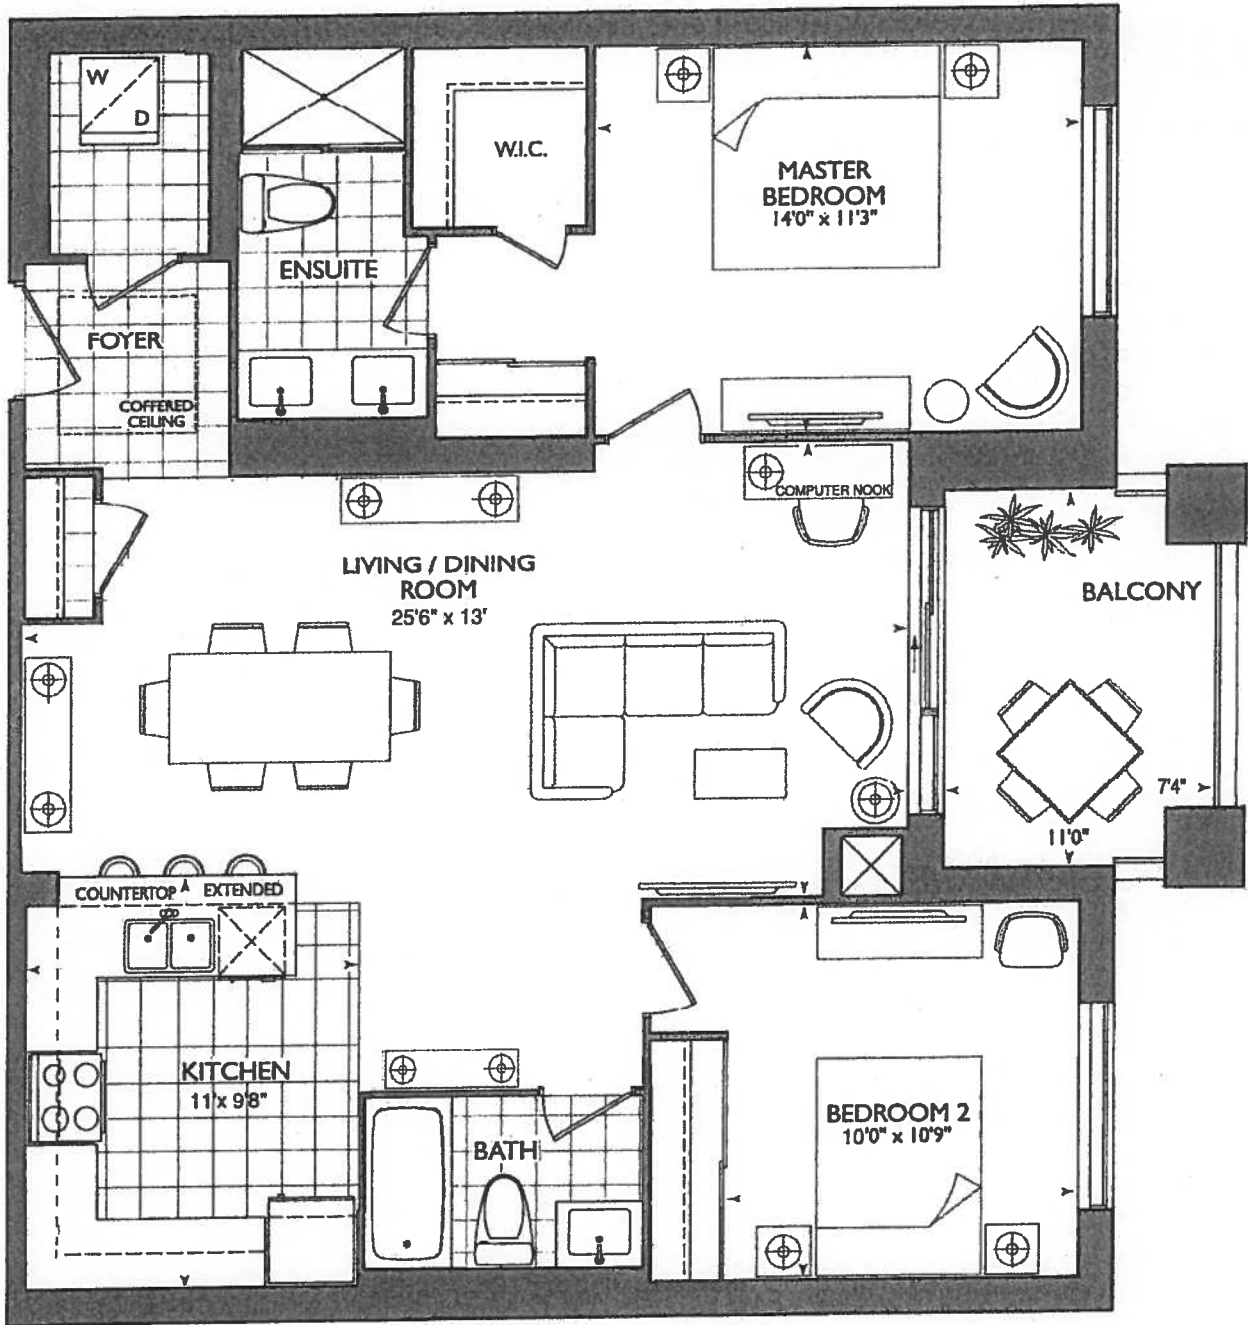


Plans and specifications are subject to change without notice. Actual usable floor space may vary from the stated floor area. All renderings are artist's concept E. & O. E.

Suite Hampton


Living Room

→ CONDUIT =

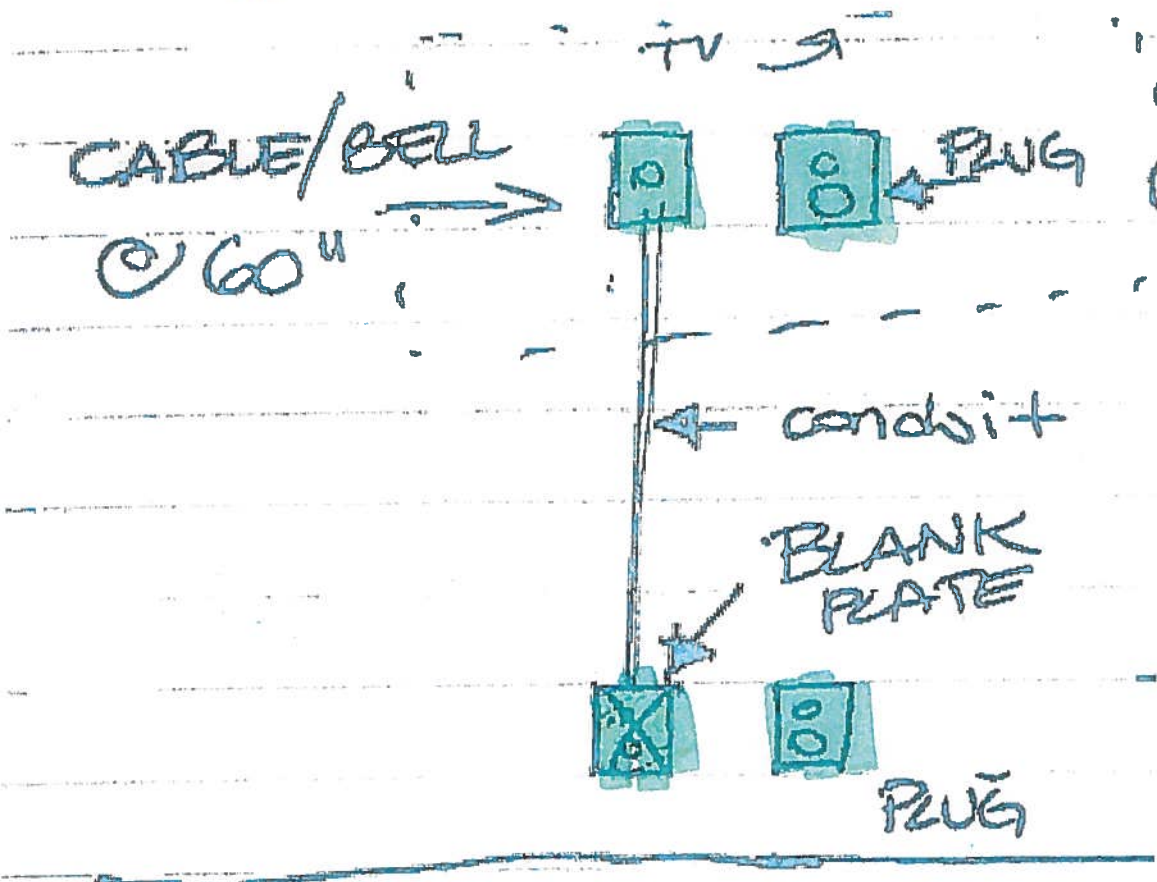

* KITCHEN *

- STANDARD KITCHEN LAYOUT
- 1ST UPG. APPLIANCE PACKAGE WITH: 36" FRIDGE, CHIMNEY HOOD FAN, MICROWAVE SHELF
- 2 CAPPED PENDANT LIGHTS
- x 6 PUCK *LIGHTS*
- 61" STOVE CENTER
- 129" SINK PIPE CENTER
- x1 PLUG IN PENINSULA
- MAIN AND ENSUITE RAISED VANITYS
- 36 1/4" WITH 3" SPLASH
- OPTIONAL KITCHEN UPGRADES: MAGIC BASE CORNER UPPER CORNER 'L' SHAPED CABINET

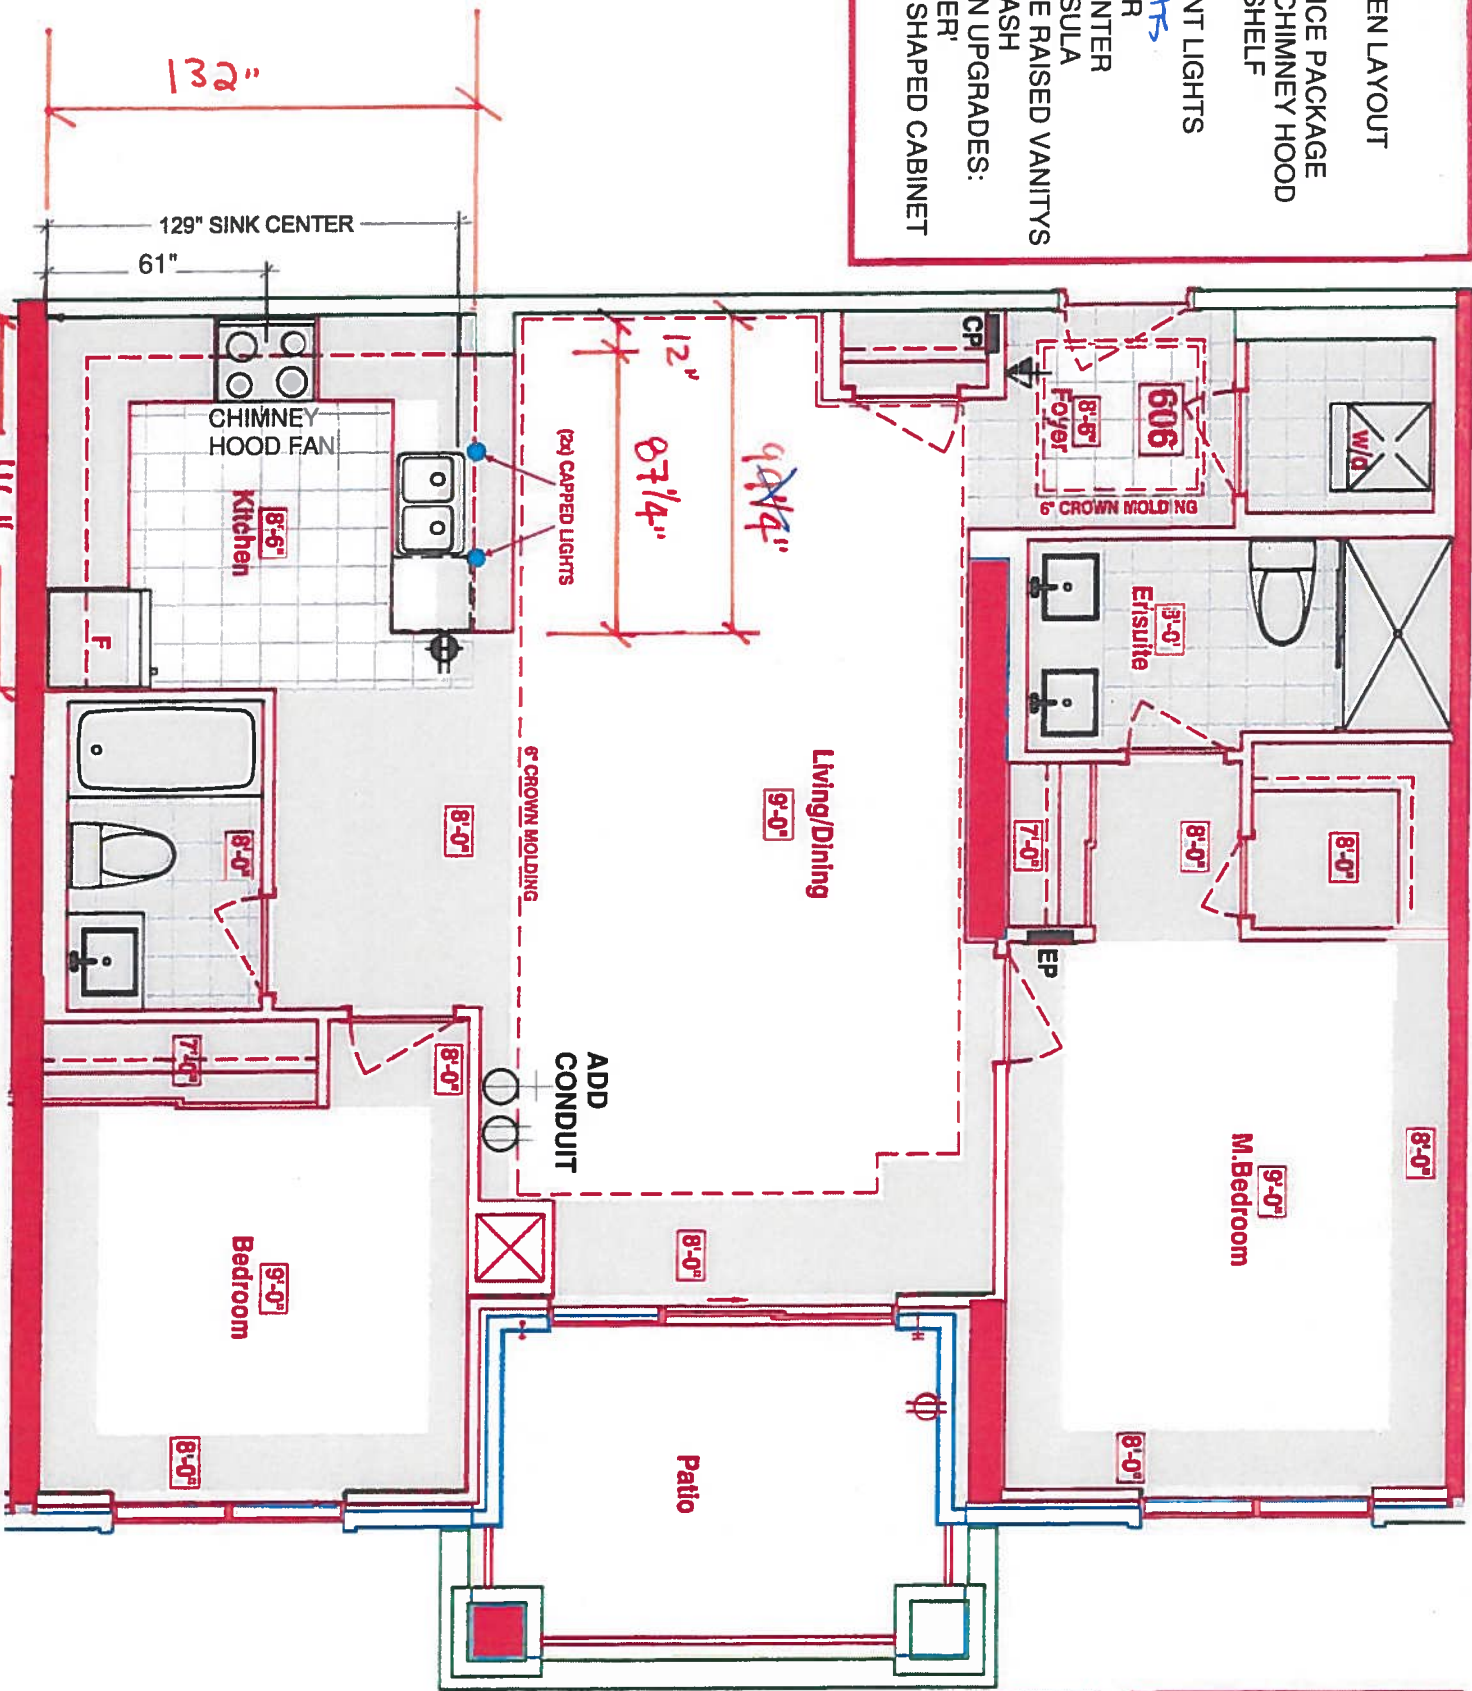

* SUITE 606 (INVENTORY SUITE)

NEW PLAN

- REMOVED DEN
- REVISED KITCHEN
- * REVISED LAUNDRY DOOR SWING & ENSUITE WALL AS PER THIS BROCHURE

ADD 1 CONDUIT IN LIVING/ DINING ROOM + PLUG + BLOCKING FOR FUTURE MOUNTED TV

LEGEND:


- SP SECURITY PANEL
- EP ELECTRICAL PANEL
- CP COMMUNICATION PANEL
- WM WATER METER
- F FRIDGE
- DRIPPED AREA
- 6" CROWN MOLDING

SUITES 606 - NOVAC BAY (Inventory Suite)

Suite
Hampton

Living Room

→ CONDUIT =

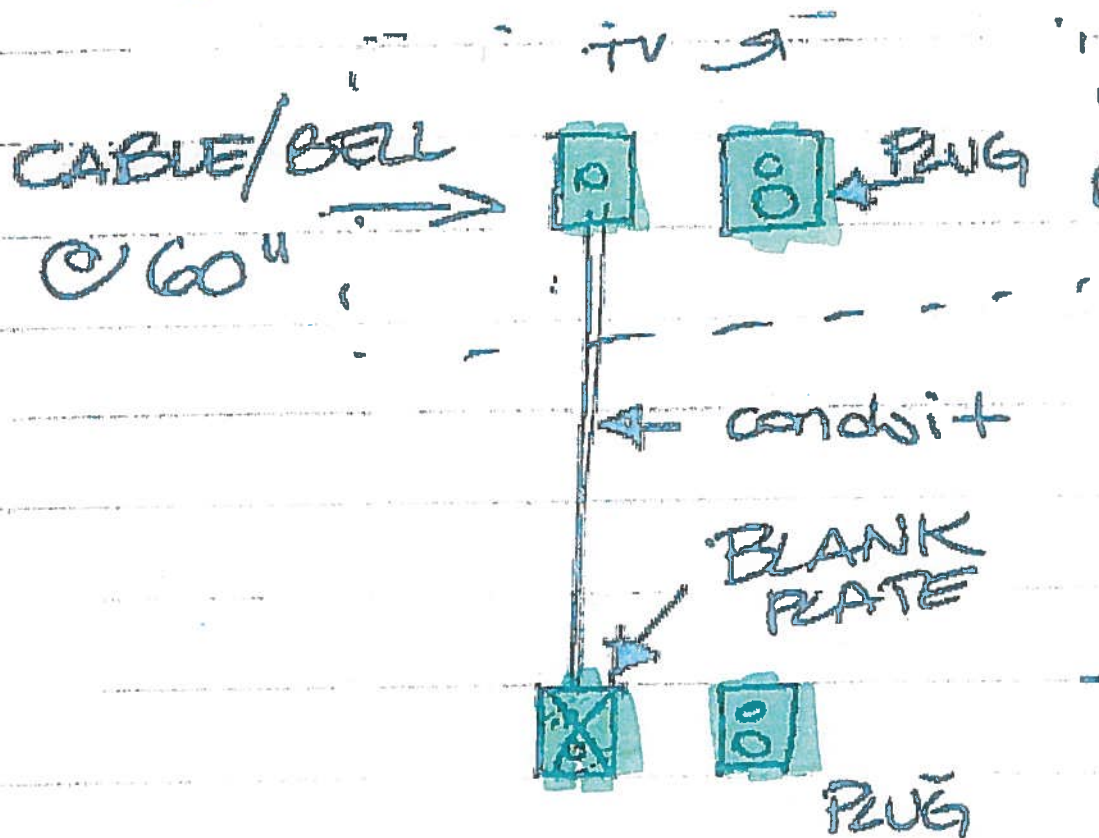


Suite 606 - March

Inventory suite

- STD KITCHEN LAYOUT w/ OPT KITCHED UPG MAGIC BASE CABINET @ upper corner "L" SHAPED CABINET
- 1" UPG APPLIANCE PKG w/ chimney hood fan, 36" REFRIG & MICRO (SHELF)
- (x2) CAPED LIGHTS
- (x6) PUCK LIGHTS
- (x1) PLUG PENINSULA

* Main + BUSINE Raised VANITIES. 36 1/4" w 3" SPACER

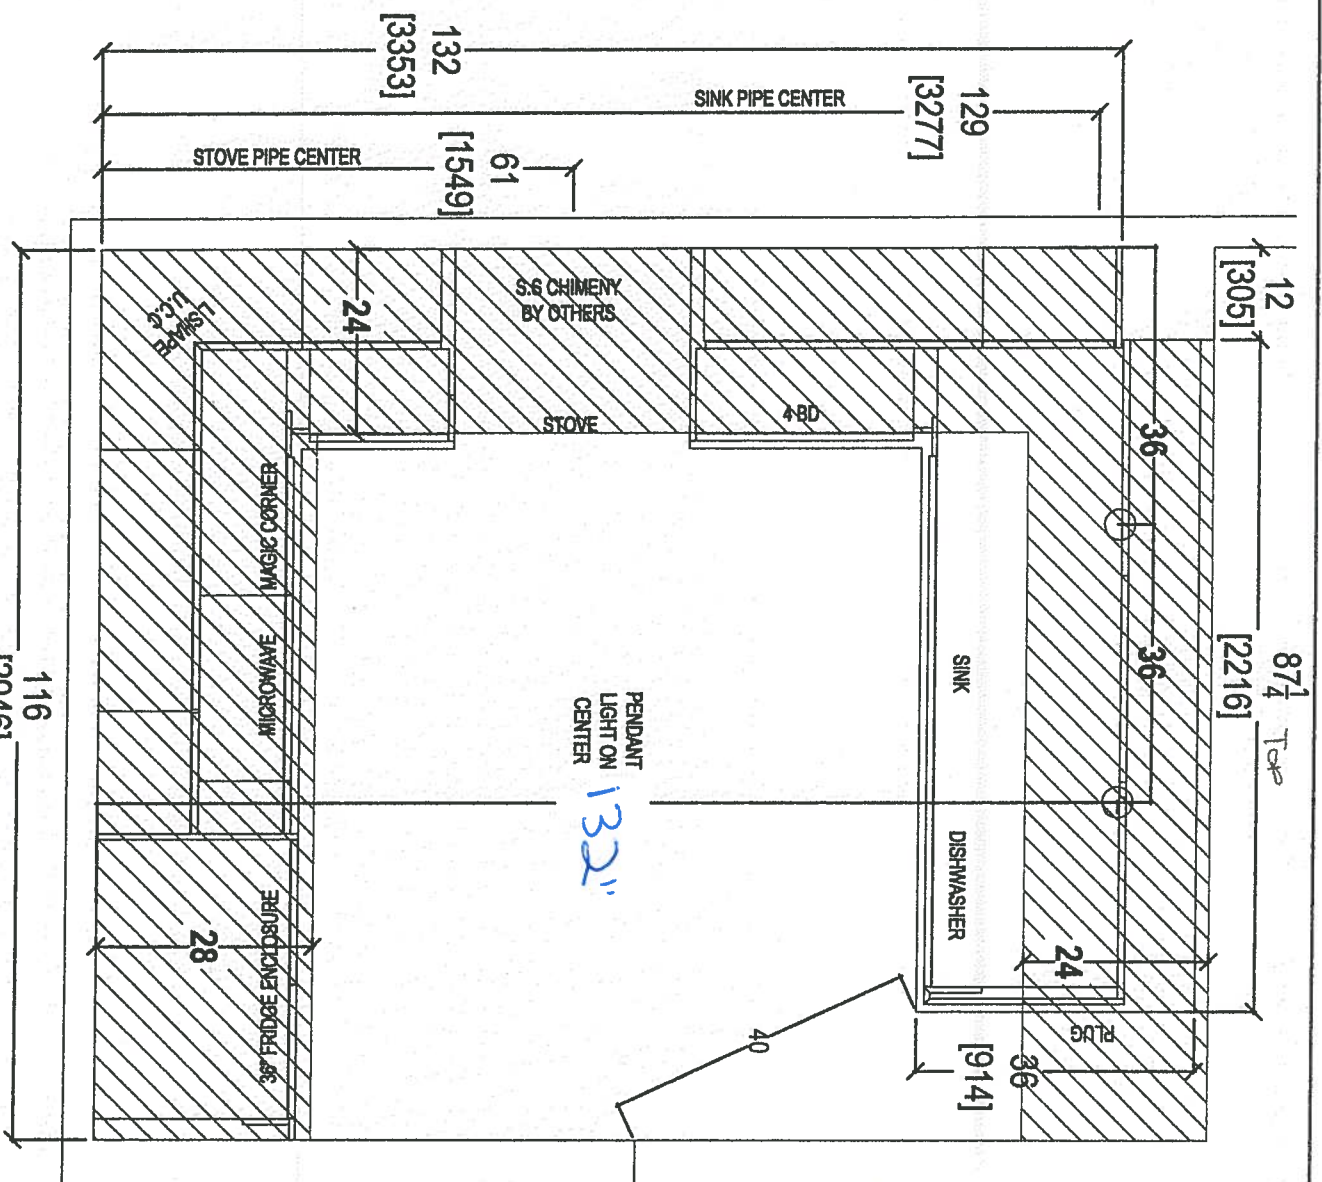


RECEIVED

FEB 06 2019



80 SANTE DRIVE, VAUGHAN, ON L4K 3C4,
T: 416.746.1811 F: 905.761.5801

CLIENT: ROYAL PINE HOMES	JOB NAME: UNIT 606 HMP	ROOM: KITCHEN FLOOR PLAN	DRAWN BY: SK	COMMENTS:
SITE: HAMPTON PLACE	DOOR STYLE: —	DOOR HANDLE: —	SCALE: 1/2" = 1'-0"	PLEASE NOTE ALL DIMENSIONS ARE NOT FINAL AND ARE SUBJECT TO CHANGE UPON FINAL SITE MEASURE
PHONE: —	FINISH: —	DRW HANDLE: —	DATE: FEB 6, 2019	
EMAIL: —	SPECIES: —	TOP: —	PAGE:	

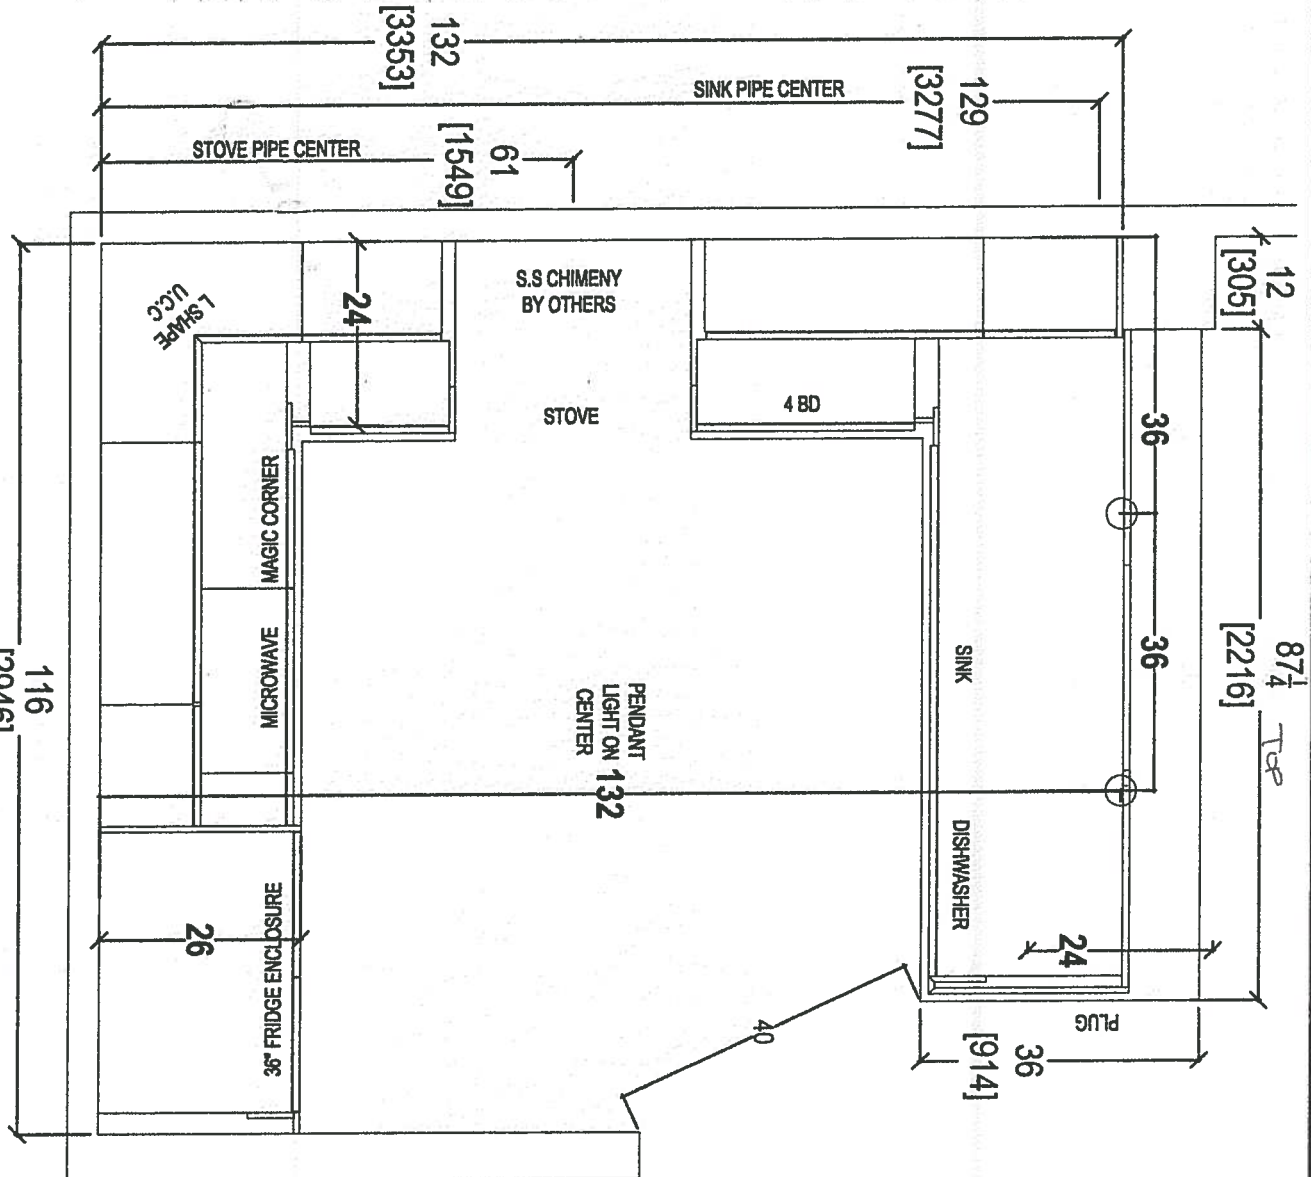


RECEIVED

FEB 06 2019



your kitchen, your taste.
80 SANTE DRIVE, VAUGHAN, ON L4K 3C4,
T: 416.748.1811 F: 905.761.5901

CLIENT: ROYAL PINE HOMES	JOB NAME: UNIT 606 HMP	ROOM: KITCHEN FLOOR PLAN	DRAWN BY: SK	COMMENTS:
SITE: HAMPTON PLACE	DOOR STYLE: —	DOOR HANDLE: —	SCALE: 1/2" = 1'-0"	PLEASE NOTE ALL DIMENSIONS ARE NOT FINAL AND ARE SUBJECT TO CHANGE UPON FINAL SITE MEASURE
PHONE: —	FINISH: —	DRW HANDLE: —	DATE: FEB 6, 2019	
EMAIL: —	SPECIES: —	TOP: —	PAGE:	

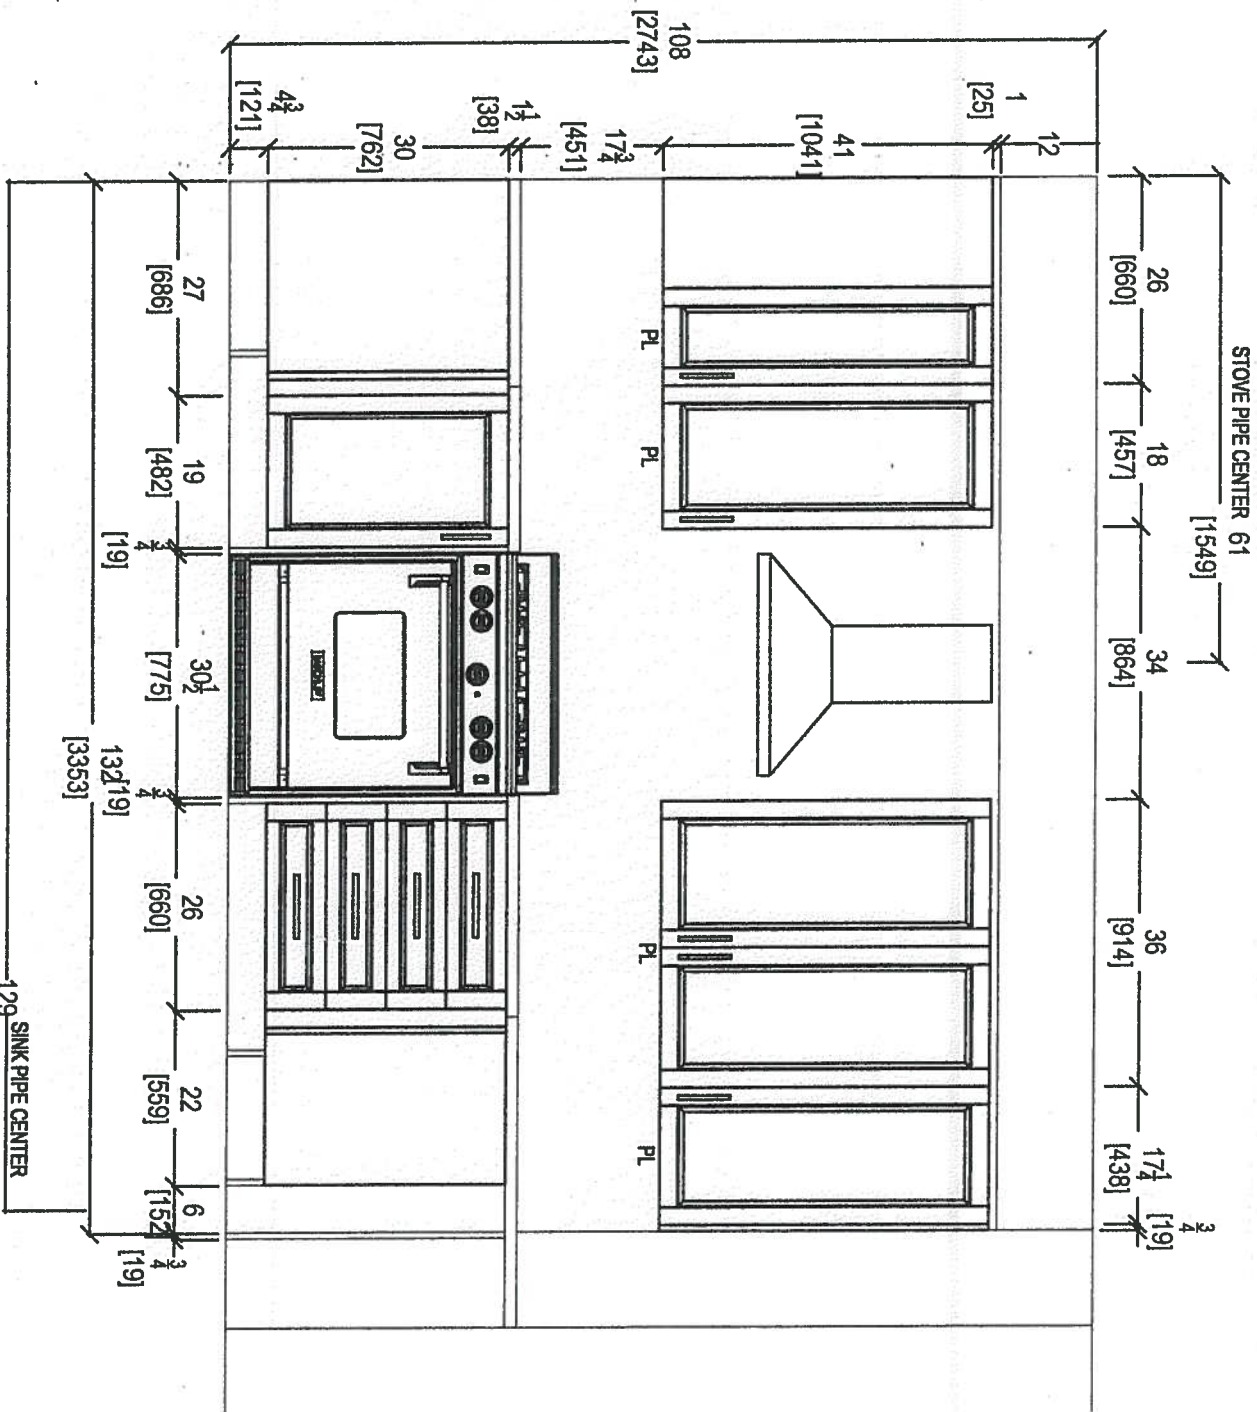


RECEIVED
FEB 06 2013



80 SANTE DRIVE, VAUGHAN, ON L4K 3C4,
T: 416.746.1811 F: 905.761.5801

CLIENT: ROYAL PINE HOMES	JOB NAME: UNIT 808 HMP	ROOM: KITCHEN FLOOR PLAN	DRAWN BY: SK	COMMENTS:
SITE: HAMPTON PLACE	DOOR STYLE: —	DOOR HANDLE: —	SCALE: 1/2" = 1' - 0"	PLEASE NOTE ALL DIMENSIONS ARE NOT FINAL AND ARE SUBJECT TO CHANGE UPON FINAL SITE MEASURE
PHONE: —	FINISH: —	DRW HANDLE: —	DATE: MAY 10, 2018	
EMAIL: —	SPECIES: —	TOP: —	PAGE:	

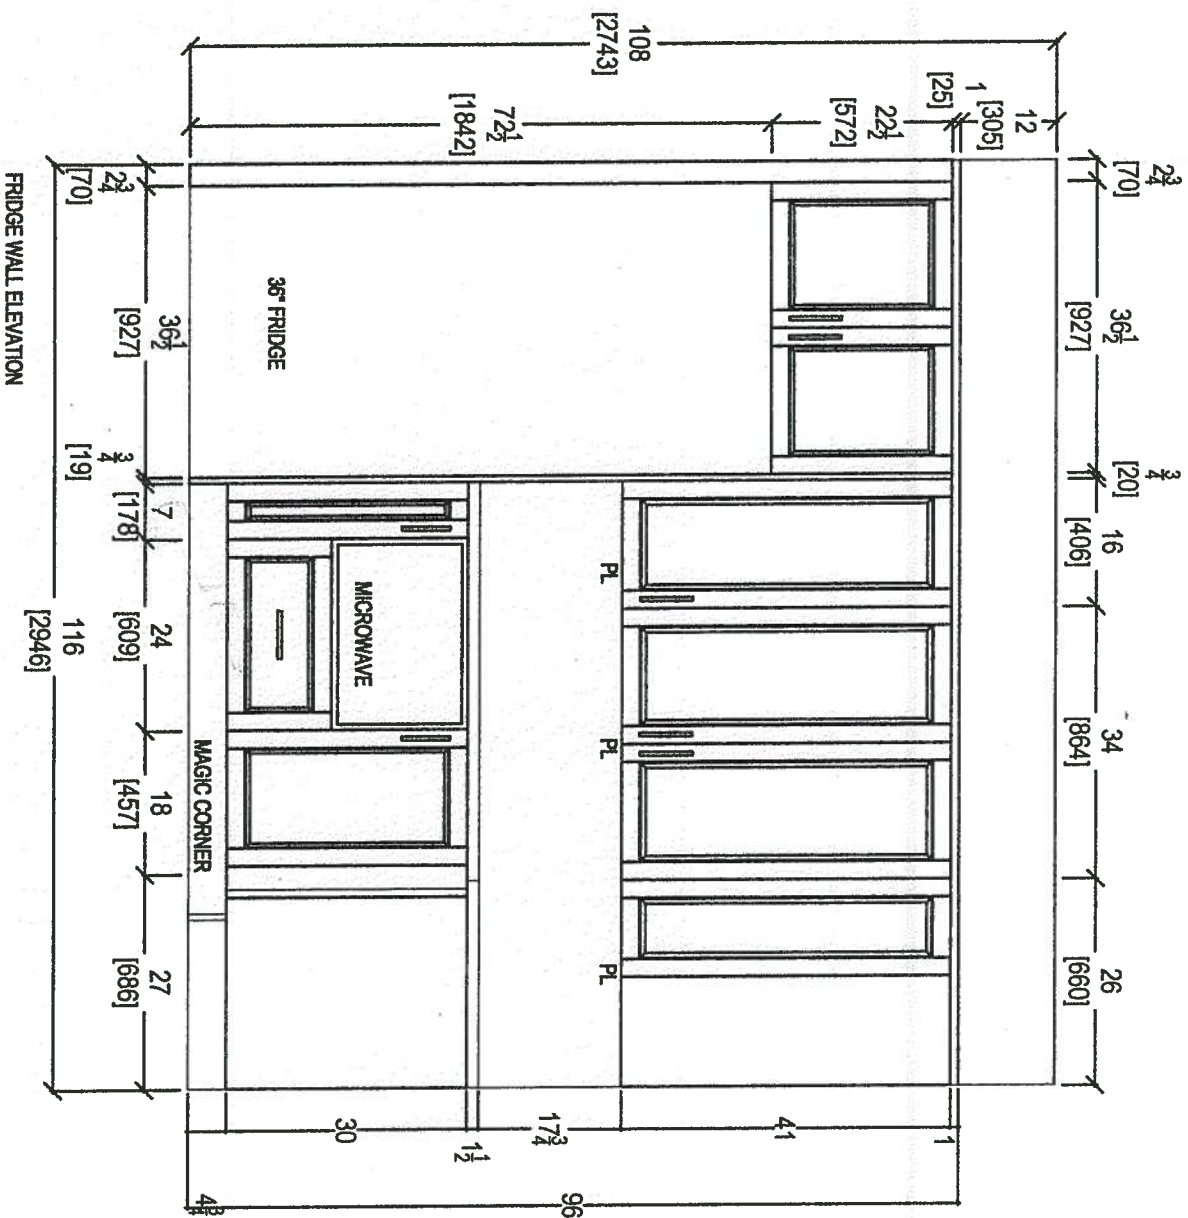



FRIDGE WALL ELEVATION

RECEIVED
FEB 06 2019



your kitchen, your taste.
80 SANTE DRIVE, VAUGHAN, ON L4K 3C4,
T: 416.748.1811 F: 905.761.5901

CLIENT: ROYAL PINE HOMES	JOB NAME: UNIT 608 HMP	ROOM: KITCHEN FLOOR PLAN	DRAWN BY: SK	COMMENTS:
SITE: HAMPTON PLACE	DOOR STYLE: ---	DOOR HANDLE: ---	SCALE: 1/2" = 1'-0"	PLEASE NOTE ALL DIMENSIONS ARE NOT FINAL AND ARE SUBJECT TO CHANGE UPON FINAL SITE MEASURE
PHONE: ---	FINISH: ---	DRAW HANDLE: ---	DATE: MAY 10, 2018	
EMAIL: ---	SPECIES: ---	TOP: ---	PAGE:	

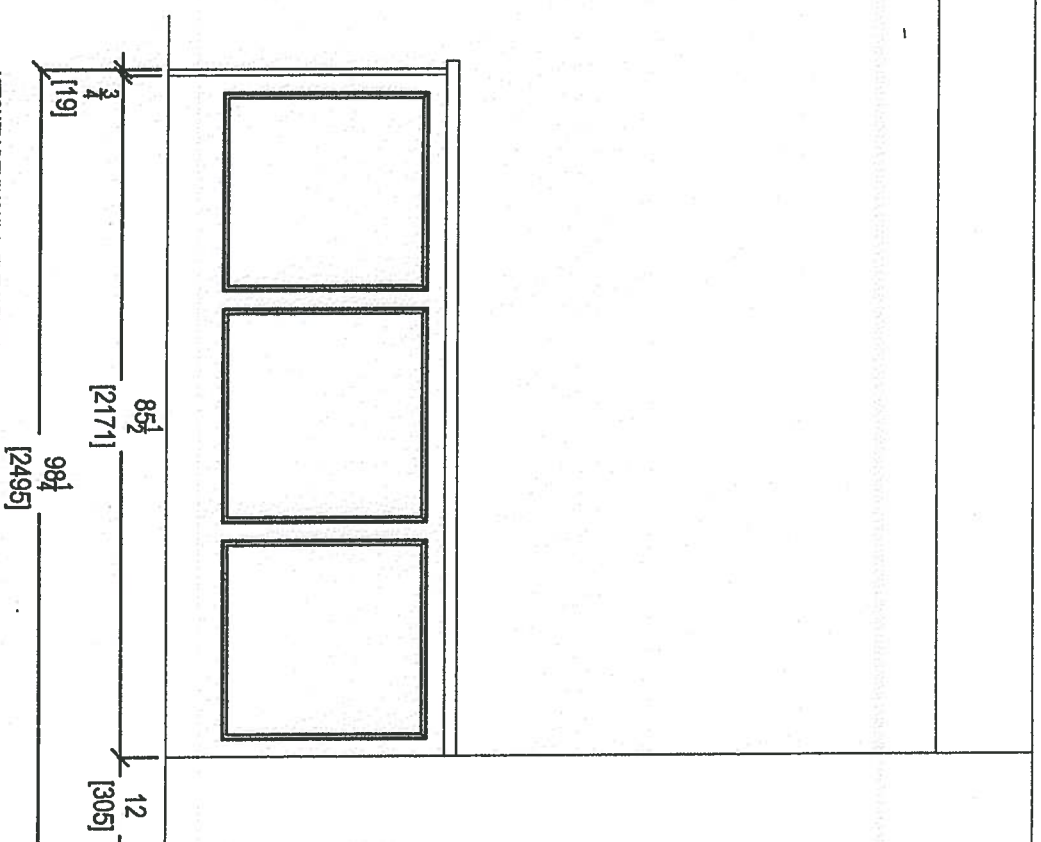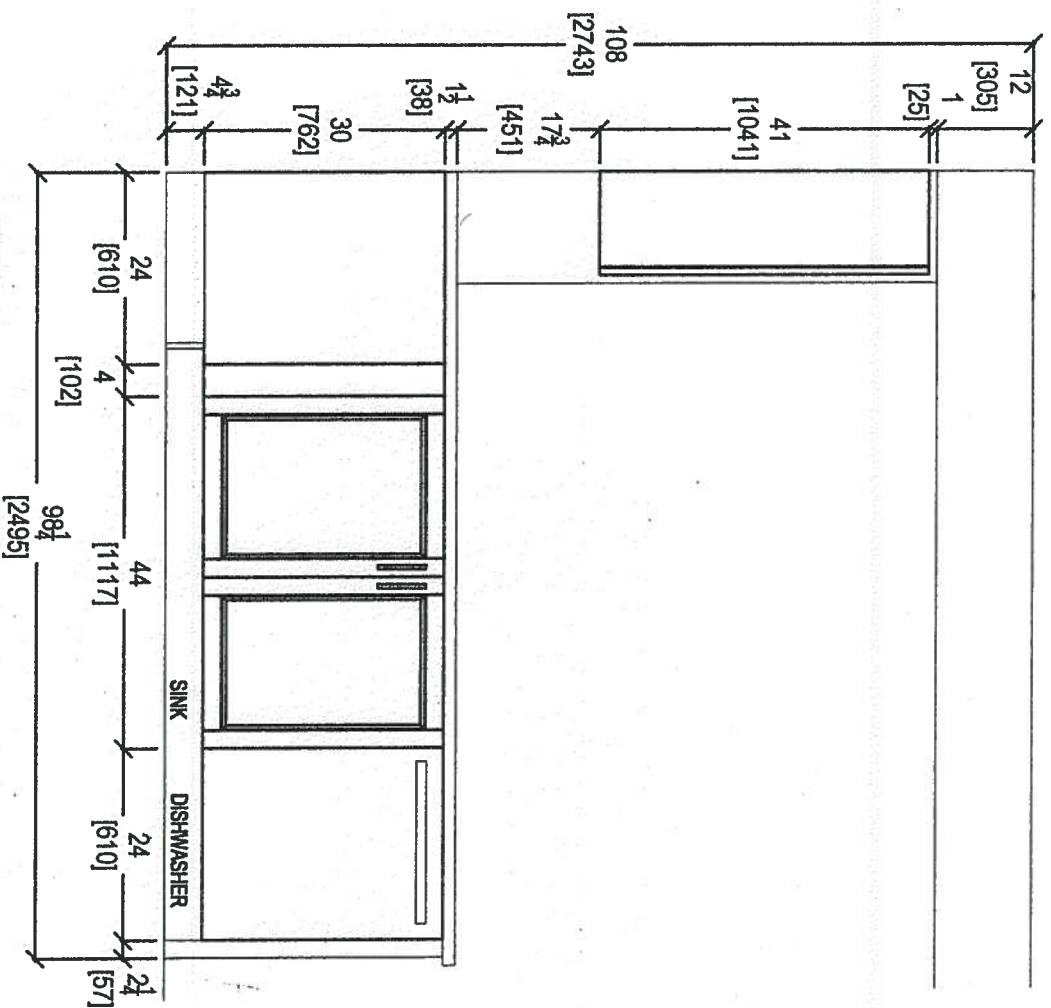





RECEIVED
FEB 16 2010



80 SANTE DRIVE, VAUGHAN, ON L4K 3C4,
T:416.746.1811 F:805.761.5901

CLIENT: ROYAL PINE HOMES	JOB NAME: UNIT 806 HMP	ROOM: KITCHEN FLOOR PLAN	DRAWN BY: SK	COMMENTS: PLEASE NOTE ALL DIMENSIONS ARE NOT FINAL AND ARE SUBJECT TO CHANGE UPON FINAL SITE MEASURE
SITE: HAMPTON PLACE	DOOR STYLE: —	DOOR HANDLE: —	SCALE: 1/2" = 1' - 0"	
PHONE: —	FINISH: —	DRW HANDLE: —	DATE: MAY 10, 2018	
EMAIL: —	SPECIES: —	TOP: —	PAGE:	

606 MAR 28 . R.

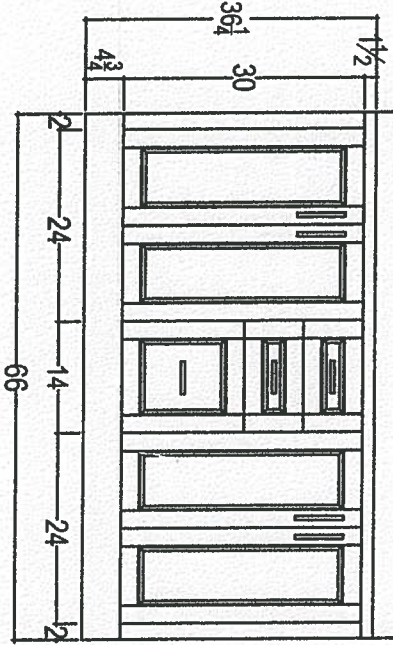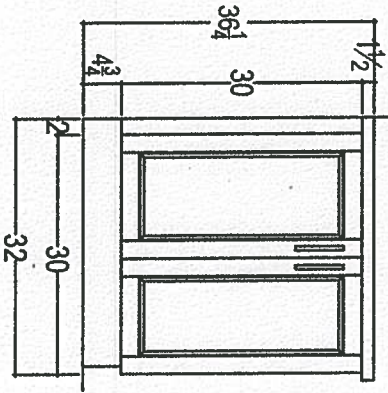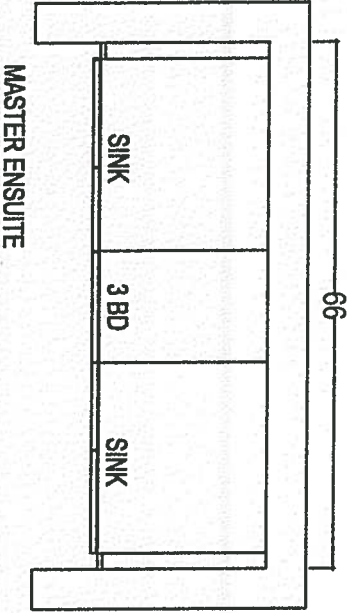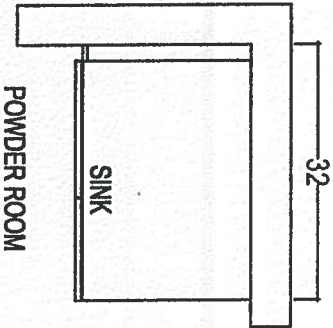

CLIENT: ROYAL PINE HOMES		JOB NAME: UNIT 606 HMP		ROOM: VANITIES		DRAWN BY: SK		COMMENTS:	
SITE: HAMPTON PLACE		DOOR STYLE: —		DOOR HANDLE: —		SCALE: 1/2" = 1'-0"		PLEASE NOTE ALL DIMENSIONS ARE NOT FINAL AND ARE SUBJECT TO CHANGE UPON FINAL SITE MEASURE	
PHONE: —		FINISH: —		DRW HANDLE: —		DATE: REVISED MARCH 28, 2019			
EMAIL: —		SPECIES: —		TOP: —		PAGE:			




your kitchen, your taste.
80 SANTE DRIVE, VAUGHAN, ON L4K 3C4,
T: 416.748.1811 F: 905.761.5801

Hampton

Upgrade
Package 2

KRFC302ESS

22 cu.ft. 36-Inch Width Counter Depth French Door Refrigerator
with Interior Dispense

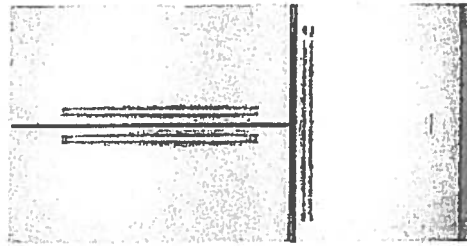

KRFC302ESS

Key Features:

- ExtendFresh™ Temperature Management System
- Interior Water Dispenser
- Professionally-Inspired Design
- Produce Preserver
- Humidity-Controlled Crispers
- FreshChill™ Temperature-Controlled Full-Width Pantry
- Pull-Out Tri-Level Freezer Drawer
- SatinGlide® System
- LED Lighting
- Star-K Certified
- Automatic Ice Maker
- Max Cool

INSIDEADVANTAGE™



<http://www.insideadvantage.com>

Product Dimensions:

Height: 72
Width: 35 3/4
Depth: 30 1/4

Electrical Requirements:

15 Amps.

Available In:

- Stainless Steel
- Black
- White

MADE IN
AMERICA

Because Whirlpool Corporation policy includes a continuous commitment to improve our products, we reserve the right to change materials and specifications without notice. We also reserve the right to discontinue or function products without notice.
© Reg. Registered trademark/™ Trademark of Whirlpool U.S.A. © 2013 Whirlpool Corporation. All Rights Reserved. All other trademarks are owned by their respective companies.
Created On: Wednesday, April 22, 2015 5:51:04

Hampton


WEE745H0FS

Upgrade Package I

Whirlpool®

<http://www.whirlpool.com>

6.4 Cu. Ft. Slide-In Electric Range with True Convection

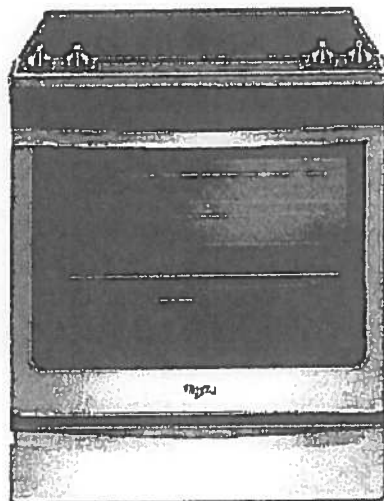

Key Features:

- Frozen Bake™ Technology
- True Convection Cooking
- FlexHeat™ Triple Radiant Element
- Convection Conversion
- AquaLift® Self-Cleaning Technology
- Temperature Sensor
- Rapid Preheat
- 6.4 Cu. Ft. Capacity
- Easy-Wipe Ceramic Glass Cooktop
- Large Oven Window
- Max Capacity Rack
- Hidden Bake Element

Product Dimensions:

Height: 36

Width: 29 7/8

Additional Information:

[Use And Care Guide](#)

[Dimension Guide](#)

[Installation Guide](#)

[Warranty Certificate](#)

INVESTED
IN
AMERICA



©Registered trademark/™ Trademark of Whirlpool, U.S.A. © 2016 Whirlpool Corporation. All Rights Reserved.
All other trademarks are owned by their respective companies.
Because Whirlpool Corporation policy includes a continuous commitment to improve our products, we reserve the right to change materials and specifications without notice. We also reserve the right to discontinue or transition products without notice.
Manufacturer's Suggested Retail Price (MSRP) and Minimum Advertised Price (MAP) provided for reference purposes only. Dealer alone determines advertised and retail prices.
Created On: Friday, January 27, 2017 10:46:47

Hampton Upgrade Package 1

WDTA50SAHZ

Whirlpool®

<http://www.whirlpool.com>

Contemporary Design. Stainless Steel Tub
Dishwasher with TotalCoverage Spray Arm

Key Features:


- Sensor Cycle
- TotalCoverage Spray Arm
- 1-Hour Wash Cycle
- Tap Touch Controls

Product Dimensions:

Height: 34 1/2
Width: 23 7/8
Depth: 24 1/2

Additional Information:

[Use And Care](#)
[Dimension Guide](#)
[Installation Guide](#)
[Energy Guide](#)
[Warranty](#)

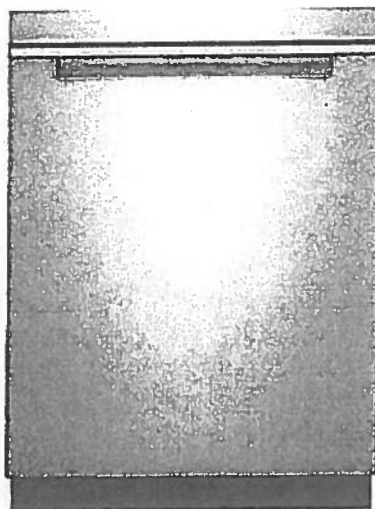

Available in:

● Black

Fingerprint Resistant Sunset Bronze

Fingerprint Resistant Black Stainless

○ White

Fingerprint Resistant Stainless Steel

INVESTED
IN
AMERICA



®Registered trademark/TM Trademark of Whirlpool, U.S.A. © 2016 Whirlpool Corporation. All Rights Reserved. All other trademarks are owned by their respective companies.

Because Whirlpool Corporation policy includes a continuous commitment to improve our products, we reserve the right to change materials and specifications without notice. We also reserve the right to discontinue or transition products without notice.

Manufacturer's Suggested Retail Price (MSRP) and Minimum Advertised Price (MAP) provided for reference purposes only. Dealer alone determines advertised and retail prices.


Hampton Upgrade Package I

WFW75HEFW

5 cu. ft. Front Load Washer with Precision Dispense



<http://www.whirlpool.com>

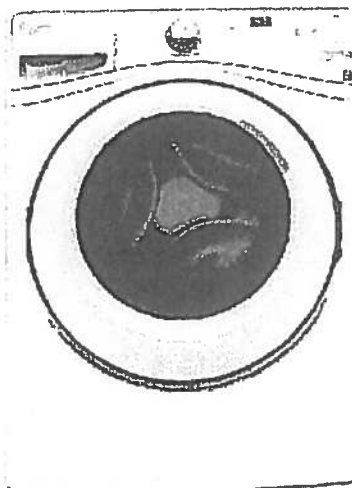

Key Features:

- Precision Dispense
- Adaptive Wash Technology
- Smooth Wave Stainless Steel Wash Basket
- 4.5 cu. ft. Capacity
- ENERGY STAR® Qualified

Product Dimensions:

Height: 39 3/4

Width: 27

Depth: 33 5/16

Electrical Requirements:

15 or 20. 120 V.

Additional Information:

[Use And Care Guide](#)

[Dimension Guide](#)

[Installation Guide](#)

[Energy Guide](#)

[Warranty Certificate](#)

INVESTED
IN
AMERICA



©Registered trademark/TM Trademark of Whirlpool, U.S.A. ©2013 Whirlpool Corporation. All Rights Reserved.
All other trademarks are owned by their respective companies.
Because Whirlpool Corporation policy includes a continuous commitment to improve our products, we reserve the right to change materials and specifications without notice. We also reserve the right to discontinue or transition products without notice.
Manufacturer's Suggested Retail Price (MSRP) and Minimum Advertised Price (MAP) provided for reference purposes only. Dealer alone determines advertised and retail prices.
Created On: Wednesday, March 23, 2016 11:51:03

Hampton Upgrade Package 1

YWED75HEFW

Whirlpool®

<http://www.whirlpool.com>

7.5 cu. ft. Duet® High Efficiency Front Load Electric Dryer with ENERGY STAR®

MSRP: \$0.00

Key Features:

- Advanced Moisture Sensing System
- Quad Baffles
- Tap Touch Controls with Memory
- EcoBoost™ Option
- Wrinkle Shield™ Plus Option
- Undercounter Installation
- 7.4 Cu. Ft. Capacity
- ENERGY STAR® Qualified

Product Dimensions:

Height: 39

Width: 27


Depth: 31

Additional Information:

[Use And Care](#)

[Installation Guide](#)

[Warranty](#)

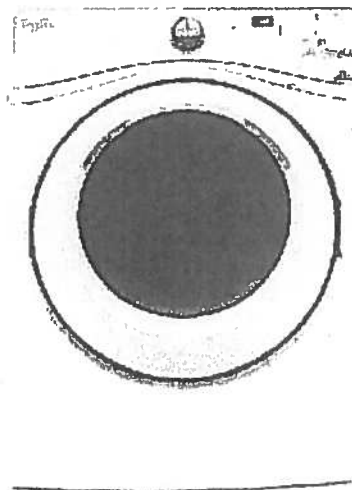

Available in:

☐ White


INVESTED
IN
AMERICA

ADA
Compliant

®Registered trademark/™ Trademark of Whirlpool, U.S.A. © 2016 Whirlpool Corporation. All Rights Reserved. All other trademarks are owned by their respective companies.

Because Whirlpool Corporation policy includes a continuous commitment to improve our products, we reserve the right to change materials and specifications without notice. We also reserve the right to discontinue or transition products without notice.

Manufacturer's Suggested Retail Price (MSRP) and Minimum Advertised Price (MAP) provided for reference purposes only. Dealer alone determines advertised and retail prices.

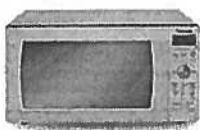

Microwave Ovens Countertop

Countertop NN-SD786S

\$289 + \$275 trim kit




MODEL & SIZE	Model Number	NN-SD786S
	Type	Family-size
	Installation	Counter Top or Built-in
	Oven Capacity	1.6 cu. ft.
	Cooking Power	1,200 Watt
	Turntable Diameter	15"
PANASONIC TECHNOLOGY	Panasonic Inverter®	Cyclonic Inverter®
	Sensor	Prestige® Genius®
DESIGN	Colour	Fingerprint Resistant Stainless Steel
	Control Panel	"Flashing Blue" Ring Dial with Button Panel
	Display Panel	"Blue" 6-Digit Expanded Display
	Cooking Options	Microwave Cooking
STYLE	Door Front	Stainless Steel
	Door Window	Reflective Mirror Finish
	Exterior Wrap	Stainless Steel
	Door Release	Push Button
	Oven Interior	Epoxy
PERFORMANCE	Power Settings	10 levels
	Multi-stage Cooking	3 stages
	Automatic Turntable	Revolving & Removable

		Menu Action Screen	Interactive Multi-Lingual
PROGRAMMABLE FEATURES		Sensor Cook	Sensor 20 Menu Items
		Sensor Reheat	yes
		More / Less Control	yes
		Inverter® Turbo Defrost	yes
		Keep Warm Button	yes
		Popcorn Button	yes
		Quick Minute	yes
		Delay Start	yes
		Delay Timer	yes
SPECIFICATIONS		Power Requirements	120 V 60 Hz; 12.7 A, 1,460 Watt; AC only
		Cavity Dimensions (W x D x H)	418 × 470 × 229 mm 16.4 x 18.5 x 9 inch
		Unit Dimensions (W x D x H)	556 × 506 × 303 mm 21.9 x 19.9 x 12 inch
		Carton Dimensions (W x D x H)	625 × 533 × 375 mm (24-5/8" × 21" × 14-3/4")
		Net Weight	Approx. 14.3 kg (32 lb)
		Gross Weight	17.7 kg (39 lb)
ACCESSORIES	TRIM KITS	27" Model Number	NN-TK722S (stainless)
		30" Model Number	NN-TK732S (stainless)

Copyright ©Panasonic Canada Inc.

MWTK60

24" Stainless Steel Microwave Trim Kit

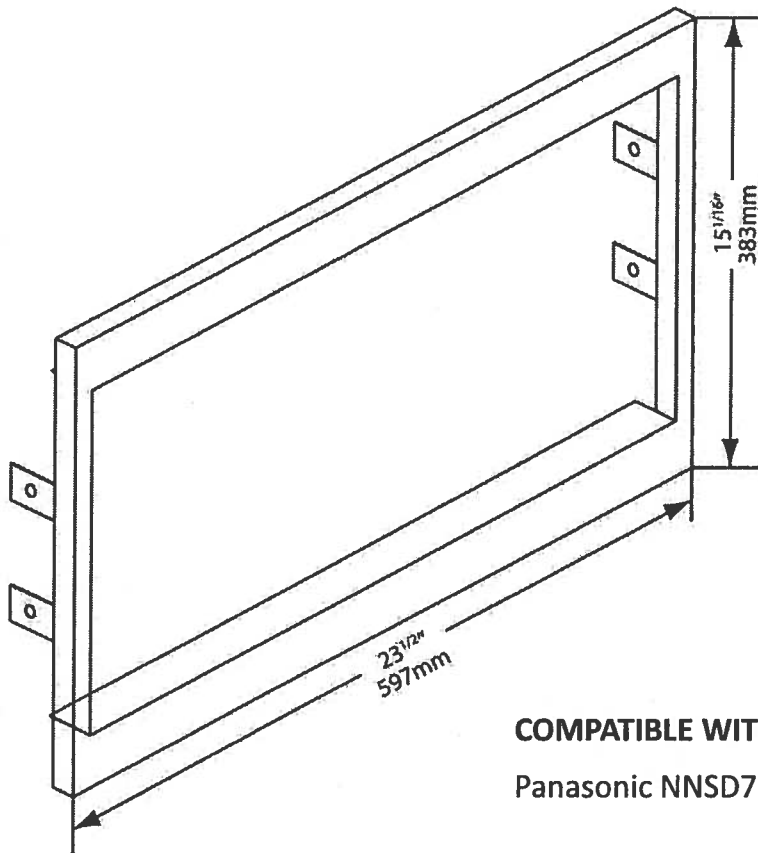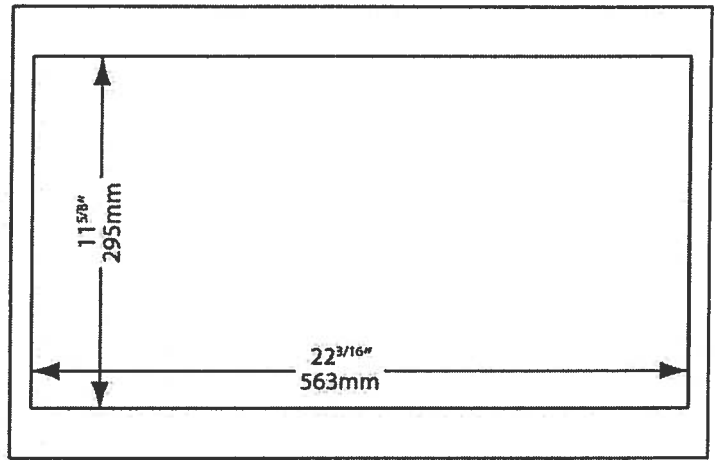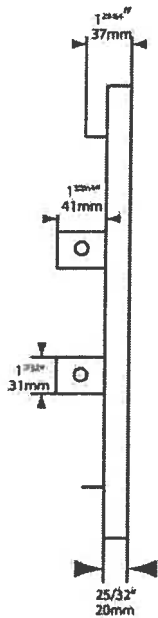

COMPATIBLE WITH:

Panasonic NNSD786, NNSD797 microwaves

Specifications are subject to change without notice
V1.0



Porter & Charles

MWTK60

24" Stainless Steel Microwave Trim Kit

VOID CUT-OUT

1. Unscrew the 4 screws holding the 2 pieces of wood in place, and retain the screws
2. Hold the MWTK-60 in place and position the 2 pieces of wood against the cabinet sides and against the MWTK. Remove the MWTK
3. Screw the 2 pieces of wood onto the base of the cabinet. The wooden strips should touch the inside of the front of the MWTK-60, and be aligned against the side gables.
(wooden stripes 18" = 46cm apart)
4. Being careful not to scratch the microwave door, lift the microwave onto the wooden strips, and move it back about 2 inches.
5. Place the MWTK-60 into position. Use the 4 screws and screw them through the flanges into the side gables.
6. Pull the microwave forward, and align the front of the microwave with the front of the MWTK-60
7. To stop the microwave from sliding backwards whilst opening it, it might be necessary to attach a piece of wood behind the feet of the microwave, on the wooden supports
8. Air must be able to flow from the microwave upwards and into the room, or roof space.
Failure to comply will void the manufacturer's warranty on the micro wave oven.

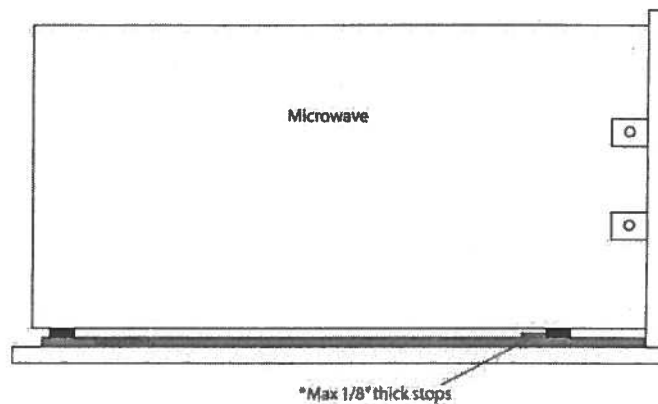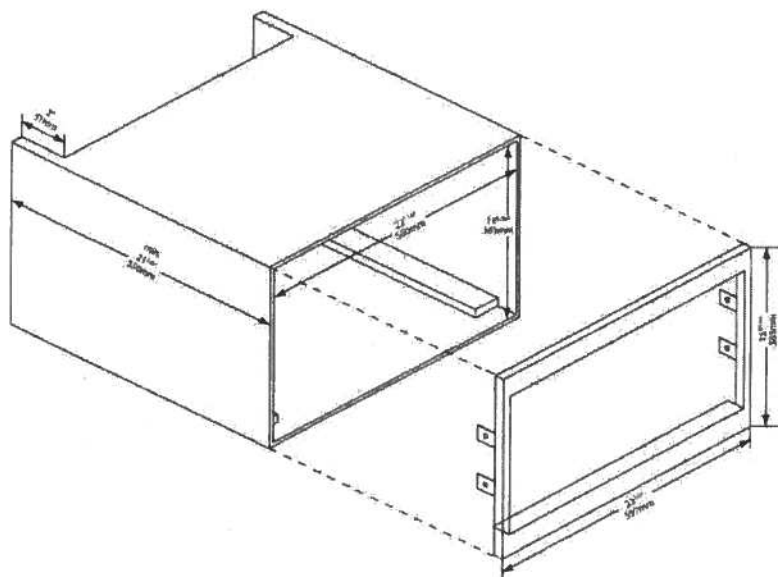



VARIANTS

FPVUL30W3SS / Vulcano Wall 30" (76 cm) 280 CFM
FPVUX36W6SS / VulcanoXL Wall 36" (90cm) 600 CFM
FPVUL24W3SS / Vulcano Wall 24" (60 cm) 280 CFM
FPVUX30W6SS / VulcanoXL Wall 30" (76 cm) 600 CFM

TECHNICAL FEATURES

Installation type
Wall

Dimensions
76 cm / 30 in

Features
Scotch brite stainless steel (AISI 304)
Electronic control
Metallic grease filter, removable and washable
Optional charcoal filter
Labyrinth filter

Finish
Scotch brite stainless steel (AISI 304)

Motor
450 m³/h / 280 cfm

Type of control
Electronic control

Speed settings
Lighting
Led 2x1,2 W - 3200 K

ACCESSOIRES

KACL.510#I
Extension H700 - Wall

KACL.512#I
Extension H960 - Wall

KACL.815
Protective cleaning cloths for stainless steel (box 10 pcs)

103050107
Square charcoal filter - Type 3

CONSUMPTION

Maximum consumption
150 W

Current
120V 60Hz

Frequency

PACKAGING

Gross weight
20 Kg

Net weight
15 Kg

Volumes
0.30 m³

Packaging size
Length: 995 mm
Height: 595 mm
Depth: 510 mm


COOKIE POLICY

We use cookies on "www.falmecnorthamerica.com". If you continue to use "www.falmecnorthamerica.com" you will be agreeing to the website General Terms and Conditions of Use, Privacy Policy and the use of cookies while using the website. To find out more about cookies and how to change your preferences please see our Cookie Policy (http://www.falmecnorthamerica.com/en_us/cookie/).

DOWNLOAD TECHNICAL SHEET

Minimum distance
Electric hob: 52 cm
Gas hob: 60 cm

Download pdf (<https://falmec-catprod1.falmec.com/technical-specifications/515/en-US>)
View all downloads

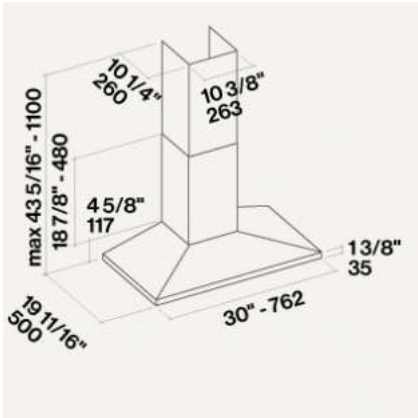

GALLERY



(/artcims/admin/upBoxImages/3238/1492233205.jpg)

DOWNLOADS

Instruction manual
wall
(.pdf - 2.71Mb)
(<https://falmec-catprod1.falmec.com/files/3738.pdf>)