






Noyac Bay

1,121 SQ FT *plus* 76sq. ft. of balcony area

SUITE 407
ORIGINAL LAYOUT
INVENTORY SUITE

(NEW).

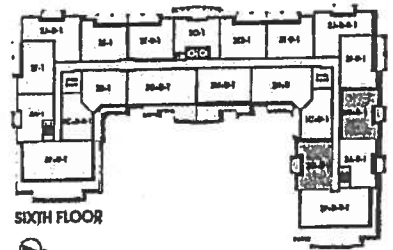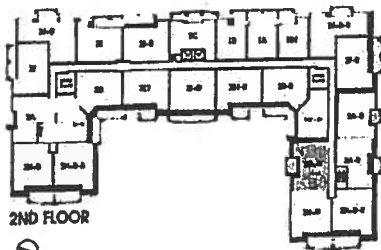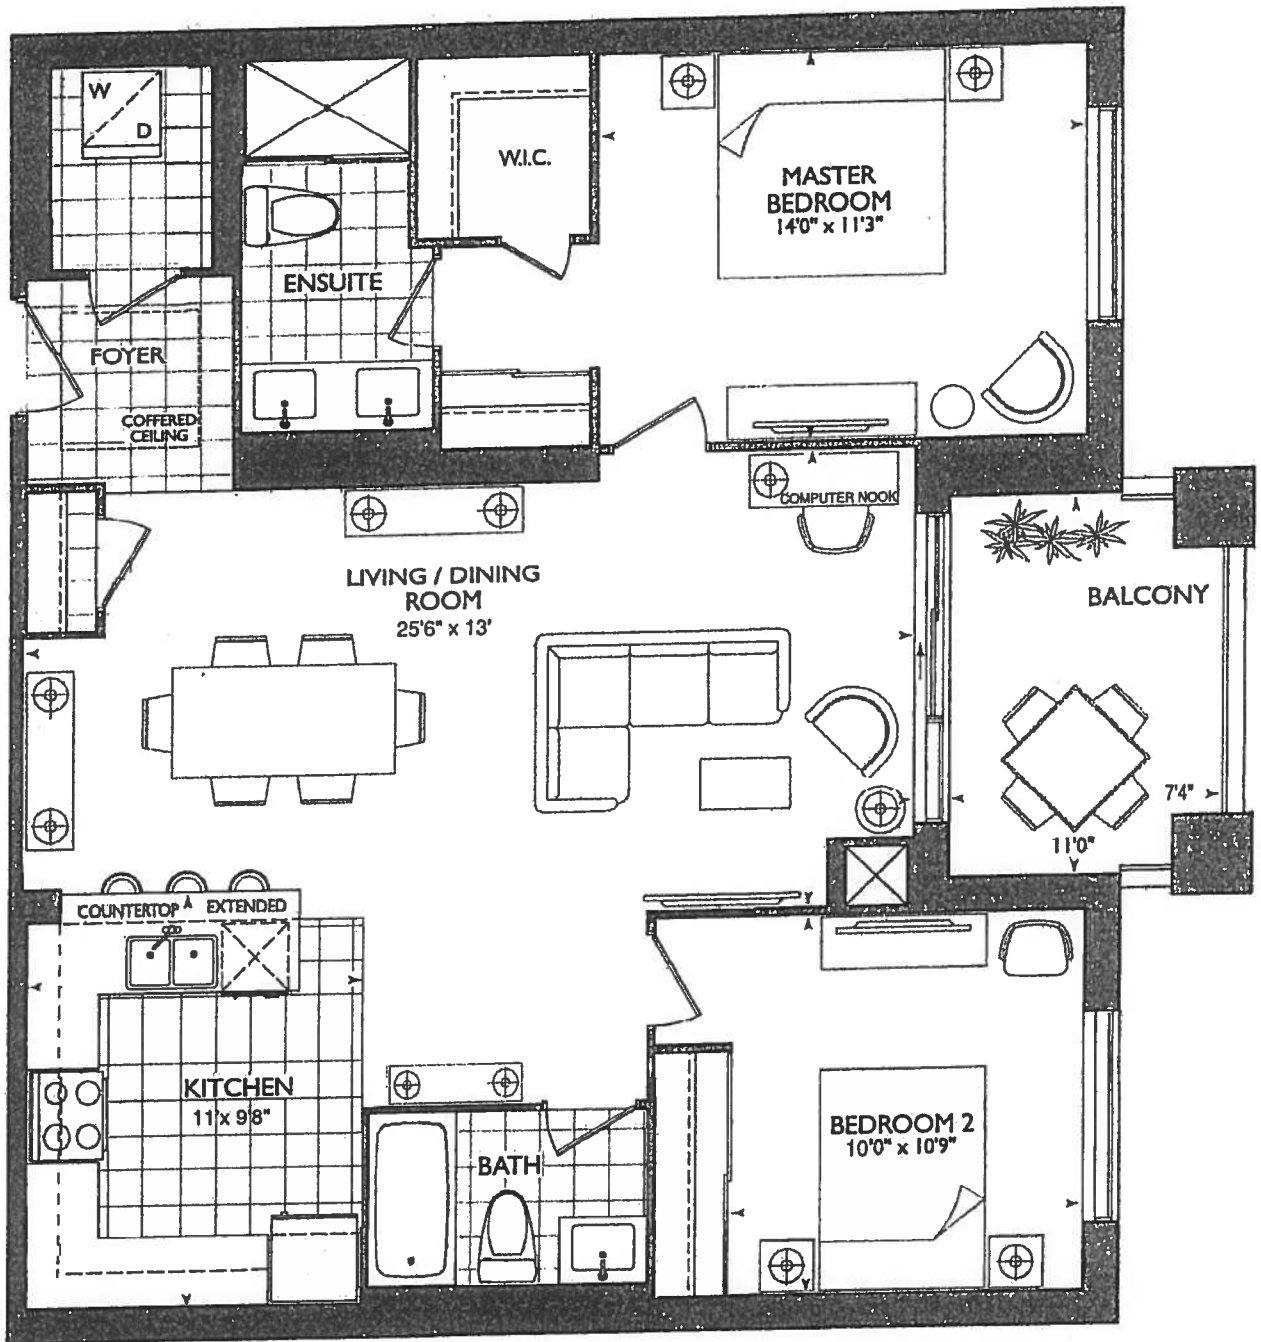

Plans and specifications are subject to change without notice. Actual usable floor space may vary from the stated floor area. All renderings are artist's concept E. & O. E.

*** KITCHEN ***
 • 5 TO KITCHEN LAYOUT
 • 15 TUG APPLIANCE PKG
 W/ OPT 36" FRIDGE
 CHIMNEY HOOD FAN
 MICRO SHELF IN PANTRY

- (X2) CAPPED PENDANT
 - (X1) PLUG PENINSULA
 (X5) PUCK LIGHTS


• 64 1/2" STOVE PRE CENTER
 • 129" SINK PRE CENTER

* Raised Powder Room
 + Ensuite Vanity
 36 1/4" W 3" SPLASH

Suite 407

NEW PLAN
 - REMOVED DEN
 - REVISED KITCHEN
 * REVISED LAUNDRY DOOR SWING & ENSUITE WALL AS PER THIS BROCHURE

• OPT UPG KITCHEN
 see KITCHEN LAYOUT

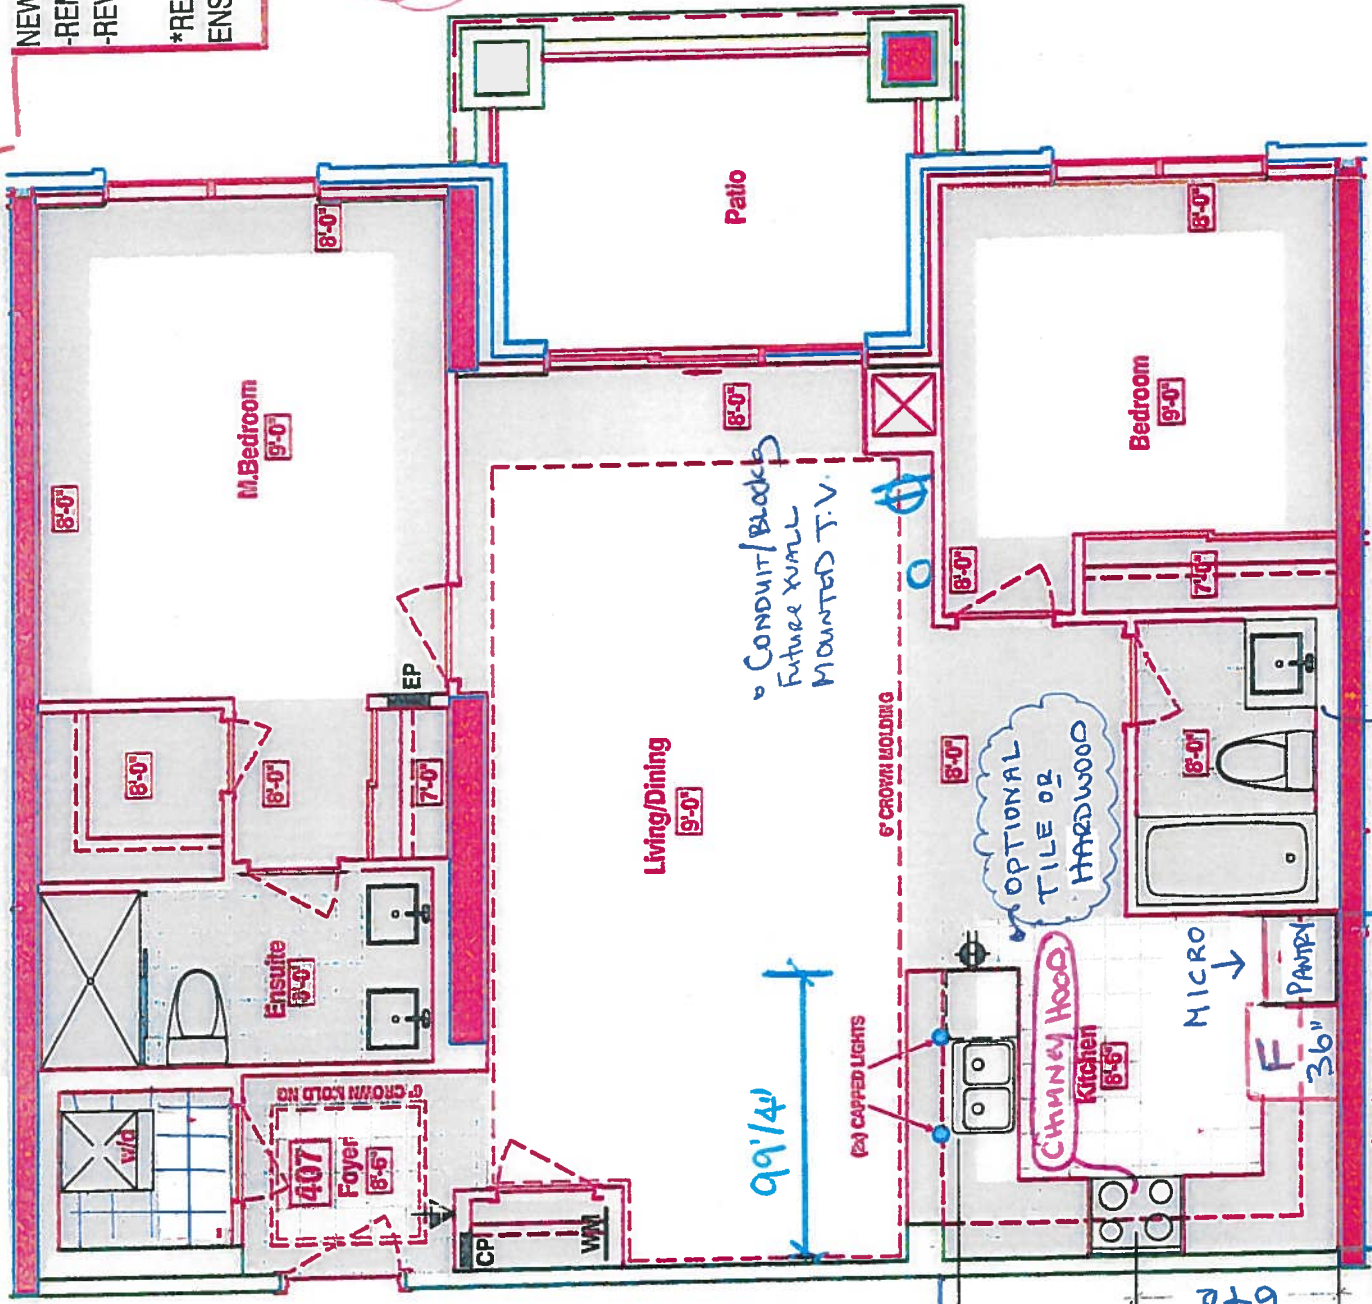

LEGEND:

	SECURITY PANEL
	ELECTRICAL PANEL
	COMMUNICATION PANEL
	WATER METER
	FRIDGE
	DROPPED AREA
	6" CROWN MOLDING

* LIVING Room
 CONDUIT/BLACK/BLUOKING
 WALL MOUNTED
 T.V.

SUITES 407 - NOYAC BAY (Inventory suite)
 Royal Fine Homes • 25 Baker Hill Blvd - Stouffville, ON • Apr 04, 2018

MAIN WASHROOM



Vince's
SITE COPY

CONSTRUCTION SUMMARY

Braylea Investments Inc.

PURCHASER: INVENTORY SUITE_407_PH_1

TEL:

LOT NUMBER	PHASE	HOUSE TYPE	CLOSING DATE
407	1	NOYAC BAY	07-Nov-19

Date Added: 06-May-19

Invoice Number: 7239

80 - FOYER- Install an upgraded floor tile 24x24 CALACATTA POLISH, in lieu of the builders standard 20x20 floor tile to be installed in the Foyer, where applicable
Note:

40 - LAUNDRY ROOM- Install an upgraded floor tile 24x24 CALACATTA POLISH, in lieu of the builders standard 8x8 floor tile ,To be installed in the Laundry Room floor, where applicable
Note:

50 - MASTER ENSUITE- Install an upgraded floor tile , 24x24 LONDON GREY, In lieu of the builders standard 13x13 floor tile, To be installed throughout the Master Ensuite floor, where applicable
Note:

95 - MASTER ENSUITE- Install an upgraded wall tile , 12x24 LONDON GREY, In lieu of the builders standard 8x10 wall tile, To be installed throughout the Master Ensuite shower stall walls, where applicable. Install Straight/Stacked/Horizontal
Note:

30 - MAIN BATHROOM- Install an upgraded floor tile , 24x24 LONDON GREY, In lieu of the builders standard 13x13 floor tile, To be installed throughout the Main Bath floor, where applicable
Note:

75 - MAIN BATHROOM- Install an upgraded wall tile , 12x24 LONDON GREY, In lieu of the builders standard 8x10 wall tile, To be installed throughout the Main Bathroom Tub Shower walls, where applicable. Install Straight/Stacked/Horizontal
Note:

1 - KITCHEN & BATHROOM- SEE QUALITY TOPS & KITCHENS FOR ALL KITCHEN & BATHROOMS UPGRADES/LAYOUTS (See attached Upgrade Package)
Note: **PLEASE NOTE** THAT THE PURCHASER WILL HAVE AN OPTION FOR THE ABOVE UPGRADE PACKAGE

1 - CLARIFICATION:
MASTER ENSUITE & MAIN BATH-Install RAISED VANITY HEIGHT at Main Bath and Master Ensuite Vanities, where applicable (See attached QTK Upgrade paperwork and Layouts)
Note: **PLEASE NOTE** THAT THE PURCHASER WILL HAVE AN OPTION FOR THE ABOVE UPGRADE PACKAGE

1 - CLARIFICATION-
Do not install or supply or credit the purchaser with the builders standard bathroom accessories, throughout ALL bathrooms. Includes: Toilet paper holder, soap dishes and towel racks
Note:

1 - KITCHEN - Install ONE (X1) ADDITIONAL PUCK LIGHTS (Same Switch as Standard Puck Lights) at kitchen. To be installed below kitchen cabinetry, where applicable. (See Attached QTK Layout for Locations)
Note: Purchaser Paying Difference for Additional Puck Lights - Standard Kitchen to Receive FOUR (X4) Puck Lights - Upgrade Kitchen Requires FIVE (X5) Puck Lights

PLEASE NOTE THIS UPGRADE WILL APPLY IF THE PURCHASER WILL UPGRADE TO THE OPTION FOR THE KITCHEN UPGRADE PACKAGE

1 - KITCHEN & BATHROOM COUNTER TOP-
PLEASE NOTE Purchaser to have the option to choose their selection at time of colour chart
Note:

Date Added: 06-May-19

Invoice Number: 7219

1 - TWO (2) CAPPED CEILING LIGHTS ABOVE THE KITCHEN SINK ON THE SAME SWITCH, AS PER PLAN
Note:

1 - 1ST UPGRADE APPLIANCE PACKAGE WITH 36" FRIDGE AS PER VENDOR SAMPLES
Note:



SITE COPY

CONSTRUCTION SUMMARY

Braylea Investments Inc.

PURCHASER: INVENTORY SUITE_407_PH_1

TEL:

LOT NUMBER	PHASE	HOUSE TYPE	CLOSING DATE	
407	1	NOYAC BAY	07-Nov-19	

Date Added: 06-May-19

Invoice Number: 7219

1 - WATER LINE FOR FRIDGE

Note:

1 - STAINLESS STEEL CHIMNEY HOOD FAN AND MICROWAVE SHELF WITH TRIM KIT IN LIEU OF STANDARD COMBINATION MICROWAVE/HOOD FAN (INCLUDES ELECTRICAL) AS PER VENDORS SPECIFICATIONS AND SAMPLES

Note:

1 - INSTALL CONDUIT AND BLOCKING FOR WALL MOUNTED TV (60 INCHES ABOVE FF) IN LIVING ROOM, AS PER PLAN

Note:

1 - SUPPLY AND INSTALL THE PANASONIC MICROWAVE, MODEL # ST765S & THE TRIM KIT MODEL # NNTK714SS

Note:

This Document is Extremely Time Sensitive - Printed 6 May 19 at 13:38



Purchaser	Decor Consultant	Model Type	Telephone Res. / Bus	Project	Closing Date	Unit
INVENTORY SUITE_407_PH_1	Laura Di Pede	NOYAC BAY	/	Braylea Investments Inc.	07/11/2019	407

	Flooring	Wall Tile	Notes
	<u>Description</u>	<u>Main</u> <u>Accent/Insert</u> <u>Pattern</u>	
MASTER ENSUITE	LONDON GREY 24X24 (UPGD)	N/A	
MAIN BATHROOM	LONDON GREY 24X24 (UPGD)	N/A	
POWDER ROOM	N/A		
KITCHEN / DINETTE	Forest Collection Northern Cordillera EE-F-9687-P	** TBD**	
FOYER	24X24 CALACATTA POLISH (UPGD)	N/A	
LAUNDRY	24X24 CALACATTA POLISH (UPGD)		
LIVING ROOM	Forest Collection Northern Cordillera EE-F-9687-P		
DINING ROOM	Forest Collection Northern Cordillera EE-F-9687-P		
DEN	N/A		
MASTER BEDROOM	Forest Collection Northern Cordillera EE-F-9687-P		
BEDROOM 2	Forest Collection Northern Cordillera EE-F-9687-P		
BEDROOM 3	N/A		
Basement Landing	N/A		

Consultant: _____ Purchaser: _____

Laura Di Pede INVENTORY SUITE_407_PH_1

Vendor: _____

Braylea Investments Inc.

Printed Jul 29, 2019 12:00 pm



Purchaser	Decor Consultant	Model Type	Telephone Res. / Bus	Project	Closing Date	Unit
INVENTORY SUITE_407_PH_1	Laura Di Pede	NOYAC BAY	/	Braylea Investments Inc.	07/11/2019	407

* INTERIOR COLOUR SCHEME * **KEVINSED** **July 29/19** *

CABINETRY, VANITIES AND COUNTERTOPS

	Style	Countertop	Counter Edge	Handle / Knob	APPLIANCE PACKAGE
MAIN BATHROOM	CATEGORY 3 FIBERBOARD QT 4401 STORMY MONDAY	* FROSTY CARINA (Upgd)Ceasastone	EDGE "I" (UPGD)	* RC924SN	
MASTER ENSUITE	* CATEGORY 3 FIBERBOARD QT 4401 STORMY MONDAY	* FROSTY CARINA (Upgd)Ceasastone	EDGE "I" (UPGD)	* RC924SN	
POWDER ROOM	N/A	N/A	N/A	N/A	
KITCHEN / DINETTE	* CATEGORY 3 FIBERBOARD QT 4801 CLASSIC GREY	* ASPEN TERRA WHITE (STD)	EDGE "I" (UPGD)	* RC917CH	Sid 31in Opening
LAUNDRY ROOM	N/A	N/A	N/A	N/A	

PLUMBING FIXTURES

KITCHEN	
Sink Model	** TBD**
Sink Faucet	** TBD**
TOILETS	
Master Ensuite	STANDARD
Main Bathroom	STANDARD
Powder Room	N/A
VANITY FAUCETS	
Master Ensuite	** TBD**
Main Bathroom	** TBD**
Powder Room	N/A
VANITY SINKS	
Master Ensuite	** TBD**
Main Bathroom	** TBD**
Powder Room	N/A
SHOWER STALL / TUBS	
Master Ensuite Shower Stall	STANDARD
Master Ensuite Tub	N/A
Main Bathroom Tub	STANDARD

Trim	
Baseboard & Casing	STANDARD
Interior Doors	STANDARD
Cornice Moulding / Medaion	
Foyer	STANDARD #CTR-611
Living Room	STANDARD #CTR-611
Dining Room	STANDARD #CTR-611
Den	N/A
Master Bedroom	N/A
Bedroom 2	N/A
Bedroom 3	N/A

Levers	STANDARD
Door Height	STANDARD
Fireplace	N/A
Location Flooring	N/A
Style	N/A
Finish	N/A
Marble	N/A
Hearth	N/A

Paint Throughout	
Walls	** TBD** SITE TO DETERMINE
Trim	STANDARD

Decor Consultant: _____ Purchaser: _____

I aaura Di Pede

INVENTORY SUITE_407_PH_1

Vendor: _____

Braylea Investments Inc

Printed Jul 29, 2019 12:00 pm

* INTERIOR COLOUR SCHEME *					
	Purchaser	Decor Consultant	Model Type	Telephone Res. / Bus	Project
	INVENTORY SUITE_407_PH_1	Laura Di Pedo	NOYAC BAY	/	Braylea Investments Inc.
					Closing Date
					07/11/2019
					Unit
					407

Purchaser(s) acknowledge the following

Counter Top Waiver:

The Purchaser acknowledges that natural stone products such as granite, marble and quartz that are installed in their dwelling may vary in shading, pattern, texture, veining, pores, colour and fissures from the sample in the Vendor's Décor Centre despite both having the same name. Marble is not recommended in high traffic areas, such as kitchens, as marble is more porous than granite and will stain and scratch easier than a granite surface. The Purchaser acknowledges that some natural stone surfaces are not flat and will vary in texture and depth. This material once installed will not be 100% flat up against the walls.

Hardwood Floor/Stair Waiver

Purchaser acknowledges and accepts that the hardwood flooring is pre-finished in a factory in a controlled environment and that the stairs are finished on site. The vendor will do their best to match the color between the stairs and the floor, but it is not possible to have an identical match and that there will be shade differences.

Standard Appliance Specifications Waiver:

In lieu of supplying appliance specifications and/or special requirements, the purchaser acknowledges that cabinetry will be made to allow for standard openings only. Standard opening sizes are as follows:

- Fridge: 29 3/4" wide x 65 7/8" high x 33 1/2 Deep
- Stove: 29 7/8" wide
- Dishwasher: 23 7/8" wide
- Microwave Fan: 30" wide x 17 1/4" high x 18 Deep
- Washer/Dryer (Stacked): 27 1/2" wide x 71 3/4" high x 32 Deep
- Exhaust Opening: 6"

and only those appliances that fit the standard openings should be selected and purchased.

Hardwood Floor Waiver:

Hardwood floors installed by the Vendor will be fully warranted for one full year against any defects in workmanship, due to improper installation. The purchaser acknowledges and understands that the vendor will not be responsible to repair the natural drying out of wood that may cause shrinkage.

Changes:

This Colour Sheet is FINAL. ANY changes requested are subject to Builder approval and a minimum administration fee of \$500.00 will be charged.

Decor Consultant: _____ Purchaser: _____
Laura Di Pedo INVENTORY SUITE_407_PH_1

Vendor: _____
Braylea Investments Inc.


Countertop Edges

CONNOLLY Marble & Granite Ltd.

EDGE
DETAILS

004


A.

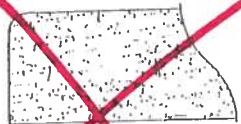

STRAIGHT EDGE
(STANDARD - 3/4")

Suite 407


I.

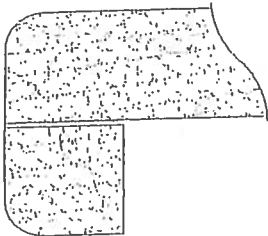

DOUBLE TOP "D" EDGE
(STANDARD - 1 1/2")


* Kitchen
* Main Bath
* Master Ensuite

M.

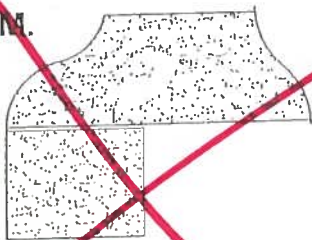

SQUARE EDGE
(MED./HIGH - 1 1/2")

EDGING UP-GRADE OPTIONS

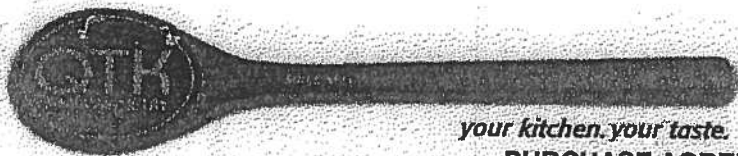

your kitchen. your taste.

PURCHASE AGREEMENT FORM

PURCHASER:		CONTRACTOR:	Braylea Investments Inc.
ADDRESS:		SITE:	HAMPTON PLACE
EMAIL:		MODEL TYPE:	NOYAC BAY (2G+D)
PHONE #:		LOT #:	407 HMP
PHONE #:		DATE:	Apr 29, 2019 Q5179

The purchaser agrees to buy and Quality Tops & Kitchens Ltd. (QTK) agrees to sell and provide for the purchaser the following articles listed herein and with attached drawing in accordance to the terms and conditions described on the reverse of this agreement form.

ROOM	DESCRIPTION	CATEGORY
KITCHEN	DOOR STYLE: FINISH: SPECIES: DOOR HARDWARE: DRW HARDWARE: COUNTER TOP: } T.B.D Counter Top by Others	OPTIONAL UPGRADES

ITEM #	QTY	DESCRIPTION	PRICE
VB	1	VALANCE BOX UPPERS & PUCK LIGHT CUTOUTS (ELEC. & LIGHTS NOT INCL.) - (OPTION PAID FOR BY BUILDER)	
FG2696	1	FRIDGE GABLE - 26" DEEP x 95-1/2"H - (OPTION PAID FOR BY BUILDER)	
FC2623	1	FRIDGE CABINET - 26" DEEP x 23"H - (OPTION PAID FOR BY BUILDER)	
BLCC	1	BASE L-SHAPE CORNER CABINET w/ 1 ADJ. SHELF	
BCR-MC1	1	MAGIC CORNER 1 PULL-OUT UNIT w/ 4 S.S. ANTI-SLIP BASKETS	
ULCC-14	1	UPPER L-SHAPE CORNER CABINET 26" x 26" - 13-3/4" DEEP	
UC-14WK	1	INCREASE DEPTH OF UPPER CABINET TO 13-3/4" DEEP (WHOLE KITCHEN) - 113 WHITE LP INTERIOR	
CUST-1	1	BLUM MOTION ANTI SLAM HINGES & 1 SET OF BLUM WHITE ANTARO DRAWER SLIDES	
CUST-2	1	PULL OUT SPICE UNIT w/ 2 FIXED BASKETS INCL. BLUM WHITE ANTARO ANTI SLAM SLIDES - 15" & 8" HIGH CLEARANCE	
CUST-3	1	TALL CABINET w/ 1 OPENING FOR MICROWAVE & 2 DRAWERS BELOW (SPECS REQUIRED)	
ROOM SUMMARY:			

ROOM	DESCRIPTION	CATEGORY
POWDER ROOM VANITY	DOOR STYLE: FINISH: SPECIES: DOOR HARDWARE: DRW HARDWARE: COUNTER TOP: Counter Top by Others	

ITEM #	QTY	DESCRIPTION	PRICE
VB-RAISE8	1	RAISE VANITY HEIGHT TO 34-1/2" - PER VANITY (>61" LONG)	
CUST-1	1	BLUM MOTION ANTI SLAM HINGES	
ROOM SUMMARY:			

ROOM	DESCRIPTION	CATEGORY
ENSUITE VANITY	DOOR STYLE: FINISH: SPECIES: DOOR HARDWARE: DRW HARDWARE: COUNTER TOP: Counter Top by Others	

ITEM #	QTY	DESCRIPTION	PRICE
VB-RAISE8	1	RAISE VANITY HEIGHT TO 34-1/2" - PER VANITY (>61" LONG)	
CUST-1	1	BLUM MOTION ANTI SLAM HINGES & 1 SET OF BLUM MOTION WHITE ANTARO DRAWER SLIDES	
ROOM SUMMARY:			



your kitchen. your taste.

PURCHASE AGREEMENT FORM

Quality Tops & Kitchens Ltd.

80 Sante Drive, Vaughan, ON L4K 3C4

T 416.746.1811

F 905.761.5901

www.QTK.ca

info@qtk.ca

PURCHASER:		CONTRACTOR:	Braylea Investments Inc.	
ADDRESS:		SITE:	HAMPTON PLACE	
EMAIL:		MODEL TYPE:	NOYAC BAY (2G+D)	
PHONE #:		LOT #:	407 HMP	
PHONE #:		DATE:	Apr 29, 2019	Q5179



EXPECTED DELIVERY DATE

TBD

SUB-TOTAL:

[REDACTED]

Customers please note all garbage bins, spice baskets, magic corner baskets and other accessories will only be delivered AFTER you move in the house. Please call us to request delivery of these items after you move in. Thank you. ALL CHANGES FINAL UPON SIGNING

TOTAL:

[REDACTED]

PLEASE READ ALL THE TERMS AND CONDITIONS ON THE ACCOMPANYING QTK TERMS & CONDITIONS DOCUMENT. BY SIGNING BELOW YOU AGREE TO RECEIVE THE ITEMS LISTED HEREIN AND PAY (ACCORDING TO QTK'S PAYMENT POLICY), AND HAVE READ AND UNDERSTOOD THE TERMS & CONDITIONS AS OUTLINED IN THE QTK TERMS & CONDITIONS DOCUMENT.

HST

[REDACTED]

GRAND TOTAL:

[REDACTED]

DEPOSIT 1 DATE:

DEPOSIT 1:

DEPOSIT 2 DATE:

DEPOSIT 2:

AMOUNT TO BE PAID IN FULL BY DUE DATE:

CUSTOMER INITIAL(S):

CUSTOMER SIGNATURE:

DATE:

CUSTOMER SIGNATURE:


DATE:

S REP NAME: Sheliza Khan Designs


QTK AUTHORIZED SIGNATURE:

APRIL 30 2019

- OPTIONAL UPGRADE KITCHEN
- 36" FRIDGE, MICRO IN PANTRY, CHIMNEY HOOD FAN
- (x2) CAPPED PENDANTS (INC.)
- (x1) PLUG PENINSULA (INC.)
- (x5) PUCK LIGHTS.
- (x1) = BASE "L" CABINET
- (x1) = UPPER CORNER CABINET "L" SHAPED
- (x1) = SPICE CABINET.
- (x1) = PANTRY w/ MICRO SHELF
- RAISED 36" VANITIES w/ 3" SPLASH IN ENSUITE & MAIN WASH.
- See GTC EXTRA'S DETAIL

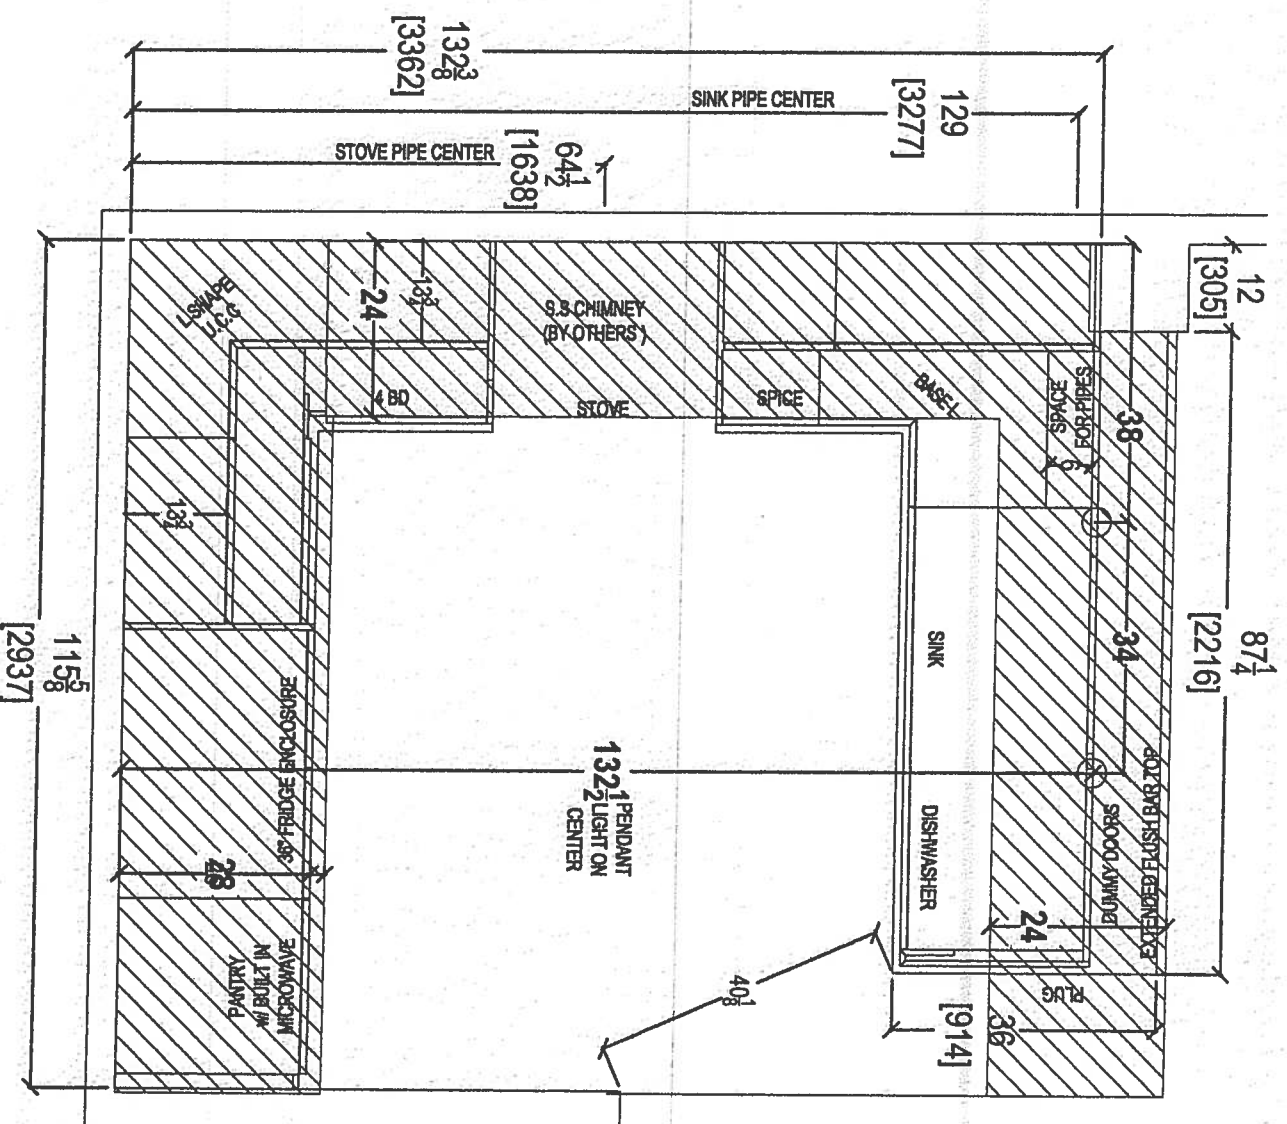

CLIENT: ROYAL PINE HOMES	JOB NAME: UNIT 407 HMP	ROOM: KITCHEN FLOOR PLAN	DRAWN BY: SK	COMMENTS: PLEASE NOTE ALL DIMENSIONS ARE NOT FINAL AND ARE SUBJECT TO CHANGE UPON FINAL SITE MEASURE
SITE: HAMPTON PLACE	DOOR STYLE: —	DOOR HANDLE: —	SCALE: 1/2" = 1' - 0"	
PHONE: —	FINISH: —	DRW HANDLE: —	DATE: REVISED APRIL 3, 2019	
EMAIL: —	SPECIES: —	TYP: —		


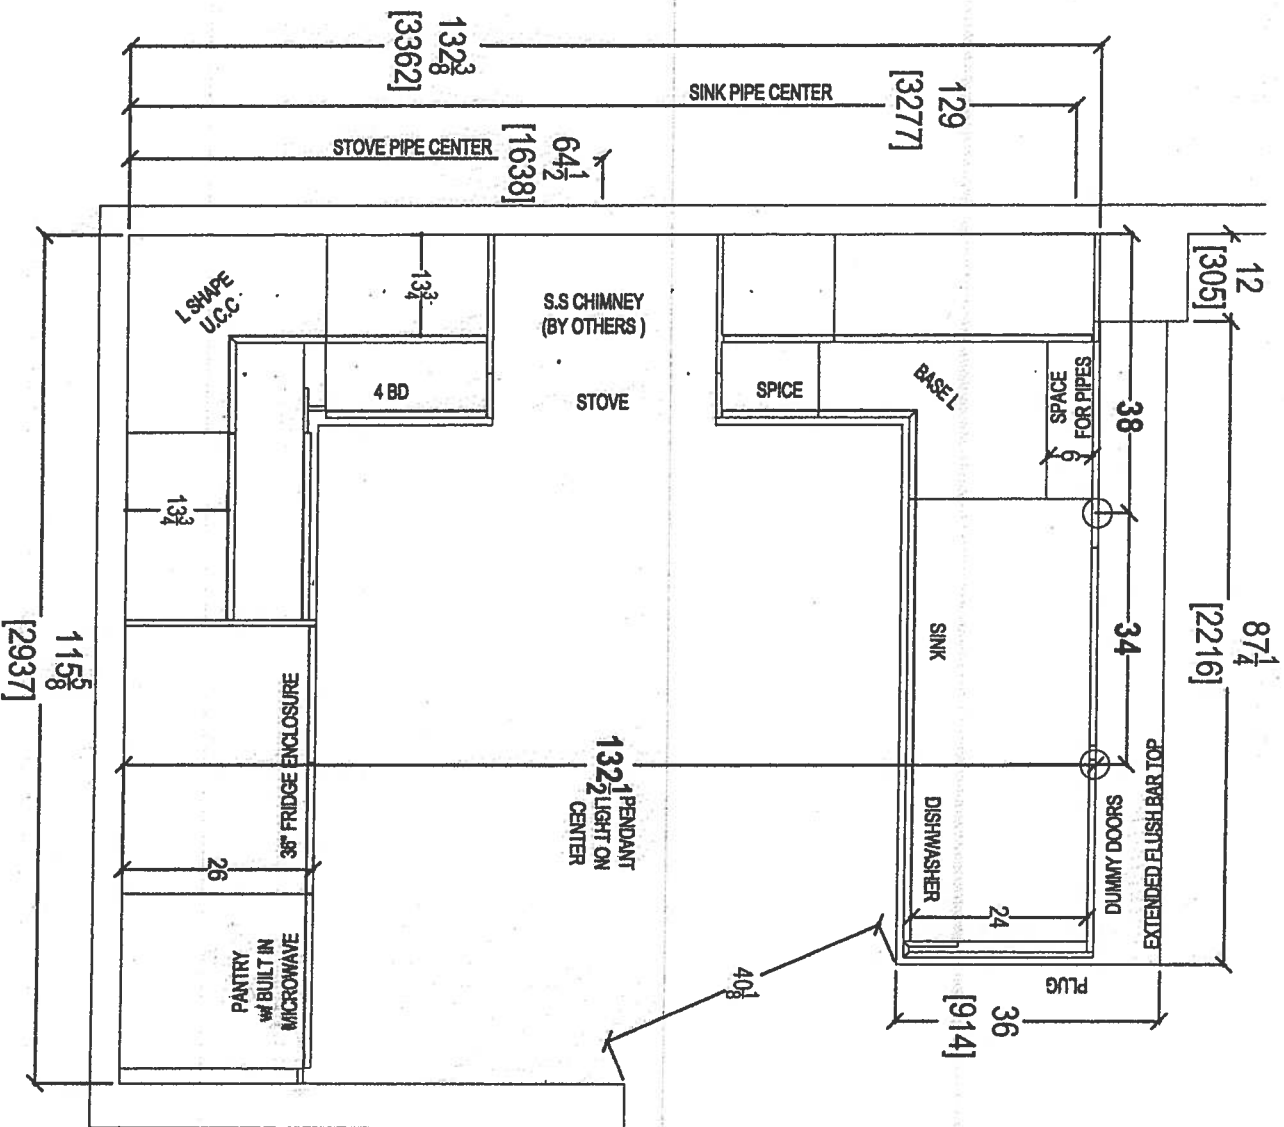


CLIENT: ROYAL PINE HOMES	JOB NAME: UNIT 407 HMP	ROOM: KITCHEN FLOOR PLAN	DRAWN BY: SK
SITE: HAMPTON PLACE	DOOR STYLE: —	DOOR HANDLE: —	SCALE: 1/2" = 1'-0"
PHONE: —	FINISH: —	DRV HANDLE: —	DATE: REVISED APRIL 3, 2019
EMAIL: —	SPECIES: —	TOP: —	PAGE: —

COMMENTS:
PLEASE NOTE ALL DIMENSIONS
ARE NOT FINAL AND ARE
SUBJECT TO CHANGE UPON
FINAL SITE MEASURE



your kitchen, your taste.
80 SANTE DRIVE, VAUGHAN, ON L4K 3C4,
T: 416.748.1811 F: 905.761.5801

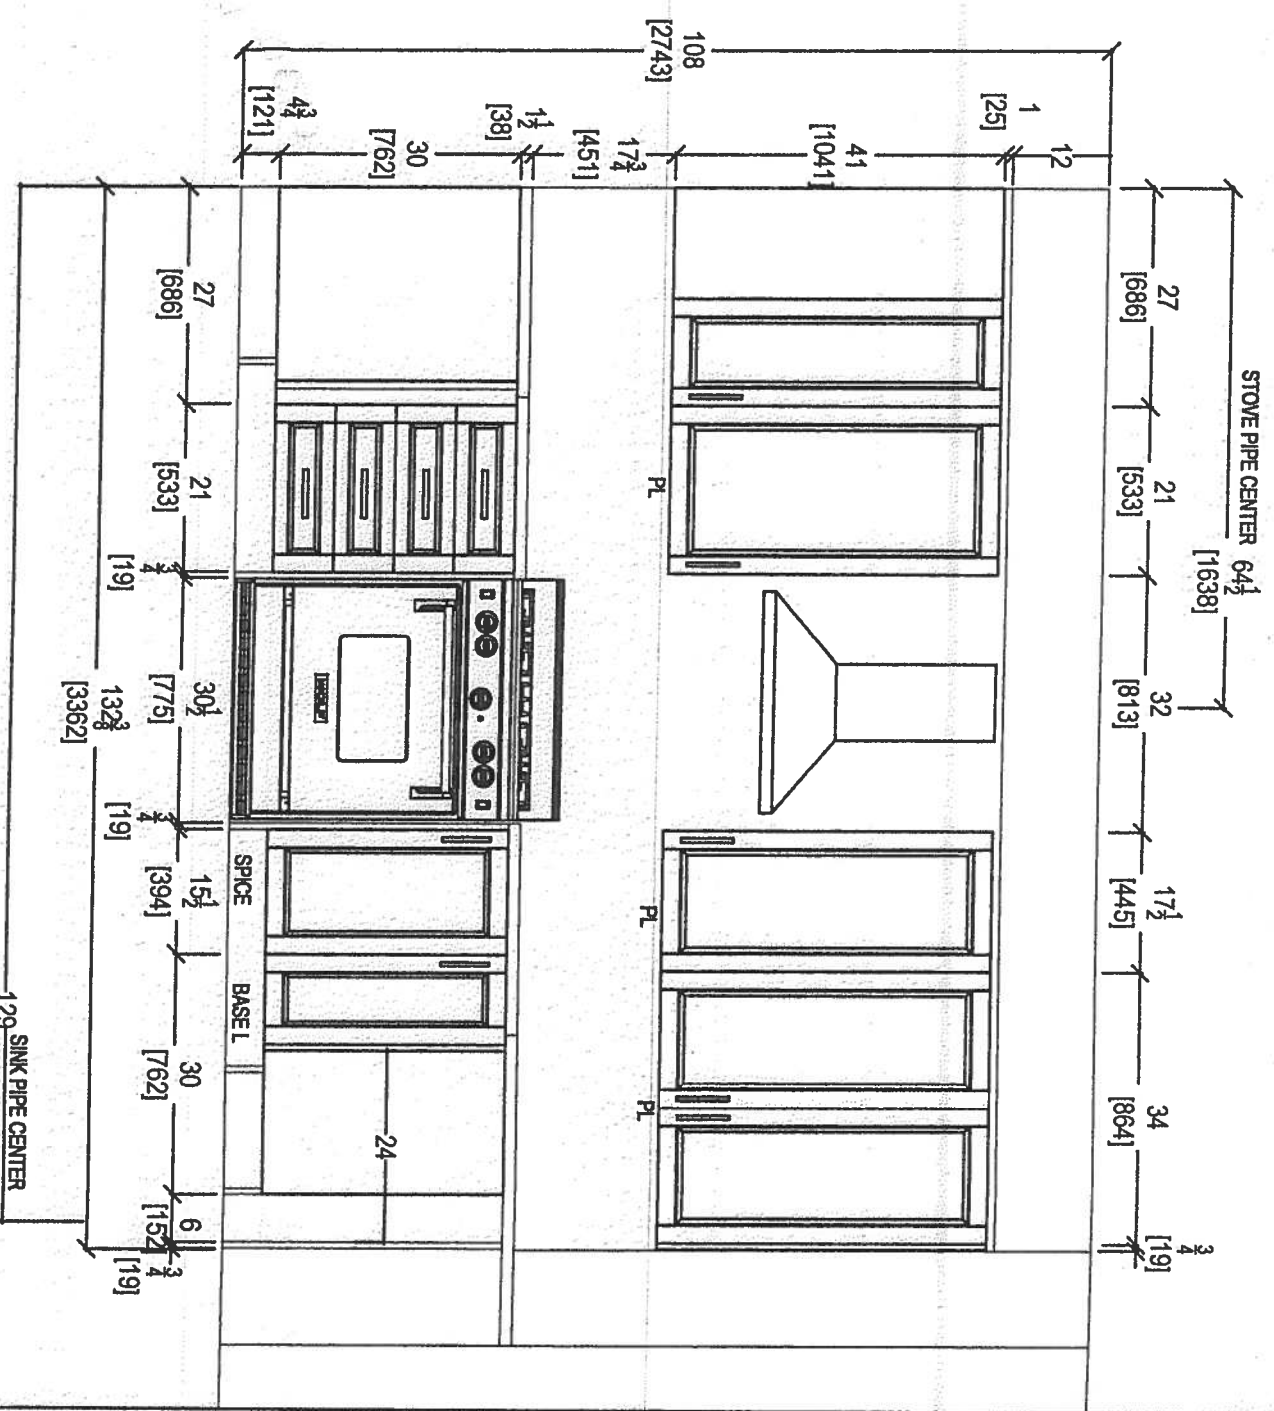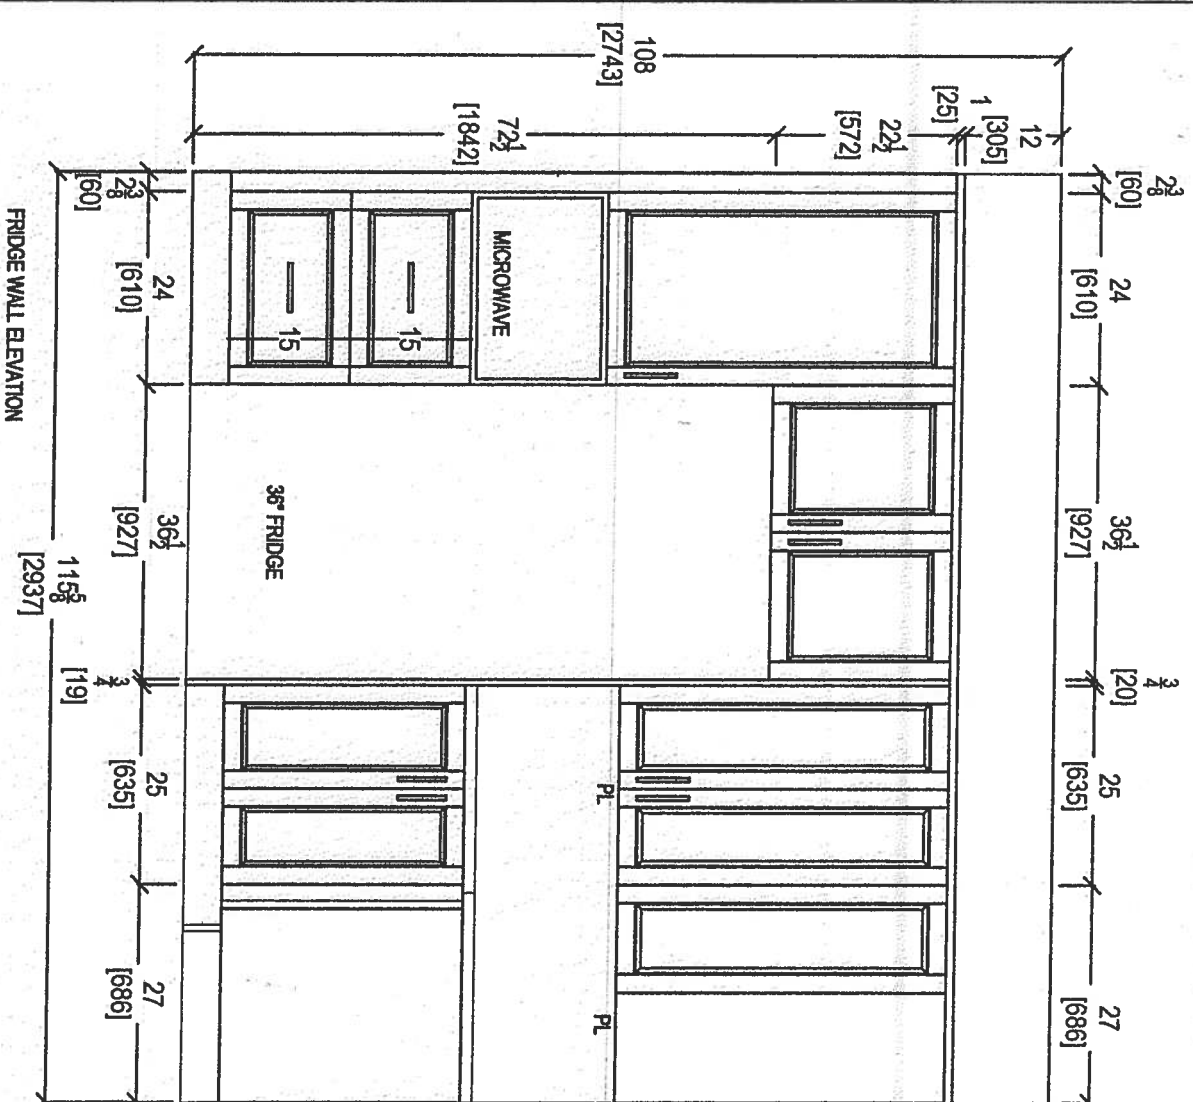

STOVE WALL ELEVATION


129" SINK PIPE CENTER




your kitchen, your taste

80 SANTE DRIVE, VAUGHAN, ON L4K 3C4,
T: 416.748.1811 F: 905.761.5901

CLIENT: ROYAL PINE HOMES	JOB NAME: UNIT 407 HMP	ROOM: KITCHEN	DRAWN BY: SK	COMMENTS:
SITE: HAMPTON PLACE	DOOR STYLE: —	DOOR HANDLE: —	SCALE: 1/2" = 1'-0"	PLEASE NOTE ALL DIMENSIONS ARE NOT FINAL AND ARE SUBJECT TO CHANGE UPON FINAL SITE MEASURE
PHONE: —	FINISH: —	DRW HANDLE: —	DATE: REVISED APRIL 3, 2019	
EMAIL: —	SPECIES: —	TOP: —	PAGE: —	

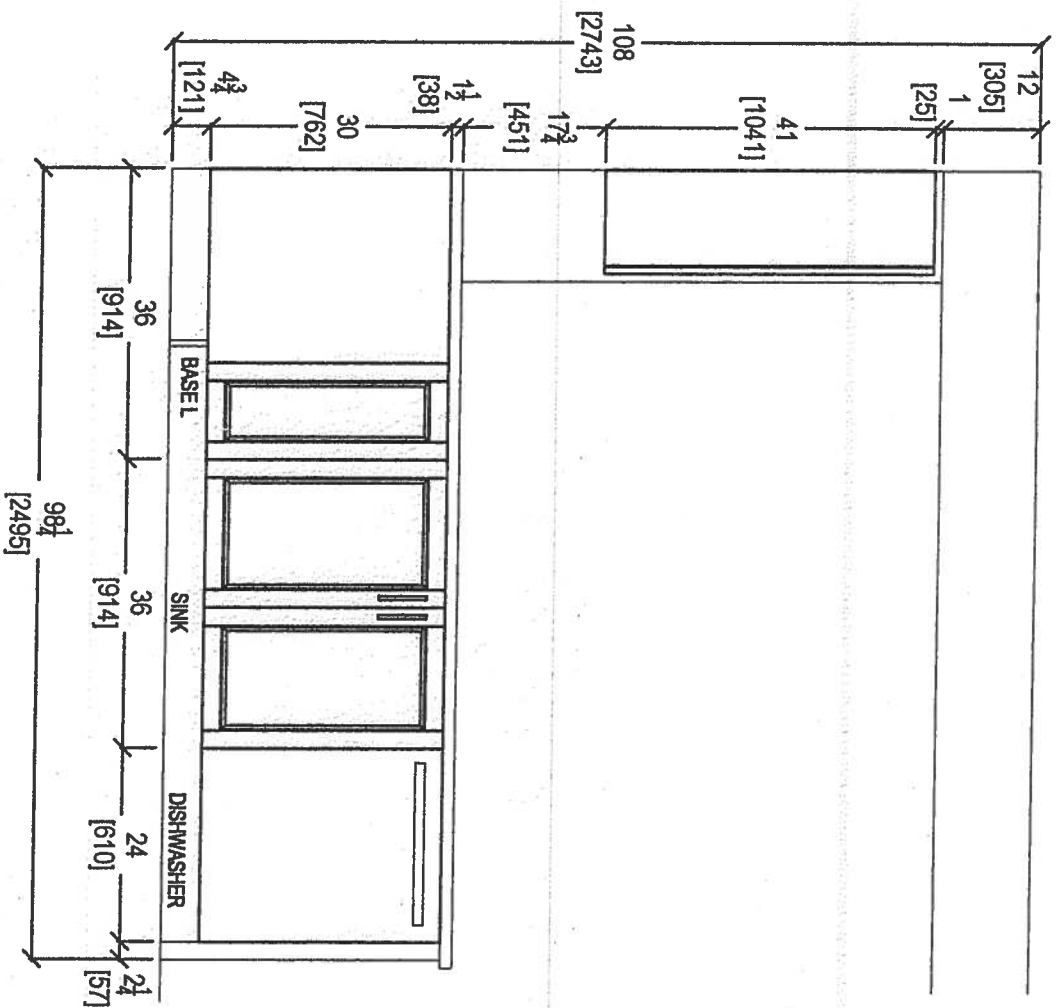

KITCHEN PENINSULA ELEVATION
FRONT VIEW




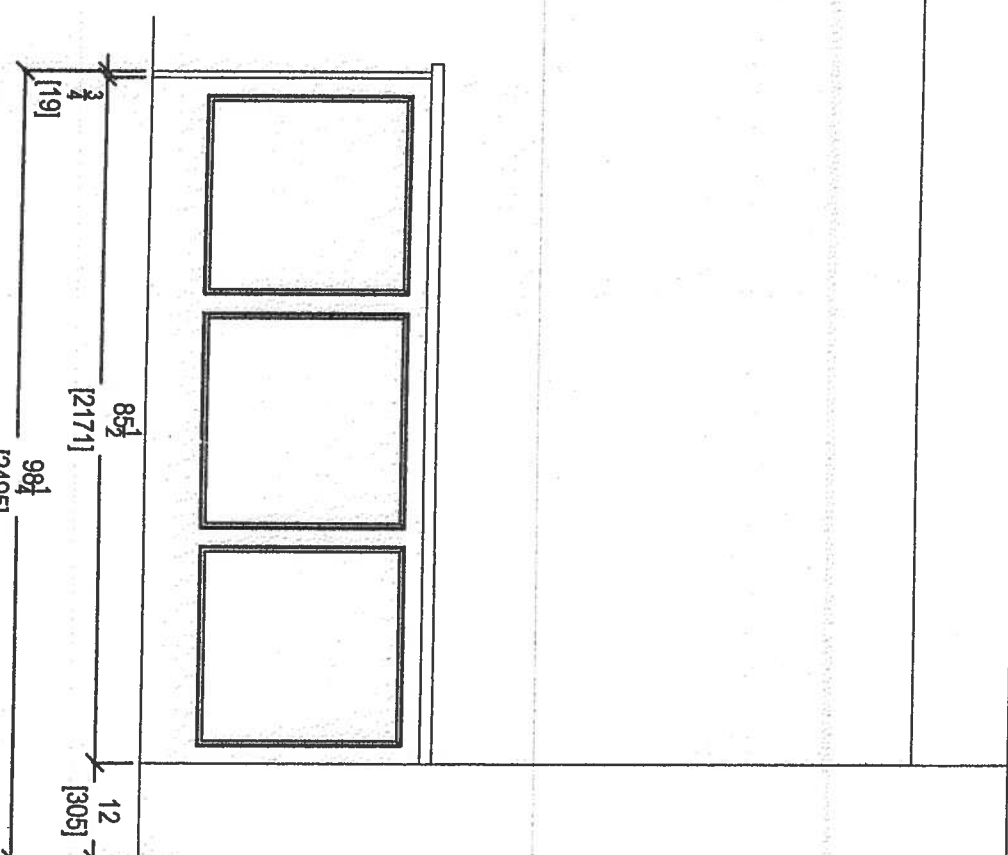


KITCHEN PENINSULA ELEVATION
REAR VIEW

QTY
your kitchen, your taste.
80 SANTE DRIVE, VAUGHAN, ON L4K 3C4,
T: 416.746.1811 F: 905.761.5901

CLIENT: ROYAL PINE HOMES	JOB NAME: UNIT 407 HMP	ROOM: KITCHEN	DRAWN BY: SK
SITE: HAMPTON PLACE	DOOR STYLE: —	DOOR HANDLE: —	SCALE: 1/2" = 1' - 0"
PHONE: —	FINISH: —	DRW HANDLE: —	DATE: REVISED APRIL 3, 2019
EMAIL: —	SPECIES: —	TOP: —	PAGE: —

COMMENTS:
PLEASE NOTE ALL DIMENSIONS
ARE NOT FINAL AND ARE
SUBJECT TO CHANGE UPON
FINAL SITE MEASURE

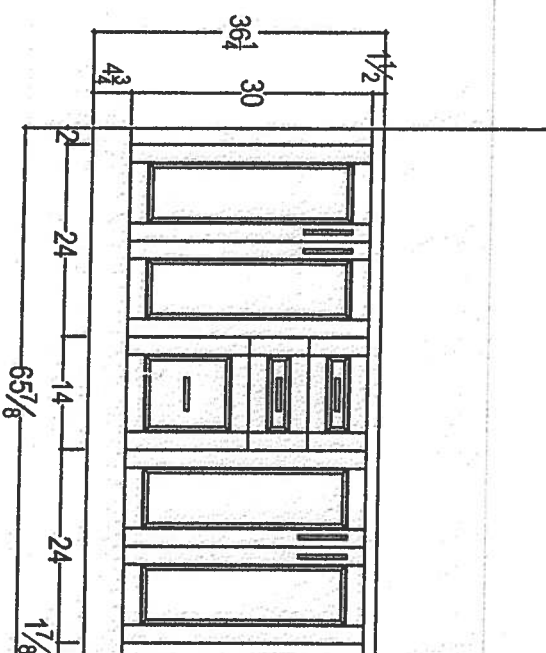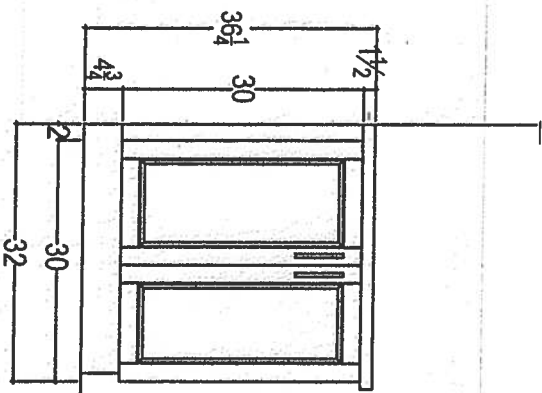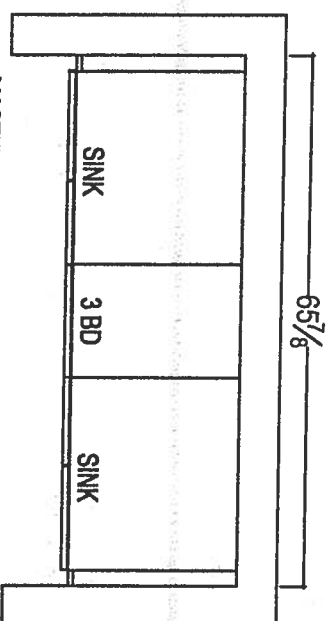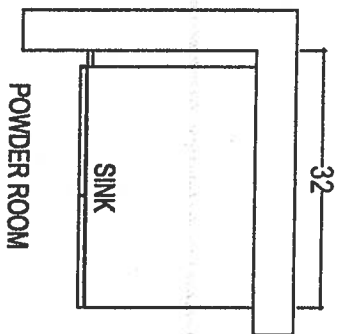

Basic VANITIES w 3" SPLASHT.



80 SANTE DRIVE, VAUGHAN, ON L4K 3C4,
T: 416.746.1811 F: 905.781.5901

CLIENT: ROYAL PINE HOMES	JOB NAME: UNIT 407 HMP	ROOM: VANITIES	DRAWN BY: SK
SITE: HAMPTON PLACE	DOOR STYLE: —	DOOR HANDLE: —	SCALE: 1/2" = 1'-0"
PHONE: —	FINISH: —	DRW HANDLE: —	DATE: REVISED APRIL 3, 2019
EMAIL: —	SPECIES: —	TOP: —	PAGE: —

COMMENTS:
PLEASE NOTE ALL DIMENSIONS
ARE NOT FINAL AND ARE
SUBJECT TO CHANGE UPON
FINAL SITE MEASURE

KRFC302ESS

22 cu.ft. 36-Inch Width Counter Depth French Door Refrigerator
with Interior Dispense



KRFC302ESS

Key Features:

- ExtendFresh™ Temperature Management System
- Interior Water Dispenser
- Professionally-Inspired Design
- Produce Preserver
- Humidity-Controlled Crispers
- FreshChill™ Temperature-Controlled Full-Width Pantry
- Pull-Out Tri-Level Freezer Drawer
- SatinGlide® System
- LED Lighting
- Star-K Certified
- Automatic Ice Maker
- Max Cool

Hampton

Upgrade
Package 2

INSIDEADVANTAGE™



<http://www.insideadvantage.com>

Product Dimensions:

Height: 72
Width: 35 3/4
Depth: 30 1/4

Electrical Requirements:

15 Amps.

Available In:

- Stainless Steel
- Black
- White

IMPORTED
IN
AMERICA

Because Whirlpool Corporation polices its trademarks, it continuously counterfeits to improve our products, we reserve the right to change materials and specifications without notice. We also reserve the right to
discontinue or transition products without notice.
©reg. Registered trademarks/™ Trademark of Whirlpool U.S.A. © 2013 Whirlpool Corporation. All Rights Reserved. All other trademarks are owned by their respective companies.
Created On: Wednesday, April 22, 2015 5:51:04

Our website uses cookies and similar tools to improve its performance and enhance your user experience. By continuing to use this website without changing your settings you consent to their use. To find out more about the cookies we use or how to change your settings, please see our cookies policy. [OK](#) [Learn more.](#)

Panasonic

\$225 + HST

Consumer

Business

Store

Support

About Us

FRANÇAIS

Search

Q

Countertop NN-ST765S

Price + \$ 329.99


SHOP NOW

Microwave Ovens > Countertop

NN-ST765S

Evolved Genius® Microwave with Cyclonic Inverter Technology

- 1,200 W High Cooking Power
- Genius Sensor Cooking with 14 Categories
- 10-level Power Settings
- 3-multi-stage Cooking
- Sensor Reheat
- Cyclonic Inverter Technology
- Full LED Lighting System

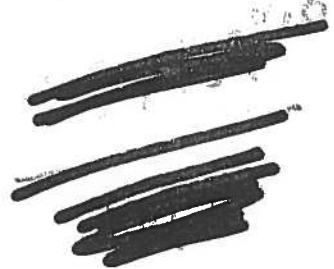

Overview

Features

Specs


Accessories

Where to Buy


Support

New Cyclonic Inverter Technology

Open (Inverter)

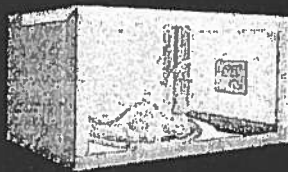

Cyclonic Inverter

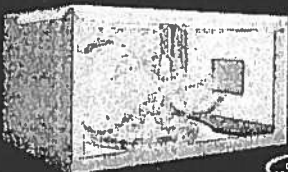

LINK
INVERTER

Meat



Fish



Chicken



Milk



NN-ST765S Countertop - Panasonic Canada

1.6 cu. ft.
Oven capacity

1200 Watt
Cooking power

304 x 555 x 493 mm
Exterior dimensions (H x W x D)

SEE ALL SPECS


NN-TK722S
27" Trim kit for NN-ST765S

NN-TK732S
30" Trim kit for NN-ST765S

NN-TK714SS
24" Trim kit for NN-ST765S

SPECIFICATIONS		Popcorn Button	Yes
		Quick Minute	Yes
		Cavity Dimensions (W x D x H)	Approx. 418 x 470 x 228 mm 15.7 x 18.5 x 8.3 inch
		Unit Dimensions (W x D x H)	555 x 493 x 304 mm 21.9 x 19.4 x 12 inch
		Carton Dimensions (W x D x H)	627 x 540 x 360 mm
ACCESSORIES	TRIM KITS	27" Model Number	NN-TK722S
		30" Model Number	NN-TK732S
	Accessory		Glass Tray

Copyright ©Panasonic Canada Inc.

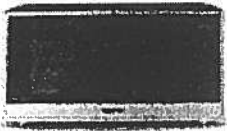

Microwave Ovens Countertop


Countertop NN-ST765S

MODEL & SIZE	Model Number	NN-ST765S
	Type	Family-size
	Installation	Countertop or built-in
	Oven Capacity	1.6 cu. ft.
	Cooking Power	1200W
	Turntable Diameter	380mm
PANASONIC TECHNOLOGY	Panasonic Inverter	Cyclonic Inverter
	Genius Sensor	Genius®
DESIGN	Color	Stainless Steel
	Control Panel	Touch pad
	Display Panel	New 4 Digit + Icon LCD / Green
STYLE	Door Window	Clear Black
	Door Release	Push Open
	Oven Interior	Paint White
PERFORMANCE	Multi-stage Cooking	3 stage
PROGRAMMABLE FEATURES	Sensor Cook	Yes
	Sensor Reheat	Yes
	Auto Cook/Reheat	Yes
	More / Less Control	Yes
	Inverter Turbo Defrost	Yes
	Keep Warm Button	Yes

NINST7655-

Trim Kit
NNTK714SS \$189

- 2. Installation Diagram
- 2. Schéma d'installation
- 2. Diagrama de instalación

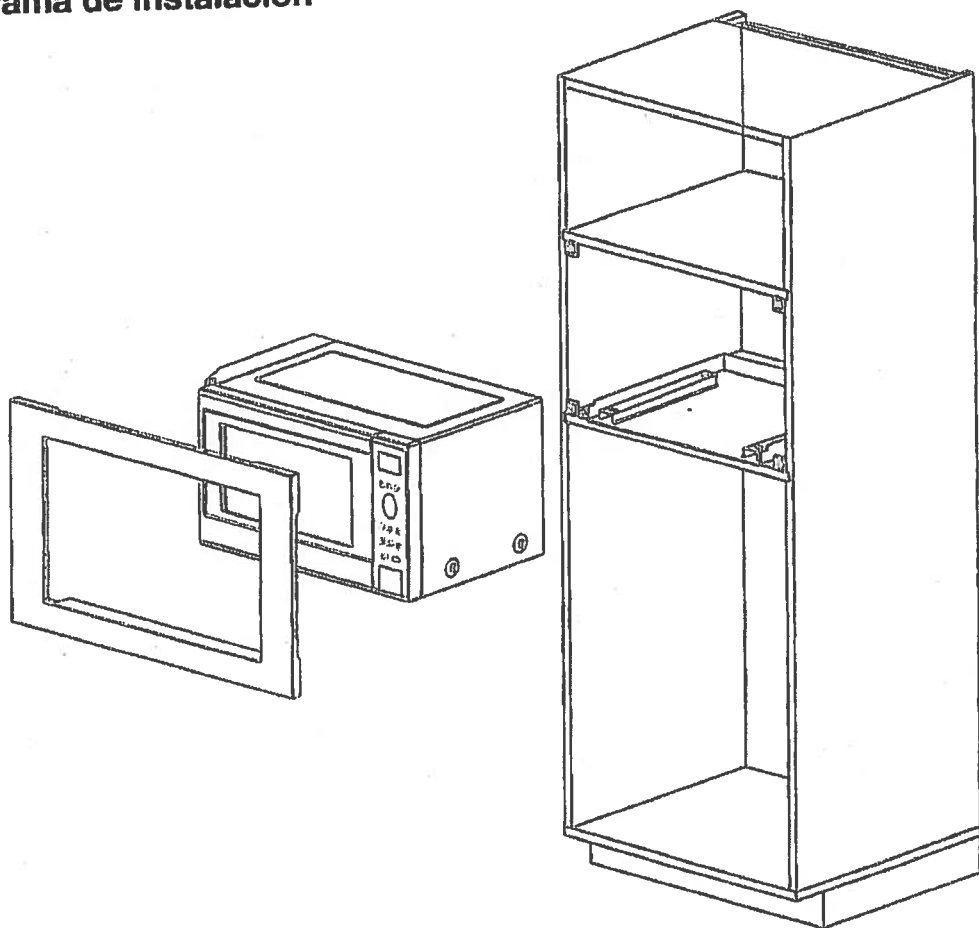


Trim Kit Dimensions	
Width	596 mm (23½") -
Height	410 mm (16 ⅞")
Depth (Thickness)	20 mm (¾")

Dimensions du nécessaire d'encastrement	
Largeur	596 mm (23½ po)
Hauteur	410 mm (16 ⅞ po)
Profondeur (épaisseur)	20 mm (¾ po)

Dimensiones del juego de acabados	
Ancho	23½" (596 mm)
Altura	16 ⅞" (410 mm)
Profundidad (grosor)	¾" (20 mm)

3. Cabinet Diagram and Dimensions
3. Schéma de l'armoire et dimensions
3. Dimensiones y diagrama del gabinete

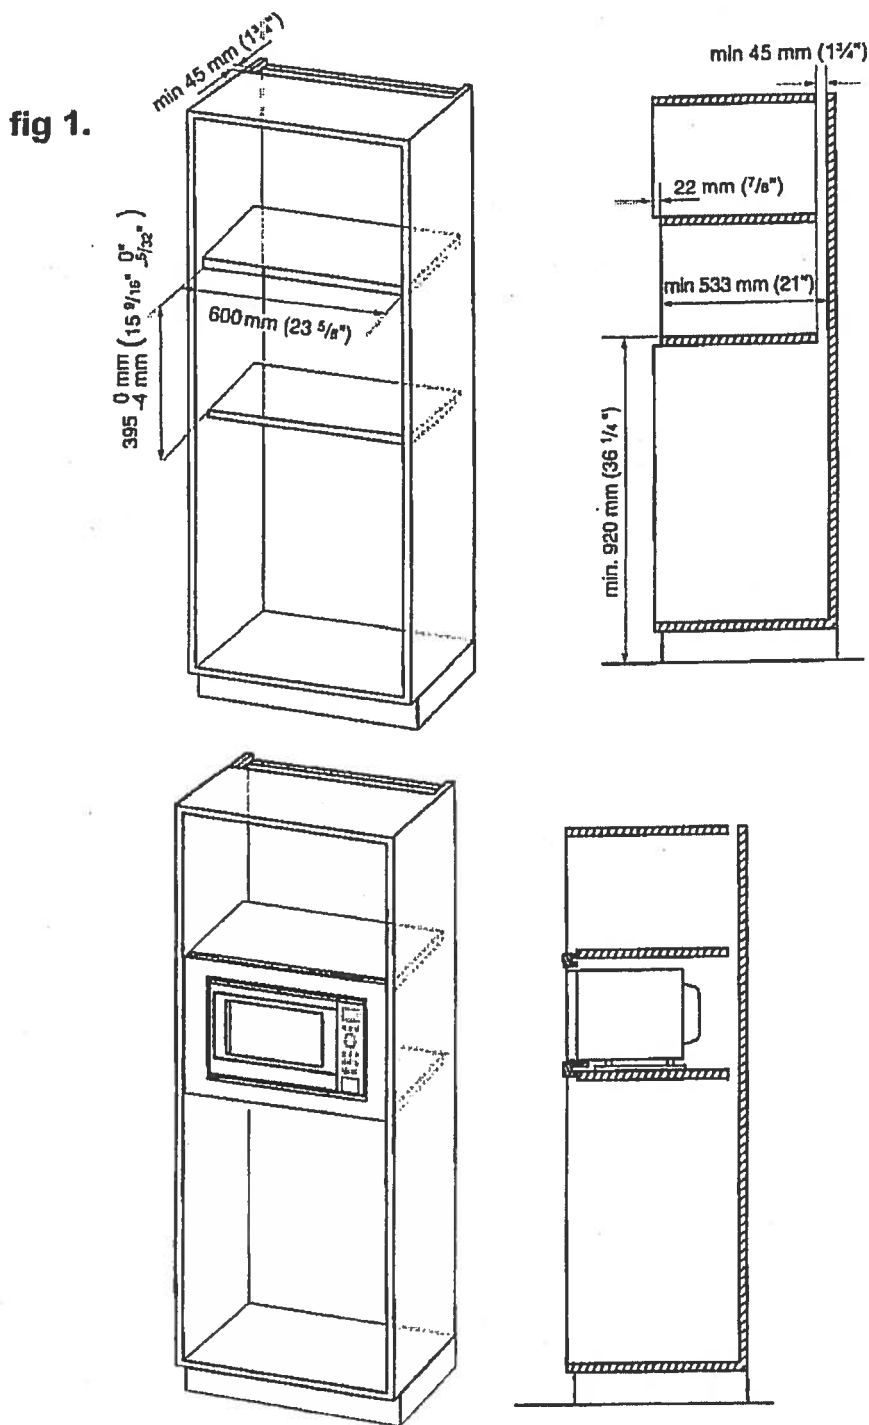

U.S.A. (EN (/en_us/)) - Select Country (/en_us/country/)

Catalogues (/en_us/catalog/) Downloads (/en_us/downloads/) Reserved area (http://portal.falmec.com/) Contacts (/en_us/contacts/)


Search Q



PRODUCTS COMPANY (/EN_US/COMPANY/) FALMEC WORLD (/EN_US/FALMEC_WORLD/)
NEWS & PRESS (/EN_US/NEWS/)

HOME (/EN_US/) > HOODS (/EN_US/TPOLOGY/HOODS-1/) >
POTENZA (/EN_US/TPOLOGY/HOODS-1/COLLECTION/POTENZA-15/) > VULCANO

SHARE THIS PRODUCT

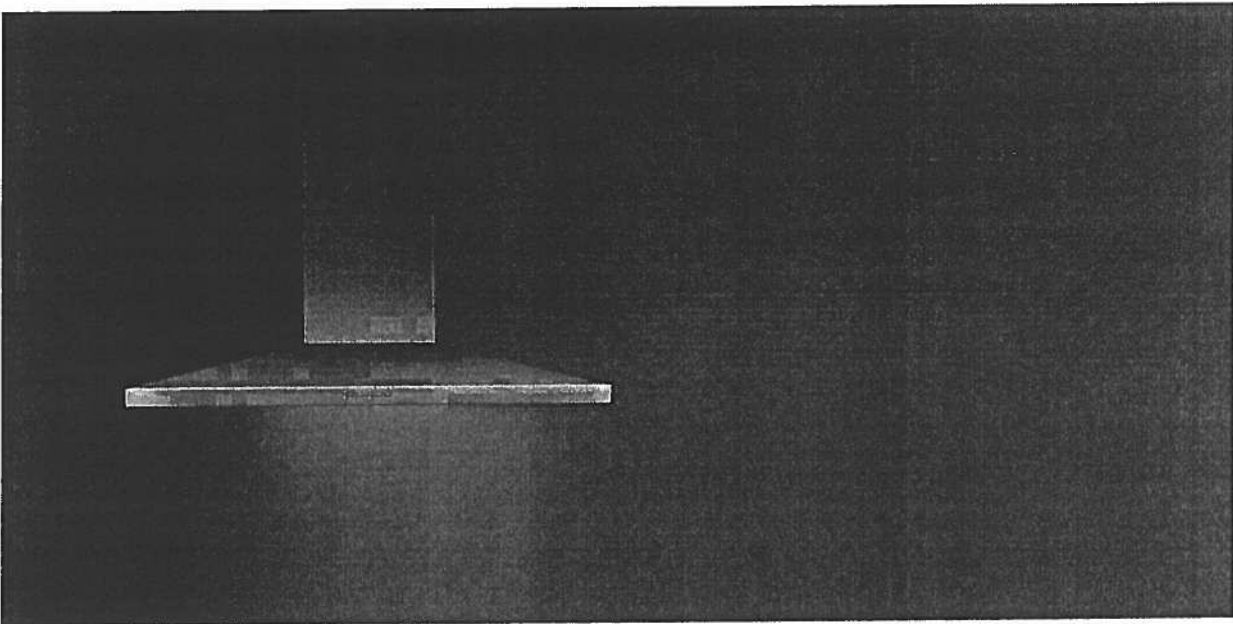

VARIANTS

FPVUL30W3SS / Vulcano Wall 30" (76 cm) 280 CFM
FPVUX36W6SS / VulcanoXL Wall 36" (90cm) 600 CFM
FPVUL24W3SS / Vulcano Wall 24" (60 cm) 280 CFM
FPVUX30W6SS / VulcanoXL Wall 30" (76 cm) 600 CFM

TECHNICAL FEATURES

Installation type
Wall
Dimensions
76 cm / 30 in
Features
Scotch brite stainless steel (AISI 304)
Electronic control
Metallic grease filter, removable and washable
Optional charcoal filter
Labyrinth filter
Finish
Scotch brite stainless steel (AISI 304)
Motor
450 m³/h / 280 cfm
Type of control
Electronic control
Speed settings

ACCESSOIRES

KACL.510#I
Extension H700 - Wall
KACL.512#I
Extension H960 - Wall
KACL.815
Protective cleaning cloths for stainless steel (box 10 pcs)
103050107
Square charcoal filter - Type 3

CONSUMPTION

Maximum consumption
150 W
Current
120V 60Hz
Frequency

PACKAGING

Gross weight
20 Kg
Net weight
15 Kg
Volumes
0.30 m³
Packaging size
Length: 995 mm
Height: 595 mm
Depth: 510 mm

COOKIE POLICY

We use cookies on "www.falmecnorthamerica.com". If you continue to use "www.falmecnorthamerica.com" you will be agreeing to the website General Terms and Conditions of Use, Privacy Policy and the use of cookies while using the website. To find out more about cookies and how to change your preferences please see our Cookie Policy (http://www.falmecnorthamerica.com/en_us/cookie/).

Led 2x1,2 W - 3200 K

DOWNLOAD TECHNICAL SHEET


4/3/2018

Hoods From Collection Potenza Vulcano | Falmec


Minimum distance
Electric hob: 52 cm
Gas hob: 60 cm

Download pdf (<https://falmec-catprod1.falmec.com/technical-specifications/515/en-US>)

[View all downloads](#)

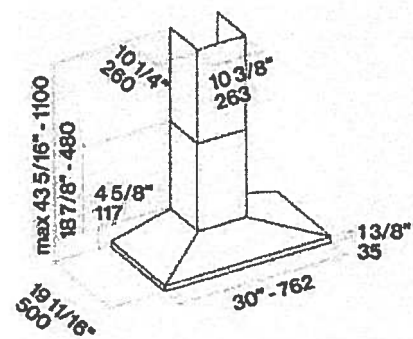

GALLERY

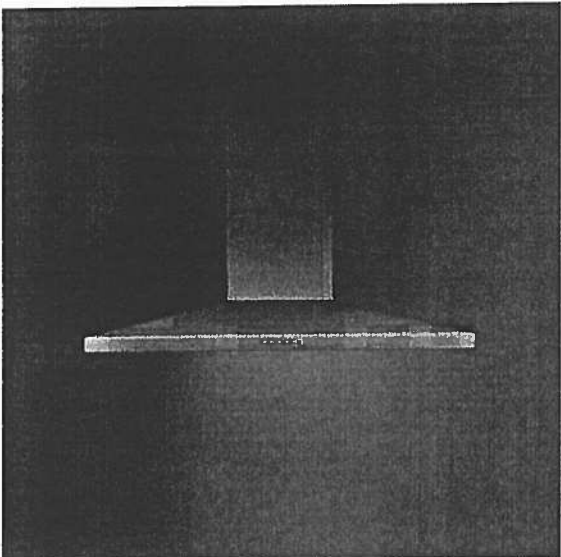

(/artcms/admin/upBoxImages/3238/1492233205.jpg)

DOWNLOADS

Instruction manual
wall
(.pdf - 2.71Mb)
(<https://falmec-catprod1.falmec.com/files/3738.pdf>)

Hampton


WEE745H0FS

Upgrade Package I

Whirlpool®

<http://www.whirlpool.com>

6.4 Cu. Ft. Slide-In Electric Range with True Convection

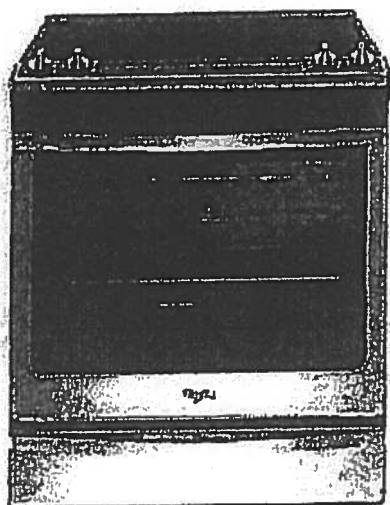

Key Features:

- Frozen Bake™ Technology
- True Convection Cooking
- FlexHeat™ Triple Radiant Element
- Convection Conversion
- AquaLift® Self-Cleaning Technology
- Temperature Sensor
- Rapid Preheat
- 6.4 Cu. Ft. Capacity
- Easy-Wipe Ceramic Glass Cooktop
- Large Oven Window
- Max Capacity Rack
- Hidden Bake Element

Product Dimensions:

Height: 36

Width: 29 7/8

Additional Information:

[Use And Care Guide](#)

[Dimension Guide](#)

[Installation Guide](#)

[Warranty Certificate](#)

INVESTED
IN
AMERICA



®Registered trademark/TM Trademark of Whirlpool, U.S.A. © 2016 Whirlpool Corporation. All Rights Reserved.
All other trademarks are owned by their respective companies.
Because Whirlpool Corporation policy includes a continuous commitment to improve our products, we reserve the right to change materials and specifications without notice. We also reserve the right to discontinue or transition products without notice.
Manufacturer's Suggested Retail Price (MSRP) and Minimum Advertised Price (MAP) provided for reference purposes only. Dealer sets ultimate advertised and retail prices.
Created On: Feb 01, 2017 10:48:47

Hampton Upgrade Package 1

WDTA50SAHZ

Whirlpool

<http://www.whirlpool.com>

Contemporary Design. Stainless Steel Tub
Dishwasher with TotalCoverage Spray Arm

Key Features:

- Sensor Cycle
- TotalCoverage Spray Arm
- 1-Hour Wash Cycle
- Tap Touch Controls

Product Dimensions:

Height: 34 1/2

Width: 23 7/8

Depth: 24 1/2

Additional Information:


[Use And Care](#)

[Dimension Guide](#)

[Installation Guide](#)

[Energy Guide](#)

[Warranty](#)

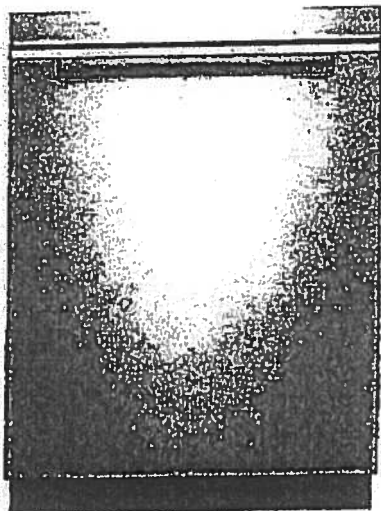

Available in:

● Black

Fingerprint Resistant Sunset Bronze

Fingerprint Resistant Black Stainless

○ White

Fingerprint Resistant Stainless Steel

INVESTED
IN
AMERICA



®Registered trademark/™ Trademark of Whirlpool, U.S.A. © 2016 Whirlpool Corporation. All Rights Reserved. All other trademarks are owned by their respective companies.

Because Whirlpool Corporation policy includes a continuous commitment to improve our products, we reserve the right to change materials and specifications without notice. We also reserve the right to discontinue or transition products without notice.

Manufacturer's Suggested Retail Price (MSRP) and Minimum Advertised Price (MAP) provided for reference purposes only. Dealer sets ultimate advertised and retail prices.


Hampton Upgrade Package I

WFW75HEFW

5 cu. ft. Front Load Washer with Precision Dispense



<http://www.whirlpool.com>

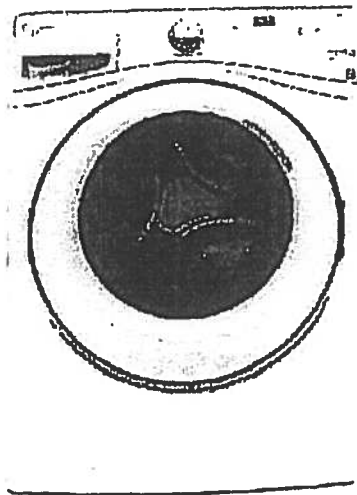

Key Features:

- Precision Dispense
- Adaptive Wash Technology
- Smooth Wave Stainless Steel Wash Basket
- 4.5 cu. ft. Capacity
- ENERGY STAR® Qualified

Product Dimensions:

Height: 39 3/4

Width: 27

Depth: 33 5/16

Electrical Requirements:

15 or 20. 120 V.

Additional Information:

[Use And Care Guide](#)

[Dimension Guide](#)

[Installation Guide](#)

[Energy Guide](#)

[Warranty Certificate](#)

INVESTED
IN
AMERICA



©Registered trademark/TM Trademark of Whirlpool, U.S.A. ©2013 Whirlpool Corporation All Rights Reserved
All other trademarks are owned by their respective companies.
Because Whirlpool Corporation policy includes a continuous commitment to improve our products, we reserve the right to change materials and specifications without notice. We also reserve the right to discontinue or transition products without notice.
Manufacturer's Suggested Retail Price (MSRP) and Minimum Advertised Price (MAP) provided for reference purposes only. Dealer sets ultimate advertised and retail prices.
Created On: Wednesday, March 23, 2016 11:51:03

Hampton Upgrade Package 1

YWED75HEFW

Whirlpool

<http://www.whirlpool.com>

7.5 cu. ft. Duet® High Efficiency Front Load Electric Dryer with ENERGY STAR®

MSRP: \$0.00

Key Features:

- Advanced Moisture Sensing System
- Quad Baffles
- Tap Touch Controls with Memory
- EcoBoost™ Option
- Wrinkle Shield™ Plus Option
- Undercounter Installation
- 7.4 Cu. Ft. Capacity
- ENERGY STAR® Qualified

Product Dimensions:

Height: 39

Width: 27


Depth: 31

Additional Information:

[Use And Care](#)

[Installation Guide](#)

[Warranty](#)

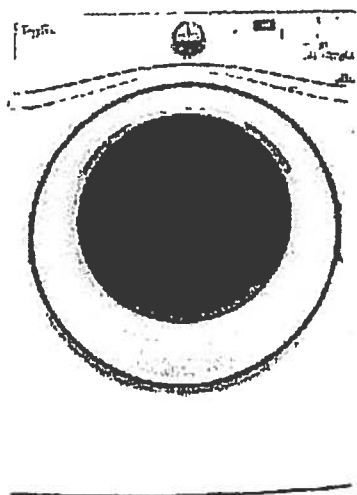

Available in:

☐ White

INVESTED
IN
AMERICA



®Registered trademark/™Trademark of Whirlpool, U.S.A. © 2016 Whirlpool Corporation. All Rights Reserved. All other trademarks are owned by their respective companies.

Because Whirlpool Corporation policy includes a continuous commitment to improve our products, we reserve the right to change materials and specifications without notice. We also reserve the right to discontinue or revision products without notice.

Manufacturer's Suggested Retail Price (MSRP) and Minimum Advertised Price (MAP) provided for reference purposes only. Dealer alone determines advertised and retail prices.


Suite
Hampton

Living Room

→ CONDUIT =

CABLE/BELL
@ 60"

TV →

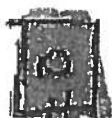

PLUG

← conduit

BLANK
PLATE



PLUG