




Original

LOT# 44
BLK 7
ELV. B

CROCUS CORNER

(18-04 CORNER)

2230 SQ. FT. / 2230 SQ. FT. (ELEV. 8)
(INCLUDES 14 SQ. FT. OF OPEN AREA)

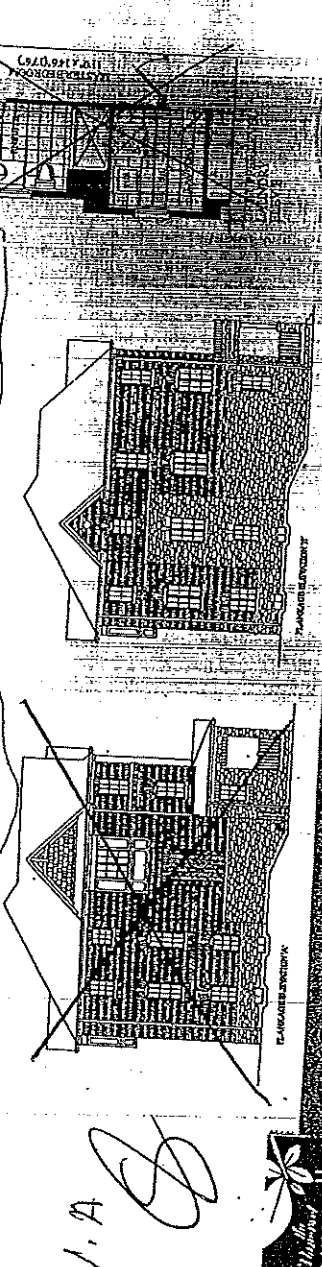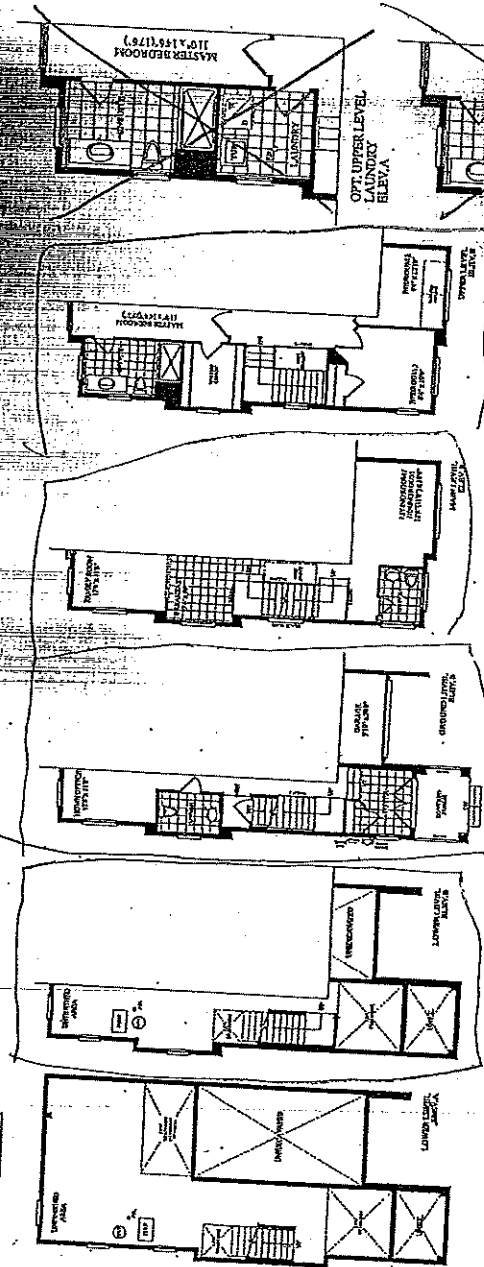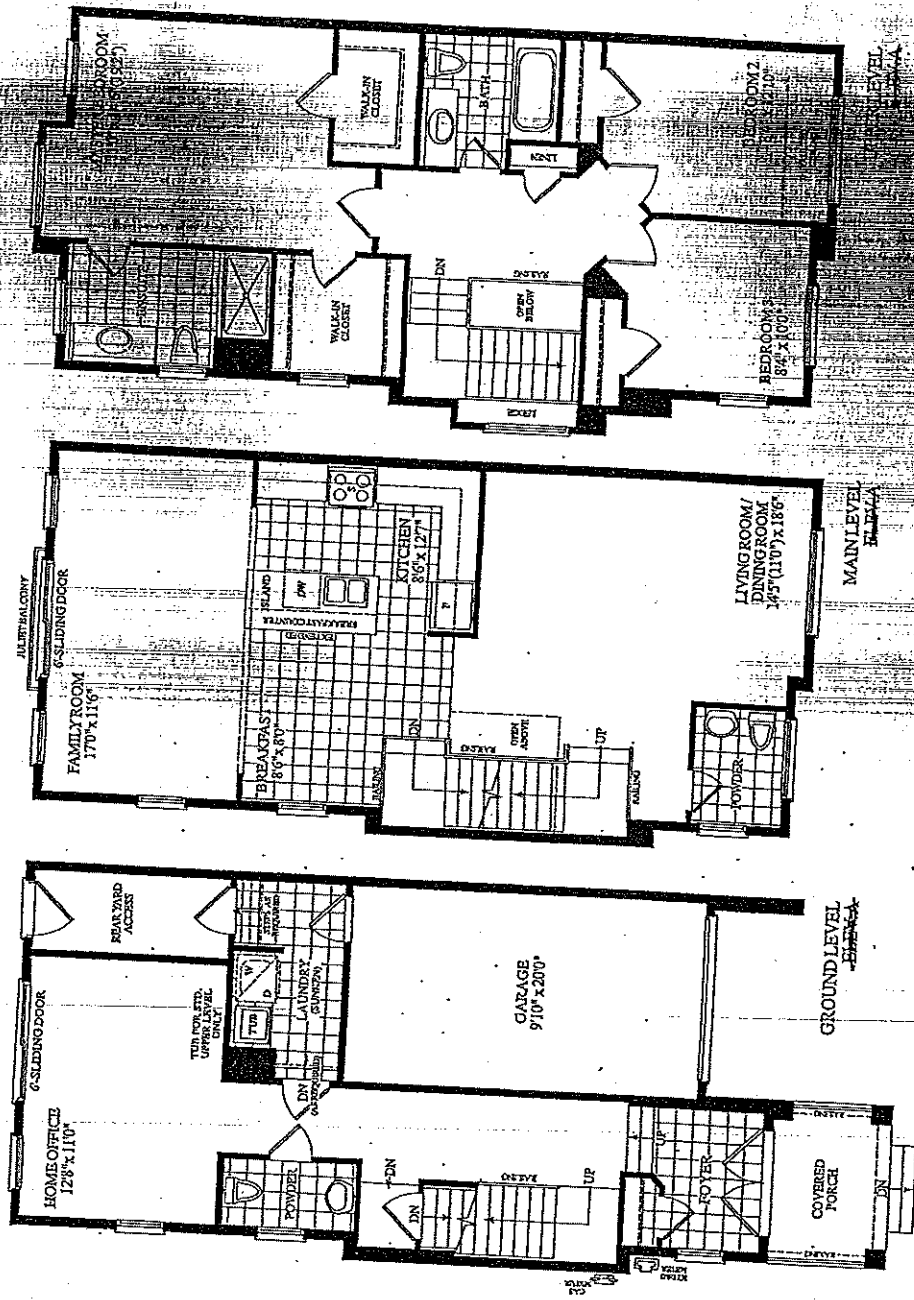

ROYAL FINE HOMES



Description - Vendor to Supply and Install the Following as Per Purchase Price

- BONUS PACKAGE -PURCHASER TO RECEIVE \$10,000 (INCLUSIVE OF TAXES) WORTH OF UPGRADES AT DECOR CENTRE AT TIME OF COLOUR CHART
- BONUS PACKAGE OF 5 APPLIANCES TO INCLUDE FRIDGE, STOVE, DISHWASHER, WASHER AND DRYER AS PER VENDORS SAMPLES
- CHOICE OF COLOUR (FROM VENDORS SAMPLES) FOR 7 1/2 INCH LAMINATE ENGINEERED FLOORING IN ALL AREAS NOT COVERED WITH CERAMIC TILES ON MAIN/GROUND LEVEL, INCLUDING STAIRS AND LANDINGS AS PER PLAN.

18' TOWNHOMES

BLK. 7 LOT 44 EL.B



CROCUS CORNER

(18-04 CORNER)



2230 SQ. FT. (ELEV. B)

(INCLUDES 14 SQ. FT. OF OPEN AREA)

(STANDARD FLOOR LEVELS)

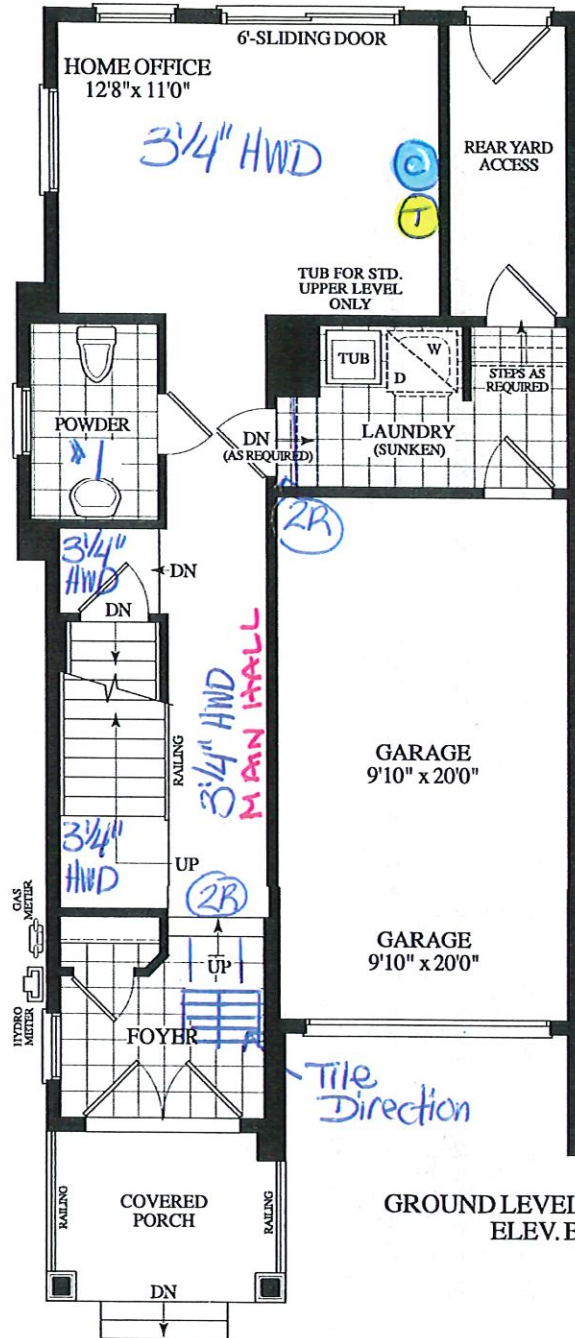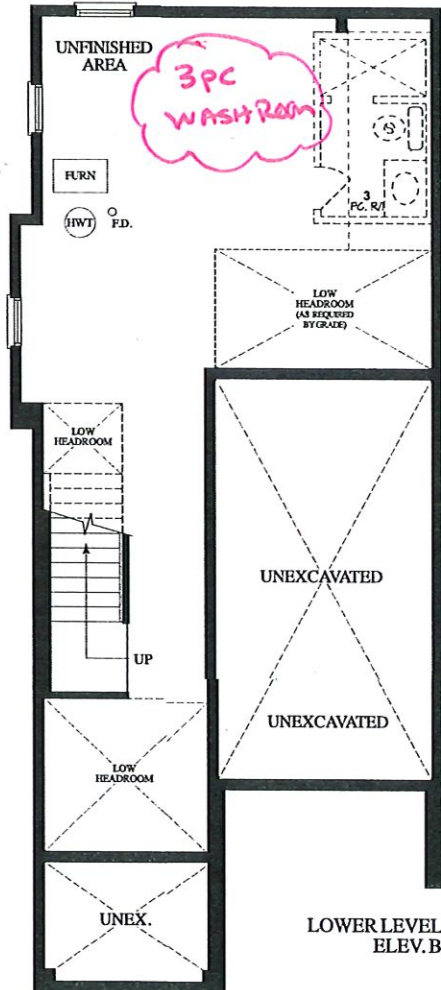

SMOOTH CEILING MAIN FLOOR

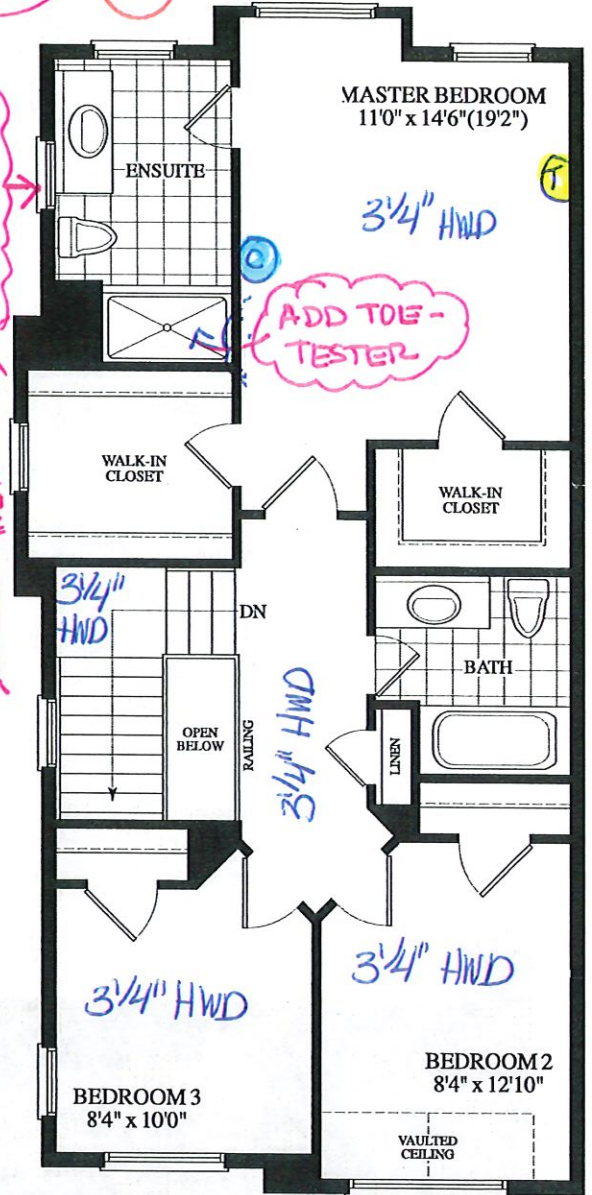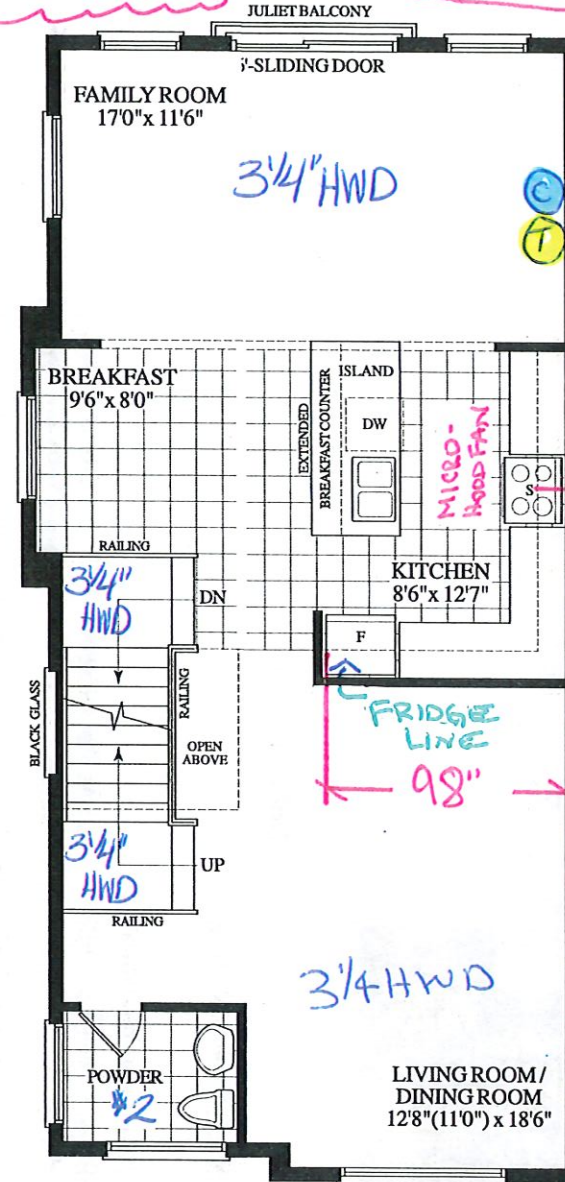

November 12, 2019

M/A

© - cable (x3)

Ⓣ - Telephone (x3)

RECEIVED
Nov. 12, 2019



Dimensions, specifications, layouts, window sizes, and materials are approximate only, may vary and are subject to change as provided in the Agreement of Purchase & Sale. Plans may be reversed. Illustrations are artist's concept. E&OE.

ROYALPINEHOMES.COM

CONSTRUCTION LAYOUT



CONSTRUCTION SUMMARY

Forestside Estates Inc.

PURCHASER: NAJIBUDDIN AMIR M

TEL:

LOT NUMBER	PHASE	HOUSE TYPE	CLOSING DATE
44 Block 7	6	CROCUS(cor)-ELEV B-std ground with std upper	30-Oct-19

Offer	BONUS PACKAGE -PURCHASER TO RECEIVE \$10,000 (INCLUSIVE OF TAXES) WORTH OF UPGRADES AT DECOR CENTRE AT TIME OF COLOUR CHART
Workshee	Note:
Offer	BONUS PACKAGE OF 5 APPLIANCES TO INCLUDE FRIDGE, STOVE, DISHWASHER, WASHER AND DRYER AS PER VENDORS SAMPLES
Workshee	Note:
Offer	CHOICE OF COLOUR (FROM VENDORS SAMPLES) FOR 7 1/2 INCH LAMINATE ENGINEERED FLOORING IN ALL AREAS NOT COVERED WITH CERAMIC TILES ON MAIN/GROUND LEVEL, INCLUDING STAIR LANDINGS AS PER PLAN.
Workshee	Note:

DESCRIPTION
WASHROOM - ROUGH-IN 3 PIECE IN BASEMENT - SEWAGE ONLY - NO WATER SUPPLY



windows
SITE COPY

CONSTRUCTION SUMMARY

Forestside Estates Inc.

PURCHASER: NAJIBUDDIN AMIR M

TEL:

LOT NUMBER	PHASE	HOUSE TYPE	CLOSING DATE
44 Block 7	6	CROCUS(cor)-ELEV B-std ground with std upper	30-Oct-19

Date Added: 12-Nov-19

Invoice Number: 7345

1 - Standard Cable Rough-Ins (x3) and Standard Telephone Rough-Ins (x3) (See Sketch)

Note:

1 - MAIN FLOOR - Upgrade to SMOOTH CEILINGS throughout Main Floor Areas, where applicable. (does not include any open to above areas) (See Sketch)
Note:

231 - GROUND FLOOR - FLOORING - Install UPGRADE HARDWOOD FLOORING - 3 1/4" x 3/4" VINTAGE RED OAK DARK WALNUT (Pearl) - To be installed throughout ground floor, where applicable. To Include; Main Hall and Home Office (See Sketch)
Note: In Lieu of Builders Standard Laminate Flooring

460 - MAIN FLOOR - FLOORING - Install UPGRADE HARDWOOD FLOORING - 3 1/4" x 3/4" VINTAGE RED OAK DARK WALNUT (Pearl) - To be installed throughout main floor, where applicable. To Include; Family Room, and Living Room / Dining Room (See Sketch)
Note: In Lieu of Builders Standard Laminate Flooring

572 - UPPER LEVEL - FLOORING - Install UPGRADE HARDWOOD FLOORING - 3 1/4" x 3/4" VINTAGE RED OAK DARK WALNUT (Pearl) - To be installed throughout upper level, where applicable. To Include; Upper Hall, Master Bedroom, Bedroom #2 and Bedroom #3 (See Sketch)
Note: In Lieu of Builders Standard Broadloom

67 - STAIRCASE LANDINGS - FLOORING - Install UPGRADE HARDWOOD FLOORING - 3 1/4" x 3/4" VINTAGE RED OAK DARK WALNUT (Pearl) - To be installed throughout staircase landings, where applicable. (See Sketch)
Note: In Lieu of Builders Standard Laminate Flooring

2 - STAIRCASE - STAIN OAK STAIRCASE WITH IRON PICKETS - To be Stained in: VINTAGE RED OAK DARK WALNUT (Pearl) throughout staircase where applicable (x2 Flights) To Include; Staircase from Ground Floor to Main Floor, and Main Floor to 2nd Floor
Note: In Lieu of Builders Standard Natural Oak

1 - STAIRCASE - Install Upgrade Railing Package - UPGRADE PACKAGE #1A - To be installed throughout staircase, where applicable (x2 Flights) (See Sketch)
To Include;
HANDRAIL- 3" CDR
PICKETS- Steel-SingleCollar / Alt.Plain - Black
POST - Type 900 3 1/2"
Note:

55 - FOYER FLOORING - 3RD UPGRADE - PORCELAIN TILES - 12x24 NEW TECH SAVANAH - To be installed throughout foyer, where applicable. (To be Installed Straight/Stacked) (See Sketch)
Note: Includes Rectified

1,760 - KITCHEN - KITCHEN BACKSPLASH - 1ST UPGRADE - 12x12 TWILIGHT OYSTER GLASS MOSAIC - To be installed throughout kitchen backsplash, where applicable. (does not include behind the fridge or stove) (See Sketch)
Note:

1 - DISCLAIMER - THERMOFOIL CABINETRY;
KITCHEN - The purchaser was advised and therefore accepts and acknowledges that by installing thermofoil cabinets in the kitchen, Note: they may result in the cabinet peeling due to the vapor and moisture of the stove and dishwasher.

1 - KITCHEN - CABINETRY HARDWARE - Install UPGRADE #1 HARDWARE - Style # 30596-195 - To be installed throughout kitchen cabinetry, where applicable (See Sketch)
Note:

1 - KITCHEN - KITCHEN SINK - Install the Builders Standard Top Mount Sink in the kitchen - BLANCO HORIZON 2.0 (8") Top mount Sink- Model # 401124
Note:

1 - KITCHEN - KITCHEN FACUET - Install the Builders Standard Faucet in the kitchen - DELTA Chrome Pull Down Kitchen Faucet (Single Hole) - Model # 976 LF Chrome
Note:



W/Notes

SITE COPY

CONSTRUCTION SUMMARY

Forestsides Estates Inc.

PURCHASER: NAJIBUDDIN AMIR M

TEL:

LOT NUMBER	PHASE	HOUSE TYPE	CLOSING DATE
44 Block 7	6	CROCUS(cor)-ELEV B-std ground with std upper	30-Oct-19

Date Added: 12-Nov-19

Invoice Number: 7345

1 - APPLIANCE PACKAGE - Install Upgrade Appliance Package - UPGRADE APPLIANCE PACKAGE #1 - To be installed throughout house, where applicable (See Sketch) Note:
1 - KITCHEN - Install WATER LINE - ROUGH IN ONLY to Fridge at Kitchen (See Sketch) Note:
1 - MASTER ENSUITE - SHOWER STALL - Install TOE TESTER to the Standard Shower Stall in the Master Ensuite. Model #T14434-LC/R10000 (See Sketch) Note:
1 - CLARIFICATION; POWDER ROOM #1, POWDER ROOM #2, MASTER ENSUITE & MAIN BATH - Install the builders standard Plumbing Fixtures throughout all bathrooms, where applicable. To Include; Powder Room #1, Powder Room #2, Master Ensuite & Main Bath (See Sketch) Note:
1 - BONUS PACKAGE - PURCHASER HAS APPLIED \$10,000.00 (Includes Taxes) WORTH OF UPGRADE PROMOTIONAL PACKAGE TOWARDS THE PURCHASE OF UPGRADES COMPLETED AT THE DECOR CENTRE Note:
1 - PURCHASER HAS ATTENDED A COLOR APPOINTMENT AT THE DECOR CENTRE AND HAS DECLINED ANY ADDITIONAL UPGRADES. Purchaser accepts and acknowledges that there will be no further changes/additions/deletions to be made upon signing on November 12,2019 Note:
1 - PURCHASER AWARE AND ACCEPTS THAT ANY CHANGES MADE TO UPGRADES AFTER SIGNING THIS PURCHASERS EXTRA FORM ARE SUBJECT TO A MINIMUM ADMINISTRATION FEE OF \$1,000 PLUS A 10% HOLDBACK FEE. Note:

This Document is Extremely Time Sensitive - Printed 28 Nov 19 at 14:27



* INTERIOR COLOUR SCHEME *

Purchaser	Decor Consultant	Model and Elevation	Telephone Res. / Bus	Project	Closing Date	Property
NAJIBUDDIN AMIR M	Melissa Di Marino	CROCUS(cor)-ELEV B-std ground with std upper	/	Forestside Estates Inc.	30/10/2019	44 Block 7

Page 1 of 3

	Flooring	Wall Tile	Plumbing
	Description	Main Accent/Insert Border / Listello Pattern	
Master Ensuite	✓ 13x13 RUSTIC LIGHT BROWN (STD)	✓ 8x10 TUSCANY GREY (STD) NONE	WHITE
Main Bathroom	✓ 13x13 RUSTIC LIGHT BROWN (STD)	✓ 8x10 TUSCANY GREY (STD) NONE	WHITE
Powder Room #1	✓ 13x13 ACROPOLIS BEIGE (STD)	N/A N/A	WHITE
Powder Room #2	✓ 13x13 ACROPOLIS BEIGE (STD)	N/A N/A	WHITE
Kitchen/Breakfast	✓ 13x13 ACROPOLIS BEIGE (STD)	✓ 12x12 Twilight Oyster Glass Mosaic (Upg) NONE	STD
Laundry	✓ 13x13 ACROPOLIS BEIGE (STD)	N/A N/A	STD
Foyer	✓ 12x24 NEW TECH SAVANAH (STRAIGHT)(Upg)		
Main Hall	✓ 3 1/4"x3/4" Vintage RedOak DarkWalnut(Pearl)(Upg)		
Home Office	✓ 3 1/4"x3/4" Vintage RedOak DarkWalnut(Pearl)(Upg)		
Family Room	✓ 3 1/4"x3/4" Vintage RedOak DarkWalnut(Pearl)(Upg)		
Living Room	✓ 3 1/4"x3/4" Vintage RedOak DarkWalnut(Pearl)(Upg)		
Dining Room	✓ 3 1/4"x3/4" Vintage RedOak DarkWalnut(Pearl)(Upg)		
Upper Hall	✓ 3 1/4"x3/4" Vintage RedOak DarkWalnut(Pearl)(Upg)		
Master Bedroom	✓ 3 1/4"x3/4" Vintage RedOak DarkWalnut(Pearl)(Upg)		
Bedroom 2	✓ 3 1/4"x3/4" Vintage RedOak DarkWalnut(Pearl)(Upg)		
Bedroom 3	✓ 3 1/4"x3/4" Vintage RedOak DarkWalnut(Pearl)(Upg)		
Rear Yard Access	✓ STANDARD		

Railings and Stairs		Cornice Moulding / Medalion	
Railings	✓ UPG-3"CDR-Vint.RedOakDarkWalnut(Pearl)	Landing - Upper	31/4"Vint.RedOakDarkWalnut(Pearl)(y2)
Pickets	✓ UPG-Steel SingleCollar/Alt.Plain-Black	Landing - Lower	31/4"Vint.RedOakDarkWalnut(Pearl)
Posts	✓ UPG-Type900 3 1/2" Vint.RedOakDarkWalnut	Ledge - Upper	N/A
Stringers	✓ STD - Vintage Red Oak Dark Walnut (Pearl)	Ledge - Lower	N/A
Treads	✓ STD - Vintage Red Oak Dark Walnut (Pearl)		
Risers	✓ STD - Vintage Red Oak Dark Walnut (Pearl)		
Runner	N/A		
Trim			
Baseboard & Casing	✓ STANDARD	Knobs	STANDARD
Front Door Glass	✓ STANDARD	Hinges	STANDARD
Interior Doors	✓ STANDARD - CARRARA	Grip Set	STANDARD

Notes	
✓ KITCHEN - KITCHEN SINK - Install the Builders Standard top mount sink in the kitchen - BLANCO HORIZON 2.0 (8") Top mount Sink Model # 401224	
✓ KITCHEN - KITCHEN FAUCET - Install the Builders Standard faucet in the kitchen - DELTA Chrome Pull Down Kitchen Faucet (Single Hole) Model # 976 LE Chrome	

Page 1 of 3

Consultant:

Melissa Di Marino

Purchaser:

NAJIBUDDIN AMIR M

Vendor:

Forestside Estates Inc.

Printed Nov 12, 2019 11:27 am



* INTERIOR COLOUR SCHEME *

Purchaser	Decor Consultant	Model and Elevation	Telephone Res. / Bus	Project	Closing Date	Property
NAJIBUDDIN AMIR M	Melissa Di Marino	CROCUS(cor)-ELEV B-std ground with std upper	/	Forestside Estates Inc.	30/10/2019	44 Block 7

Page 2 of 3

Master Ensuite

Main Bathroom

Powder Room #1

Powder Room #2

Kitchen/Breakfast

Laundry

Foyer

Main Hall

Home Office

Family Room

Living Room

Dining Room

Upper Hall

Master Bedroom

Bedroom 2

Bedroom 3

Rear Yard Access

Interior Paint

Description

COOL WHITE

COOL WHITE

Cabinet

Style

NY THERMOFOIL - VERMONT (STD)

NY THERMOFOIL - VERMONT (STD)

N/A

N/A

NY THERMOFOIL - CHOCO CHERRY (STD)

N/A

Appliance Opening/Dimension

Fridge Size SEE NOTES

Range Std 31in Opening

Built-Ins None

Microwave None

Hood Fan See Notes

Exhaust Opening 6" 8"

Dishwasher Cabinet Std 24in Opening

Fireplace

Fireplace

N/A

Location Flooring

N/A

Style

N/A

Finish

N/A

Marble

N/A

Hearth

N/A

Page 2 of 3

Decor Consultant:

Melissa Di Marino

Purchaser:

NAJIBUDDIN AMIR M

Notes

**KITCHEN - INSTALL UPGRADE APPLIANCE PACKAGE #1 - TO BE INSTALLED THROUGHOUT HOUSE, WHERE APPLICABLE

**KITCHEN - INSTALL OVER THE RANGE MICROWAVE / HOOD FAN COMBINATION UNIT (SEE ATTACHED SPECS)

Vendor:

Forestside Estates Inc.

Printed Nov 12, 2019 11:27 am

Lot 44 / BLK 7 Forestside

Villa

KITCHENS & FINE CABINETRY LTD

8111 Jane St. Unit 10
Concord, Ontario L4K 4L7
Tel. (905) 669-7028
Fax. (905) 669-7903
email: designstudio@villakitchens.ca
www.villakitchens.ca

CLIENT: ROYAL PINE HOMES

PROJECT: FORESTSIDE

ADDRESS: RP-FS6-44 BLK 07

MODEL: CROCUS CORNER ELEV B

KITCHEN

UPGRADE APPLIANCE PKG #1

November 18, 2019




DRAWN BY: DIDI

DATE: NOV 18/2019

REVISION:

PAGE: 1 OF 6

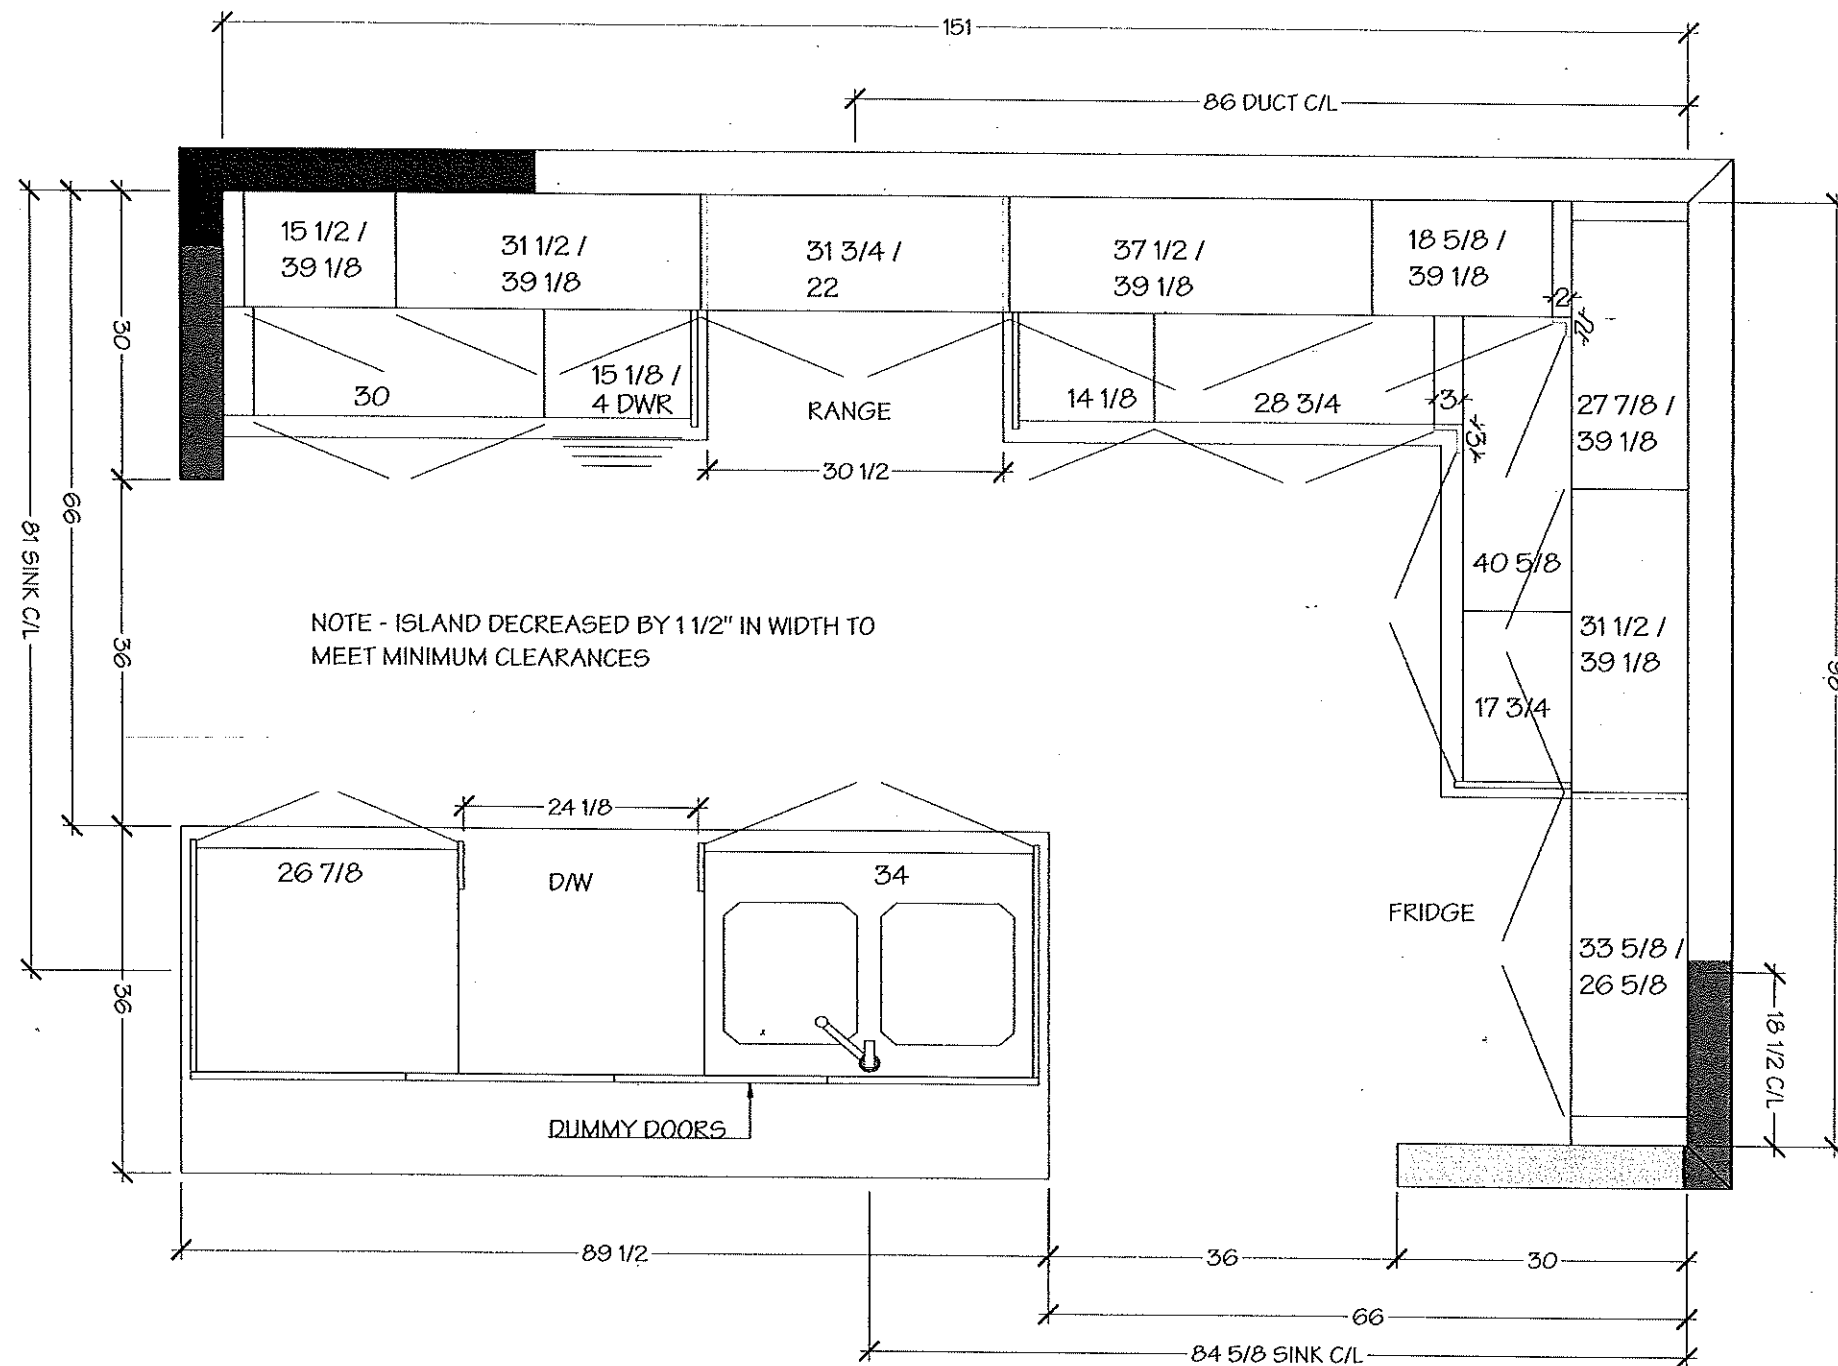

Lot 44 / BLK 7 Forestside

Villa
KITCHENS & FINE CABINETRY LTD

8111 Jane St. Unit 10
Concord, Ontario L4K 4L7
Tel. (905) 669-7028
Fax. (905) 669-7903
email: designstudio@villakitchens.ca
www.villakitchens.ca

CLIENT: ROYAL PINE HOMES
PROJECT: FORESTSIDE
ADDRESS: RP-FS6-44 BLK 07
MODEL: CROCUS CORNER ELEV B


KITCHEN

UPGRADE APPLIANCE PKG #1

November 18, 2019



DRAWN BY: DIDI
DATE: NOV 18/2019
REVISION:
PAGE: 2 OF 6

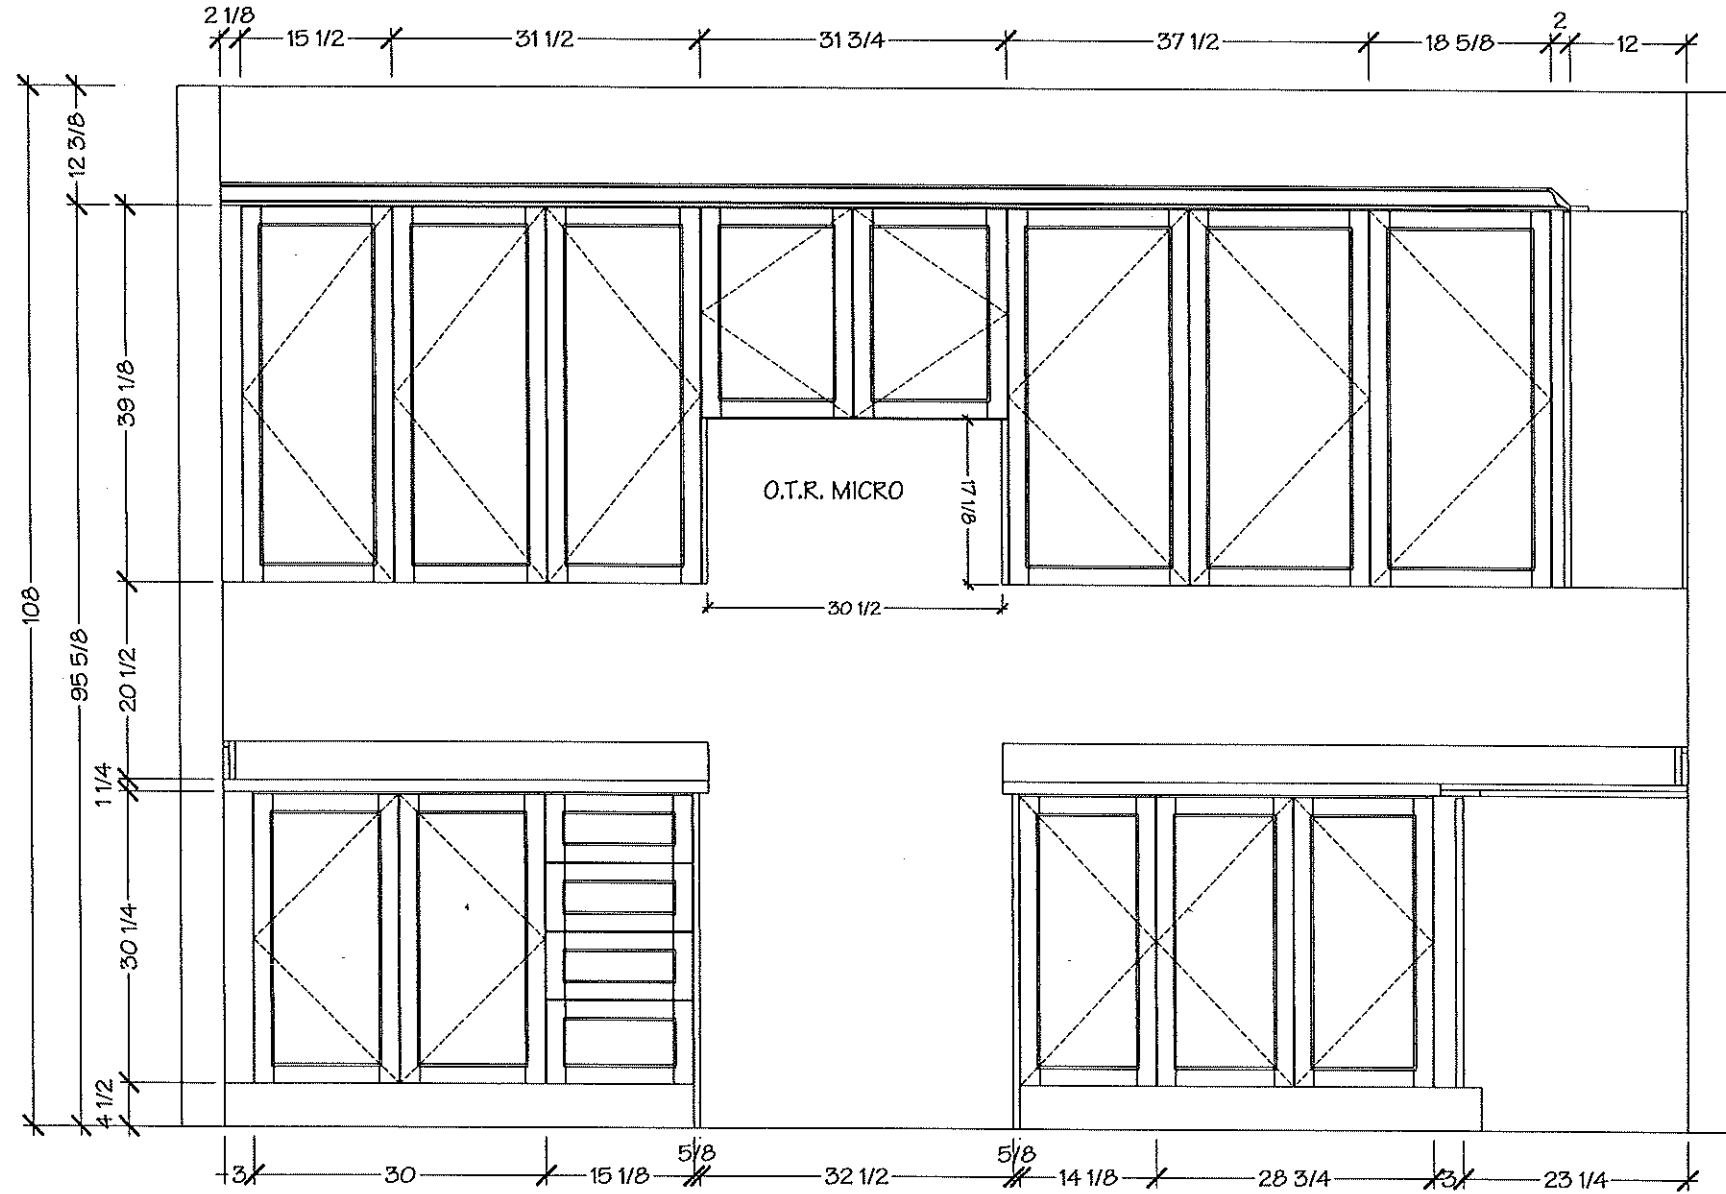

Lot 44/ BLK 7 Forestside

Villa

KITCHENS & CABINETS LTD

8111 Jane St. Unit 9
Concord, Ontario L4L 4L7
Tel. (905) 669-7993
Fax. (905) 669-7993
email: design@villakitchens.ca
www.villakitchens.ca

CLIENT: ROYAL HOMES
PROJECT: FORESTSIDE
ADDRESS: LOT 44 BLK 07
MODEL: CROOKS CORNER ELEV B

KITCHEN

UPGRADE APPLIANCE PKG #1

November 18, 2019




DRAWN BY: [initials]

DATE: NOV 18 2019

REVISION:

PAGE: 3 OF 6

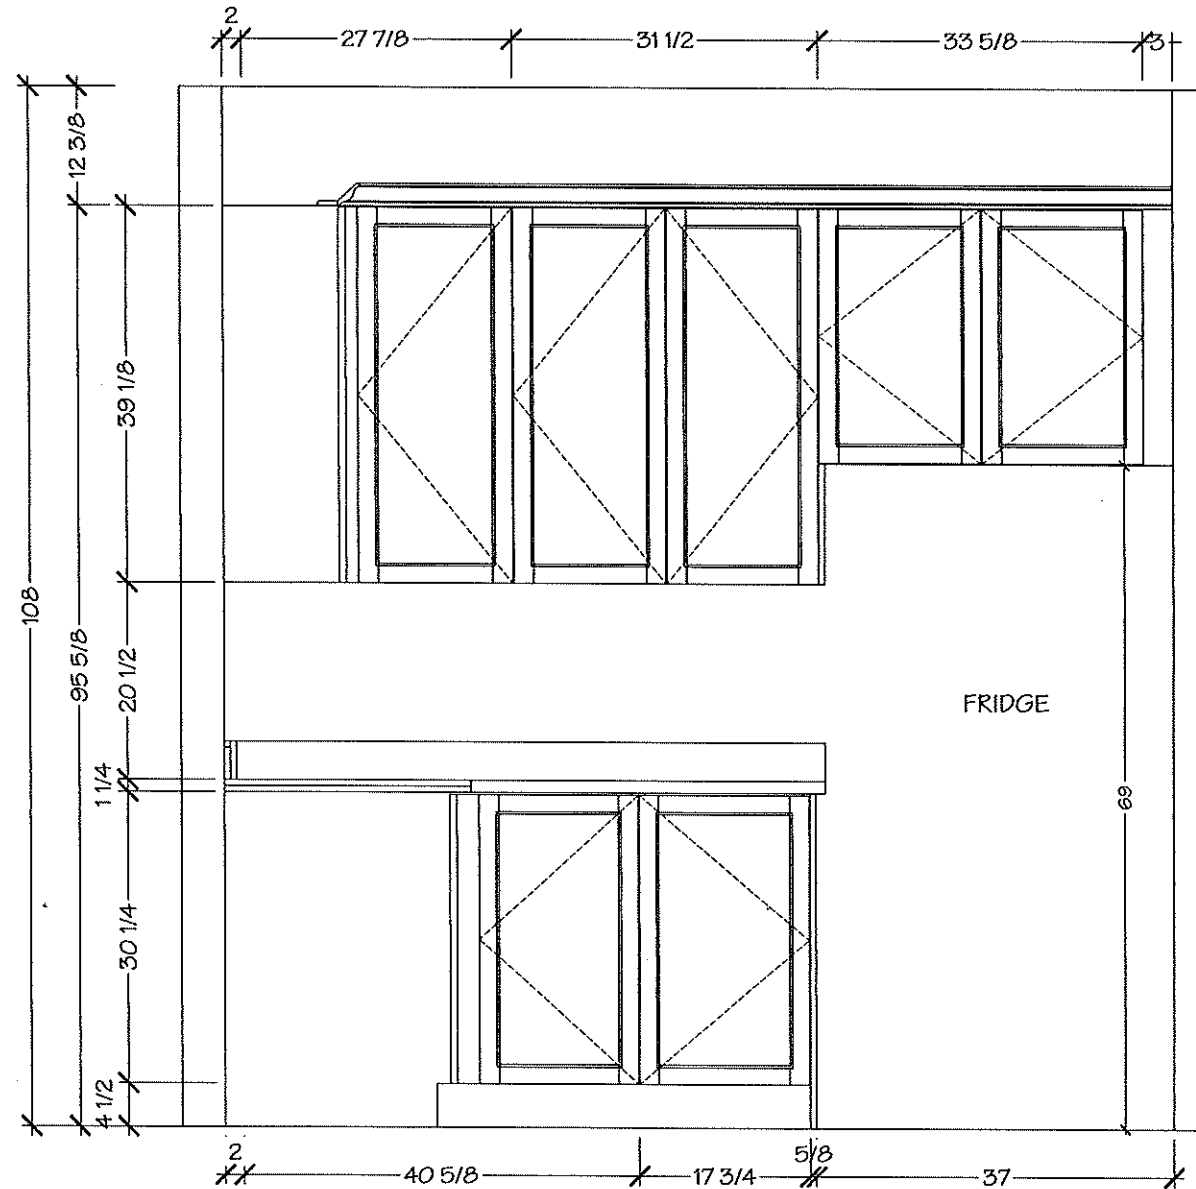

Lot 44 / BLK 7 Forestside

Villa
KITCHENS & FINE CABINETRY LTD

8111 Jane St. Unit 10
Concord, Ontario L4K 4L7
Tel. (905) 669-7028
Fax. (905) 669-7903
email: designstudio@villakitchens.ca
www.villakitchens.ca

CLIENT: ROYAL PINE HOMES
PROJECT: FORESTSIDE
ADDRESS: RP-FS6-44 BLK 07
MODEL: CROCUS CORNER ELEV B



KITCHEN

UPGRADE APPLIANCE PKG #1

November 18, 2019



DRAWN BY: DDI
DATE: NOV 18 2019
REVISION:
PAGE: 4 OF 6

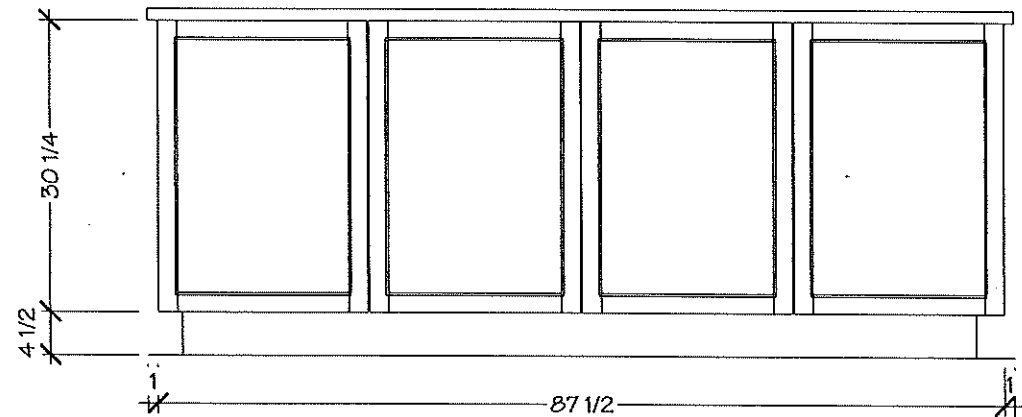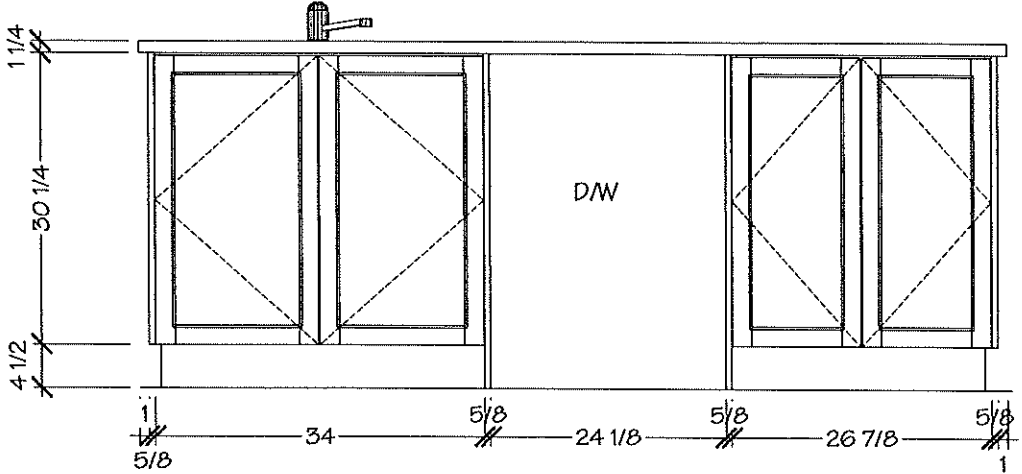

Lot 44 / BLK 7 Forestside

Villa

KITCHENS & FINE CABINETRY LTD

8111 Jane St. Unit 10
Concord, Ontario L4K 4L7
Tel. (905) 669-7028
Fax. (905) 669-7903
email: designstudio@villakitchens.ca
www.villakitchens.ca



CLIENT: ROYAL PINE HOMES
PROJECT: FORESTSIDE
ADDRESS: RP-FS6-44 BLK 07
MODEL: CROCUS CORNER ELEV B

MASTER ENSUITE

November 18, 2019



DRAWN BY: DIDI
DATE: NOV 18/2019
REVISION:
PAGE: 5 OF 6

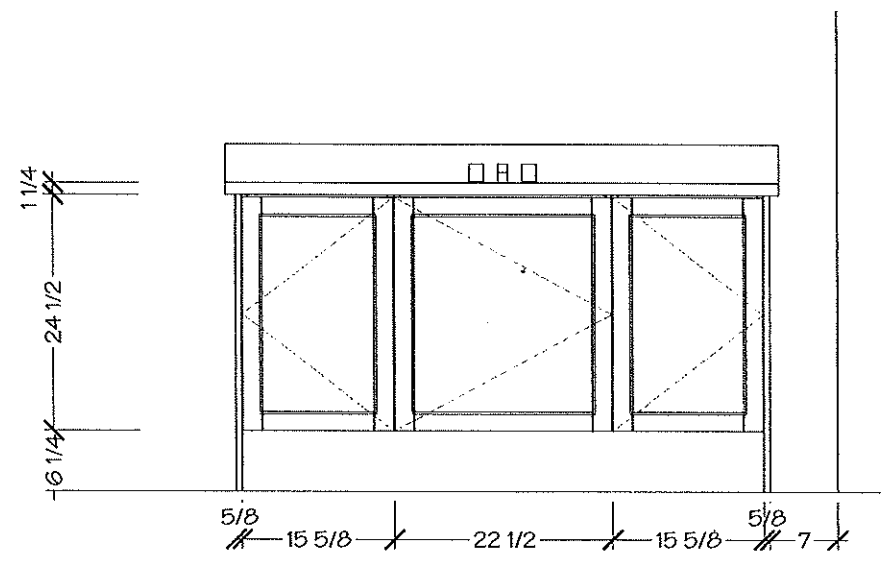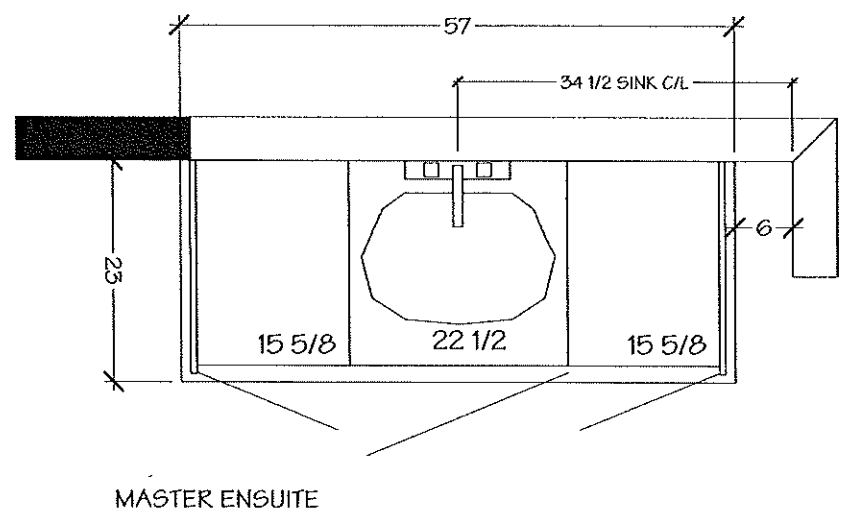

Lot 44 / BLK 7 Forestside

Villa

KITCHENS & FINE CABINETRY LTD

8111 Jane St. Unit 10
Concord, Ontario L4K 4L7
Tel. (905) 669-7028
Fax. (905) 669-7903
email: designstudio@villakitchens.ca
www.villakitchens.ca


CLIENT: ROYAL PINE HOMES
PROJECT: FORESTSIDE
ADDRESS: RP-FS6-44 BLK 07
MODEL: CROCUS CORNER ELEV B

MAIN BATH


November 18, 2019




DRAWN BY: DIDI
DATE: NOV 18/2019
REVISION:
PAGE: 6 OF 6

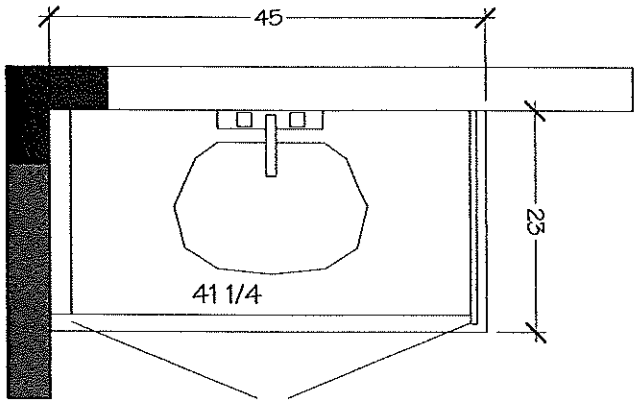

MAIN BATH

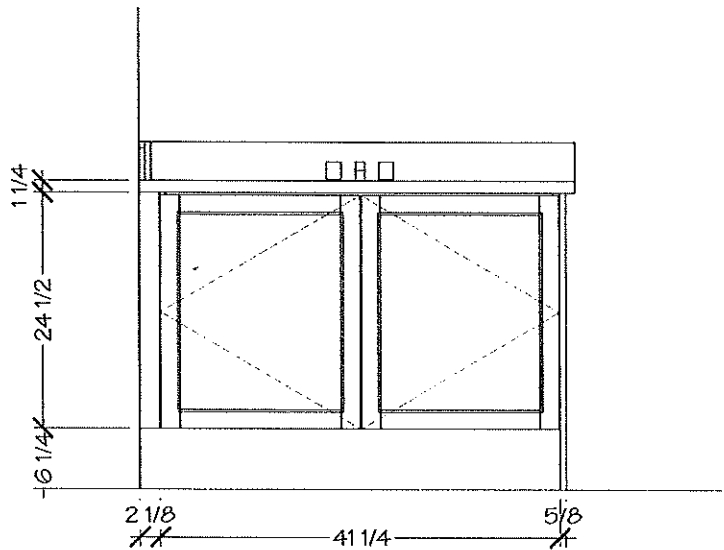

Lot 44 / Blk 7
Forestside
STANDARD SHOWER

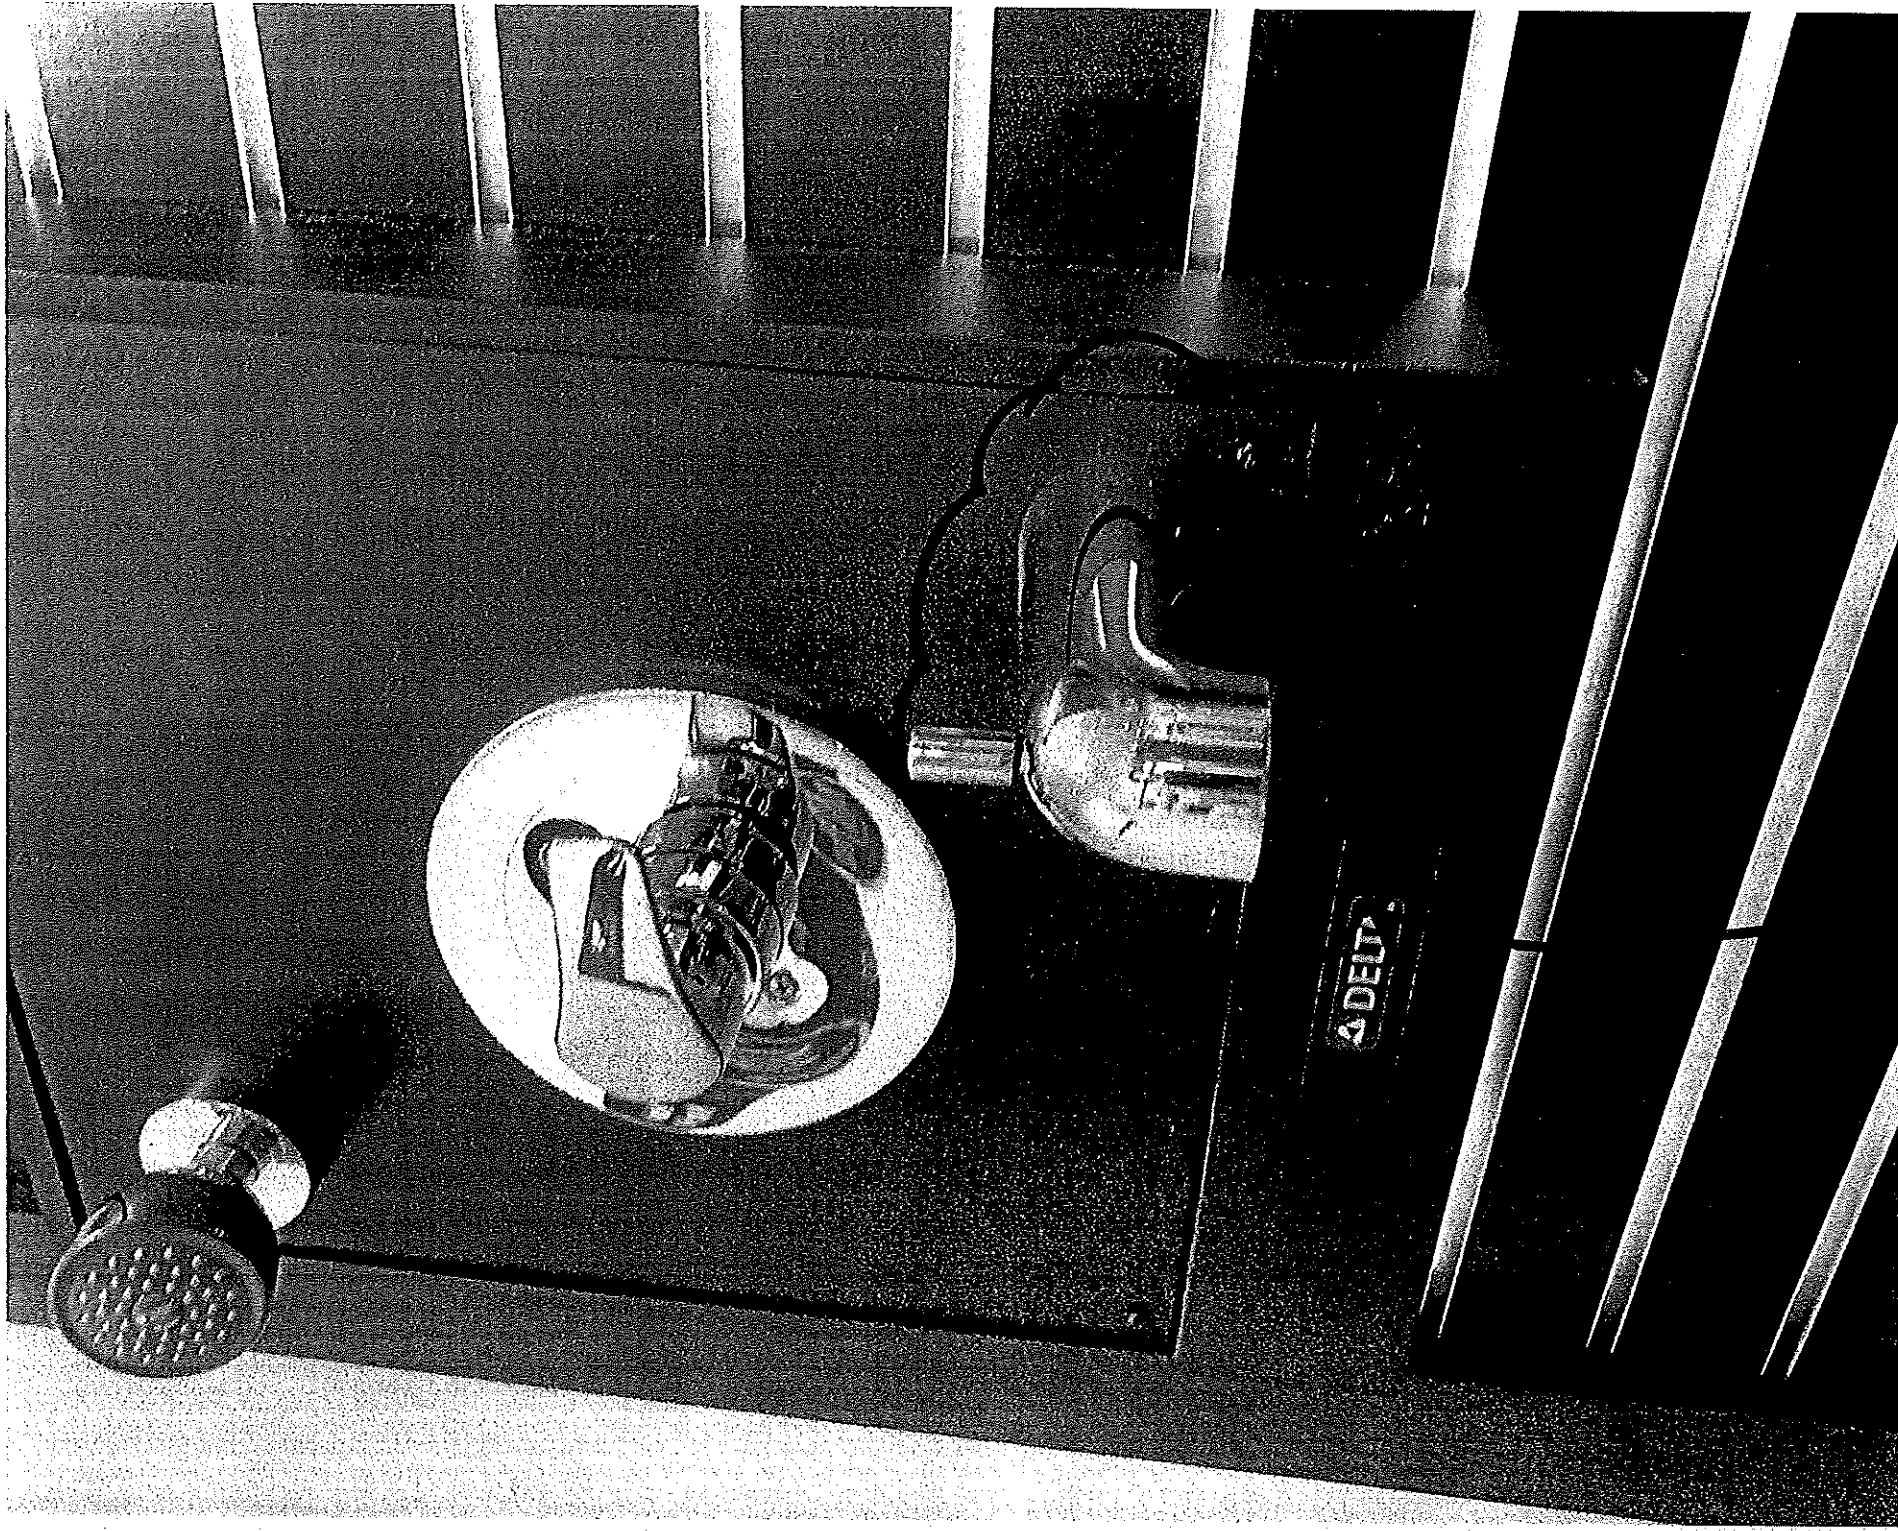

Add Toe Tester
Master Ensuite
Shower