




BLK. 4 LOT 18 ELA
MOON FLOWER
(17-04 CORNER)
2690 SQ. FT.

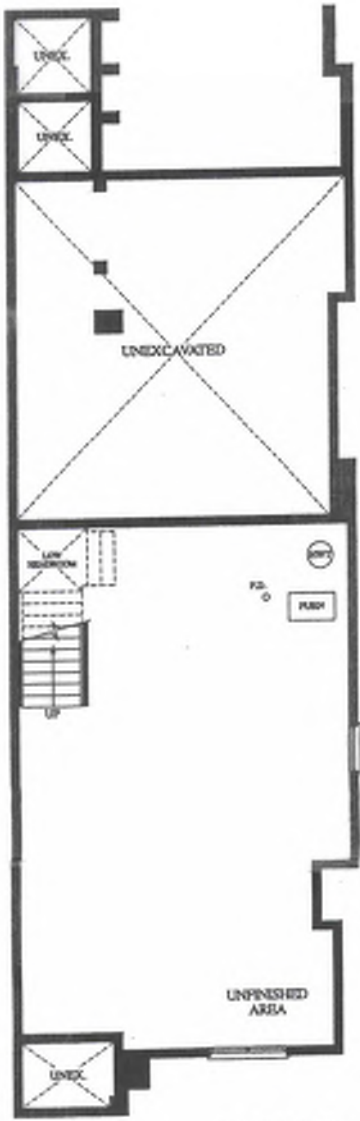


LOWER LEVEL ELEV.A

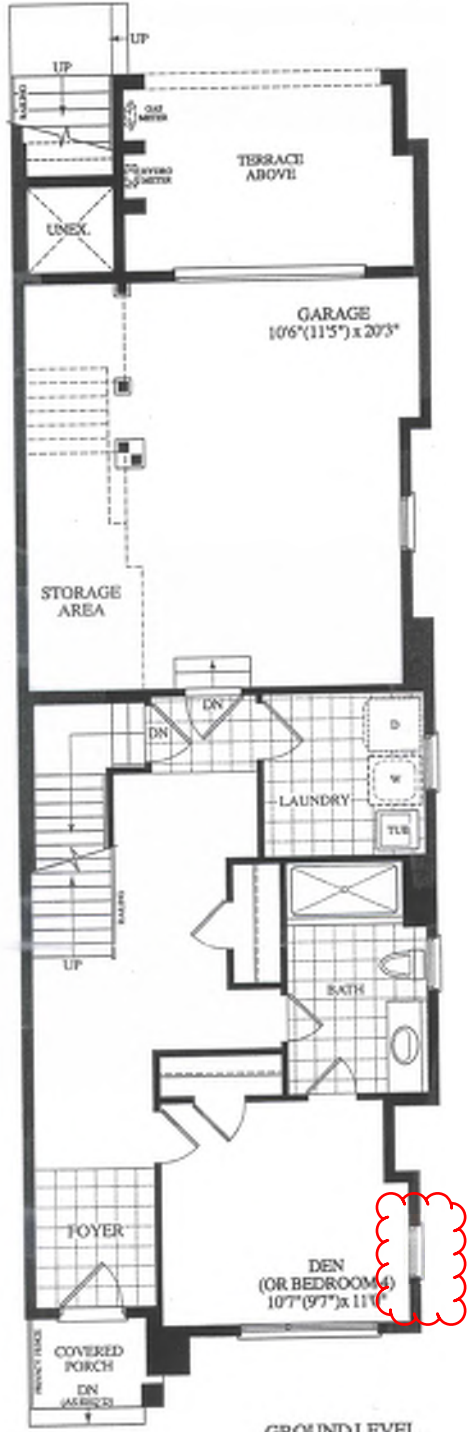

GROUND LEVEL ELEV.A

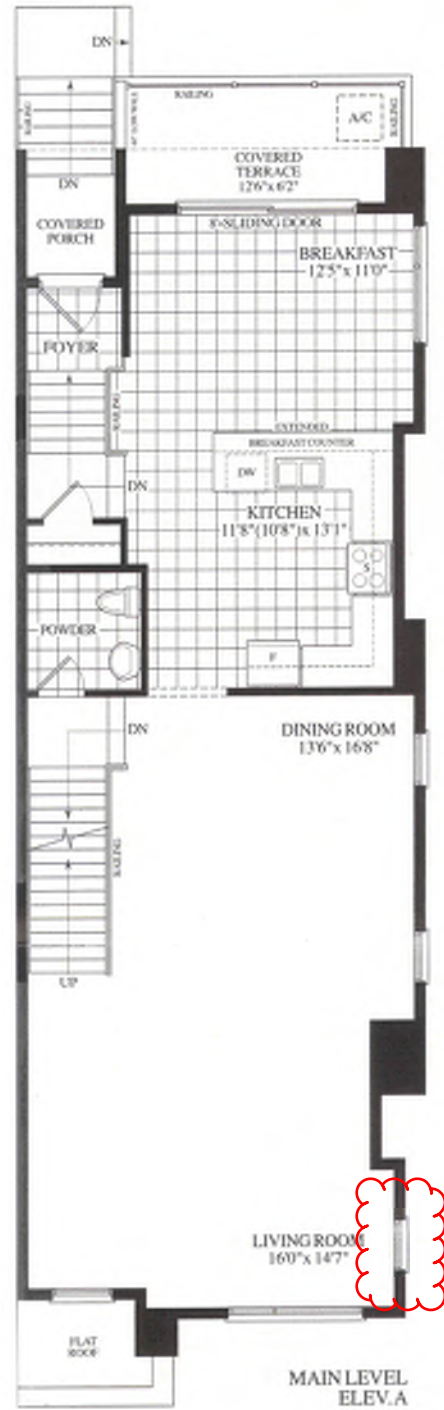

MAIN LEVEL ELEV.A

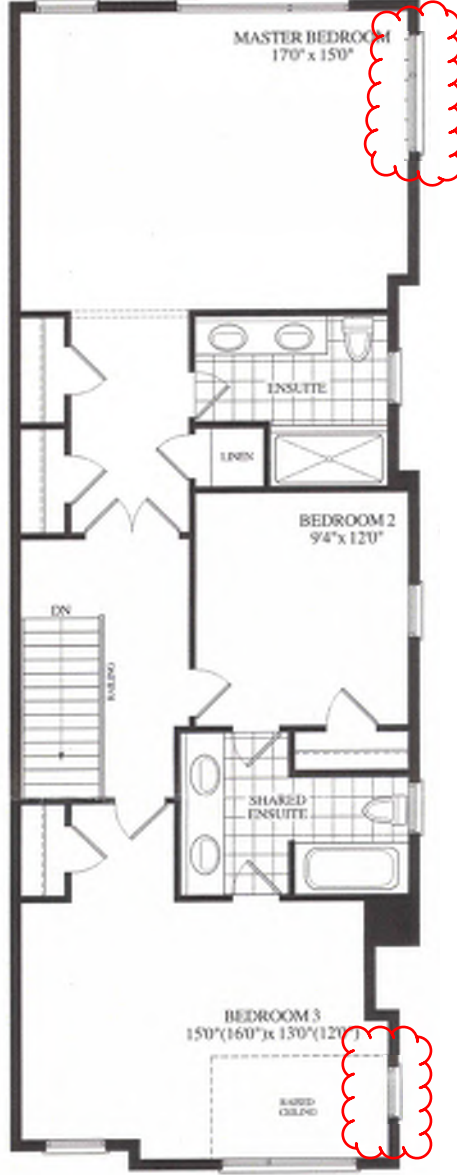

UPPER LEVEL ELEV.A



FRONT ELEVATION



REAR ELEVATION



Schedule "B"

Purchaser **BEANT K ARAICH**

And


Vendor **Forestside Estates Inc.**

Lot Number **018 Block 4 at STREET "C" Phase 6 Plan As Per Schedule C** In the City of Brampton

Dated Required: **1-Oct-20** Model: **THE MOONFLOWER-CORNER UNIT (17-04Ccor)**

Description - Vendor to Supply and Install the Following as Per Purchase Price

- BONUS PACKAGE -PURCHASER TO RECEIVE \$15,000 (INCLUSIVE OF TAXES) WORTH OF UPGRADES AT DECOR CENTRE AT TIME OF COLOUR CHART
- BONUS PACKAGE OF 5 APPLIANCES TO INCLUDE FRIDGE, STOVE, DISHWASHER, WASHER AND DRYER AS PER VENDORS SAMPLES
- CHOICE OF COLOUR (FROM VENDORS SAMPLES) FOR 7 1/2 INCH LAMINATE ENGINEERED FLOORING IN ALL AREAS NOT COVERED WITH CERAMIC TILES ON MAIN/GROUND LEVEL, INCLUDING STAIR LANDINGS AS PER PLAN.
- COMPLETE AIR CONDITIONING SYSTEM, AS PER VENDORS STANDARD SAMPLES AND SPECIFICATIONS

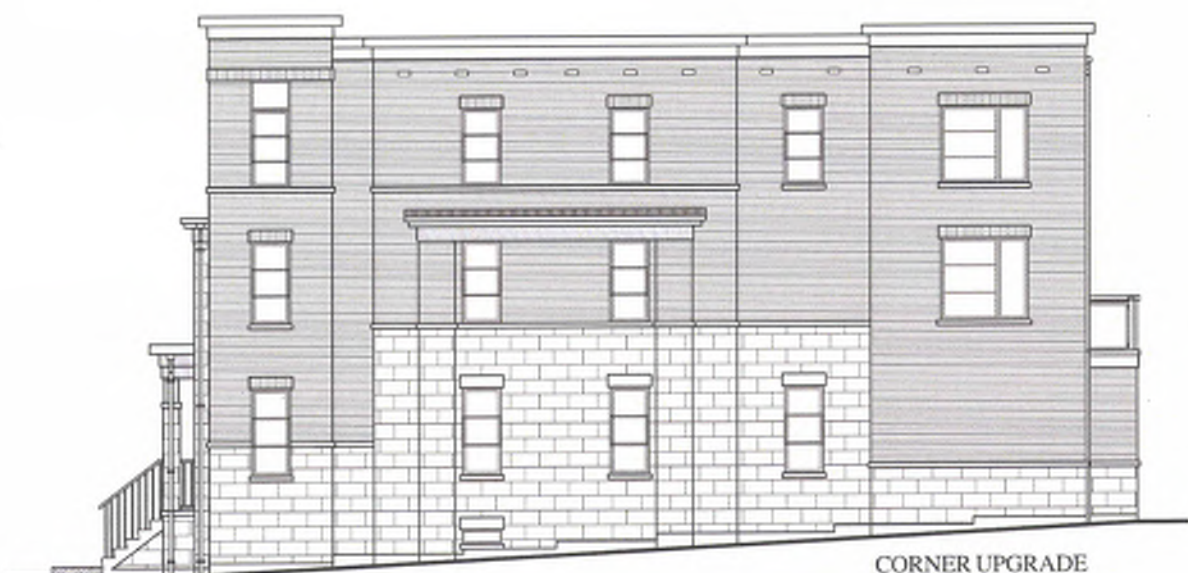

CORNER UPGRADE
RIGHT SIDE-ELEV.A