
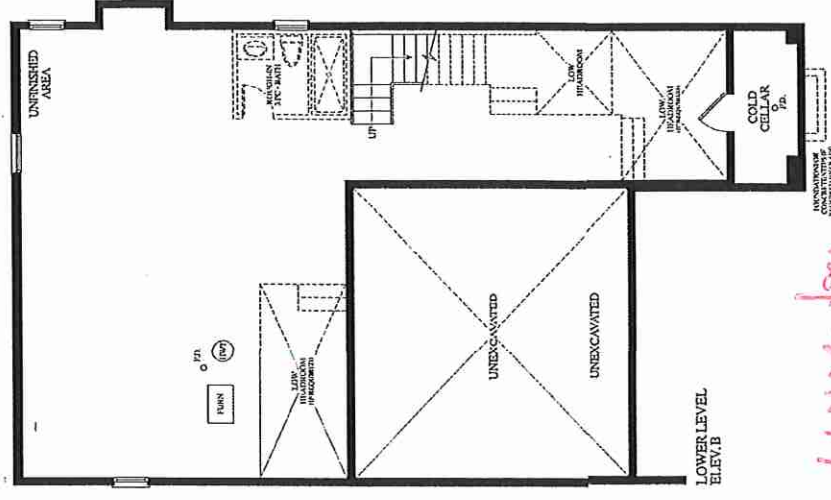
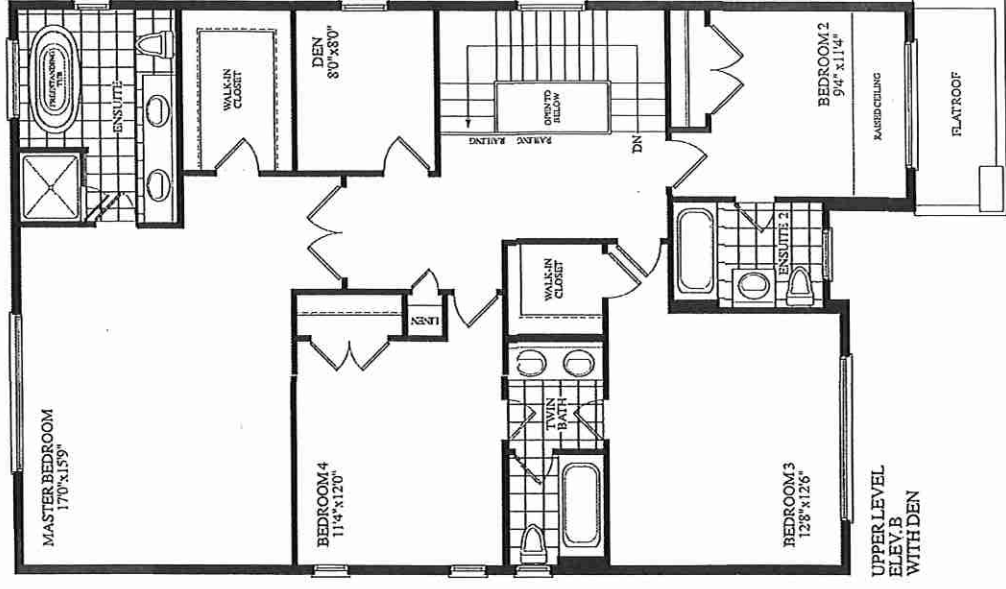


THE CHADWICK ⁽³⁸⁻¹³⁾

ELEVATION B
2600
SQUARE FEET
INCLUDES 17 SQ. FT. OPEN AREA

38' LOTS

INVENTORY
38-13 CHADWICK
Opt. Main-Laundry on Main
EL.B - LOT 20

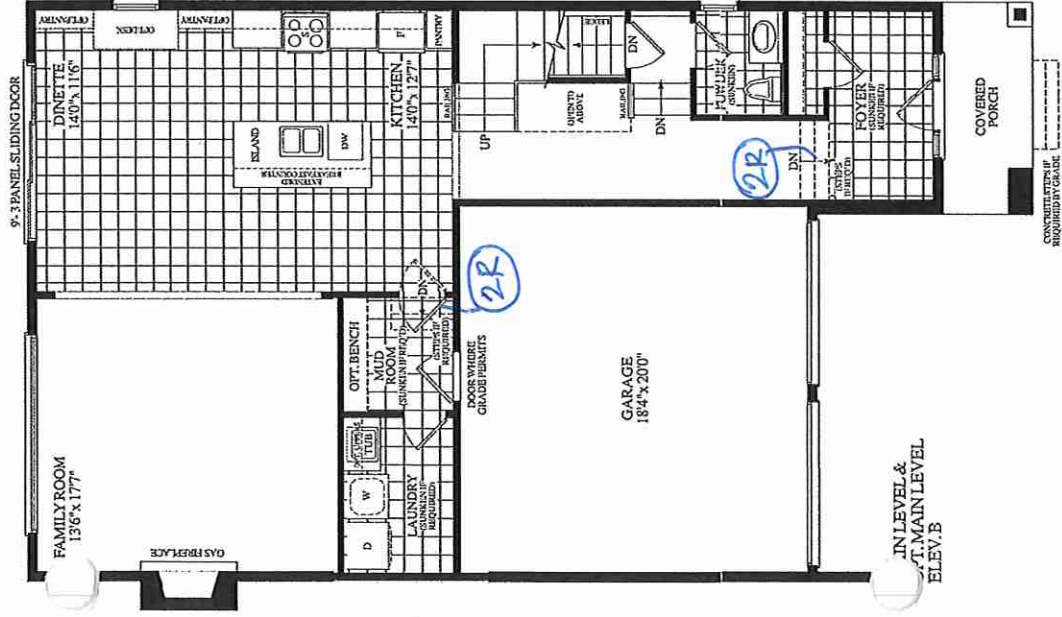

ELEVATION B
2600
SQUARE FEET



LOT# ZQ-1 INVENTORS



As a result, investigations and discussions are subject to change with duration. All results are preliminary. A floor is laid in the interim—time helps. As a result, floor services are only from the national board and BLS.