

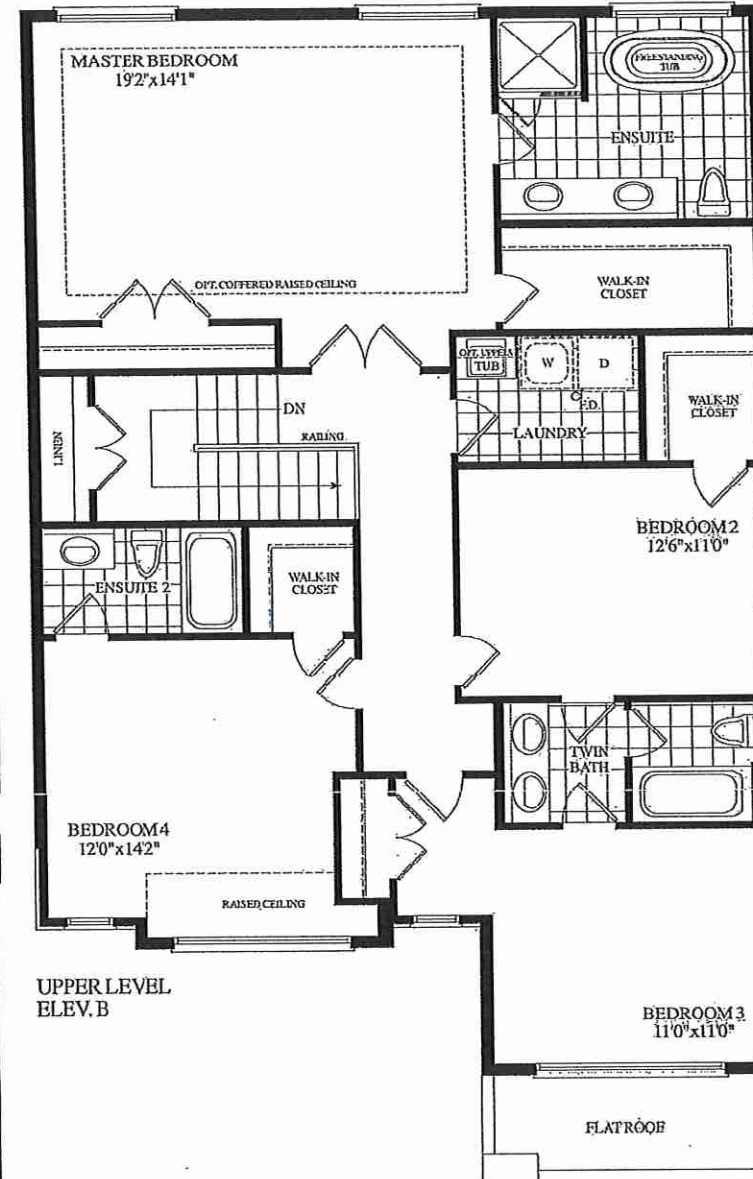


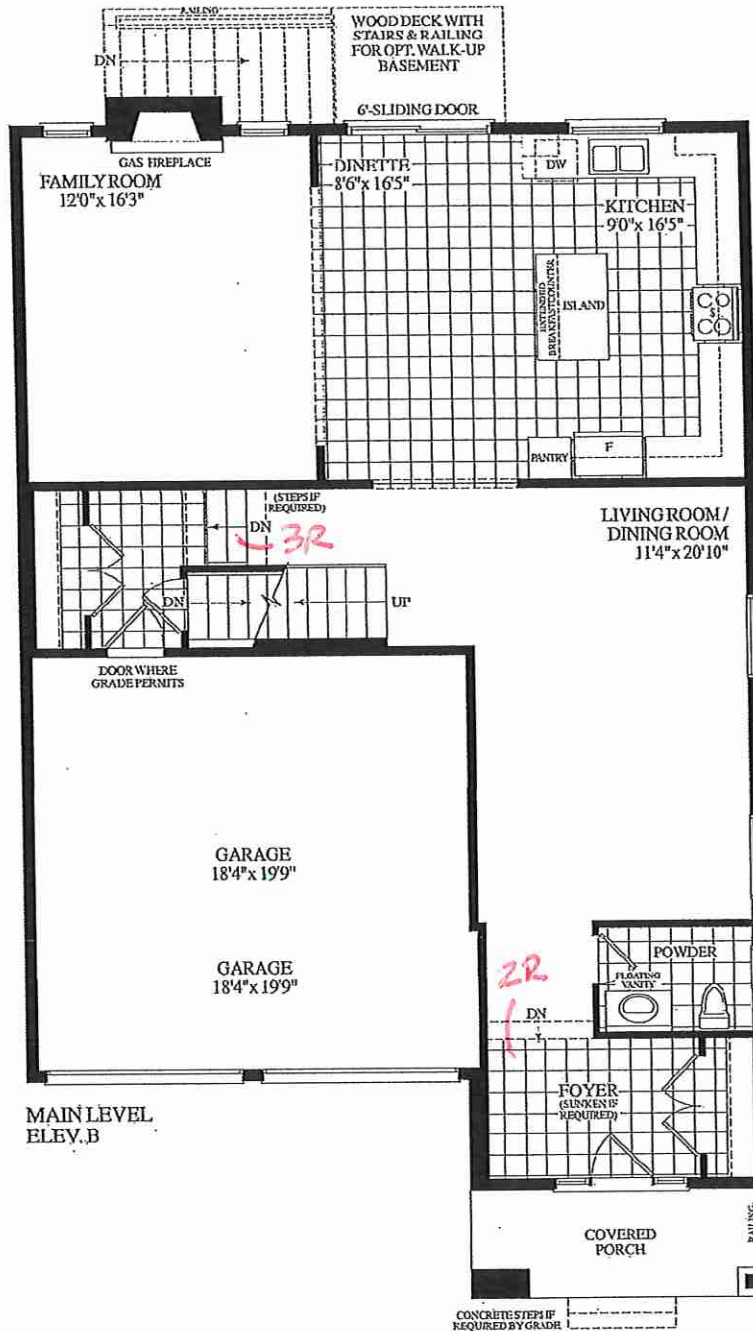

Dimensions, specifications, layouts, window sizes, materials are approximate only, may vary, and are subject to change as provided in the Agreement of Purchase & Sale. Plans may be revised. Illustrations are artist's concept. E2O.E.

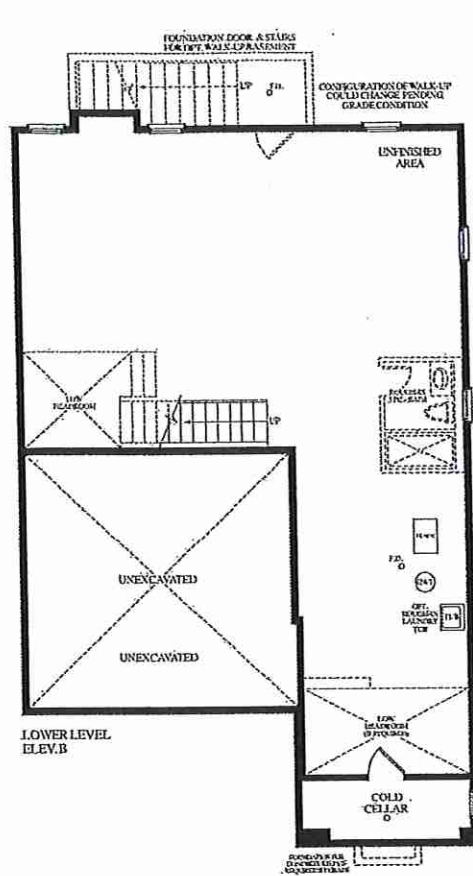

SCHEDULE "B"

Purchaser HUO, AN CAO,
Purchaser JANICE GIANG
And
Vendor Grovetrail Developments Inc.
Lot Number 23 Longworth Avenue, Phase 1, Plan AS PER SCHEDULE C in the City of Richmond Hill
Date of Offer March 28, 2021
Dated Required: February 23, 2022 Model: BELVEDERE (38-11B) ELEV B ()

Description - Vendor to Supply and Install the Following as Per Purchase Price

- BONUS PACKAGE FOR 38' DETACHED: PURCHASER TO RECEIVE \$15,000.00 (INCLUSIVE OF TAXES, WORTH OF UPGRADES AT DECOR CENTRE AT TIME OF COLOUR CHART

