
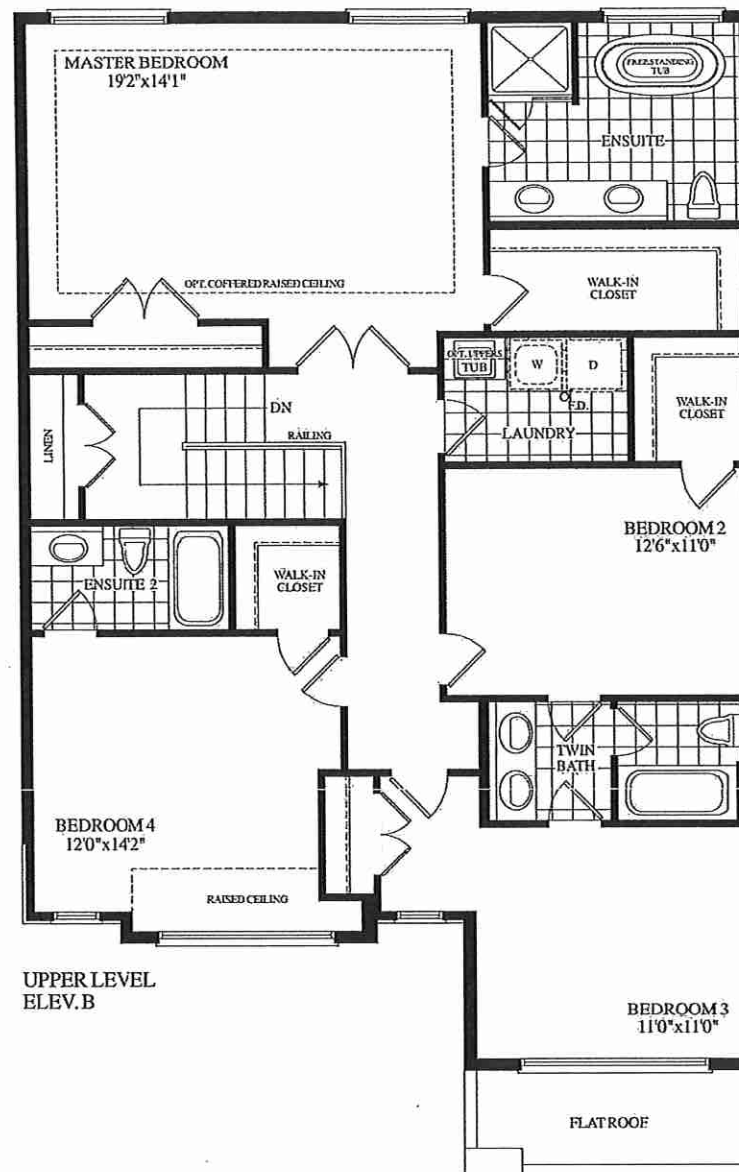
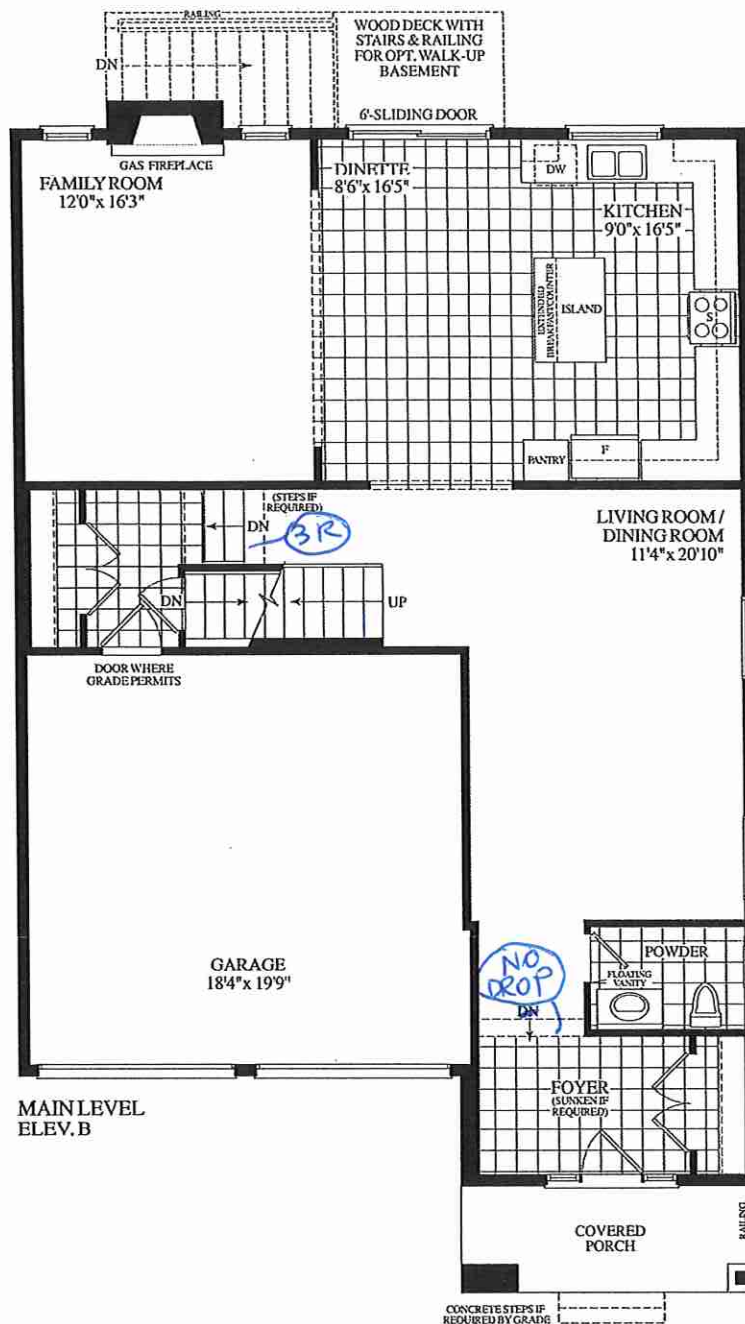


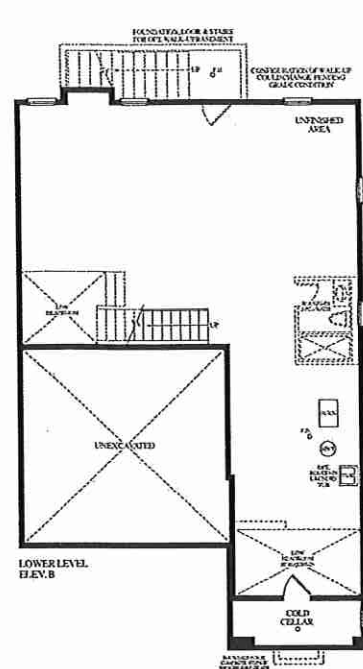

SCHEDULE "B"

Purchaser	PENG WANG,
Purchaser	YING ZHAO,
And	
Vendor	Grovetrail Developments Inc.
Lot Number	32 Longworth Avenue, Phase 1, Plan AS PER SCHEDULE C in the City of Richmond Hill
Date of Offer	March 27, 2021
Dated Required:	March 02, 2022 Model: BELVEDERE (38-11B) ELEV B ()

Description - Vendor to Supply and Install the Following as Per Purchase Price

- BONUS PACKAGE FOR 38' DETACHED: PURCHASER TO RECEIVE \$15,000.00 (INCLUSIVE OF TAXES) WORTH OF UPGRADES AT DECOR CENTRE AT TIME OF COLOUR CHART



Dimensions, specifications, layouts, window sizes, and materials are approximate only, may vary, and are subject to change as provided in the Agreement of Purchase & Sale. Plans may be reversed. Illustrations are artist's concept. E.O.E.