

(38-08)

2370

2370

SQUARE FEET
INCLUDES 11 SQ.FT. OPEN AREA





38' LOTS

INVENTORY

38-08 ASHTON EL.A

OPT. MAIN - 3 BATHS

LOT 29

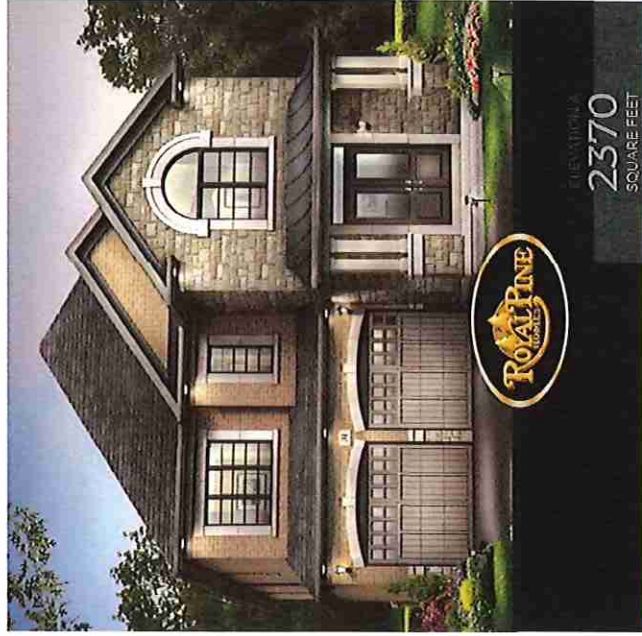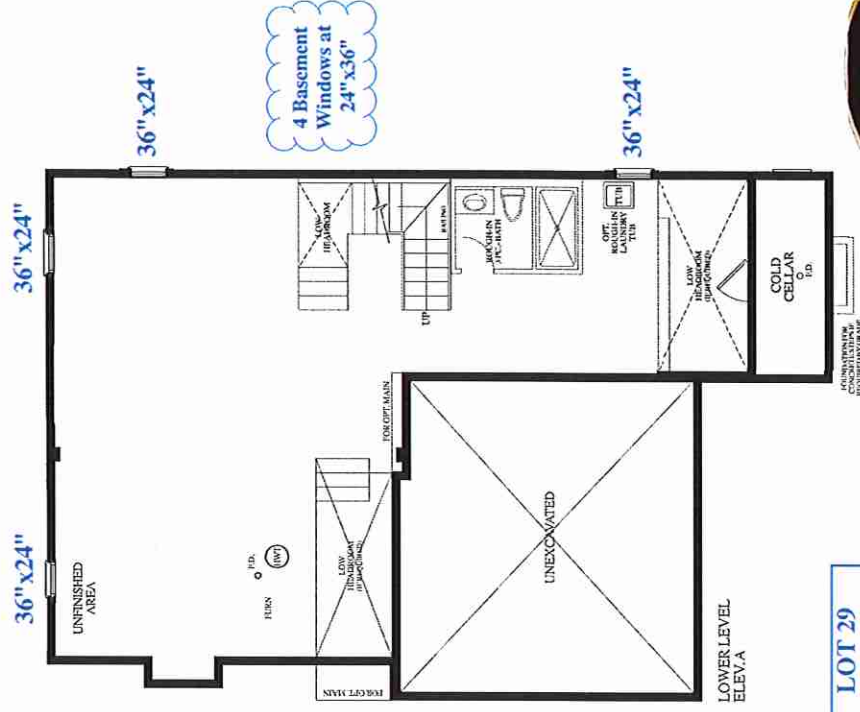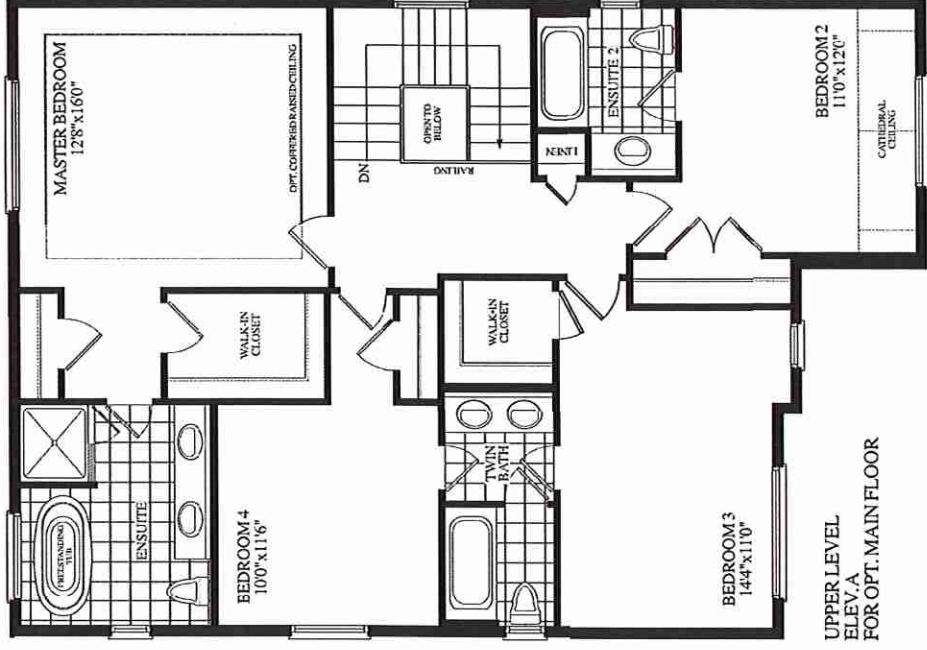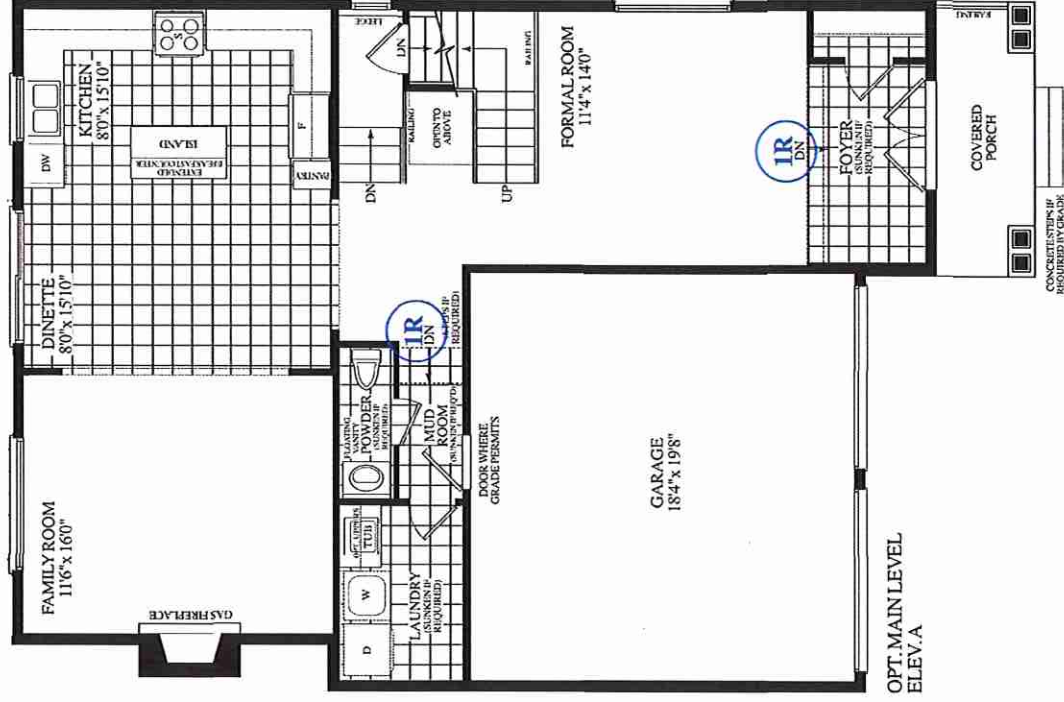

Materials, specifications and floor plans are subject to change without notice. All renderings are artist's concept. All floor plans are approximate dimensions. Actual floor plans may vary from the stated floor area. E&OE.