



INVENTORY
38-13 CHADWICK
Opt. Main-Laudry on Main
EL.B- LOT 20

FOUNDATION STAGE
CAPPED FLOOR ONLY

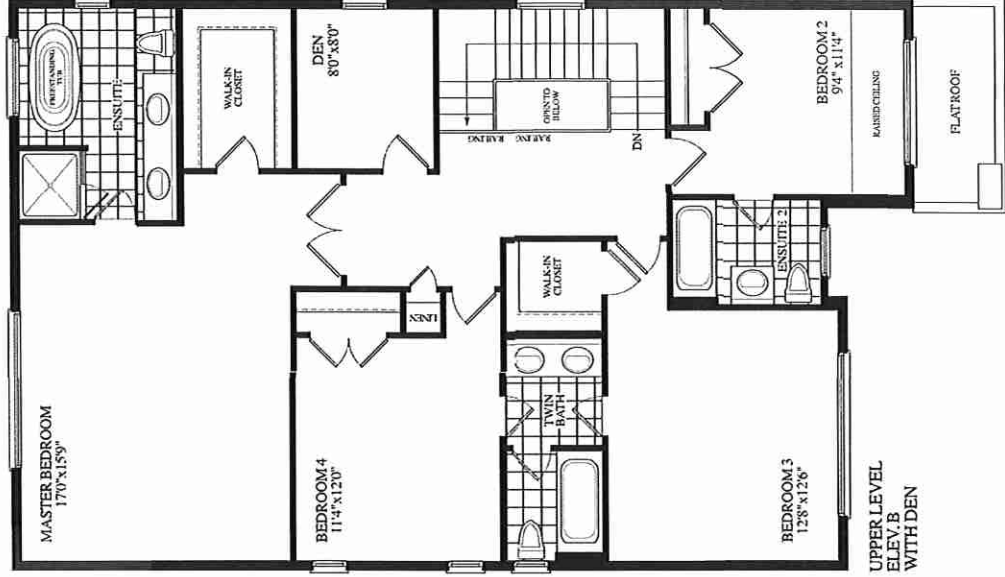

(x1) 36" x 24" basement window

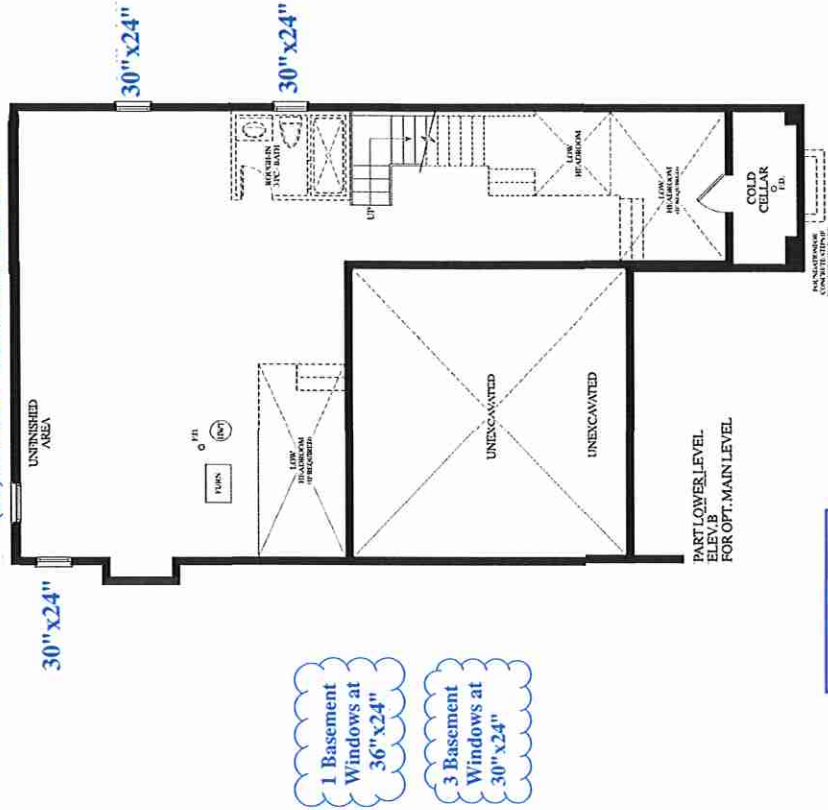

ELEVATION B
2600
SQUARE FEET

LOT 20
INVENTORY

