


INVENTORY
38-13 CHADWICK
Opt. Main-Laudry on Main
EL.C - LOT 21
Walk up


NO PERMIT
NO EXCAVATION

Deck Above
approximate
10'x5'

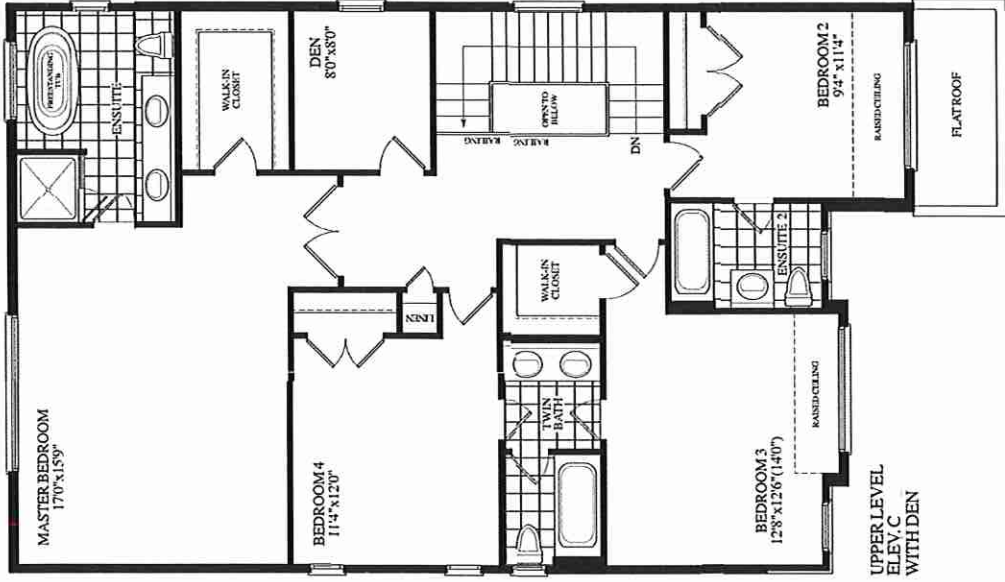

WALK UP

Deck Above
approximate
10'x5'

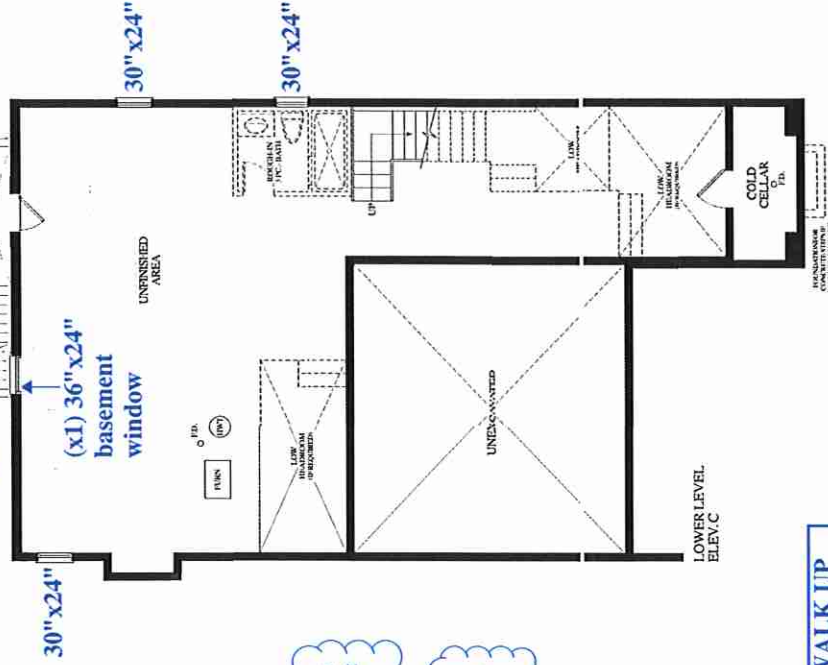

1 Basement
Windows at
36" x 24"

3 Basement
Windows at
30" x 24"



ELEVATION C
2600
SQUARE FEET

WALK UP
INVENTORY
LOT 21

