
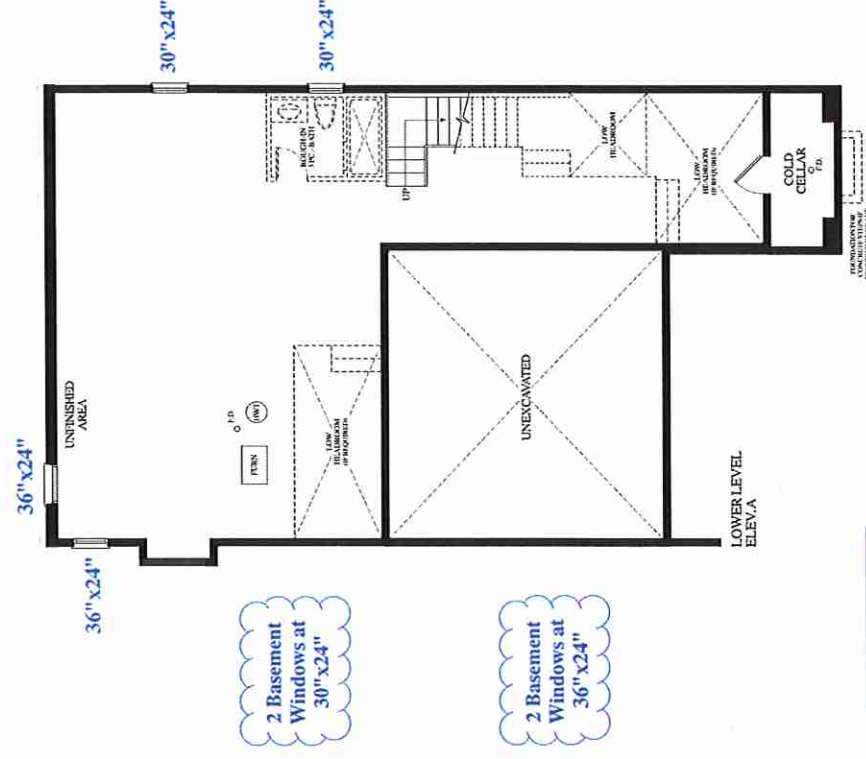


INVENTORY
38-13 CHADWICK
Opt. Main-Laundry on Main
EL.A - LOT 36

**NO PERMIT
NO EXCAVATION**

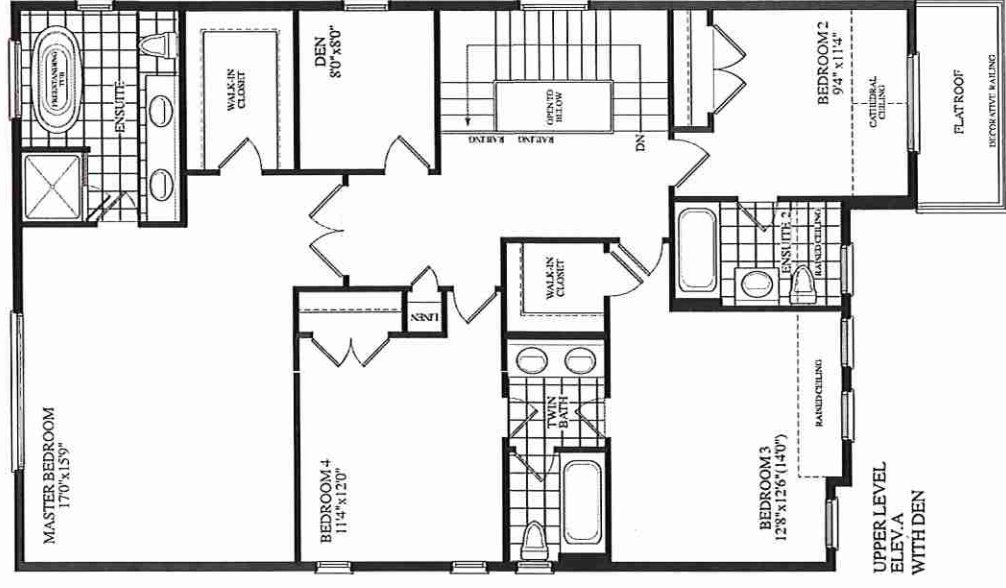

ELEVATION A
2600
SQUARE FEET

INVENTORY
LOT 36

