

SITE STATISTICS				
ITEM		PROPOSED		
LOT FRONTAGE	11.6 m	38'-1"		
LOT AREA	313.20 sq.m	3371.28 sq. ft.		
MAX. ALLOWABLE COVERAGE (%)		50		
BUILDING COVERAGE CALCULATION	COVERAGE W/O PORCH		151.80 sq.m	
	LOT COVERAGE		48.47 %	
BUILDING HEIGHT CALCULATION	FIN. FLOOR ELEV.	AVG. (EST.) GRADE	FF TO AVG. GRADE	FF TO MEAN OF ROOF
	295.98	295.07	0.91	7.46 m
PROP. BUILDING HEIGHT	8.37 m	27'-6"		
MAX BUILDING HEIGHT	12m FROM AVG. GRADE TO MEAN			

FRONT YARD LANDSCAPE AREA	
FRONT YARD AREA :	49.67 m2
DRIVEWAY AREA:	31.50 m2
COVERED PORCH AREA:	0.00 m2
SOFT LANDSCAPE AREA :	18.17 m2
LANDSCAPE / OPEN SPACE:	36.58 %


City File D19-20001	
MODEL NO.	3814
HOUSE STYLE (I.E. BUNGALOW, WALKOUT ETC.)	2 STOREY
BUILDING CLASSIFICATION	GROUP C
	-

W Architect Inc.
DESIGN CONTROL REVIEW

AUG. 09, 2021

FINAL BY: MMI

This stamp is only for the purposes of design control and carries no other professional obligations.

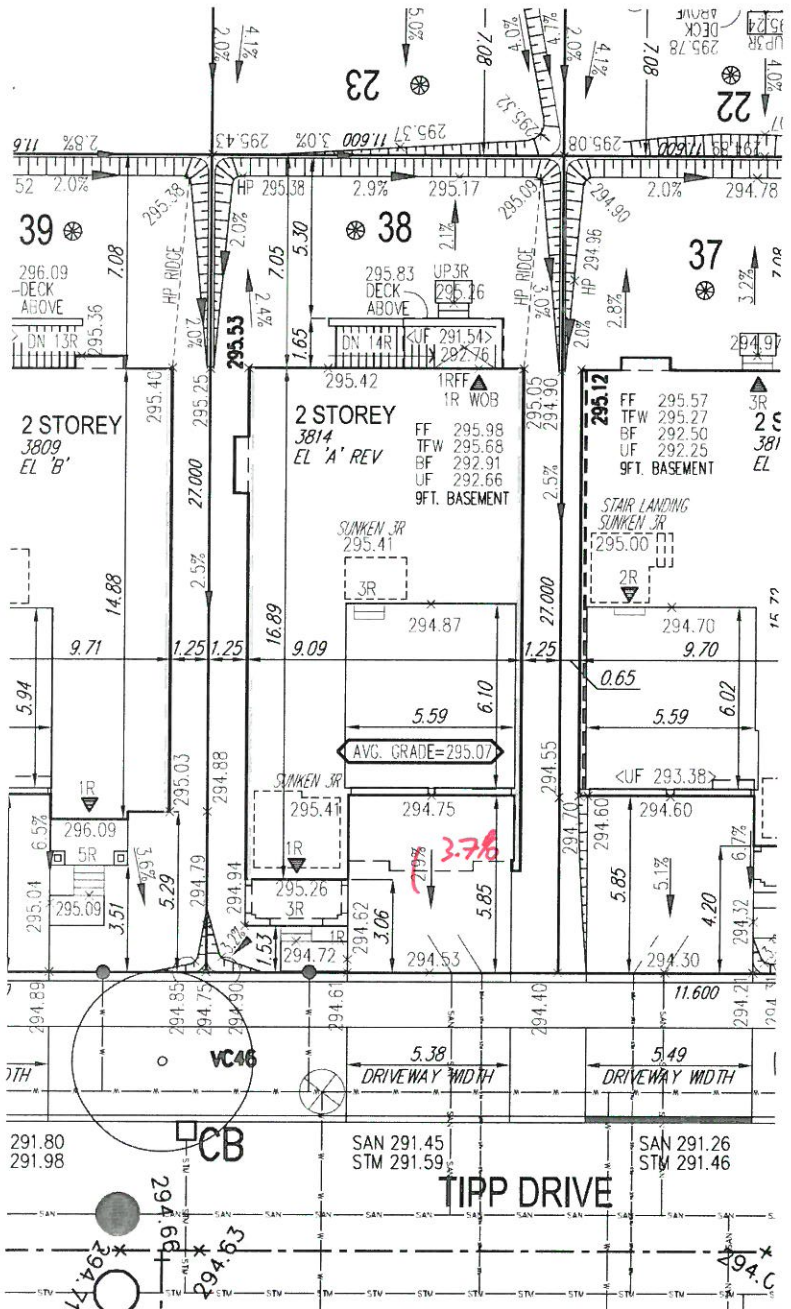

N.T.S.

KEY MAP

Subject LOT

REVIEWED ONLY AS TO GENERAL COMPLIANCE WITH THE INTENT OF THE GRADING AND SERVICING DRAWINGS. THE ENGINEER DOES NOT WARRANT THAT THE INFORMATION CONTAINED ON THIS PLAN IS EITHER ACCURATE OR CORRECT. SOLE RESPONSIBILITY FOR CORRECT DESIGN, DETAILS AND DIMENSIONS WILL REMAIN WITH THE PARTY SUBMITTING THE DRAWING.

- ☐ REVIEWED
☒ REVIEWED AS NOTED
☐ REVISE AND RESUBMIT

The MUNICIPAL INFRASTRUCTURE Group Ltd.


Date: Aug 4 2021

By: [Signature]

GENERAL NOTES:

- BUILDER TO VERIFY LOCATION OF UTILITIES AND OTHER SERVICES. IF MIN. DIMENSIONS ARE NOT MAINTAINED, BUILDER IS TO RELOCATE AT BUILDER'S EXPENSE.
- BUILDER TO VERIFY ELEV. OF STM. AND SAN. LATERALS IN RELATION TO BASEMENT U/S OF FOOTING ELEVATIONS FOR COMPLIANCE WITH MUNICIPAL STANDARDS PRIOR TO EXCAVATION.
- APPROVED PERMIT DRAWINGS & CONSTRUCTION NOTES MUST BE REVIEWED AND FOLLOWED IN CONJUNCTION WITH THE SITING AND GRADING PLAN. BUILDER TO VERIFY BUILDING ENVELOPE ON SITE PLAN MATCHES APPROVED PERMIT DRAWINGS & CONSTRUCTION NOTES PRIOR TO POURING CONCRETE. IF THERE ARE ANY DISCREPANCIES, THEY ARE TO BE BROUGHT TO THE ATTENTION OF HUNT DESIGN ASSOCIATES INC.
- UNLESS NOTED ON BUILDING ENVELOPE OR APPROVED PERMIT DRAWINGS & CONSTRUCTION NOTES, ALL TOP OF FOUNDATION WALLS INCLUDING GARAGE WALLS TO BE CONSISTENT WITH THE ELEVATION PROVIDED FOR TFW ON SITING AND GRADING PLAN. THE EXTERIOR OF THE FOUNDATION WALL TO BE PROVIDED WITH A REDUCTION OF THICKNESS FOR MASONRY VENEER AS REQUIRED.

ISSUED FOR FINAL APPROVAL	DS	2021.07.28
ISSUED FOR PRELIMINARY APPROVAL	DS	2021.07.13

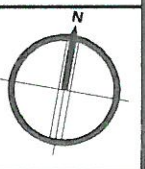

ENGINEERED FILL LOTS	SANITARY MANHOLE	WATER SERVICE	BELL PEDESTAL	HYDRO TRANSFORMER	SANITARY LINE	DOWNSPOUTS	SUMP PUMP AND SURFACE DISCHARGE LOCATION	FF FINISHED FLOOR
STREET TREE	STORM MANHOLE	HYDRO SERVICE	CABLE PEDESTAL	PAD MOUNTED MOTOR	STORM WATER LINE	WINDOWS PERMITTED	UPGRADE ELEVATION	TFW TOP OF FOUNDATION WALL
RETAINING WALL	VALVE & CHAMBER	SHEET DRAINAGE	HYDRO POLE	EXISTING GRADES	WATERLINE	45 MINUTE FIRE RATED WALL	FENCE AND GATE	BF BASEMENT FLOOR
CATCH BASIN	VALVE & BOX	STREET LIGHT PEDESTAL	HYDRO POLE GUY	190.10 PROPOSED GRADES	HYDRO LINE	(NO WINDOWS PERMITTED)	PRIVACY FENCE	UF UNDERSIDE OF FOOTING
DOUBLE / SINGLE STM & SAN CONNECTION	HYDRANT	STREET LIGHT	STREET SIGN	2.0% SWALE DIRECTION	GAS LINE	EXTERIOR DOOR LOCATION	ACUSTIC FENCE	WOB WALKOUT BASEMENT
		TRAFFIC SIGNAL POWER PEDESTAL	COMMUNITY MAILBOX	EMBANKMENT / BERM MAX 3:1 SLOPE	CABLE LINE	EXTERIOR DOOR LOCATION IF GRADE PERMITS		MOD MODIFIED
					BELL			REV REVERSED
					HYDRO, GAS, BELL, CABLE LINE			ND NO DOOR
								(XXXXXX) HIGHLIGHTED GRADE

SITING AND GRADING PLAN

THE UNDERSIGNED HAS REVIEWED AND TAKES RESPONSIBILITY FOR THIS DESIGN AND HAS THE QUALIFICATIONS AND MEETS THE REQUIREMENTS SET OUT IN THE ONTARIO BUILDING CODE TO BE A DESIGNER.

QUALIFICATION INFORMATION

DEREK R. SANTOS

37308

NAME

SIGNATURE

BCIN

REGISTRATION INFORMATION

HUNT DESIGN ASSOCIATES INC.

19695

HUNT DESIGN ASSOCIATES INC.

www.huntdesign.ca

Royal Pine Homes / Centerfield Properties Inc - 216102 "OAKRIDGE MEADOWS", RICHMOND HILL, ON

Drawn By DS Checked By DS Scale 1:250 File Number 216102-SP01.DWG Lot / Page Number 38

8966 Woodbine Ave, Markham, ON L3R 0J7 T 905.737.5133 F 905.737.7326