


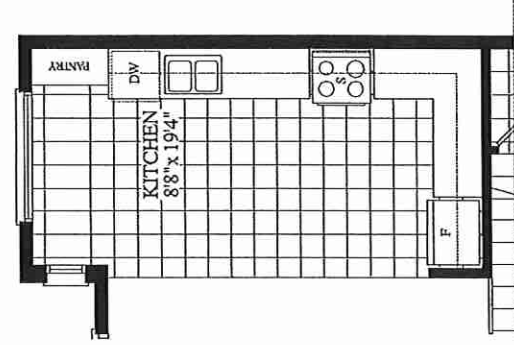
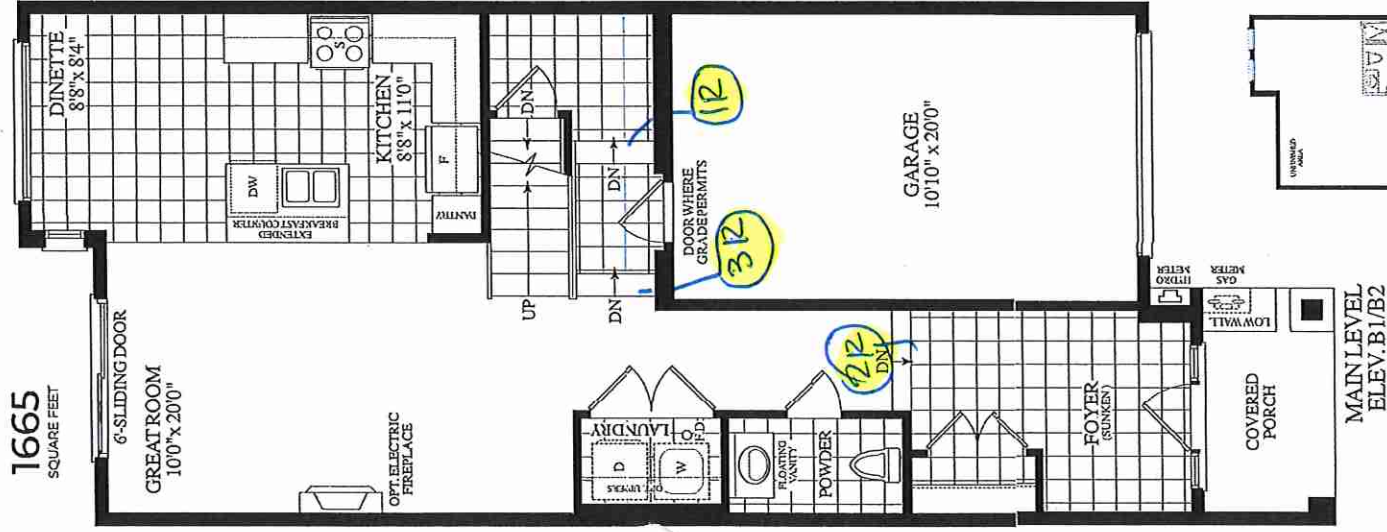


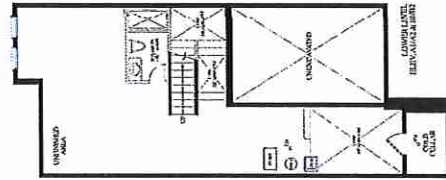

1665
SQUARE FEET

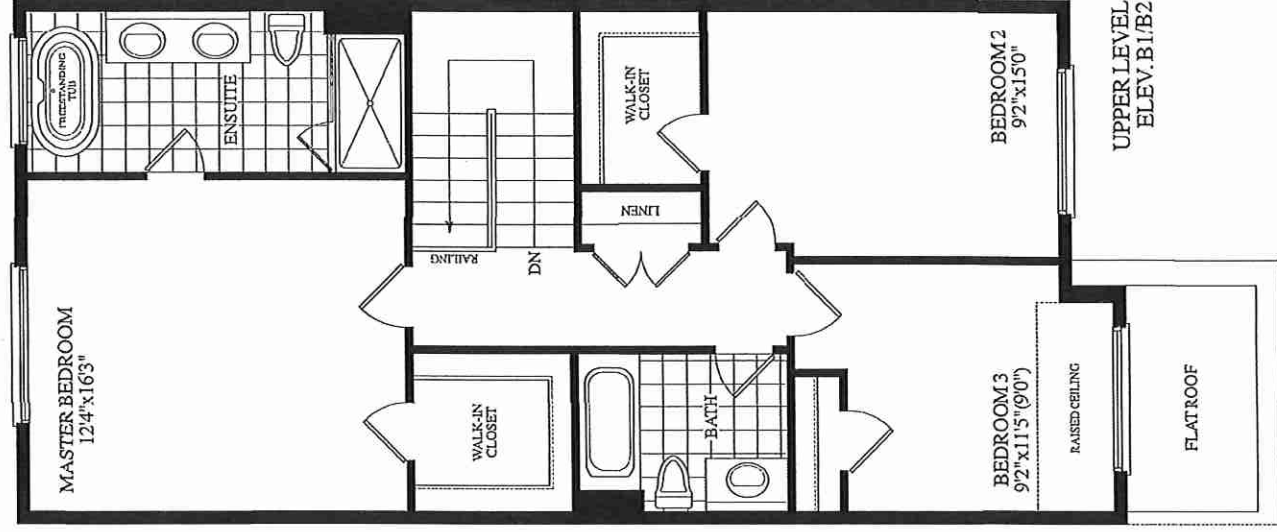

PART. MAIN LEVEL
FOR OPT. KITCHEN LAYOUT

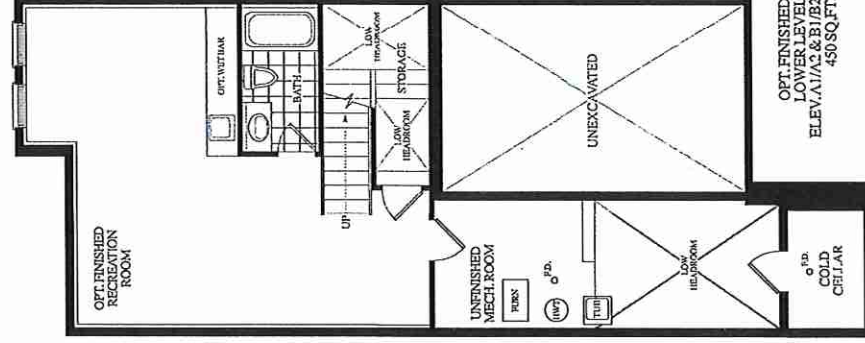

BLK 58 - TH 18.
Inventory House

