
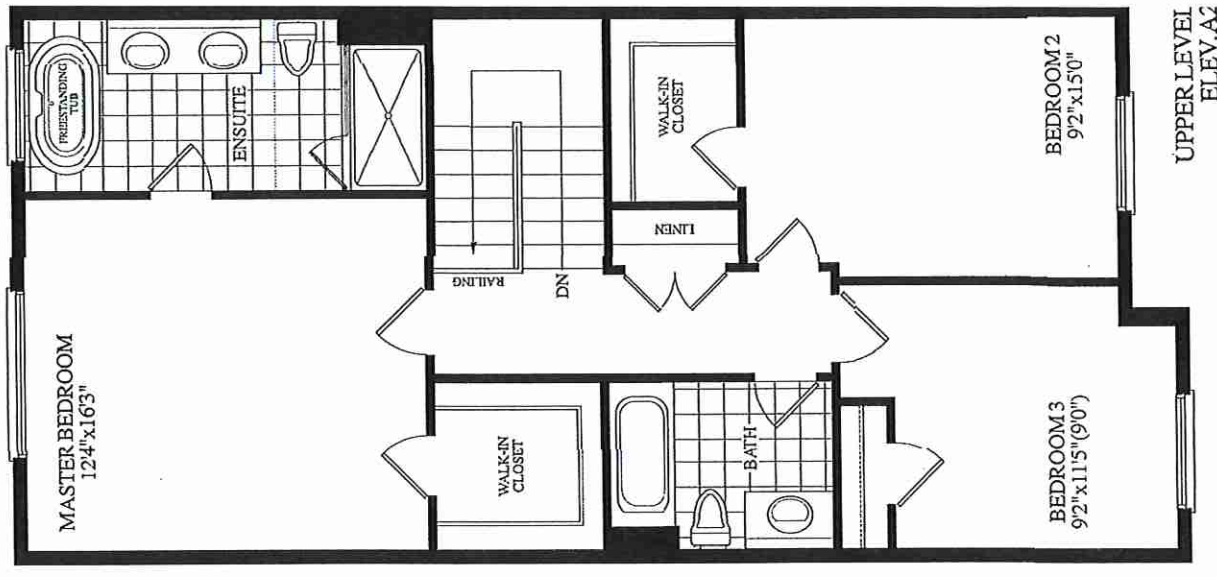


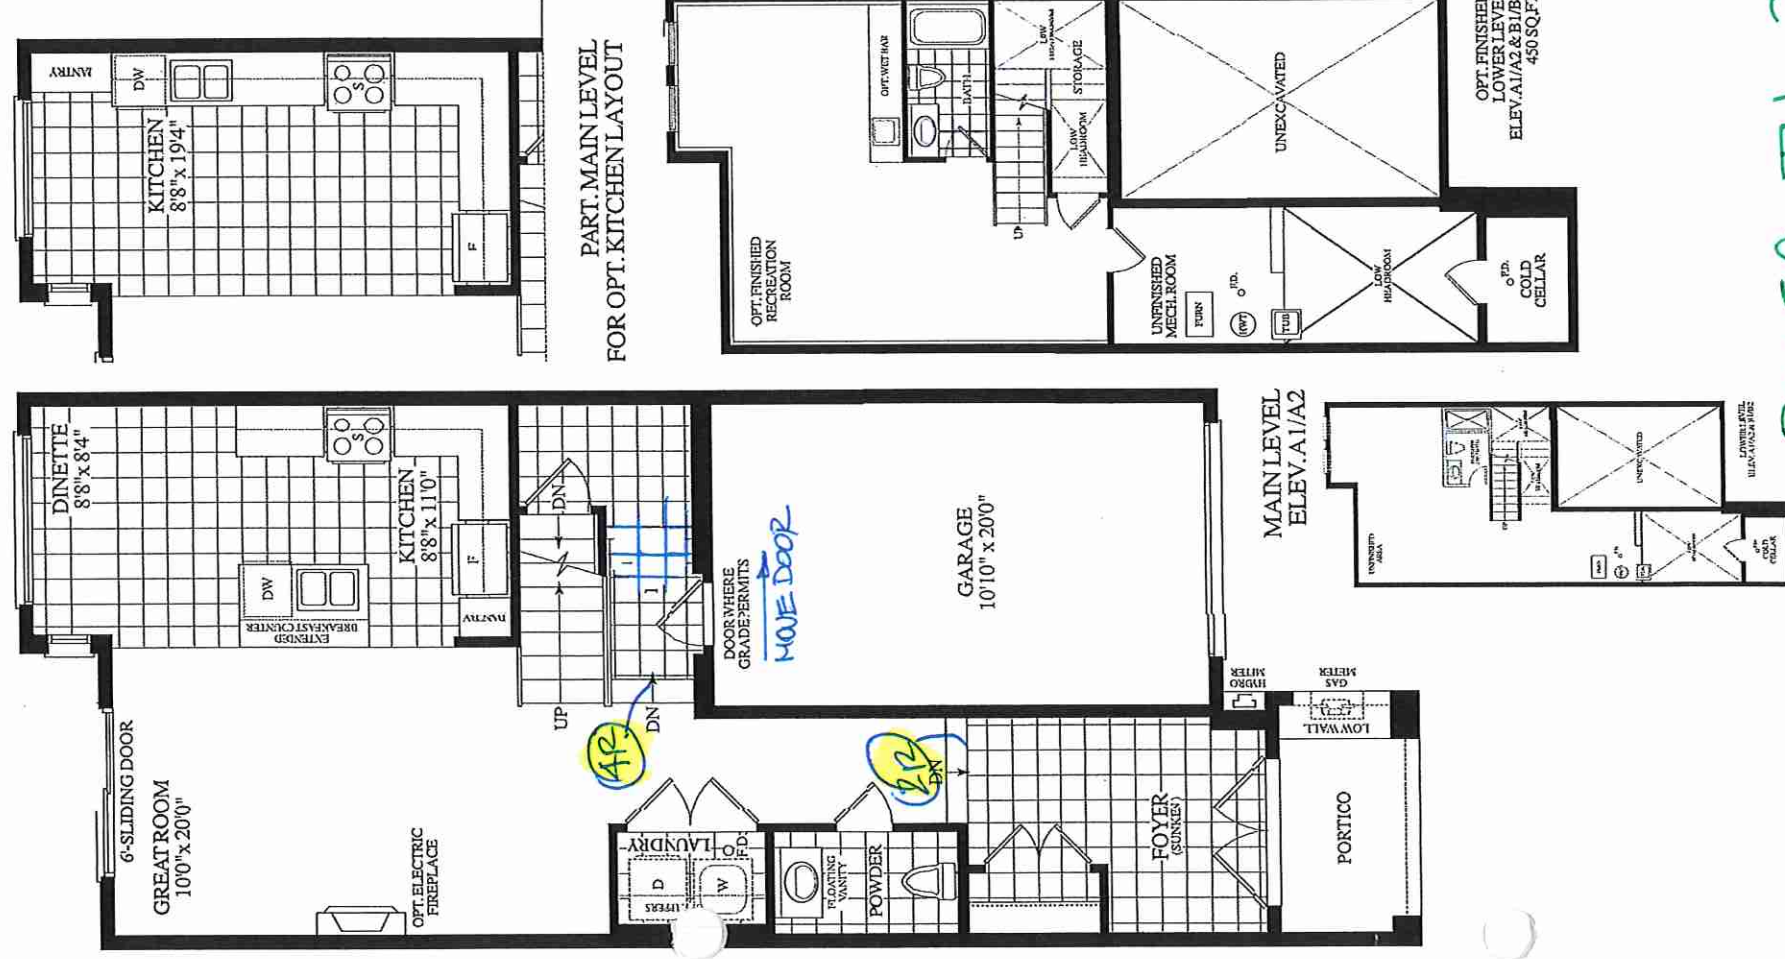

51 EV. 11/18/23

1665
SQUARE FEET

BUK 59-TT-24
INVENTORY