



SITE COPY

CONSTRUCTION SUMMARY
Grovetrail Developments Inc.

PURCHASER: LING LIU

TEL:

LOT NUMBER	PHASE	HOUSE TYPE	CLOSING DATE
39 Block 54	1a	LAWSON (20-08A2S) ELEV A2	09-Feb-22

Date Added: 26-Jul-21 Invoice Number: 7433

1 - PURCHASER HAS ATTENDED A SCHEDULED STRUCTURAL APPOINTMENT BY PHONE ON MONDAY JULY 5TH, 2021 AND HAS DECLINED ANY ADDITIONAL UPGRADES.

Note:



1 - PURCHASER AWARE AND ACCEPTS THAT ANY CHANGES MADE TO UPGRADES AFTER SIGNING THIS PURCHASERS EXTRA FORM ARE SUBJECT TO A MINIMUM ADMINISTRATION FEE OF \$1,000. PLUS A 10% HOLDBACK FEE.

Note:

This Document is Extremely Time Sensitive - Printed 3 Aug 21 at 16:24

BONUS PACKAGE FOR TOWNHOUSE: PURCHASER TO RECEIVE \$7500.00 (INCLUSIVE OF TAXES)
WORTH OF UPGRADES AT DÉCOR CENTRE AT TIME OF COLOUR CHART


BONUS PACKAGE FOR TOWNHOUSE: 5 APPLIANCES TO INCLUDE FRIDGE, STOVE, DISHWASHER
WITH STAINLESS STEEL FINISH AND WHITE WASHER AND DRYER AS PER VENDORS SAMPLES.
DELIVERED ONLY – NOT INSTALLED.

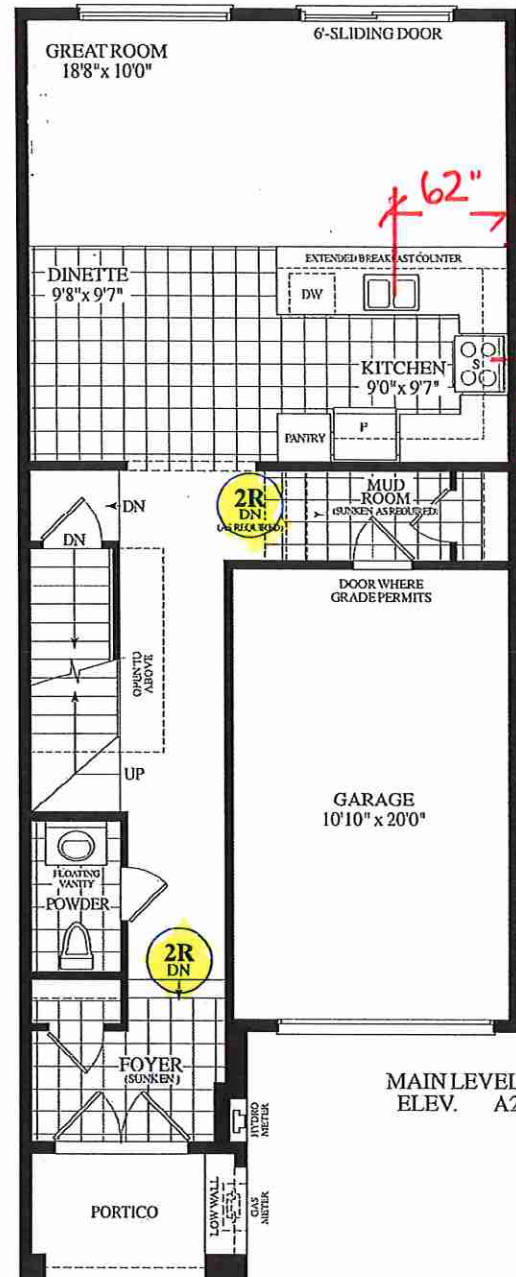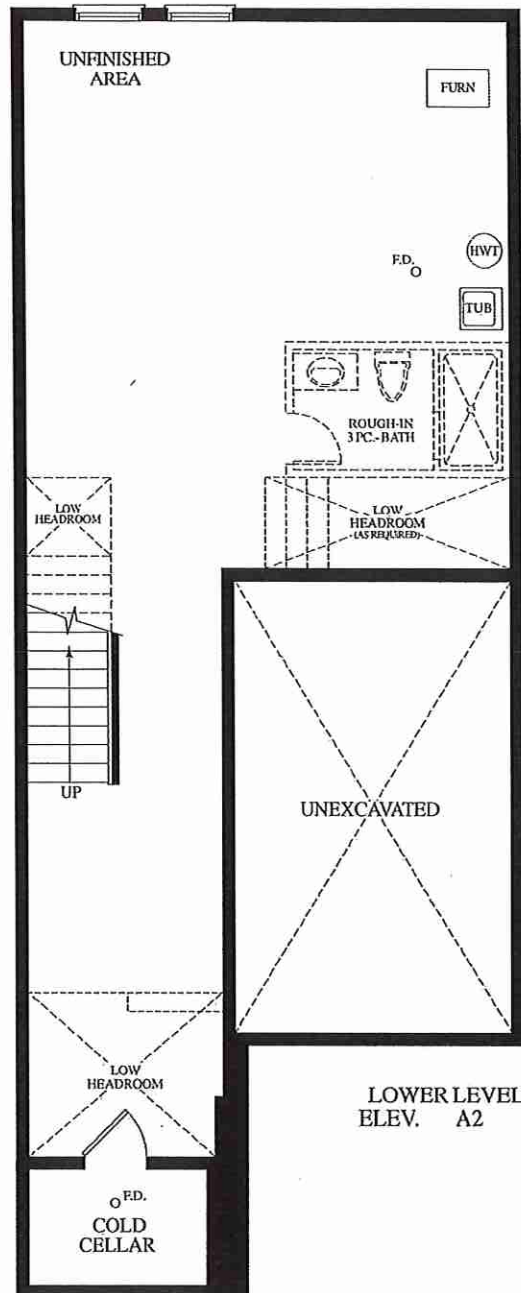

62"


115"

52"

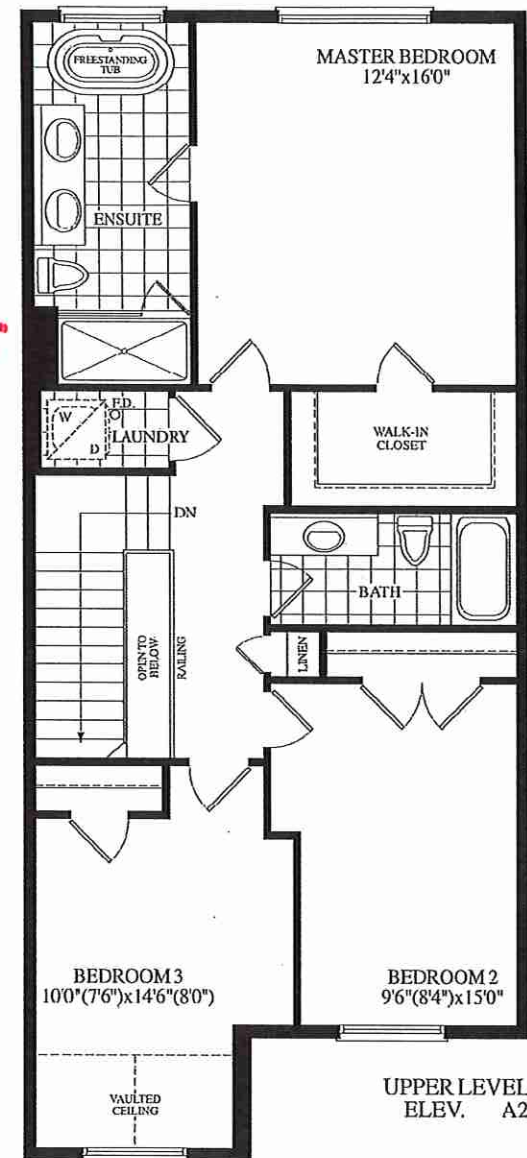

BLK 54 LOT #39

2008 ELEV A2

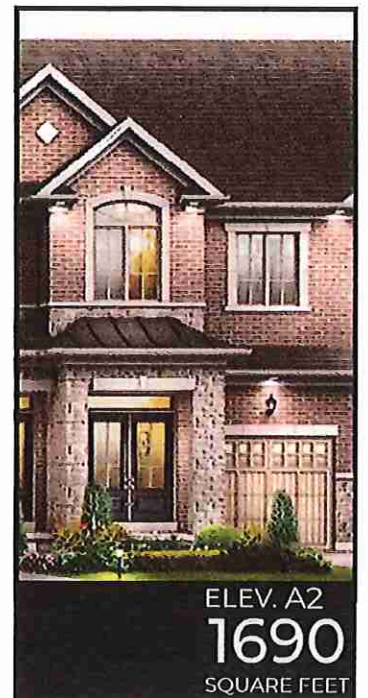

RECEIVED

JULY 26 2011

SCHEDULE "B"

Purchaser
And
Vendor
Lot Number
Date of Offer
Dated Required:

LING LIU
Grovetrail Developments Inc.
39 Block 54 , Phase 1a, Plan AS PER SCHEDULE C in the City of Richmond Hill
March 26, 2021
February 09, 2022

Model: LAWSON (20-08A2S) ELEV A2 ()

Description - Vendor to Supply and Install the Following as Per Purchase Price

- BONUS PACKAGE FOR TOWNHOUSE: PURCHASER TO RECEIVE \$7,500.00 (INCLUSIVE OF TAXES) WORTH OF UPGRADES AT DECOR CENTRE AT TIME OF COLOUR CHART
- BONUS PACKAGE FOR TOWNHOUSE: 5 APPLIANCES TO INCLUDE FRIDGE, STOVE, DISHWASHER WITH STAINLESS STEEL FINISH AND WHITE WASHER AND DRYER AS PER VENDORS SAMPLES. DELIVERED ONLY - NOT INSTALLED.

