

FORESTSIDE TOWNHOUSES

(Royal Pine Homes)



SITE INSTRUCTION # 6

Instruction Issued By: Kevin Deonarraine

Instruction Issued To: Vince Staffieri

Date: October 6th, 2021

JAP Project No: 19066

Text of Instruction:

The following revisions have been made to the drawing set:

1.1 **Refer to Drawing S-103B "2ND FLOOR FRAMING PLAN"**

- a) Updated to match slab edge to add canopies on Building C

END OF SITE INSTRUCTION # 6

FORESTSIDE TOWNHOUSES

TORONTO, ONTARIO

Project
Number : #19066

Issued for : ISSUED FOR SITE INSTRUCTION # 6

Issued date : OCTOBER 06, 2021



**JABLONSKY, AST
AND PARTNERS**
CONSULTING ENGINEERS

1129 LESLIE STREET
DON MILLS, ON., M3C 2K5
TEL. 416-447 7405
FAX 416-447 2771
e-mail: jap@astint.on.ca

LIST OF STRUCTURAL DRAWINGS


Drawing Index

FOR CONTINUATION
SEE DWG S-103B
FOR CONTINUATION
SEE DWG S-103A


FOR CONTINUATION
SEE DWG S-103B
FOR CONTINUATION
SEE DWG S-103A

FOR CONTINUATION
SEE DWG S-103B
FOR CONTINUATION
SEE DWG S-103A


BUILDING C

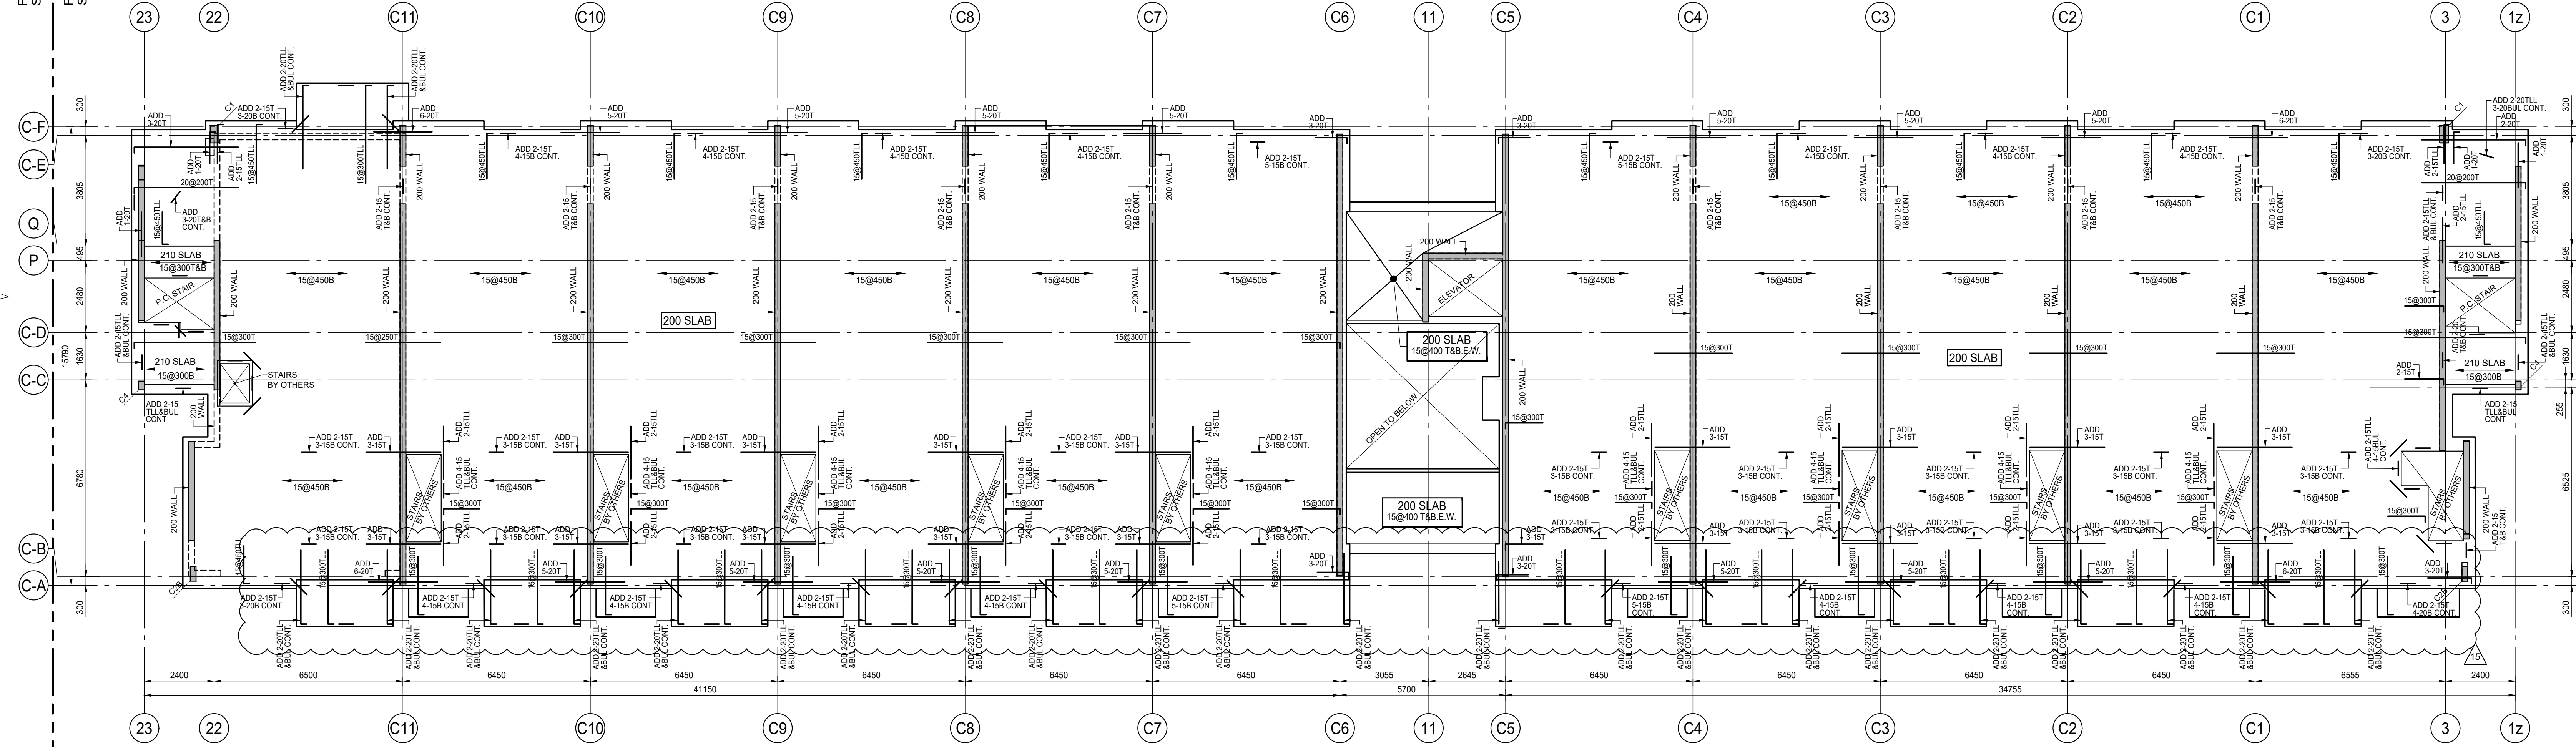

BUILDING B

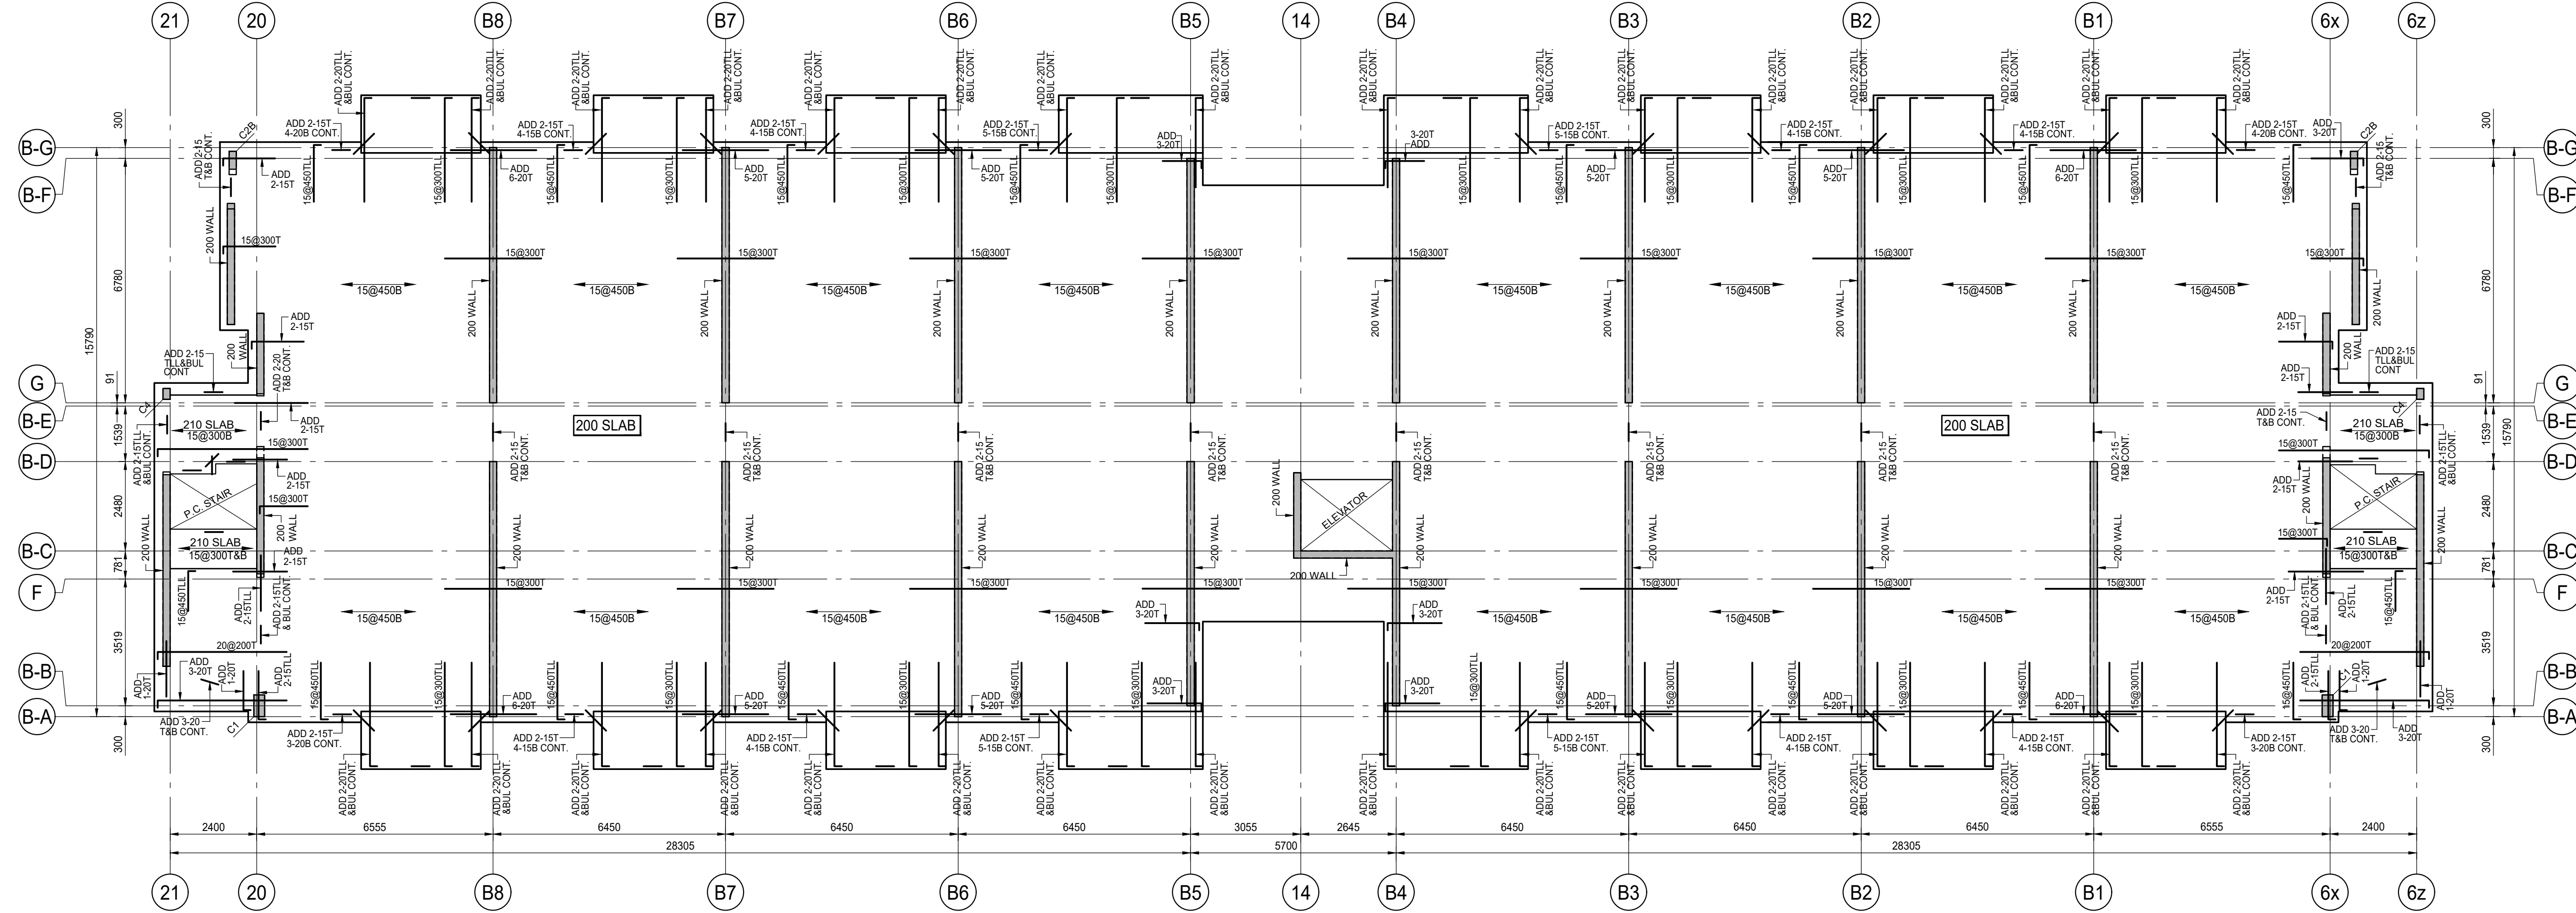

BUILDING A

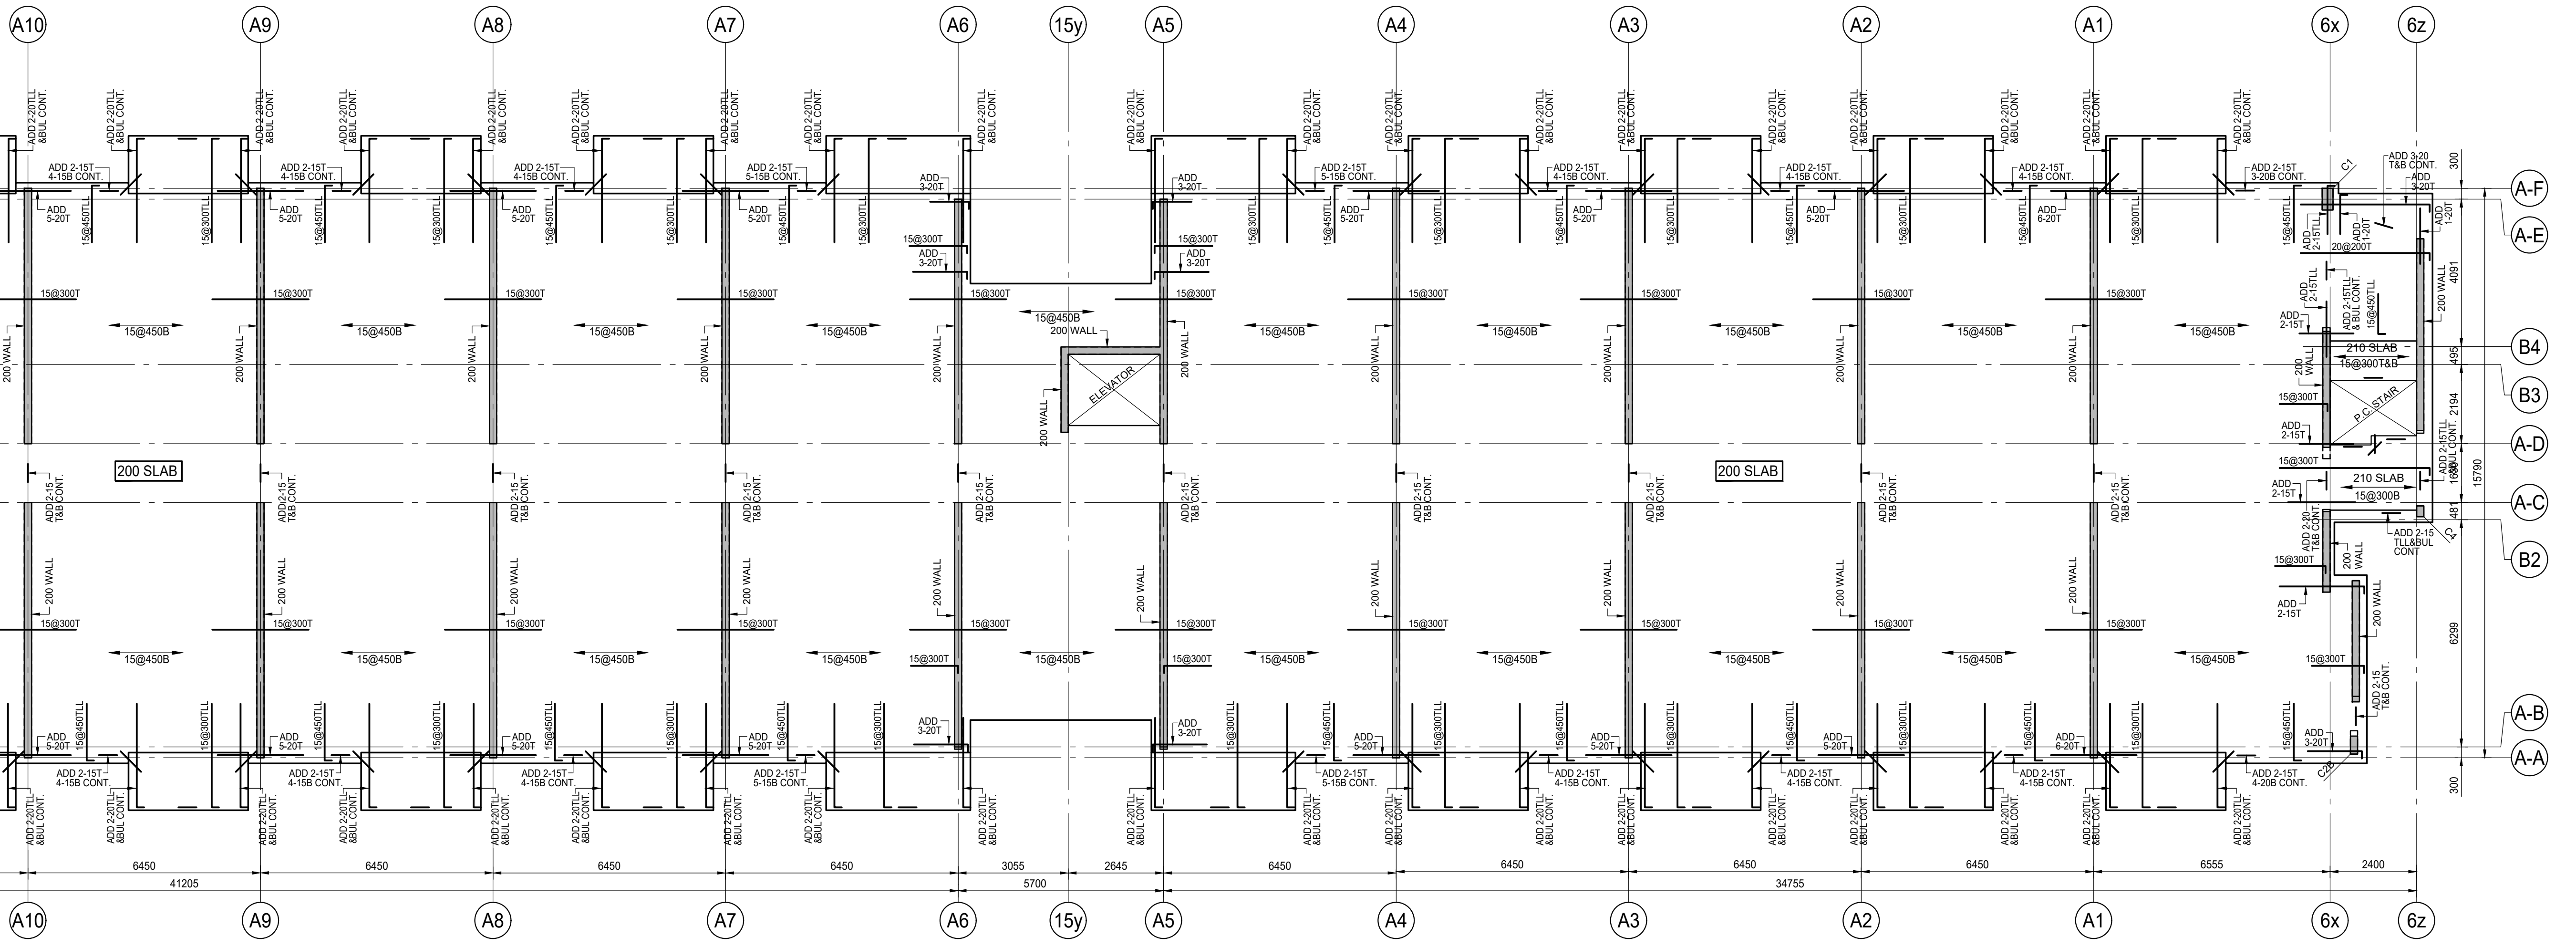

2ND FLOOR FRAMING PLAN SCALE 1:100

1. FOR GENERAL NOTES, SEE DRAWING S-103A.

COLUMN - C1
300x600 6-20V +10@300 TIES
C2A 200x450 6-20V +10@300 TIES
C2B 200x500 6-20V +10@300 TIES
C3 250x800 8-20V +10@300 TIES
C4 200x300 4-20V +10@300 TIES

WALLS = 200 THICK
10@400H&V E.F.
+ ADD 2-20H TOP

300 THICK
10@270H&V E.F.
+ ADD 2-20H TOP

ISSUES

No.	DATE	DESCRIPTION
1.	2019-08-02	ISSUED FOR TENDER
2.	2019-08-28	ISSUED FOR TENDER ADDENDUM #1
3.	2020-01-31	ISSUED FOR TENDER ADDENDUM #3
4.	2020-05-07	ISSUED FOR TENDER ADDENDUM #4
5.	2020-09-28	ISSUED FOR PERMIT
6.	2021-01-08	ISSUED FOR TENDER ADDENDUM #5
7.	2021-02-22	ISSUED FOR TENDER ADDENDUM #6
8.	2021-03-03	ISSUED FOR PERMIT BUILDINGS A, B, C, D
9.	2021-03-25	ISSUED FOR PROGRESSIVE CONSTRUCTION
10.	2021-03-25	ISSUED FOR PERMIT BUILDINGS A, B, C, D
11.	2021-05-18	ISSUED FOR SITE INSTRUCTION #4
12.	2021-05-28	ISSUED FOR SITE INSTRUCTION #5
13.	2021-06-15	ISSUED FOR PROGRESSIVE CONSTRUCTION #2
14.	2021-09-27	ISSUED FOR PERMIT REVISION TO BUILDING D
15.	2021-10-06	ISSUED FOR SITE INSTRUCTION #6

REVISIONS


CONTRACTOR MUST VERIFY ALL DIMENSIONS AND BE RESPONSIBLE FOR SAME REPORTING ANY DISCREPANCIES TO THE ARCHITECT BEFORE COMMENCING THE WORK.

PRINTS ARE NOT TO BE SCALED.

Jablonsky, Ast
and Partners
CONSULTING
ENGINEERS
1120 LESLIE STREET
DON MILLS, ON, M3C 2K5
TEL: (416) 447-1400
FAX: (416) 447-2771

Job Title:
FORETSIDE TOWNHOUSES
TORONTO, ONTARIO

Sheet Title:
**2ND FLOOR
BUILDINGS A, B, & C**

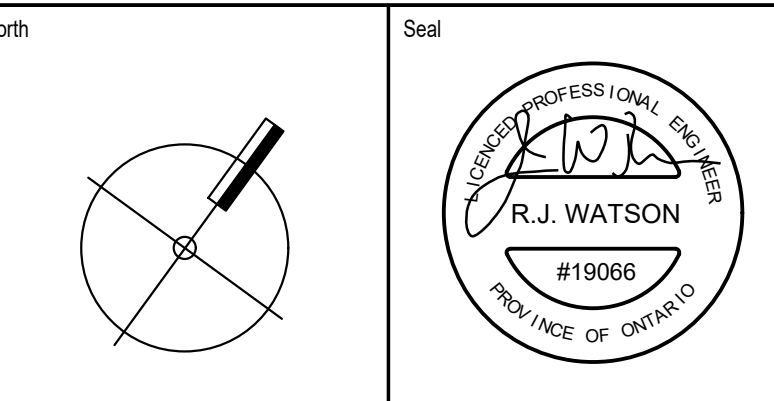

Date Plotted: **ND** Date: **Oct 06 2021**
Drawn By: **JW** Scale: **1 : 100**
Checked By: **JW** Revision Number:
Job No.: **19066** Sheet No.: **S-103B**