



PURCHASER: KAIDI ZOU				CONSTRUCTION SUMMARY		TEL:	
Grovetrail Developments Inc.							
LOT NUMBER	PHASE	HOUSE TYPE	CLOSING DATE				
43 Block 53	1	20-09 MAJOR MACKENZIE-END Elev A1	15-Feb-22				
Offer	BONUS PACKAGE FOR TOWNHOUSE: PURCHASER TO RECEIVE \$7,500.00 (INCLUSIVE OF TAXES) WORTH OF UPGRADES AT DECOR CENTRE AT TIME OF COLOUR CHART						
Workshee	Note:						
Offer	BONUS PACKAGE FOR TOWNHOUSE: 5 APPLIANCES TO INCLUDE FRIDGE, STOVE, DISHWASHER WITH STAINLESS STEEL FINISH AND WHITE WASHER AND DRYER AS PER VENDORS SAMPLES. DELIVERED ONLY - NOT INSTALLED.						
Workshee	Note:						



file copy
SITE MASTER

CONSTRUCTION SUMMARY

Grovetrail Developments Inc.

PURCHASER: KAIDI ZOU

TEL:

LOT NUMBER	PHASE	HOUSE TYPE	CLOSING DATE
43 Block 53	1	MAJOR MACKENZIE-END Elev A1	15-Feb-22

Date Added: 26-Oct-21 Invoice Number: 7573

1 - Standard Cable and Telephone Rough In (See Sketch) Note:
1 - GARAGE DOOR- Install the builders standard garage door handle with lock Note:
1 - UPPER HALL- Install an Upgrade #1 Laminate floor on the Upper Hall, in lieu of the builders standard carpet. Install the Highland Watson Oak Natural Model # EE-H-292, throughout the Upper Hall, where applicable Note:
1 - KITCHEN- Install an Upgrade #3 kitchen cabinet, throughout the kitchen, where applicable. Install the DOUBLE SHAKER MDF SHORELINE Note:
1 - KITCHEN- Install an Upgrade #2 counter top, throughout the kitchen area, where applicable. Install the EMMERSTONE AURORA, in lieu of teh builders standard Note:
1 - KITCHEN- Install an upgrade #2 kitchen backsplash, throughout the kitchen area, where applicable. Install the 3x6 Tavella Polvere (grey) Glossy. **Does not include behind the fridge/stove** Note:
32 - KITCHEN- Install the 3x6 Tevla Polvere (Grey) Glossy kitchen backsplash tile on a BRICK PATTERN , throughout the kitchen backsplash area(where applicable) **Does not include behind the fridge /stove** Note:
1 - KITCHEN- Install an upgraded kitchen undermount sink , in lieu of the builders standard sink. Install the Blanco Quatrus U Super Single Model # 401248 Note: **PLEASE NOTE** Install the builders standard kitchen faucet
1 - MASTER ENSUITE- Install an upgrade #2 counter top in the Master Ensuite, in lieu of the builders standard. Install teh EMMERSTONE BORGHINI ARABESCATO Note:
1 - APPLIANCE PACKAGE- SUPPLY the Standard Appliance Package To be supplied ONLY for the home, where applicable. Note:
1 - Purchaser to receive TEN (X10) Potlights on Main floor as per their Standard Features and Finishes List Note:
1 - GREAT ROOM- In addition to the builders standard ceiling light, Install SIX (X6) LED potlights in the Great Room. All SIX (X6) pot lights to be on one switch (See Sketch) Note:
1 - KITCHEN- Relocate the builders standard ceiling light from the kitchen to above the island. Ceiling light to be centred above the island. (See Sketch) Note:
1 - KITCHEN- In addition to the builders standard ceiling light above the island, Install FOUR (X4) LED potlights in the Kitchen area. All FOUR (X4) pot lights to be on one separate switch (See Sketch) Note: **Purchaser is apying for the additional seperate switch only**
1 - COUNTER TOPS Purchaser accepts & acknowledges that the Stone slabs vary in size & all seams are visible & the fabricator reserves the right to position the seams as necessary. Note:



FILE COPY
SITE MASTER

CONSTRUCTION SUMMARY

Grovetrail Developments Inc.

PURCHASER: KAIDI ZOU

TEL:

LOT NUMBER	PHASE	HOUSE TYPE	CLOSING DATE
43 Block 53	1	MAJOR MACKENZIE-END Elev A1	15-Feb-22

Date Added: 26-Oct-21 Invoice Number: 7573

1 - COUNTER TOP

CLARIFICATION- MASTER ENSUITE / MAIN BATH/POWDER ROOM- Install the Standard 3" Splash throughout all bathroom vanity counter tops, where applicable. To include the Main Bath and the Master Ensuite, Powder Room

Note:

1 - STAIRCASE VS FLOORING WOOD SPECIES DIFFERENCE:

STAIRCASE - The purchaser was advised and therefore accepts and acknowledges that the wood species of the staircase and flooring chosen do not match. This difference may result in a stain colour variance.

Note: The purchaser agrees that the vendor is to be exempt from any and all claims by the purchaser regarding this colour variance.

1 - STAIRCASE VS FLOORING

STAINING DIFFERENCE:

STAIRCASE - The purchaser was advised and therefore accepts and acknowledges that the stain of the staircase and flooring chosen do not match. This difference might result in an undesirable colour variance.

Note: The purchaser agrees that the vendor is to be exempt from any and all claims by the purchaser regarding this colour variance.

1 - PLUMBING CLARIFICATION-

MASTER ENSUITE / MAIN BATH/POWDER ROOM- Install the builders standard Plumbing Fixtures throughout all bathrooms, where applicable.

Note:

1 - PURCHASER HAS ATTENDED A COLOR APPOINTMENT AT THE DECOR CENTRE AND HAS DECLINED ANY ADDITIONAL UPGRADES.

Note:

1 - PURCHASER AWARE AND ACCEPTS THAT ANY CHANGES MADE TO UPGRADES AFTER SIGNING THIS PURCHASERS EXTRA FORM ARE SUBJECT TO A MINIMUM ADMINISTRATION FEE OF \$1,000 PLUS A 10% HOLDBACK FEE.

Note:

Date Added: 14-Sep-21 Invoice Number: 7492

1 - FRONT EXTERIOR DOUBLE DOOR- Due to the possible shortage of the original standard 3/4 glass pane front door, the purchaser has selected a substitute model. Purchaser has selected the substitute model of FULL GLASS pane, for the front double door entry.

Note: **See attached picture for reference** Purchaser is aware that if the original 3/4 glass pan front door is available at time of construction installation, original front door glass will be installed.

1 - PURCHASER AWARE AND ACCEPTS THAT ANY CHANGES MADE TO UPGRADES AFTER SIGNING THIS PURCHASERS EXTRA FORM ARE SUBJECT TO A MINIMUM ADMINISTRATION FEE OF \$1,000. PLUS A 10% HOLDBACK FEE.

Note:

Date Added: 26-Jul-21 Invoice Number: 7450

1 - BASEMENT-Install the 200 AMP Service, in lieu of the builders standard 100 AMP service. (See Sketch)

Note:

1 - PURCHASER HAS ATTENDED A STRUCTURAL APPOINTMENT WITH THE DECOR CENTRE VIA ZOOM AND HAS DECLINED ANY ADDITIONAL UPGRADES.

Note:

1 - PURCHASER AWARE AND ACCEPTS THAT ANY CHANGES MADE TO UPGRADES AFTER SIGNING THIS PURCHASERS EXTRA FORM ARE SUBJECT TO A MINIMUM ADMINISTRATION FEE OF \$1,000. PLUS A 10% HOLDBACK FEE.

Note:

1 - BONUS PACKAGE - PURCHASER HAS APPLIED \$7,500 (INCLUSIVE OF TEXES) UPGRADE PROMOTIONAL PACKAGE TOWARDS THE PURCHASE PURCHASE OF UPGRADES IN THIS AGREEMENT.

Note: **PLEASE NOTE** THE PURCHASER HAS A REMAINING BONUS PACKAGE OF \$5,805 (INCLUSIVE OF TAXES) TO BE SPENT AT THE DECOR CENTRE TOWARDS TEH COLOUR CHART APPOINTMENT



* INTERIOR COLOUR SCHEME *

Purchaser
KAIDI ZOU

Decor Consultant
Laura Di Pede

Model and Elevation
MAJOR MACKENZIE-END Elev A1

Telephone Res. / Bus
/

Project
Grovetrail Developments Inc.

Closing Date
15/02/2022

Property
43 Block 53

Page 1 of 3

Master Ensuite

Main Bathroom

Wder Room

Kitchen/Dinette

MUD ROOM

Foyer

Main Hall

Great Room

Laundry(2nd Floor)

Upper Hall

Master Bedroom

Bedroom 2

Bedroom 3

Flooring

Description

✓ 13X13 MALENA ICE (STD)

✓ 13X13 RUSTIC GREY (STD)

✓ 13X13 COSTA WHITE (STD)

✓ 13X13 COSTA WHITE (STD)

✓ 13X13 COSTA WHITE (STD)

✓ 13X13 COSTA WHITE (STD)

✓ Highland Watson Oak Natural EE-H-292 (STD)

✓ Highland Watson Oak Natural EE-H-292 (STD)

✓ 13X13 RUSTIC GREY (STD)

✓ Highland Watson Oak Natural EE-H-292 (UPGD)

✓ (STD) 40 OZ OPENING NIGHT # 20

✓ (STD) 40 OZ OPENING NIGHT # 20

✓ (STD) 40 OZ OPENING NIGHT # 20

Wall Tile

Main

✓ 8X10 MALENA CARBON (STD)

✓ 8X10 NATURALE GRIGIO (STD)

N/A

✓ 3x6 Tavella Polvere Glossy- BrickPat (Up)

N/A

Accent/Insert

N/A

N/A

Border / Listello

N/A

N/A

Pattern

N/A

N/A

N/A

BrickPattern

N/A

Plumbing

WHITE

WHITE

WHITE

N/A

Railings and Stairs

Railings ✓ STD- Mirage Red Oak DRIFTWOOD

Pickets ✓ STD- PLAIN FLAT BLACK

Posts ✓ STD- Mirage Red Oak DRIFTWOOD

Stringers ✓ STD- Mirage Red Oak DRIFTWOOD

Treads ✓ STD- Mirage Red Oak DRIFTWOOD

Risers ✓ STD- Mirage Red Oak DRIFTWOOD

Runner N/A

Landing - Upper ✓ Oak Natural EE-H-292 (STD) (X2)

Landing - Lower ✓ Oak Natural EE-H-292 (STD)

Ledge - Upper N/A

Ledge - Lower N/A

Trim

Baseboard & Casing STANDARD

Front Door Glass STANDARD

Interior Doors STANDARD

Knobs ✓ STANDARD

Hinges ✓ STANDARD

Grip Set ✓ STANDARD

Notes

✓ MASTER ENSUITE- GREY 2X2 SHOWER STALL FLOOR MOSAIC & WHITE CURB

Cornice Moulding / Medallion

Foyer NO

Living Room NO

Dining Room NO

Family Room NO

Main Hall NO

Kitchen NO

2nd Floor Hall NO

Page 1 of 3

Consultant:

Laura Di Pede

Purchaser:

KAIDI ZOU

Vendor:

Grovetrail Developments Inc.

Printed Oct 26, 2021 1:20 pm



* INTERIOR COLOUR SCHEME *

Purchaser KAIDI ZOU	Decor Consultant Laura Di Pede	Model and Elevation MAJOR MACKENZIE-END Elev A1	Telephone Res. / Bus /	Project Grovetrail Developments Inc.	Closing Date 15/02/2022	Property 43 Block 53
-------------------------------	--	---	----------------------------------	--	-----------------------------------	--------------------------------

Page 2 of 3

Master Ensuite

Main Bathroom

Powder Room

Kitchen/Dinette

Laundry(2nd Floor)

Foyer

Main Hall

Great Room

Upper Hall

Master Bedroom

Bedroom 2

Bedroom 3

Interior Paint

Description

STD- SILVER BIRCH

STD- SILVER BIRCH

Cabinet

Style

(STD) EURO MAPLE SOAPSTONE

(STD) EURO MAPLE SOAPSTONE

(STD) EURO RUSTICA LARICE BIANCO RU-05

UPGD DOUBLE SHAKER MDF SHORELINE

N/A

Appliance Opening/Dimension

Fridge Size STANDARD

Range STANDARD

Built-Ins None

Microwave None

Hood Fan STANDARD

Exhaust Opening 6" 8"

Dishwasher Cabinet Std 24in Opening

Fireplace

Fireplace NO

Fireplace N/A

Location Flooring NO

Location Flooring N/A

Style NO

Style N/A

Finish NO

Finish N/A

Marble NO

Marble N/A

Hearth NO

Hearth N/A

Notes

KITCHEN- STANDARD STAINLESS STEEL EXHAUST FAN

Page 2 of 3

Decor Consultant:

Laura Di Pede

Purchaser:



KAIDI ZOU

Vendor:

Grovetrail Developments Inc.

Printed Oct 26, 2021 1:20 pm

X-2

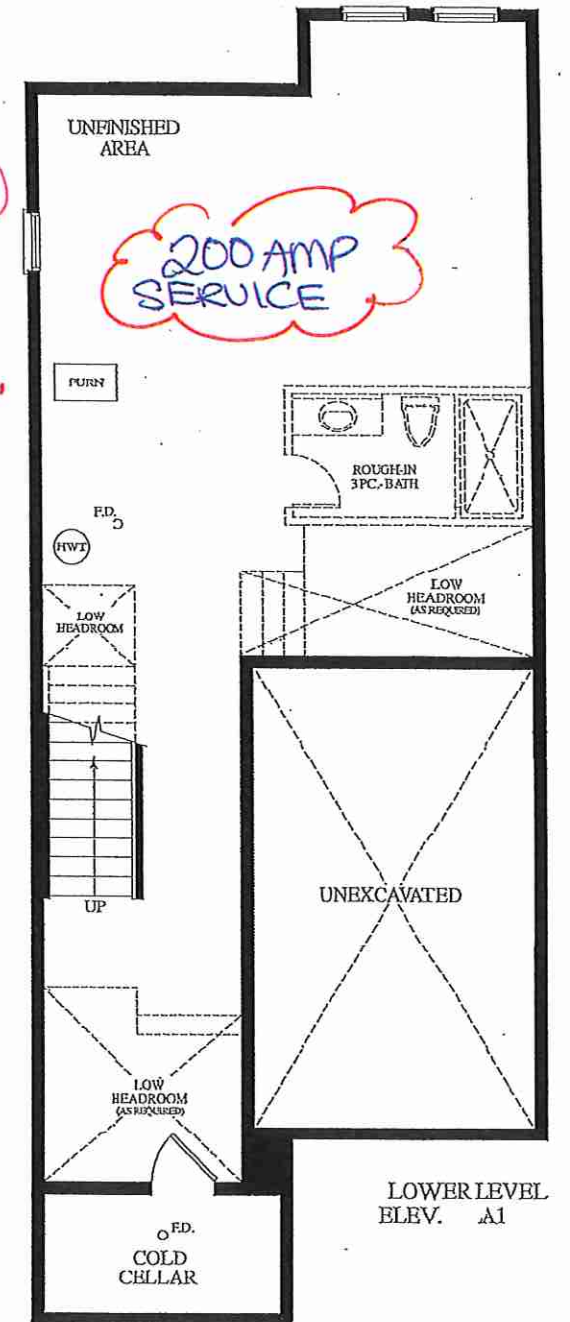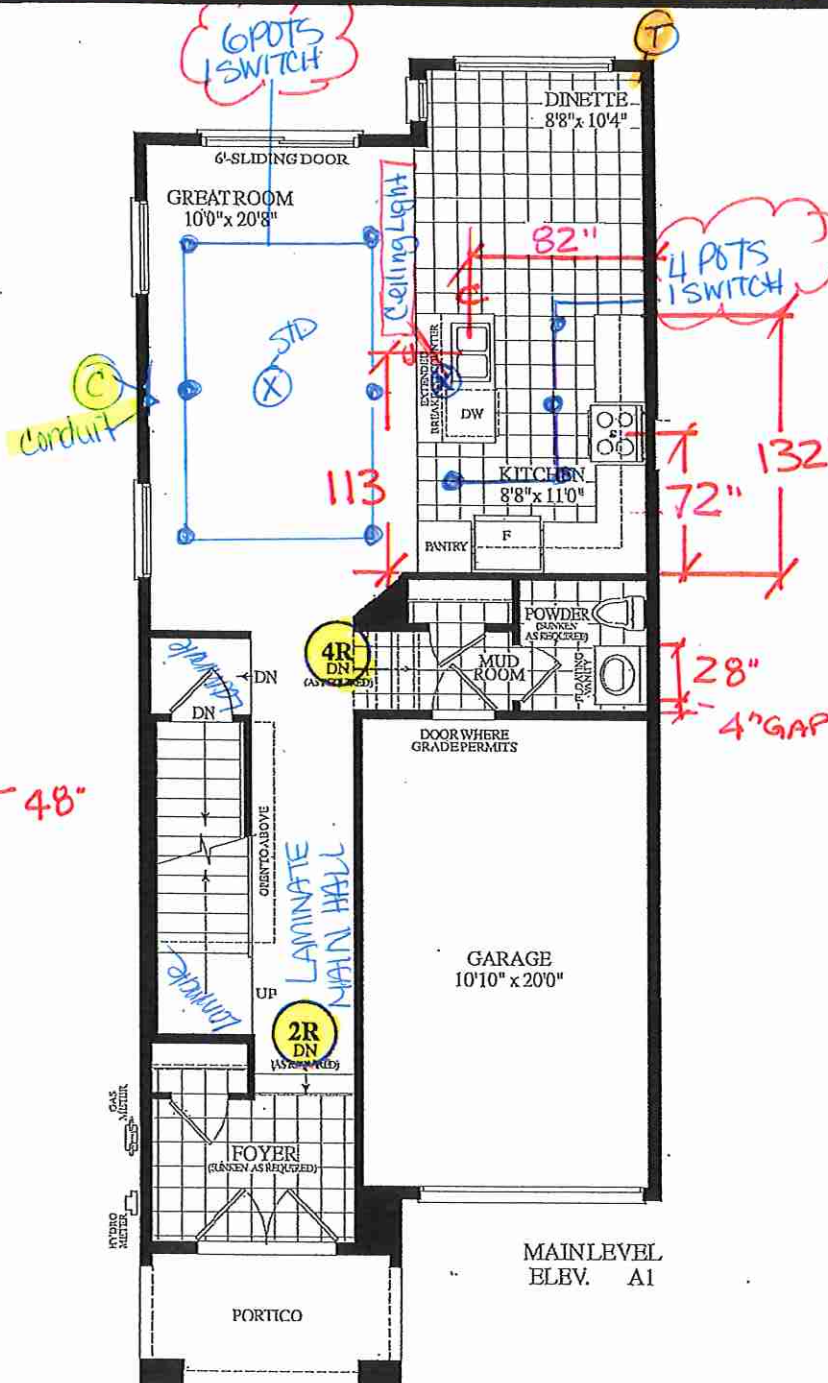

LOT 43 BLK 53
20-09 END.
FLEV A1

LOT 43 BLK 53

Villa

KITCHENS & FINE CABINETS LTD

8111 Jane St. Unit 10
Concord, Ontario L4K 4L7
Tel. (905) 669-7028
Fax. (905) 669-7903
email: designstudio@villakitchens.ca
www.villakitchens.ca

CLIENT: ROYAL PINE HOMES

PROJECT: CENTERFIELD

ADDRESS: RP-CE-MASTER

MODEL: MACKENZIE 2009 END

KITCHEN

NOTE: THIS SITE GETS STD-CROWN




DRAWN BY: DIDI

DATE: JUNE 18/2021

REVISION:

PAGE: 1 OF 4

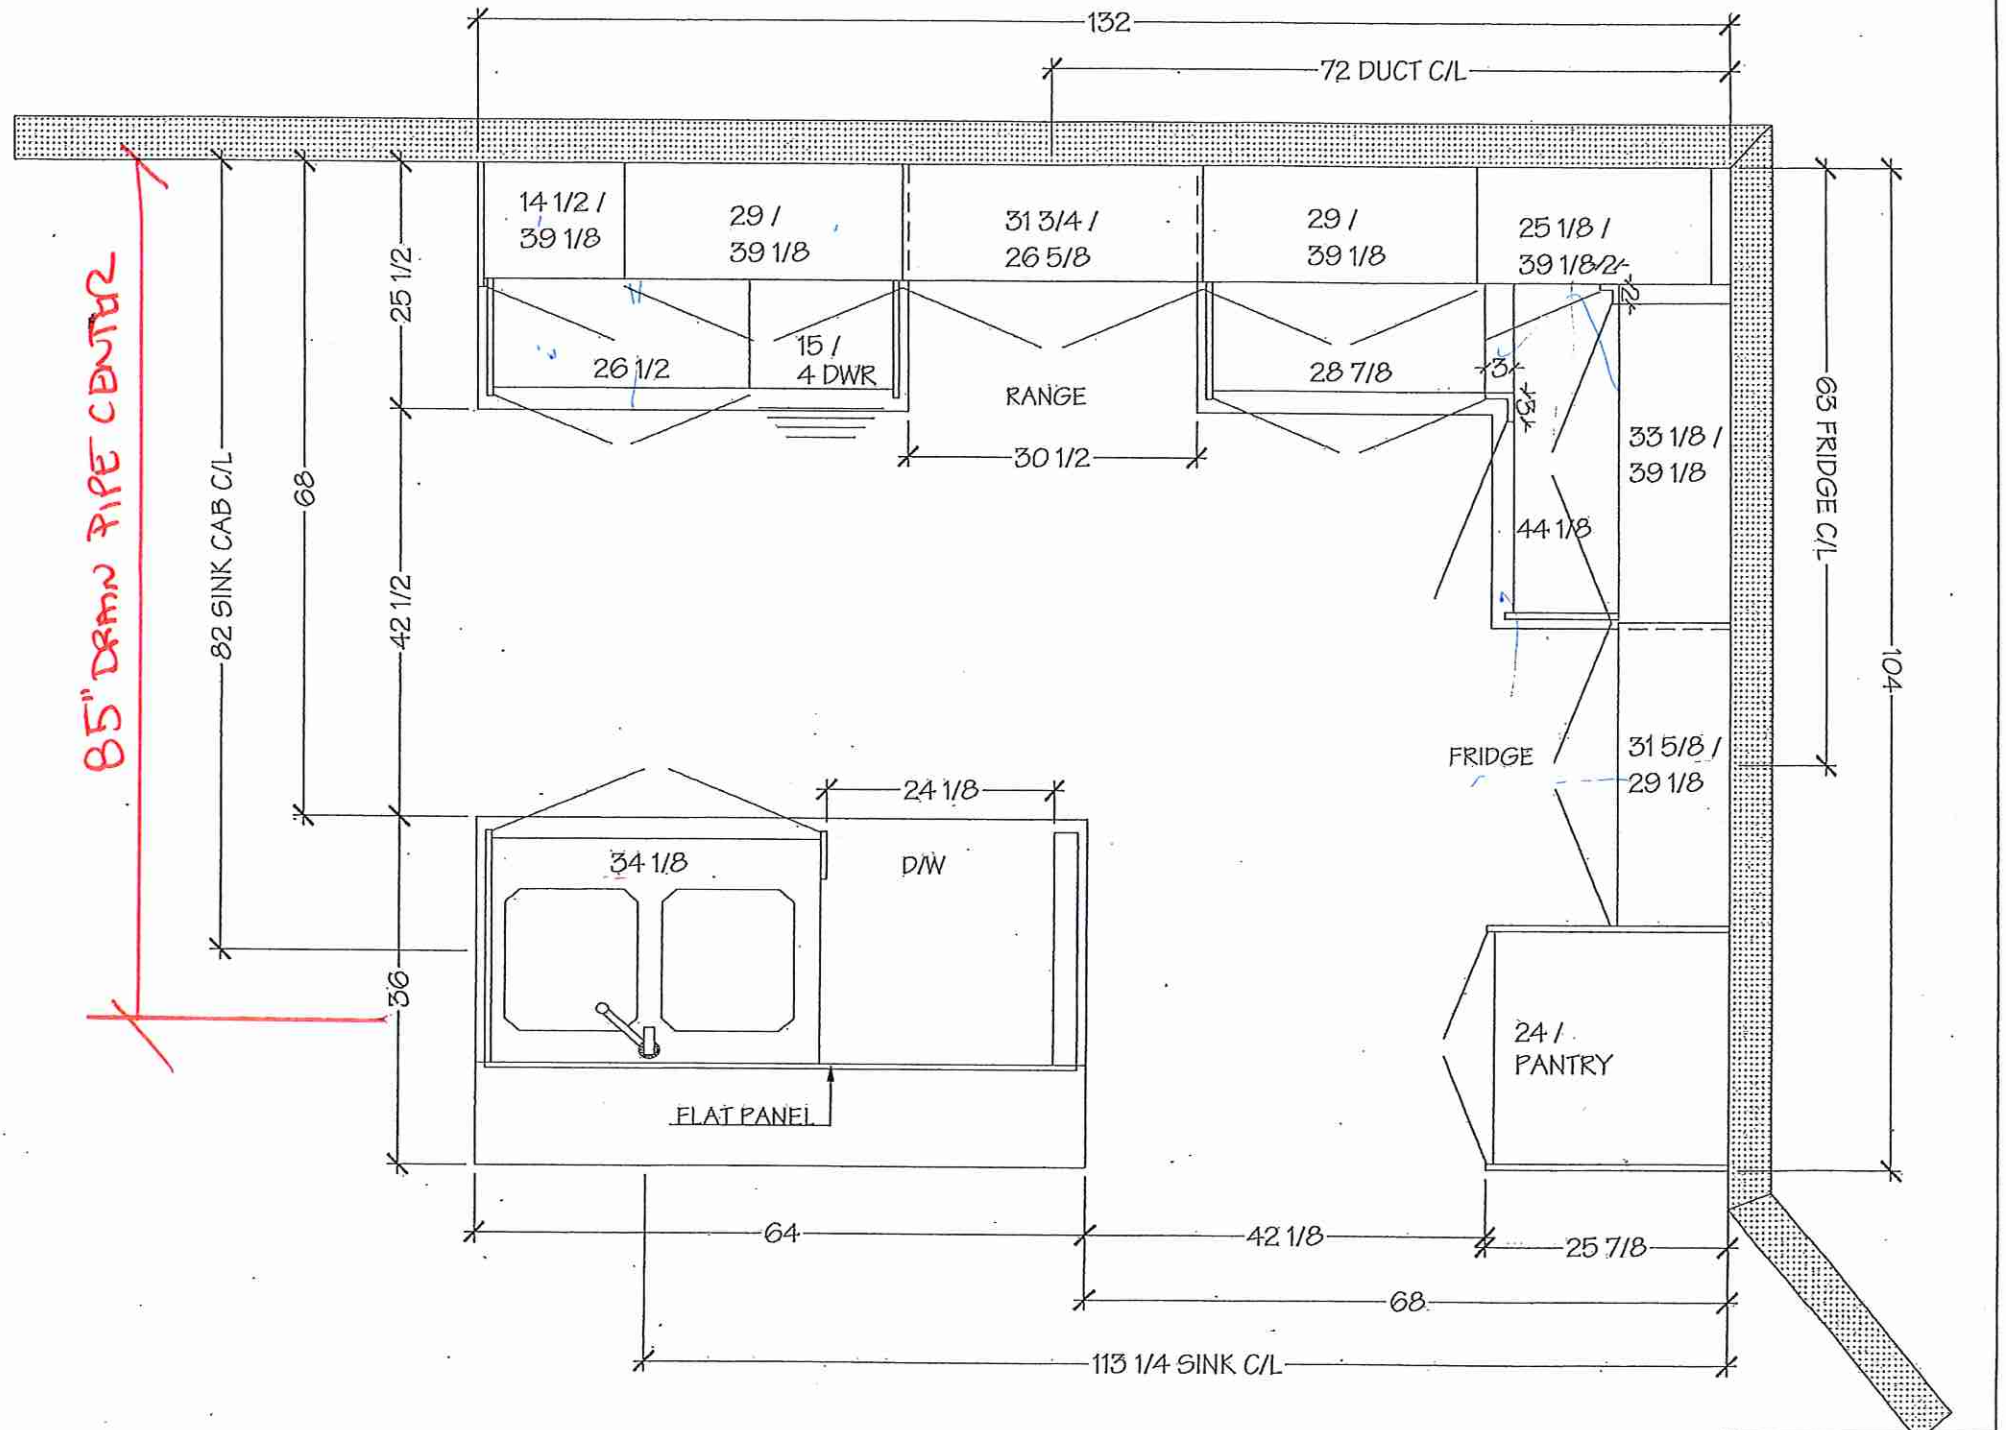



8111 Jane St. Unit 10
Concord, Ontario L4K 4L7
Tel. (905) 669-7028
Fax. (905) 669-7903
email: designstudio@villakitchens.ca
www.villakitchens.ca


CLIENT: ROYAL PINE HOMES
PROJECT: CENTERFIELD
ADDRESS: RP-CE-MASTER
MODEL: MACKENZIE 2009 END

VANITIES


K-2

DRAWN BY: DIDI
DATE: JUNE 18/2021
REVISION:
PAGE: 3 OF 4


FLOATING VANITY
RECESSED KICK

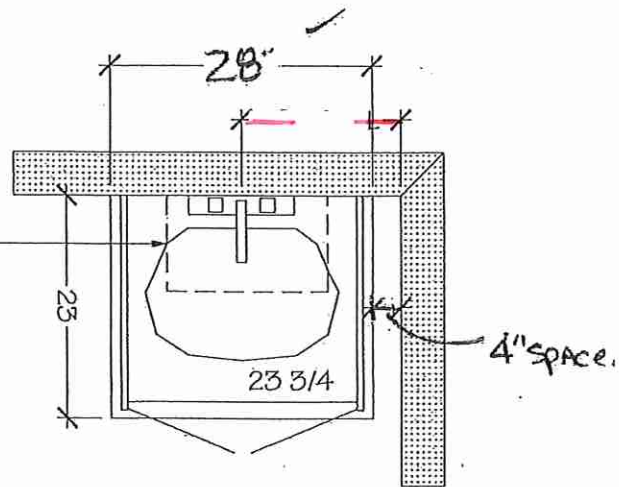


POWDER ROOM

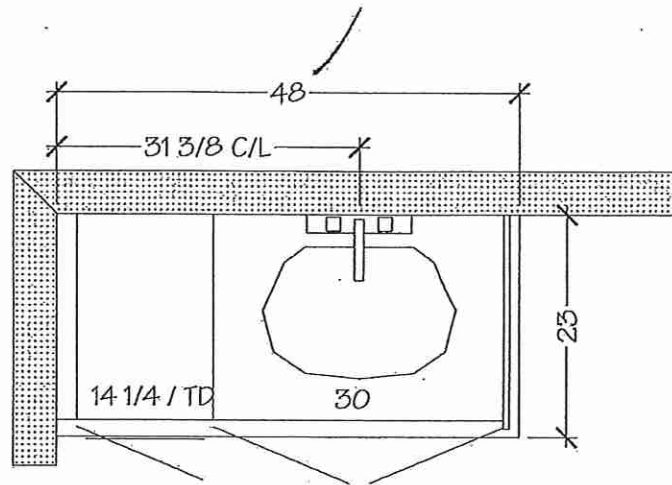

MAIN BATH

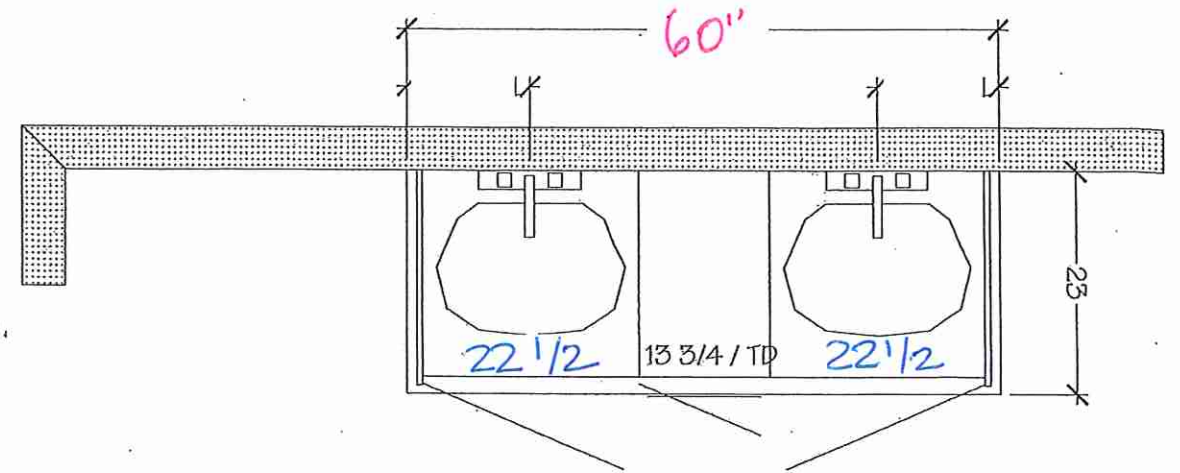

MASTER ENSUITE

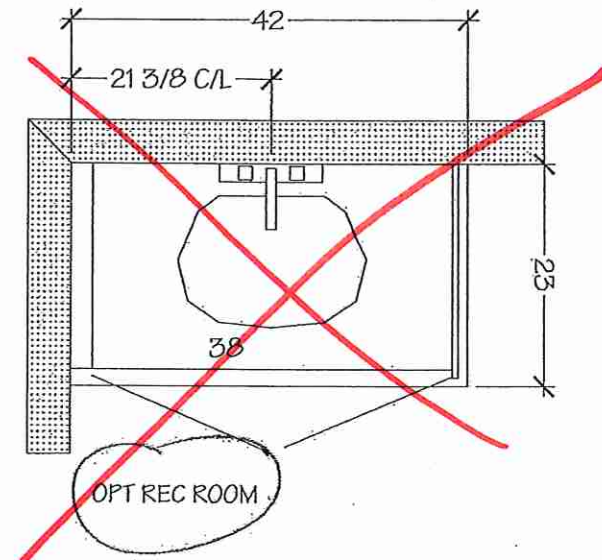

OPT REC ROOM

PLEASE SEE 225 OR

Villa
KITCHENS & FINE CABINETRY LTD


8111 Jane St. Unit 10
Concord, Ontario L4K 4L7
Tel (905) 669-7028
Fax (905) 669-7903
email: designstudio@villakitchens.ca
www.villakitchens.ca

CLIENT: ROYAL PINE HOMES
PROJECT: CENTERFIELD
ADDRESS: RP-CE-MASTER
MODEL: MACKENZIE 2009

KITCHEN

NOTE: BULKHEAD
BASED ON A STANDARD
PROFIED CROWN

DRAWN BY: DIDI
DATE: SEPT 09/2021
REVISION:
PAGE: 1 OF 2

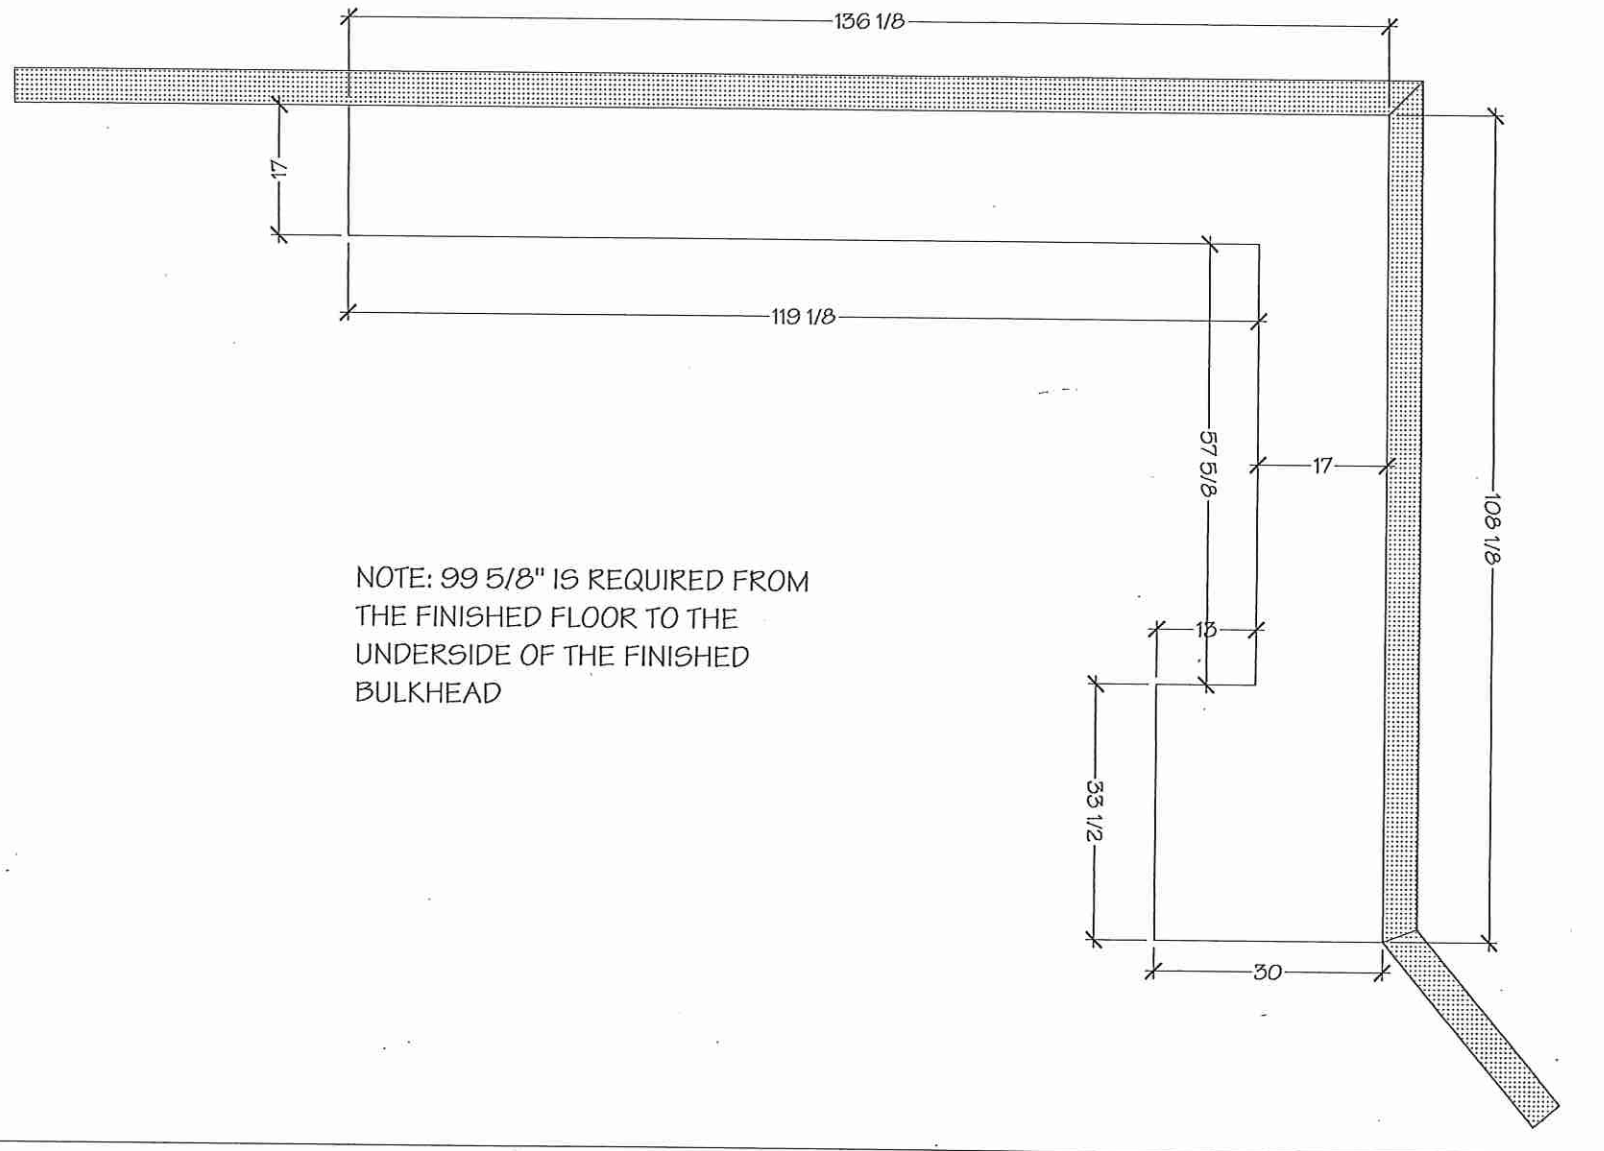


LOT 43 BLK 53

EDGE
DETAILS

004

A.

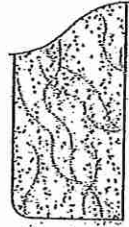


STRAIGHT EDGE
(STANDARD - 3/4")

- * Powder Room
- * Master Ensuite
- * Main Bathroom
- * Kitchen




**L.

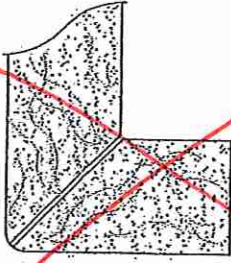

MITER WITH SKIRT EDGE
(MEDIUM - 1 1/2")

M.

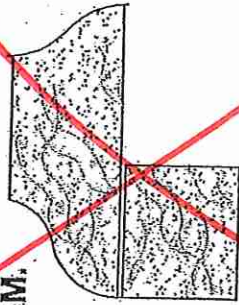

OGEES - SQUARE EDGE
(MED./HIGH - 1 1/2")

EDGING UP-GRADE OPTIONS

RECEIVED
ROCKWELL

BLANCO

Sink Specifications

Colour SKU

brushed finish 401248

Design and planning tips

- Min cabinet size: 36 in (915 mm)
- Bowl Depth: 9 in (230.0 mm)

Specifications:

Installation clips, Sink template, Installation instructions, 3 ½" (90 mm) stainless steel strainer

Depending on cabinet construction, a different cabinet size may be required. Consult the cabinet manufacturer.

Codes/Standards: ASME A112.19.3-2017/ CSA B45.4-17

Optional Accessories

~~Elevated Grid 406346~~

~~Workstation 406344~~

~~CapFlow Strainer Cover 517666~~

~~Ash Cutting Board 406345~~

~~Sink Grid 402125~~

Warranty

Limited lifetime warranty on all sinks and faucets. One-year warranty on all accessories and soap dispensers.

Code/Standards Compliance

BLANCO sinks and faucets are third-party tested and certified to CSA, cUPC, ANSI/ASME, IAPMO and NSF standards and listed by applicable certification bodies. For more information on individual product listings, contact our office or listing organization.



Need support? Learn more by watching our sink & faucet How-to videos:

<https://www.blanco.com/ca-en/support/how-to-videos/how-to-videos-for-sinks/>



BLANCO Canada Inc
100 Corporation Drive
Brampton ON L6S 6B5

Tel & Fax


Tel: 905-494-2400 Toll free: 1-877-425-2626

Fax: 905-494-2425 Toll free: 1-877-825-2626

While BLANCO strives to provide accurate information, all images and dimensions in this document are intended for reference only and are subject to change at any time without notice. This document is not intended for use as an installation guide. For technical installation details, refer to installation instructions provided with the product. BLANCO assumes no responsibility for the use of superseded or voided specifications.

QUATRUS U 1 SUPER SINGLE


Stainless steel brushed finish

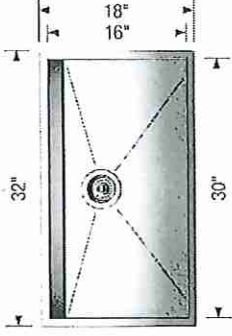

Standard Faucet

Lot 43 BLK53

✓

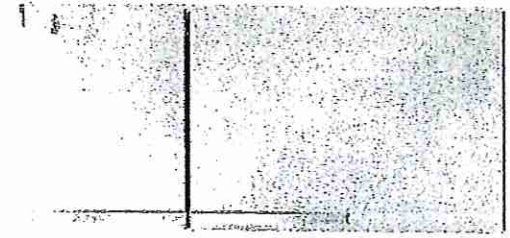

Whirlpool® 30" Wide Top-Freezer Refrigerator with Flexi-Slide™ Bin

WRT318FZDM

There's always a place for fresh and frozen favorites inside the 30" wide top-freezer refrigerator with 18 cu. ft. capacity. To give you more convenient storage options above the refrigerator crispser, the Flexi-Slide™ bin quickly moves side-to-side.

Top Features

- Flexi-Slide™ Bin**
Make space for tall items with the bin that quickly and easily moves side-to-side for convenient storage options.
- Quiet Cooling**
Keep noise down in the kitchen with a design that provides quiet cooling.
- Frameless Glass Shelves**
Store more items on each shelf with wall-to-wall frameless glass shelves, which offer greater storage flexibility.
- EZ Connect Icemaker Kit**
This optional icemaker adds convenient, easily accessible ice without having to worry about refilling ice trays.

Dimensions

Depth	33 1/2
Height	65 7/8
Width	29 3/4

Controls

Control Location	Interior
Max Cool/Fast Cool	No

Interior

Cabinet Color	Grey
Cabinet Finish	Smooth
Door Color	Stainless Steel
Door Finish	Smooth
Door Opening	Right
Handle Color	Stainless Steel
Handle Material	Metal
Handle Type	Reach-Through Handle

Exterior

Cabinet Color	Grey
Cabinet Finish	Smooth
Door Color	Stainless Steel
Door Finish	Smooth
Door Opening	Right
Handle Color	Stainless Steel
Handle Material	Metal
Handle Type	Reach-Through Handle

Appliance Volume and Shelf Area

Freezer Volume (Cu Ft)	5.09
Refrigerator Volume (Cu Ft)	15.06

Details

Cooling Type	Single Evaporator
Counter Depth	No
Door Style	Flat

Controls

Control Type	Electronic
Automatic Defrost	Yes

Available Finishes/Colours

- ☒ WRT318FZDB Black
- ☐ WRT318FZDW White


Manuals & Literature:

- Dimension Guide
- Energy Guide
- Installation Instructions
- Use and Care
- Warranty



Lot 43 BLK53

K2

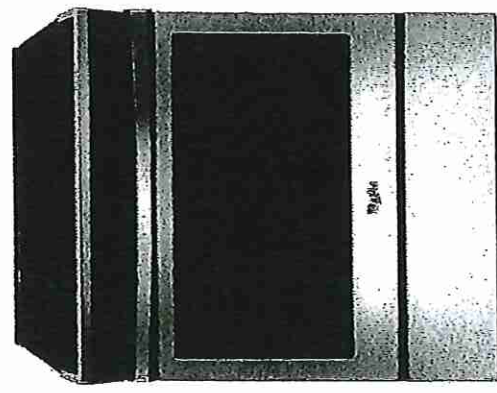

4.8 cu. ft. guided Electric Front Control Range
with the easy-wipe ceramic glass cooktop

YWEE510S0FS

Cook for the family, even on a hectic schedule with our 4.8 cu. ft. knobless electric front control range with the easy-wipe ceramic glass cooktop. This cooking range is designed with features that help you get dinner to the table quickly. Skip preheating for favorites like pizza and lasagna with Frozen Bake™ technology.

Top Features
Frozen Bake™ Technology
Frozen Bake™ technology cooks frozen foods faster by eliminating the need to preheat the oven. Just select the food type, temperature and cook time listed on the frozen item's package and the oven will start customizing. Now you can cook frozen pizza 31%
Guided Cooktop Controls
Control the heat without the guesswork. The knobless design uses up/down arrows to select the temperature you need, while heat level indicators show when you are simmering and melting.
FlexHeat™ Dual Radiant Elements
Get two elements in one with a 6" inner ring that's great for smaller pots and pans and a 9" expandable outer ring that makes room for larger cookware.

Dimensions		Features	
Depth	28 15/16"	Power Outage Compatible	No
Width	29 7/8"		
Configuration and Overview		Configuration	
Range Type	Slide-In	Range Configuration	Slide-In
		Oven Configuration	Single Oven
Exterior		Controls	
Door Removable	Yes	Display Color	Blue
Drawer Type	Storage Drawer	Electronic Display Type	LED
Door Type	Metal & Glass		
Oven Window Size	Extra Large		
Features		Cooktop Details	
Hot Surface Indicator Light	Yes	Number of Cooking Element-Burners	4
Heating Element On Indicator Light	Yes	Right Rear Element-Burner Size	6"
Power On Indicator Light	Yes		

Available Finishes/Colours

 YWEE510S0FB
Black

 YWEE510S0FV
Black Stainless

 YWEE510S0FW
White

 YWEE510S0FS
Black-on-Stainless

Manuals & Literature:

 [Installation Instructions](#)

 [Use and Care](#)

 [Warranty](#)



Because Whirlpool Corporation policy includes a continuous commitment to improve our products, we reserve the right to change materials and specifications without notice. Dimensions are for planning purposes only. For complete details, see Installation Instructions packed with product. Specifications subject to change without notice.

LOT 43 BLK 53

Whirlpool®

Heavy-Duty Dishwasher with 1-Hour Wash Cycle

WDF330PAHS

Get the right clean for your dishes with this heavy-duty dishwasher. Finish the job in half the time with the 1-hour wash cycle and rely on the soil sensor to adjust to the soil levels of your dishes for the most thorough clean. Count on this dishwasher, because no one has fewer repairs for over 20 years in a row.

Top Features

1-Hour Wash Cycle
Clean dishes in half the time so your plates, pans and glasses are thoroughly cleaned up and taken care of in just an hour.

Soil sensor
Determines how dirty dishes are and adjusts the Normal cycle as needed to make sure dishes come out clean.

Normal cycle
Use for normal amounts of food soil to clean up leftover messes from your day-to-day meals.

Heavy Cycle
Takes care of heavily soiled messes and other hard-to-clean dishes without the extra elbow grease by adding extra time to the cycle.

Available Finishes/Colours



WDF330PAHB
Black



WDF330PAHW
White

WDF330PAHS
Stainless Steel

WDF330PAHT
Biscuit

Manuals & Literature:

- [Dimension Guide](#)
- [Energy Guide](#)
- [Installation Instructions](#)
- [Use and Care](#)
- [Warranty](#)

Dimensions

Depth 24 1/2
Height 34 1/2
Width 23 7/8

Controls

Automatic Temperature Controls Yes
Control Type Push Button
Control Location Front
Last Cycle Recall Yes
Sensor Yes
Status Light White

Features

Dispensers Detergent and Rinse Aid
Sound Package Yes
Number of Wash Levels 4

Configuration and Overview

Decibel Level (dBA) 55

Exterior

Control Panel Color Black
Handle Color Black
Handle Material Plastic
True Hold Door Yes
Handle Type Short Pocket
Toe Panel Color Black

Compatibility

Works With No

Features

Rinse Aid Dispenser Level Indicator Yes


Lot 43 BLK 53

1.2



4.0 cu.ft I.E.C. Electric Stacked Laundry Center
9 Wash cycles and AutoDry™

YWET4027HW

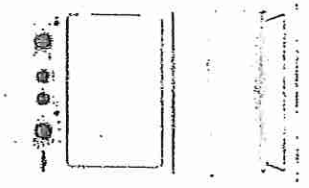

Get the capacity you want and the space you need with an electric stacked washer and dryer combination. The washer with fabric softener dispenser releases fabric softener at just the right time and the dryer automatically senses when clothes are ready and stops the cycle to help prevent overdrying.

Top Features

- Dual action Agitator with Fabric Softener Dispenser
Get dual action cleaning and convenient fabric softener dispensing at just the right time when you fill this cap with softener before the cycle begins.
- White Porcelain Basket
Keep your washer looking good thanks to the durable finish that resists scratches, chemicals and rust.
- AutoDry™ Drying System
Help prevent overdrying with the AutoDry™ drying system that senses when clothes have reached the right moisture content and stops the cycle.
- 4 Drying Cycles
Choose the right setting for each load when you dry with Normal, Delicate, Air Only or Timed Dry cycles.

Available Finishes/Colours

- ☐ YWET4027HW White

Manuals & Literature:

- Energy Guide
- Installation Instructions
- Use and Care

Dimensions

Depth	32 7/16	Washer Capacity (cu. ft.)	3.5
Height	75 1/2	Doors Included	No
Width	27 1/4	Motor Drive Type	Belt

Appearance

Dryer Door Reversible	No
-----------------------	----

Details

Advanced Vibration Control™	Yes
-----------------------------	-----

Dryer Capacity (cu. ft.)	5.9
Automatic Load Size Sensing Technology	Yes

Maximum Spn Speed (RPM)	690
-------------------------	-----

Controls

End of Cycle Signal	No
---------------------	----

Control Type	Dials
--------------	-------

LED Color	Green
-----------	-------

Electronic Display Type	No
-------------------------	----

Exterior

Window	No
--------	----

Cycles

Number of Wash Cycles	9
-----------------------	---

