



CONSTRUCTION SUMMARY

Grovetrail Developments Inc.

PURCHASERS: TERESA LUK PING LEE and PHILIP CHUN HO LEUNG

TEL: RES.: 416-317-2278

LOT NUMBER	PHASE	HOUSE TYPE	CLOSING DATE
41 Block 53	1	PALMER Elev A	12-Apr-22

Offer	BONUS PACKAGE FOR TOWNHOUSE: PURCHASER TO RECEIVE \$7,500.00 (INCLUSIVE OF TAXES) WORTH OF UPGRADES AT DECOR CENTRE AT TIME OF COLOUR CHART
Workshee	Note:

Offer	BONUS PACKAGE FOR TOWNHOUSE: 5 APPLIANCES TO INCLUDE FRIDGE, STOVE, DISHWASHER WITH STAINLESS STEEL FINISH AND WHITE WASHER AND DRYER AS PER VENDORS SAMPLES. DELIVERED ONLY - NOT INSTALLED.
Workshee	Note:



FILE COPY
SITE MASTER

CONSTRUCTION SUMMARY

Grovetrail Developments Inc.

PURCHASERS: TERESA LUK PING LEE and PHILIP CHUN HO LEUNG

TEL: RES.: 416-317-2278

LOT NUMBER	PHASE	HOUSE TYPE	CLOSING DATE
41 Block 53	1	PALMER Elev A	12-Apr-22

Date Added: 05-Nov-21 Invoice Number: 7545

1 - Standard Cable and Telephone location (See Sketch) Note:
1 - Purchaser has been made aware of the wall change between garage and powder room wall, and basement wall- As per Fonzie Note:
1 - MASTER BEDROOM- Delete & close off the entrance to the Walk in closet from the Master Bedroom. Relocate the Walk In Closet entrance to the Master Ensuite. Purchaser to enter into the Master Bedroom WIC from the Master Ensuite (See Sketch) Note: **No Charge As Per Fonzie**
1 - GARAGE DOOR- Install the builders standard garage door handle with lock Note:
1 - KITCHEN- Install an Upgrade #3 kitchen cabinets, throughout the kitchen, where applicable. Install teh Double Shaker MDF ESCARPMENT Note:
1 - KITCHEN- Install an Upgrade #1 Kitchen Package,as per the attached upgraded Kitchen & Bathroom Layouts. Note:
1 - KITCHEN- Install an upgrade edge for the counter top , throughout the kitchen, where applicable. Install the "L" Edge, in lieu of the builders standard edge Note:
50 - KITCHEN- Install an Upgrade #2 kitchen backsplash , in lieu of the builders standard. Install the 4X16 POLVERE DIAMONTE, To be installed Straight throughout teh kitchen (where appliacble) Does not include behind the fridge/stove Note:
1 - KITCHEN- Install an upgraded kitchen sink, in lieu of the builders standard undermount kitchen sink. Install the Blanco FORMERA U2 Model # 402243 Note: **PLEASE NOTE**Install the builders standard kitchen faucet**
1 - APPLIANCE PACKAGE- SUPPLY the Standard Appliance Package To be supplied ONLY for the home, where applicable. ONLY STANDARD-STOVE, D/W, WASHER & DRYER Note:
1 - KITCHEN- Upgrade ONLY the fridge in the kitchen, in lieu of the builders standard fridge. Upgrade to the Whirlpool 30" wide French door Model # WRF560SEHZ Note:
1 - KITCHEN- Install a rough in water line to fridge in the kitchen to accommodate the upgraded Whirlpool fridge. Note:
372 - MAIN FLOOR- Install an Upgrade #4 12x24 floor tile, BREACH on the main floor area, in lieu of the builders standard floor tile. To include the Foyer, Powder Room, lower Landing,and Kitchen area ONLY, to be installed Straight/Stacked (See Sketch) Note:
1 - MAIN FLOOR- Delete the builders standard floor tile in the Dinette area and the main hall between the Foyer and the Great Room. Install the Highland Collection Watson Natural Oak Model # EE-H-292 Note:
1 - SECOND FLOOR- Install the Highland Collection Watson Natural Oak Model # EE-H-292, in lieu of the builders standard carpet on the second floor. To be insatllted throughout the Upper Hall, Master Bedroom, Bedroom #2, #3 Note:



FILE COPY
SITE MASTER

CONSTRUCTION SUMMARY

Grovetrail Developments Inc.

PURCHASERS: TERESA LUK PING LEE and PHILIP CHUN HO LEUNG

TEL: RES.: 416-317-2278

LOT NUMBER	PHASE	HOUSE TYPE	CLOSING DATE
41 Block 53	1	PALMER Elev A	12-Apr-22

Date Added: 05-Nov-21 Invoice Number: 7545

1 - MAIN BATHROOM- In addition to the builders standard shower head, Install the Moen Eco Performance 1 Function Handshower with Slide Bar Model #3868/EP/A725 CHROME. Note:
1 - MASTER ENSUITE- In lieu of the builders standard shower stall faucet, Install the Moen Posi-Temp Belfield Posi Temp Shower Only with 3 Function Transfer Valve/Trim & Slide Bar with Hand ShowerModel # T2312EP/U361CI/UT4301/62320/6996EP/A725 Note:
1 - DINETTE- Shift the builders standard ceiling light towards the Dinette window. Builders standard ceiling to be APPROXIMATELY, 4'-0" away from the window (See Sketch) Note:
1 - GREAT ROOM- Shift the builders standard ceiling light towards the Great Room exterior wall. Builders standard ceiling to be APPROXIMATELY 4'-0" away from the wall (See Sketch) Note:
1 - ** As per the Purchase and Sale Agreement, purchaser to receive TEN (X10) standard potlights. See below for location of pot lights. Note:
1 - DEN- In addition to the builders standard ceiling light in the Den, Install TWO(x2) LED pot lights in the Den. Both Potlights to be installed on one seperate switch. (See Sketch) Note: **PLEASE NOTE** Purchaser has been charged only for the seperate switch.
1 - GREAT ROOM- In addition to the builders standard ceiling light in the Great Rm, Install FOUR (X4) LED pot lights in the Great Room. All FOUR (X4) Potlights to be installed on one seperate switch (See Sketch) Note: **PLEASE NOTE** Purchaser has been charged only for the additional seperate switch.
1 - KITCHEN- In addition to the builders standard ceiling light in the Kitchen, Install FOUR (X4) LED pot lights in the kitchen. All FOUR (X4) Potlights to be installed on one seperate switch (See Sketch) Note: **PLEASE NOTE** Seperate switch for teh potlights to be installed on the standard switch provided as per the Standrad Feature and Finsihes List.
1 - UPPER HALL- Relocate the builders standard Upper Hall ceiling light, to be installed centred (if possible) to the Open to Below area. (See Sketch) Note:
1 - PLUMBING- CLARIFICATION- MASTER ENSUITE / MAIN BATH/POWDER ROOM- Install the builders standard Plumbing Fixtures throughout all bathrooms, where applicable. Note: **PLEASE NOTE** Master Ensuite Shower Stall to have Upgraded shower fixture** **PLEASE NOTE** Main Bath Tub/Shower to have Upgraded Hand Held**
1 - COUNTER TOPS Purchaser accepts & acknowledges that the Stone slabs vary in size & all seams are visible & the fabricator reserves the right to position the seams as necessary. Note:
1 - COUNTER TOP- CLARIFICATION- MASTER ENSUITE / MAIN BATH/ POWDER RM- Install the Standard 3" Splash throughout all bathroom vanity counter tops, where applicable. To include the Main Bath, Master Ensuite & Powder Room Note:
1 - STAIRCASE VS FLOORING WOOD SPECIES DIFFERENCE: STAIRCASE - The purchaser was advised and therefore accepts and acknowledges that the wood species of the staircase and flooring chosen do not match. This difference may result in a stain colour variance. Note: The purchaser agrees that the vendor is to be exempt from any and all claims by the purchaser regarding this colour variance.
1 - STAIRCASE VS FLOORING STAINING DIFFERENCE: STAIRCASE - The purchaser was advised and therefore accepts and acknowledges that the stain of the staircase and flooring chosen do not match. This difference might result in an undesirable colour variance. Note: The purchaser agrees that the vendor is to be exempt from any and all claims by the purchaser regarding this colour variance.



FILE COPY
SITE MASTER

CONSTRUCTION SUMMARY

Grovetrail Developments Inc.

PURCHASERS: TERESA LUK PING LEE and PHILIP CHUN HO LEUNG

TEL: RES.: 416-317-2278

LOT NUMBER	PHASE	HOUSE TYPE	CLOSING DATE
41 Block 53	1	PALMER Elev A	12-Apr-22

Date Added: 05-Nov-21 Invoice Number: 7545

1 - PURCHASER HAS ATTENDED A COLOR APPOINTMENT AT THE DECOR CENTRE AND HAS DECLINED ANY ADDITIONAL UPGRADES.
Note:

1 - PURCHASER AWARE AND ACCEPTS THAT ANY CHANGES MADE TO UPGRADES AFTER SIGNING THIS PURCHASERS EXTRA FORM ARE SUBJECT TO A MINIMUM ADMINISTRATION FEE OF \$1,000 PLUS A 10% HOLDBACK FEE.
Note:

Date Added: 21-Sep-21 Invoice Number: 7505

1 - FRONT EXTERIOR DOUBLE DOOR- Due to the possible shortage of the original standard 3/4 glass pane front door, the purchaser has selected a substitute model. Purchaser has selected the substitute model of FULL GLASS pane, for the front double door entry.
Note: **See attached picture for reference** Purchaser is aware that if the original 3/4 glass pan front door is available at time of construction installation, original front door glass will be installed.

1 - PURCHASER AWARE AND ACCEPTS THAT ANY CHANGES MADE TO UPGRADES AFTER SIGNING THIS PURCHASERS EXTRA FORM ARE SUBJECT TO A MINIMUM ADMINISTRATION FEE OF \$1,000. PLUS A 10% HOLDBACK FEE.
Note:

Date Added: 26-Jul-21 Invoice Number: 7442

1 - KITCHEN- Install a GAS LINE-ROUGHIN FOR STOVE AND INCLUDES ELECTRICAL OUTLET for future Gas stove. Purchaser accepts and acknowledges that the Vendor will supply an electric stove as per their Purchase & Sale Agreement.
Note:

1 - PURCHASER AWARE AND ACCEPTS THAT ANY CHANGES MADE TO UPGRADES AFTER SIGNING THIS PURCHASERS EXTRA FORM ARE SUBJECT TO A MINIMUM ADMINISTRATION FEE OF \$1,000. PLUS A 10% HOLDBACK FEE.
Note:

1 - PURCHASER HAS ATTENDED A SCHEDULED STRUCTURAL APPOINTMENT BY PHONE WITH THE DECOR CENTRE ONLY MONDAY JUNE 28, 2021 AND HAS DECLINED ANY ADDITIONAL UPGRADES.
Note:

1 - BONUS PACKAGE - PURCHASER HAS APPLIED \$7,500 (INCLUDES HST) UPGRADE PROMOTIONAL PACKAGE TOWARDS THE PURCHASE PURCHASE OF UPGRADES IN THIS AGREEMENT. THE PURCHASER HAS A REMAINING BALANCE OF \$6,144 (INCLUSIVE OF TAXES) TO BE SPENT AT THE DESIGN STUDIO
Note:

This Document is Extremely Time Sensitive - Printed 8 Nov 21 at 9:43

Bedroom 3

Grovetrail Developments Inc.
Printed Nov 03, 2021 11:45 am

Gravelrail Developments Inc.
Printed Nov 03, 2021 11:45 am

* INTERIOR COLOUR SCHEME *

 Purchasers TERESA LUK PING LEE & PHILIP CHUN HO LEUNG	Decor Consultant Laura Di Pede	Model and Elevation PALMER Elev A	Telephone Res. / Bus (416) 317-2278 /	Project Grovetrail Developments Inc.	Closing Date 12/04/2022	Property 41 Block 53
--	--	---	---	--	-----------------------------------	--------------------------------

Purchaser(s) acknowledge the following

Arborite Counter Top Waiver:

Purchaser acknowledges that countertops are susceptible to damage/swelling from standing water. Care must be taken to ensure that countertops are kept free of standing water at joints and openings at sinks and faucets. Delamination can also occur caused by excessive heat from appliances and cooking equipment. Therefore, the Vendor assumes no responsibility for these conditions if caused by the Purchaser's negligence.

Hardwood Floor/Stair Waiver

Purchaser acknowledges and accepts that the hardwood flooring is pre-finished in a factory in a controlled environment and that the stairs are finished on site. The vendor will do their best to match the color between the stairs and the floor, but it is not possible to have an identical match and that there will be shade differences.

Standard Appliance Specifications Waiver:

In lieu of supplying appliance specifications and/or special requirements, the purchaser acknowledges that cabinetry will be made to allow for standard openings only. Standard opening sizes are as follows:

- Fridge: 36" wide x 72 1/2" high
- Stove: 31" wide
- Dishwasher: 24" wide
- OPTIONAL Microwave box: 24" wide x 15" high x 19" deep

and only those appliances that fit the standard openings should be selected and purchased.

Hardwood Floor Waiver:

Hardwood floors installed by the Vendor will be fully warranted for one full year against any defects in workmanship, due to improper installation. The Purchaser acknowledges and understands that the vendor will not be responsible to repair the natural drying out of wood that may cause shrinkage.

Changes:

This Colour Sheet is FINAL. ANY changes requested are subject to Builder approval and a minimum administration fee of \$1,000.00 will be charged.

Page 3 of 3

Decor Consultant:

Laura Di Pede

Purchaser:

DocuSigned by:

TERESA LUK PING LEE

Purchaser:

DocuSigned by:

PHILIP CHUN HO LEUNG

Vendor:

Grovetrail Developments Inc.



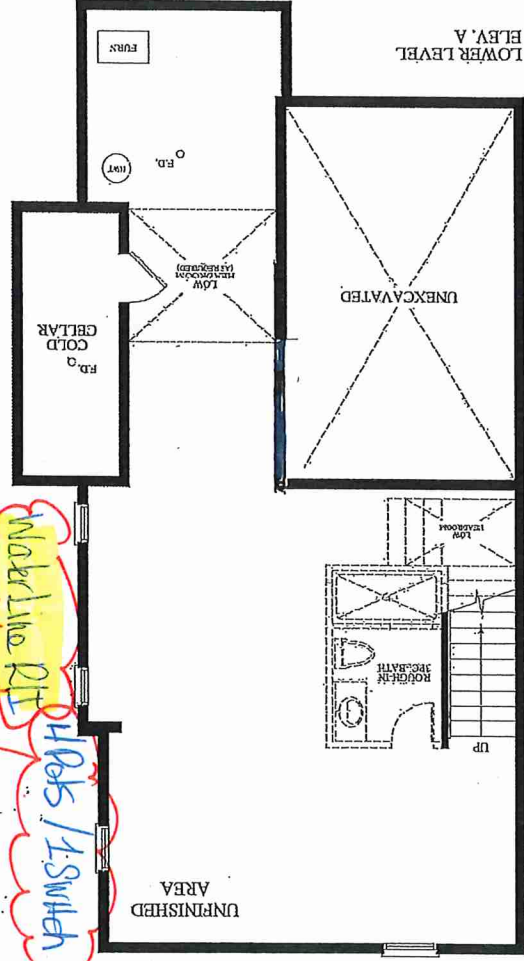


TABLE
Telephone
CONDUIT Next to (C)

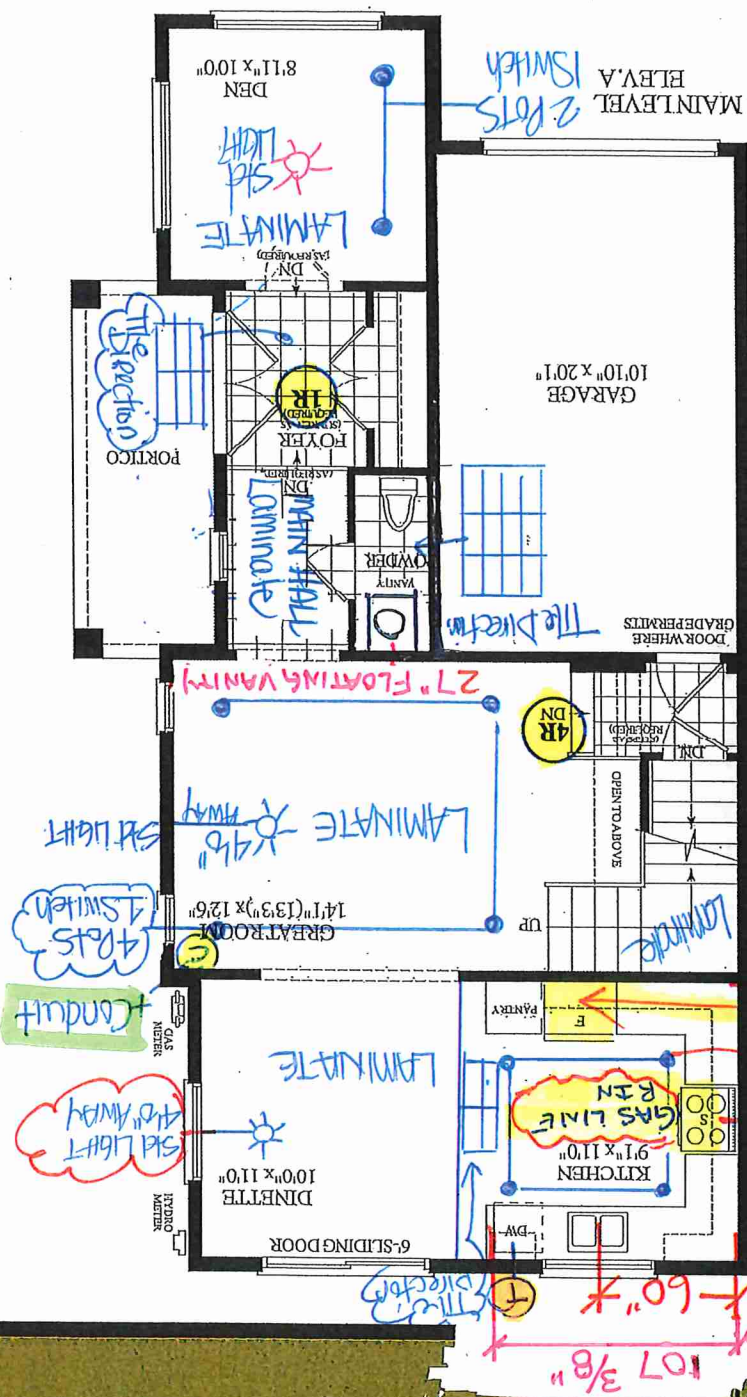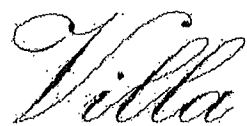

KITCHENS & FINE CABINETRY LTD

8111 Jane St. Unit 10
Concord, Ontario L4K 4L7
Tel. (905) 669- 7028
Fax. (905) 669 - 7903
email: designstudio@villakitchens.ca
www.villakitchens.ca

CLIENT: ROYAL PINE HOMES

PROJECT: CENTERFIELD

ADDRESS: RP-CE-MASTER

MODEL: PALMER 2011 CORNER UPG 1 PKG

KITCHEN

NOTE: THIS SITE GETS STD-CROWN

UPG 1 PACKAGE INCLUDES:

- DEEP FRIDGE UPPER
- POT DWR
- BASE BI-FOLD
- SOFT CLOSE DRS + DWRs
- TRAY CAB


LOT 41 BLK 53

DRAWN BY: DIDI

DATE: JUNE 18/2021

REVISION:

PAGE: 1 OF 3

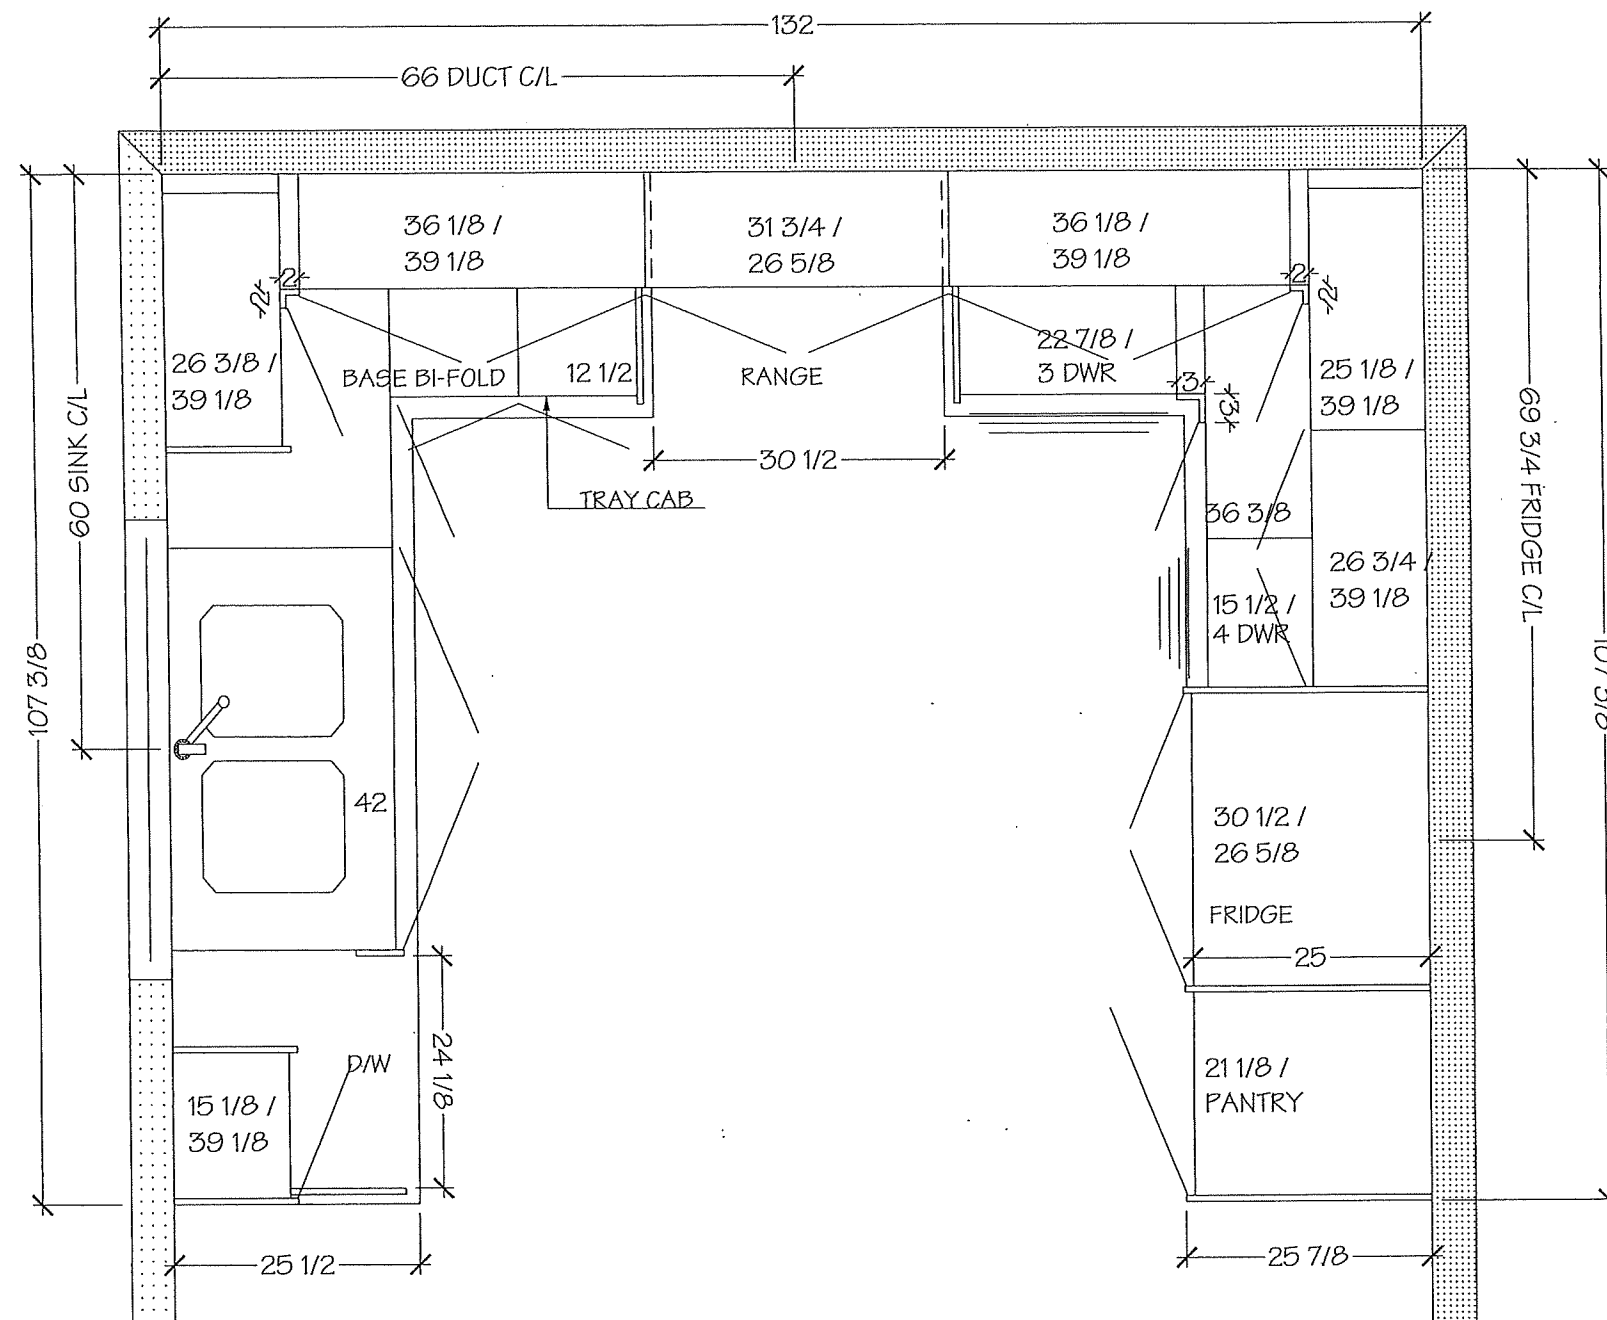

Villa

KITCHENS & FINE CABINETRY LTD

8111 Jane St. Unit 10
Concord, Ontario L4K 4L7
Tel. (905) 669- 7028
Fax. (905) 669 - 7903
email: designstudio@villakitchens.ca
www.villakitchens.ca

CLIENT: ROYAL PINE HOMES

PROJECT: CENTERFIELD

DRESS: RP-CE-MASTER

MODEL: PALMER 2011 CORNER UPG 1 PKG

VANIITES





LOT 41 BLK 53


DRAWN BY: DIDI

DATE: JUNE 18/2021

REVISION:

PAGE: 2 OF 3

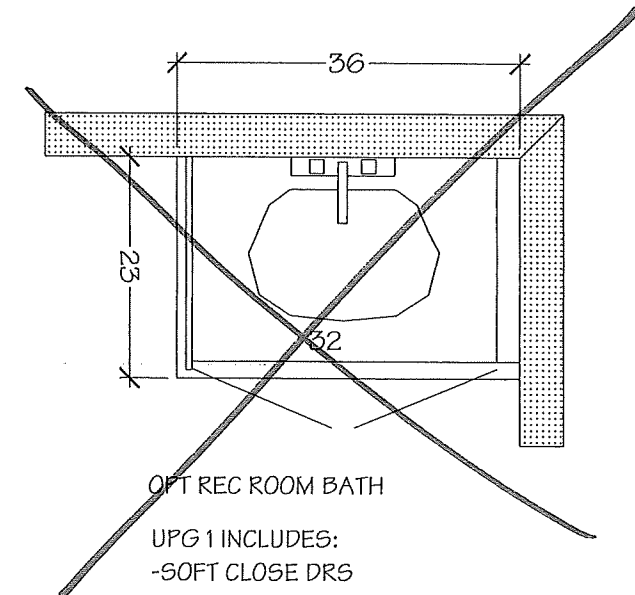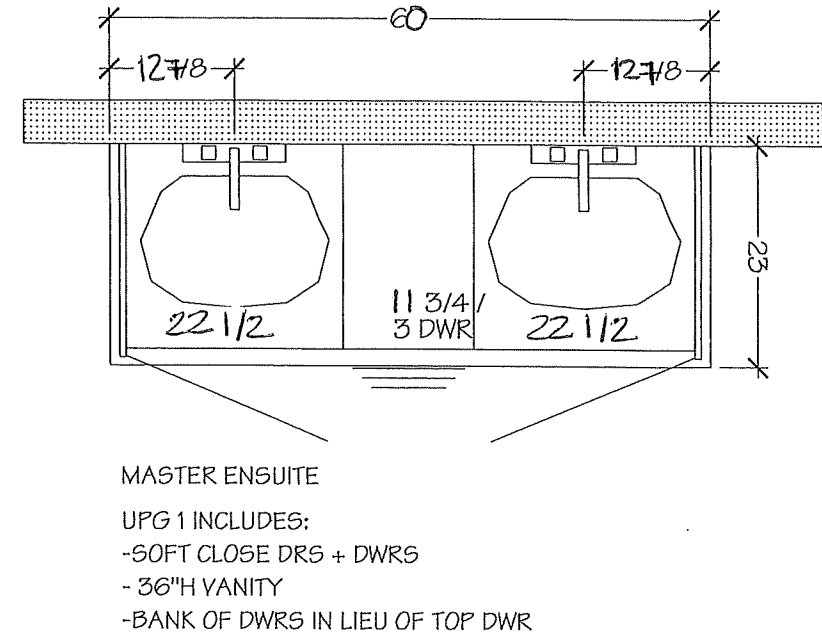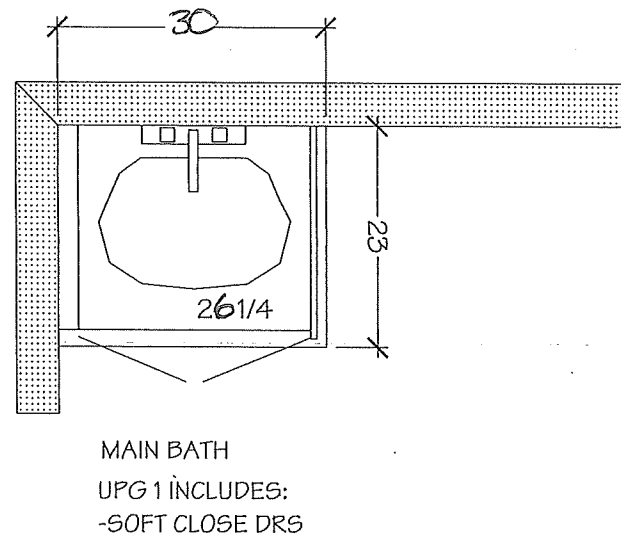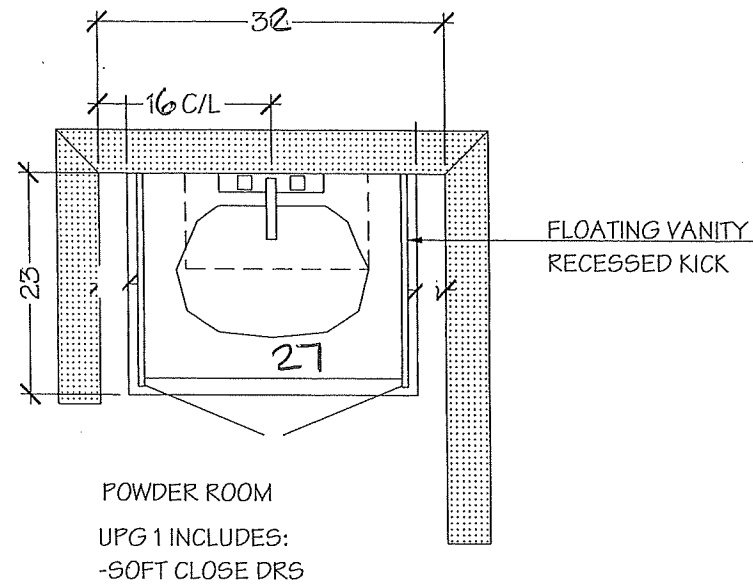

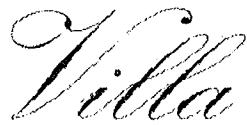

KITCHENS & FINE CABINETRY LTD

8111 Jane St. Unit 10
Concord, Ontario L4K 4L7
Tel. (905) 669- 7028
Fax. (905) 669 - 7903
email: designstudio@villakitchens.ca
www.villakitchens.ca

CLIENT: ROYAL PINE HOMES

PROJECT: CENTERFIELD

ADDRESS: RP-CE-MASTER


MODEL: PALMER 2011 CORNER UPG 1 PKG

KITCHEN

NOTE: BASED ON A
STANDARD
PROFILED CROWN

DT 41 BLK 53

DRAWN BY: DIDI
DATE: NOVEMBER 5/2021
REVISION:
PAGE: 1 OF 1

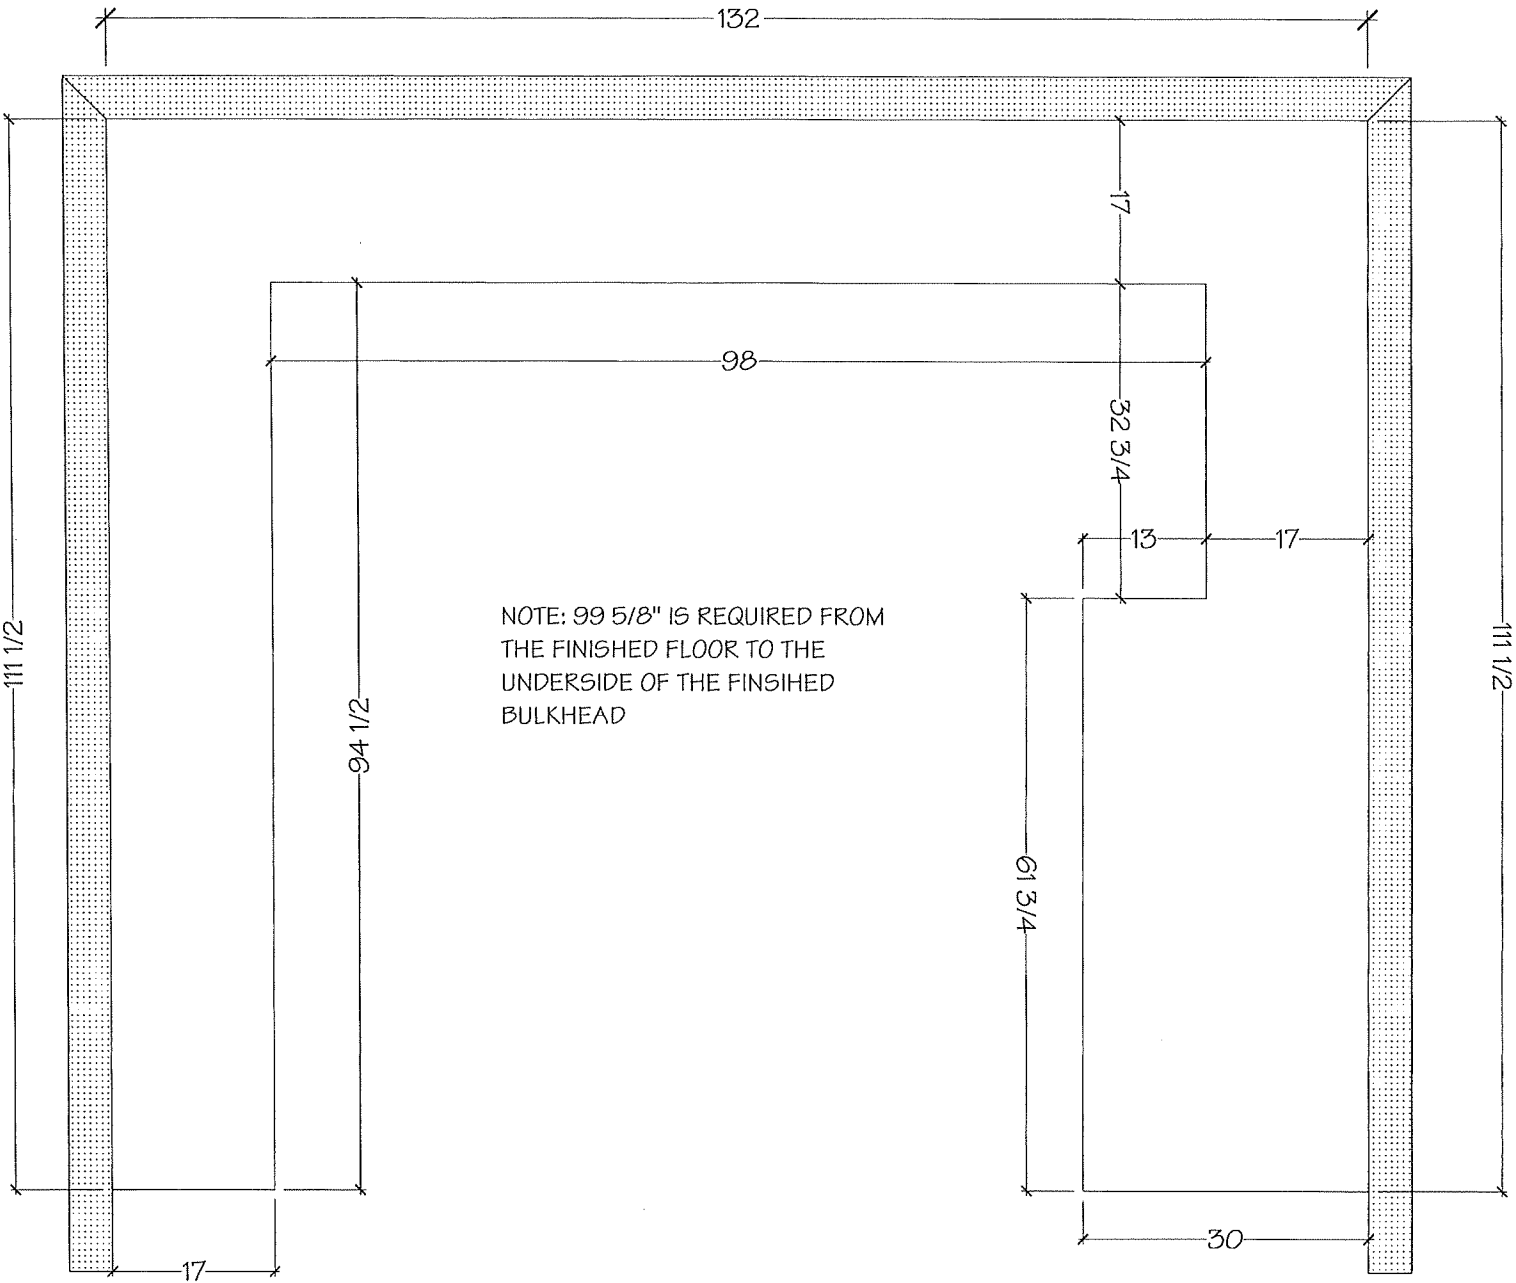

NOTE MEASURES ARE BASED ON FINISHED DRYWALLED


*Only If There Are Pipes *
Otherwise No Box

LOT 41 BLK 53
UPGRADE



30-inch Wide French Door Refrigerator - 20 cu. ft.

WRF560SEHZ

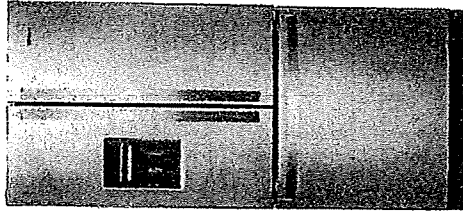

Available Finishes/Colours

- ☒ WRF560SEHB
Black
- ☐ WRF560SEHW
White
- ☒ WRF560SEHV
FingerPrint
Resistant Black
Stainless Steel
- ☐ WRF560SEHZ
FingerPrint
Resistant Stainless
Steel

Manuals & Literature:

- Dimension Guide
- Energy Guide
- Use and Care
- Warranty

Find purposefully-designed storage zones for items you use most in this 30-inch french door bottom freezer refrigerator. Humidity-controlled crispers let you store fruits and veggies in their ideal environment while adjustable gallon door bins add loading flexibility when and where you need it.

Top Features

- Adjustable Gallon Door Bins**
Move these adjustable bins anywhere in the door for increased loading flexibility when and where you need it.
- Tuck Shelf**
Make room for tall items. The front adjusts and slides out of the way, creating space for things like a 2-liter bottle or large salad bowl.
- Humidity-Controlled Crispers**
Store fruits and vegetables in their ideal environment.
- Spillproof Glass Shelves**
Simplify cleanup with shelves that help contain spills and prevent liquids from leaking below.

Dimensions		Configuration and Overview	
Depth	34 3/8	Number of Doors	3
Height	68 3/8	Compatibility	
Width	30	Connectivity	No
AHAM Volumes And Shelf Area		Works With	No
Freezer Volume (Cu Ft)	6.34	Details	
Refrigerator Volume (Cu Ft)	13.34	Advance Foam Insulation	99.9% lower Global Warming Potential and Better Energy Performance
Total Volume (Cu Ft)	19.7	Cooling Type	Single Evaporator
Configuration and Overview		Counter Depth	No
Advance Foam Insulation	99.9% lower Global Warming Potential and Better Energy Performance	Door Style	Contour
Counter Depth	No	Misc.	
		Accessory Relationships	
		Yes	

LASTMAN'S BAD BOY
Josh Robins
josh@noobody.com


500 Fenmar Drive
North York, ON M9L 2V5

Page 2 of 7



Because Whirlpool Corporation policy includes a continuous commitment to improve our products, we reserve the right to change materials and specifications without notice. Dimensions are for planning purposes only. For complete details, see Installation Instructions packed with product. Specifications subject to change without notice.

Lot 41 BLK53

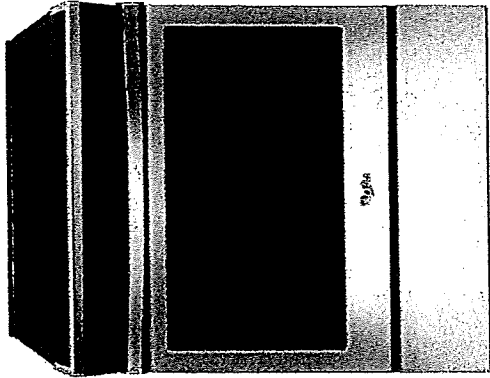

4.8 cu. ft. guided Electric Front Control Range
with the easy-wipe ceramic cooktop

YWEE510S0FS

Cook for the family, even on a hectic schedule with our 4.8 cu. ft. knobless electric front control range with the easy-wipe ceramic glass cooktop. This cooking range is designed with features that help you get dinner to the table quickly. Skip preheating for favorites like pizza and lasagna with Frozen Bake™ technology.

Top Features

Frozen Bake™ Technology

Frozen Bake™ technology cooks frozen foods faster by eliminating the need to preheat the oven. Just select the food type, temperature and cook time listed on the frozen item's package and the oven will start customizing. Now you can cook frozen pizza 31% faster.

Guided Cooktop Controls

Control the heat without the guesswork. The knobless design uses up/down arrows to select the temperature you need, while heat level indicators show when you are simmering and melting.

FlexHeat™ Dual Radiant Elements

Get two elements in one with a 6" inner ring that's great for smaller pots and pans and a 9" expandable outer ring that makes room for larger cookware.

Dimensions

Depth 28 15/16"

Width 29 7/8"

Features

Power Outage Compatible No

Configuration and Oven View

Range Type Slide-In

Configuration

Range Configuration Slide-In

Oven Configuration Single Oven

Exterior

Door Removable Yes

Drawer Type Storage Drawer

Door Type Metal & Glass

Oven Window Size Extra Large

Controls

Display Color Blue

Electronic Display Type LED

Cooktop Details

Number of Cooking Element-Burners 4

Right Rear Element-Burner Size 6"

Features

Hot Surface Indicator Light Yes

Heating Element On Indicator Light Yes

Power On Indicator Light Yes

Available Finishes/Colours

YWEE510S0FB Black

YWEE510S0FS Black-Or-Stainless

YWEE510S0FV Black Stainless

YWEE510S0FW White

Manuals & Literature:

Installation Instructions


Use and Care

Warranty



LOT 41 BLK 53

Whirlpool®

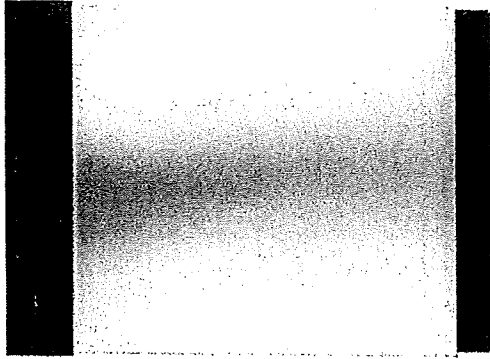

Available Finishes/Colours

- ☒ WDF330PAHB
Black
- ☐ WDF330PAHW
White
- ☐ WDF330PAHS
Stainless Steel
- ☐ WDF330PAHT
Biscuit

Manuals & Literature:

-  [Dimension Guide](#)
-  [Energy Guide](#)
-  [Installation Instructions](#)
-  [Use and Care](#)
-  [Warranty](#)

Heavy-Duty Dishwasher with 1-Hour Wash Cycle

WDF330PAHS

Get the right clean for your dishes with this heavy-duty dishwasher. Finish the job in half the time with the 1-hour wash cycle and rely on the soil sensor to adjust to the soil levels of your dishes for the most thorough clean. Count on this dishwasher, because no one has fewer repairs for over 20 years in a row.

Top Features

1-Hour Wash Cycle

Clean dishes in half the time so your plates, pans and glasses are thoroughly cleaned up and taken care of in just an hour.

Soil sensor

Determines how dirty dishes are and adjusts the Normal cycle as needed to make sure dishes come out clean.

Normal cycle

Use for normal amounts of food soil to clean up leftover messes from your day-to-day meals.

Heavy Cycle

Takes care of heavily soiled messes and other hard-to-clean dishes without the extra elbow grease by adding extra time to the cycle

Dimensions		Features	
Depth	24 1/2	Dispensers	Detergent and Rinse Aid
Height	34 1/2	Sound Package	Yes
Width	23 7/8	Number of Wash Levels	4

Controls

Automatic Temperature Controls	Yes
Control Type	Push Button
Control Location	Front
Last Cycle Recall	Yes
Sensor	Yes
Status Light	White

Configuration and Overview

Decibel Level (dBA)	55
---------------------	----

Exterior

Control Panel Color	Black
Handle Color	Black
Handle Material	Plastic
True Hold Door	Yes
Handle Type	Short Pocket
Toe Panel Color	Black


Compatibility

Works With	No
------------	----

Features

Rinse Aid Dispenser Level Indicator	Yes
-------------------------------------	-----

Lot 41 BLK53

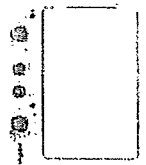

4.0 cu.ft I.E.C. Electric Stacked Laundry Center
9 Wash cycles and AutoDry™

YWET4027HW

Get the capacity you want and the space you need with an electric stacked washer and dryer combination. The washer with fabric softener dispenser releases fabric softener at just the right time and the dryer automatically senses when clothes are ready and stops the cycle to help prevent overdrying.

Top Features

Dual action Agitator with Fabric Softener Dispenser
Get dual action cleaning and convenient fabric softener dispensing at just the right time when you fill this cap with softener before the cycle begins.

White Porcelain Basket

Keep your washer looking good thanks to the durable finish that resists scratches, chemicals and rust.

AutoDry™ Drying System

Help prevent overdrying with the AutoDry™ drying system that senses when clothes have reached the right moisture content and stops the cycle.

4 Drying Cycles

Choose the right setting for each load when you dry with Normal, Delicate, Air Only or Timed Dry cycles.

Available Finishes/Colours




YWET4027HW
White


Manuals & Literature:



Energy Guide

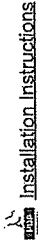

Installation Instructions

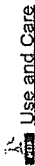

Use and Care

Dimensions

Depth	32 7/16	Washer Capacity (cu. ft.)	3.5
Height	75 1/2	Hoses Included	No
Width	27 1/4	Motor Drive Type	Belt

Details

Washer Capacity (cu. ft.)	3.5
Hoses Included	No
Motor Drive Type	Belt

Appearance

Dryer Door Reversible

No

Controls

End of Cycle Signal

No

Control Type

Dials

Details

Advanced Vibration Control™

Yes

LED Color

Green

Electronic Display Type

No

Dryer Capacity (cu. ft.)

5.9

Automatic Load Size Sensing Technology

Yes

Maximum Spin Speed (RPM)

690

Exterior

Window

No

Cycles

Number of Wash Cycles

9



BLANCO

LOT 41 BL:53.

Sink Specifications

Colour SKU
 402243

FORMERA U 2
Stainless steel

Design and planning tips




- Min cabinet size: 36 in (915 mm)
- Bowl Depth: 9 in (230.0 mm)

Specifications:

Sink template, Installation instructions, Clips,
3½" (90 mm) stainless steel strainer(s), Limited
Lifetime Warranty

Depending on cabinet construction, a different
cabinet size may be required. Consult the cabinet
manufacturer.

Codes/Standards: ASME A112.19.3-2017/ CSA
B45.4-17

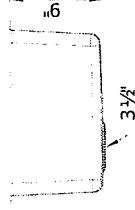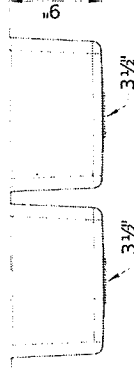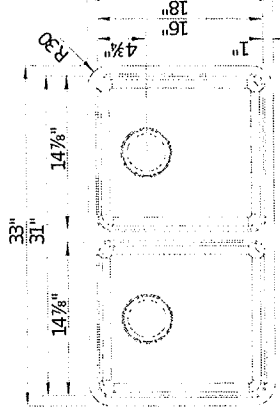

~~Optional Accessories~~

~~Sink Grid 402250~~

~~CapFlow Strainer Cover 517666~~

** Standard Kitchen Faucet **

Warranty

Limited lifetime warranty on all sinks and faucets. One-year warranty on all accessories and soap dispensers.

Code/Standards Compliance

BLANCO sinks and faucets are third-party tested and certified to CSA, cUPC, ANSI/ASME, IAPMO and NSF standards and listed by applicable certification bodies. For more information on individual product listings, contact our office or listing organization.



Need support? Learn more by watching our sink & faucet How-to videos:

<https://www.blanco.com/ca-en/support/how-to-videos/how-to-videos-for-sinks/>



BLANCO Canada Inc
100 Corporation Drive
Brampton ON L6S 6B5

Tel & Fax

Tel: 905-494-2400 Toll free: 1-877-425-2626

Fax: 905-494-2425 Toll free: 1-877-825-2626

While BLANCO strives to provide accurate information, all images and dimensions in this document are intended for reference only and are subject to change at any time without notice. This document is not intended for use as an installation guide. For technical installation details, refer to installation instructions provided with the product. BLANCO assumes no responsibility for the use of superseded or voided specifications.


LOT 41 BLK 53.

MASTER SUITE

Belfield™

Traditional | Transitional | Modern

Williamsburg-era details and intricate design cues give each Belfield faucet a timeless look, while multiple finish options add a distinctly personalized touch to the traditional styling

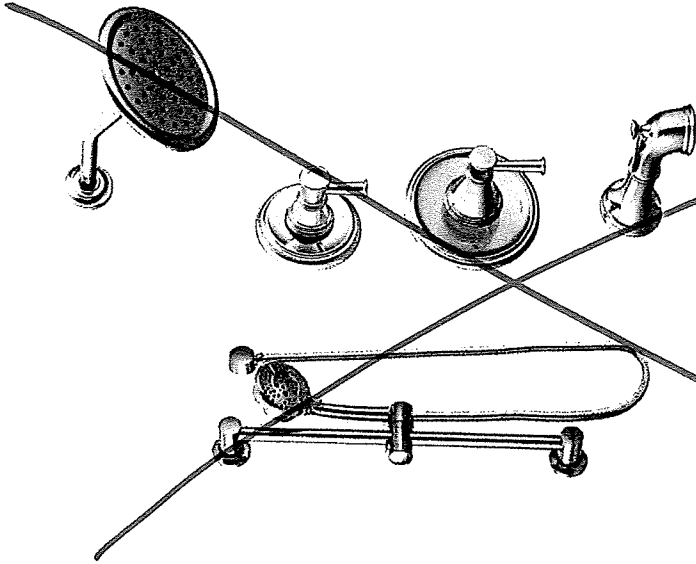


Posi-Temp® Tub/Shower Faucet
with 3 Function Transfer Valve/Trim
and Slide Bar with Hand Shower *

For NL, please use 3667EPNL slide bar

Model T2313EP / U361CI / UT4301 /
62320 / 3669EP / A725

Chrome - \$1,408.26
Other - \$2,282.70

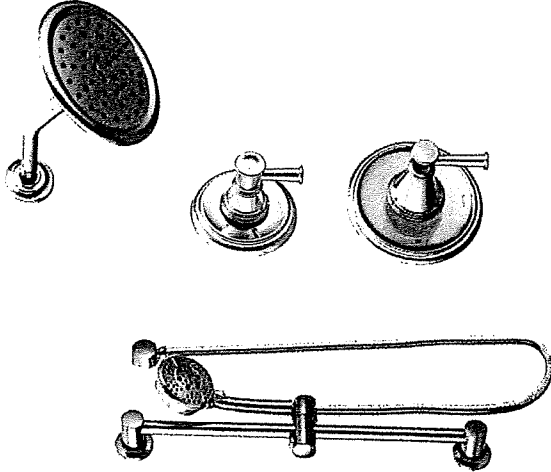


Posi-Temp® Shower Only
with 3 Function Transfer Valve/Trim
and Slide Bar with Hand Shower *

For NL, please use 3667EPNL slide bar

Model T2312EP / U361CI / UT4301 / 62320 /
3669EP / A725

*Chrome - \$1,334.46
Other - \$2,179.36

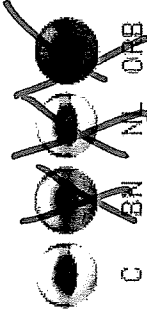

FINISH OPTIONS:

To order, combine the model number with one of these finish letter(s):
LifeShine® Brushed Nickel (BN), Polished Nickel (NL) & Oil Rubbed Bronze (ORB).
To order Chrome (C) model, use model number only.
Please see the 2020 Shower Design Guide for installation

LOT 41 BLK 53

MAIN BATHROOM

Handshowers with Slide Bars


Align™ Eco-Performance 1 Function Handshower with Slide Bar
Model 3867EP / A725

Chromef - \$528.06
Otherf - \$1,060.98

C BN BG BL


Eco-Performance 4 Function Handshower with Slide Bar
Model 3869EP / A725


Chromef - \$494.58
Otherf - \$1,060.98

C ORB BG BL


Eco-Performance 1 Function Handshower with Slide Bar
Model 3868EP / A725


Chromef - \$417.18
Otherf - \$663.24

C BN BG ORB

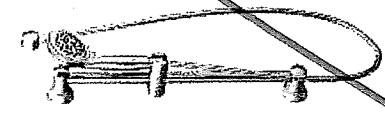
Envi™ Eco-Performance 1 Function Handshower with Slide Bar
Model 3863EP / A725


Chromef - \$494.58
Otherf - \$1,060.98

C BN

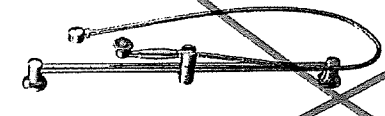
Kingsley™ Eco-Performance 1 Function Handshower with Slide Bar
Model 3869EP / A725

Chromef - \$621.84
Otherf - \$1,060.98

C BN ORB WR

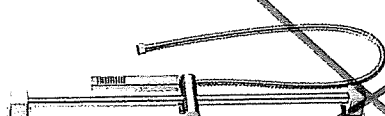
Eco-Performance 1 Function Round/Square Handshower with Slide Bar
Model 3988EP / A725

Chromef - \$550.44
Otherf - \$1,083.84

C BN ORB

FINISH OPTIONS:

To order, combine the model number with one of these finish letter(s):

LifeShine® Brushed Nickel (BN), Oil Rubbed Bronze (ORB), Matte Black (BL), Brushed Gold (BG) & Wrought Iron (WR).


To order Chrome (C), use model number only.

LOT 41 BLK 53

EDGE
DETAILS

004


A.

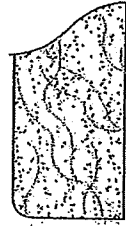

STRAIGHT EDGE
(STANDARD - 3/4")


- * POWDER ROOM
- * MASTER ENSUITE
- * MAIN BATHROOM

** L.

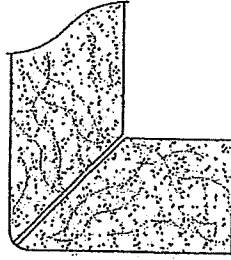

- * Kitchen

MITER WITH SKIRT EDGE
(MEDIUM - 1 1/2")

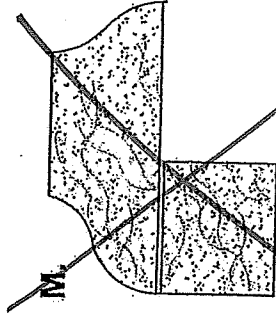

OGEE - SQUARE EDGE
(MED./HIGH - 1 1/2")

EDGING UP-GRADE OPTIONS

RECEIVED
11/25/17