




Release Code: R7.0 SW L1-L2 P#1 BENDING DETAILS.

Bar Mark	Qty	Size	Total length	Type	'A'	'B'	'C'	'D'	'E'	'F'	'G'	'H'	'J'	'K'	'U'	'V'
248	10M	3400														
72	10M	7000														
12	20M	7000														
4	20M	3140														
12	10M	3140														
18	10M	2920														
12	15M	1300														
12	15M	7000														
4	20M	2220														
12	10M	2220														
1004	96	10M	1030	IT			450	130	450							
1517	16	15M	1430	IT			650	130	650							
2020	16	20M	1860	IT			850	160	850							
1516	33	15M	1200	IT			600	600								

DRAWING REVIEW
 This review of this drawing does not in any way relieve the contractor of responsibility for its accuracy or for compliance with the contract documents.

No comment	See comment
Amend & Resubmit	Rejected See Remarks

Submission No. 19066
 Project No. 19066
 By: AJ
 Date: 28 May 2021
 JABLONSKY, AST AND PARTNERS
 Consulting Engineers
 3 Concorde Gate, North York, ON M3C 4H8

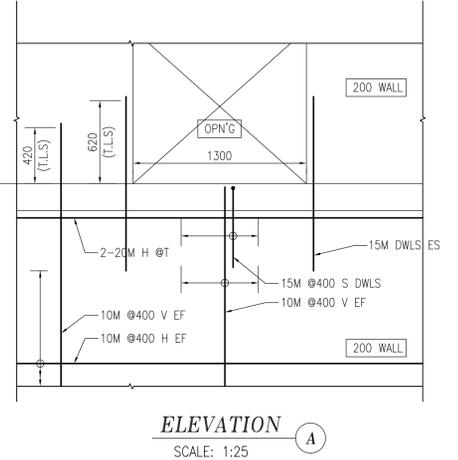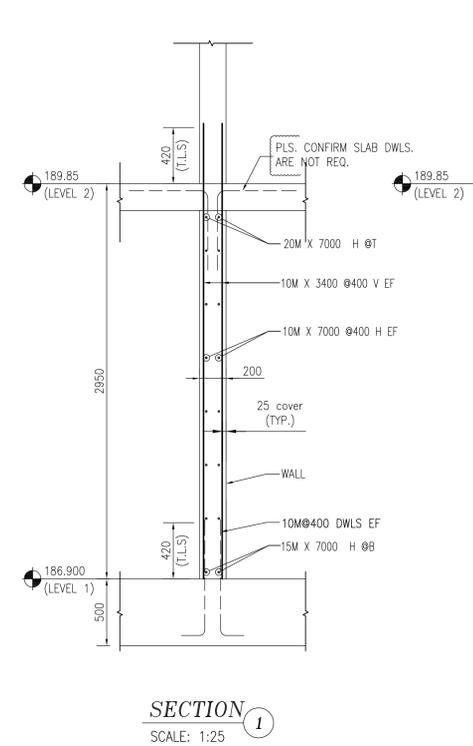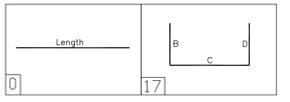

* ELEVATIONS AND DIMENSIONS SHOWN ARE FOR VERIFICATION PURPOSES ONLY AND ARE NOT TO BE USED FOR CONSTRUCTION
 * ALL CONFIRMS/VERIFIES WILL BE ASSUMED CORRECT AND APPROVED AS IS UNLESS COMMENTED ON THE APPROVAL DRWS

LEGEND

ALT = ALTERNATE	FF = FAR FACE	OF = OUTSIDE FACE
BOT = BOTTOM	FS = FORM SAVER	SC = SAW CUT END
BIS = BEND INTO SLAB	GI0 = GROUT IN DOWELS	STG = STAGGER
CB = CORNER BAR	H = HORIZONTAL	STR = STRIPS
CJ = CONTROL JOINT	I = INSIDE FACE	T = TOP
CS = CUT TO SUIT SITE COND.	IF = INSIDE FACE	THR/1 = THREAD LENG
DWL = DWELS	LL = LOWER LAYER	THR/2 = THREAD ZENIS
EE = EACH END	MID = MIDDLE	UL = UPPER LAYER
EF = EACH FACE	MIN = MINIMUM	V/N = UNLESS NOTED
EJ = EXPANSION JOINT	NF = NEAR FACE	V = VERTICAL
ES = EACH SIDE	OC = ON CENTER	TT = TAMP. TIES
EW = EACH WAY		

STRAIGHT BARS LABEL FORMAT
 7 B15M X 3600
 QUANTITY, GRADE, LENGTH

BENT BARS LABEL FORMAT
 7 B15M B1501
 QUANTITY, GRADE, SIZE, BAR MARK

GRADES OF STEEL
 B = GRADE 400
 C = CRACK COATED
 F = F500
 S = STAINLESS
 W = WELDABLE

NOTES

- ALL STEEL TO BE GRADE 400W
- STRENGTH OF CONCRETE
 35MPa - SLAB
 35MPa - INTERIOR COLUMNS & WALLS
- CONCRETE COVER:
 WALLS --- 25mm

4. COMPRESSION LAP SPLICE

BAR SIZE	STANDARD LAP (mm)
10M	300
15M	440
20M	590
25M	730
30M	880
35M	1030

5. TENSION LAP SPLICE (L.S.) & DEVELOPMENT LENGTH (Ld)

BAR SIZE	f _c =25		f _c =30		f _c =35	
	L.S.	L.d	L.S.	L.d	L.S.	L.d
10M	490	380	450	350	420	320
15M	740	570	670	520	620	480
20M	980	750	890	690	830	640
25M	1530	1170	1390	1070	1290	990
30M	1830	1410	1670	1290	1550	1190
35M	2130	1640	1950	1500	1800	1390

FOR APPROVAL: MAY/19/21 JJ


MANSTEEL REBAR
 105 Industrial Road, Richmond Hill, Ontario L4C 2Y4 Canada
 Phone: 905-737-9797
 Fax: 905-737-9724
 Email: Info@mansteelrebar.com

FORESTSIDE TOWNHOUSES - BRAMPTON, ON


PROJECT: SHEAR WALLS L1-L2 P#1

CUSTOMER: ROYAL PINE HOMES

Project no. 2177
 SCALE: AS SHOWN
 DRAWING No. R7.0

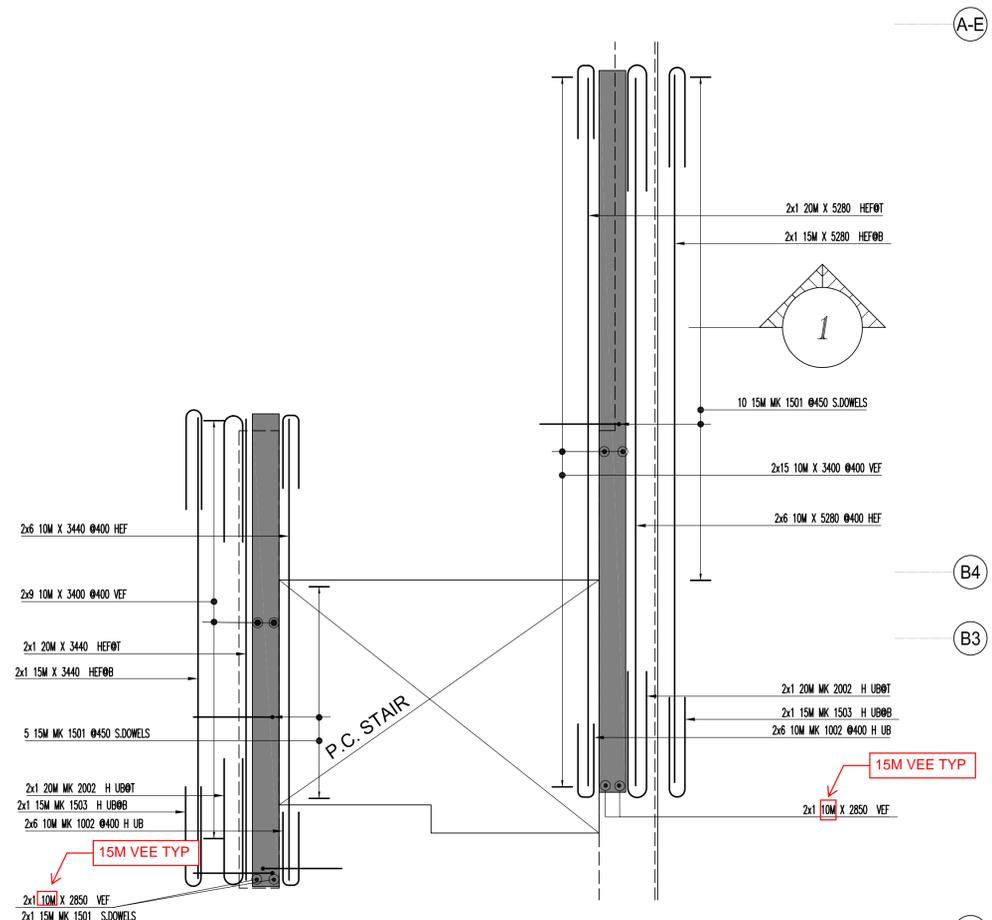

BUILDING-A
STAIR WALL PLAN L1-L2
 SCALE: 1:25 (POUR-1; POUR#4 SIM.)
 (2 NOS REQUIRED)

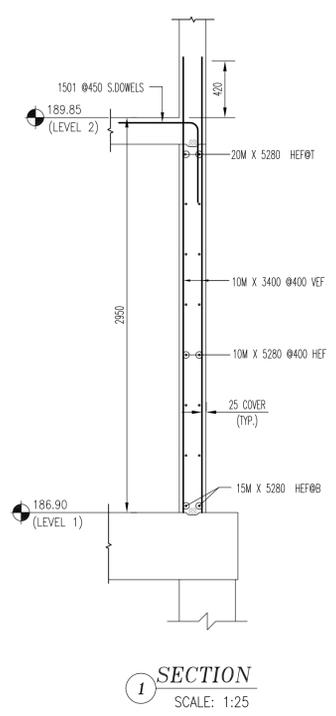


SECTION 1
 SCALE: 1:25

Release Code: R7.1 STAIR SW L1-L2 P# BENDING DETAILS.

Bar Mark	Qty	Size	Total length	Type	A'	B'	C'	D'	E'	F'	G'	H'	I'	J'	K'	L'	M'
12 10M	5280		5280														
2 20M	5280		5280														
2 15M	5280		5280														
2 20M	3440		3440														
2 15M	3440		3440														
12 10M	3440		3440														
2 10M	2850		2850														
2 10M	2850		2850														
48 10M	3400		3400														
1002	24 10M	1230 17			550	130	550										
2002	4 20M	2060 17			950	160	950										
1503	4 15M	1630 17			750	130	750										
1501	17 15M	1200 17			600	600											

Release Code: R7.1 STAIR SW L1-L2 P# BENDING DETAILS.

Bar Mark	Qty	Size	Total length	Type	A'	B'	C'	D'	E'	F'	G'	H'	I'	J'	K'	L'	M'
2 20M	5280		5280														
48 10M	3400		3400														
2 15M	5280		5280														
2 20M	3440		3440														
2 15M	3440		3440														
12 10M	3440		3440														
2 10M	2850		2850														
2 10M	2850		2850														
12 10M	5280		5280														
1002	24 10M	1230 17			550	130	550										
1503	4 15M	1630 17			750	130	750										
2002	4 20M	2060 17			950	160	950										
1501	17 15M	1200 17			600	600											

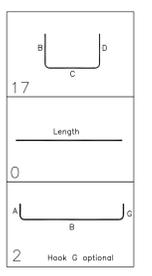

DRAWING REVIEW
 This review of this drawing does not in any way relieve the contractor of responsibility for its accuracy or for compliance with the contract documents.

No comment	See comment
Amend & Resubmit	Rejected See Remarks

Submission No. _____
 Project No. 19066
 By: AJ
 Date: 28 May 2021
 JABLONSKY, AST AND PARTNERS
 Consulting Engineers
 3 Concorde Gate, North York, ON M3C 4H8


- NOTES**
- ALL STEEL TO BE GRADE 400W
 - STRENGTH OF CONCRETE 35MPa - INTERIOR COLUMNS & WALLS
 - CONCRETE COVER: VERTICALS -- 25mm

4. COMPRESSION LAP SPlice

BAR SIZE	STANDARD LAP (mm)
10M	300
15M	440
20M	590
25M	730
30M	880
35M	1030

5. TENSION LAP SPlice (L.S.) & DEVELOPMENT LENGTH (Ld) (FOR WALL OR COL & Ld IN CAP OR FTG.)

BAR SIZE	fc=25		fc=30		fc=35	
	L.S	L.d	L.S	L.d	L.S	L.d
10M	490	380	450	350	420	320
15M	740	570	670	520	620	480
20M	980	750	890	690	830	640
25M	1530	1170	1390	1070	1290	990
30M	1830	1410	1670	1290	1550	1190
35M	2130	1640	1950	1500	1800	1390

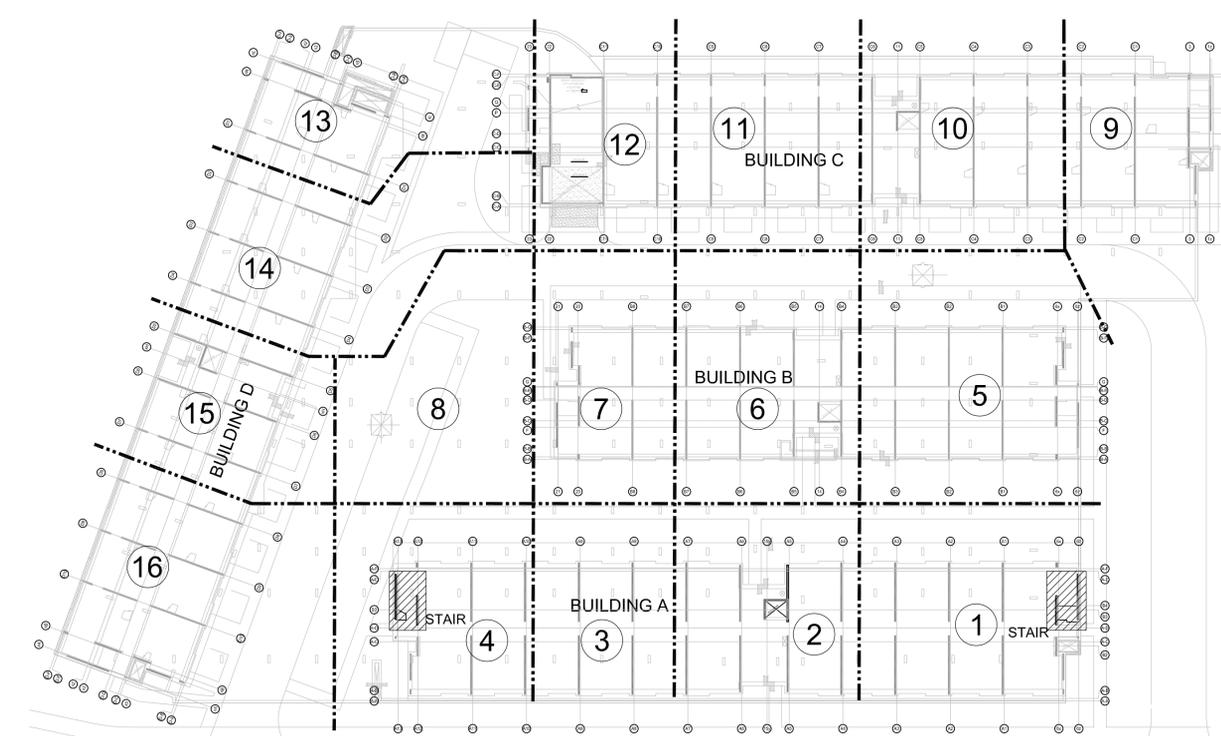

KEY PLAN
 SCALE: NTS

* ELEVATIONS AND DIMENSIONS SHOWN ARE FOR VERIFICATION PURPOSES ONLY AND ARE NOT TO BE USED FOR CONSTRUCTION
 * ALL CONFIRMS/VERIFIES WILL BE ASSUMED CORRECT AND APPROVED AS IS UNLESS COMMENTED ON THE APPROVAL DRGWS

LEGEND

ALT = ALTERNATE	FF = FAR FACE	OF = OUTSIDE FACE
BOT = BOTTOM	FS = FORM SAWER	SC = SAW CUT END
BIS = BEND INTO SLAB	GD = GRID IN DOWELS	STG = STAGGER
CB = CORNER BAR	H = HORIZONTAL	STR = STRIPS
CJ = CONTROL JOINT	IF = INSIDE FACE	T = TOP
CS = CUT TO SUIT SITE COND.	LL = LOWER LAYER	THR/1 = THREAD END
DWL = DOWELS	ML = MIDDLE	THR/2 = THREAD ZENIS
EE = EACH END	MIN = MINIMUM	UL = UPPER LAYER
EF = EACH FACE	NF = NEAR FACE	V/N = UNLESS NOTED
EJ = EXPANSION JOINT	OC = ON CENTER	V = VERTICAL
ES = EACH SIDE	TT = TEMP. TIES	
EW = EACH WAY		

STRAIGHT BARS LABEL FORMAT
 7 B15M X 3600
 QUANTITY, GRADE, LENGTH

BENT BARS LABEL FORMAT
 7 B15M B1501
 QUANTITY, GRADE, LENGTH, BAR MARK

GRADES OF STEEL
 B = GRADE 400W
 C = CRACK CORRECTED
 F = F600
 S = STAINLESS
 W = WELDABLE

FOR APPROVAL: MAY/19/21 JJ

ISSUE: _____ REMARKS: _____ DATE: _____ BY: _____


MANSTEEL REBAR
 105 Industrial Road, Richmond Hill, Ontario L4C 2Y4 Canada
 Phone: 905-737-9797
 Fax: 905-737-9724
 Email: Info@mansteelrebar.com

PROJECT: **FORESTSIDE TOWNHOUSES - BRAMPTON, ON**
 PART OF STRUCTURE: **STAIR SHEAR WALLS L1-L2 P#1&4**

CUSTOMER: ROYAL PINE HOMES
 Project no. 2177
 SCALE: AS SHOWN



DETAILED BY: JJ
 BAR LIST No. _____
 CHECKED BY: _____

DRAWING No. **R7.1**

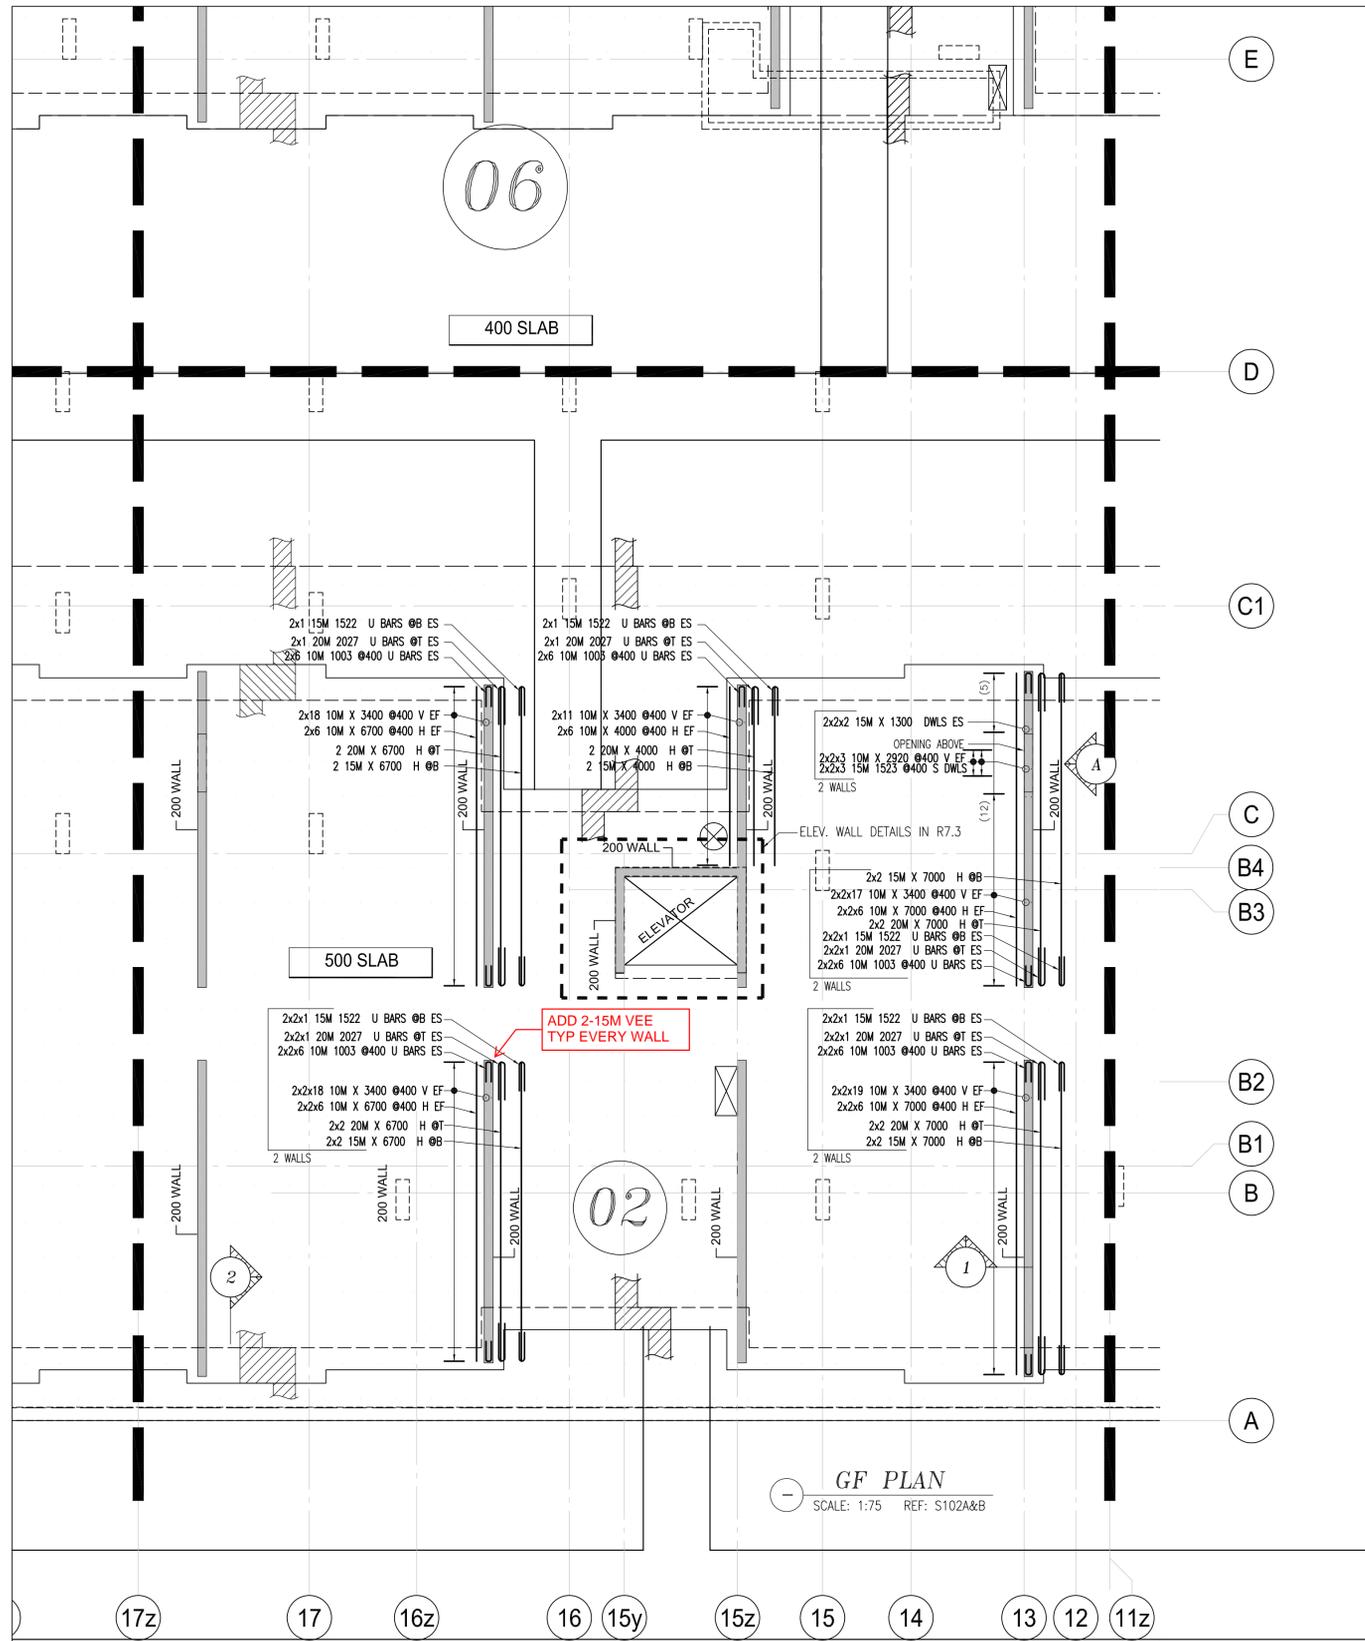

Release Code: R7.2 SW L1-L2 P#2 BENDING DETAILS.

Bar Mark	Qty	Size	Total length	Type	'A'	'B'	'C'	'D'	'E'	'F'	'G'	'H'	'I'	'J'	'K'	'L'	'M'
815M	7000																
27410M	3400																
4810M	7000																
820M	7000																
1210M	2920																
815M	1300																
615M	6700																
620M	6700																
3610M	6700																
215M	4000																
220M	4000																
1210M	4000																
1003	9610M	1030	11		450	130	450										
1522	1615M	1430	11		650	130	650										
2027	1620M	1860	11		850	160	850										
1523	1215M	1200	11		600	600											

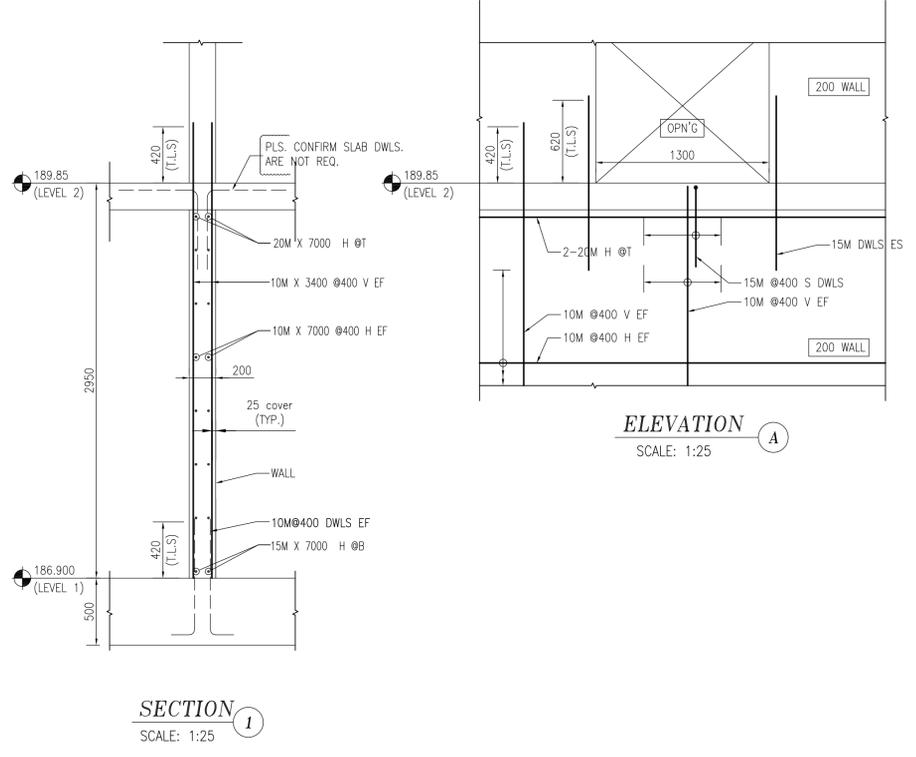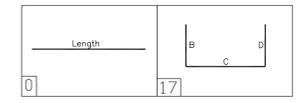

DRAWING REVIEW
This review of this drawing does not in any way relieve the contractor of responsibility for its accuracy or for compliance with the contract documents.

No comment	See comment
Amend & Resubmit	Rejected See Remarks

Submission No. 19066
Project No. 19066
By AF
Date 28 May 2021
JABLONSKY, AST AND PARTNERS
Consulting Engineers
3 Concorde Gate, North York, ON M3C 4H8

* ELEVATIONS AND DIMENSIONS SHOWN ARE FOR VERIFICATION PURPOSES ONLY AND ARE NOT TO BE USED FOR CONSTRUCTION
* ALL CONFIRMS/VERIFIES WILL BE ASSUMED CORRECT AND APPROVED AS IS UNLESS COMMENTED ON THE APPROVAL DRWGWS

LEGEND

ALT = ALTERNATE	FF = FAR FACE	OF = OUTSIDE FACE
BOT = BOTTOM	FS = FORM SAVER	SAW CUT END
BIS = BEND INTO SLAB	GD = GROUT IN DOWELS	STG = STAGGER
CB = CORNER BAR	H = HORIZONTAL	STR = STRIPS
CJ = CONTROL JOINT	IF = INSIDE FACE	T = TOP
CS = CUT TO SUIT SITE COND.	LL = LOWER LAYER	THR/1 = THREAD END
DWL = DOWELS	ML = MIDDLE	THR/2 = THREAD ZENIS
EE = EACH END	MIN = MINIMUM	UL = UPPER LAYER
EF = EACH FACE	NF = NEAR FACE	V/N = VERTICAL UNLESS NOTED
EJ = EXPANSION JOINT	OC = ON CENTER	V = VERTICAL
ES = EACH SIDE	TT = TEMP. TIES	
EW = EACH WAY		

STRAIGHT BARS LABEL FORMAT
7 B15M X 3600
GRADE QUANTITY LENGTH

BENT BARS LABEL FORMAT
7 B15M B1501
GRADE QUANTITY LENGTH

GRADES OF STEEL
B = GRADE 400W
C = GRADE 500W
E = GRADE 600W
S = STAINLESS
W = WELDABLE

NOTES

- ALL STEEL TO BE GRADE 400W
- STRENGTH OF CONCRETE
35MPa - SLAB
35MPa - INTERIOR COLUMNS & WALLS
- CONCRETE COVER:
SLAB T --- 25mm
SLAB B --- 25mm
- COMPRESSION LAP SPLICE
- TENSION LAP SPLICE (L.S.) & DEVELOPMENT LENGTH (L_d)

BAR SIZE	STANDARD LAP (mm)	
	L.S	L _d
10M	300	
15M	440	
20M	590	
25M	730	
30M	880	
35M	1030	

BAR SIZE	f _c =25		f _c =30		f _c =35	
	L.S	L _d	L.S	L _d	L.S	L _d
10M	490	380	450	350	420	320
15M	740	570	670	520	620	480
20M	980	750	890	690	830	640
25M	1530	1170	1390	1070	1290	990
30M	1830	1410	1670	1290	1550	1190
35M	2130	1640	1950	1500	1800	1390

FOR APPROVAL: MAY/19/21 JJ

ISSUE: REMARKS DATE BY

MANSTEEL REBAR
105 Industrial Road, Richmond Hill, Ontario L4C 2Y4 Canada
Phone: 905-737-9797
Fax: 905-737-9724
Email: info@mansteelrebar.com

PROJECT: FORESTSIDE TOWNHOUSES - BRAMPTON, ON

PART OF STRUCTURE: SHEAR WALLS L1-L2 P#2

CUSTOMER: ROYAL PINE HOMES
Project no. 2177
SCALE: AS SHOWN

DETAILED BY: JJ
BAR LIST No.
CHECKED BY:


DRAWING No. **R7.2**

DRAWING REVIEW
 This review of this drawing does not in any way relieve the contractor of responsibility for its accuracy or for compliance with the contract documents.


✓ No comment	See comment
Amend & Resubmit	Rejected See Remarks

Submission No. 19006
 Project No. AF
 By AF
 Date 15 Jun 2021

JABLONSKY, AST AND PARTNERS
 Consulting Engineers
 3 Concorde Gate, North York, ON M3C 4H6

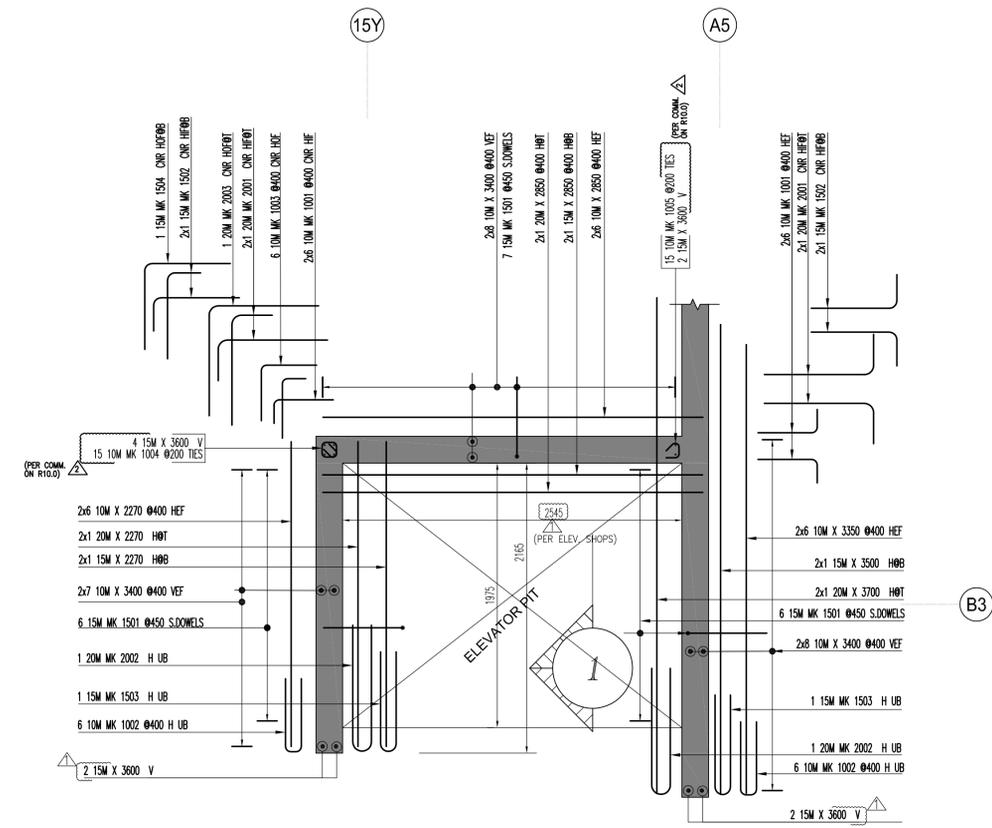

BUILDING-A
ELEVATOR WALL PLAN L1-L2
 SCALE: 1:25
 (POUR-2)

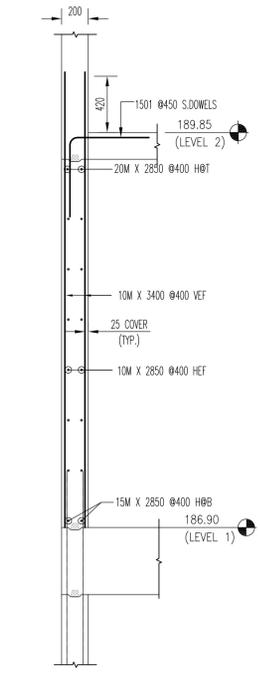



SECTION 1
 SCALE: 1:25

Release Code: R7.3 ELEV SW L1-L2 P#2 BENDING DETAILS.

Bar Mark	Qty	Size	Total length	Type	A'	B'	C'	D'	E'	F'	G'	H'	J'	K'	O'	W'
	12	10M	2270			2270										
	46	10M	3400			3400										
	12	10M	2850			2850										
	2	20M	2850			2850										
	2	15M	2850			2850										
	2	15M	2270			2270										
	2	20M	2270			2270										
	2	15M	3500			3500										
	2	20M	3700			3700										
	12	10M	3350			3350										
	4	15M	3600			3600										
1003	6	10M	840	T		420	420									
1001	24	10M	630	T	180	450										
1002	12	10M	1230	T		550	130	550								
2003	1	20M	1660	T		830	830									
1501	19	15M	1200	T		600	600									
1503	2	15M	1630	T		750	130	750								
2002	2	20M	2060	T		950	160	950								
1504	1	15M	1300	T		650	650									
2001	4	20M	1140	T	300	830										
1502	4	15M	910	T	260	650										

Release Code: R7.3 ELEV L1-L2 P#2 PABENDING DETAILS.

Bar Mark	Qty	Size	Total length	Type	A'	B'	C'	D'	E'	F'	G'	H'	J'	K'	O'	W'
1005	15	10M	320	T	100	120									100	
1004	15	10M	680	T	100	120	120	120	120						100	70

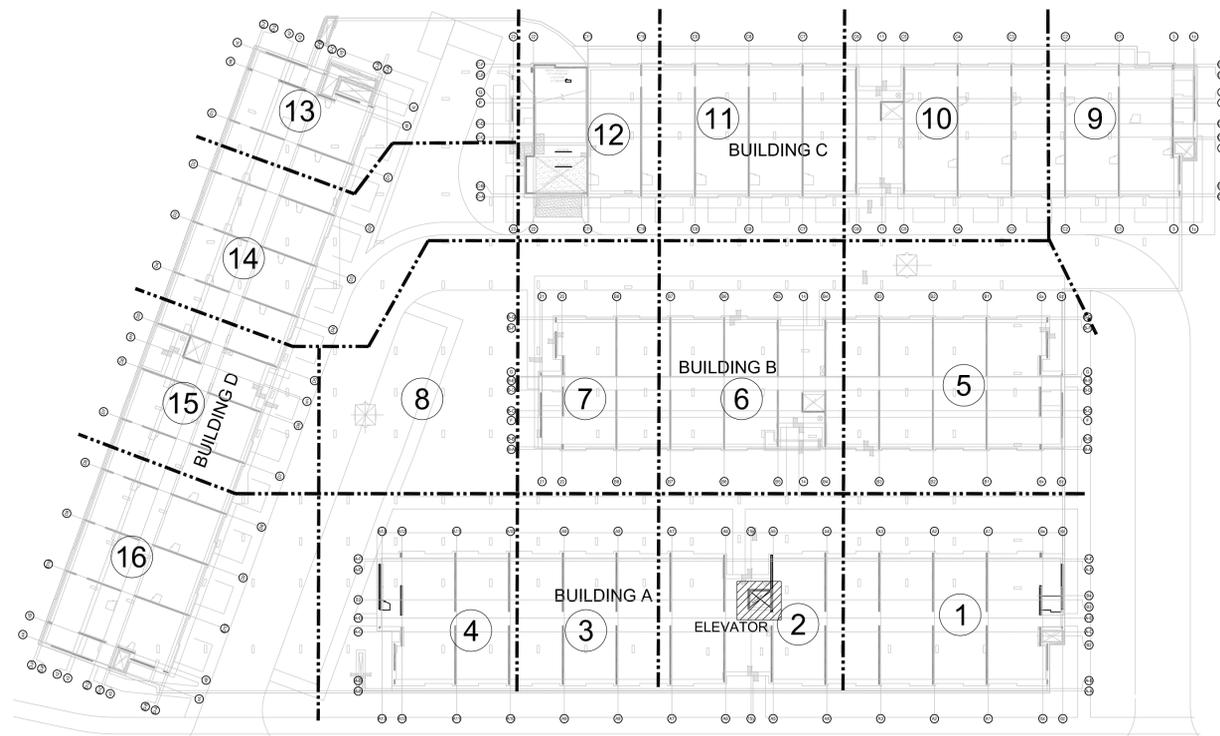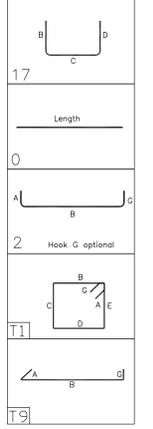

KEY PLAN
 SCALE: NTS

- NOTES**
- ALL STEEL TO BE GRADE 400W
 - STRENGTH OF CONCRETE 35MPa - INTERIOR COLUMNS & WALLS
 - CONCRETE COVER: VERTICALS --- 25mm

4. COMPRESSION LAP SPlice

BAR SIZE	STANDARD LAP (mm)
10M	300
15M	440
20M	590
25M	730
30M	880
35M	1030

5. TENSION LAP SPlice (Ls) & DEVELOPMENT LENGTH (Ld) (FOR WALL OR COL & Ld IN CAP OR FTG.)

BAR SIZE	fc=25		fc=30		fc=35	
	L.S	L.d	L.S	L.d	L.S	L.d
10M	490	380	450	350	420	320
15M	740	570	670	520	620	480
20M	980	750	890	690	830	640
25M	1530	1170	1390	1070	1290	990
30M	1830	1410	1670	1290	1550	1190
35M	2130	1640	1950	1500	1800	1390

* ELEVATIONS AND DIMENSIONS SHOWN ARE FOR VERIFICATION PURPOSES ONLY AND ARE NOT TO BE USED FOR CONSTRUCTION
 * ALL CONFIRMS/VERIFIES WILL BE ASSUMED CORRECT AND APPROVED AS IS UNLESS COMMENTED ON THE APPROVAL DRWS

LEGEND

ALT = ALTERNATE	FF = FAR FACE	OF = OUTSIDE FACE
BOT = BOTTOM	FS = FORM SAWER	SC = SAW CUT END
BIS = BEND INTO SLAB	GD = GROUT IN DOWELS	STG = STAGGER
CB = CORNER BAR	H = HORIZONTAL	STR = STRIPS
CJ = CONTROL JOINT	IF = INSIDE FACE	T = TOP
CUT = CUT TO SUIT COND.	LL = LOWER LAYER	THR/1 = THREAD END
DWL = DOWELS	MID = MIDDLE	THR/2 = THREAD ZENIS
EE = EACH END	MIN = MINIMUM	UL = UPPER LAYER
EF = EACH FACE	NF = NEAR FACE	V = VERTICAL
EJ = EXPANSION JOINT	OC = ON CENTER	TT = TAMP TIES
ES = EACH SIDE		
EW = EACH WAY		

STRAIGHT BARS LABEL FORMAT

7 B15M X 3600
 QUANTITY, SIZE, LENGTH

BENT BARS LABEL FORMAT

7 B15M B1501
 QUANTITY, SIZE, L-BR MARK

GRADES OF STEEL

B = GRADE 400W
 C = CR60
 F = CR60 COATED
 S = STAINLESS
 W = WELDABLE

ISSUE	REMARKS	DATE	BY
2	REV PER COMM. ON R10.0 (ADDED ZONE BARS)	JUN/09/21	JU
1	REV. PER COMM. & FINAL ELEV. SHOPS - FOR FAB.	MAY/31/21	JU
0	FOR APPROVAL	MAY/19/21	JU

MANSTEEL REBAR


105 Industrial Road, Richmond Hill, Ontario L4C 2Y4 Canada
 Phone: 905-737-9797
 Fax: 905-737-9724
 Email: Info@mansteelrebar.com

PROJECT
FORESTSIDE TOWNHOUSES - BRAMPTON, ON

PART OF STRUCTURE
ELEVATOR SHEAR WALLS L1-L2 P#2



CUSTOMER: ROYAL PINE HOMES
 Project no. 2177
 SCALE: AS SHOWN

DETAILED BY: JU
 BAR LIST No.
 DRAWING No. **R7.3**

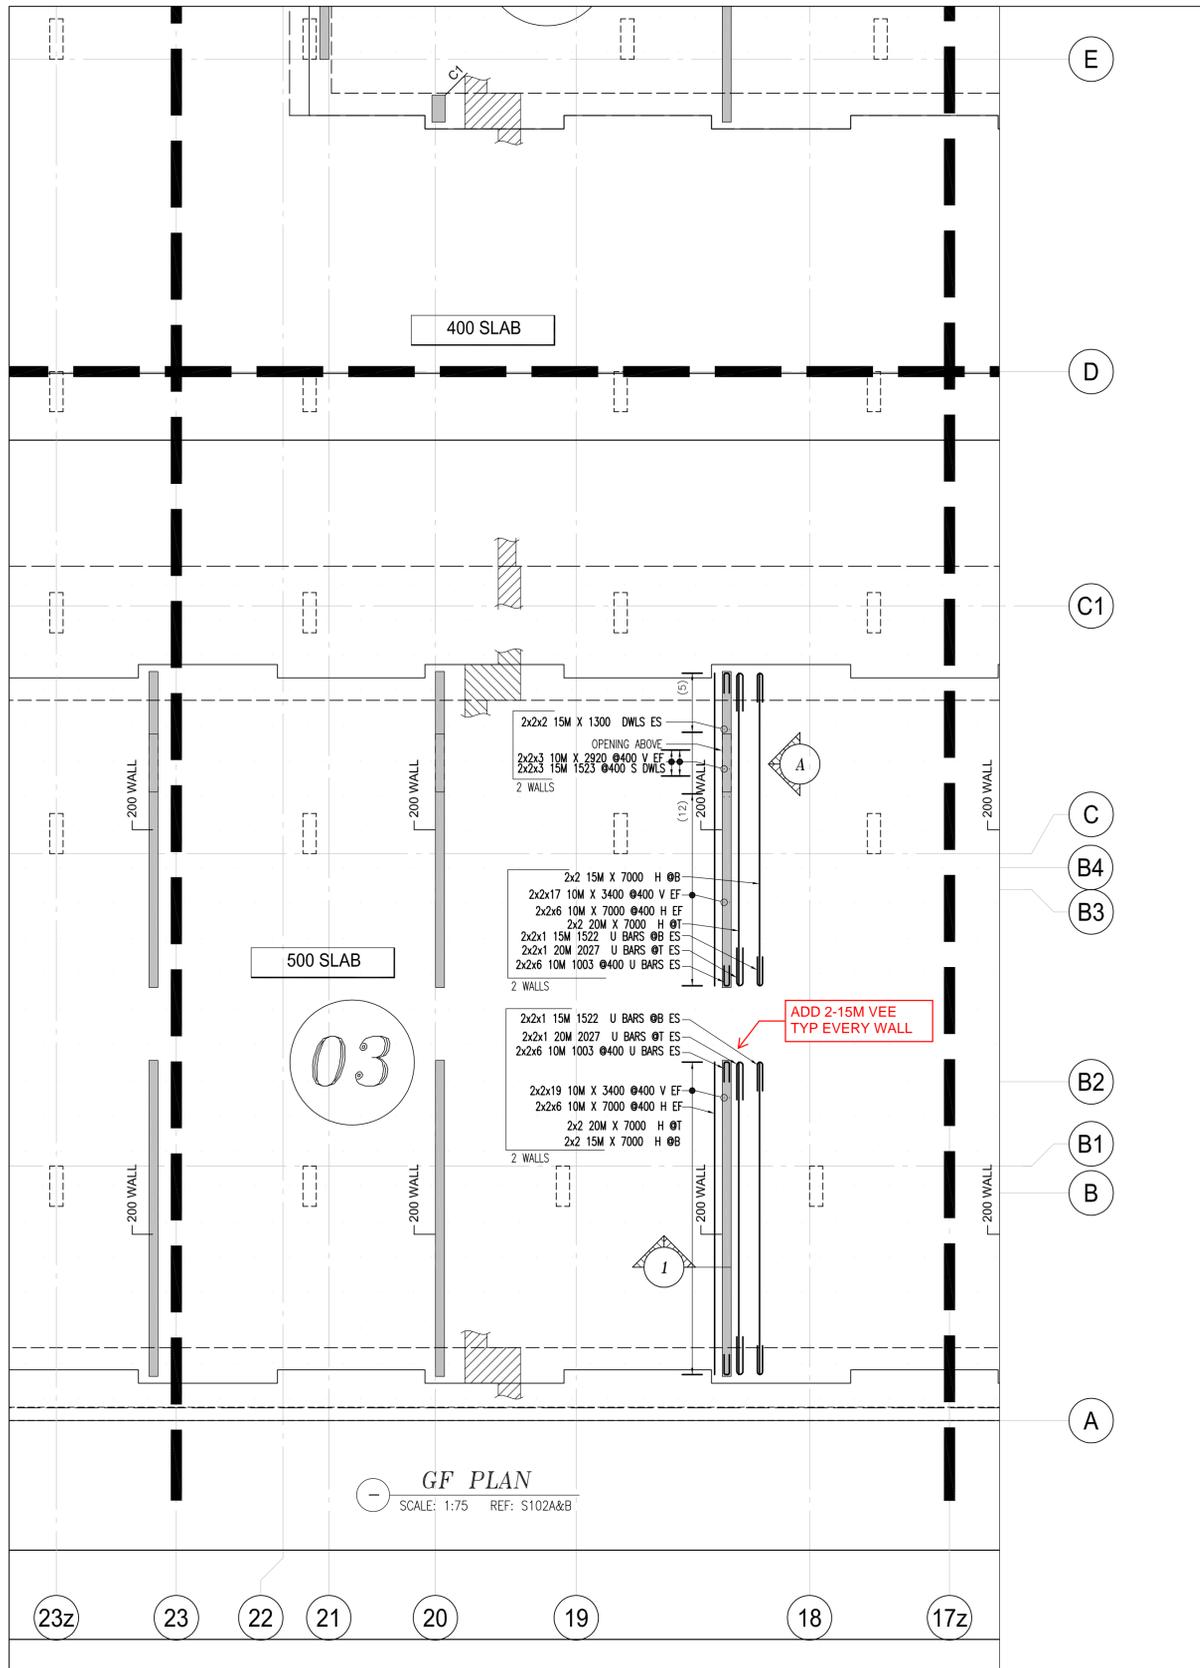

Release Code: R7.4 SW L1-L2 P#3 BENDING DETAILS.

Bar Mark	Qty	Size	Total length	Type	'A'	'B'	'C'	'D'	'E'	'F'	'G'	'H'	'J'	'K'	'U'	'V'	
	144	10M	3400			3400											
	12	10M	2920			2920											
	8	15M	7000			7000											
	4	8M	7000			7000											
	8	20M	7000			7000											
	8	15M	1300			1300											
1003	4	8M	1030	17		450	130	450									
2027	8	20M	1860	17		850	160	850									
1522	8	15M	1430	17		650	130	650									
1523	12	15M	1200	17		600	600										

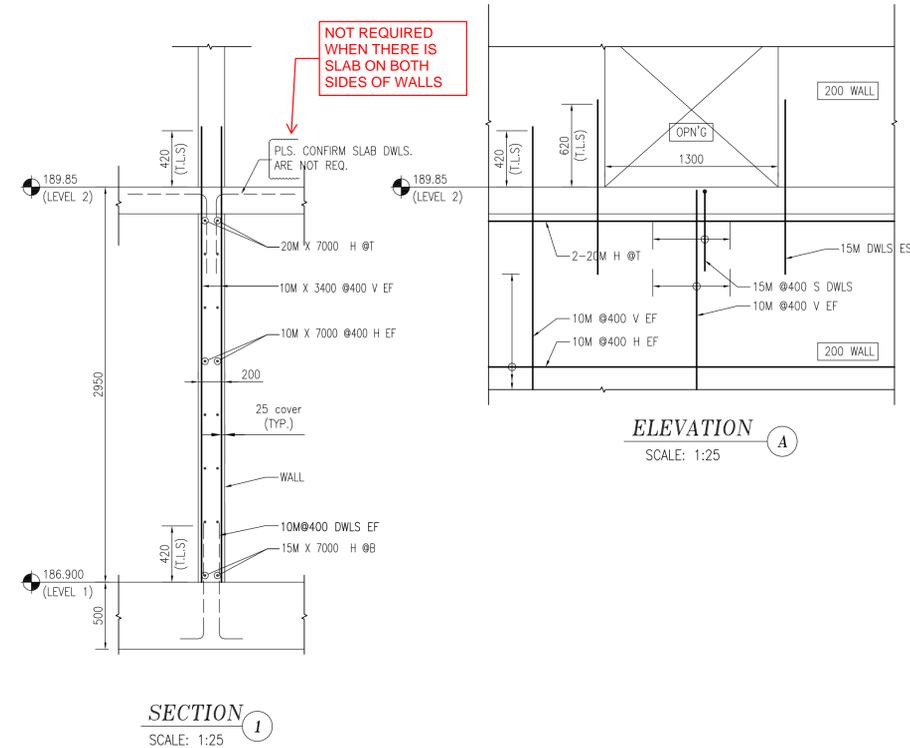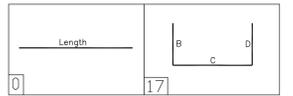

DRAWING REVIEW

This review of this drawing does not in any way relieve the contractor of responsibility for its accuracy or for compliance with the contract documents.

No comment	See comment
Amend & Resubmit	Rejected See Remarks

Submission No. _____
Project No. 19066
By: JF
Date: 28 May 2021

JABLONSKY, AST AND PARTNERS
Consulting Engineers
9 Concorde Gate, North York, ON M3C 4H8

* ELEVATIONS AND DIMENSIONS SHOWN ARE FOR VERIFICATION PURPOSES ONLY AND ARE NOT TO BE USED FOR CONSTRUCTION

* ALL CONFIRMS/VERIFIES WILL BE ASSUMED CORRECT AND APPROVED AS IS UNLESS COMMENTED ON THE APPROVAL DRAWS

LEGEND

ALT = ALTERNATE	FF = FAR FACE	OF = OUTSIDE FACE
BOT = BOTTOM	FS = FORM SAWER	SAW CUT END
BIS = BEND INTO SLAB	GD = GROUT IN DOWELS	STG = STAGGER
CB = CORNER BAR	H = HORIZONTAL	STR = STRIPS
CJ = CONTROL JOINT	IF = INSIDE FACE	T = TOP
CS = CUT TO SUIT SITE COND.	LL = LOWER LAYER	THR/1 = THREAD END
DWL = DOWELS	ML = MIDDLE	THR/2 = THREAD ZENIS
EE = EACH END	MIN = MINIMUM	UL = UPPER LAYER
EF = EACH FACE	NF = NEAR FACE	UNLESS NOTED
EJ = EXPANSION JOINT	OC = ON CENTER	V = VERTICAL
ES = EACH SIDE	TT = TEMP. TIES	
EW = EACH WAY		

STRAIGHT BARS LABEL FORMAT

7 B15M X 3600

GRADE QUANTITY LENGTH

BENT BARS LABEL FORMAT

7 B15M B1501

GRADE QUANTITY LENGTH

GRADES OF STEEL

B = GRADE 400W
C = GRADE 500W
F = GRADE 600W
S = STAINLESS
W = WELDABLE

FOR APPROVAL	MAY/19/21	JJ
ISSUE	REMARKS	DATE

MANSTEEL REBAR

105 Industrial Road, Richmond Hill, Ontario L4C 2Y4 Canada
Phone: 905-737-9797
Fax: 905-737-9724
Email: Info@mansteelrebar.com

PROJECT

FORESTSIDE TOWNHOUSES - BRAMPTON, ON

PART OF STRUCTURE

SHEAR WALLS L1-L2 P#3

CUSTOMER: ROYAL PINE HOMES

Project no. 2177

SCALE: AS SHOWN

DRAWING No. **R7.4**

DETAILED BY: JJ BAR LIST No. _____


CHECKED BY: _____

NOTES

- ALL STEEL TO BE GRADE 400W
- STRENGTH OF CONCRETE
35MPa - SLAB
35MPa - INTERIOR COLUMNS & WALLS
- CONCRETE COVER:
SLAB T --- 25mm
SLAB B --- 25mm
- COMPRESSION LAP SPLICE
- TENSION LAP SPLICE (L.S.) & DEVELOPMENT LENGTH (L_d)

BAR SIZE	STANDARD LAP (mm)	
	L.S.	L _d
10M	300	
15M	440	
20M	590	
25M	730	
30M	880	
35M	1030	

BAR SIZE	f _c =25		f _c =30		f _c =35	
	L.S.	L _d	L.S.	L _d	L.S.	L _d
10M	490	380	450	350	420	320
15M	740	570	670	520	620	480
20M	980	750	890	690	830	640
25M	1530	1170	1390	1070	1290	990
30M	1830	1410	1670	1290	1550	1190
35M	2130	1640	1950	1500	1800	1390

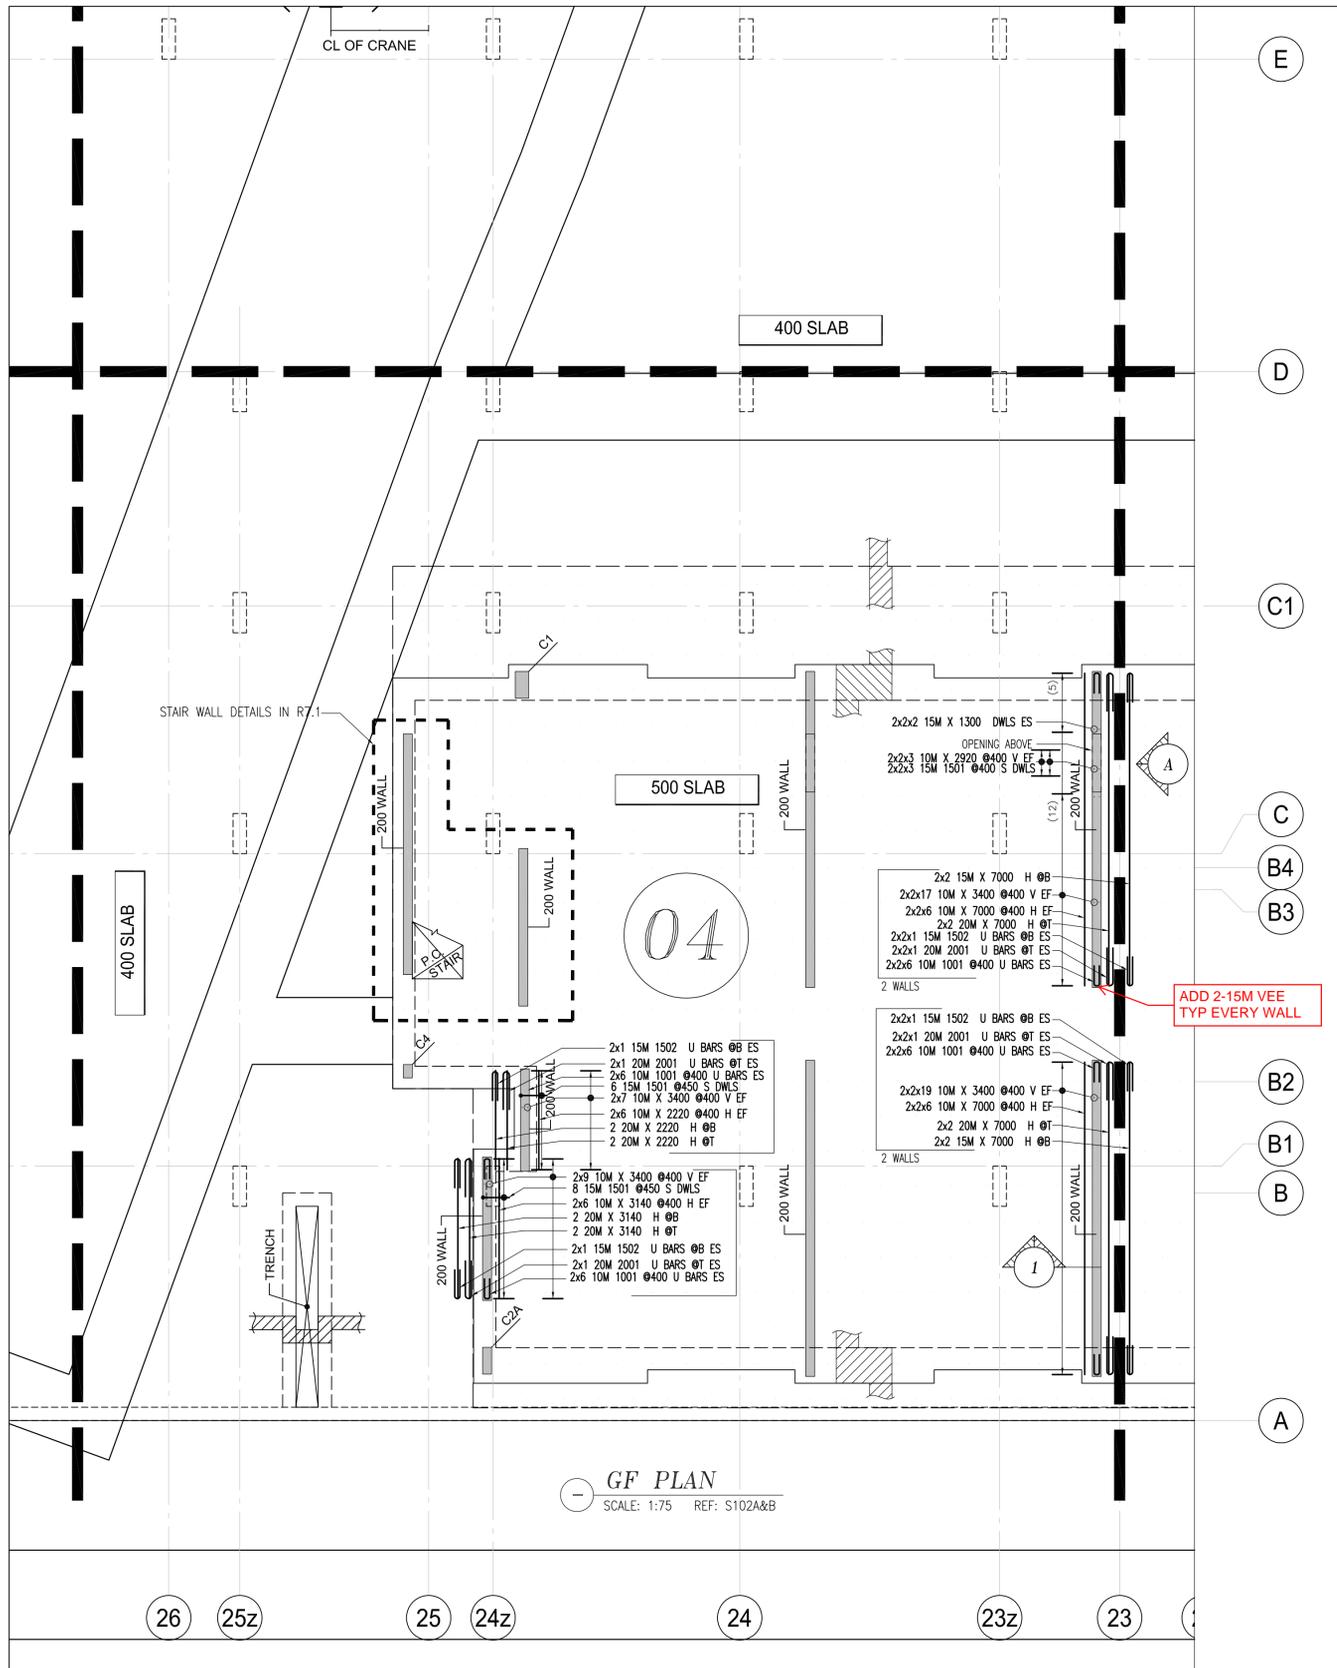

GF PLAN
SCALE: 1:75 REF: S102A&B



Release Code: R7.5 SW L1-L2 P#4 BENDING DETAILS.

Bar Mark	Qty	Size	Total length	Type	X	Y	Z	T	F	G	H	J	K	L	M
1210M	2920		2920												
815M	1300		1300												
17610M	3400		3400												
4810M	7000		7000												
820M	7000		7000												
815M	7000		7000												
420M	3140		3140												
1210M	3140		3140												
420M	2220		2220												
1210M	2220		2220												
1001	7210M	1030	17		450	130	450								
1501	2615M	1200	17		600	600									
1502	1215M	1430	17		650	130	650								
2001	1220M	1860	17		850	160	850								

DRAWING REVIEW
This review of this drawing does not in any way relieve the contractor of responsibility for its accuracy or for compliance with the contract documents.

No comment	See comment
Amend & Resubmit	Rejected See Remarks

Submission No. 19066
Project No. AF
By AF
Date 28 May 2021
JABLONSKY, AST AND PARTNERS
Consulting Engineers
3 Concorde Gate, North York, ON M3C 4H8

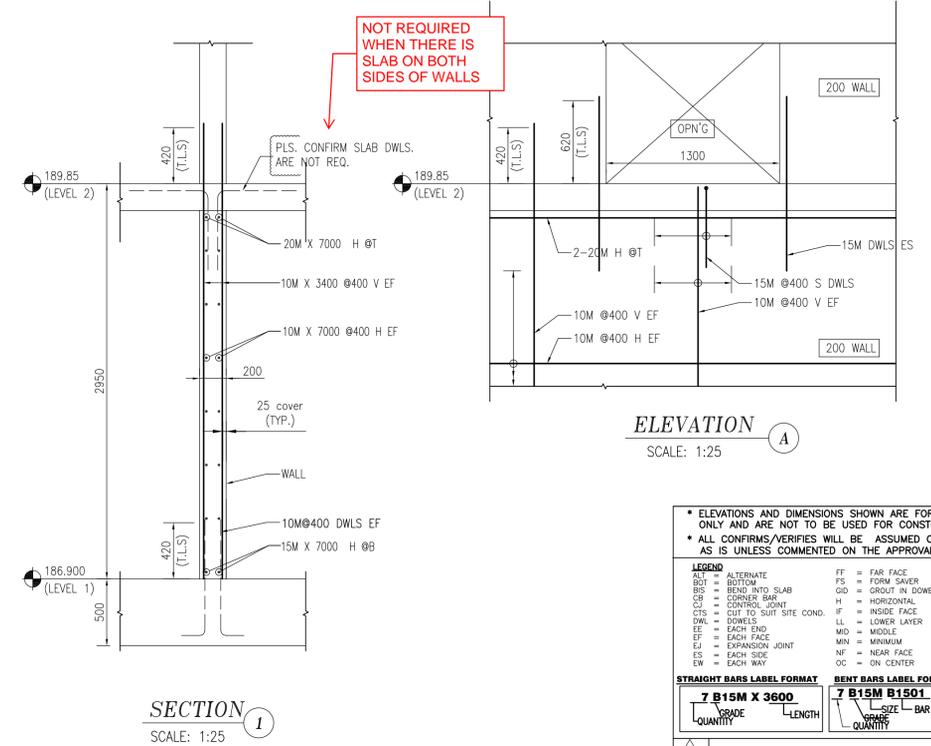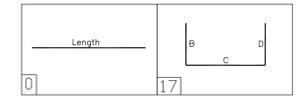

* ELEVATIONS AND DIMENSIONS SHOWN ARE FOR VERIFICATION PURPOSES ONLY AND ARE NOT TO BE USED FOR CONSTRUCTION
* ALL CONFIRMS/VERIFIES WILL BE ASSUMED CORRECT AND APPROVED AS IS UNLESS COMMENTED ON THE APPROVAL DRINGS

LEGEND

ALT = ALTERNATE	FF = FAR FACE	OF = OUTSIDE FACE
BOT = BOTTOM	FS = FORM SAVER	SAW CUT END
BIS = BEND INTO SLAB	GI0 = GRID IN DOWELS	STG = STAGGER
CB = CORNER BAR	H = HORIZONTAL	STR = STRIPS
CI = CONTROL JOINT	IF = INSIDE FACE	T = TOP
CJ = CUT TO SUIT SITE COND.	LL = LOWER LAYER	THR/1 = THREAD END
DWL = DOWELS	LL = LOWER LAYER	THR/2 = THREAD ZENDS
EE = EACH END	MID = MIDDLE	UL = UPPER LAYER
EF = EACH FACE	MIN = MINIMUM	V/n = VERTICAL
EJ = EXPANSION JOINT	NF = NEAR FACE	V = VERTICAL
ES = EACH SIDE	OC = ON CENTER	TT = TEMP. TIES
EW = EACH WAY		

STRAIGHT BARS LABEL FORMAT
GRADE QUANTITY

BENT BARS LABEL FORMAT
GRADE QUANTITY

GRADES OF STEEL
B = GRADE 400W
C = GRADE 500W
F = GRADE 600W
S = STAINLESS
WF = WELDABLE

NOTES

- ALL STEEL TO BE GRADE 400W
- STRENGTH OF CONCRETE
35MPa - SLAB
35MPa - INTERIOR COLUMNS & WALLS
- CONCRETE COVER:
WALLS -- 25mm

4. COMPRESSION LAP SPLICE

BAR SIZE	STANDARD LAP (mm)
10M	300
15M	440
20M	590
25M	730
30M	880
35M	1030

5. TENSION LAP SPLICE (L.S.) & DEVELOPMENT LENGTH (Ld)

BAR SIZE	fc=25		fc=30		fc=35	
	L.S.	L.d	L.S.	L.d	L.S.	L.d
10M	490	380	450	350	420	320
15M	740	570	670	520	620	480
20M	980	750	890	690	830	640
25M	1530	1170	1390	1070	1290	990
30M	1830	1410	1670	1290	1550	1190
35M	2130	1640	1950	1500	1800	1390

FOR APPROVAL	MAY/19/21	JJ
ISSUE	REMARKS	DATE

MANSTEEL REBAR
105 Industrial Road, Richmond Hill, Ontario L4C 2Y4 Canada
Phone: 905-737-9797
Fax: 905-737-9704
Email: info@mansteelrebar.com

FORESTSIDE TOWNHOUSES - BRAMPTON, ON
PART OF STRUCTURE
SHEAR WALLS L1-L2 P#4

CUSTOMER: ROYAL PINE HOMES
Project no. 2177
SCALE: AS SHOWN
DRAWING No. R7.5