

KEY PLAN

REV. NO.	DESCRIPTION	DATE	BY	APPD.

THIS DRAWING IS ON LOAN ONLY, NOT TO BE COPIED OR DUPLICATED IN ANY WAY WITHOUT WRITTEN CONSENT FROM MCINTOSH PERRY.

IT IS THE CONTRACTOR'S RESPONSIBILITY TO VERIFY ALL DIMENSIONS ON SITE.

ANY DISCREPANCIES ARE TO BE REPORTED TO MCINTOSH PERRY

THIS DRAWING SHALL NOT BE SCALED.

THIS DRAWING IS NOT TO BE USED FOR CONSTRUCTION UNTIL APPROVED.

THE CLIENT EXPRESSLY AGREES THAT IT HAS ENTERED INTO THIS AGREEMENT WITH MCINTOSH PERRY, BOTH ON ITS OWN BEHALF AND AS AGENT ON BEHALF OF ITS EMPLOYEES AND PRINCIPALS. THE CLIENT EXPRESSLY AGREES THAT MCINTOSH PERRY'S EMPLOYEES AND PRINCIPALS SHALL HAVE NO PERSONAL LIABILITY TO THE CLIENT IN RESPECT OF A CLAIM, WHETHER IN CONTRACT, TORT AND/OR ANY OTHER CAUSE OF ACTION IN LAW. ACCORDINGLY, THE CLIENT EXPRESSLY AGREES THAT IT WILL BRING NO PROCEEDINGS AND TAKE NO ACTION IN ANY COURT OF LAW AGAINST ANY OF MCINTOSH PERRY EMPLOYEES OR PRINCIPALS IN THEIR PERSONAL CAPACITY.

IMPORTANT

- ☐ PRELIMINARY : NOT TO BE USED FOR CONSTRUCTION OR FABRICATION.
- ☐ APPROVED : FOR CONSTRUCTION OR FABRICATION.
- ☐ FINAL : SUBJECT TO LOCAL APPROVAL.
- ☐ REVISED : DESTROY ALL PREVIOUS COPIES.

APPROVED

J. LEE  
100203648  
Aug 4, 2021  
PROVINCE OF ONTARIO

DATE

CLIENT  
IRONSTONE FORMING LTD.  
16 GRIGGSDEN AVE.  
ETOBICOKE, ONT., M9P2Z7.

PROJECT  
ROYAL PINE HOMES  
FORESTSIDE TOWNHOUSES PH.3  
ATTMAR DR. & THE GORE RD  
BRAMPTON, ONTARIO

TITLE  
SHORING TO PART PLAN.  
GROUND FL.

SCALE AS NOTED	DATE AUG, 2021
DRAWN N.B.	CHECKED

**McINTOSH PERRY**  
2640 HIGHWAY 7, SUITE 200 VAUGHAN, ON L4K 1V9  
Tel: 905.856.5200 Fax: 905.695.0221  
Toll Free: 1.888.348.8991 www.mcintoshperry.com

DRAWING NUMBER	4-G-212858-06	REV. 
-------------------	---------------	----------

(FOR CONTINUATION, REFER TO DRAWING 4-G-212858-04)

(FOR CONTINUATION, REFER TO DRAWING 4-G-212858-07)

FOR GENERAL NOTES REFER TO  
DRAWING 4-G-212858-05

REVIEW OF RESHORING SHOP DRAWINGS.  
1. THE REVIEW OF THIS DRAWING IS FOR GENERAL CONFORMANCE WITH THE TENDER DOCUMENTS.  
2. THE RESPONSIBILITY FOR THE ADEQUACY AND ACCURACY OF THIS DRAWING REMAINS WITH THE FORMWORK CONTRACTOR AND HIS ENGINEER WHOSE SEAL APPEARS ON THIS DRAWING.




JABLONSKY, AST AND PARTNERS  
CONSULTING ENGINEERS  
SIGNED: MB  
DATED: 16 Aug 2021

DESIGN NOTES  
UNDER 200 SLAB.....ALUMA BEAM JOIST @488mm(19.2") c/c MAX.  
UNDER 400 DROP.....ALUMA BEAM JOIST @305mm(12") c/c MAX.  
UNDER 500 DROP.....ALUMA BEAM JOIST @305mm(12") c/c MAX.  
UNDER 1250 BEAM.....ALUMA BEAM JOIST @254mm(10") c/c MAX.

PLAN:SHORING TO PART PLAN OF GROUND FL.  
SCALE 1:100  
( THE STRUCTURAL PLAN OF THE SHORING LAYOUT WAS DRAWN FROM STRUCTURAL DWG. No. S-102B  
DATED MAR 25TH, 2021 ISSUED NO.10 PREPARED BY JABLONSKY, AST AND PARTNERS INC. )




(FOR CONTINUATION, REFER TO DRAWING 4-G-212858-06)

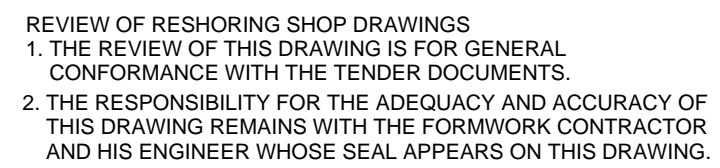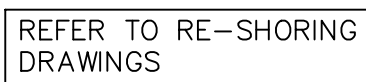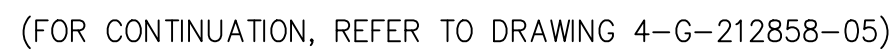

JABLONSKY, AST AND PARTNERS  
CONSULTING ENGINEERS  
SIGNED \_\_\_\_\_ MB  
DATED 16 Aug 2021

SCALE 1:100

( THE STRUCTURAL PLAN OF THE SHORING LAYOUT WAS DRAWN FROM STRUCTURAL DWG. NO. S-102B  
DATED MAR 25TH, 2021 ISSUED NO.10 PREPARED BY JABLONSKY, AST AND PARTNERS INC. )

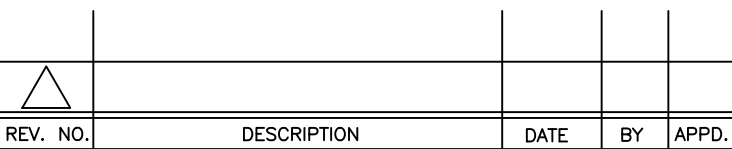

THE CLIENT EXPRESSLY AGREES THAT IT HAS ENTERED INTO THIS AGREEMENT WITH MCINTOSH PERRY,, BOTH ON ITS OWN BEHALF AND AS AGENT ON BEHALF OF ITS EMPLOYEES AND PRINCIPALS. THE CLIENT EXPRESSLY AGREES THAT MCINTOSH PERRY'S EMPLOYEES AND PRINCIPALS SHALL HAVE NO PERSONAL LIABILITY TO THE CLIENT IN RESPECT OF A CLAIM, WHETHER IN CONTRACT, TORT AND/OR OTHERWISE OUT OF ACTION IN LAW. ACCORDINGLY, THE CLIENT EXPRESSLY AGREES THAT IT WILL BRING NO PROCEEDINGS AND TAKE NO ACTION IN ANY COURT OF LAW AGAINST ANY OF MCINTOSH PERRY EMPLOYEES OR PRINCIPALS IN THEIR PERSONAL CAPACITY.

- ☐ PRELIMINARY : NOT TO BE USED FOR CONSTRUCTION OR FABRICATION.
- ☐ APPROVED : FOR CONSTRUCTION OR FABRICATION.
- ☐ FINAL : SUBJECT TO LOCAL APPROVAL.
- ☐ REVISED : DESTROY ALL PREVIOUS COPIES.

DATE \_\_\_\_\_  
CLIENT \_\_\_\_\_  
IRONSTONE FORMING LTD.  
16 GRIGGS DEN AVE.  
ETOBICOKE, ONT., M9P2Z7.

PROJECT ROYAL PINE HOMES  
FORESTSIDE TOWNHOUSES PH.3  
ATTMAR DR. & THE GORE RD  
BRAMPTON, ONTARIO

TITLE


SHORING TO PART PLAN.  
GROUND FL.

SCALE AS NOTED	DATE AUG, 2021
DRAWN N.B.	CHECKED


**McINTOSH PERRY**  
2640 HIGHWAY 7, SUITE 200 VAUGHAN, ON L4K 1V9  
Tel: 905.856.5200 Fax: 905.695.0221  
Toll Free: 1.888.348.8991 [www.mcintoshperry.com](http://www.mcintoshperry.com)

DRAWING NUMBER	4-G-212858-07	REV. A
-------------------	---------------	-----------




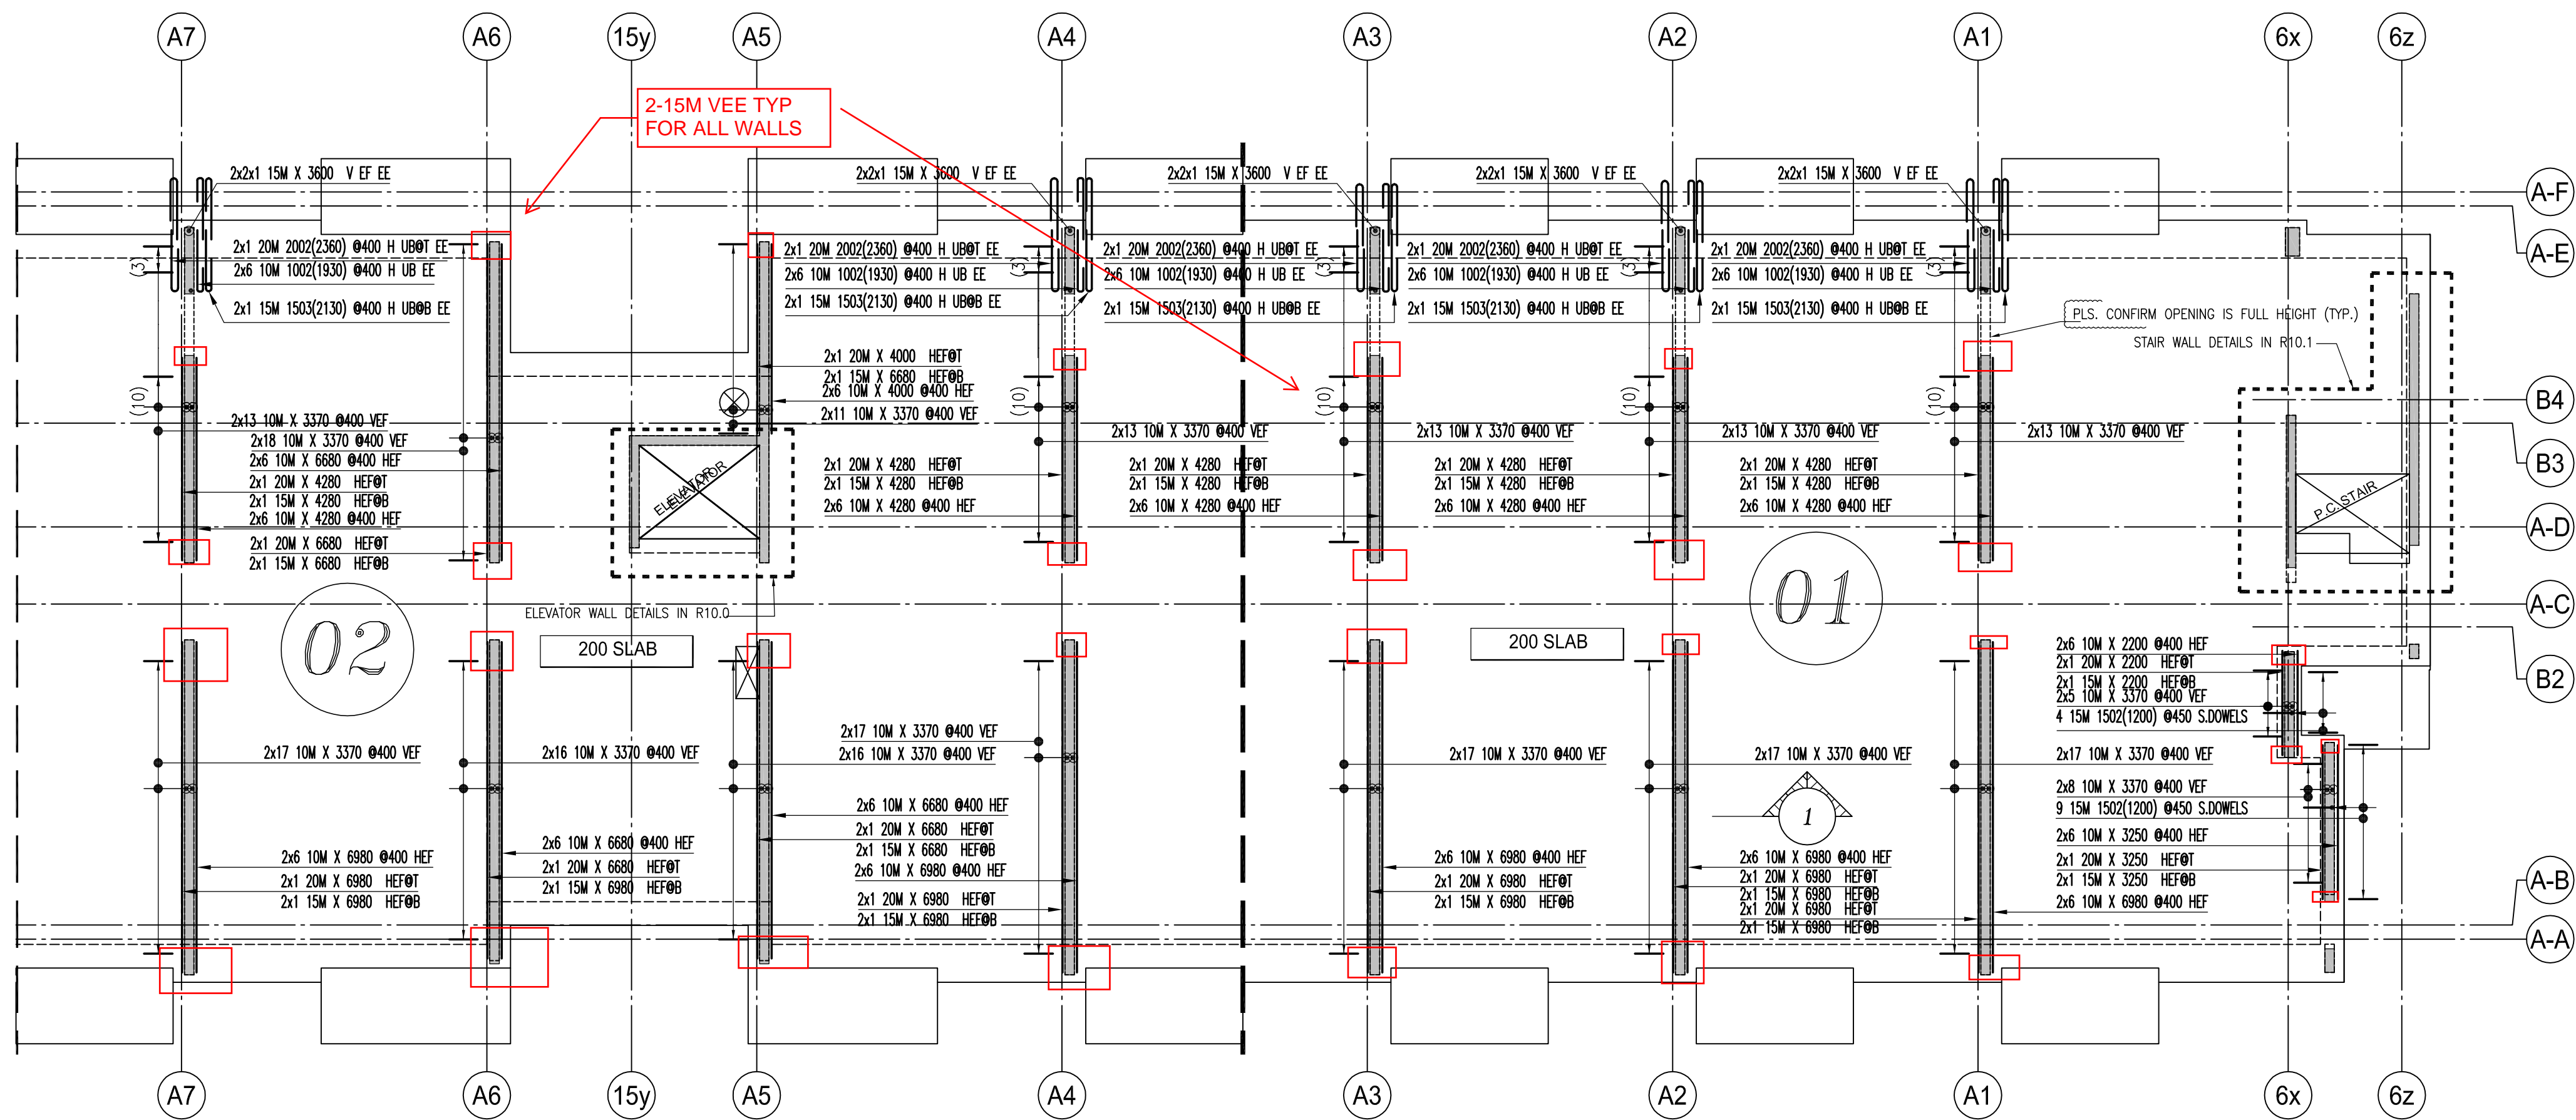

**BUILDING-A WALL PLAN**  
SCALE: 1:100  
(POUR-1 & 2)

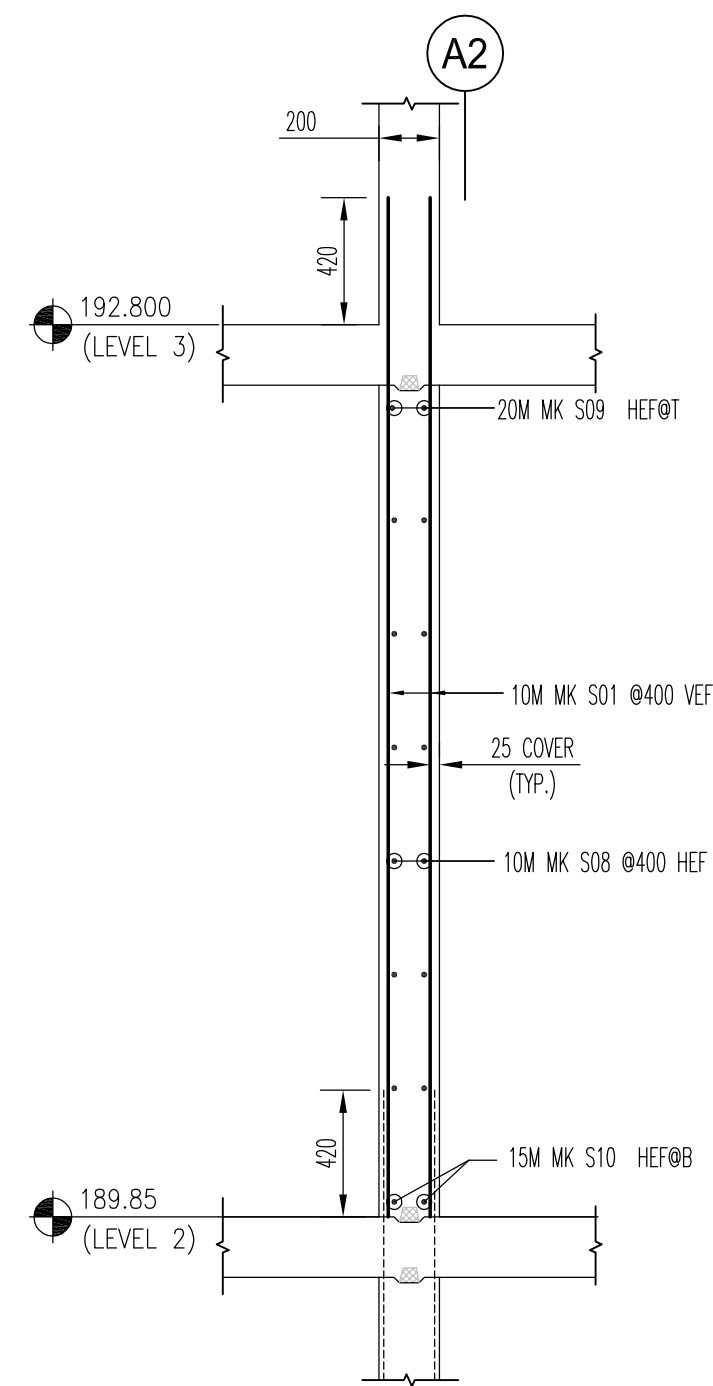


**SECTION**  
SCALE: 1:25

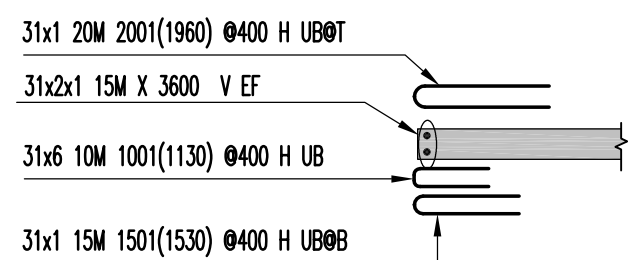

**TYPICAL WALL END DETAIL**  
SCALE: 1:50  
(32 NO'S REQUIRED) (POUR-1&2)

Release Code: R10.2 SW L2-L3 P#1&2 BENDING DETAILS.													
Bar Mark	Qty	Size	Total length	Type	'A'	'B'	'C'	'D'	'E'	'F'	'G'	'H'	'I'
215M	3750		3750										
1210M	3750		3750										
2120M	3750		3750										
44610M	3370		3370										
215M	2200		2200										
1210M	2200		2200										
2120M	2200		2200										
6010M	4280		4280										
10120M	4280		4280										
1015M	4280		4280										
6010M	6980		6980										
10120M	6980		6980										
1215M	6980		6980										
3610M	6680		6680										
6120M	6680		6680										
615M	6680		6680										
1210M	4000		4000										
2120M	4000		4000										
8215M	3600		3600										
1001	18610M	1130	11		500	130	500						
1002	6010M	9930	11		500	130	1300						
2002	10120M	2360	11		900	160	1300						
1503	1015M	2130	11		700	130	1300						
1501	3115M	1530	11		700	130	700						
2001	3120M	1960	11		900	160	900						
1502	1315M	1200	11		600	600							

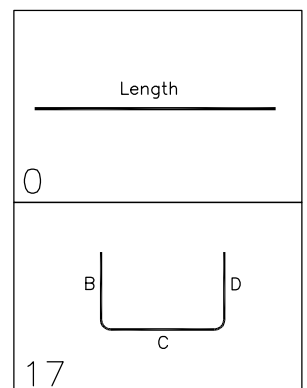

**NOTES**

- ALL STEEL TO BE GRADE 400W
- STRENGTH OF CONCRETE  
35MPa - INTERIOR COLUMNS & WALLS

- CONCRETE COVER:  
VERTICALS

-- 25mm

4. COMPRESSION LAP SPLICE

BAR SIZE	STANDARD LAP (mm)
10M	300
15M	440
20M	590
25M	730
30M	880
35M	1030

5. TENSION LAP SPLICE (L.S) & DEVELOPMENT LENGTH (L<sub>d</sub>)

BAR SIZE	f <sub>c</sub> =25		f <sub>c</sub> =30		f <sub>c</sub> =35	
	L.S	L <sub>d</sub>	L.S	L <sub>d</sub>	L.S	L <sub>d</sub>
10M	380	330	350	300	320	300
15M	570	490	520	400	480	370
20M	750	650	690	530	640	490
25M	1170	1010	1070	830	990	770
30M	1410	1210	1290	990	1190	920
35M	1640	1410	1500	1160	1390	1070

- ELEVATIONS AND DIMENSIONS SHOWN ARE FOR VERIFICATION PURPOSES ONLY AND ARE NOT TO BE USED FOR CONSTRUCTION
- ALL CONFIRMS/VERIFIES WILL BE ASSUMED CORRECT AND APPROVED AS IS UNLESS COMMENTED ON THE APPROVAL DRWS

LEGEND		
ALT = ALTERNATE	FF = FAR FACE	OF = OUTSIDE FACE
BOT = BOTTOM	FS = FORM SAVER	SC = SAW CUT END
BIS = BEND INTO SLAB	GID = GROUT IN DOWELS	STG = STAGGER
CB = CORNER BAR	H = HORIZONTAL	STR = STIRRUPS
CTS = CUT TO SUIT SITE COND.	IF = INSIDE FACE	T = TOP
DWL = DOWELS	LL = LOWER LAYER	THR/2 = THREAD END
EE = EACH END	MD = MIDDLE	THR/2 = THREAD ZENOS
EF = EACH FACE	MIN = MINIMUM	UL = UPPER LAYER
EJ = EXPANSION JOINT	NF = NEAR FACE	U/N = UNLESS NOTED
ES = EACH SIDE	OC = ON CENTER	V = VERTICAL
EW = EACH WAY	TT = TEMP. TIES	

STRAIGHT BARS LABEL FORMAT	BENT BARS LABEL FORMAT	GRADES OF STEEL
7 B15M X 3600 QUANTITY LENGTH	7 B15M B1501 QUANTITY SIZE - BR MARK	B = GRADE 400W C = GRADE 500W S = GRADE 600W W = WELDABLE

FOR APPROVAL	DATE	BY
ISSUE	REMARKS	

**MANSTEEL**  
REBAR

**MANSTEEL REBAR**  
105 Industrial Road, Richmond Hill,  
Ontario L4C 2Y4 Canada  
Phone: 905-737-9797  
Fax: 905-737-9704  
Email: info@mansteelrebar.com

**FORESTSIDE TOWNHOUSES**  
-BRAMPTON, ON

**SHEAR WALLS L2-L3 P#1&2**

CUSTOMER: ROYAL PINE HOMES

DETAILED BY: JU


CHECKED BY:

Project no. 2177


SCALE: AS SHOWN

DRAWING No.


**R10.2**

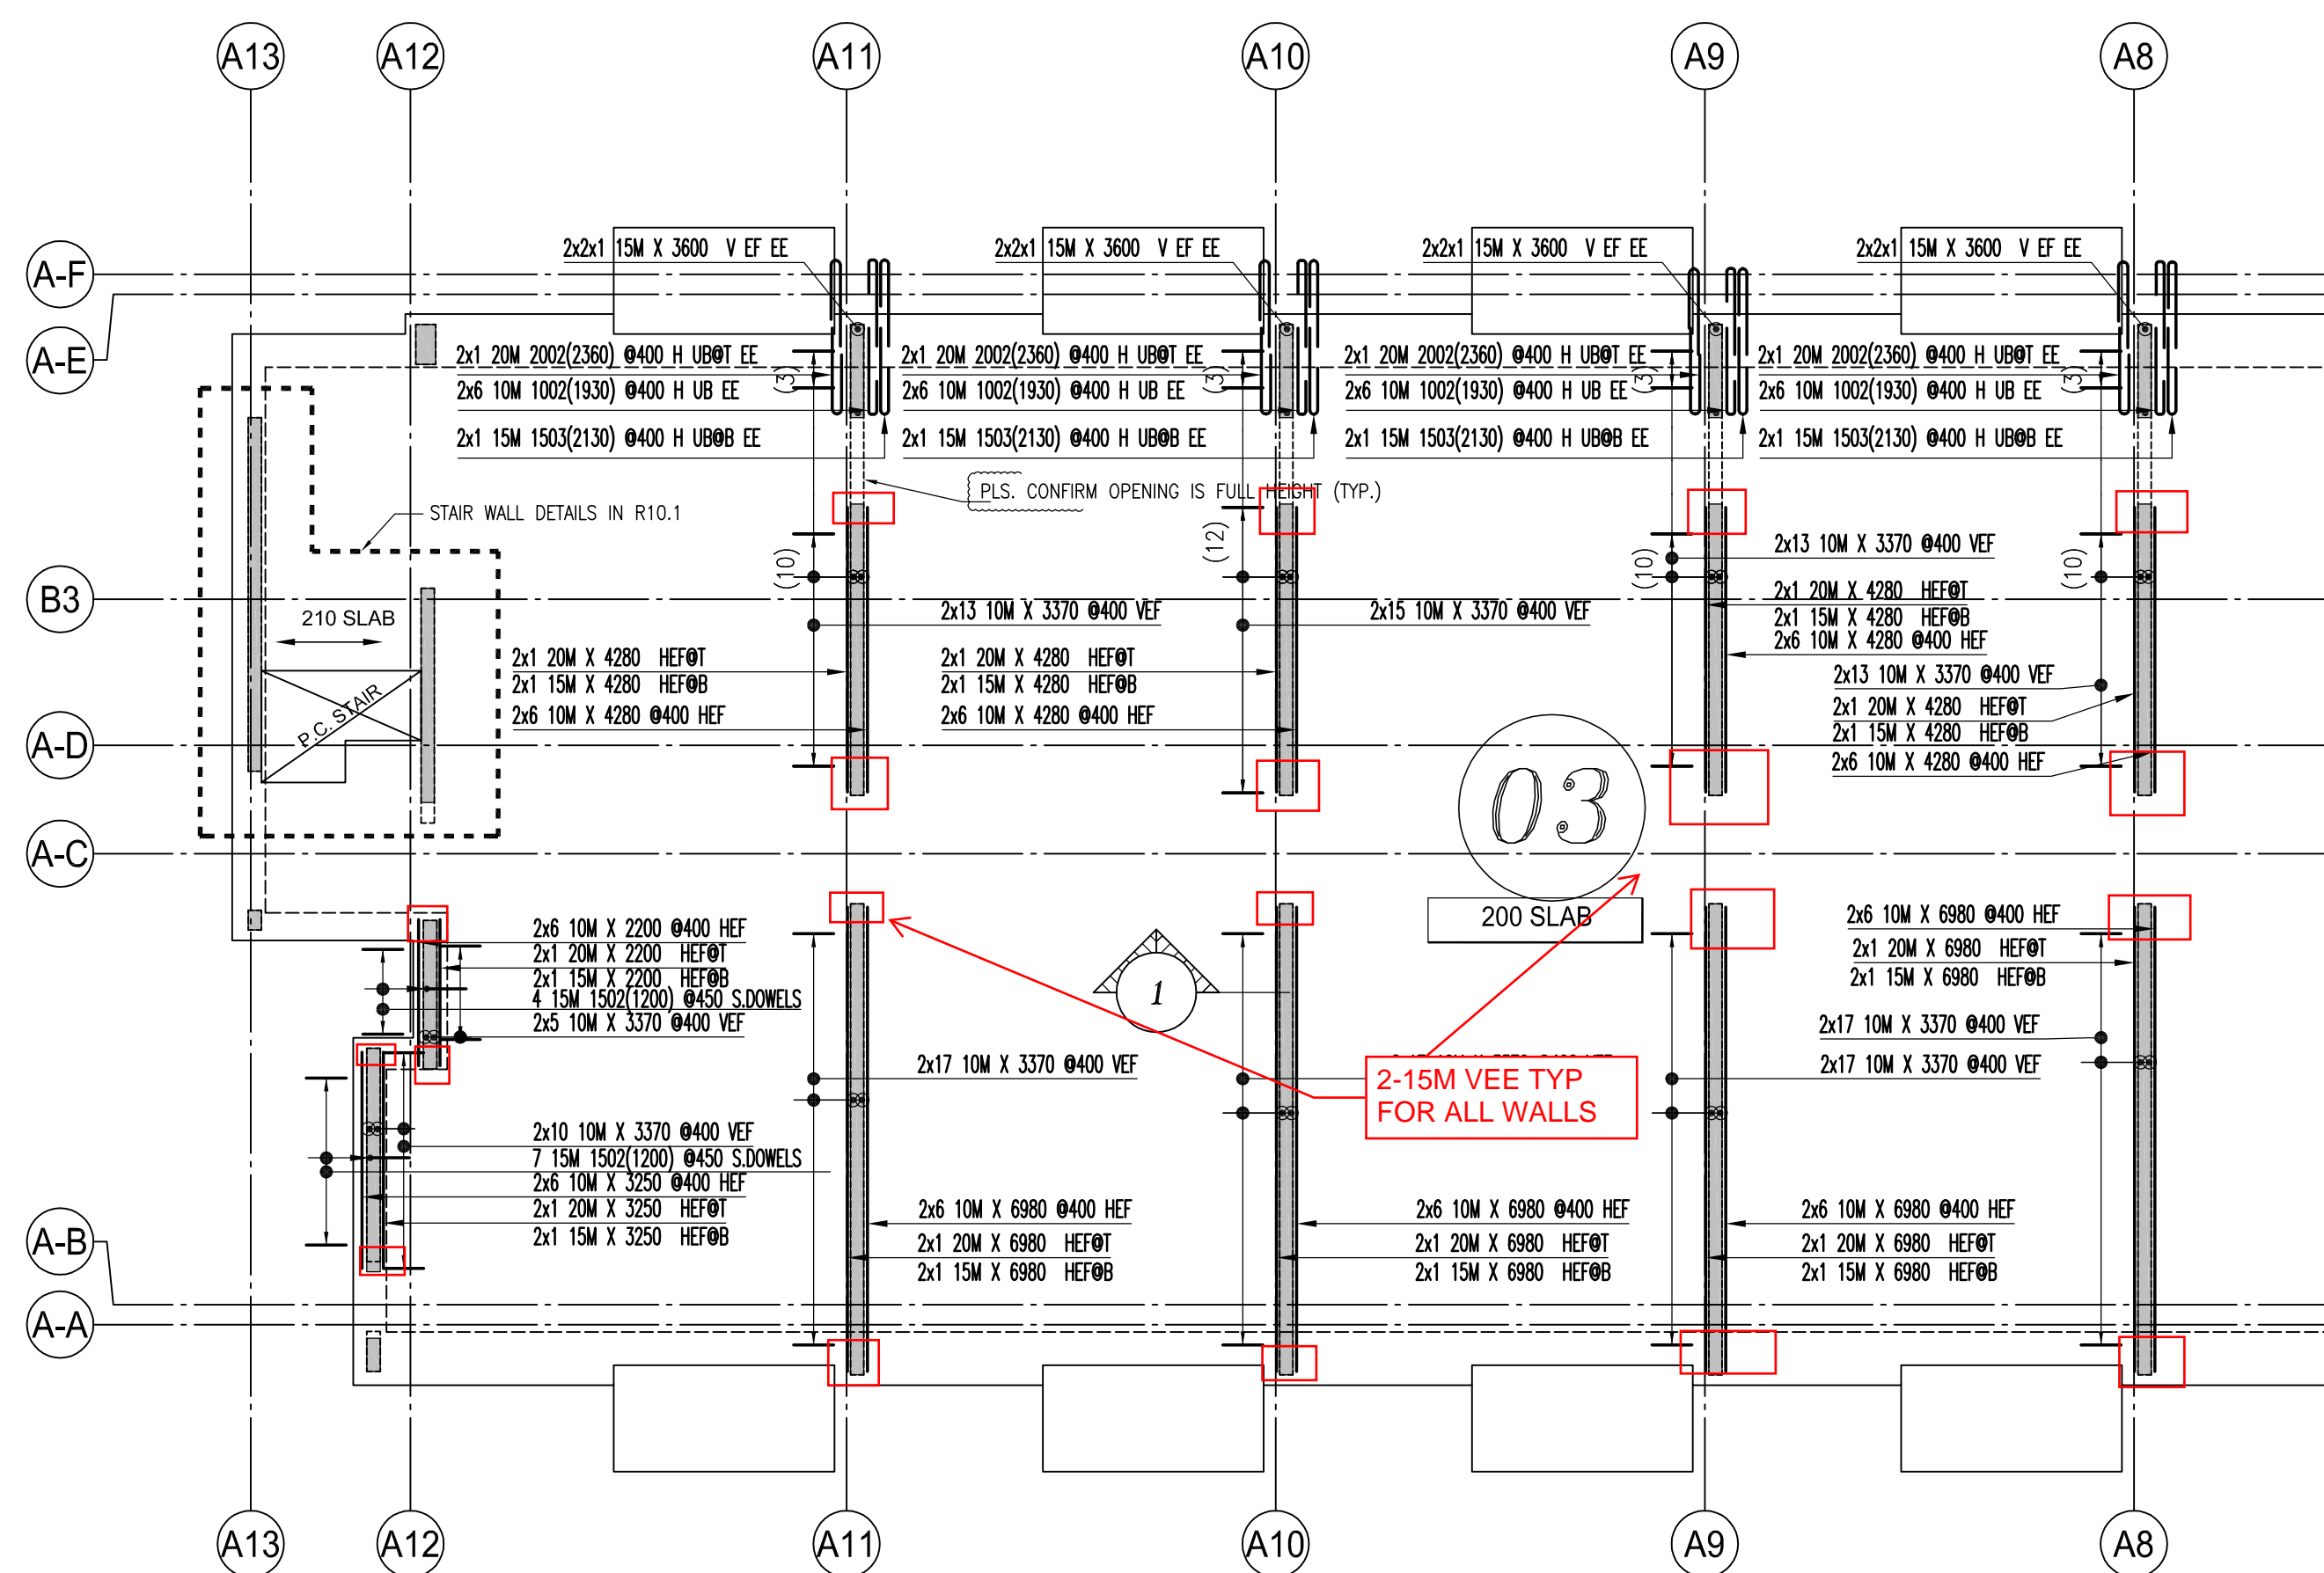


BUILDING-A WALL PLAN  
SCALE: 1:100  
(POUR-3 & 4)

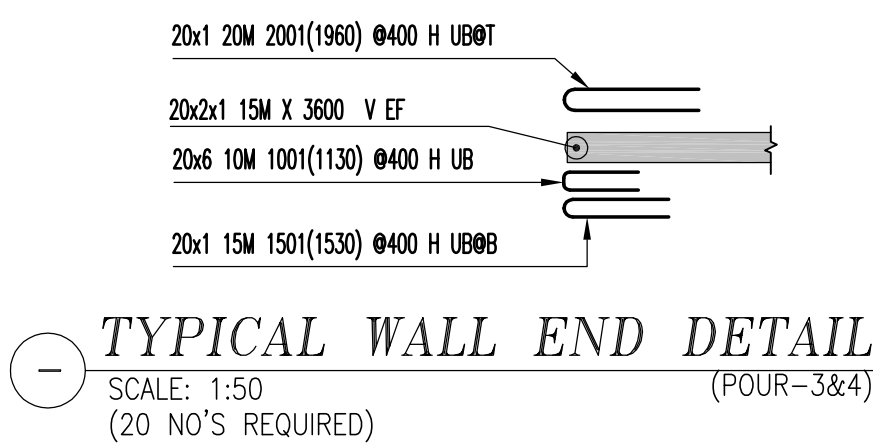

TYPICAL WALL END DETAIL  
SCALE: 1:50  
(20 NO'S REQUIRED)

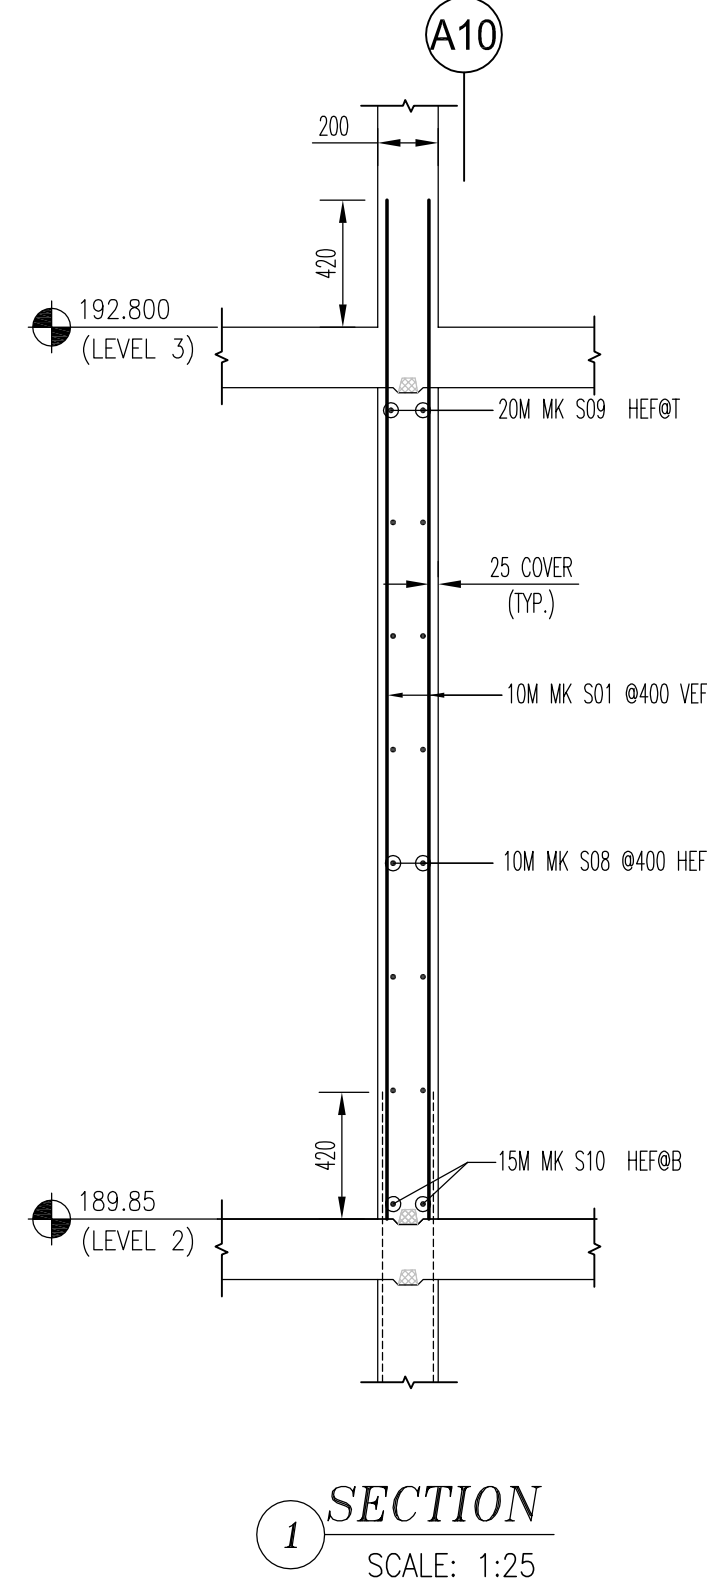

Release Code: R10.3 SW L2-L3 P#3&4 BENDING DETAILS.														
Bar Mark	Qty	Size	Total length	Type	'A'	'B'	'C'	'D'	'E'	'F'	'G'	'H'	'J'	'K'
8/15M	6980				6980									
48/10M	6980				6980									
8/20M	6980				6980									
274/10M	3370				3370									
48/10M	4280				4280									
8/20M	4280				4280									
8/15M	4280				4280									
56/15M	3600				3600									
2/15M	2200				2200									
12/10M	2200				2200									
2/20M	2200				2200									
2/15M	3250				3250									
12/10M	3250				3250									
2/20M	3250				3250									
1002	48/10M	1930	17		500	130	1300							
1001	120/10M	1120	17		500	130	500							
2002	8/20M	2360	17		900	160	1500							
1502	11/15M	1200	17		600	600								
1503	8/15M	2130	17		700	130	1300							
1501	20/15M	1530	17		700	130	700							
2001	20/20M	1960	17		900	160	900							

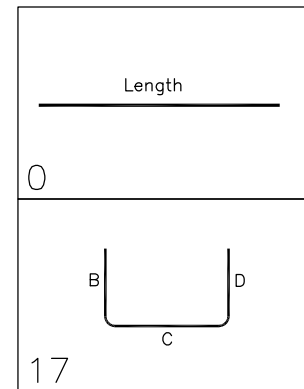

NOTES

1. ALL STEEL TO BE GRADE 400W
2. STRENGTH OF CONCRETE  
35MPa - INTERIOR COLUMNS & WALLS

3. CONCRETE COVER:  
VERTICALS

-- 25mm

4. COMPRESSION LAP SPLICE

BAR SIZE	STANDARD LAP (mm)
10M	300
15M	440
20M	590
25M	730
30M	880
35M	1030

5. TENSION LAP SPLICE (L.S) & DEVELOPMENT LENGTH (Ld)

BAR SIZE	fc=25		fc=30		fc=35	
	L.S	L.d	L.S	L.d	L.S	L.d
10M	380	330	350	300	320	300
15M	570	490	520	400	480	370
20M	750	650	690	530	640	490
25M	1170	1010	1070	830	990	770
30M	1410	1210	1290	990	1190	920
35M	1640	1410	1500	1160	1390	1070

DRAWING REVIEW

This review of this drawing does not in any way relieve the contractor of responsibility for its accuracy or for compliance with the contract documents.

No comment	See comment
Amend & Resubmit	Rejected See Remarks

Submission No. 19066  
Project No. 19066  
By AT  
Date 01 Jun 2021

JABLONSKY, AST AND PARTNERS  
Consulting Engineers  
3 Concorde Gate, North York, ON M3C 4H9

- ELEVATIONS AND DIMENSIONS SHOWN ARE FOR VERIFICATION PURPOSES ONLY AND ARE NOT TO BE USED FOR CONSTRUCTION
- ALL CONFIRMS/VERIFIES WILL BE ASSUMED CORRECT AND APPROVED AS IS UNLESS COMMENTED ON THE APPROVAL DRWS

LEGEND		
ALT = ALTERNATE	FF = FAR FACE	OF = OUTSIDE FACE
BOT = BOTTOM	FS = FORM SAVER	SC = SAW CUT END
BIS = BEND INTO SLAB	GID = GROUT IN DOWELS	STG = STAGGER
CB = CORNER BAR	H = HORIZONTAL	STR = STIRRUPS
CTS = CUT TO SUIT SITE COND.	IF = INSIDE FACE	T = TOP
DWL = DOWELS	LL = LOWER LAYER	THR/2 = THREAD ZENDS
EE = EACH END	MD = MIDDLE	THR/2 = THREAD ZENDS
EF = EACH FACE	MIN = MINIMUM	UL = UPPER LAYER
EJ = EXPANSION JOINT	NF = NEAR FACE	U/n = UNLESS NOTED
ES = EACH SIDE	OC = ON CENTER	V = VERTICAL
EW = EACH WAY	TT = TIE	TT = TIE

STRAIGHT BARS LABEL FORMAT	BENT BARS LABEL FORMAT	GRADES OF STEEL
7 B15M X 3600 QUANTITY LENGTH	7 B15M B1501 QUANTITY LENGTH SIZE BR WAX	B = GRADE 400W C = GRADE 500W S = GRADE 500W W = GRADE 500W

FOR APPROVAL	MAY/27/21	JU
ISSUE	REMARKS	DATE
MANSTEEL REBAR	MANSTEEL REBAR	DATE

MANSTEEL REBAR  
105 Industrial Road, Richmond Hill,  
Ontario L4C 2Y4 Canada  
Phone: 905-737-9797  
Fax: 905-737-9704  
Email: info@mansteelrebar.com


PROJECT  
FORESTSIDE TOWNHOUSES  
-BRAMPTON, ON

PART OF STRUCTURE  
SHEAR WALLS L2-L3 P#3

CUSTOMER: ROYAL PINE HOMES  
Project no. 2177  
SCALE: AS SHOWN

DETAILED BY: JU  
BAR LIST No.  
DRAWING No.  
R10.3



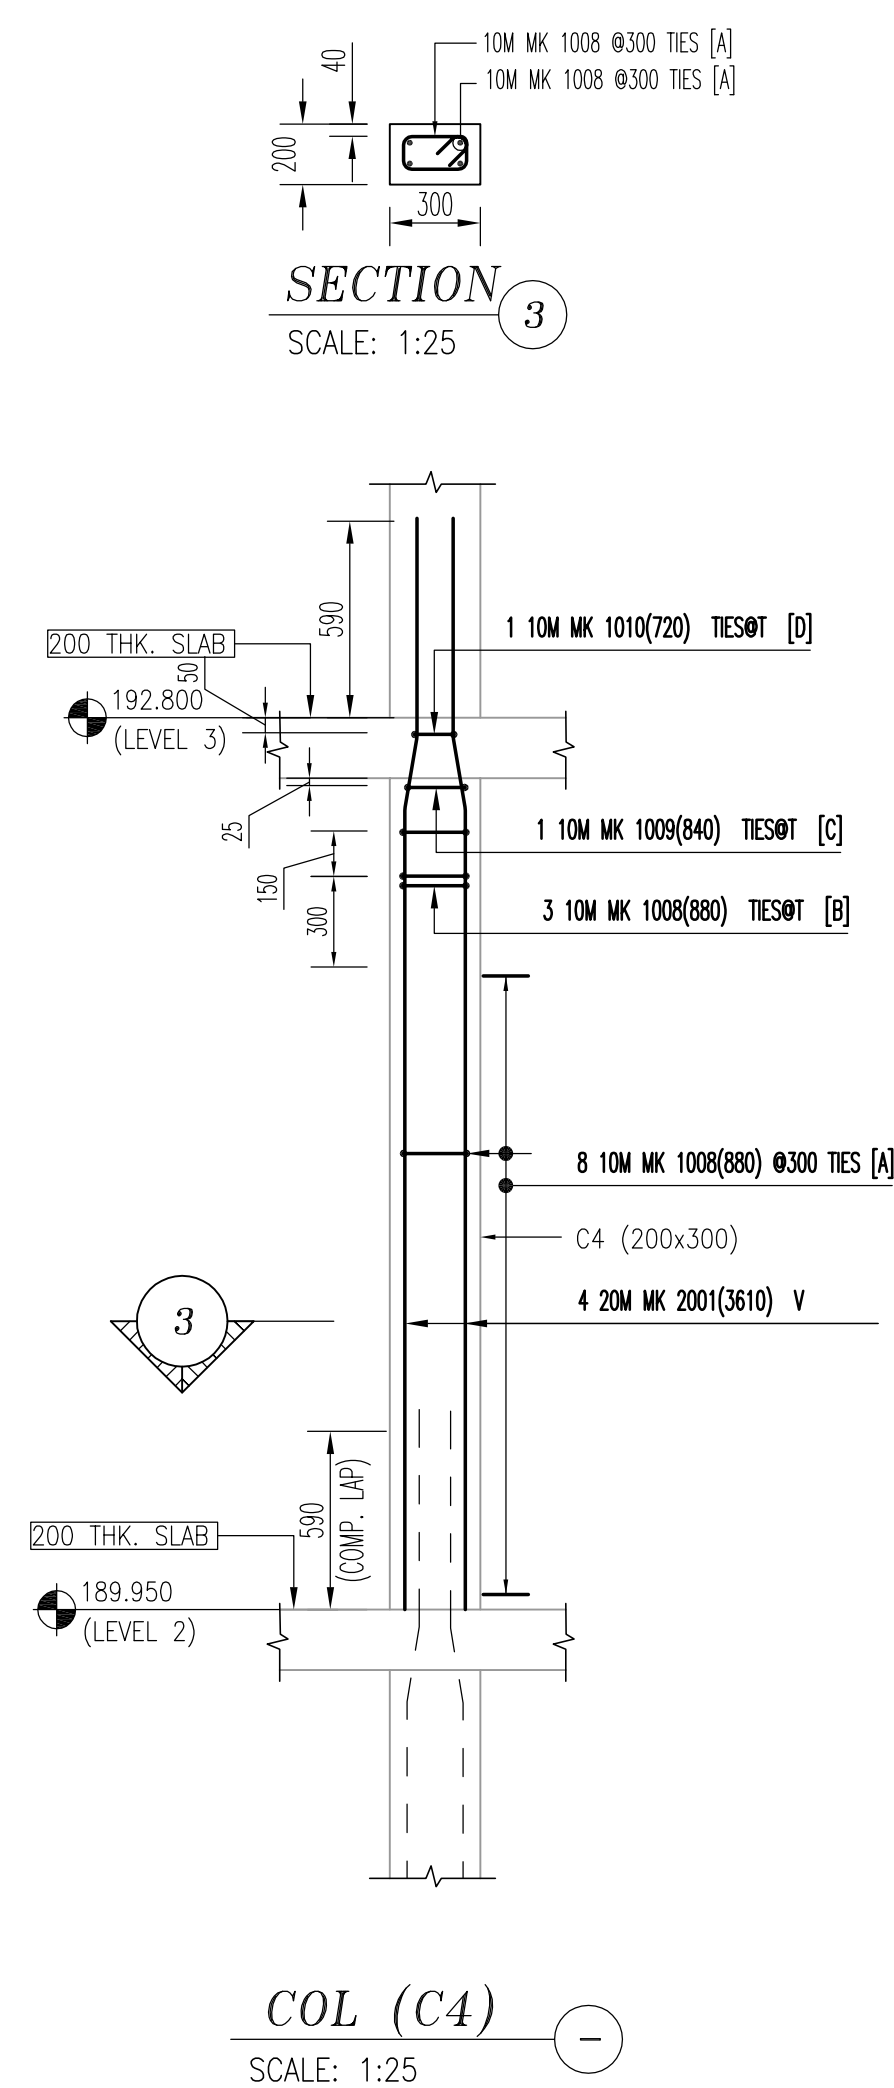

T1

Diagram T1 shows a square frame with vertices A, B, C, and D. A diagonal member connects vertex B to a point G on the vertical member CD. A horizontal member extends from G to vertex E. Dimensions are indicated: K is the horizontal distance from A to C and from B to G; H is the vertical distance from C to G. The total width is O, and the total height is O.

3 Hooks A & G optional


Diagram 3 shows a U-shaped frame with vertices A, B, C, D, E, F, and G. Dimensions are indicated: K is the horizontal distance from A to C and from F to G; H is the vertical distance from C to D and from E to F. The total width is O, and the total height is O.

T9

Diagram T9 shows a U-shaped frame with vertices A and G. The bottom horizontal member is labeled B. The frame is symmetric and has a constant cross-section.

-- 40mm



BAR SIZE	fc=25		fc=30		fc=35	
	L.S.	L <sub>d</sub>	L.S.	L <sub>d</sub>	L.S.	L <sub>d</sub>
10M	380	330	350	300	320	300
15M	570	490	520	400	480	370
20M	750	650	690	530	640	490
25M	1170	1010	1070	830	990	770
30M	1410	1210	1290	990	1190	920
35M	1640	1410	1500	1160	1390	1070

PROJECT		FORESTSIDE TOWNHOUSES -BRAMPTON, ON	
PART OF STRUCTURE		COLUMNS L2-L3 -P#1	
CUSTOMER :		Project no.    2177	
ROYAL PINE HOMES		SCALE:    AS SHOWN	
		DRAWING No.	
DETAILED BY:    JU	BAR LIST No.	R11.0 	
CHECKED BY:			

This review of this drawing does not in any way relieve the contractor of responsibility for its accuracy or for compliance with the contract documents.


Submission No. \_\_\_\_\_  
Project No. **19066**  
By **AF**  
Date **01 Jun 2021**

JABLONSKY, AST AND PARTNERS  
Consulting Engineers  
3 Concorde Gate, North York, ON M3C 4H9

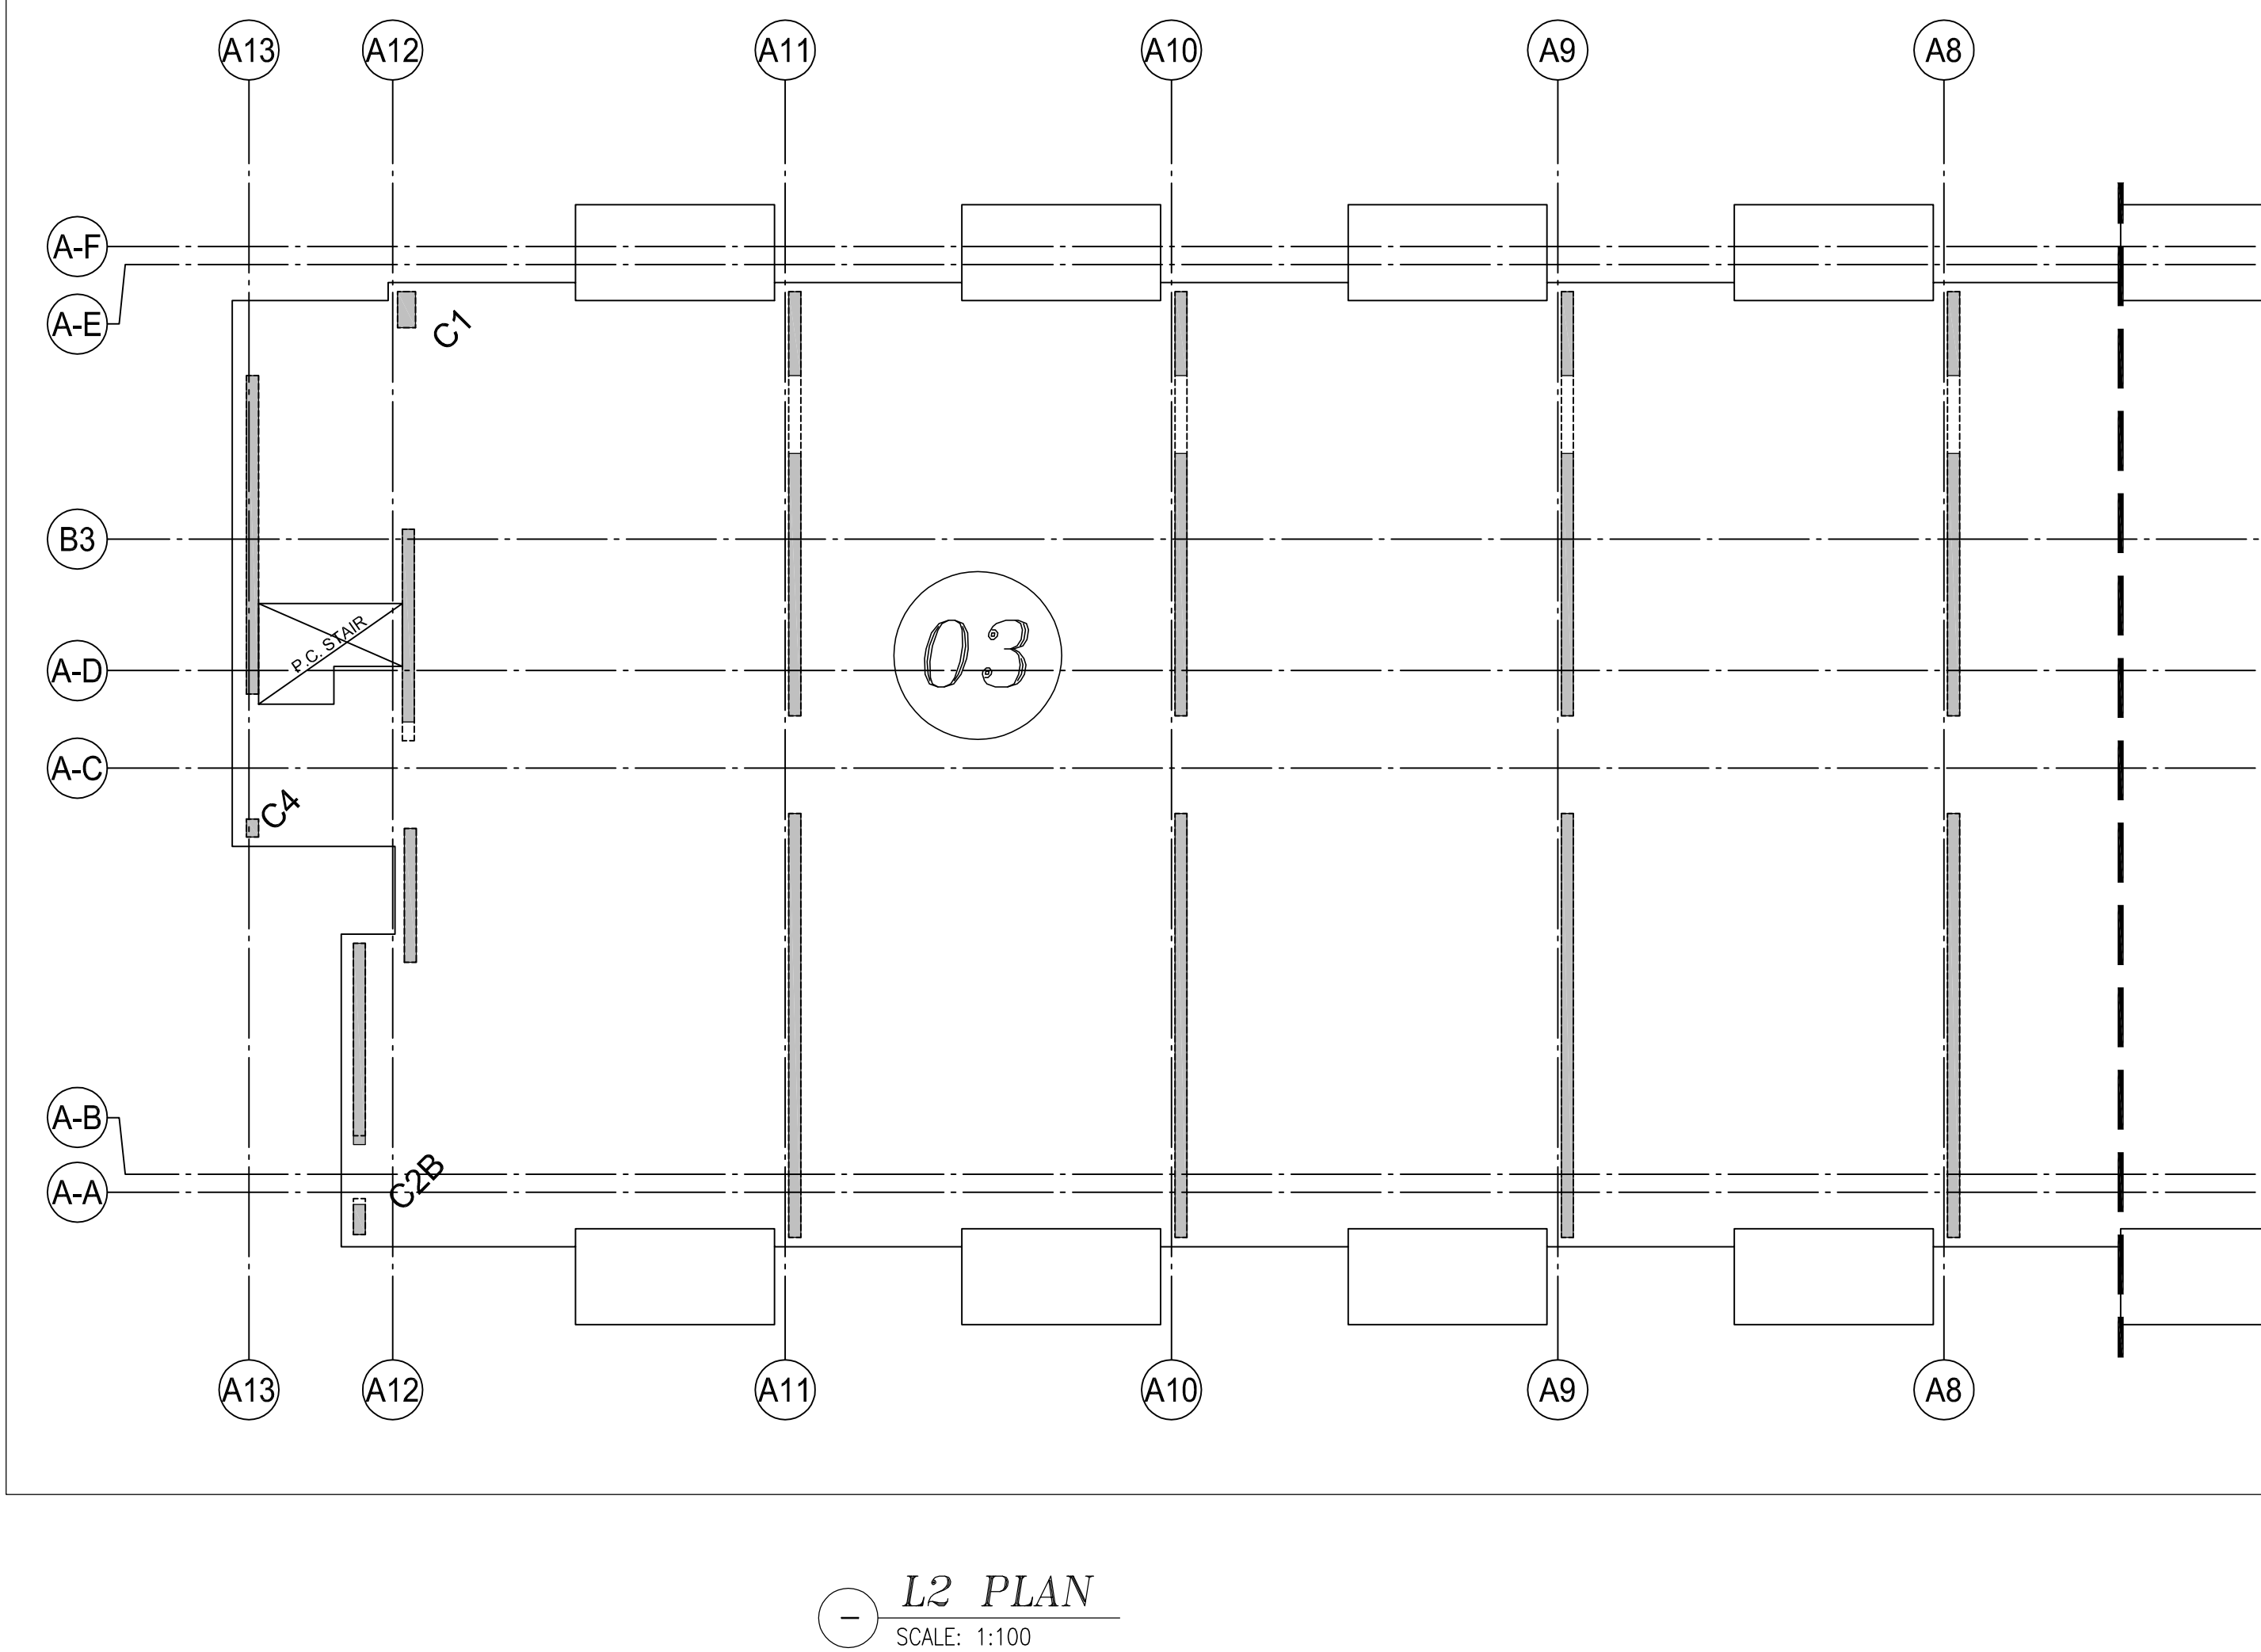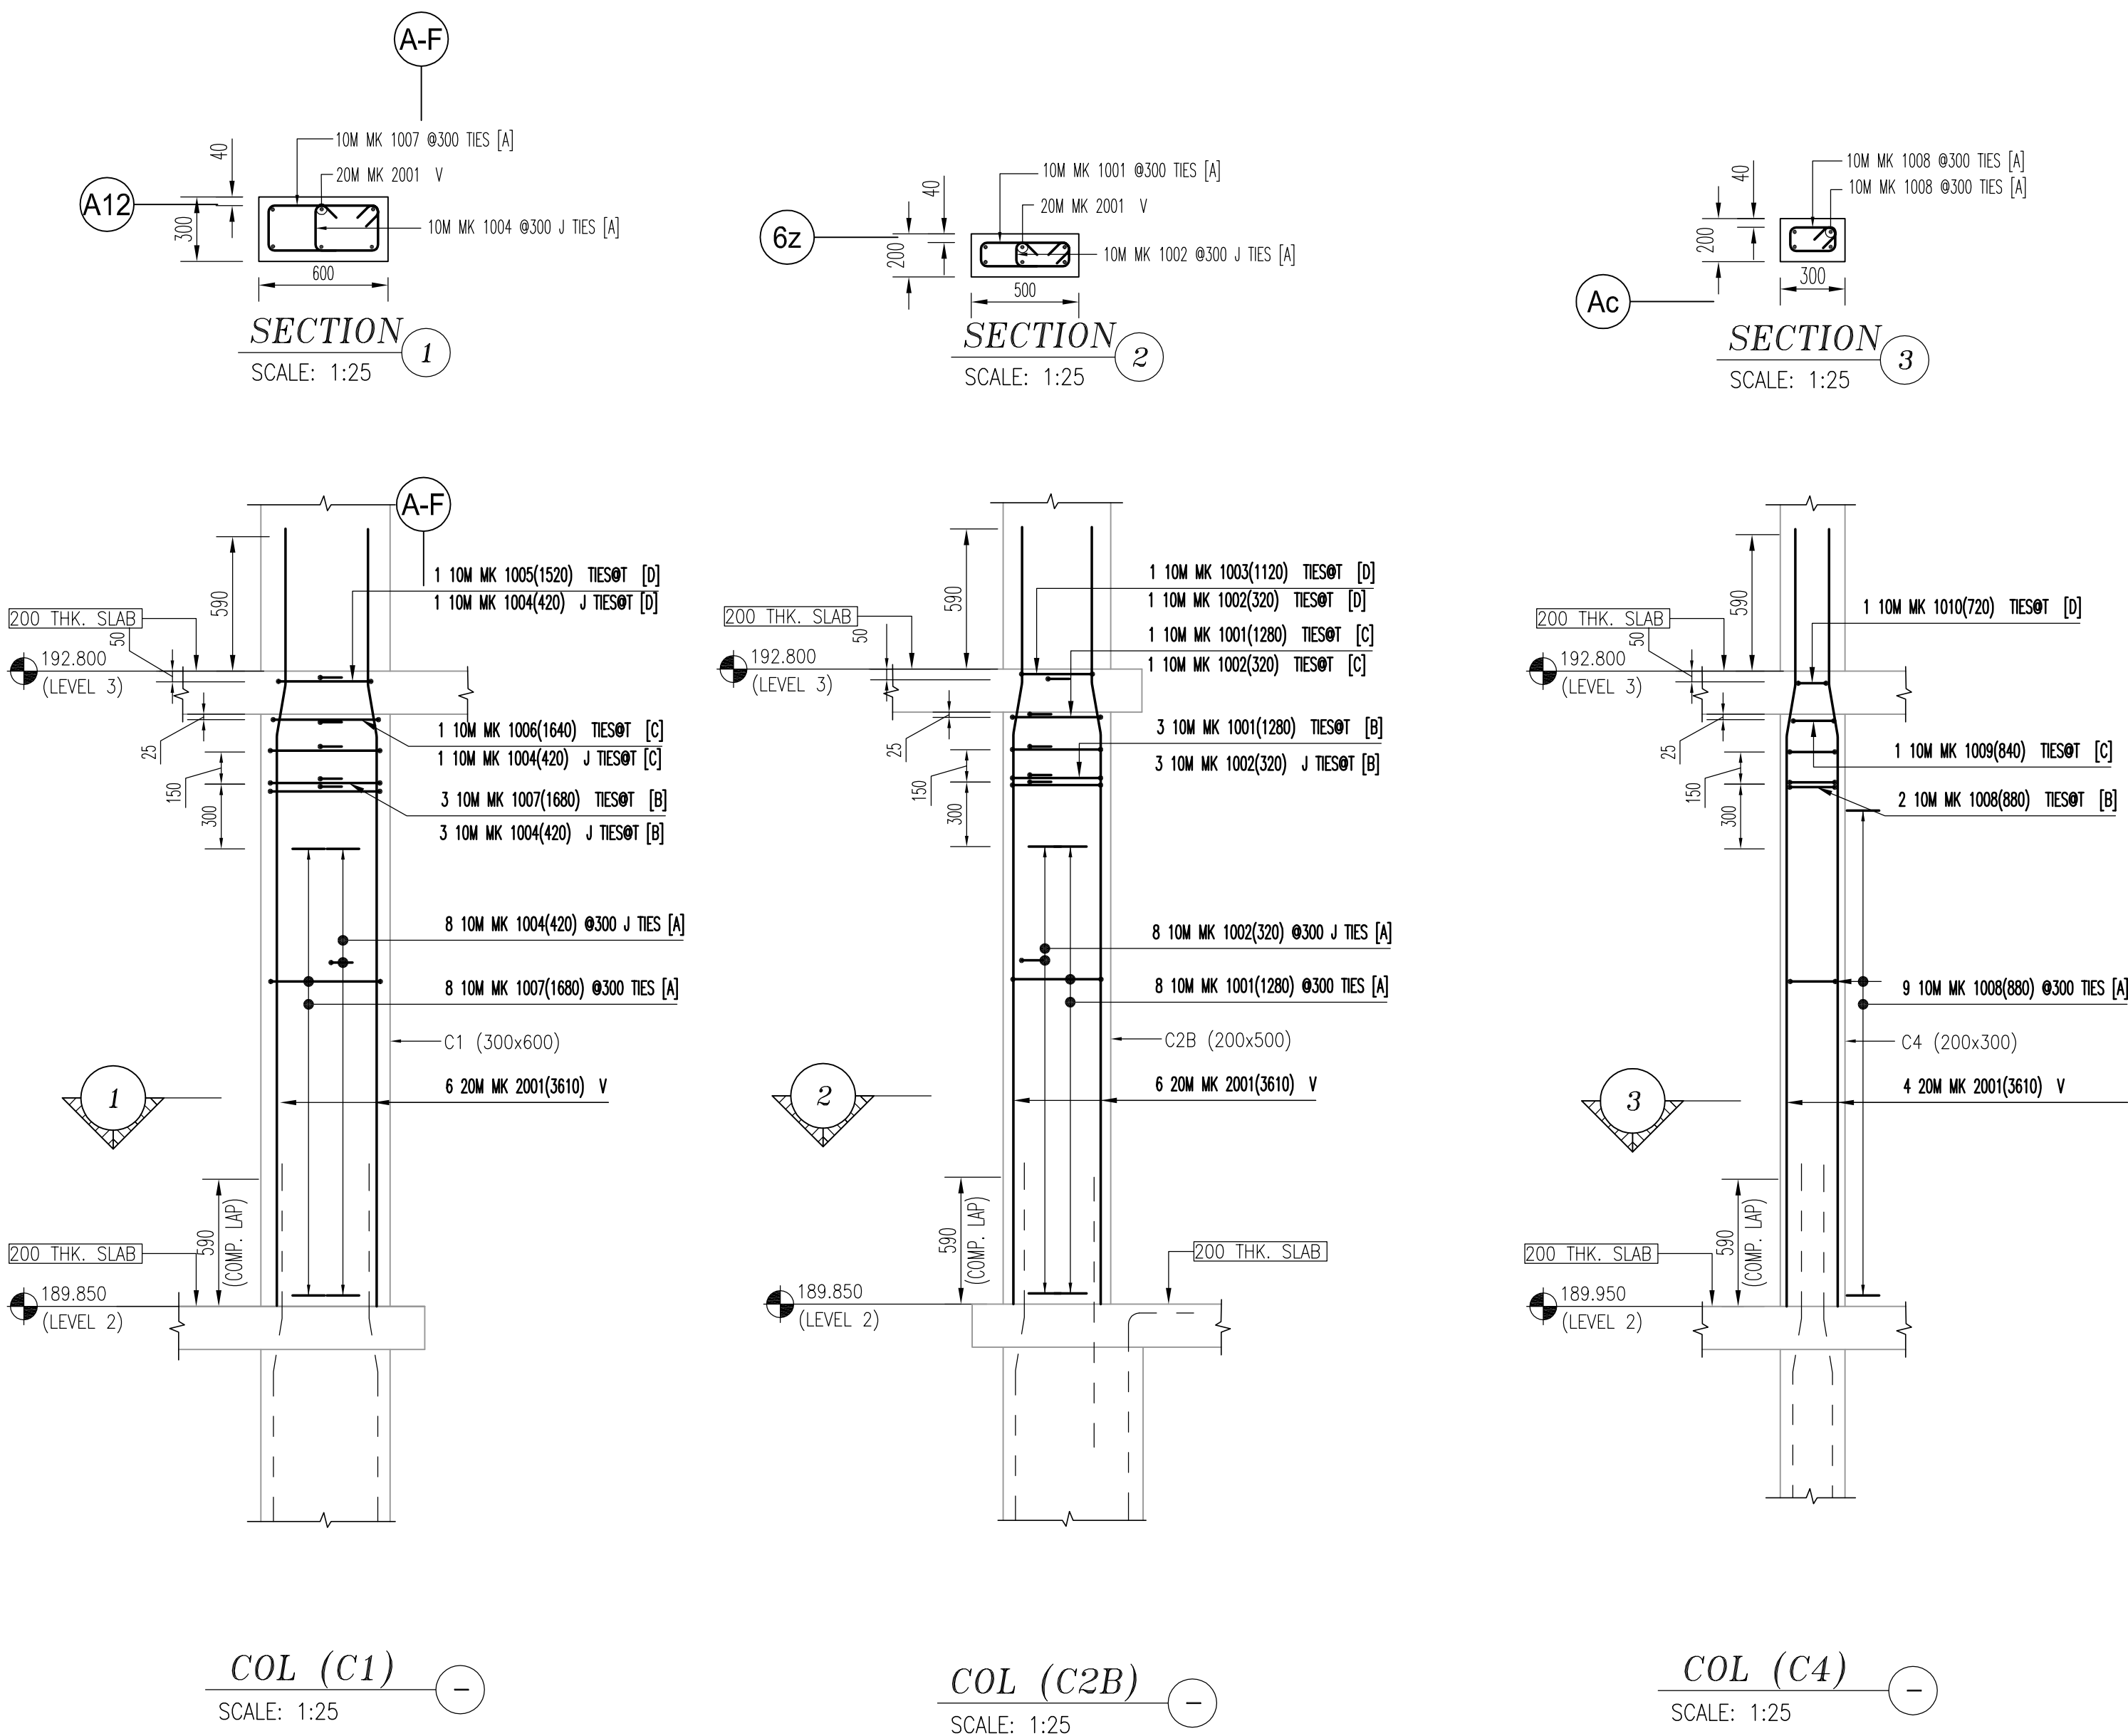

Release Code: R-11.1 COL L2-L3 P#3 BENDING DETAILS.

Bar Mark	Qty	Size	Total length	Type	A'	B'	C'	D'	E'	F'	G'	H'	I'	J'	K'	L'	M'
1001	12	10M	1280	T1	100	420	120	420	120		100						
1002	13	10M	320	T9	100	120					100						
1003	1	10M	1120	T1	100	340	120	340	120		100						
1004	13	10M	420	T9	100	220					100						
1005	1	10M	1520	T1	100	440	220	440	220		100						
1006	1	10M	1640	T1	100	500	220	500	220		100						
1007	11	10M	1680	T1	100	520	220	520	220		100						
1008	11	10M	880	T1	100	220	120	220	120		100						
1009	1	10M	840	T1	100	200	120	200	120		100						
1010	1	10M	720	T1	100	140	120	140	120		100						
2001	16	20M	3610	J		725	240	2650						60		235	3610

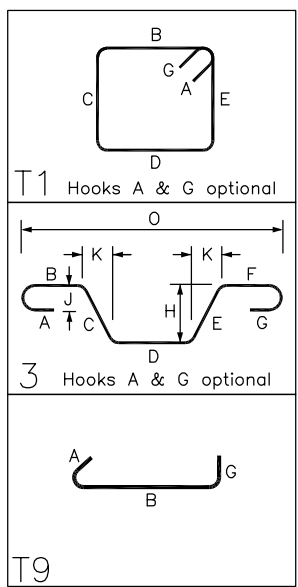

**DRAWING REVIEW**

This review of this drawing does not in any way relieve the contractor of responsibility for its accuracy or for compliance with the contract documents.

<input checked="" type="checkbox"/> No comment	<input type="checkbox"/> See comment
<input type="checkbox"/> Amend & Resubmit	<input type="checkbox"/> Rejected See Remarks

Submission No. 19066  
Project No. AF  
By 01 Jun 2021  
Date

JABLONSKY, AST AND PARTNERS  
Consulting Engineers  
3 Concorde Gate, North York, ON M3C 4H8

NOTES

1. ALL STEEL TO BE GRADE 400W  
2. STRENGTH OF CONCRETE  
35MPa - INTERIOR COLUMNS & WALLS

3. CONCRETE COVER:  
TIES

-- 40mm

4. COMPRESSION LAP SPLICE

BAR SIZE	STANDARD LAP (mm)
10M	300
15M	440
20M	590
25M	730
30M	880
35M	1030

5. TENSION LAP SPLICE (L.S) & DEVELOPMENT LENGTH (Ld)

BAR SIZE	fc=25		fc=30		fc=35	
	L.S	L.d	L.S	L.d	L.S	L.d
10M						
15M	380	330	350	300	320	300
20M	570	490	520	400	480	370
25M	750	650	690	530	640	490
30M	1170	1010	1070	830	990	770
35M	1410	1210	1290	990	1190	920

- ELEVATIONS AND DIMENSIONS SHOWN ARE FOR VERIFICATION PURPOSES ONLY AND ARE NOT TO BE USED FOR CONSTRUCTION  
• ALL CONFIRMS/VERIFIES WILL BE ASSUMED CORRECT AND APPROVED AS IS UNLESS COMMENTED ON THE APPROVAL DRWS

LEGEND

ALT = ALTERNATE	FF = FAR FACE	OF = OUTSIDE FACE
BOT = BOTTOM	FS = FORM SAVER	SC = SAW CUT END
BIS = BEND INTO SLAB	GID = GROUT IN DOWELS	STG = STAGGER
CB = CORNER BAR	H = HORIZONTAL	STR = STIRRUPS
CTS = CUT TO SUIT SITE COND.	IF = INSIDE FACE	T = TOP
DWL = DOWELS	LL = LOWER LAYER	THR/2 = THREAD ZENDS
EE = EACH END	MD = MIDDLE	UL = UPPER LAYER
ET = EACH FACE	MIN = MINIMUM	W/n = UNLESS NOTED
EJ = EXPANSION JOINT	NF = NEAR FACE	V = VERTICAL
ES = EACH SIDE	OC = ON CENTER	TT = TOP TIES
EW = EACH WAY		

STRAIGHT BARS LABEL FORMAT	BENT BARS LABEL FORMAT	GRADES OF STEEL
7 B15M X 3600 QUANTITY LENGTH	7 B15M B1501 QUANTITY SIZE - BR MARK	B = GRADE 400W C = GRADE 500W S = GRADE 600W W = WELDABLE

FOR APPROVAL

ISSUE

REMARKS

DATE

BY

MANSTEEL REBAR

105 Industrial Road, Richmond Hill, Ontario L4C 2Y4 Canada  
Phone: 905-737-9797  
Fax: 905-737-9704  
Email: info@mansteelrebar.com

FORESTSIDE TOWNHOUSES  
-BRAMPTON, ON

COLUMNS L2-L3 -P#3

CUSTOMER: ROYAL PINE HOMES

DETAILED BY: JU

CHECKED BY:

Project no. 2177

SCALE: AS SHOWN

DRAWING No.

R11.1




## DRAWING REVIEW


This review of this drawing does not in any way relieve the contractor of responsibility for its accuracy or for compliance with the contract documents.

No comment	✓ See comment
Amend & Resubmit	Rejected See Remarks



Submission No. 15006  
Project No. 15006  
By: AL  
Date: 01 Jun 2021  
JABLONSKY, AST AND PARTNERS  
Consulting Engineers  
9 Concorde Gate, North York, ON M3C 4H5

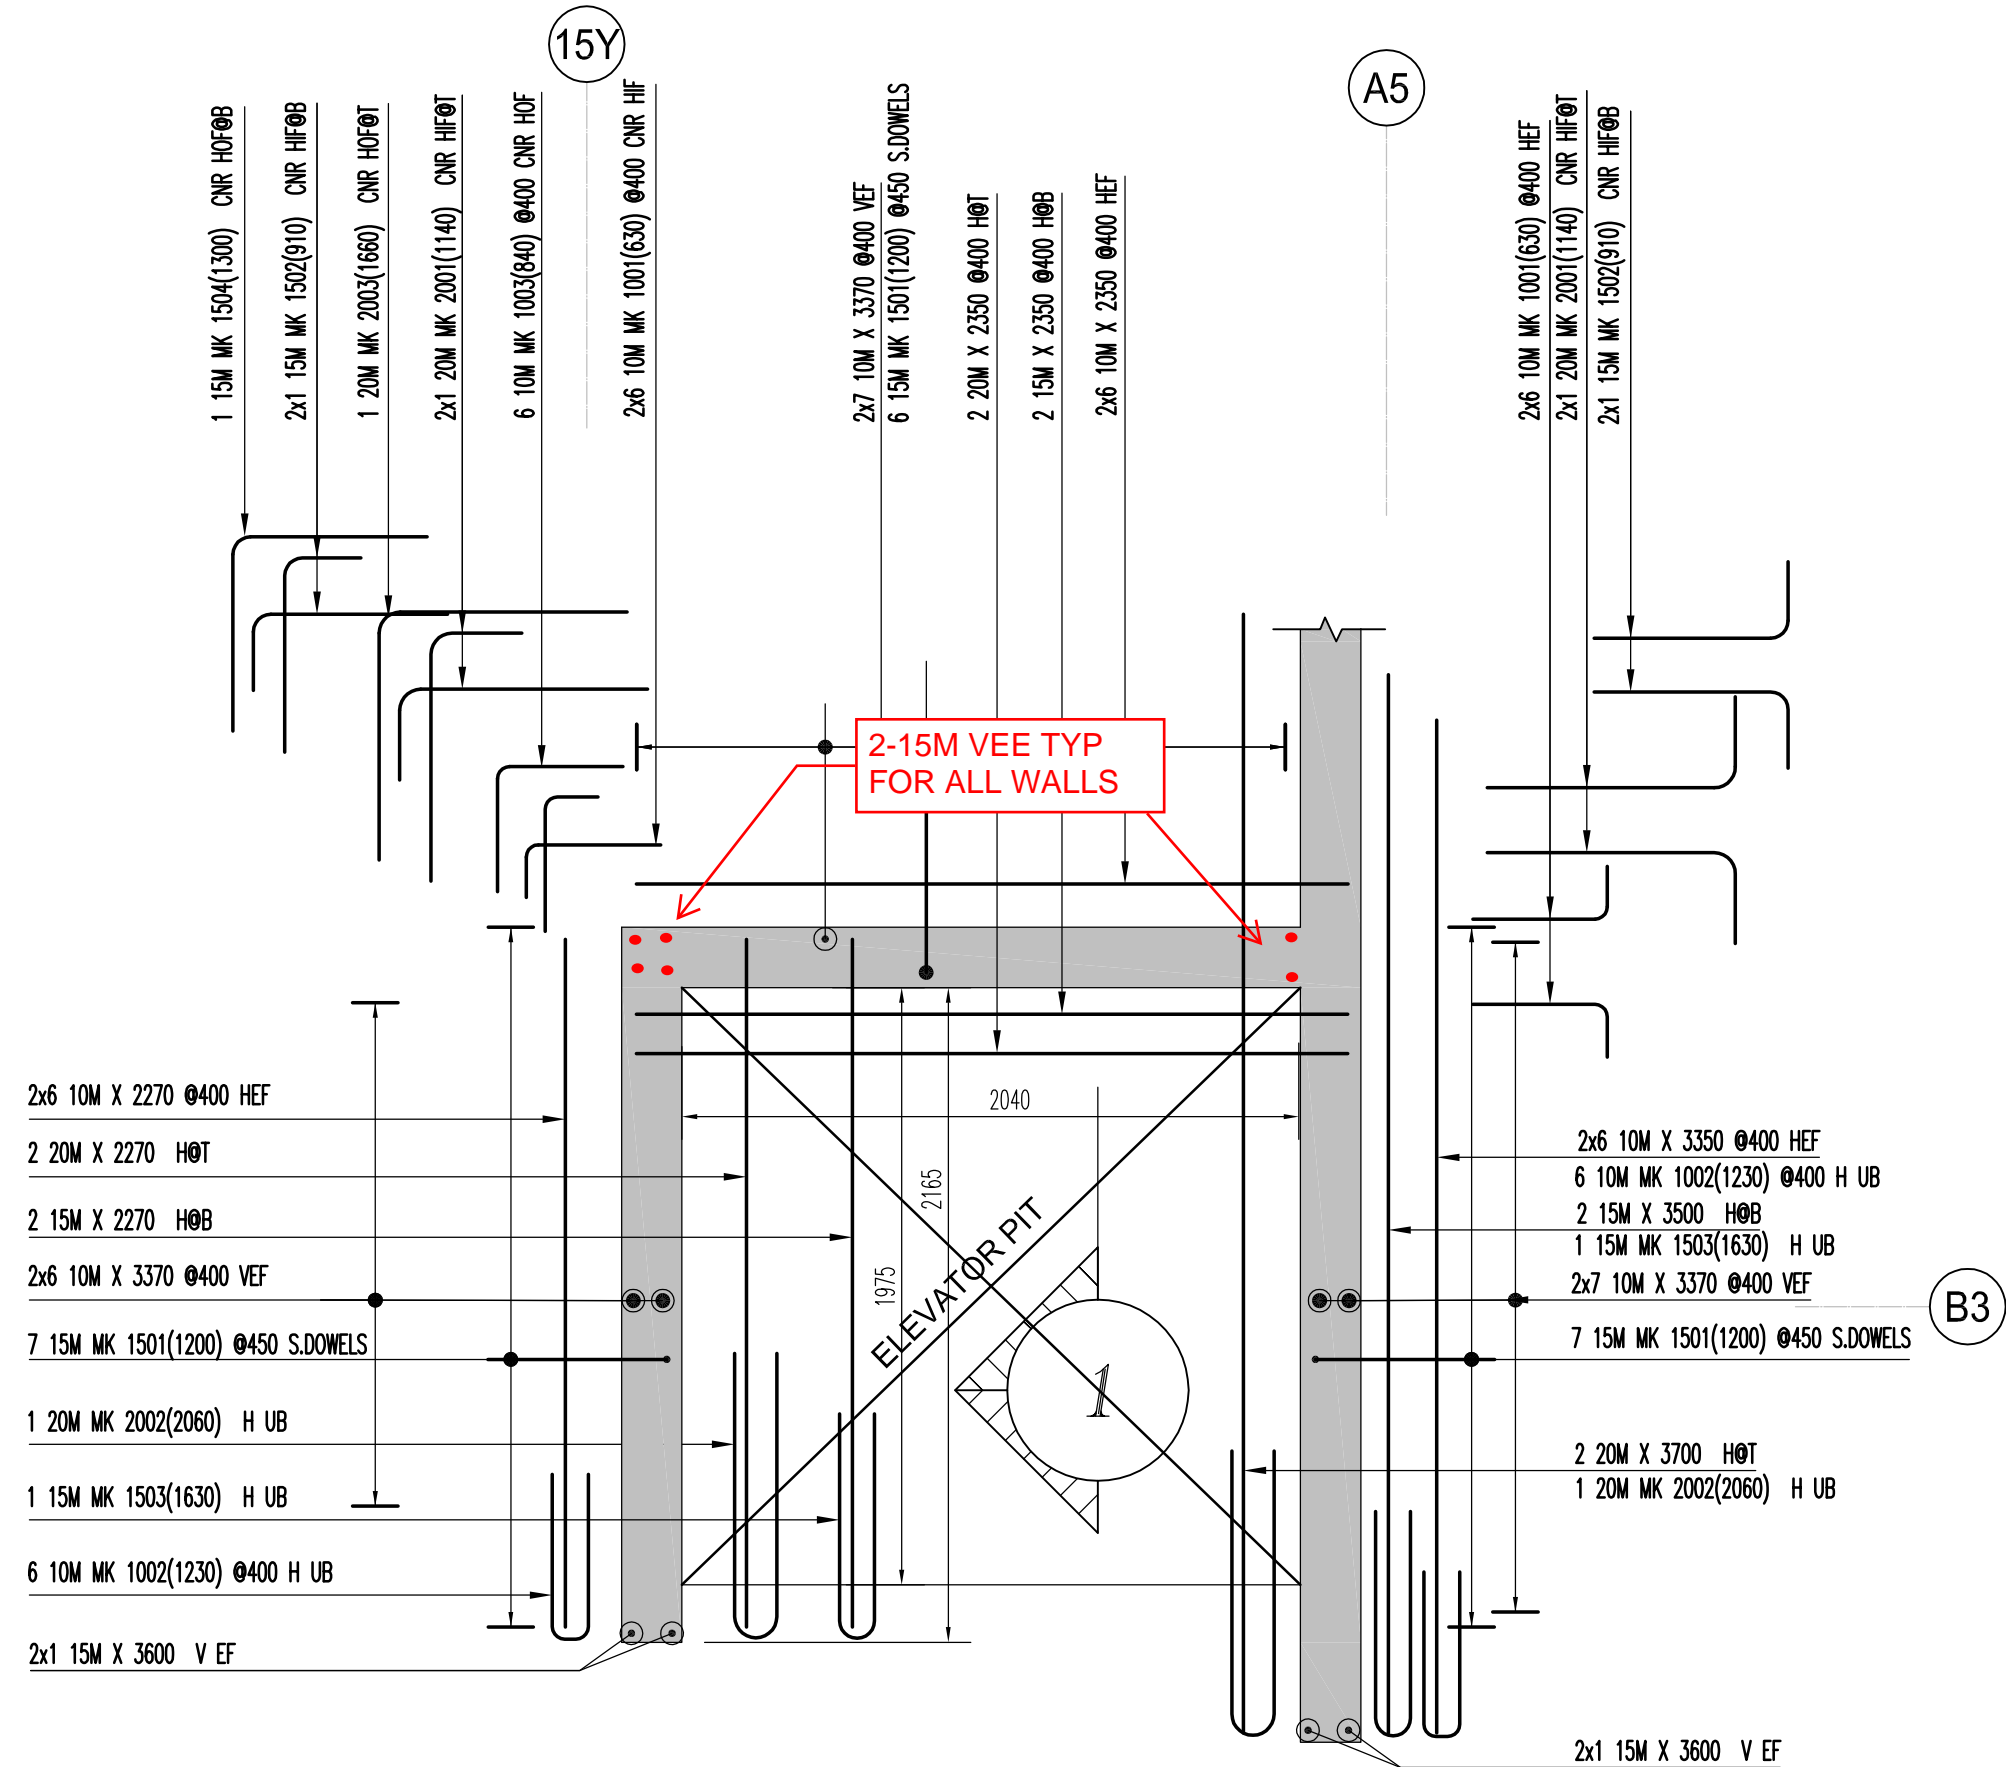

BUILDING-A  
ELEVATOR WALL PLAN L2-L3  
SCALE: 1:25  
(POUR-2)

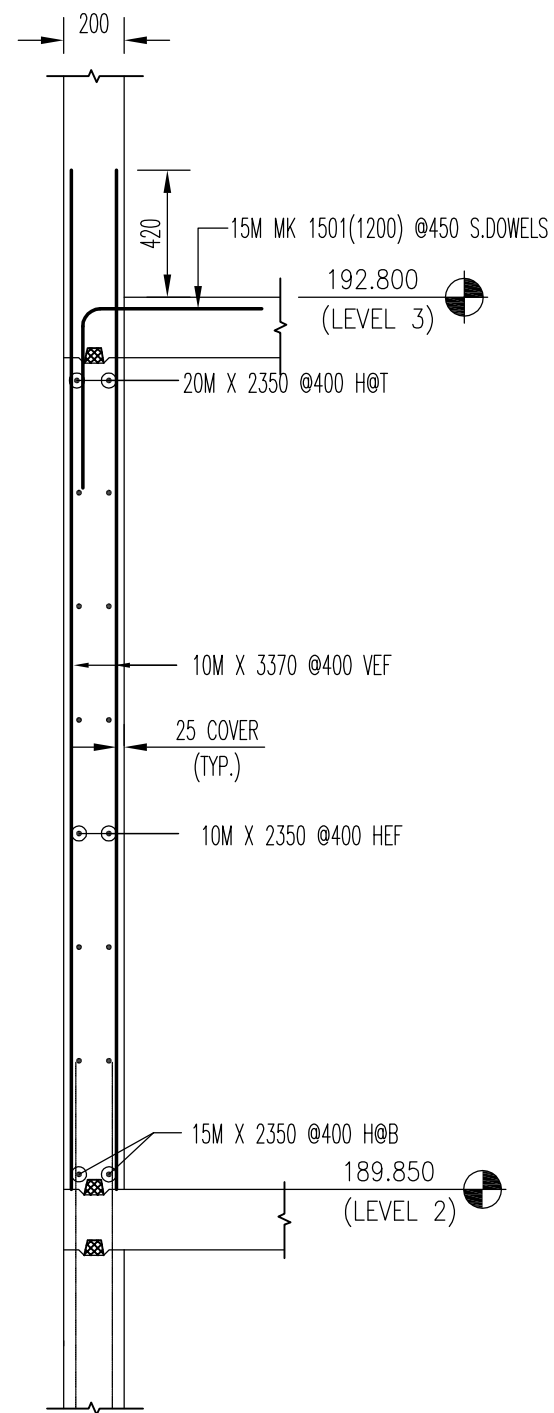

Bar Mark	Qty	Size	Total length	Type	A'	B'	C'	D'	E'	F'	G'	H'	I'	J'	K'	L'	M'
1001	24	10M	630	2	180	450											
1003	6	10M	840	17		420	420										
1002	12	10M	1230	17		550	130	550									
1501	20	15M	1200	17		600	600										
1503	2	15M	1630	17		750	130	750									
2002	2	20M	2060	17		950	160	950									
1502	4	15M	990	2	260	650											
1504	1	15M	1300	17		650	650										
2001	4	20M	1140	2	310	830											
2003	1	20M	1660	17		830	830										

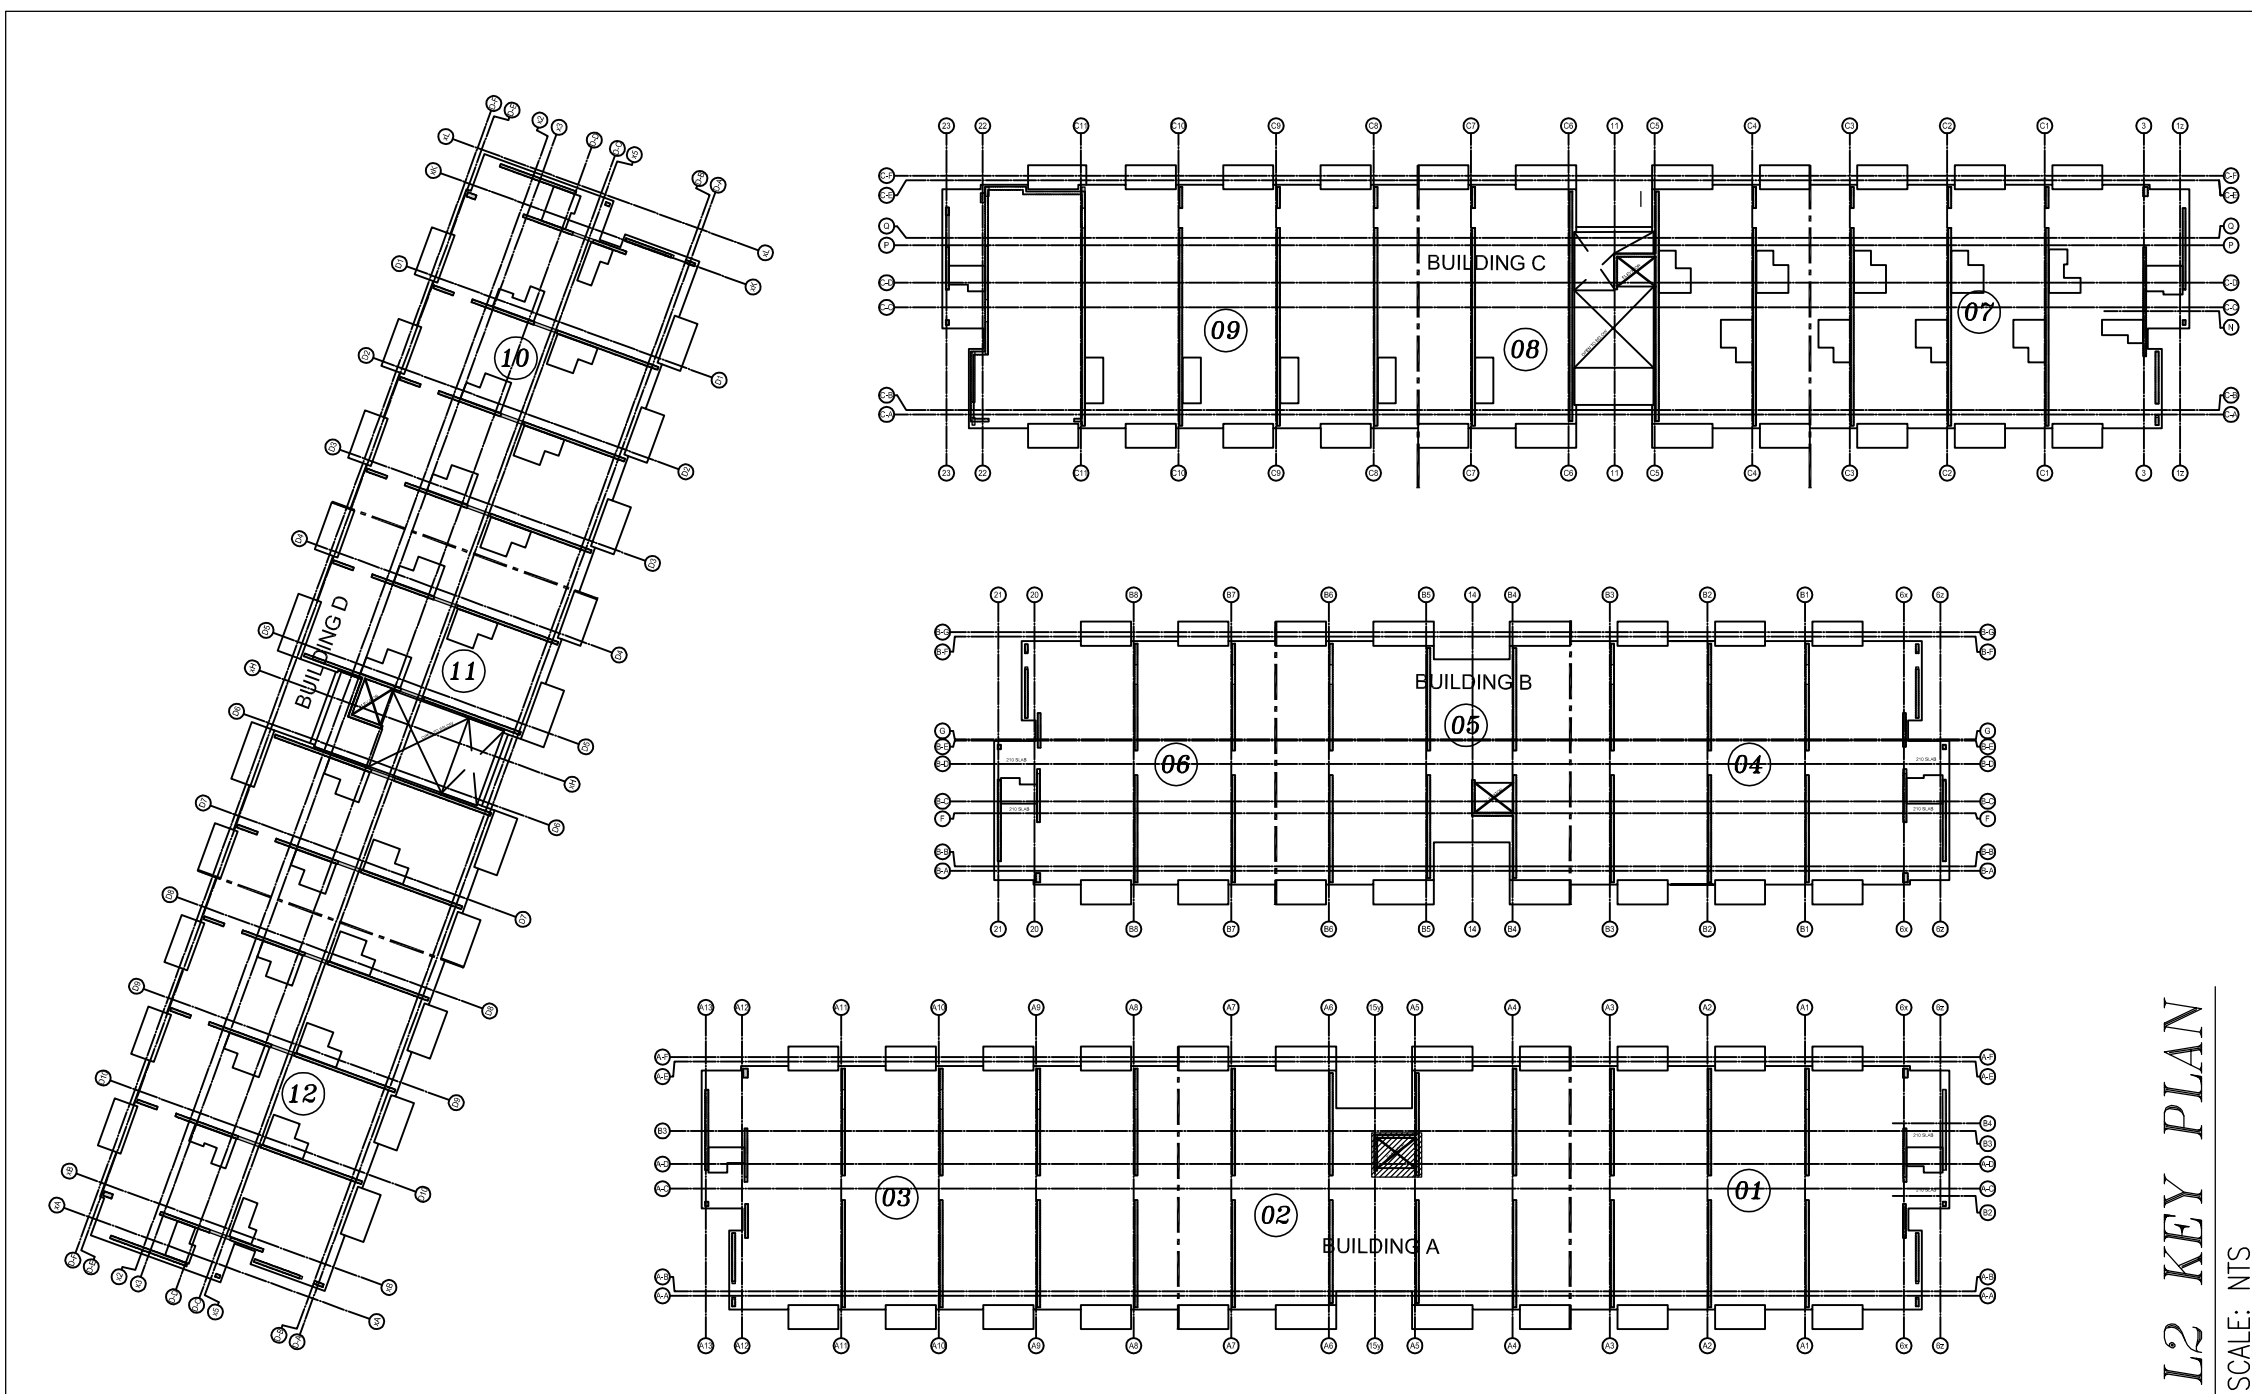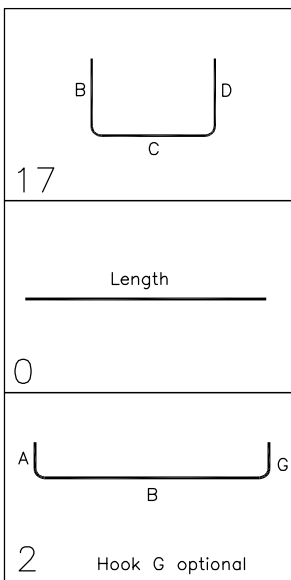

## NOTES

- ALL STEEL TO BE GRADE 400W
- STRENGTH OF CONCRETE 35MPa - INTERIOR COLUMNS & WALLS

- CONCRETE COVER: VERTICALS

-- 25mm

BAR SIZE	STANDARD LAP (mm)
10M	300
15M	440
20M	590
25M	730
30M	880
35M	1030


BAR SIZE	fc=25		fc=30		fc=35	
	L.S	L.d	L.S	L.d	L.S	L.d
10M	380	330	350	300	320	300
15M	570	490	520	400	480	370
20M	750	650	690	530	640	490
25M	1170	1010	1070	830	990	770
30M	1410	1210	1290	990	1190	920
35M	1640	1410	1500	1160	1390	1070

- ELEVATIONS AND DIMENSIONS SHOWN ARE FOR VERIFICATION PURPOSES ONLY AND ARE NOT TO BE USED FOR CONSTRUCTION
- ALL CONFIRMS/VERIFIES WILL BE ASSUMED CORRECT AND APPROVED AS IS UNLESS COMMENTED ON THE APPROVAL DRWS


LEGEND	STRAIGHT BARS LABEL FORMAT	BENT BARS LABEL FORMAT	GRADES OF STEEL
ALT = ALTERNATE BOT = BOTTOM BIS = BEND INTO SLAB CB = CORNER BAR CTS = CUT TO SUIT SITE COND. DWL = DOWELS EE = EACH END EF = EACH FACE EJ = EXPANSION JOINT ES = EACH SIDE EW = EACH WAY	7 B15M X 3600 QUANTITY TYPE LENGTH	7 B15M Ø1501 QUANTITY SIZE BENT MARK	GRADE 400W GRADE 500W GRADE 600W GRADE 878



Release Code: R10.1 STR SW L2-L3 P18ENDING DETAILS.																	
Bar Mark	Qty	Size	total length	type	'A'	'B'	'C'	'D'	'E'	'F'	'G'	'H'	'I'	'J'	'K'	'O'	'R'
	80	10M	3370			3370											
	24	10M	3140				3140										
	24	10M	5210				5210										
	4	20M	5200				5200										
	4	15M	5200				5200										
	4	20M	3150			3150											
	4	15M	3150			3150											
	16	15M	3600			3600											
1004	36	10M	1000	17			500	500									
1002	48	10M	1230	17			550	130	550								
1505	4	15M	1060	2	260		800										
1503	8	15M	1630	17			750	130	750								
1501	8	15M	1200	17			600	600									
2002	8	20M	2060	17			950	160	950								

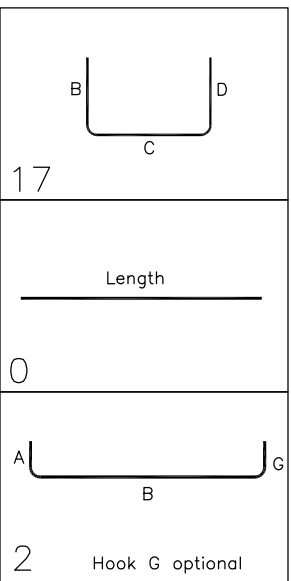

DRAWING REVIEW	
<p>This review of this drawing does not in any way relieve the contractor of responsibility for its accuracy or for compliance with the contract documents.</p>	
<input checked="" type="checkbox"/> No comment	<input type="checkbox"/> See comment
<input type="checkbox"/> Amend & Resubmit	<input type="checkbox"/> Rejected <input type="checkbox"/> See Remarks
<b>Submission No.</b> <b>Project No.</b> 19066 <b>By</b> AF <b>Date</b> 01 Jun 2021	
<b>JABLONSKY, AST AND PARTNERS</b> Consulting Engineers 3 Concord Gate, North York, ON M3C 4H9	

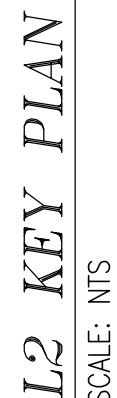

\* ELEVATIONS AND DIMENSIONS SHOWN ARE FOR VERIFICATION PURPOSES ONLY AND ARE NOT TO BE USED FOR CONSTRUCTION

\* ALL CONFIRMS/VERIFIES WILL BE ASSUMED CORRECT AND APPROVED AS IS UNLESS COMMENTED ON THE APPROVAL DRWGS

<b>LEGEND</b>					
ALT =	ALTERNATE	FF =	FAR FACE	OF =	OUTSIDE FACE
BOT =	BOTTOM	FS =	FORM SAYER	SC =	SAW CUT END
BS =	BEND INTO SLAB	GID =	GROUT IN DOWELS	STG =	STAGGER
CB =	CORNER BAR	H =	HORIZONTAL	STIR =	STIRRUPS
CJ =	CONTROL JOINT	IF =	INSIDE FACE	T =	TOP
CTS =	CUT TO SUIT SITE COND.	LL =	LOWER LAYER	THR/1R =	THREAD 1END
DOW =	DOWELS	MID =	MIDDLE	THR/2R =	THREAD 2ENDS
EE =	EACH END	MIN =	MINIMUM	UL =	UPPER LAYER
EF =	EACH FACE	NF =	NEAR FACE	u/v =	UNLESS NOTED V
ES =	EACH SIDE	OC =	ON CENTER	V =	VERTICAL
EW =	EACH WAY			TT =	TEMP. TIES

TRAIGHT BARS LABEL FORMAT	BENT BARS LABEL FORMAT	GRADES OF STEEL
<p>7 B15M X 3600</p> <p>QUANTITY      GRADE      LENGTH</p>	<p>7 B15M B1501</p> <p>QUANTITY      GRADE      SIZE      BAR MARK</p>	<p>B = GRADE 40R            E = EPOXY COATED            C = CRP            Z = GALVANIZED            S = STAINLESS            W = WELDABLE</p>

0	FOR APPROVAL	MAY/27/21	JJ
ISSUE	REMARKS	DATE	BY

**MANSTEEL**



**R E B A R**


**MANSTEEL REBAR**

105 Industrial Road, Richmond Hill,  
Ontario L4C 2Y4 Canada

Phone: 905-737-9797

Fax: 905-737-9704

Email: [info@mansteelrebar.com](mailto:info@mansteelrebar.com)

PROJECT <h1 style="margin: 0;">FORESTSIDE TOWNHOUSES</h1> <h2 style="margin: 0;">-BRAMPTON, ON</h2>	
PART OF STRUCTURE <h3 style="margin: 0;">STAIR SHEAR WALLS L2-L3 P#1&amp;3</h3>	
CUSTOMER :  ROYAL PINE HOMES	Project no. <b>2177</b>  SCALE: <b>AS SHOWN</b>  DRAWING No.  <div style="font-size: 2em; font-weight: bold; text-align: center;">R10.1</div> <div style="text-align: right; margin-top: -10px;">  </div>
DETAILED BY: <b>JU</b>  CHECKED BY:	BAR LIST No.

## NOTES

- 1, ALL STEEL TO BE GRADE 400W  
2, STRENGTH OF CONCRETE  
35MPa - INTERIOR COLUMNS & WALLS

3. CONCRETE COVER:  
VERTICALS

BAR SIZE	STANDARD LAP (mm)
10M	300
15M	440
20M	590
25M	730
30M	880
35M	1030

#### 4. COMPRESSION LAP SPLICE

TENSION LAP SPLICE (L.S) & DEVELOPMENT LENGTH (Ld)						
BAR SIZE	fc=25		fc=30		fc=35	
	L.S	L.d	L.S	L.d	L.S	L.d
10M	380	330	350	300	320	300
15M	570	490	520	400	480	370
20M	750	650	690	530	640	490
25M	1170	1010	1070	830	990	770
30M	1410	1210	1290	990	1190	920
35M	1640	1410	1500	1160	1390	1070

5, TENSION LAP SPLICE (L.S) & DEVELOPMENT LENGTH ( $L_d$ )

PROJECT  
FORESTSIDE TOWNHOUSES  
-BRAMPTON, ON

PART OF STRUCTURE  
STAIR SHEAR WALLS L2-L3 P#1&3

CUSTOMER :

ROYAL PINE HOMES

ETAILED BY:

Project no. 2177

SCALE: AS SHOWN

DRAWING No.

D 14