

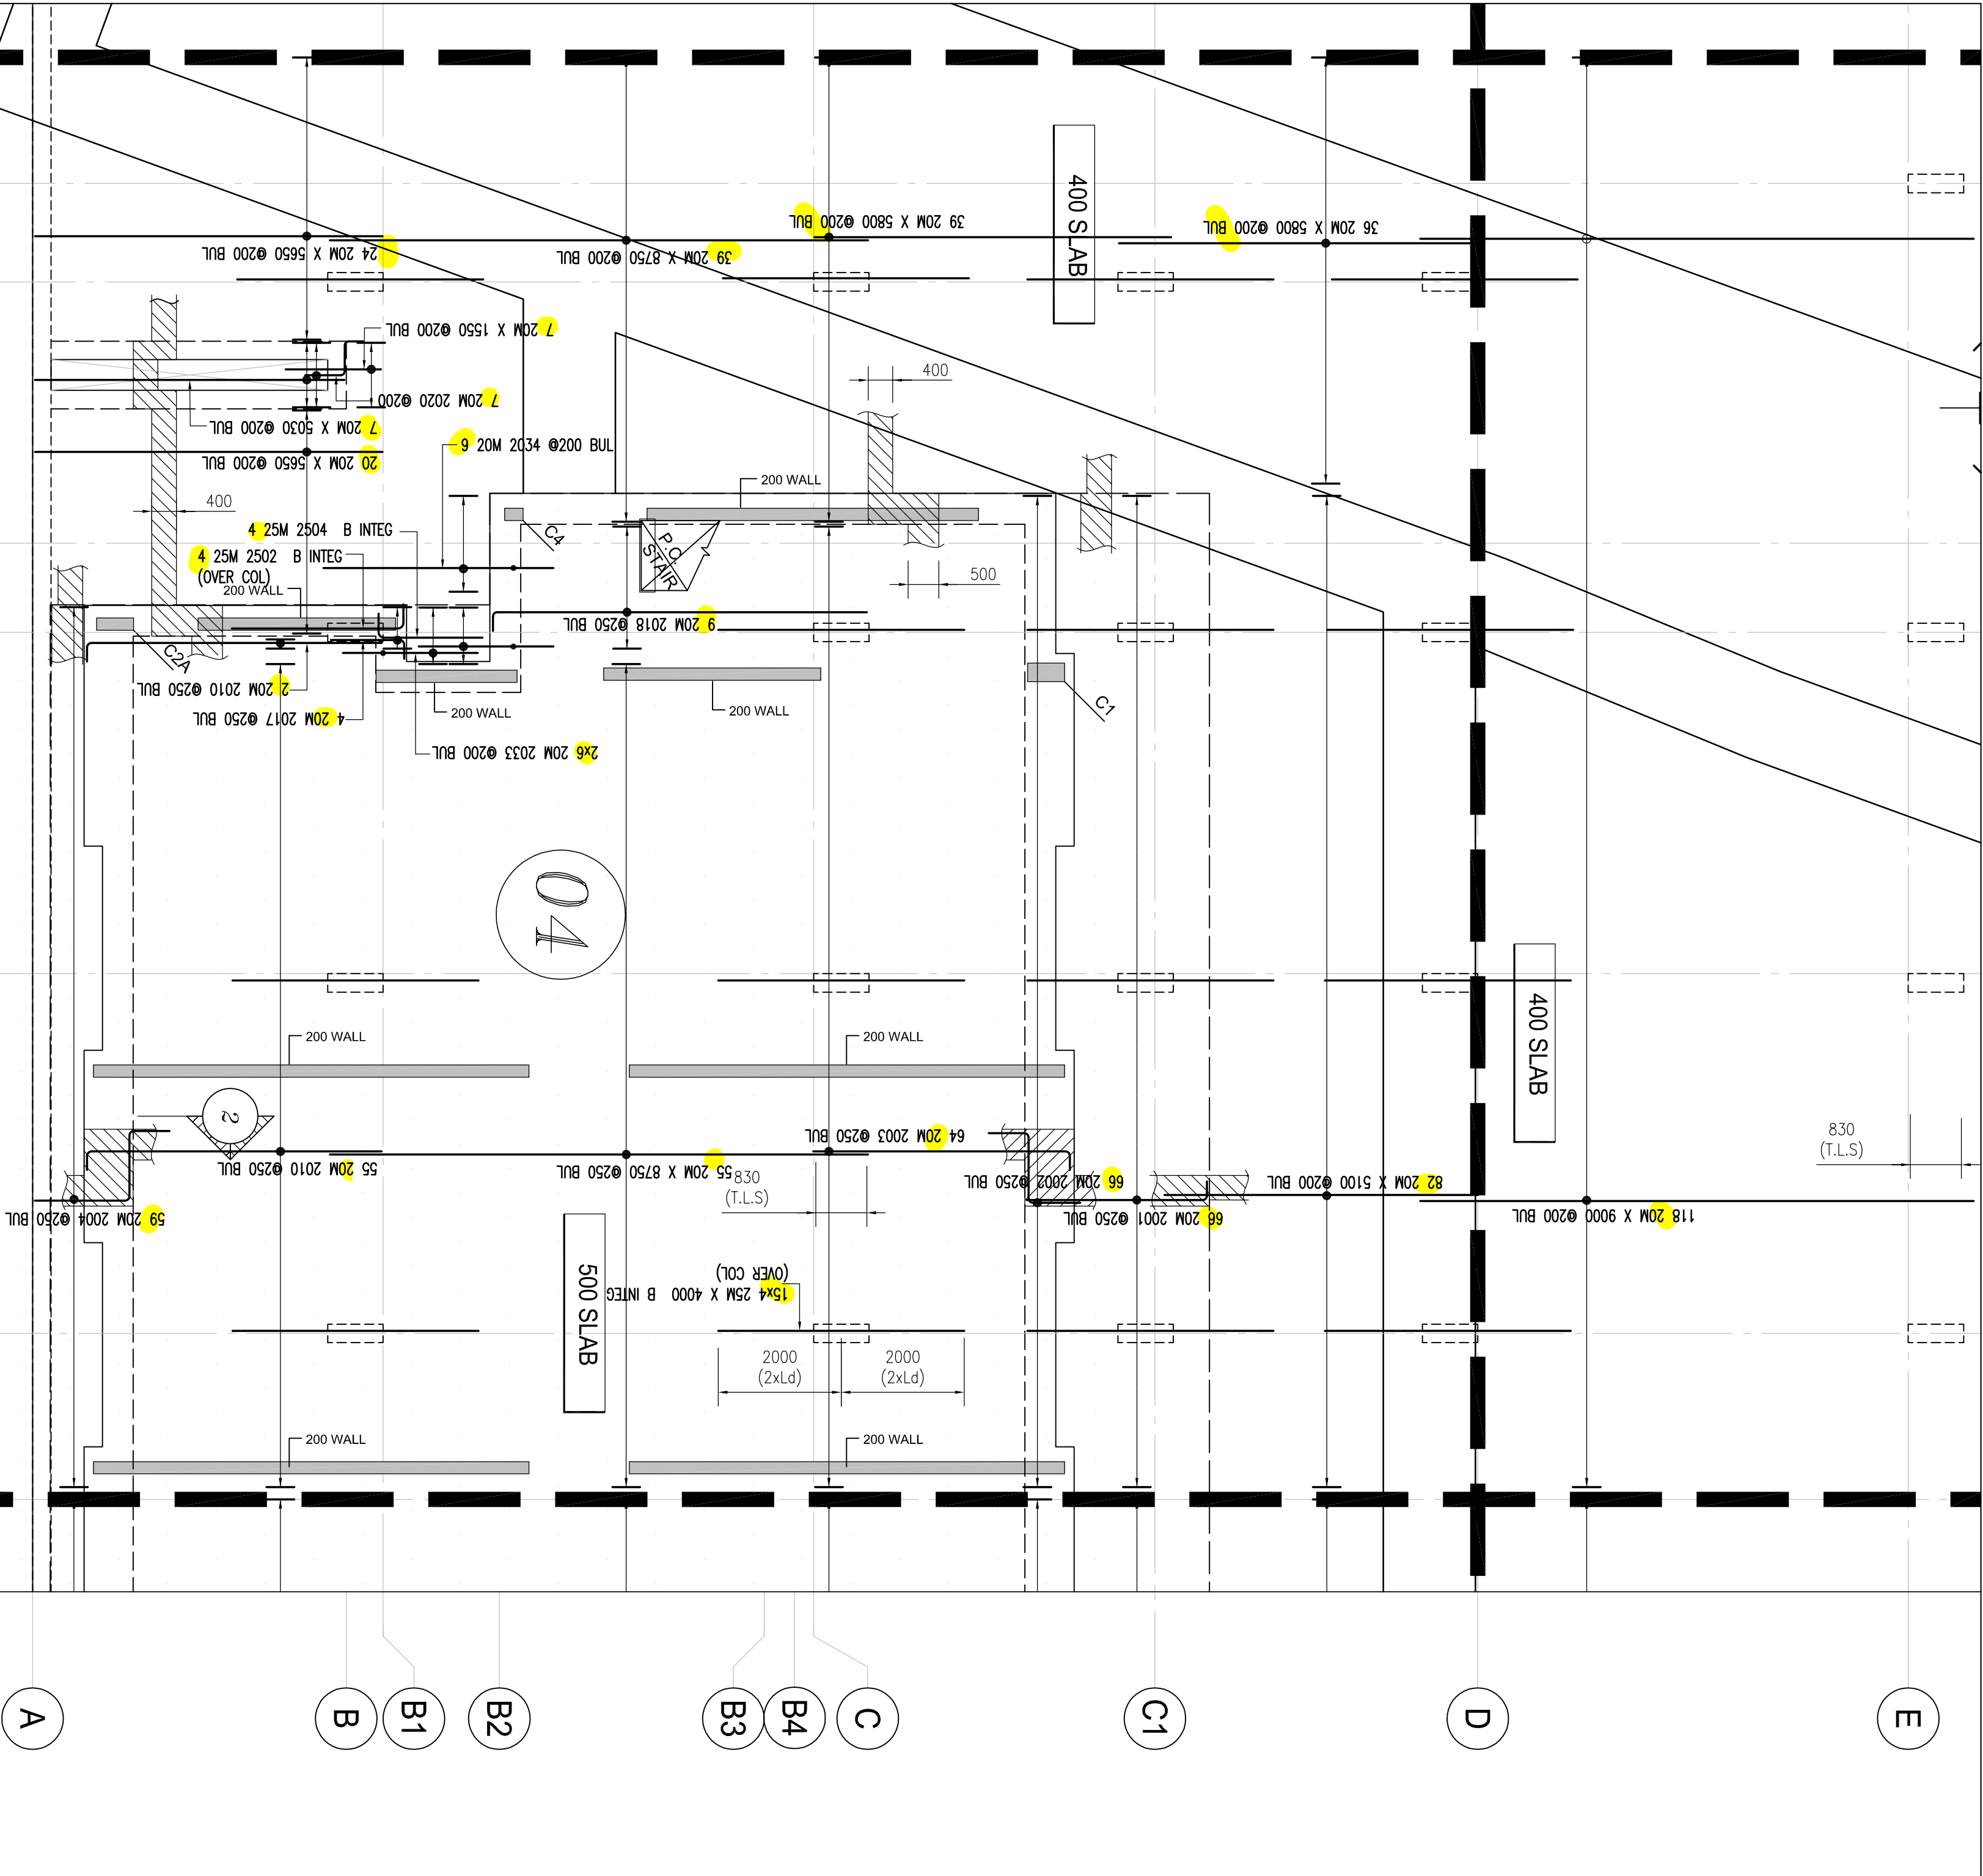


Release Code: R6.3B GF BUL P#4														BENDING DETAILS.											
Bar Mark	Qty	Standard length (m)	A	B	C	D	E	F	G	H	I	J	K	L											
4A 20M	8750	9000																							
18 20M	9000																								
82 20M	5000																								
60 25M	4000																								
44 20M	5650																								
75 20M	5800																								
7 20M	5030																								
7 20M	7550																								
200B	9 20M	6440 2	300																						
203B	12 20M	3200 20	660																						
203A	9 20M	4790 20	660																						
202Z	4 25M	3200 2	440																						
200I	66 20M	3250 2	300																						
200J	7 20M	1530 20	300																						
205A	4 25M	2200 2	440																						
200Z	66 20M	3560 20	660																						
2002	66 20M	4450 2	300																						
200I	44 20M	4450 2	300																						
200I	51 20M	5000 2	300																						
200I	4 20M	5800 2	300																						
200A	59 20M	3580 20	660																						

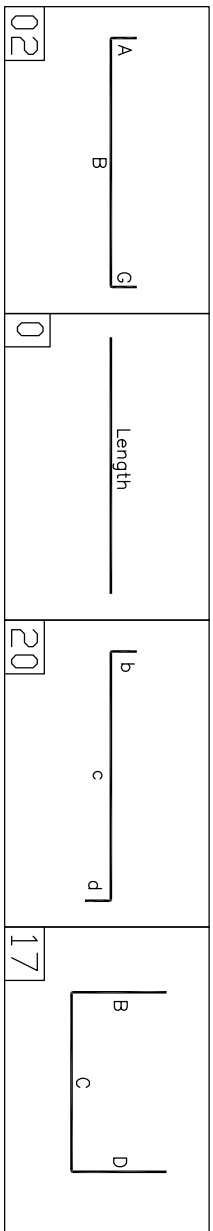

GF PLAN BUL
SCALE: 1:75 REF: S102A4B

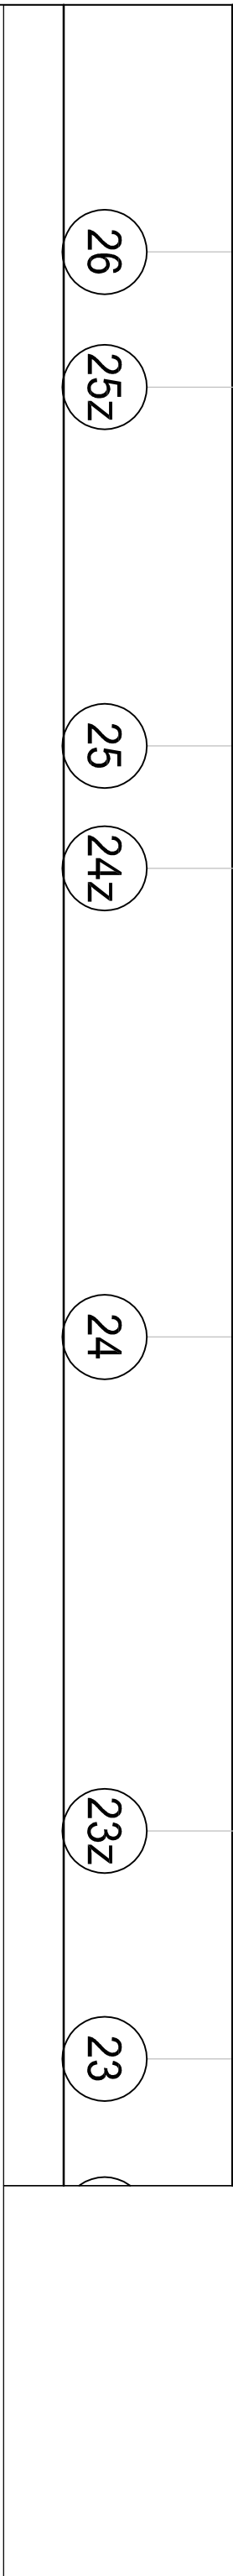

NOTES

1. ALL STEEL TO BE GRADE 400W
2. STRENGTH OF CONCRETE
35MPa – SLAB
35MPa – INTERIOR COLUMNS & WALLS
3. CONCRETE COVER:
SLAB T – 25mm
SLAB B – 25mm


4. COMPRESSION LAP SPLICE

BAR SIZE	STANDARD LAP (mm)
10M	300
15M	440
20M	590
25M	730
30M	880
35M	1030

5. TENSION LAP SPLICE (L.S) & DEVELOPMENT LENGTH (Ld)

BAR SIZE	L.S	L.S	L.S	L.S
10M	490	360	350	420
15M	740	570	670	620
20M	980	750	890	830
25M	1390	1070	1290	990
30M	1830	1410	1670	1350
35M	2130	1640	1950	1500

SECTION 2
SCALE: 1:25

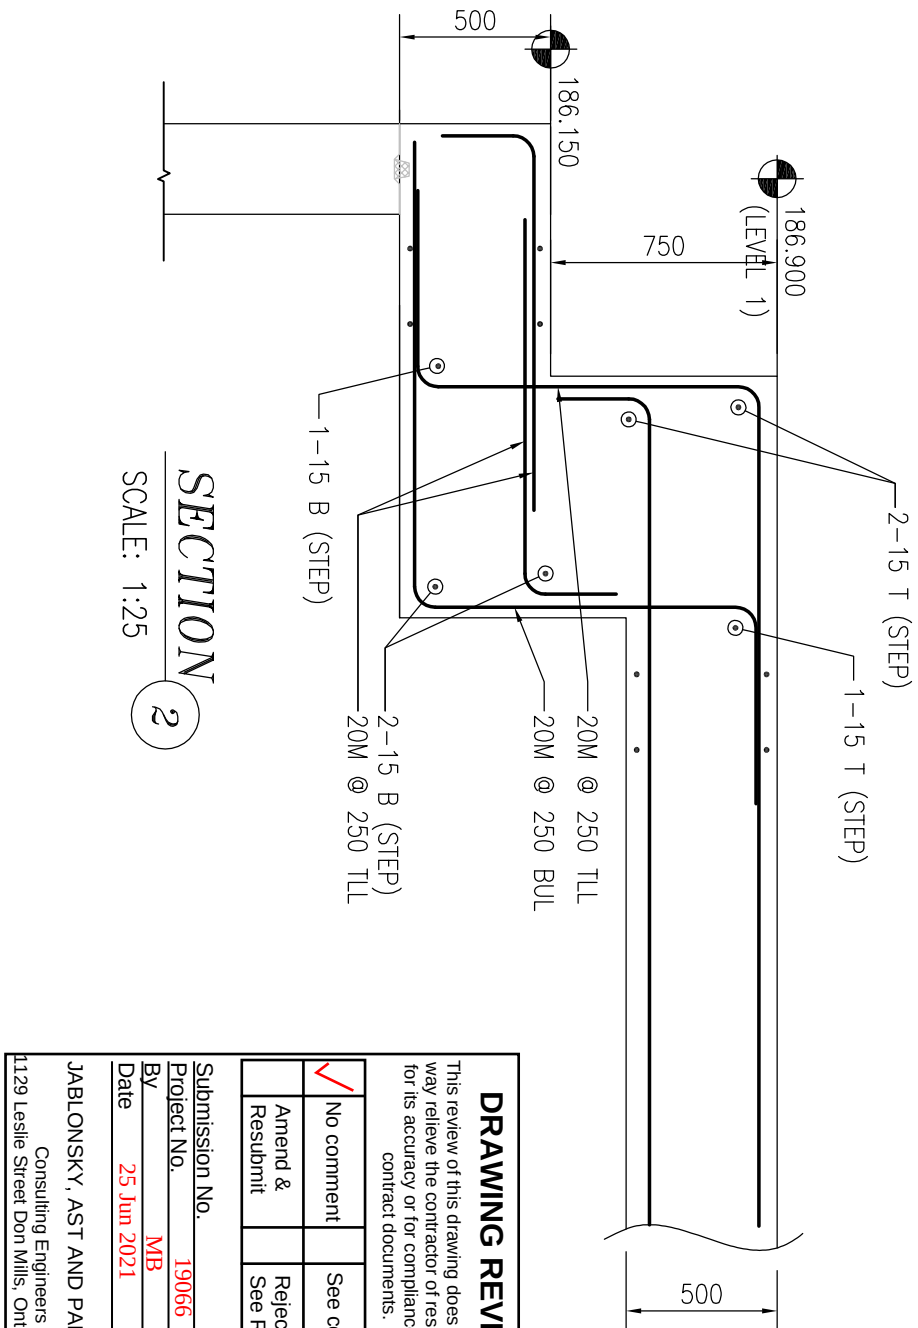

DRAWING REVIEW			
☒ No comment ☐ Amend & Resubmit ☐ See comment ☐ Rejected ☐ See Remarks	Submission No. T066 Project No. 25 Jun 2021 Date 25 Jun 2021 JABLONSKY, JAST AND PARTNERS Consulting Engineers 1139 Apple Street, 2nd Fl., Stn. MC 2K5	Approved & Resubmitted See Remarks	See comment Rejected See Remarks

- ELEVATIONS AND DIMENSIONS SHOWN ARE FOR VERIFICATION PURPOSES ONLY AND ARE NOT TO BE USED FOR CONSTRUCTION
- ALL DIMENSIONS/QUANTITIES MUST BE CHECKED FOR CONSTRUCTION AND APPROVED AS SHOWN/QUANTITIES ON THE APPROVAL SHEETS

LEGEND	SYMBOL	DESCRIPTION
ALTERNATE		
BAR		REINFORCING BAR
CONC		CONCRETE
FORM		FORMWORK
WALL		WALL
SLAB		SLAB
CEILING		CEILING
FLOOR		FLOOR
ROOF		ROOF
FOUNDATION		FOUNDATION
ANCHOR		ANCHOR
WALL		WALL
SLAB		SLAB
CEILING		CEILING
FLOOR		FLOOR
ROOF		ROOF
FOUNDATION		FOUNDATION
ANCHOR		ANCHOR
WALL		WALL
SLAB		SLAB
CEILING		CEILING
FLOOR		FLOOR
ROOF		ROOF
FOUNDATION		FOUNDATION
ANCHOR		ANCHOR
WALL		WALL
SLAB		SLAB
CEILING		CEILING
FLOOR		FLOOR
ROOF		ROOF</

