
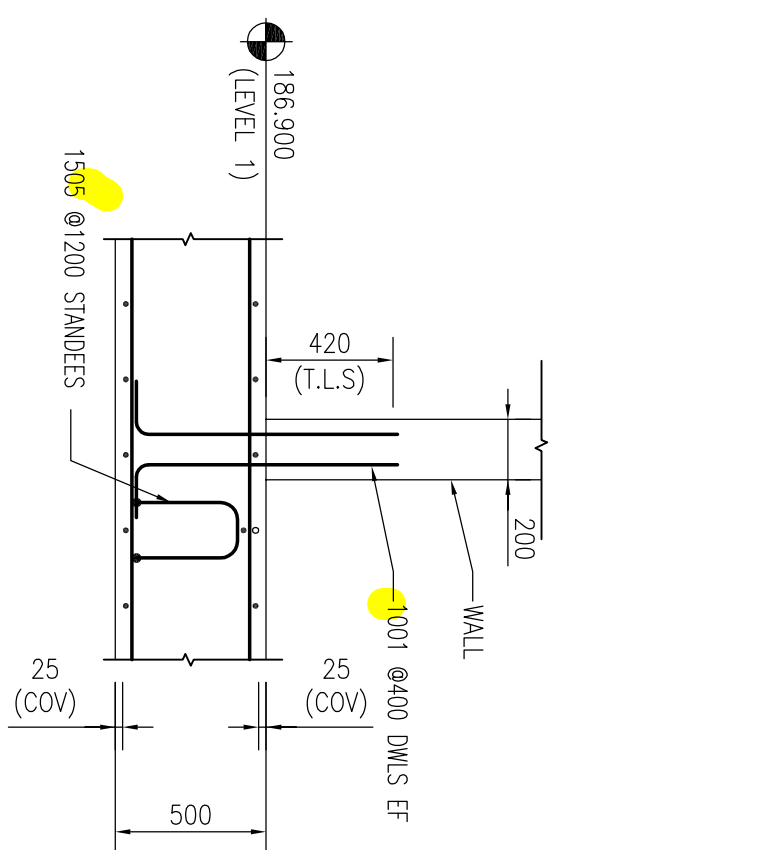
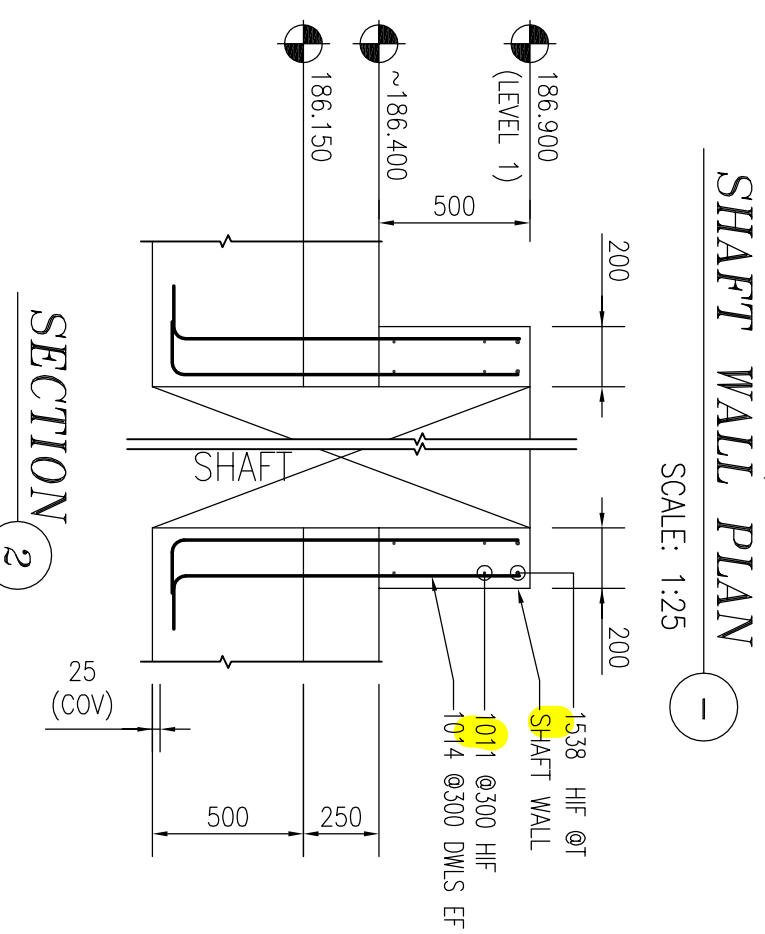
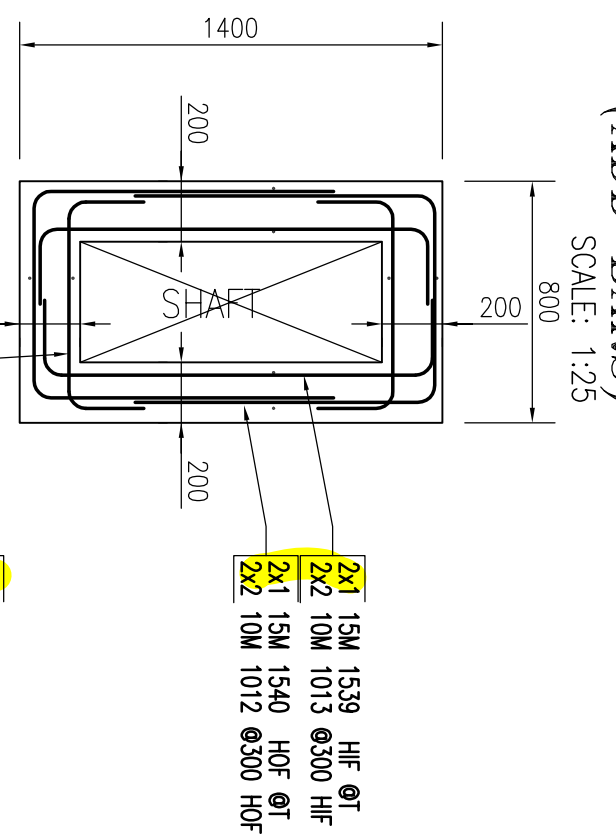
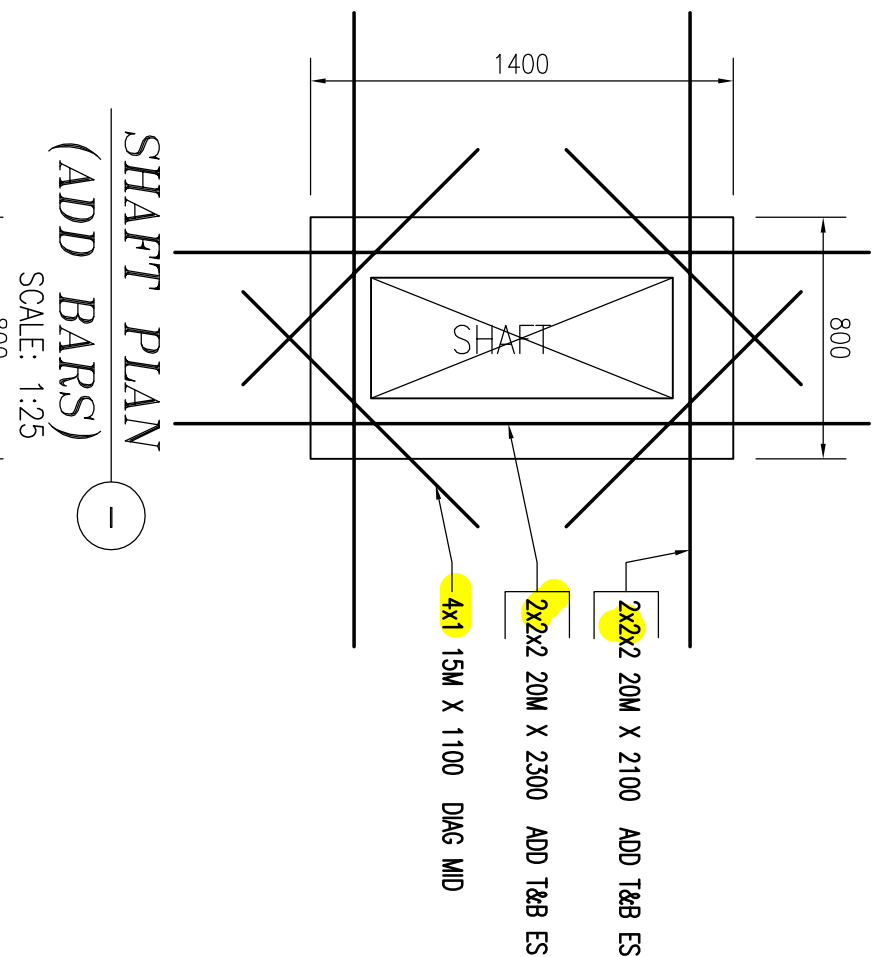


Release Code: R6.5A of BIL F#6													
Run	Day	Sec	Min	Sec	Min	Sec	Min	Sec	Min	Sec	Min	Sec	Min
1509	18	594	2300.03	300	1860	1320	280						
1510	18	594	2301.2	260	1840								
1511	18	594	2302.4	260	1840								
1512	18	594	2303.6	260	1840								
1559	18	594	2360.0	260	1840								

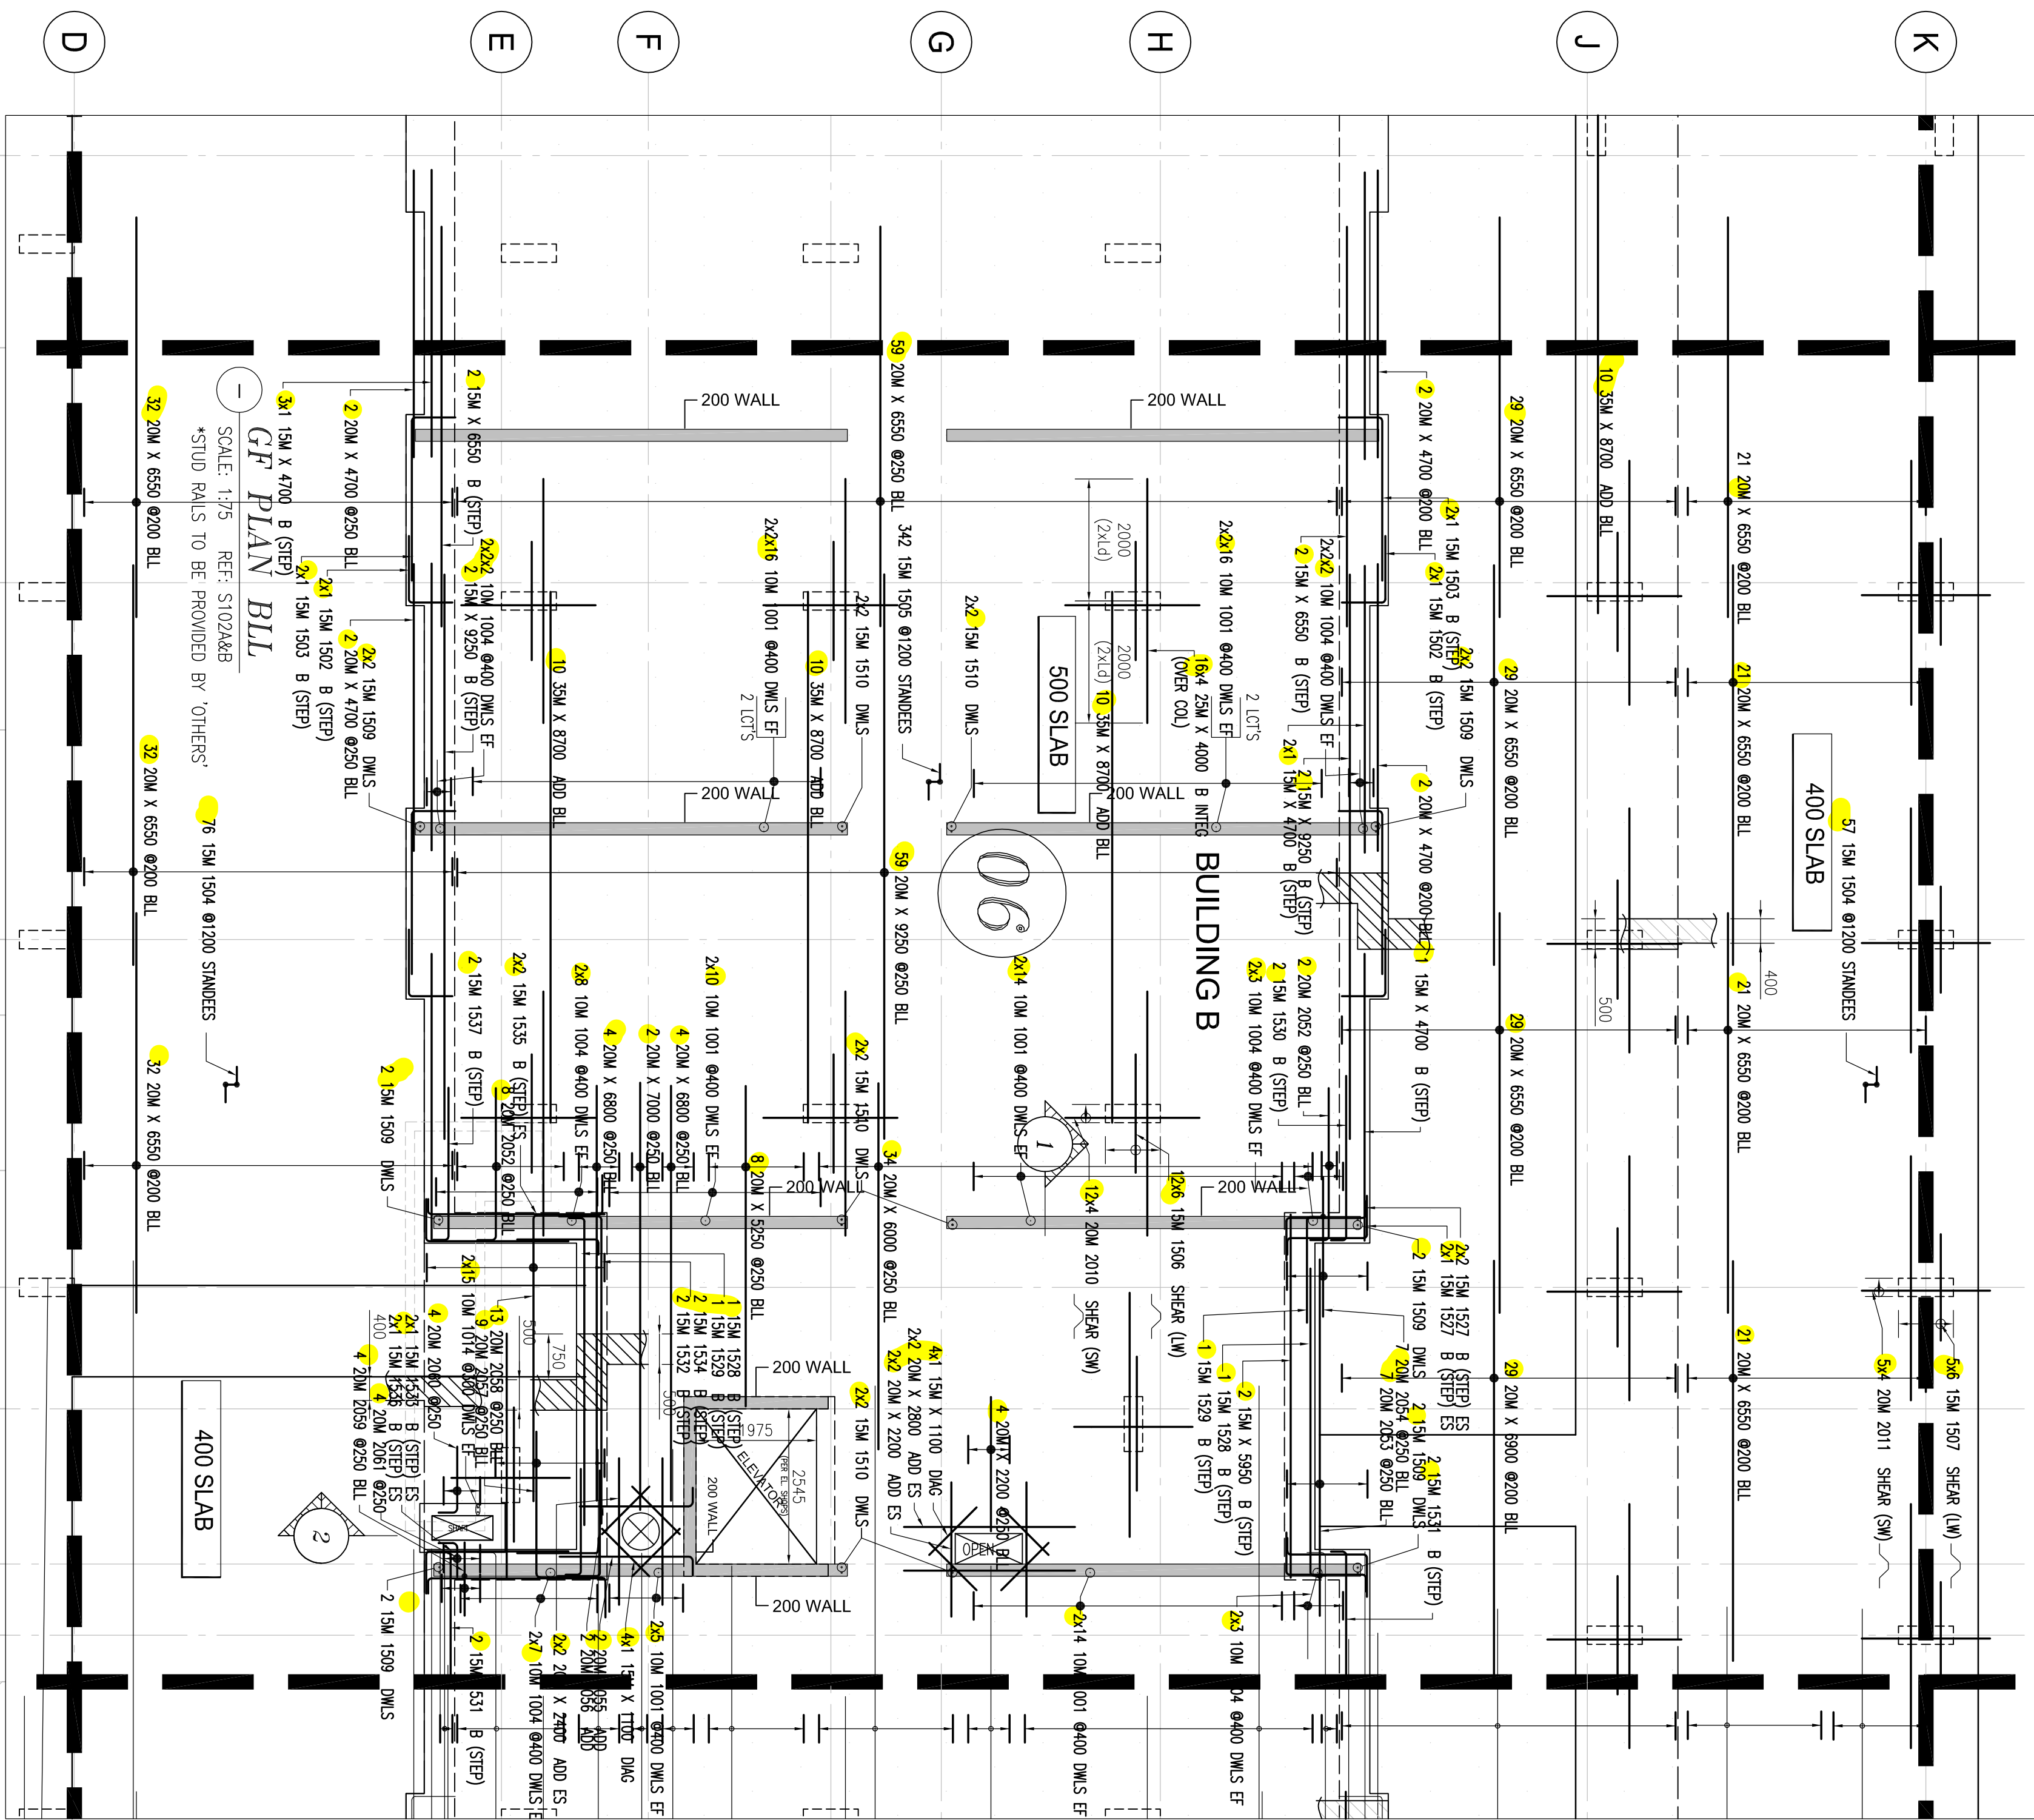

DRAWING REVIEW		
This review of this drawing does not in any way relieve the contractor of responsibility for the accuracy or for compliance with the contract documents.		
☒	No comment	See comment
☐	Amend & Resubmit	Reflected See Remarks
Submission No. 19066 Project No. N/A By MJB Date 04 August 2021		
JABLONSKY, AST AND PARTNERS Consulting Engineers 294 Leslie Street Don Mills, Ont. M3C 2V5		

Consulting Engineers
1129 Leslie Street Don Mills, Ont. M3C 2K5

[illegible][illegible]

