


DRAWING REVIEW	
<p>This review of this drawing does not in any way relieve the contractor of responsibility for its accuracy or for compliance with the contract documents.</p>	
No comment	<input checked="" type="checkbox"/> See comment
Amend & Resubmit	<input type="checkbox"/> Rejected <input type="checkbox"/> See Remarks
Submission No. <u>19066</u> Project No. <u>MB</u> By <u>15 Oct 2021</u> Date	


JABLONSKY, AST AND PARTNERS
Consulting Engineers
1129 Leslie Street Don Mills, Ont. M3C 2K5

NOTES		4. COMPRESSION LAP SPlice		5. TENSION LAP SPlice (L _S) & DEVELOPMENT LENGTH (L _d)	
1. ALL STEEL TO BE GRADE 400W		BAR SIZE		BAR SIZE	
2. STRENGTH OF CONCRETE		STANDARD LAP (mm)		L _S (mm) & L _d (mm) FOR F _{yk} =35	
35MPa – INTERIOR COLUMNS & WALLS		10M	300	L _S	L _d
		15M	440	18d	35d
		20M	590	24d	42d
		25M	730	30d	52d
		30M	880	36d	62d
		35M	1030	42d	70d
3. CONCRETE COVER:					
VERTICALS	-- 25mm				

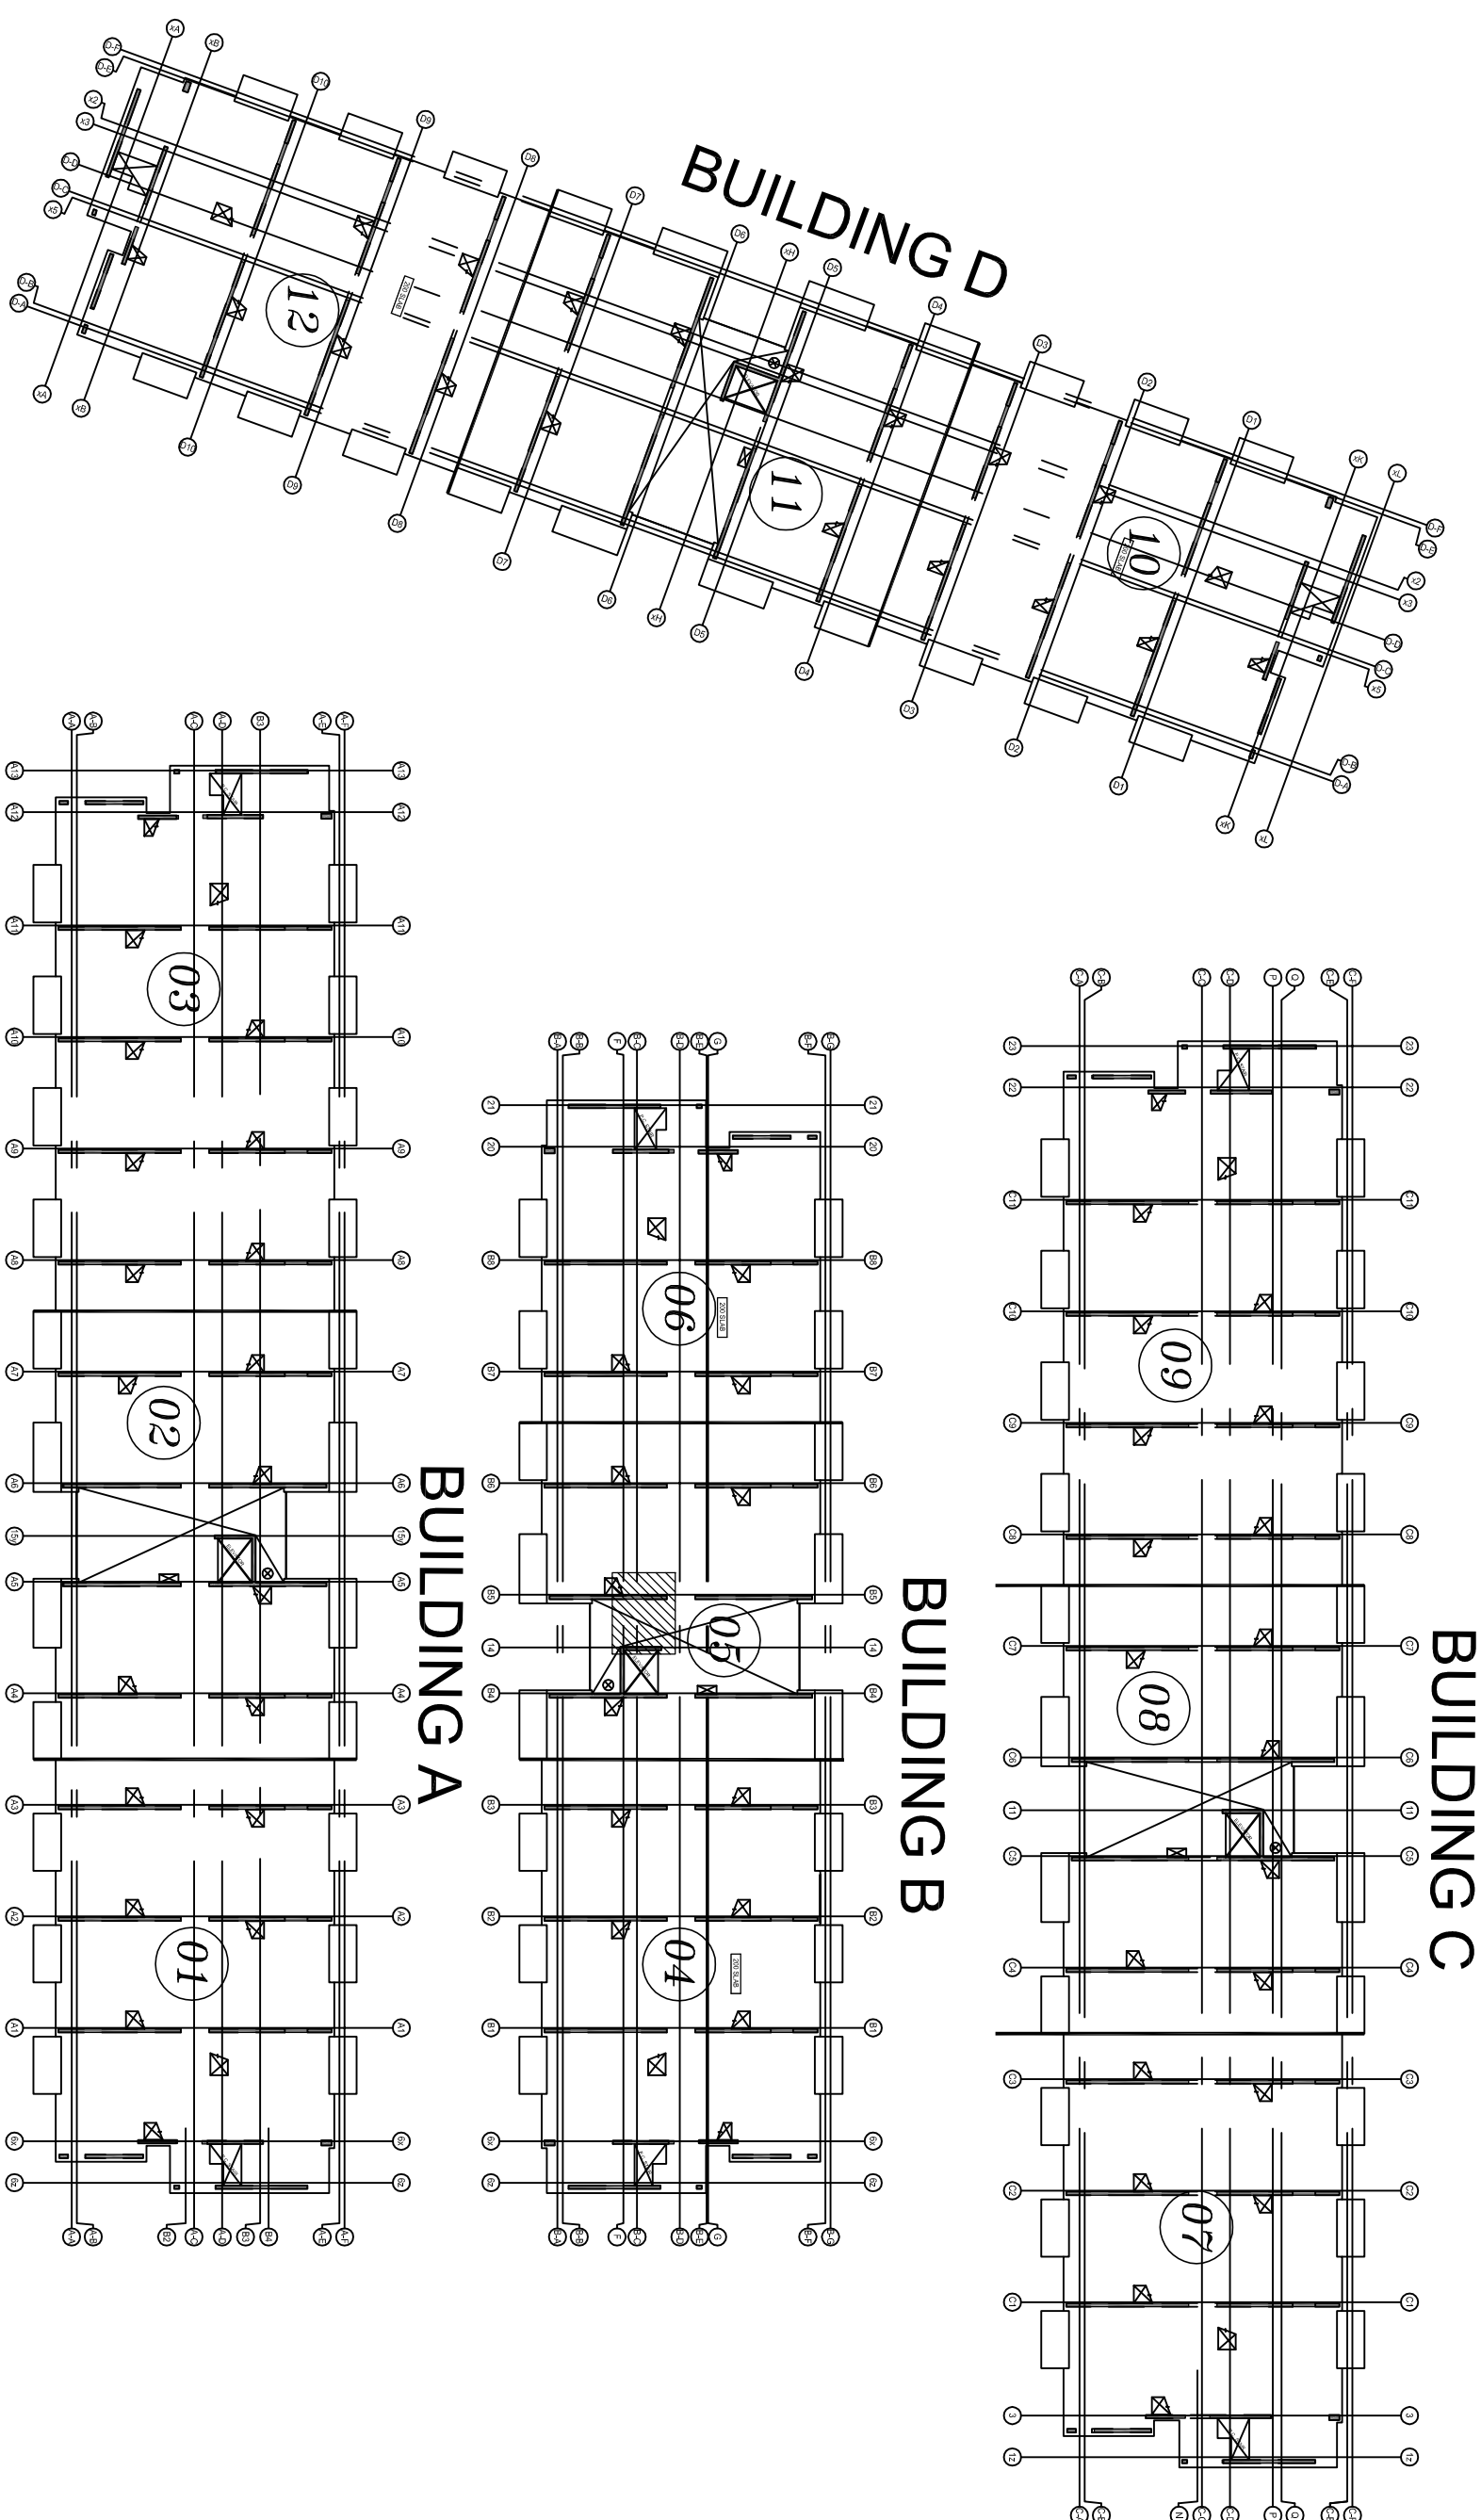

STANDARD LABEL FORMAT		BEST LABEL FORMAT	
7 B15M X 3660 DATE ITEM QUANTITY		7 B15M X 15101 DATE ITEM QTY QUANTITY	
CHANGES TO BE MADE ALL COMPANIES APPEARS WILL BE ASSUMED CORRECT AND APPROVED AS IS UNLESS COMMENTED ON THE APPROVAL DIMENS		CHANGES TO BE MADE ALL COMPANIES APPEARS WILL BE ASSUMED CORRECT AND APPROVED AS IS UNLESS COMMENTED ON THE APPROVAL DIMENS	


[illegible]

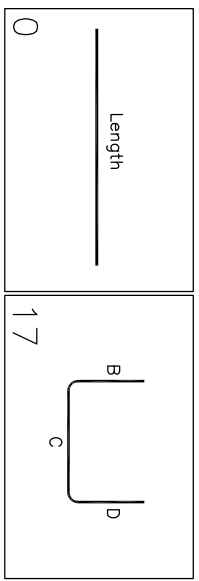[illegible]

This review of this drawing does not in any way relieve the contractor of responsibility for its accuracy or for compliance with the contract documents.

✓	No comment	See comment
	Amend & Resubmit	Rejected See Remarks






SCALE: 1:25

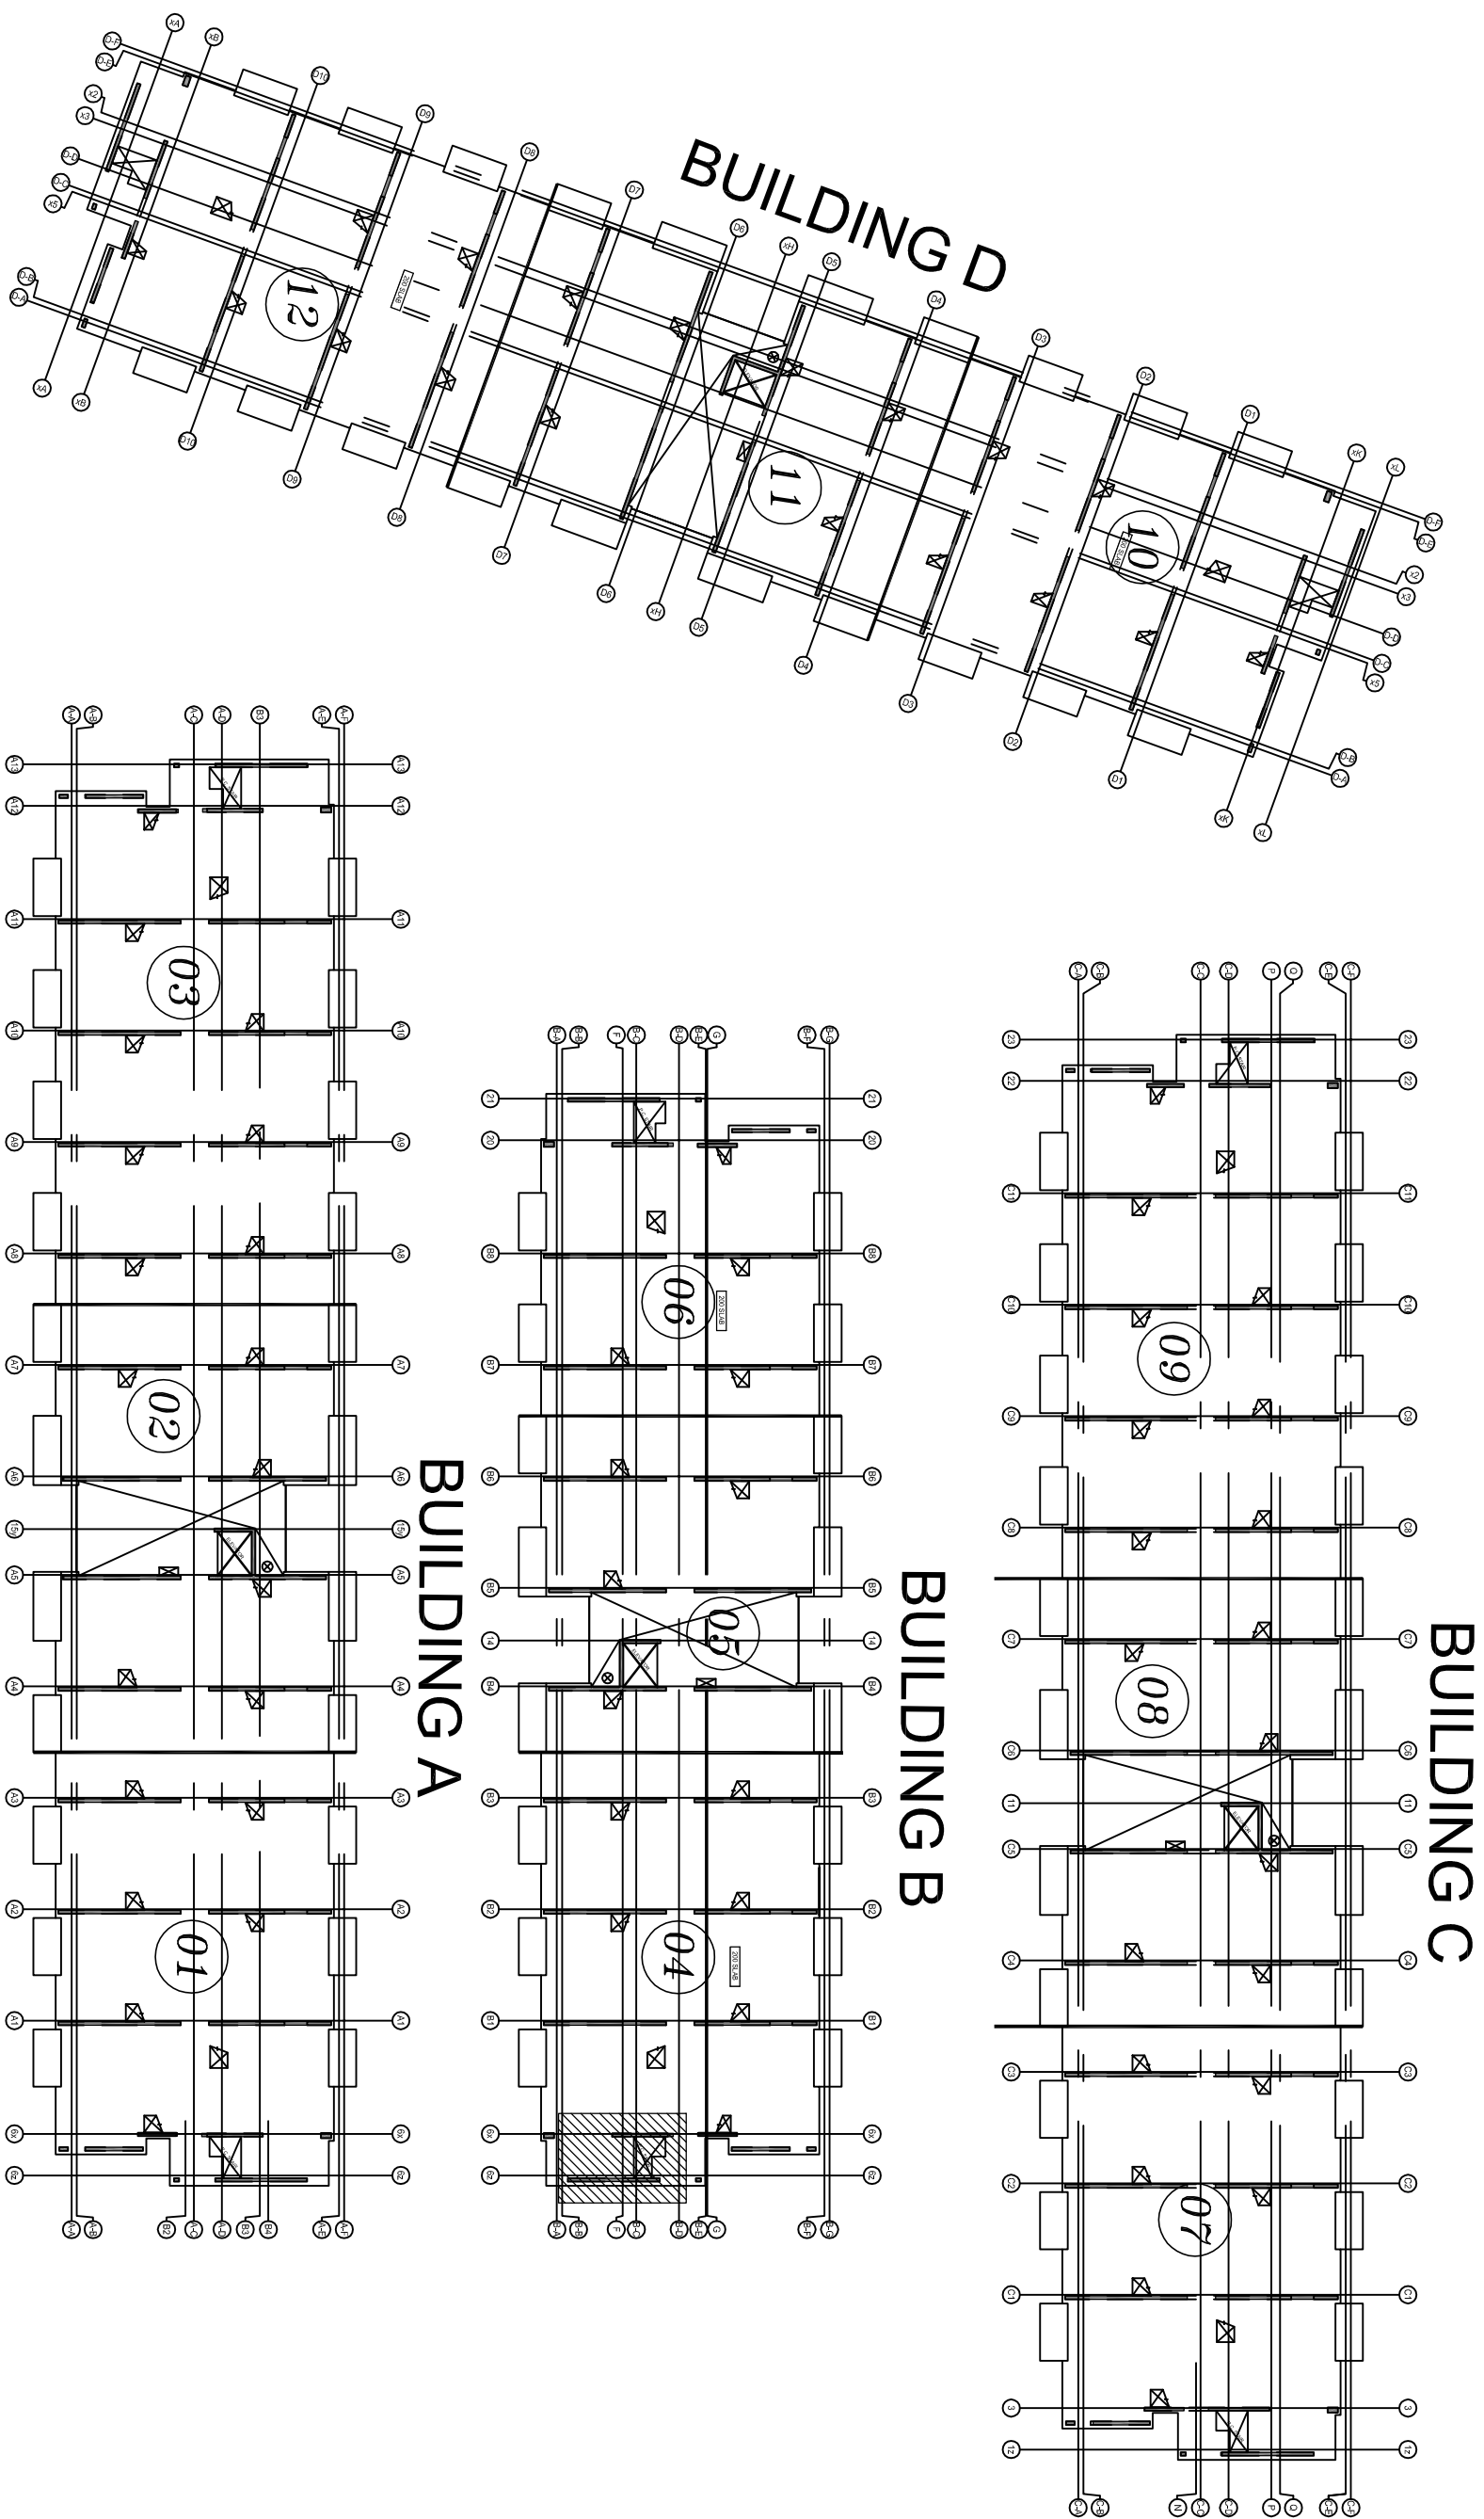

BAR SIZE	STANDARD LAP (mm)
10M	300
15M	440
20M	590
25M	730
30M	880
35M	1030

TENSION APPLIED (FOR WALL OR BAR SIZE)	TENSION APPLIED (L) & DEVELOPMENT LENGTH (L _d) (FOR WALL OR BAR SIZE)					
	f _c = 25		f _c = 30		f _c = 35	
	L	L _d	L	L _d	L	L _d
10M	450	380	450	350	420	320
15M	740	570	670	520	620	480
20M	980	750	880	690	830	640
25M	1530	1170	1390	1070	1290	990
30M	1830	1410	1670	1280	1550	1190
35M	2130	1640	1950	1500	1800	1390


<p> <small>* ELEVATION AND DIMENSIONS SHOWN ARE FOR VERIFICATION PURPOSES ONLY AND ARE NOT TO BE USED FOR CONSTRUCTION PURPOSES.</small> <small>AS IS UNLESS COMMENTED ON THE APPROVAL DRAWING</small> </p>		<p> <small>LEGEND</small> 1.00 = ALUMINUM 2.00 = BRASS 3.00 = BRASS 4.00 = BRASS 5.00 = BRASS 6.00 = BRASS 7.00 = BRASS 8.00 = BRASS 9.00 = BRASS 10.00 = BRASS 11.00 = BRASS 12.00 = BRASS 13.00 = BRASS 14.00 = BRASS 15.00 = BRASS 16.00 = BRASS 17.00 = BRASS 18.00 = BRASS 19.00 = BRASS 20.00 = BRASS 21.00 = BRASS 22.00 = BRASS 23.00 = BRASS 24.00 = BRASS 25.00 = BRASS 26.00 = BRASS 27.00 = BRASS 28.00 = BRASS 29.00 = BRASS 30.00 = BRASS 31.00 = BRASS 32.00 = BRASS 33.00 = BRASS 34.00 = BRASS 35.00 = BRASS 36.00 = BRASS 37.00 = BRASS 38.00 = BRASS 39.00 = BRASS 40.00 = BRASS 41.00 = BRASS 42.00 = BRASS 43.00 = BRASS 44.00 = BRASS 45.00 = BRASS 46.00 = BRASS 47.00 = BRASS 48.00 = BRASS 49.00 = BRASS 50.00 = BRASS 51.00 = BRASS 52.00 = BRASS 53.00 = BRASS 54.00 = BRASS 55.00 = BRASS 56.00 = BRASS 57.00 = BRASS 58.00 = BRASS 59.00 = BRASS 60.00 = BRASS 61.00 = BRASS 62.00 = BRASS 63.00 = BRASS 64.00 = BRASS 65.00 = BRASS 66.00 = BRASS 67.00 --	--	---	--

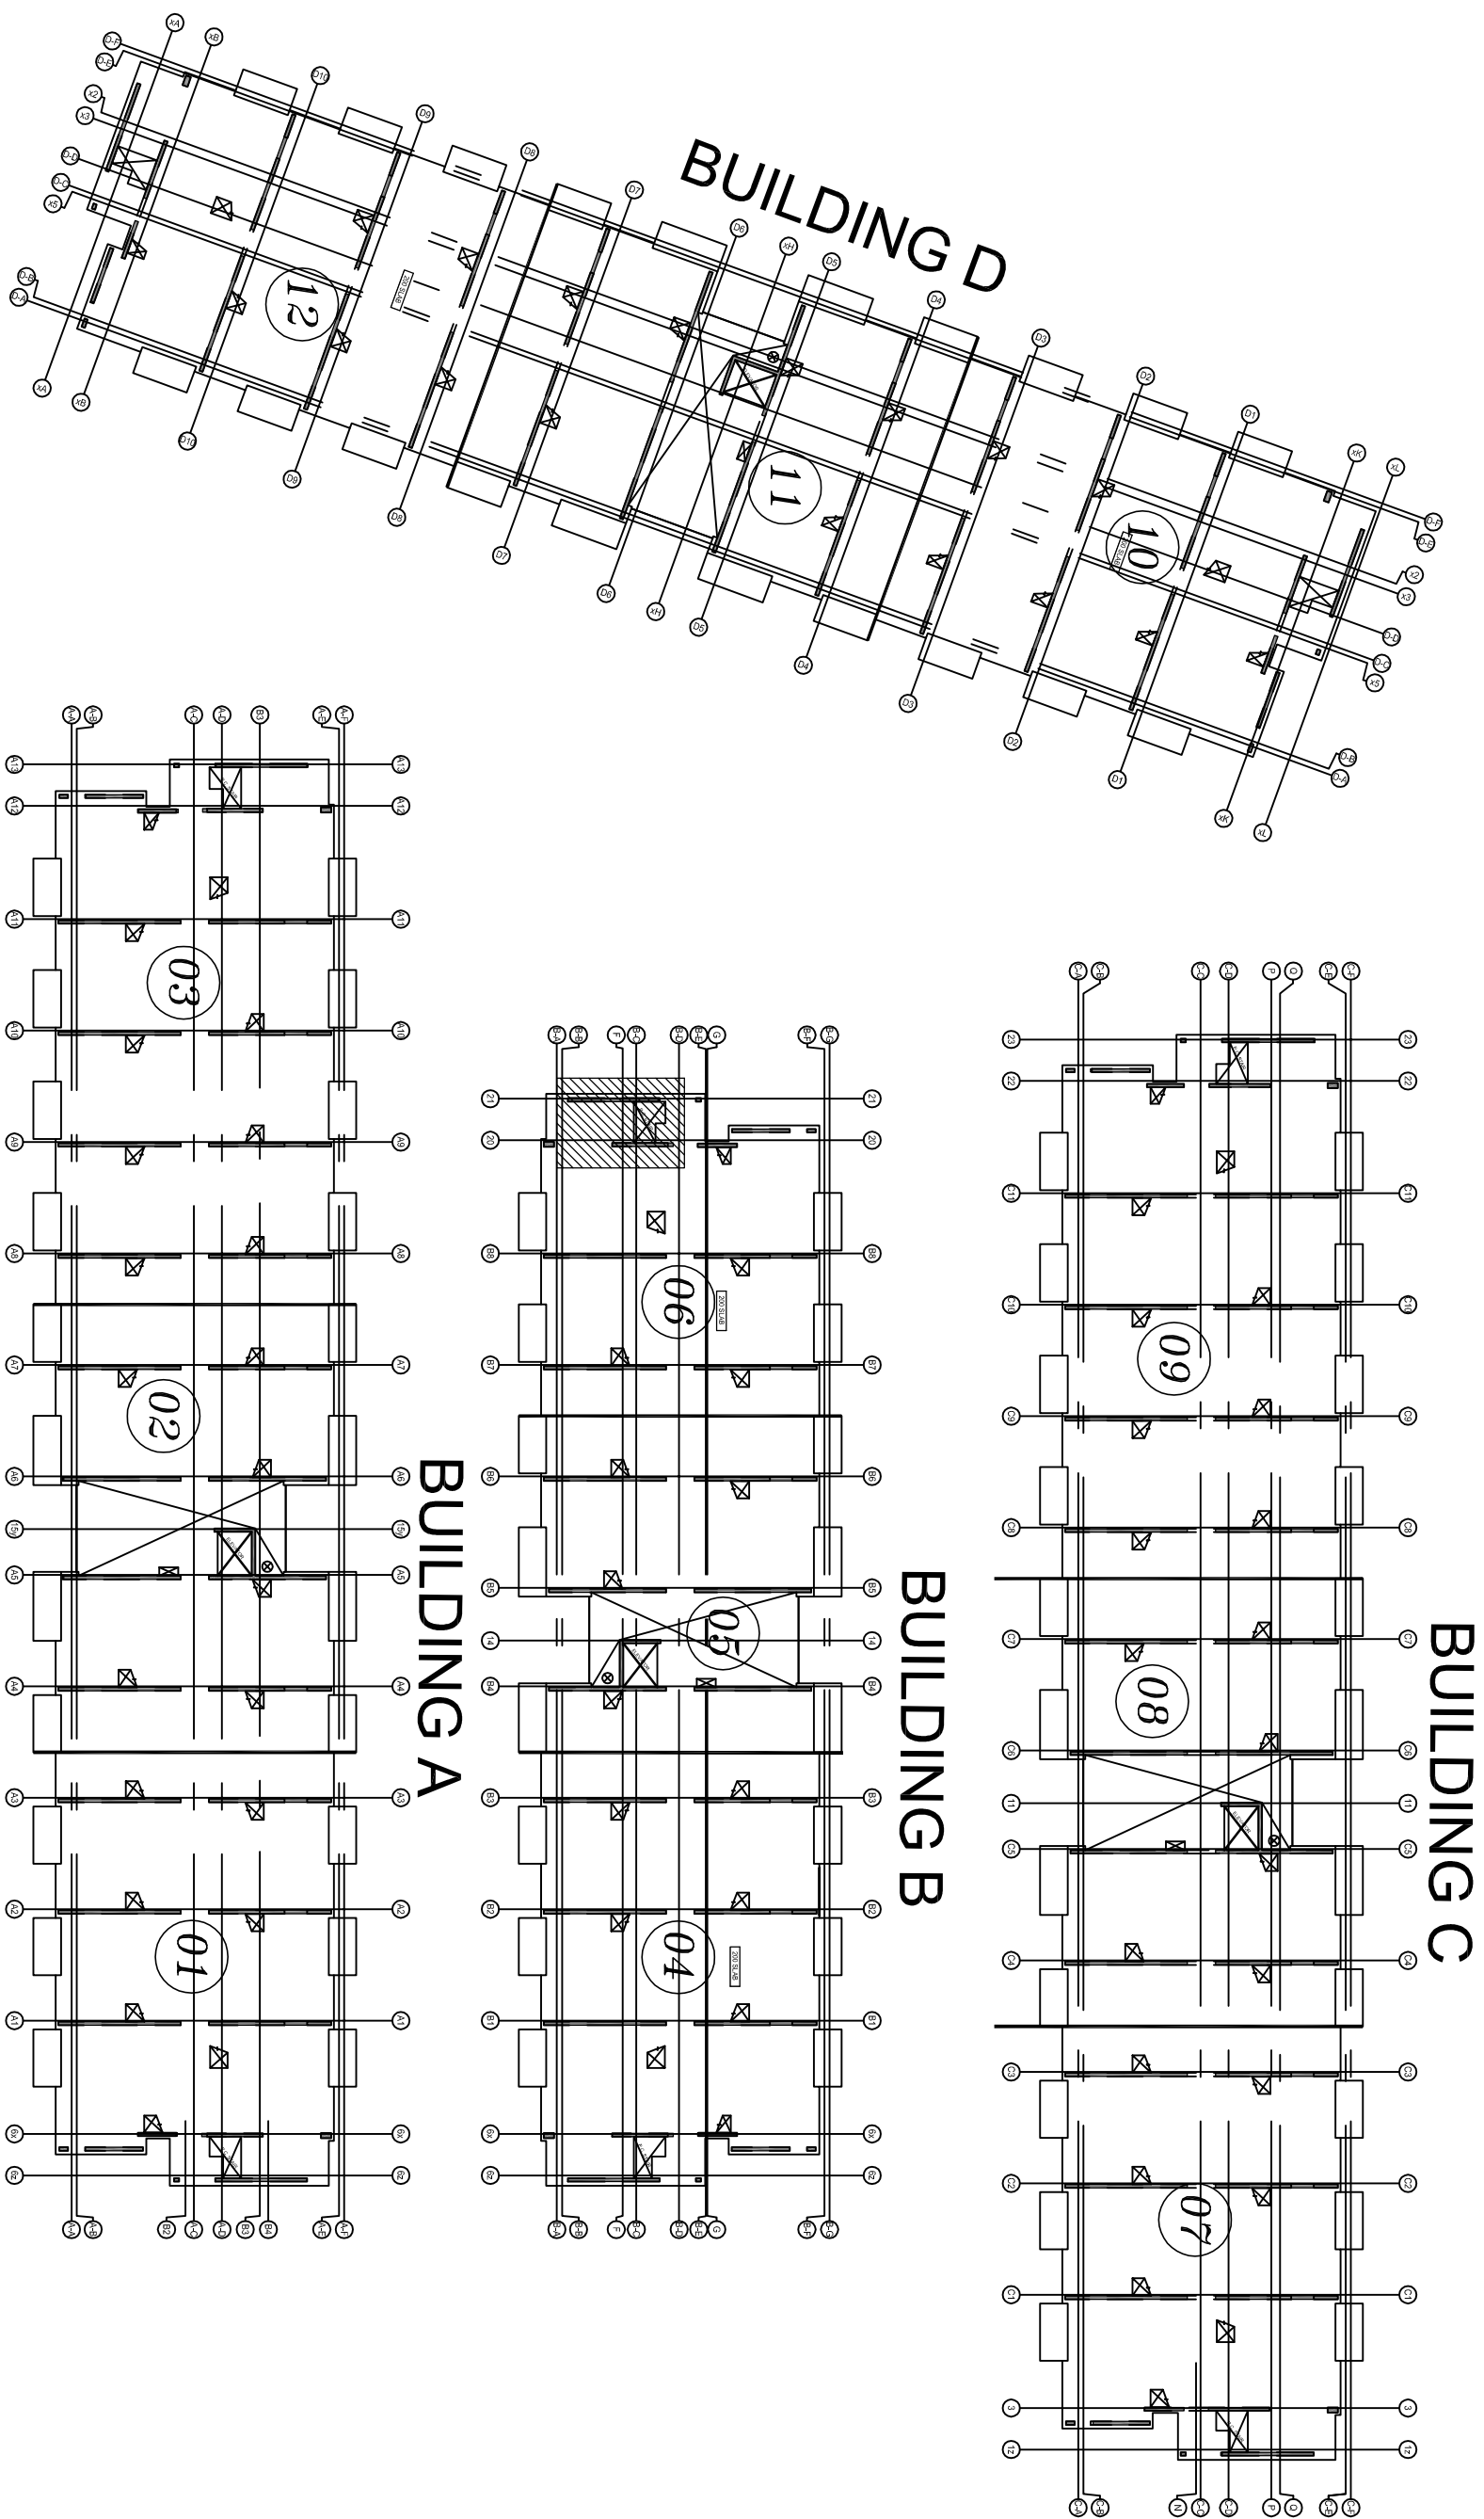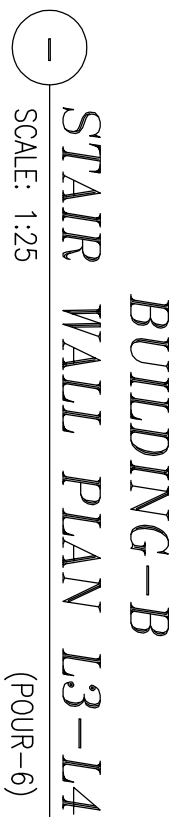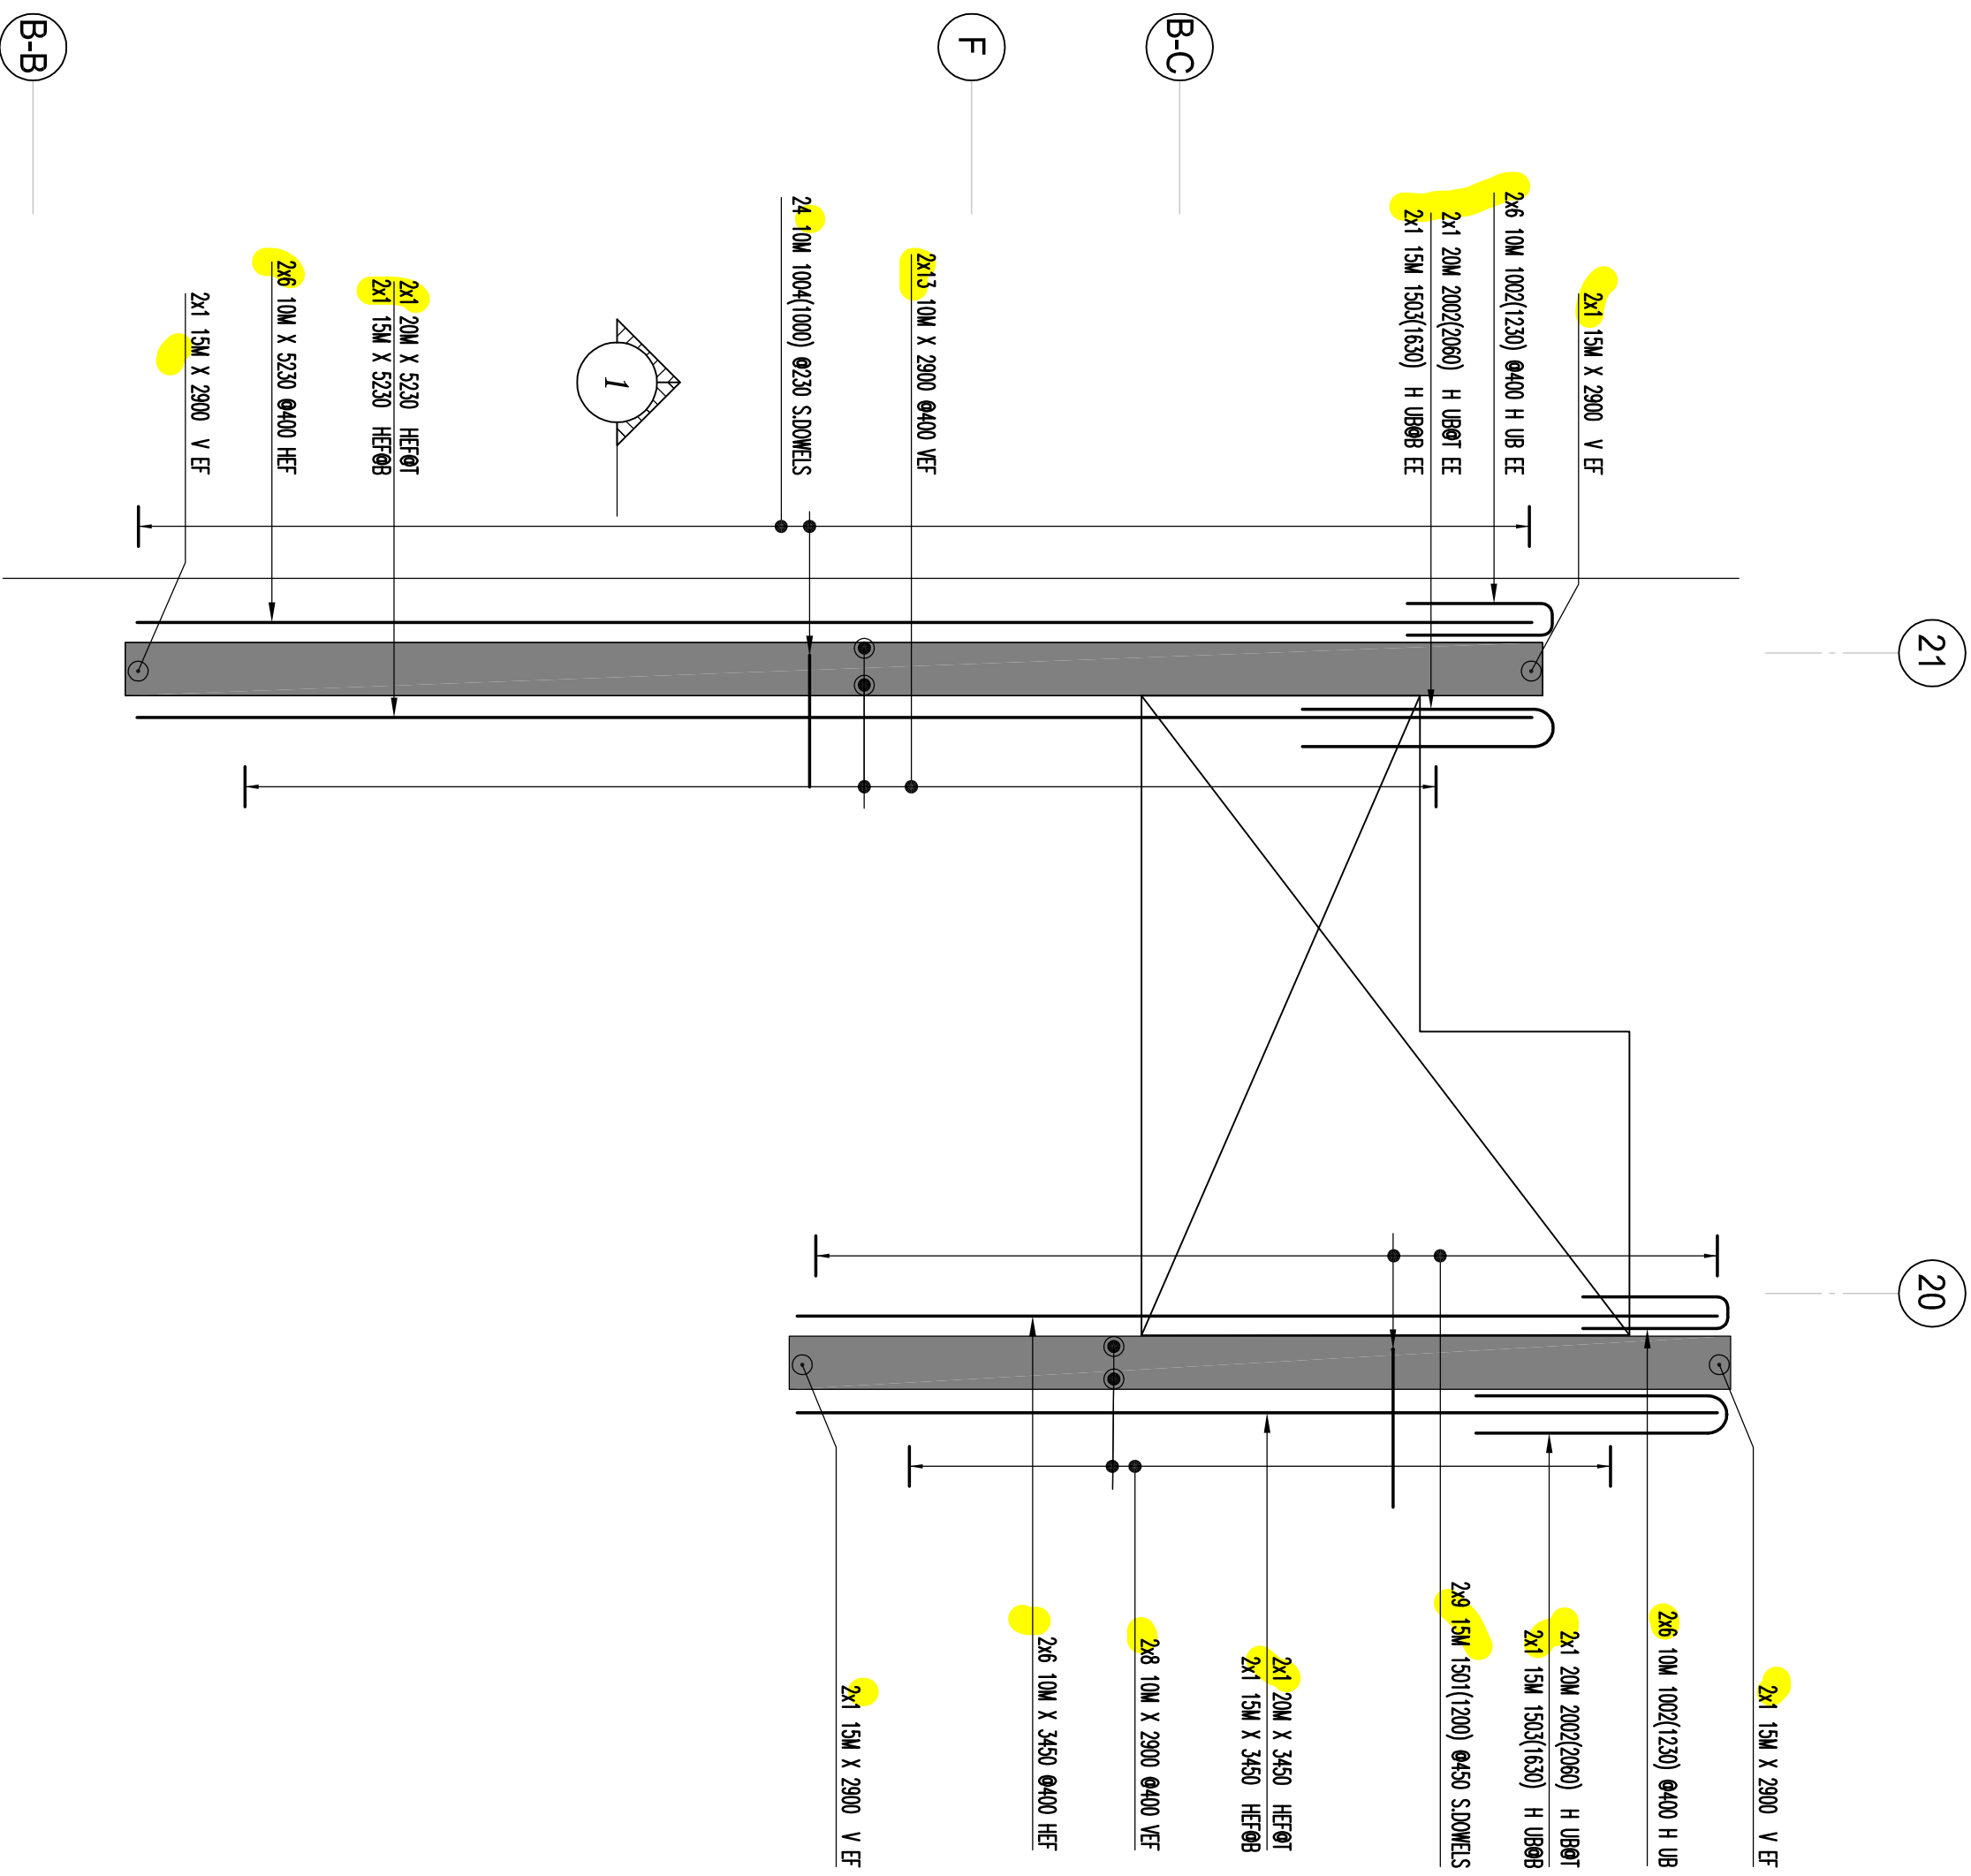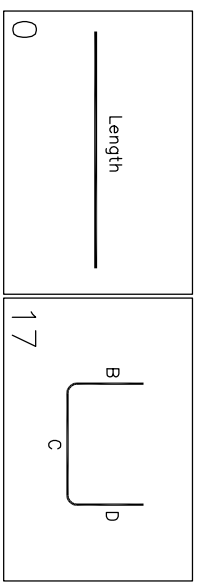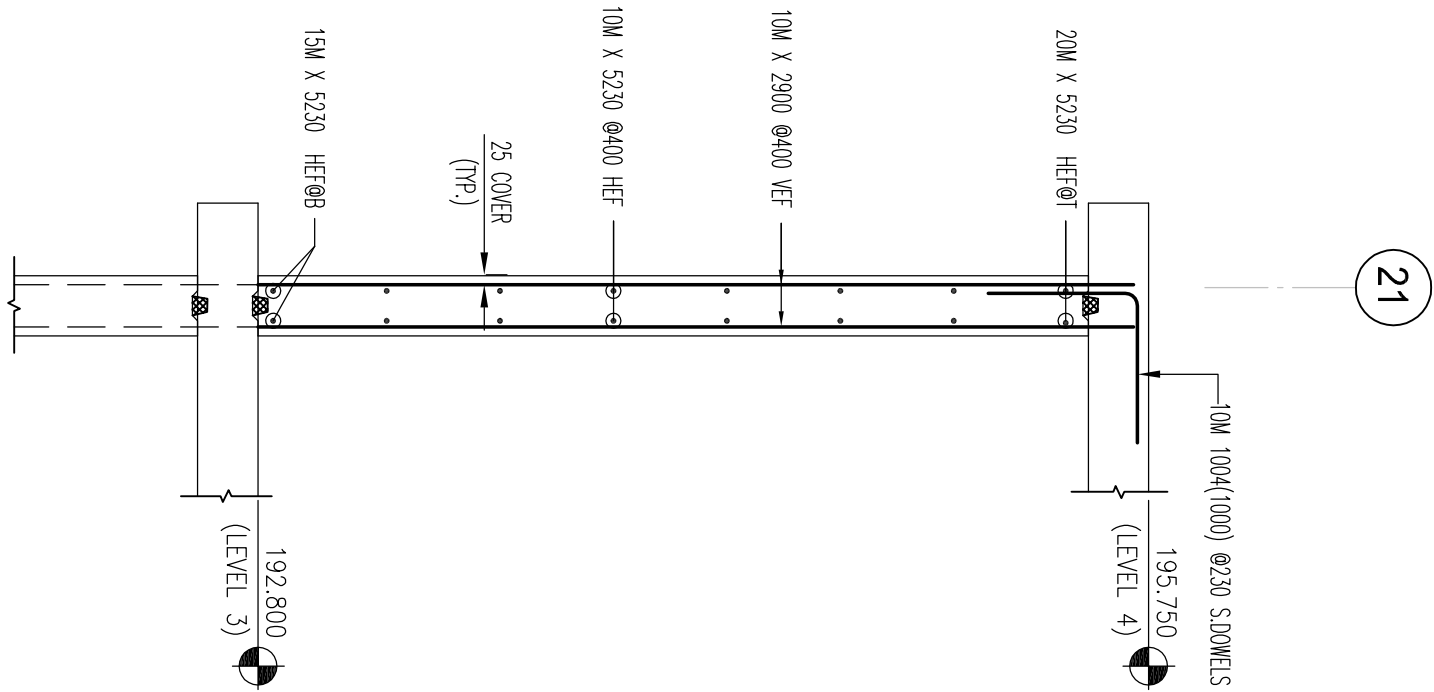[illegible]


BAR SIZE	STANDARD LAP (mm)
10M	300
15M	440
20M	590
25M	730
30M	880
35M	1030

BAR SIZE	TENSILE STRENGTH (LBS) & DEVELOPMENT (FOR WALL OR PIPE Ld IN CAP OR FIT)						LENGTH (Ld)	
	f _c =25		f _c =30		f _c =35		Ld	Ld
	Ld	Ld	Ld	Ld	Ld	Ld		
10M	490	380	450	350	420	320		
11M	540	420	510	400	470	370		
12M	590	470	560	450	520	480		
14M	780	570	670	620	620	620		
20M	940	750	890	860	830	640		
25M	1530	1170	1390	1070	1250	990		
30M	1830	1410	1670	1290	1550	1190		
35M	2130	1640	1950	1500	1800	1390		

[illegible]

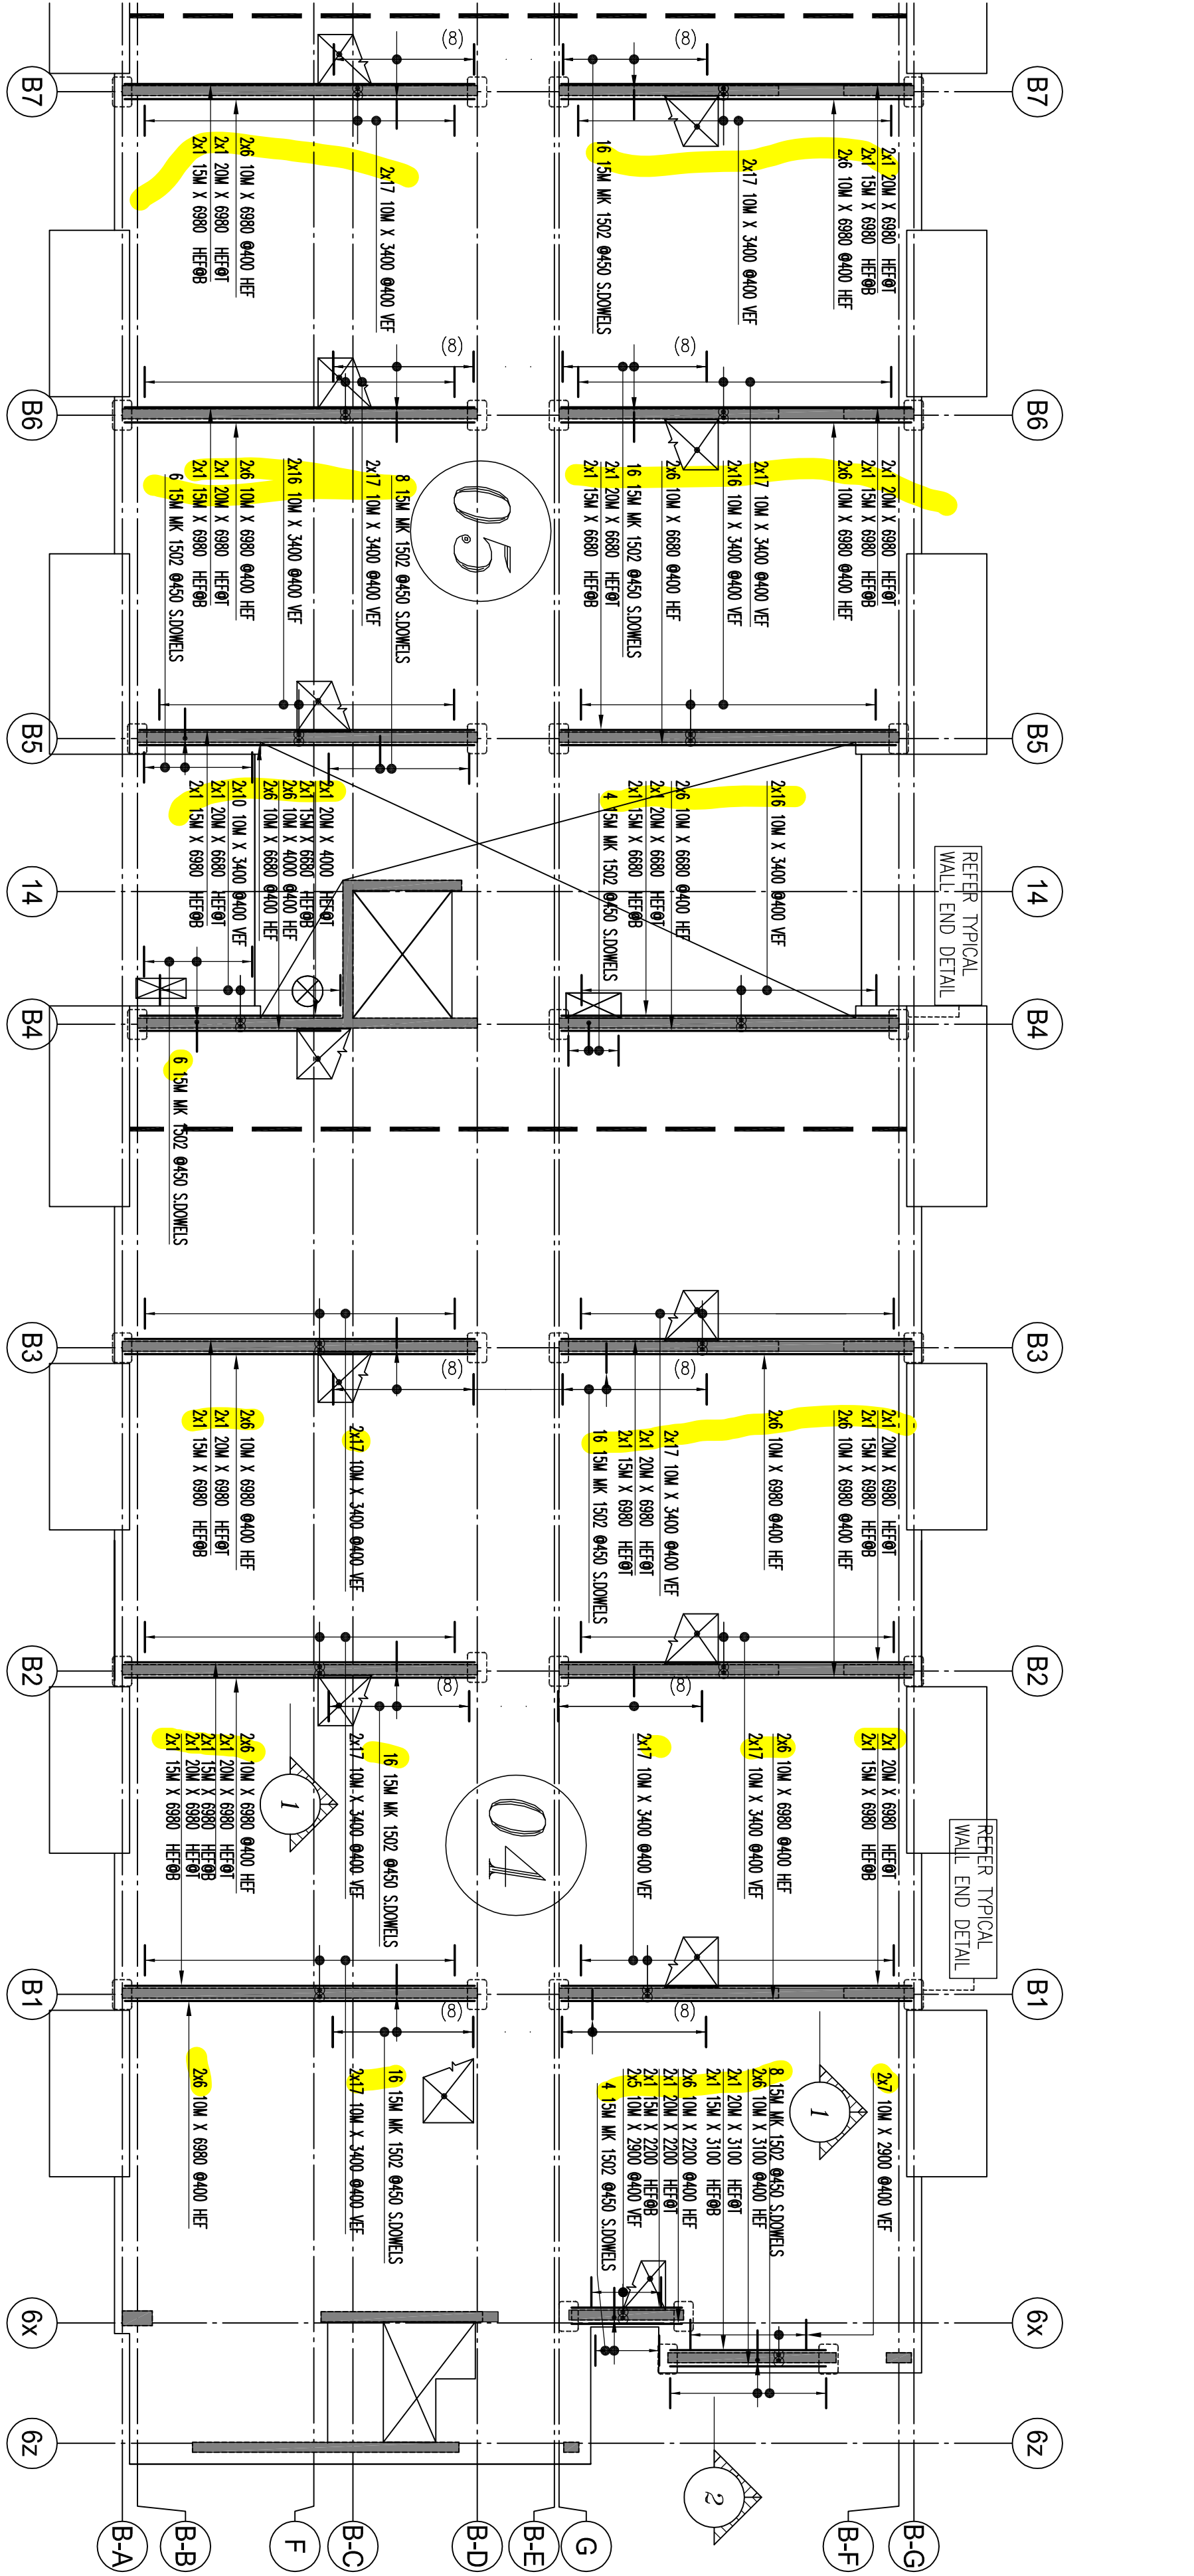

BUILDING-B WALL PLAN
SCALE: 1:100
(FOUR-4 & 5)

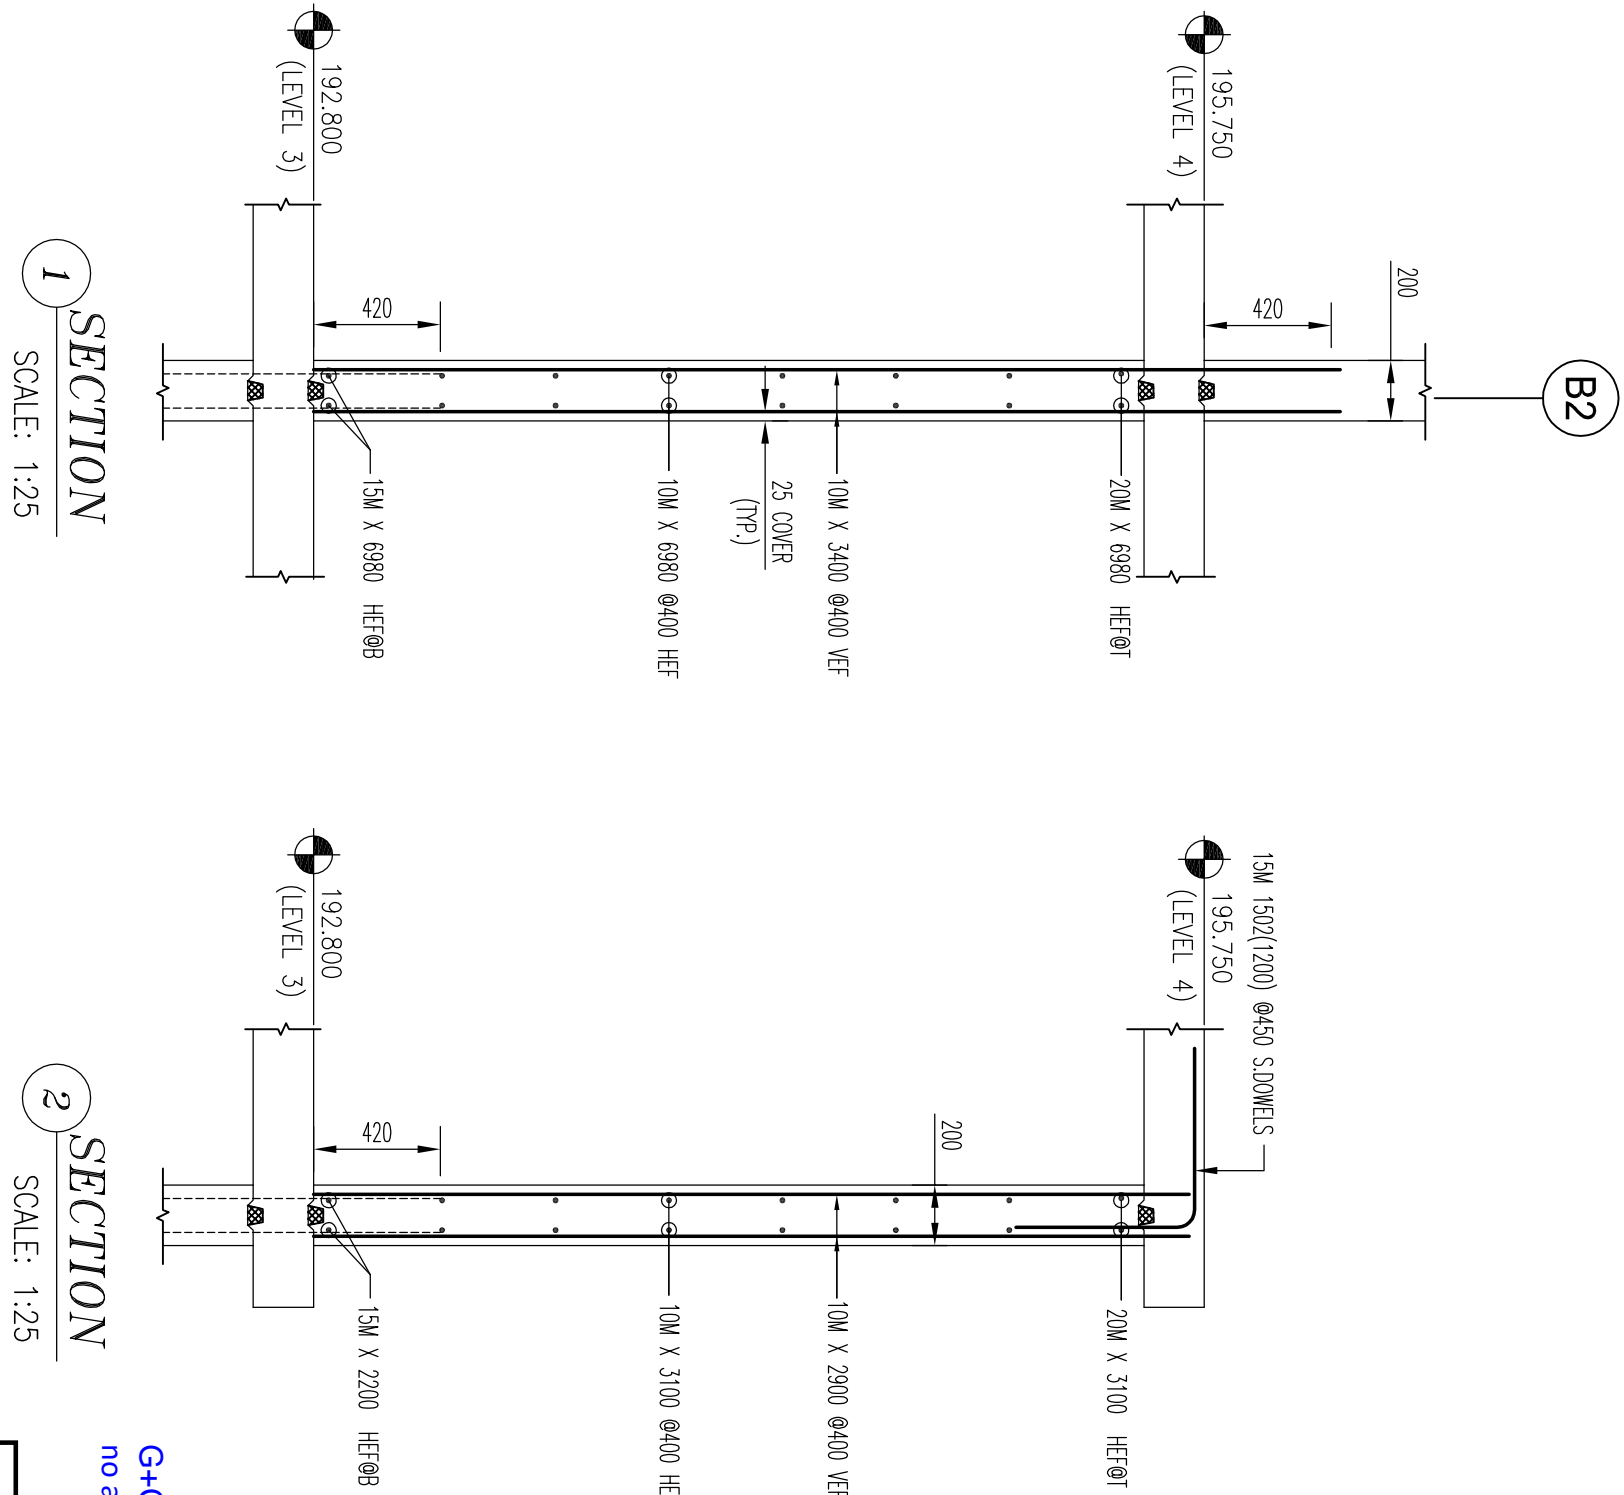


DRAWING REVIEW
This review of this drawing does not in any way relieve the contractor of responsibility for its accuracy or for compliance with the contract documents.


✓ No comment	See comment
Amend &	Reflected
Resubmit	See Remarks

Submission No. **19066**
Project No. **MB**
By **15 Oct 2021**
Date



JABLONSKY, AST AND PARTNERS
Consulting Engineers
1129 Leslie Street Don Mills Ont. M3C 2K5

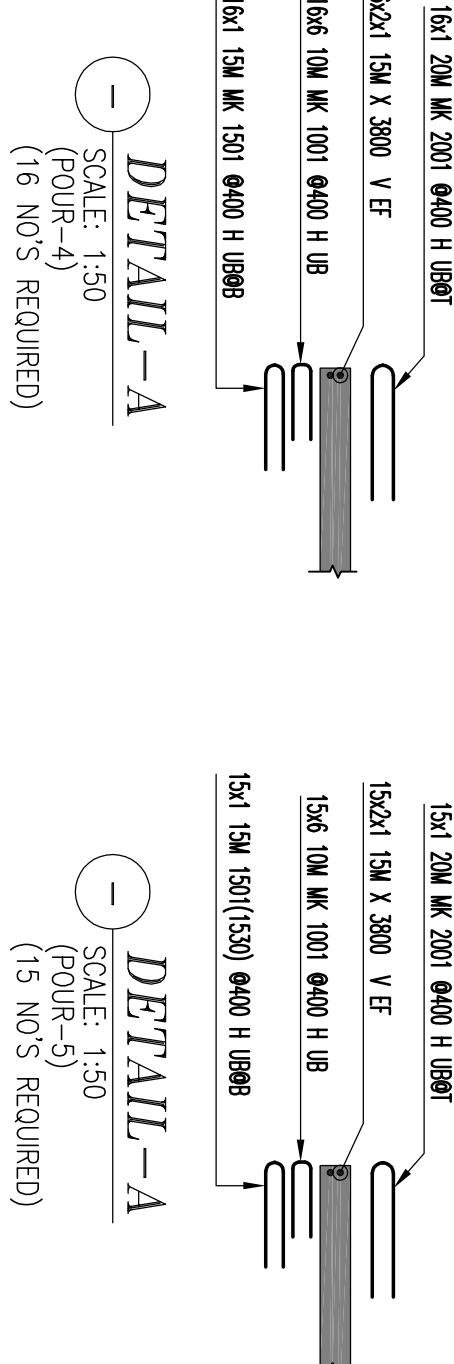


Bar Mark	Qty	Size	Total Length (m)	Unit	Weight (kg)
10M	200	10M	6000	Y	3000
12M	100	12M	3000	Y	1500
16M	50	16M	1500	Y	750
20M	20	20M	600	Y	300
24M	10	24M	300	Y	150
28M	5	28M	150	Y	75
32M	2	32M	60	Y	30
36M	1	36M	30	Y	15
40M	1	40M	15	Y	7.5
44M	1	44M	7.5	Y	3.75
48M	1	48M	3.75	Y	1.875
52M	1	52M	1.875	Y	0.9375
56M	1	56M	0.9375	Y	0.46875
60M	1	60M	0.46875	Y	0.234375
64M	1	64M	0.234375	Y	0.1171875
68M	1	68M	0.1171875	Y	0.05859375
72M	1	72M	0.05859375	Y	0.029296875
76M	1	76M	0.029296875	Y	0.0146484375
80M	1	80M	0.0146484375	Y	0.00732421875
84M	1	84M	0.00732421875	Y	0.003662109375
88M	1	88M	0.003662109375	Y	0.0018310546875
92M	1	92M	0.0018310546875	Y	0.00091552734375
96M	1	96M	0.00091552734375	Y	0.000457763671875
100M	1	100M	0.000457763671875	Y	0.0002288818359375
104M	1	104M	0.0002288818359375	Y	0.00011444091796875
108M	1	108M	0.00011444091796875	Y	0.000057220458984375
112M	1	112M	0.000057220458984375	Y	0.0000286102294921875
116M	1	116M	0.0000286102294921875	Y	0.00001430511474609375
120M	1	120M	0.00001430511474609375	Y	0.000007152557373046875
124M	1	124M	0.000007152557373046875	Y	0.0000035762786865234375
128M	1	128M	0.0000035762786865234375	Y	0.00000178813934326171875
132M	1	132M	0.00000178813934326171875	Y	0.000000894069671630859375
136M	1	136M	0.000000894069671630859375	Y	0.0000004470348358154296875
140M	1	140M	0.0000004470348358154296875	Y	0.00000022351741790771484375
144M	1	144M	0.00000022351741790771484375	Y	0.000000111758708953857421875
148M	1	148M	0.000000111758708953857421875	Y	0.0000000558793544769287109375
152M	1	152M	0.0000000558793544769287109375	Y	0.00000002793967723846435546875

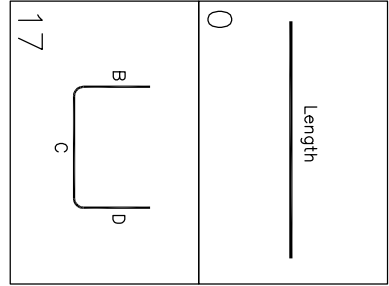


Bar Mark	Qty	Size	Total Length (m)	Unit	Weight (kg)
10M	200	10M	6000	Y	3000
12M	100	12M	3000	Y	1500
16M	50	16M	1500	Y	750
20M	20	20M	600	Y	300
24M	10	24M	300	Y	150
28M	5	28M	150	Y	75
32M	2	32M	60	Y	30
36M	1	36M	30	Y	15
40M	1	40M	15	Y	7.5
44M	1	44M	7.5	Y	3.75
48M	1	48M	3.75	Y	1.875
52M	1	52M	1.875	Y	0.9375
56M	1	56M	0.9375	Y	0.46875
60M	1	60M	0.46875	Y	0.234375
64M	1	64M	0.234375	Y	0.1171875
68M	1	68M	0.1171875	Y	0.05859375
72M	1	72M	0.05859375	Y	0.029296875
76M	1	76M	0.029296875	Y	0.0146484375
80M	1	80M	0.0146484375	Y	0.00732421875
84M	1	84M	0.00732421875	Y	0.003662109375
88M	1	88M	0.003662109375	Y	0.0018310546875
92M	1	92M	0.0018310546875	Y	0.00091552734375
96M	1	96M	0.00091552734375	Y	0.000457763671875
100M	1	100M	0.000457763671875	Y	0.0002288818359375
104M	1	104M	0.0002288818359375	Y	0.00011444091796875
108M	1	108M	0.00011444091796875	Y	0.000057220458984375
112M	1	112M	0.000057220458984375	Y	0.0000286102294921875
116M	1	116M	0.0000286102294921875	Y	0.00001430511474609375
120M	1	120M	0.00001430511474609375	Y	0.000007152557373046875
124M	1	124M	0.000007152557373046875	Y	0.0000035762786865234375
128M	1	128M	0.0000035762786865234375	Y	0.00000178813934326171875
132M	1	132M	0.00000178813934326171875	Y	0.000000894069671630859375
136M	1	136M	0.000000894069671630859375	Y	0.0000004470348358154296875
140M	1	140M	0.0000004470348358154296875	Y	0.00000022351741790771484375
144M	1	144M	0.00000022351741790771484375	Y	0.000000111758708953857421875
148M	1	148M	0.000000111758708953857421875	Y	0.0000000558793544769287109375
152M	1	152M	0.0000000558793544769287109375	Y	0.00000002793967723846435546875

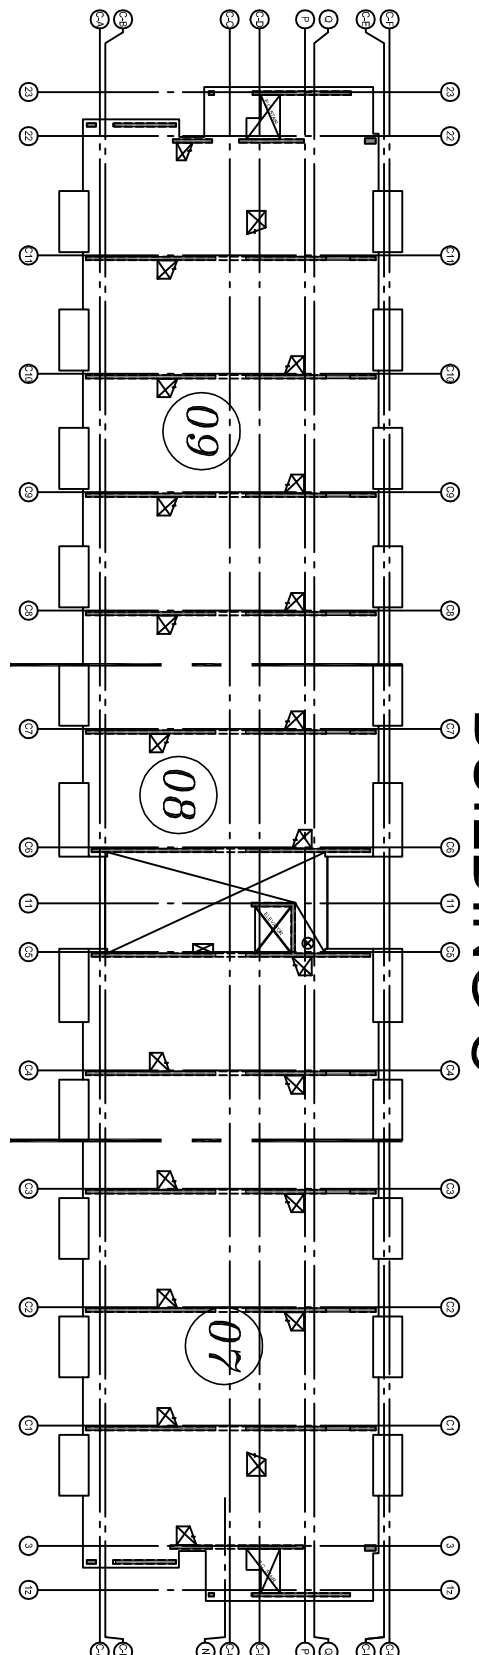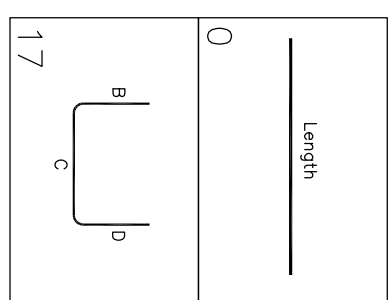


BUILDING C

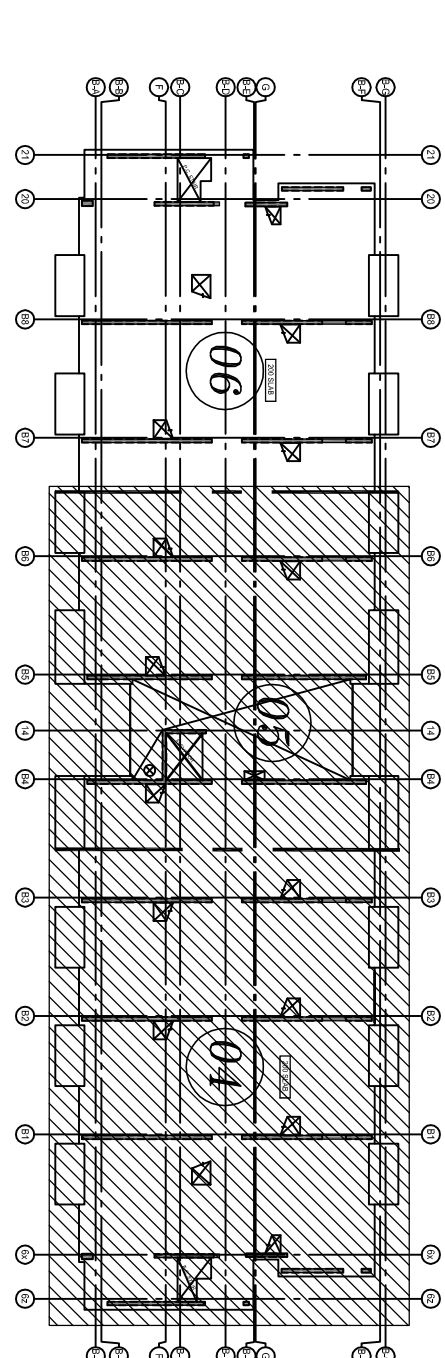

BUILDING B

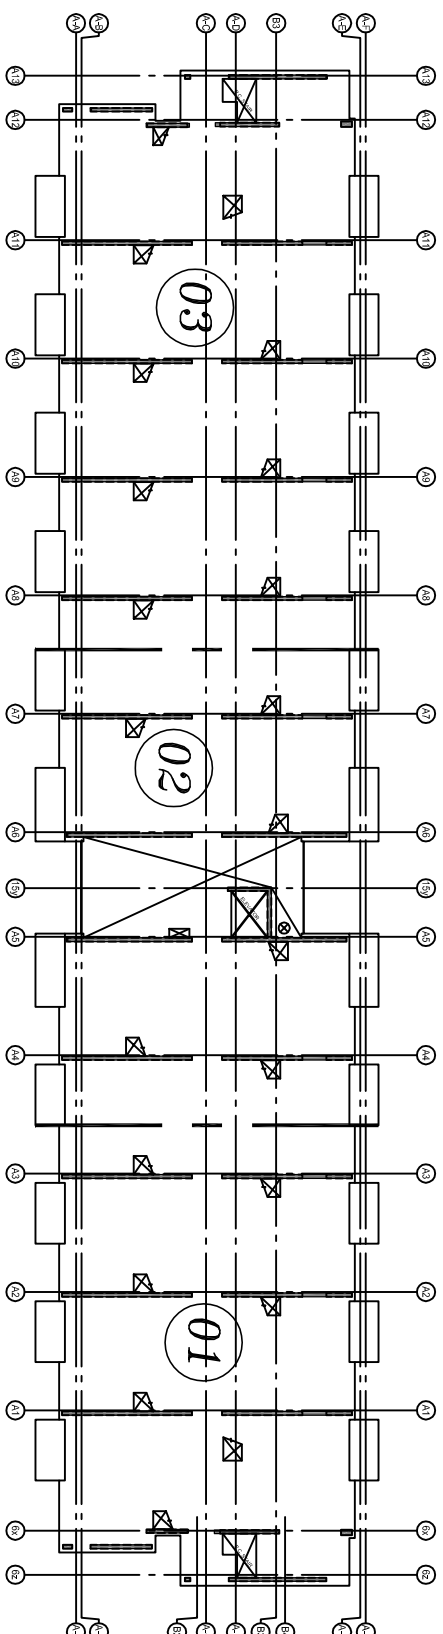

BUILDING A

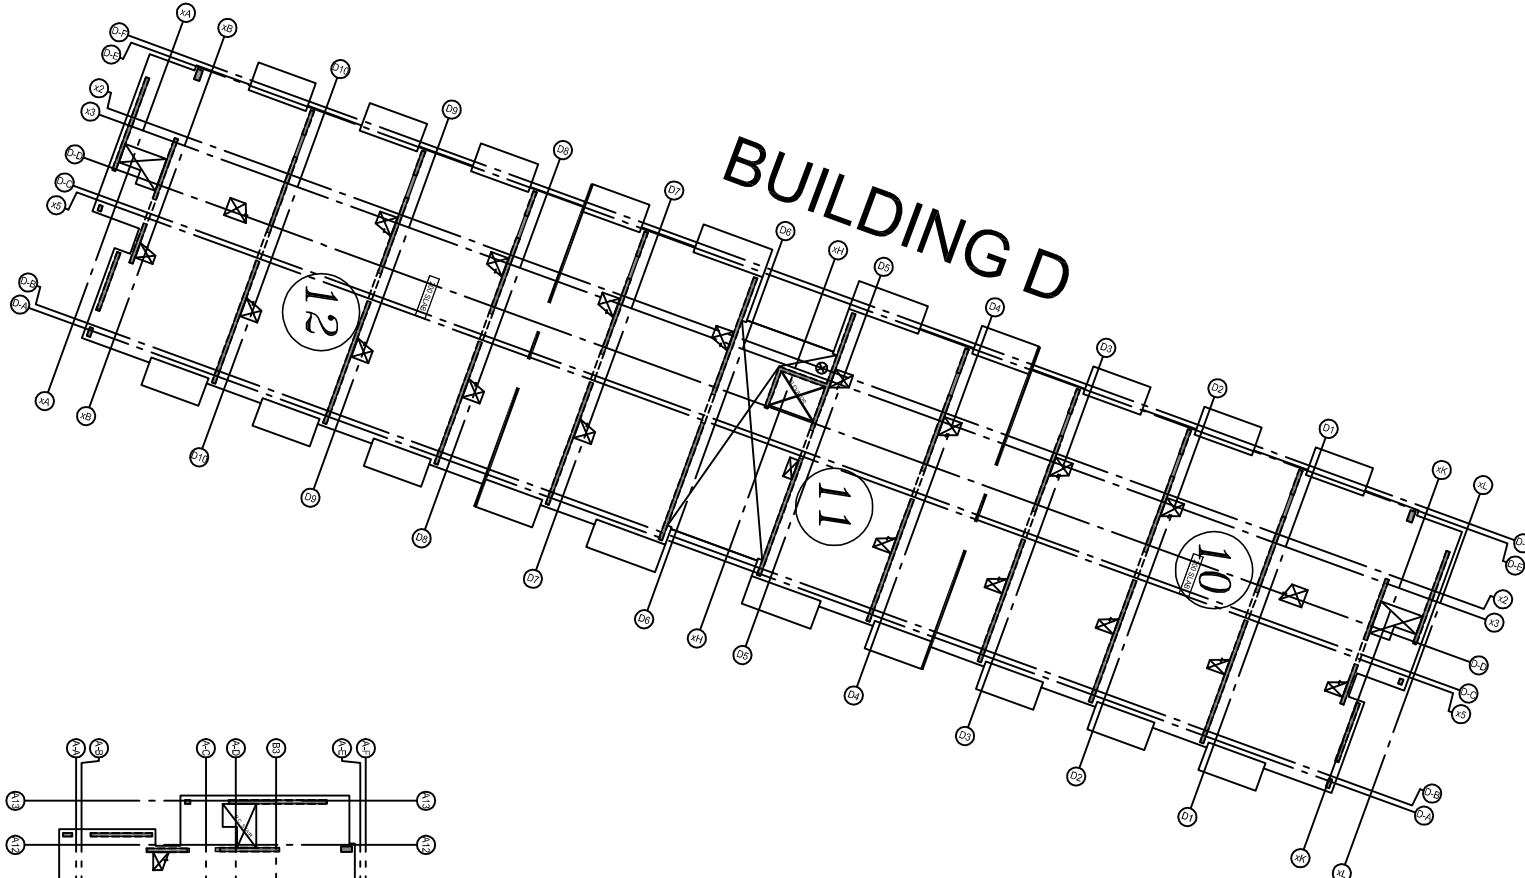

BUILDING D

NOTES

1. ALL STEEL TO BE GRADE 400W
2. STRENGTH OF CONCRETE 35MPa – INTERIOR COLUMNS & WALLS
3. CONCRETE COVER: – – 25mm

BAR SIZE	STANDARD LAP (mm)
10M	300
15M	440
20M	590
25M	730
30M	880
35M	1030










BAR SIZE	L.S	L.d	L.S	L.d	L.S	L.d
10M	490	380	450	350	420	320
15M	740	570	670	520	620	480
20M	980	750	890	690	830	640
25M	1230	940	1070	830	990	790
30M	1480	1130	1290	1000	1190	990
35M	1730	1320	1550	1190	1390	1190

• ELEVATIONS AND DIMENSIONS SHOWN ARE FOR VERIFICATION PURPOSES ONLY AND ARE NOT TO BE USED FOR CONSTRUCTION AND APPROVED AS SUCH. CONSULT THE ARCHITECT FOR ANY CHANGES.


LEGEND	SYMBOL	DESCRIPTION
1. ALL STEEL TO BE GRADE 400W	1	1. ALL STEEL TO BE GRADE 400W
2. STRENGTH OF CONCRETE 35MPa	2	2. STRENGTH OF CONCRETE 35MPa
3. CONCRETE COVER: – – 25mm	3	3. CONCRETE COVER: – – 25mm
4. REINFORCEMENT LAYERS	4	4. REINFORCEMENT LAYERS
5. REINFORCEMENT LAYERS	5	5. REINFORCEMENT LAYERS
6. REINFORCEMENT LAYERS	6	6. REINFORCEMENT LAYERS
7. REINFORCEMENT LAYERS	7	7. REINFORCEMENT LAYERS
8. REINFORCEMENT LAYERS	8	8. REINFORCEMENT LAYERS
9. REINFORCEMENT LAYERS	9	9. REINFORCEMENT LAYERS
10. REINFORCEMENT LAYERS	10	10. REINFORCEMENT LAYERS
11. REINFORCEMENT LAYERS	11	11. REINFORCEMENT LAYERS
12. REINFORCEMENT LAYERS	12	12. REINFORCEMENT LAYERS

ISSUE	FOR APPROVAL	DATE	BY
1	MANSTEEL, REBAR	OCT/14/21	JJ
2	REBAR		
3			
4			
5			
6			
7			
8			
9			
10			
11			
12			

PROJECT	FORSTSIDE TOWNHOUSES –BRAIMPTON, ON
CUSTOMER	ROYAL PINE HOMES
DESIGNED BY	JJ
CHECKED BY	JJ
DATE	15 Oct 2021
SCALE	AS SHOWN
DRAWING NO.	R13.7

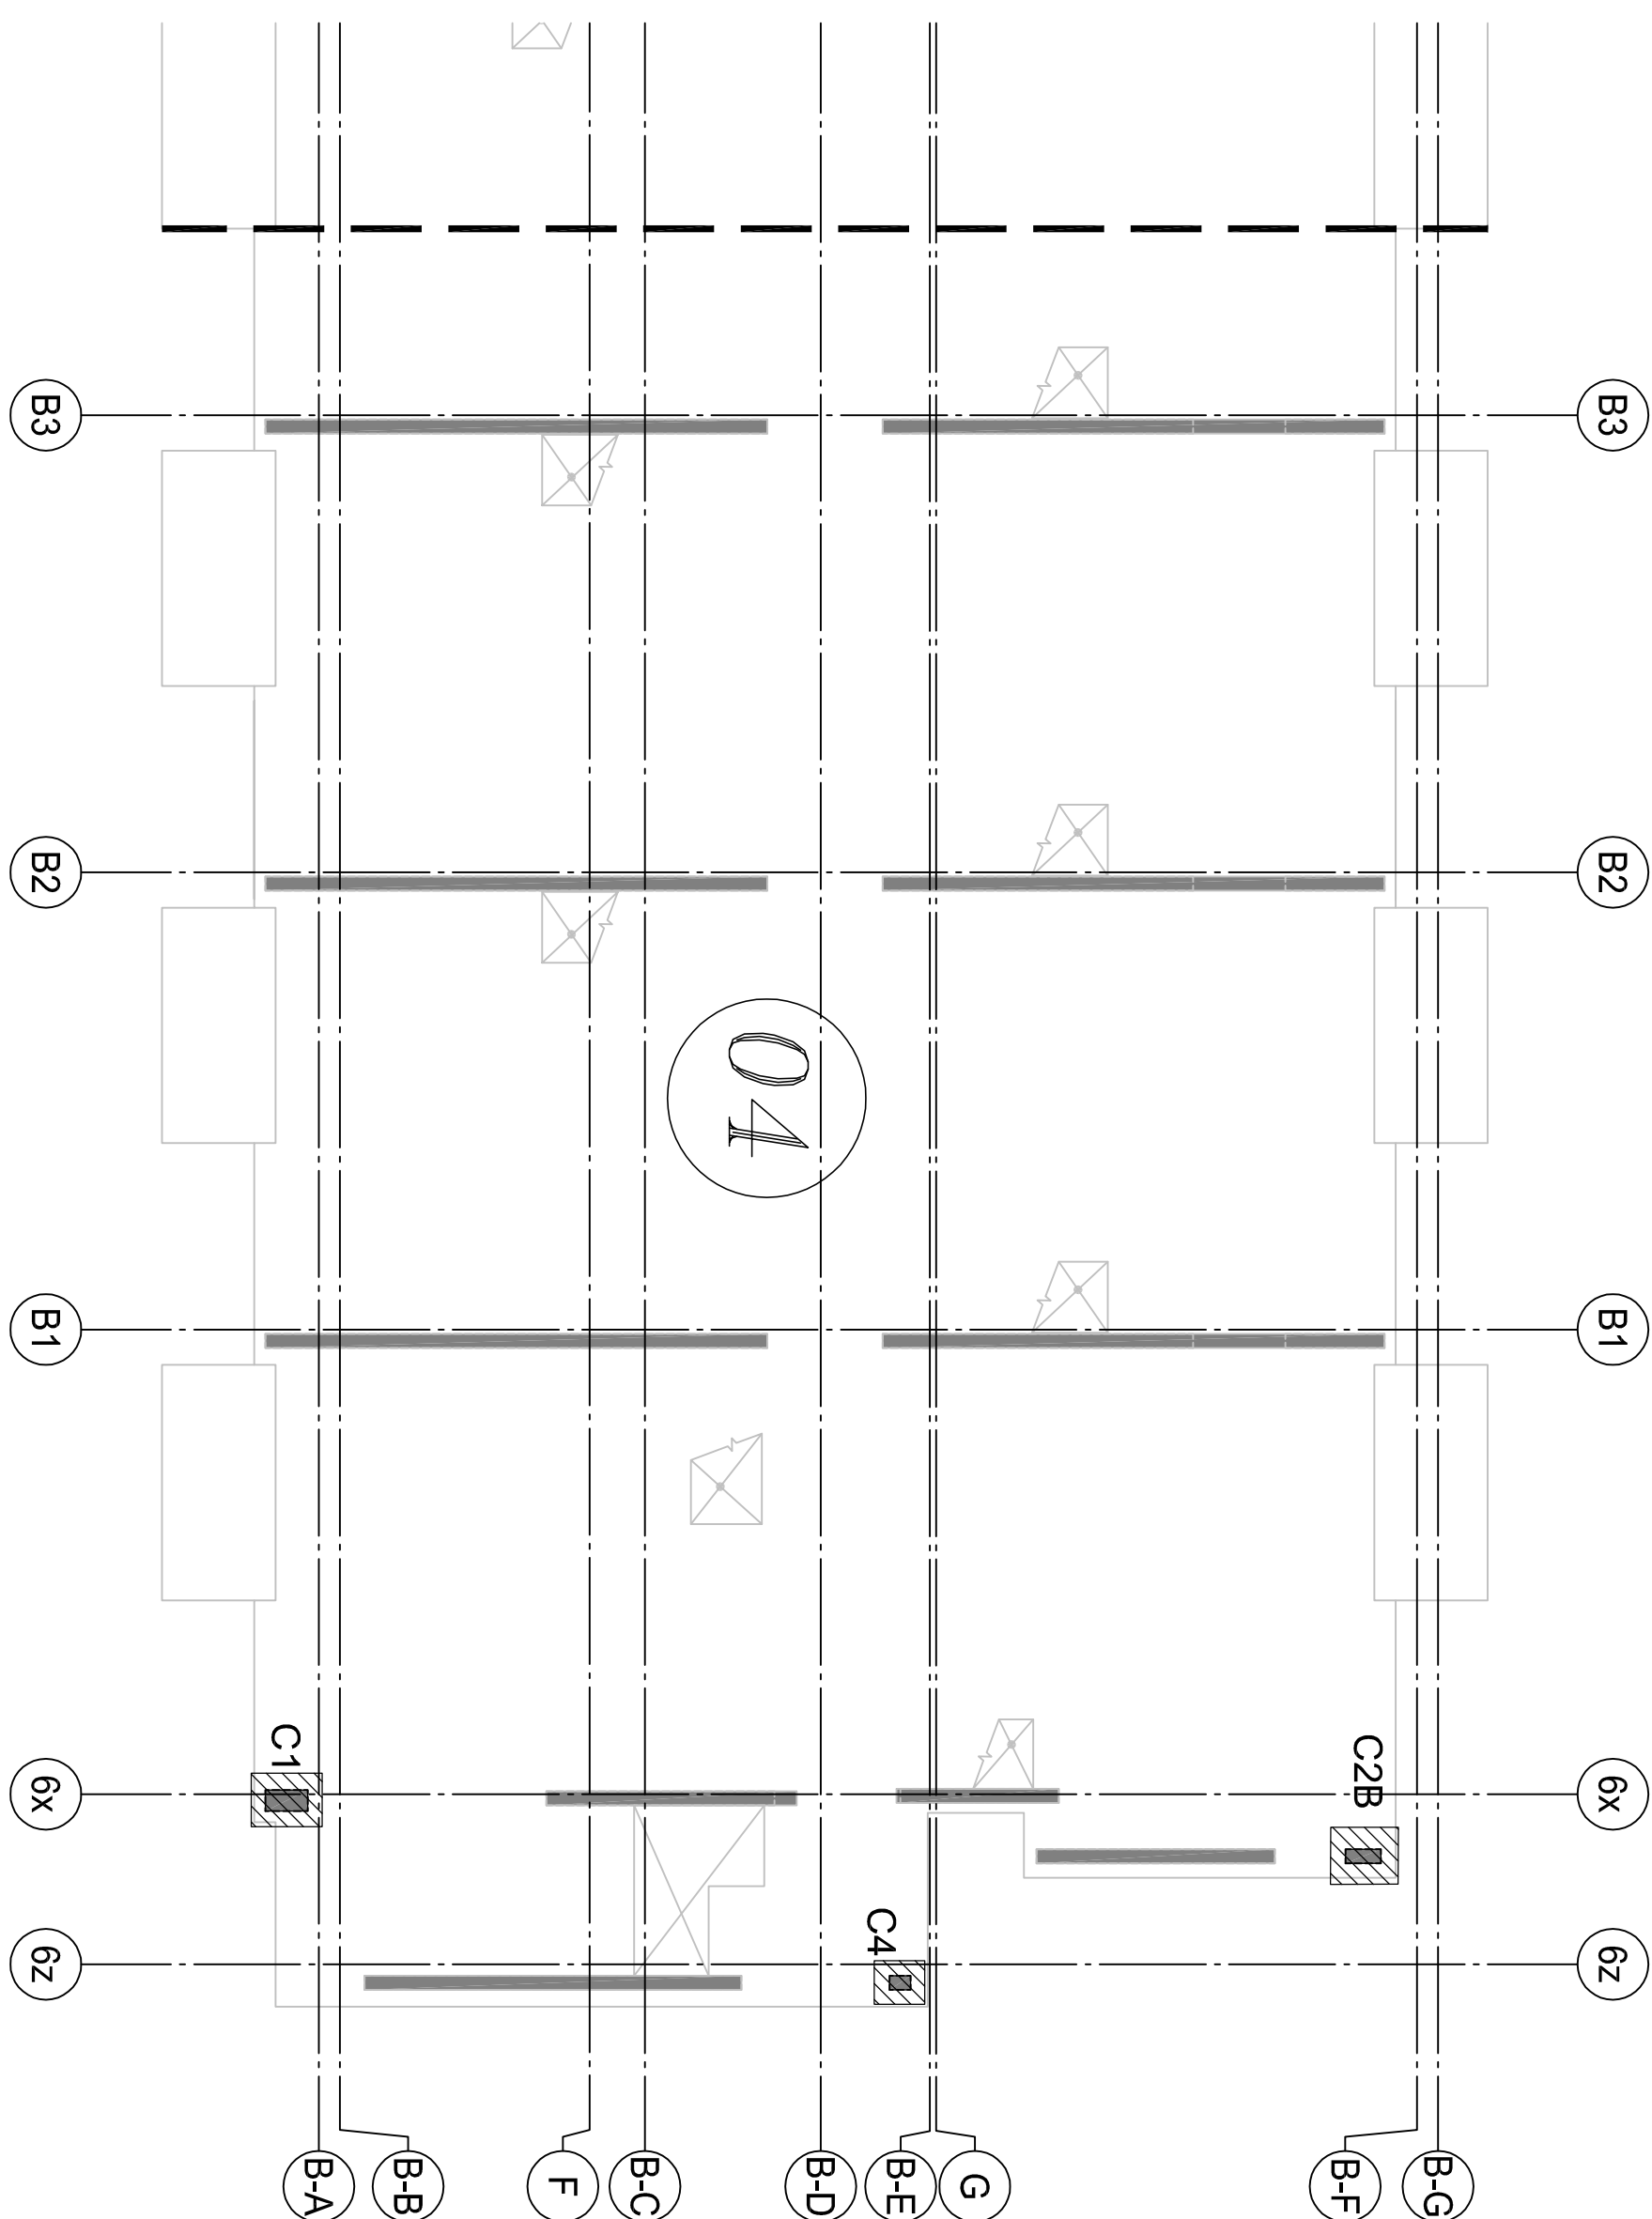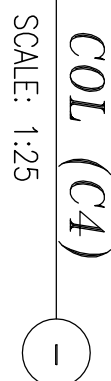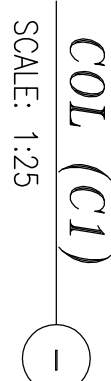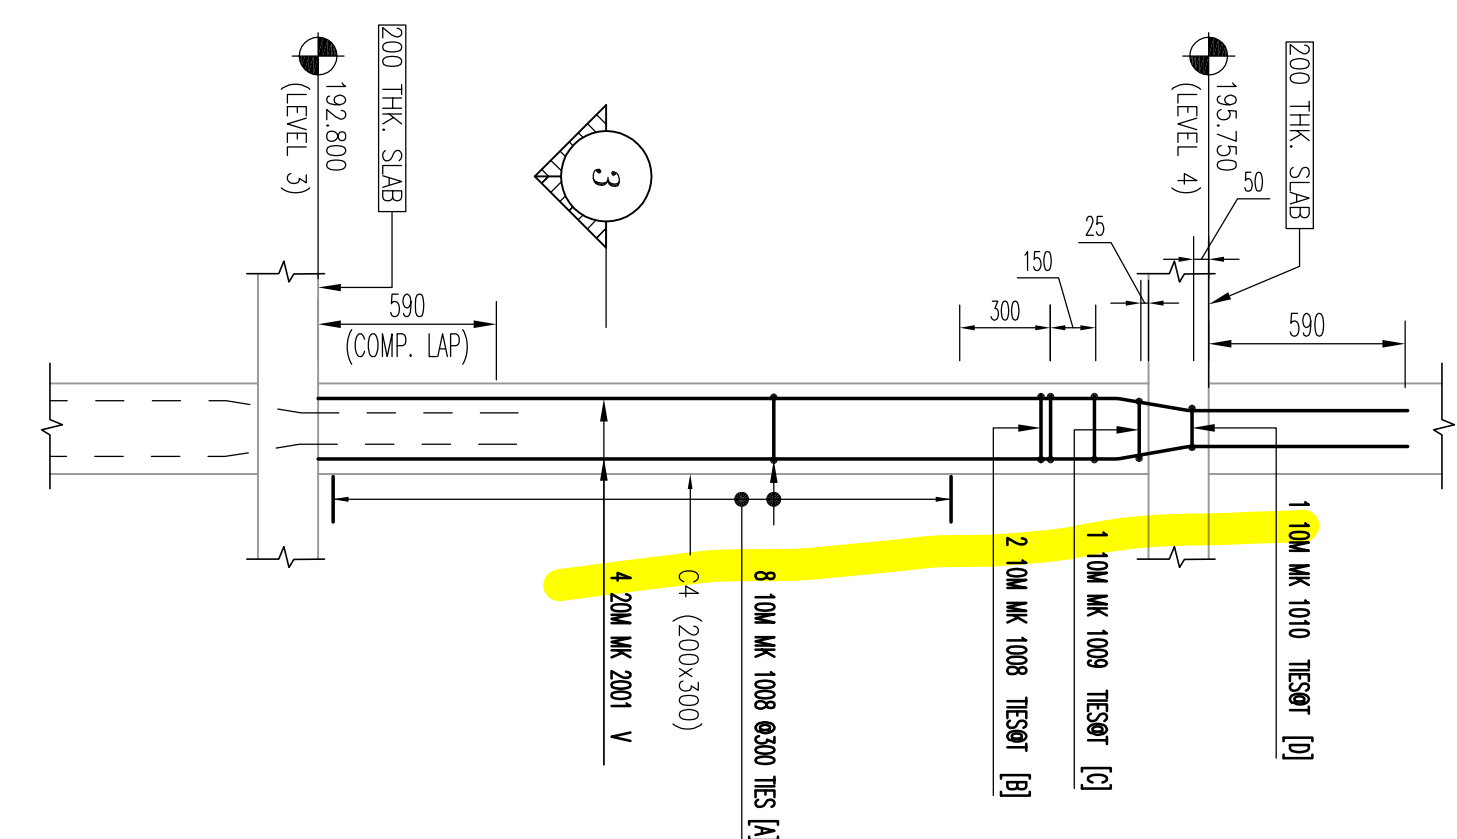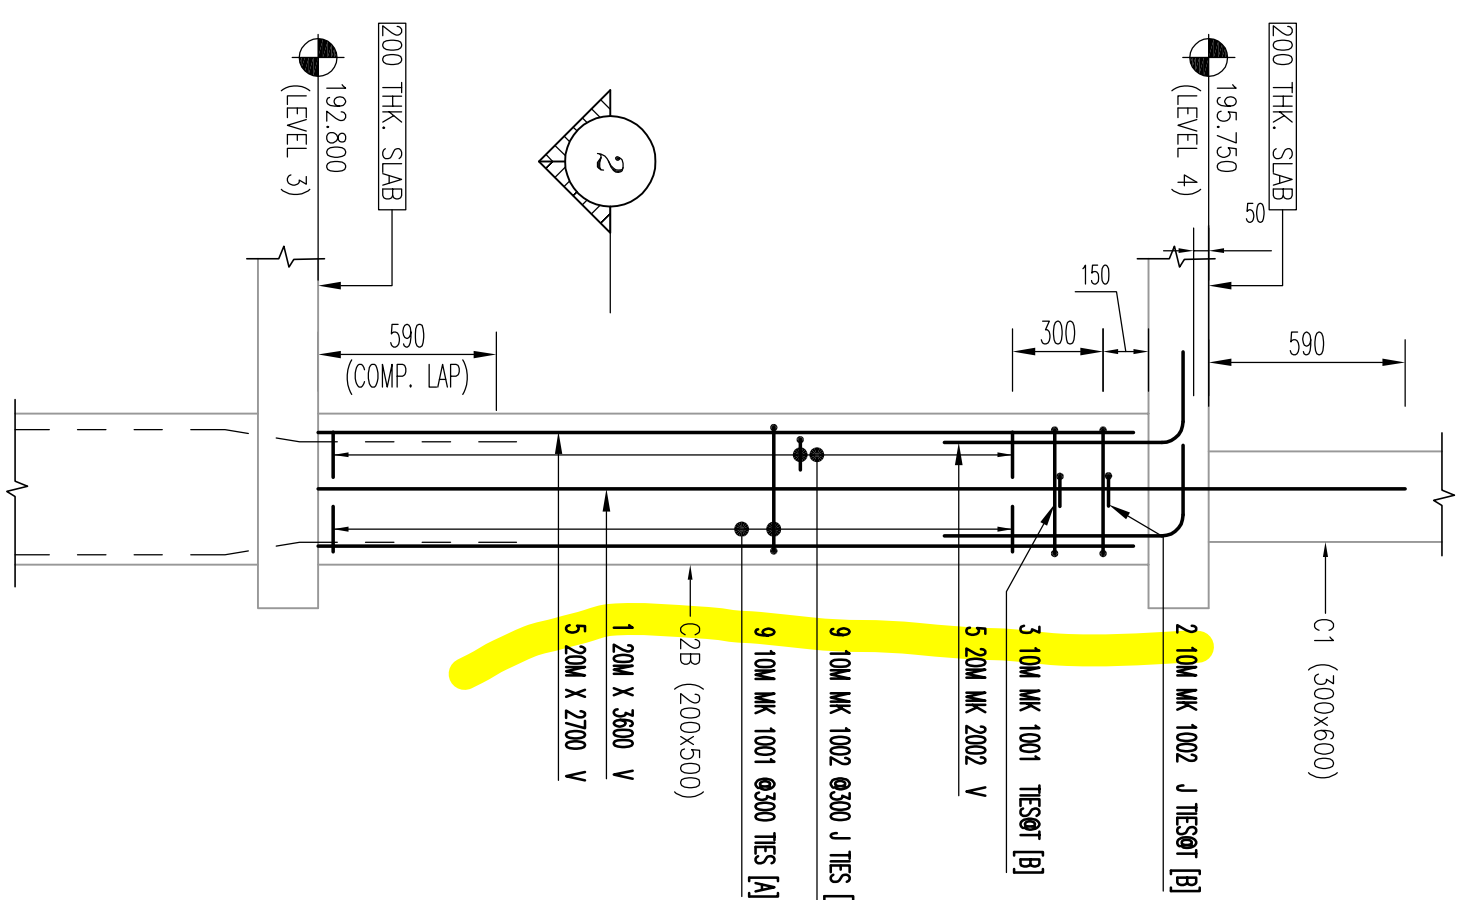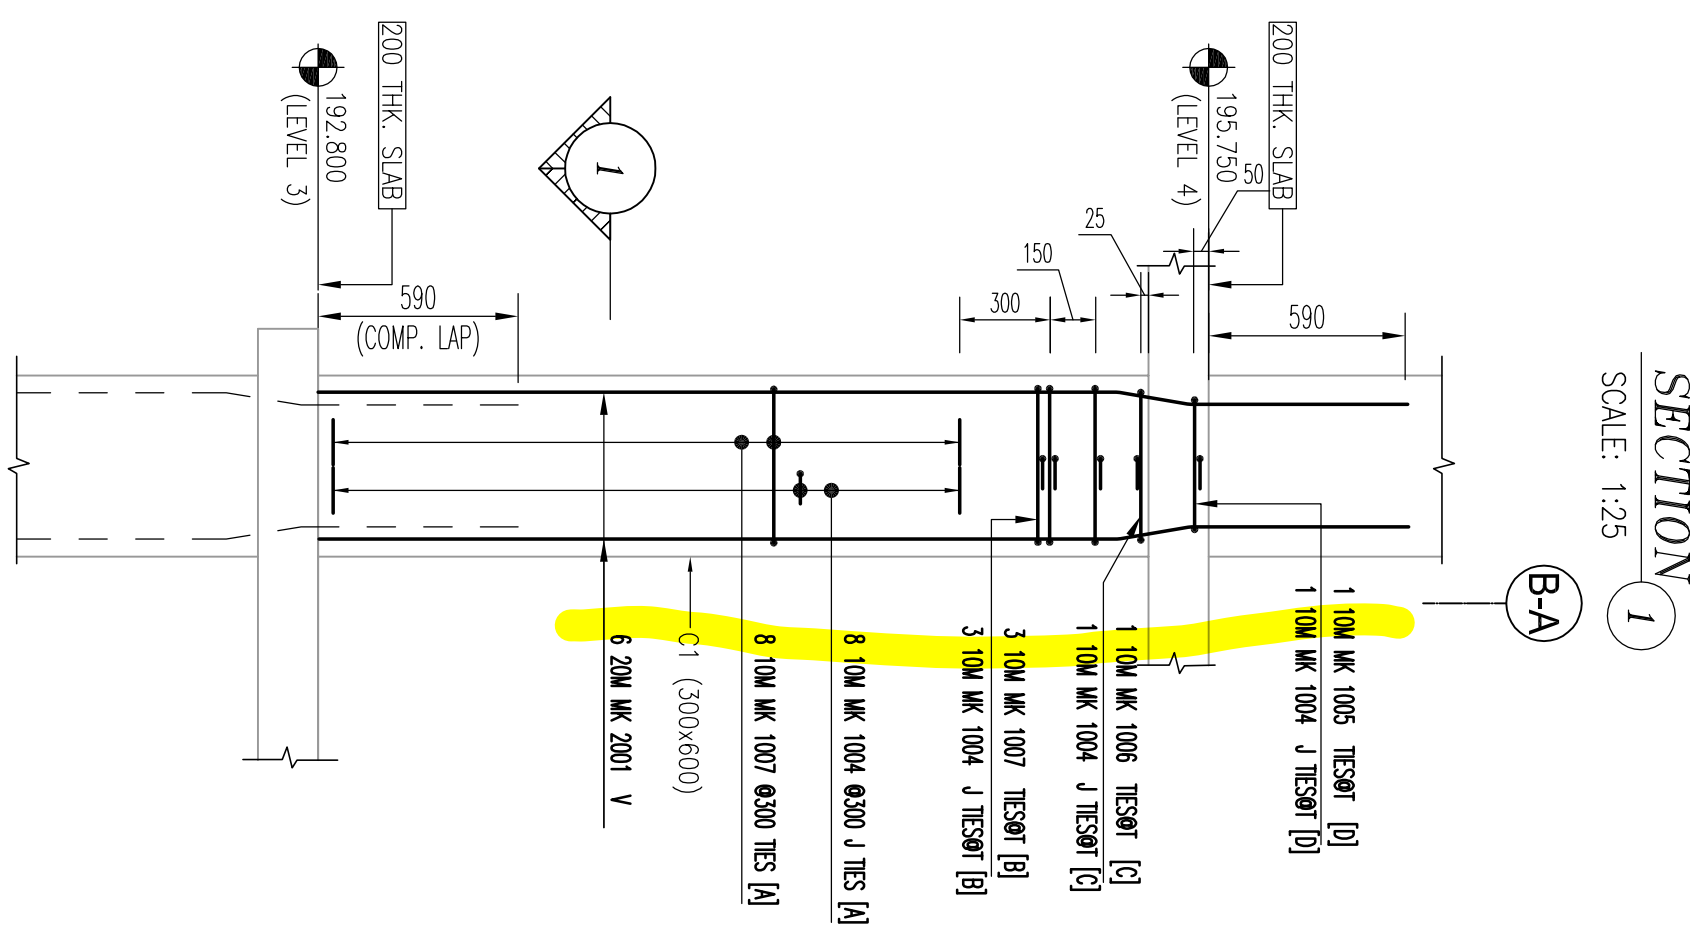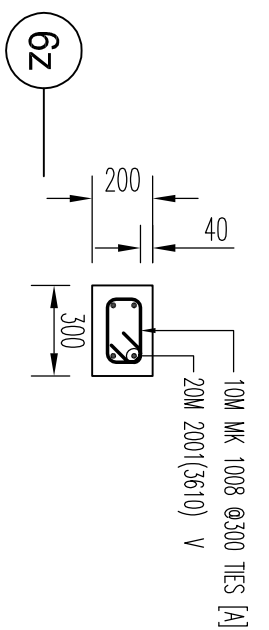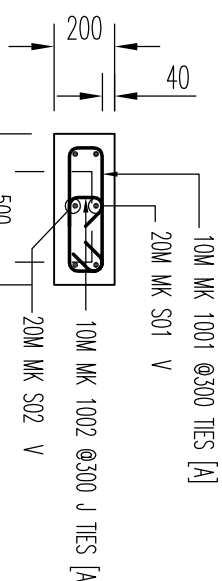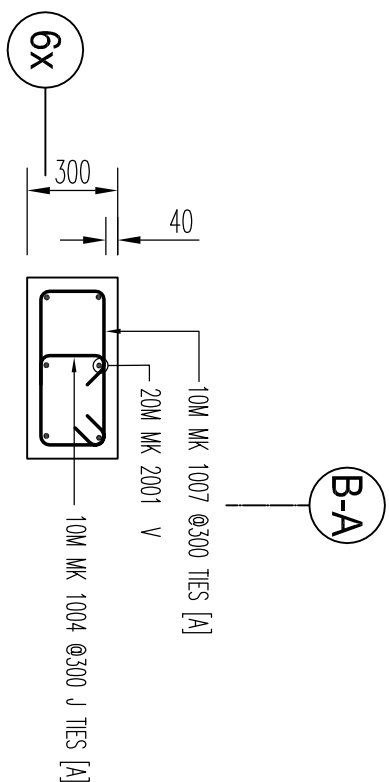

Bioscience Resource Project: Unit 13 - Life on Earth													
Strata	Age	Substratum	Life	Plant	Animal	Plant	Animal	Plant	Animal	Plant	Animal	Plant	Animal
1004	13,000	460 ft	100	200									
1003	13,000	250 ft	100	150	140	120							
1002	11,000	840 ft	100	200									
1001	11,000	100	100	120	200	120							
1000	11,000	100	100	120	200	120							
1005	11,000	150 ft	100	40	100	100							
1006	11,000	150 ft	100	40	200	440	200						
1007	11,000	160 ft	100	50	250	50	200						
1008	11,000	160 ft	100	50	250	50	200						
1009	11,000	200 ft	100	50	250	50	200						
1010	11,000	250 ft	100	50	250	50	200						
1011	10,000	300 ft	100	50	250	50	200						
1012	10,000	350 ft	100	50	250	50	200						
1013	10,000	400 ft	100	50	250	50	200						
1014	10,000	450 ft	100	50	250	50	200						
1015	10,000	500 ft	100	50	250	50	200						
1016	10,000	550 ft	100	50	250	50	200						
1017	10,000	600 ft	100	50	250	50	200						
1018	10,000	650 ft	100	50	250	50	200						
1019	10,000	700 ft	100	50	250	50	200						
1020	10,000	750 ft	100	50	250	50	200						
1021	10,000	800 ft	100	50	250	50	200						
1022	10,000	850 ft	100	50	250	50	200						
1023	10,000	900 ft	100	50	250	50	200						
1024	10,000	950 ft	100	50	250	50	200						
1025	10,000	1,000 ft	100	50	250	50	200						
1026	10,000	1,050 ft	100	50	250	50	200						
1027	10,000	1,100 ft	100	50	250	50	200						
1028	10,000	1,150 ft	100	50	250	50	200						
1029	10,000	1,200 ft	100	50	250	50	200						
1030	10,000	1,250 ft	100	50	250	50	200						
1031	10,000	1,300 ft	100	50	250	50	200						
1032	10,000	1,350 ft	100	50	250	50	200						
1033	10,000	1,400 ft	100	50	250	50	200						
1034	10,000	1,450 ft	100	50	250	50	200						
1125	10,000	6,000 ft	100	50	250	50	200						
1126	10,000	6,050 ft	100	50	250	50	200						
1127	10,000	6											

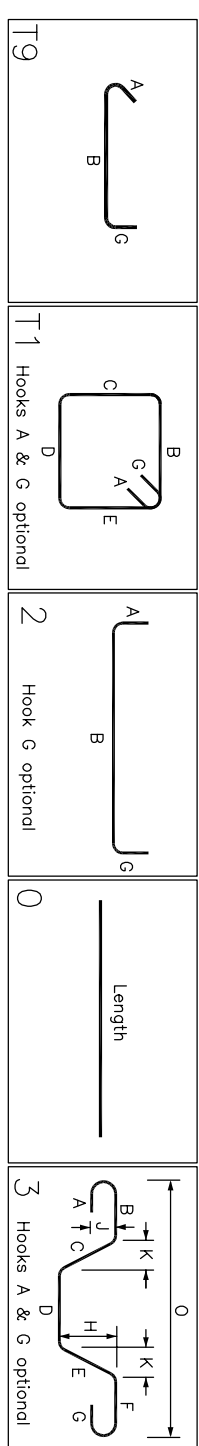

NOTES

1. ALL STEEL TO BE GRADE 400W
2. STRENGTH OF CONCRETE
35MPa — INTERIOR COLUMNS & WALLS
3. CONCRETE COVER:
TIES — 40mm

BAR SIZE	STANDARD LAP (mm)
10M	300
15M	440
20M	590
25M	730
30M	880
35M	1030

BAR SIZE	$t_c=25$			$t_c=30$			$t_c=35$		
	L/D	L/S	L/D	L/D	L/S	L/D	L/D	L/S	L/D
10M	4.90	3.80	4.50	3.50	4.20	3.20			
15M	7.40	5.70	6.70	5.20	6.20	4.80			
20M	8.60	7.50	8.80	6.90	8.30	6.40			
25M	15.50	11.70	13.90	10.70	12.90	9.90			
30M	18.30	14.10	16.70	12.80	15.50	11.90			
35M	21.30	16.40	19.50	15.00	18.00	13.90			

DRAWING REVIEW




This review of this drawing does not in any way, relieve the contractor of responsibility for its accuracy, or for compliance with the contract documents.

✓	
No comment	See comment
Amend & Resubmit	Rejected See Remarks

Submission No.	19066
Project No.	
By	MB
Date	15 Oct 2021

JABLONSKY, AST AND PARTNERS
Consulting Engineers
1129 Leslie Street Don Mills, Ont. M3C 2K5

[illegible]

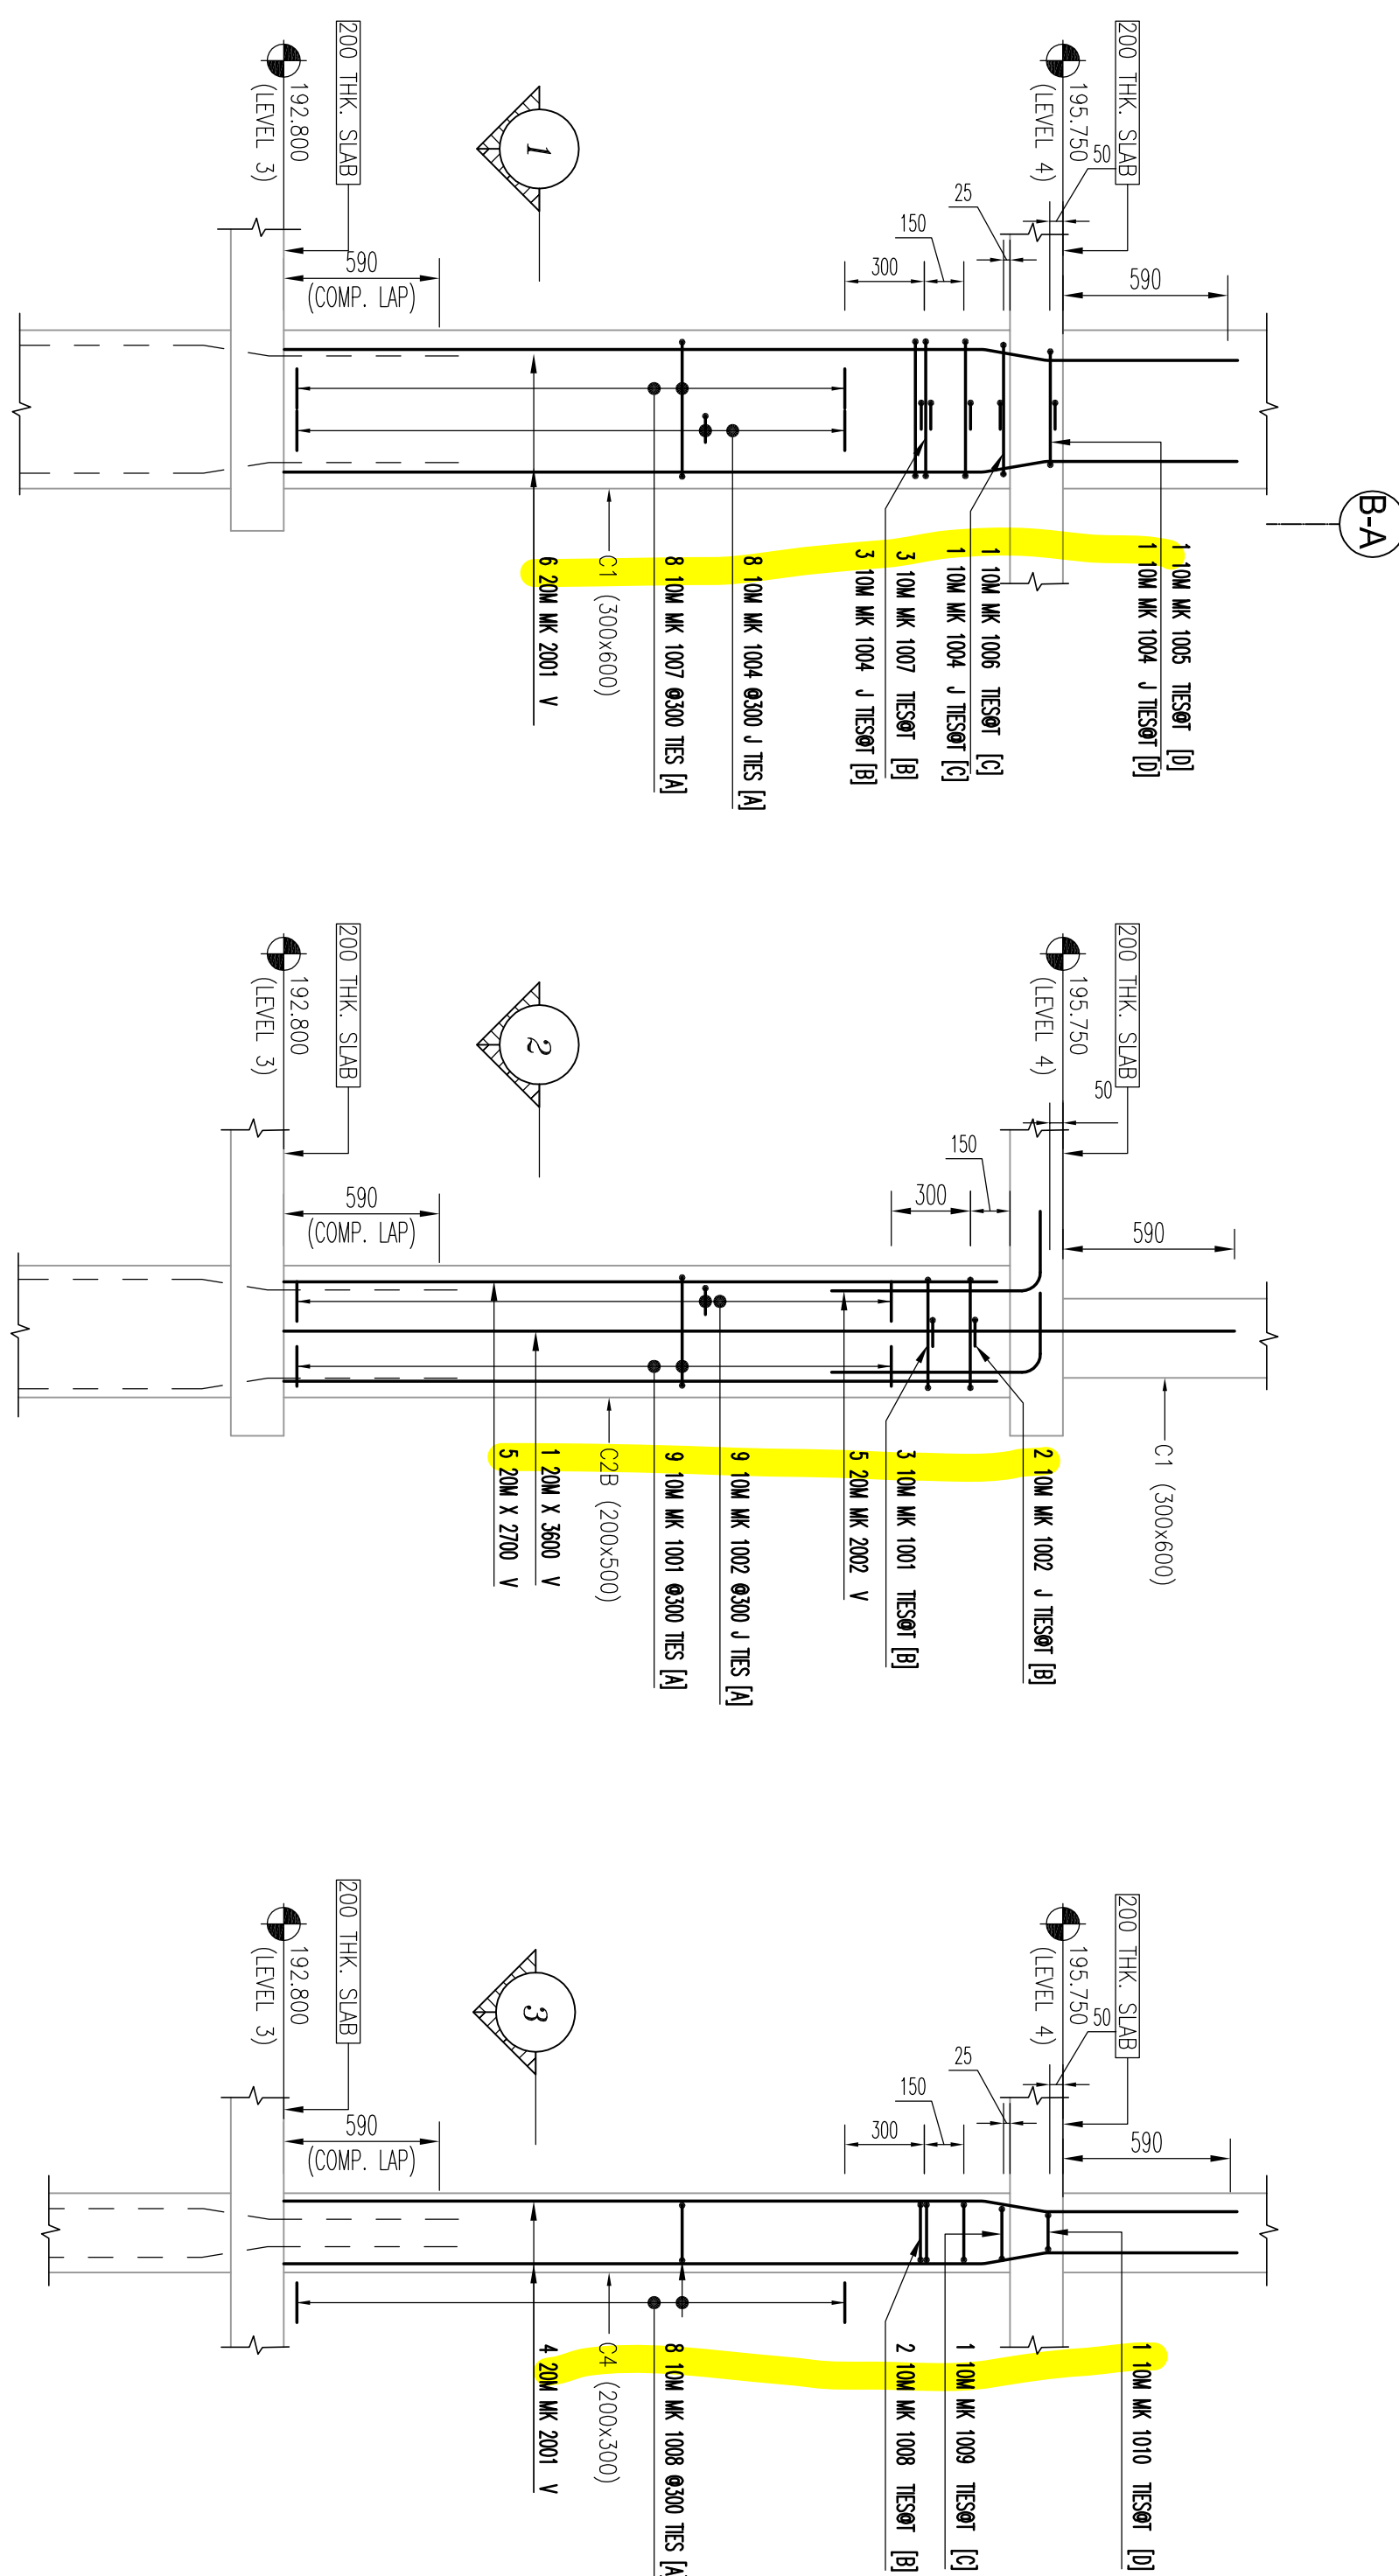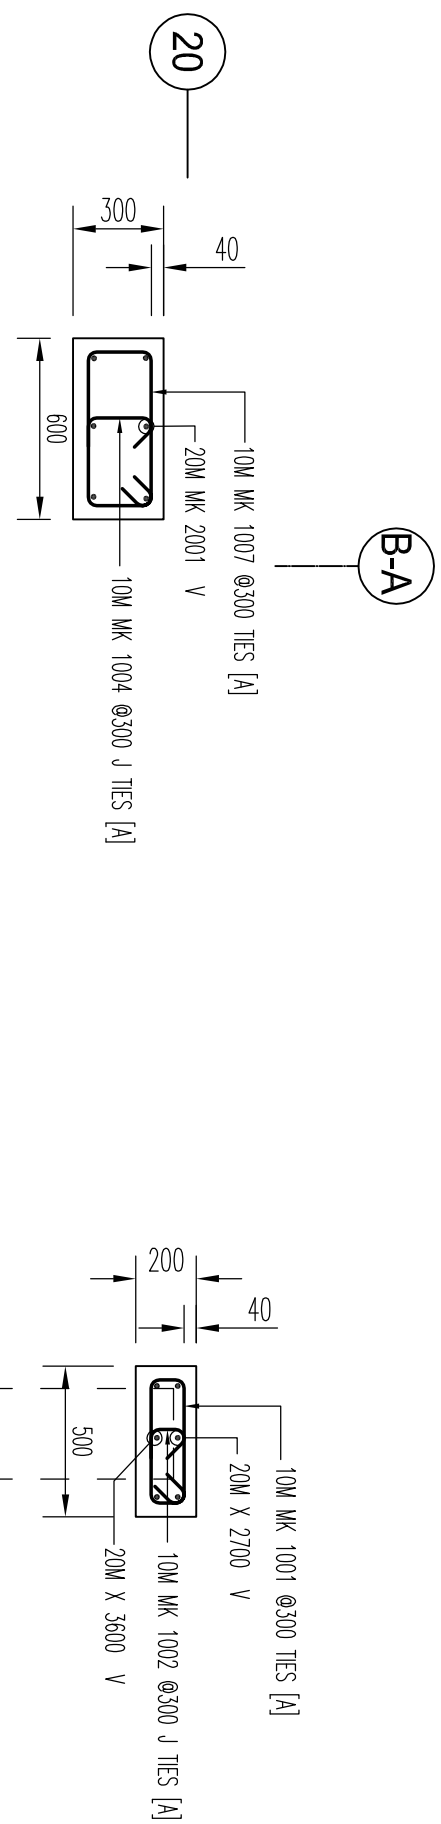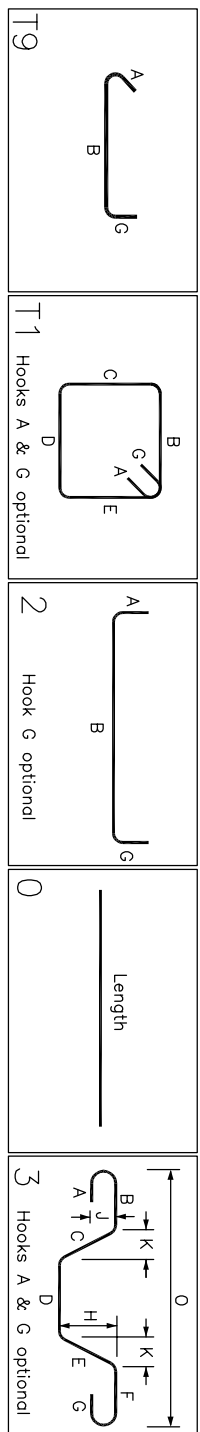[illegible]

NOTES

1. ALL STEEL TO BE GRADE 400W
2. STRENGTH OF CONCRETE
35MPa – INTERIOR COLUMNS & WALLS
3. CONCRETE COVER:
TIES – 40mm

BAR SIZE	STANDARD LAP (mm)
10M	300
15M	440
20M	590
25M	730
30M	880
35M	1030

BAR SIZE	$f_c=25$		$f_c=30$		$f_c=35$	
	L.S.	L.d	L.S.	L.d	L.S.	L.d
10M	490	380	450	350	420	320
15M	740	570	670	520	620	480
20M	880	750	890	690	830	640
25M	1530	1170	1390	1070	1290	990
30M	1830	1410	1670	1290	1550	1190

DRAWING REVIEW	
This review of this drawing does not in any way relieve the contractor of responsibility for its accuracy or for compliance with the contract documents.	
<input checked="" type="checkbox"/> No comment	<input type="checkbox"/> See comment
<input type="checkbox"/> Amend & Resubmit	<input type="checkbox"/> Rejected See Remarks

G+C
no architectural items noted for G+C to review

[illegible]

0	FOR APPROVAL	OCT/14/21	u
1			
2			
**FORESTSIDE TOWNHOUSES
-BRAMPTON, ON**

PART OF STRUCTURE		COLUMNS L3-L4 - P#6	
CUSTOMER:		Project no. 2177	
ROYAL PINE HOMES		SCALE AS SHOWN	
DEFINED BY: <u> </u>	BAR LIST No.	DRAWING No.	
CHECKED BY: <u> </u>		R14.3	
		0	