
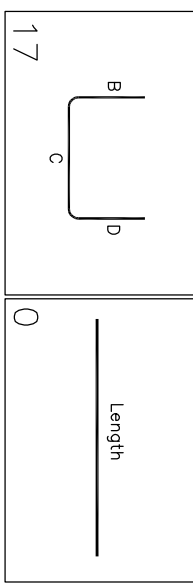


[illegible]

Length _____

Boxcar Number: R150E Type S1, T1U, & T1L					BPH LIST							
Box Mark	Qty	Size	Load Length	Type	"1"	"2"	"3"	"4"	"5"	"6"	"7"	"8"
1502	14	15H	2030	1	180	1650					130	
1501	18	15H	1780	1	180	1600					130	

Poisson function RFLD (20, 20, 10000)											
Run blocks	QW	Size	Total length	type	$\mathcal{N}$	$\mathcal{V}$	$\mathcal{C}$	$\mathcal{V}$	$\mathcal{C}$	$\mathcal{V}$	$\mathcal{C}$
1001	16100	1001	17		550	550					
	81006	2303	0		2303						
	10006	2655	0		2655						
1002	21306	5581	17		5581	452					
	41306	2303	0		2303						
	41306	2655	0		2655						
1503	81306	1603	17		803	803					

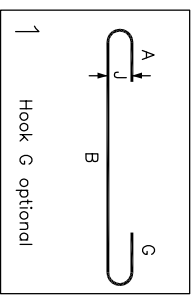

DRAWING REVIEW			
This review of this drawing does not in any way relieve the contractor of responsibility for the accuracy or for compliance with the contract documents.			
No comment	☒	See comment	
Amend & Resubmit	☐	Rejected	
		See Remarks	
Submission No.		19066	
Project No.		MB	
By			
Date		10 Nov 2021	
JABLONSKY, AST AND PARTNERS			
Consulting Engineers			
1239 Leslie Street Dot Mills, Ont. M3C 2K5			

ADDENDUM NO.	
Project No.	19066
By	MB
Date	10 Nov 2021

JABLONSKY, AST AND PARTNERS
 Consulting Engineers
 1129 Leslie Street Don Mills, Ont. M3C 2K5

* ELEVATIONS AND DIMENSIONS SHOWN ARE FOR VERIFICATION PURPOSES ONLY AND ARE NOT TO BE USED FOR CONSTRUCTION

* ALL CONFIRMS/VERIFIES WILL BE ASSUMED CORRECT AND APPROVED AS IS UNLESS COMMENTED ON THE APPROVAL DRWGS

[illegible][illegible]

FORESTSIDE TOWNHOUSES -BRAampton, ON	
PART OF STRUCTURE	
ELEVATOR ROOF SLAB & CURBS P#2	
ARCHITECT/OWNER:	Project no. 2177
ROYAL PINE HOMES	SCALE AS SHOWN
PREPARED BY: AJ CHECKED BY:	DRAWING NO.
S&B LIST No.	R15.0B

