



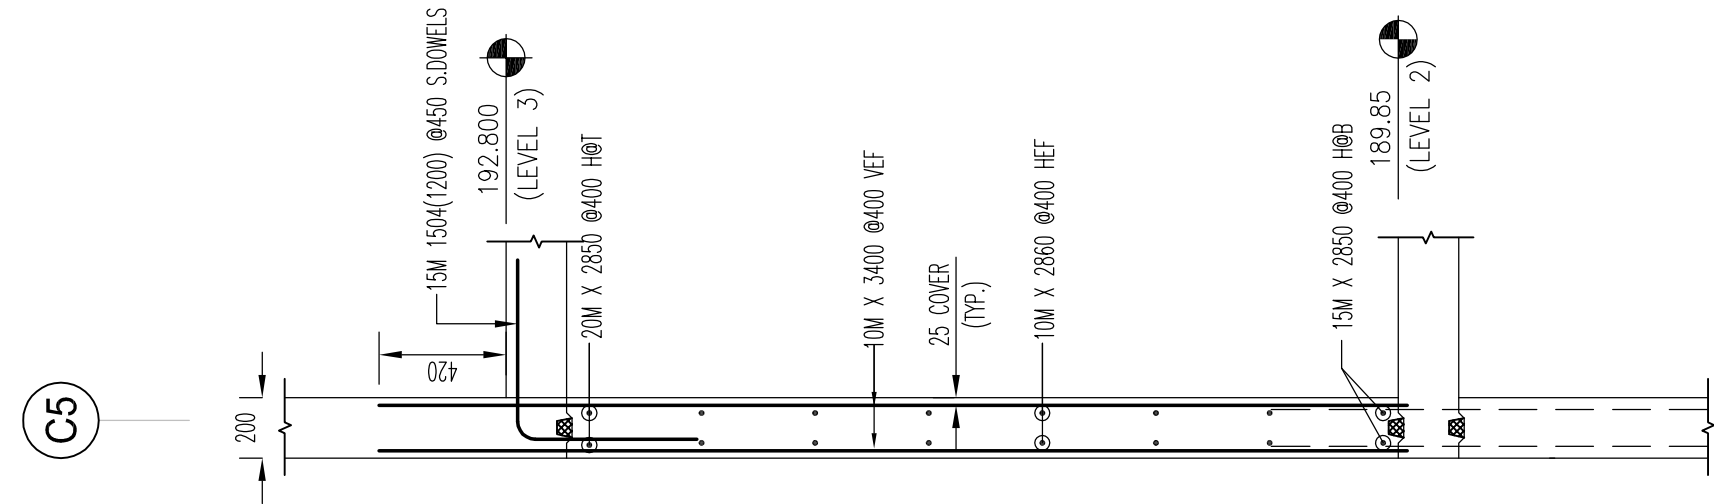

SCALE: 1:25

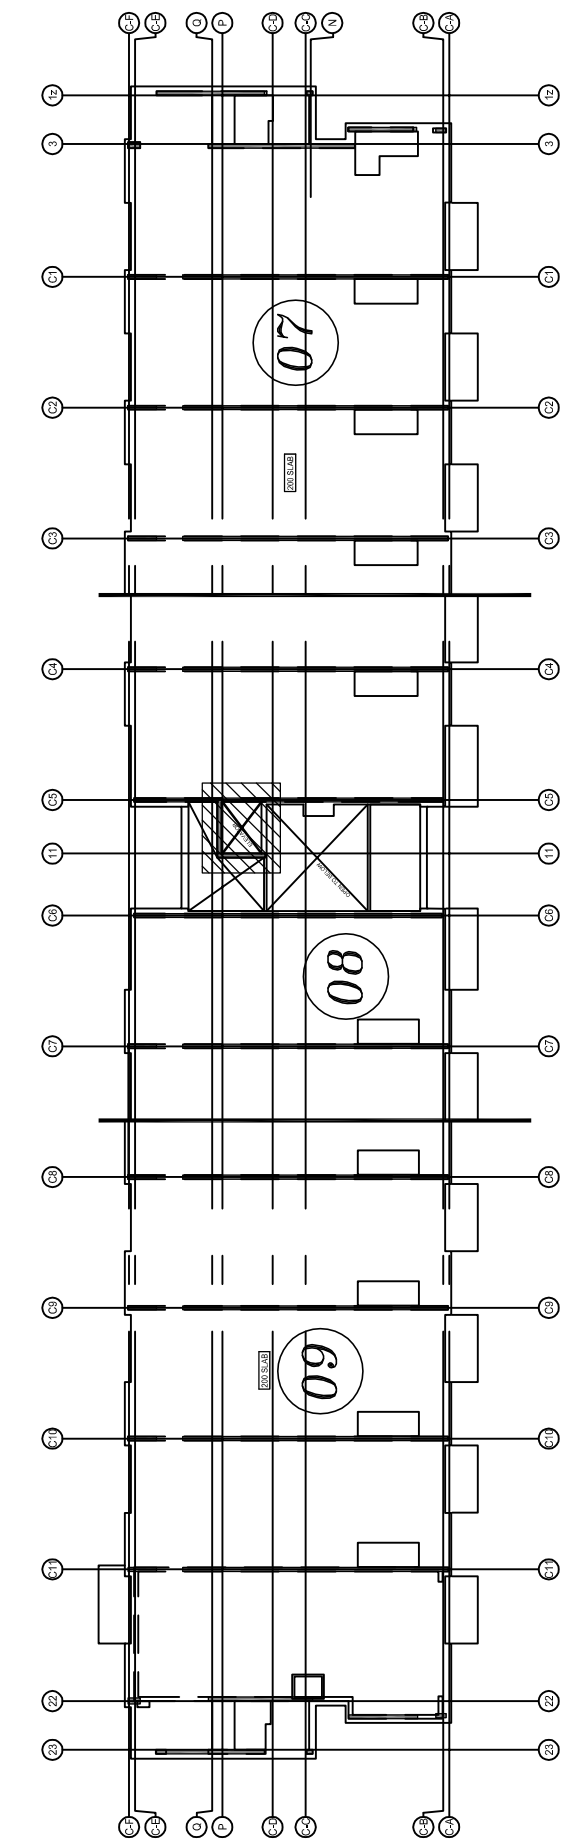

Submission No.	
Project No.	19066
By	MB
Date	01 Dec 2021

TENSION LAP SPLICE (L.S) & DEVELOPMENT LENGTH (Ld)

BAR SIZE	CR = 25			CR = 30			CR = 35		
	L	S	Ld	L	S	Ld	L	S	Ld
10M	490	380	450	350	420	320			
15M	740	570	670	520	620	480			
20M	980	750	890	690	830	640			
25M	1530	1170	1390	1070	1290	990			
30M	1830	1410	1670	1290	1550	1190			
35M	2130	1640	1950	1500	1800	1390			

4. COMPRESSION LAP SPLICE

BAR SIZE	STANDARD LAP (mm)
10M	300
15M	440
20M	590
25M	730
30M	880
35M	1030

2, STRENGTH OF CONCRETE
35MPa - INTERIOR COLUMNS & WALLS

3, CONCRETE COVER:
VERTICALS

— 25mm

LEGEND	ALF	ALTERNATE	EF	EF	FAIR FACE	OF	OUTSIDE FACE
BUT	BUT	BUT INTO SLAB	FG	FG	FAIR FACE	OC	OUTSIDE CUT END
BIS	BIS	CORNER BAR	GH	GH	GRIND IN DOWELS	STG	STAGGER
CON	CON	CONTROL JOINT	GJ	GJ	HORIZONTAL	STIR	STIRRUPS
CJS	CJS	CUT SITE COND.	IL	IL	INSIDE FACE	T	TOP
DOW	DOW	DOWELS	LL	LL	LOWER LAYER	THR/1=	THREAD 1 END
EAC	EAC	EACH END	MD	MD	MIDDLE	THR/2=	THREAD 2 END
EE	EE	EACH FACE	MIN	MIN	MINIMUM	UL	UPPER LAYER
EF	EF	EXPANDED JOINT	NF	NF	NEAR FACE	U/L	UPPER LAYER NOTED
ES	ES	EACH SIDE	OC	OC	ON CENTER	V	VERTICAL
EW	EW	EACH WAY	NC	NC	NEAR CENTER	T	TEMP. TIES




STRAIGHT BARS LABEL FORMAT	7 B15M X 3600 GRADE SIZE LENGTH QUANTITY	BENT BARS LABEL FORMAT	7 B15M B1501 GRADE SIZE BEND MARK SHAPE QUANTITY	GRADES OF STEEL B = GRADE 400R E = EPOXY COATED C = CRP G = GALVANIZED S = STAINLESS W = WELDABLE
--	---	--------------------------------------	---	--

<	<	<	<

NO	FOR APPROVAL	DATE	BY
0	ISSUE		
MANSTEEL  REBAR		REMARKS MANSTEEL REBAR 105 Industrial Road, Richmond Hill, Ontario L4C 2V4 Canada Phone: 905-737-9797 Fax: 905-737-9704 Email: info@mansteelrebar.com	

PROJECT
FORESTSIDE TOWNHOUSES
-BRAMPTON, ON

PART OF STRUCTURE ELEVATOR SHEAR WALLS - L2-L3 P#8	CUSTOMER : ROYAL PINE HOMES	Project no. 2177	SCALE: AS SHOWN
		DRAWING No.	
BAR LIST No.	REBAR BY: AJ	R10.9	
CHECKED BY:	0		

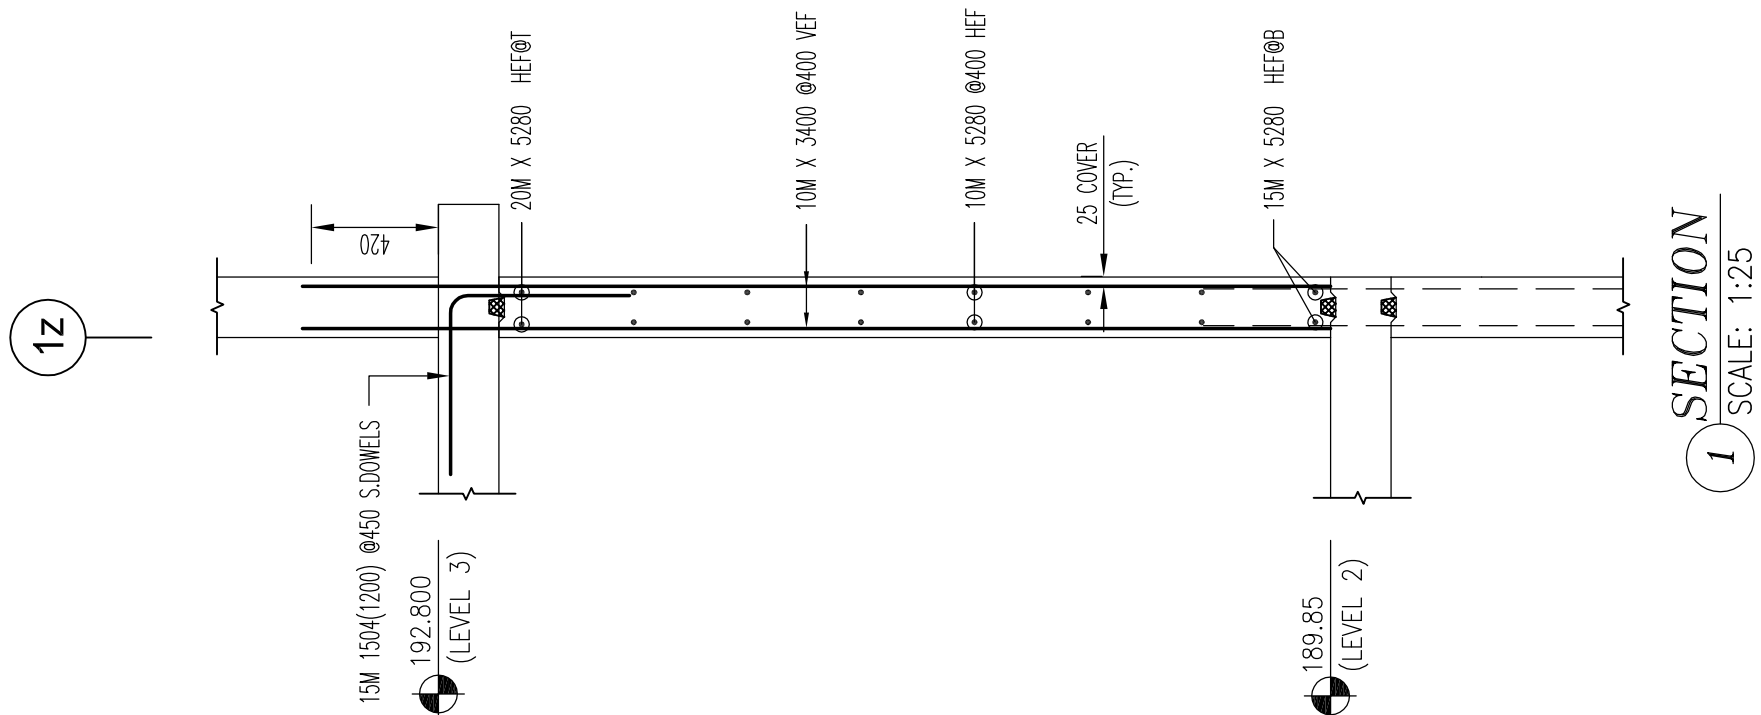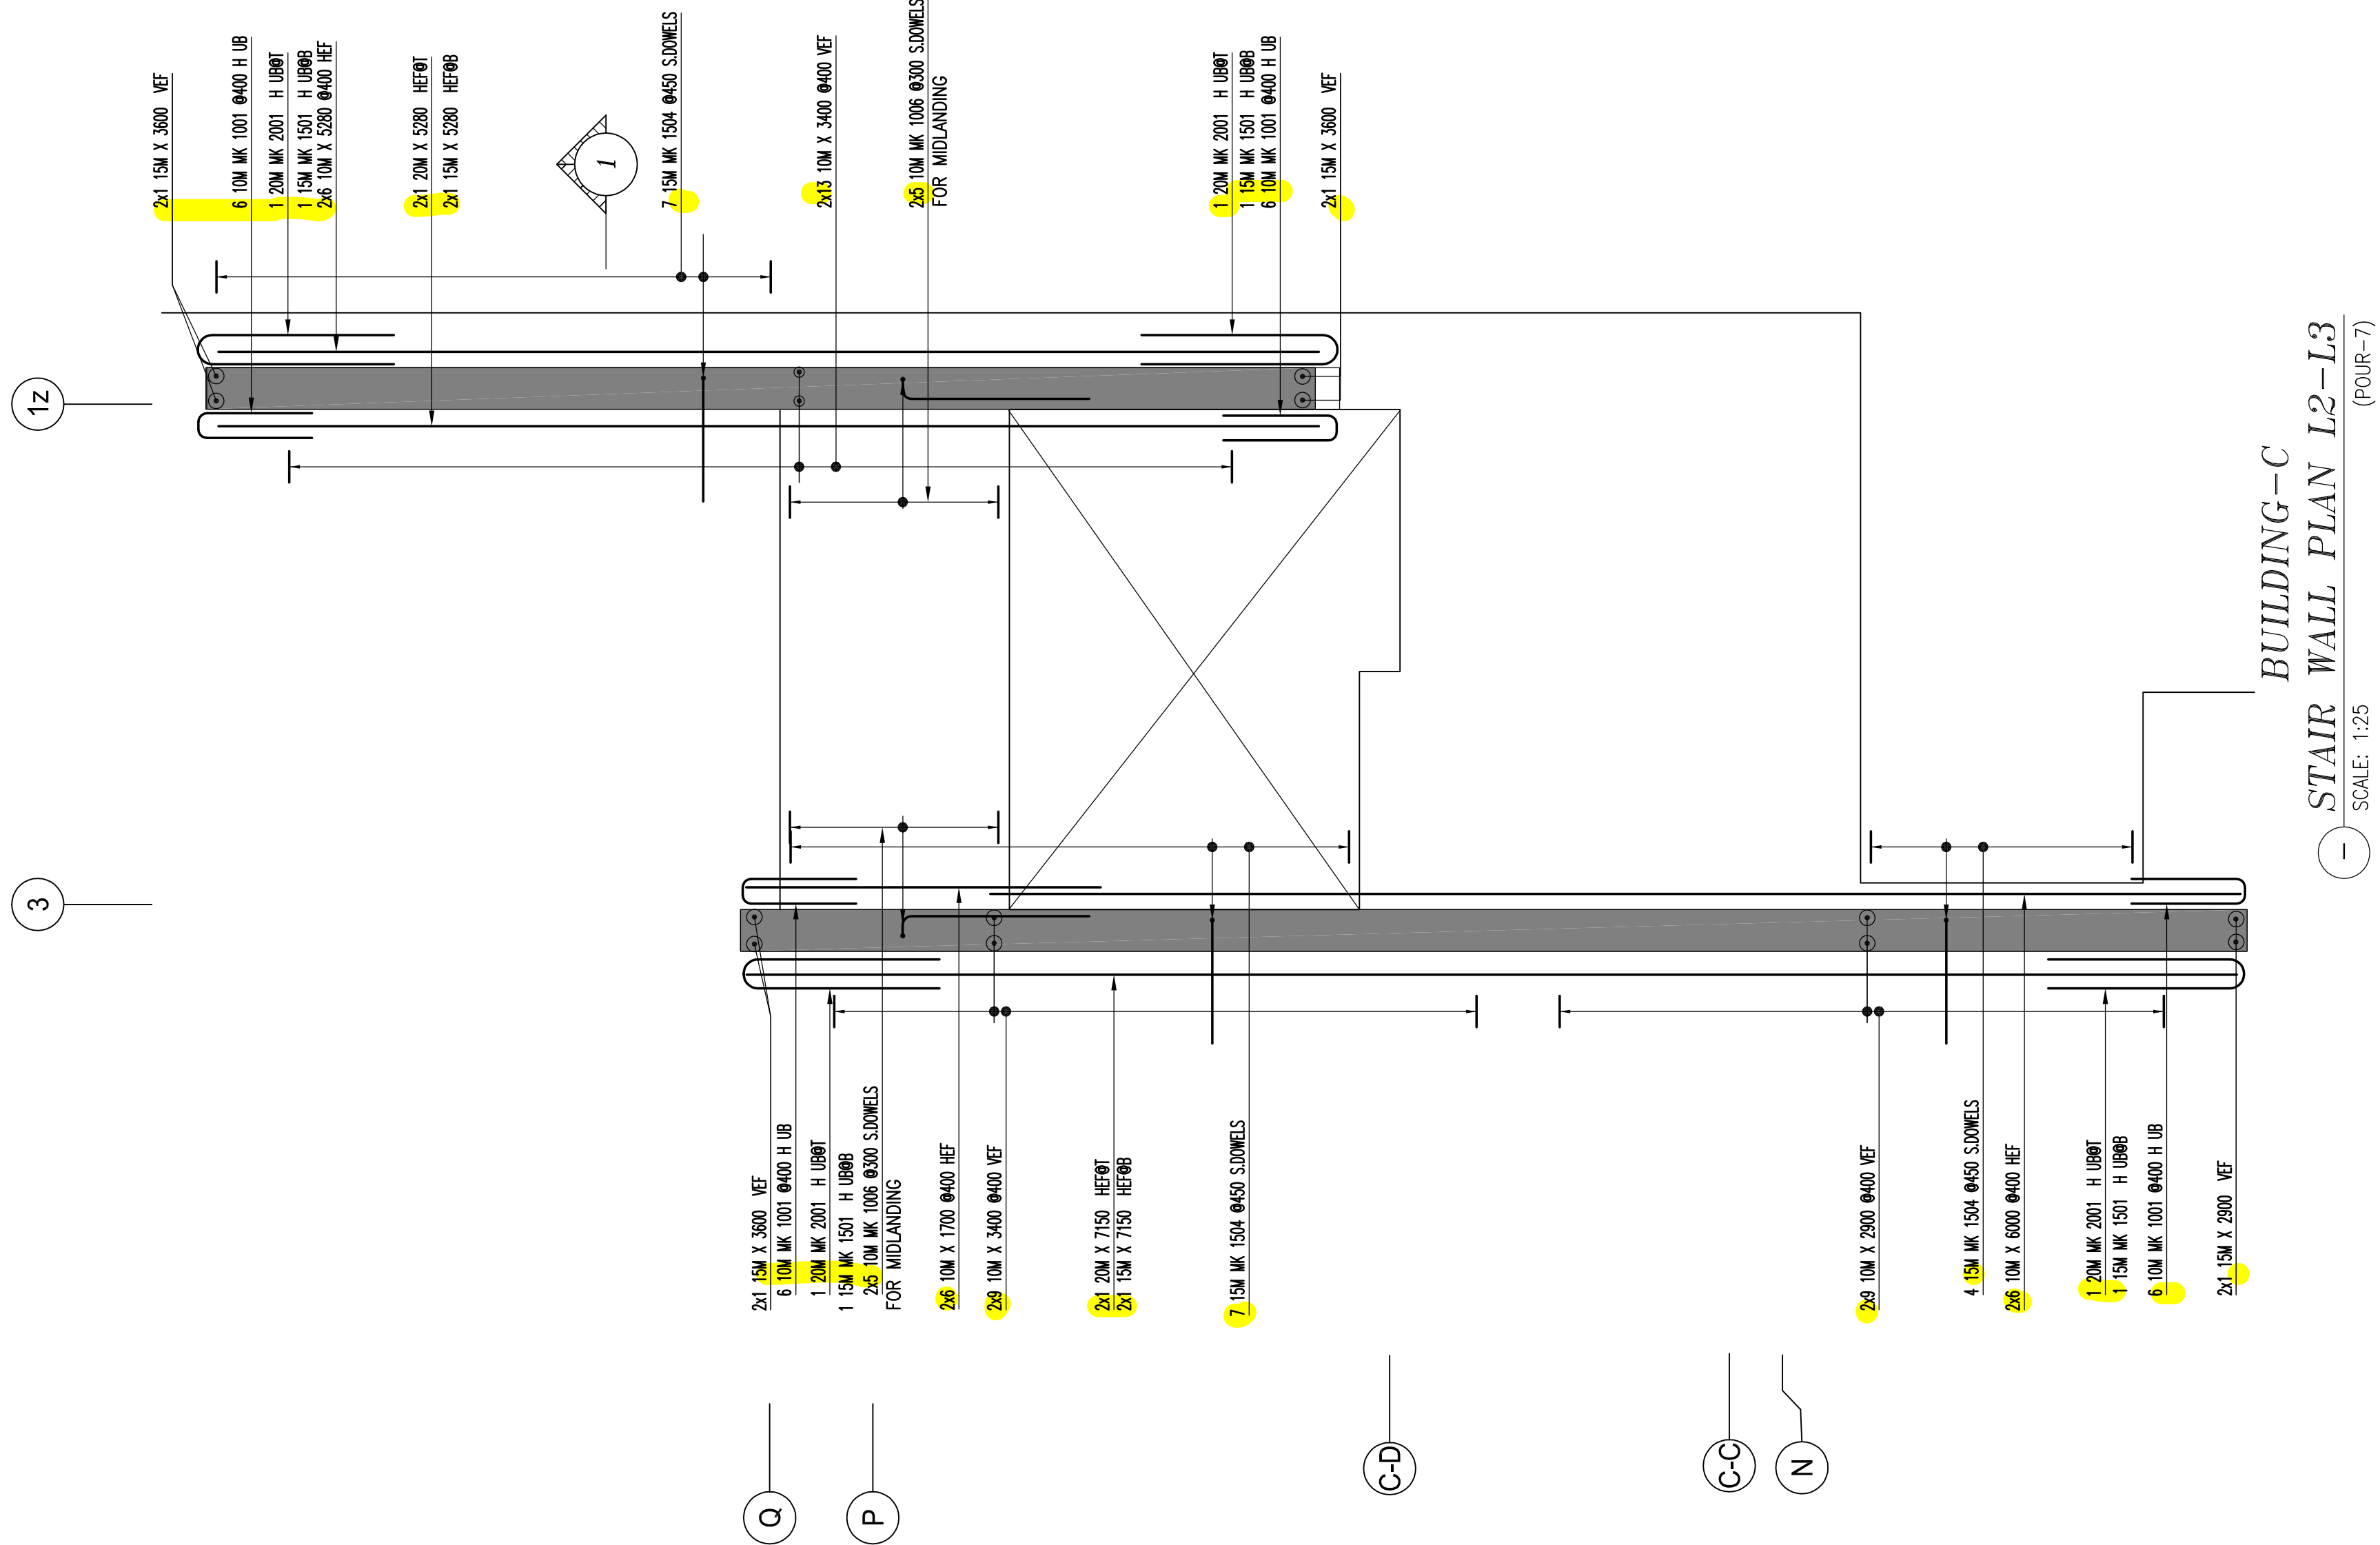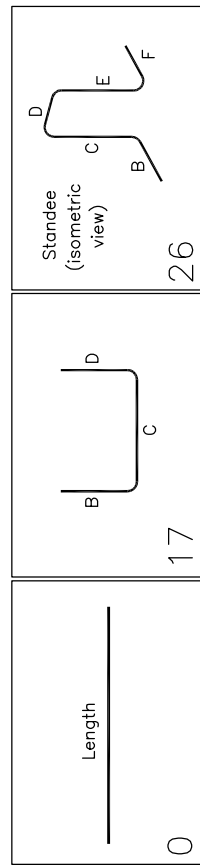[illegible]

DRAWING REVIEW

✓	No comment	See comment
	Amend & Resubmit	Rejected See Remarks

Submission No.	
Project No.	19066
By	MB
Date	01 Dec 2021

JABLONSKY, AST AND PARTNERS
Consulting Engineers
129 Leslie Street Don Mills, Ont. M3C 2K5

* ELEVATIONS AND DIMENSIONS SHOWN ARE FOR VERIFICATION PURPOSES ONLY AND ARE NOT TO BE USED FOR CONSTRUCTION

* ALL CONFIRMS/VERIFIES WILL BE ASSUMED CORRECT AND APPROVED AS IS UNLESS COMMENTED ON THE APPROVAL DRWGS

LEGEND	TRAIGHT RAIL LABEL FORMAT	BENT RAIL LABEL FORMAT	GRADES OF STEEL
1	2	3	4
5	6	7	8
9	10	11	12
13	14	15	16
17	18	19	20
21	22	23	24
25	26	27	28
29	30	31	32
33	34	35	36
37	38	39	40
41	42	43	44
45	46	47	48
49	50	51	52
53	54	55	56
57	58	59	60
61	62	63	64
65	66	67	68
69	70	71	72
73	74	75	76
77	78	79	80
81	82	83	84
85	86	87	88
89	90	91	92
93	94	95	96
97	98	99	100


0	FOR APPROVAL	NOV/29/21	JU
REMARKS		DATE	BY
MANSTEEL REBAR 10000 Highway 70, Richmond Hill, Ontario L4C 2Y4, Canada Phone: 905-733-9797 Fax: 905-733-9704 Email: info@mansteelrebar.com			
MANSTEEL  REBAR			

PROJECT

FORESTSIDE TOWNHOUSES
-BRAMPTON, ON

PART OF STRUCTURE
STAIR SHEAR WALLS -L2-L3 P#77

CUSTOMER : ROYAL PINE HOMES	Project no. 2177	
	SCALE: AS SHOWN	
DRAWING No.		R10.10
DETAILED BY: JU CHECKED BY:	BAR LIST No.	

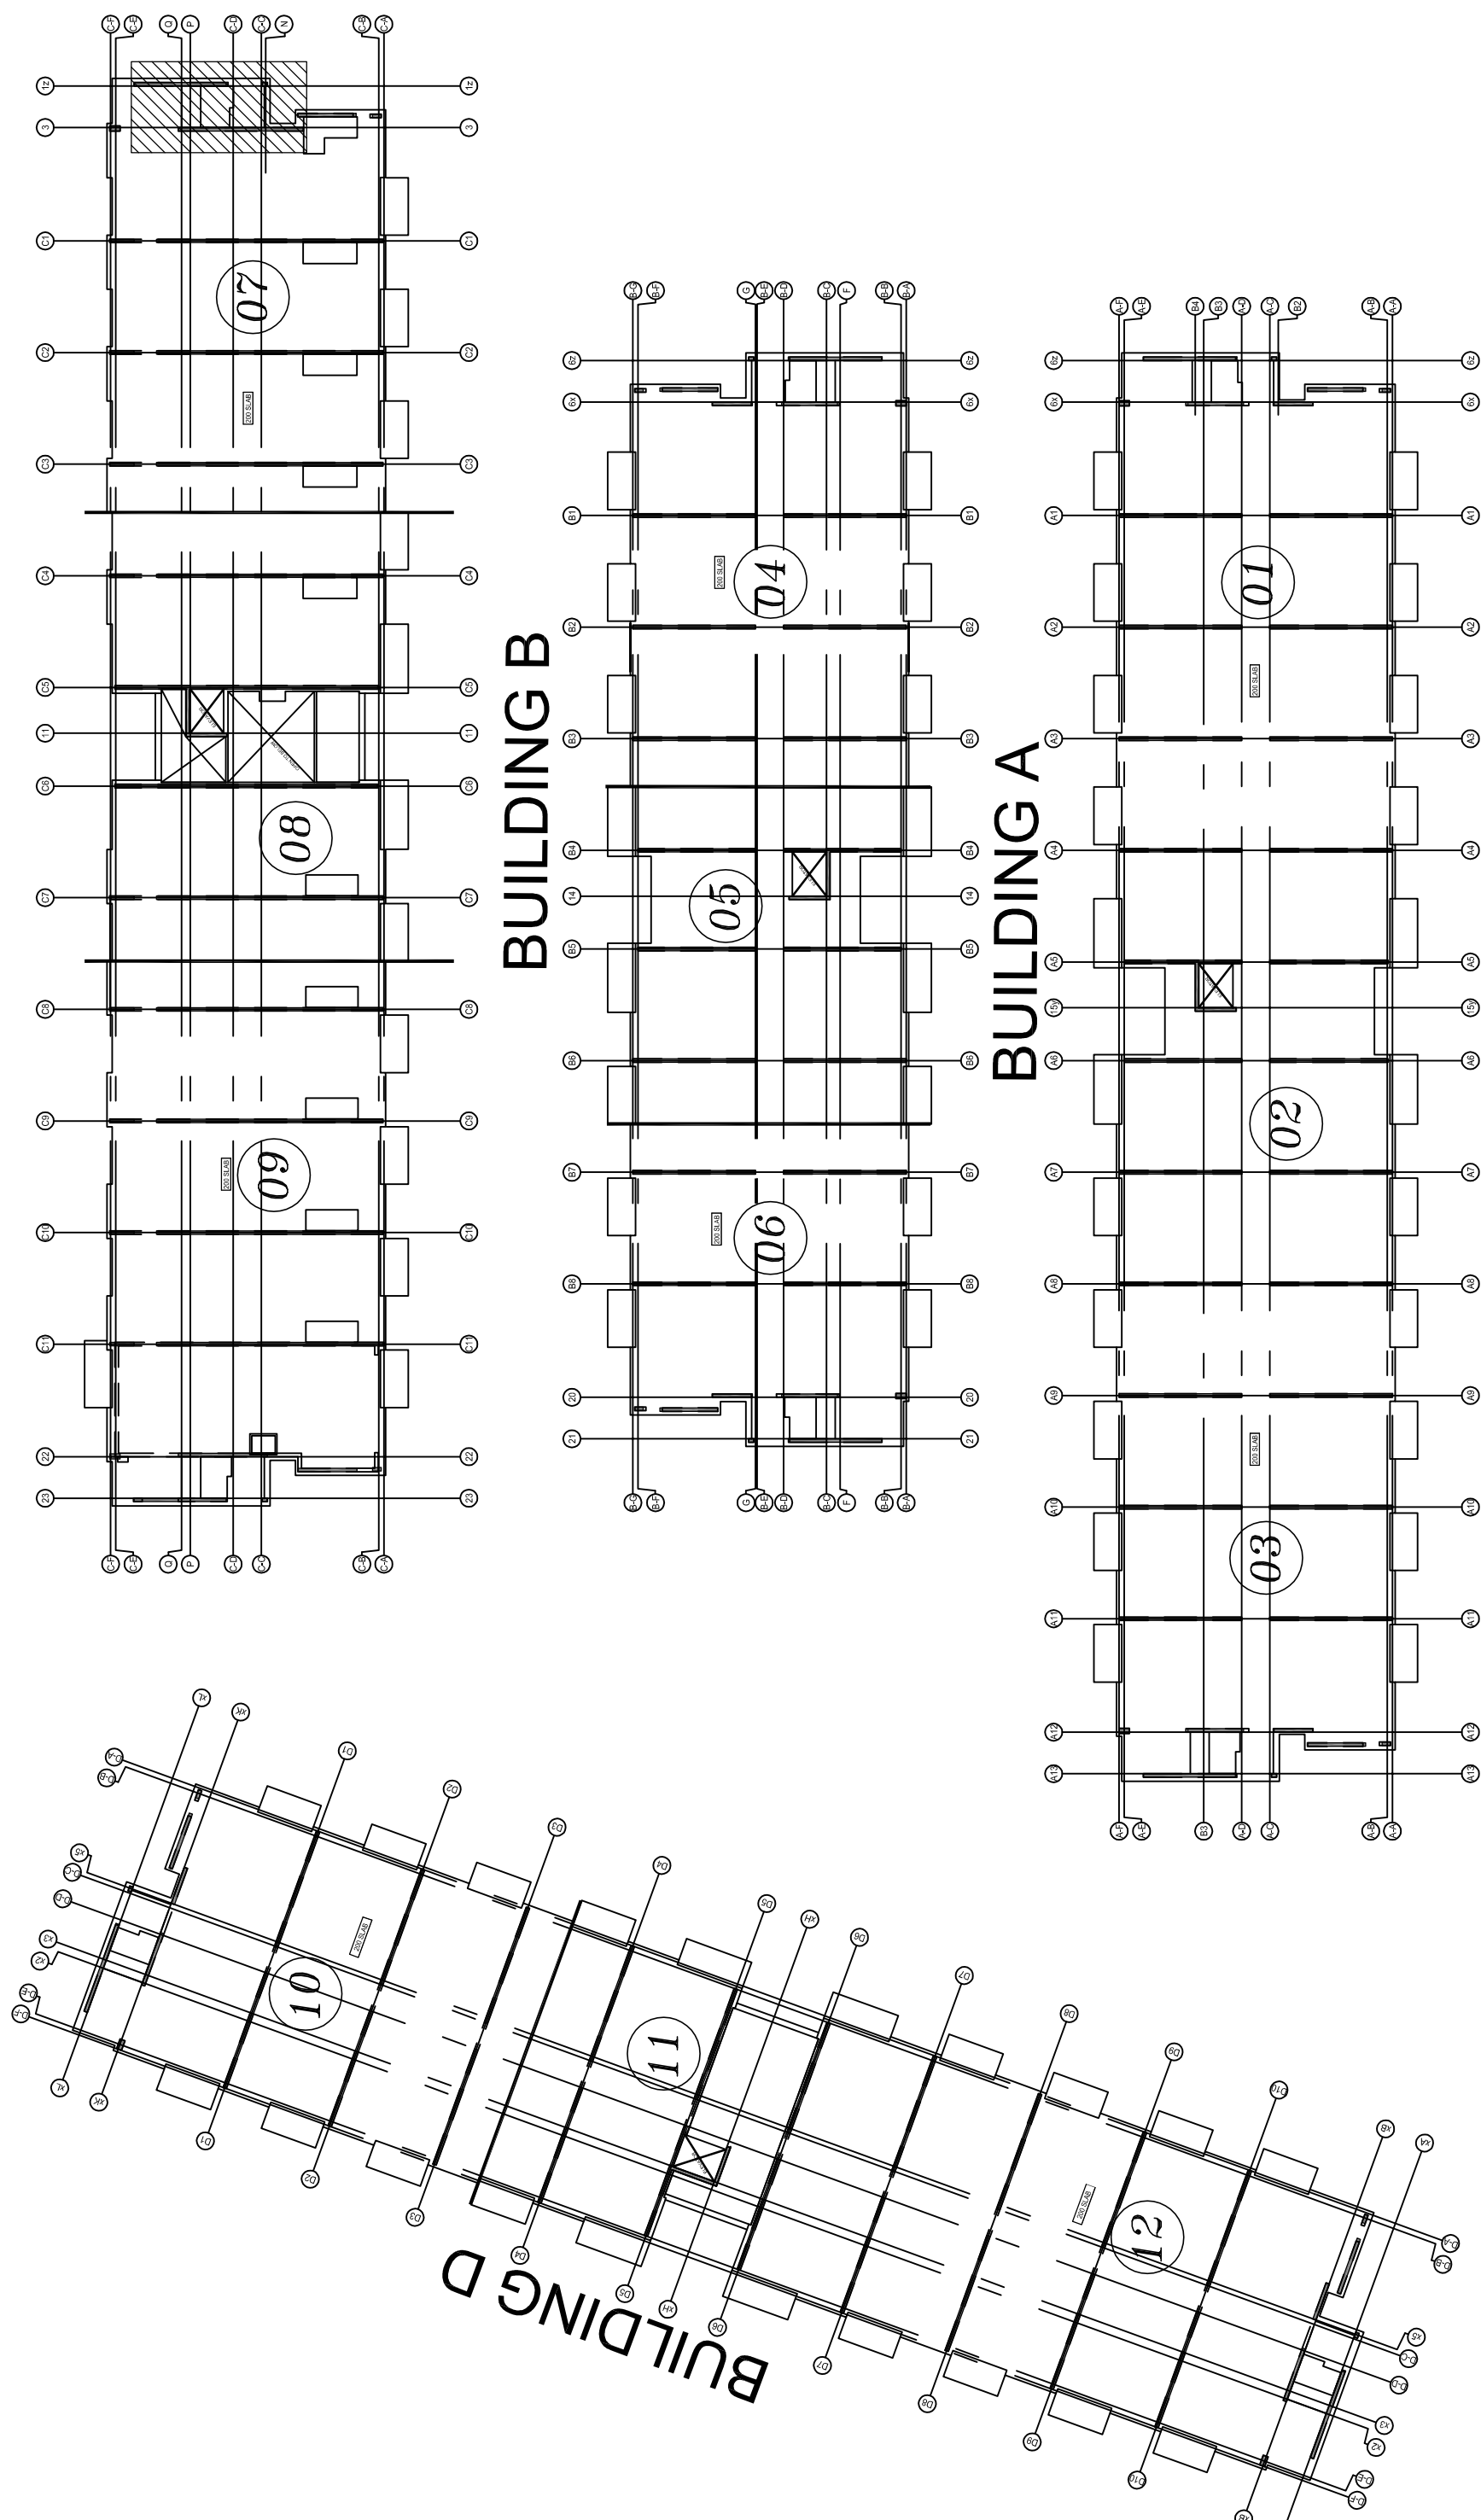

NOTES
1, ALL STEEL TO BE GRADE 400W







2, STRENGTH OF CONCRETE 35MPa – INTERIOR COLUMNS & WALLS

3, CONCRETE COVER:
VERTICALS

— 25mm

BAR SIZE	fc=25		fc=30		fc=35	
	L.S.	L.d	L.S.	L.d	L.S.	L.d
10M	490	380	450	350	420	320
15M	740	570	670	520	620	480
20M	980	750	890	690	830	640
25M	1530	1170	1390	1070	1290	990
30M	1830	1440	1670	1290	1350	1190
35M	2130	1640	1950	1500	1800	1390

BAR SIZE	STANDARD LAP (mm)
10M	300
15M	440
20M	590
25M	730
30M	880
35M	1030

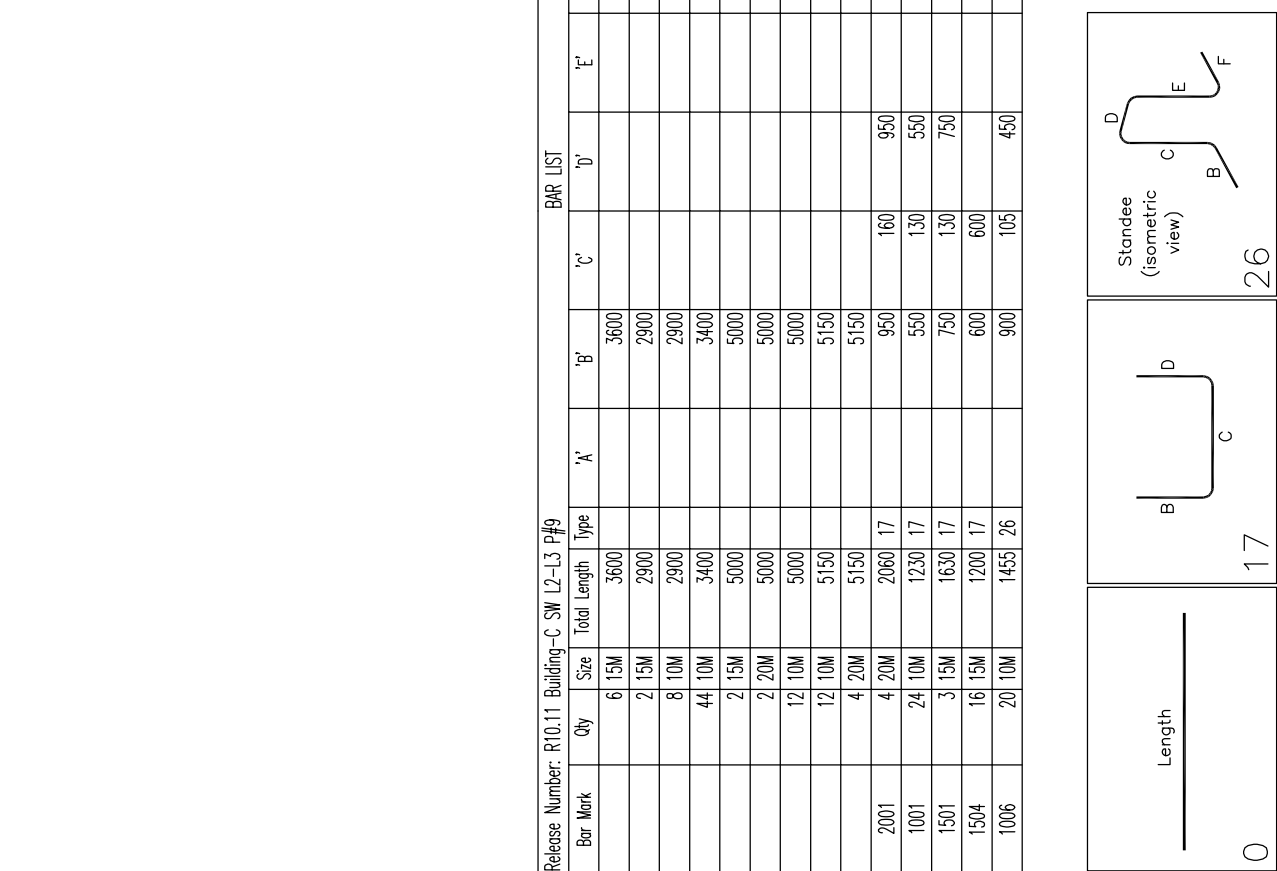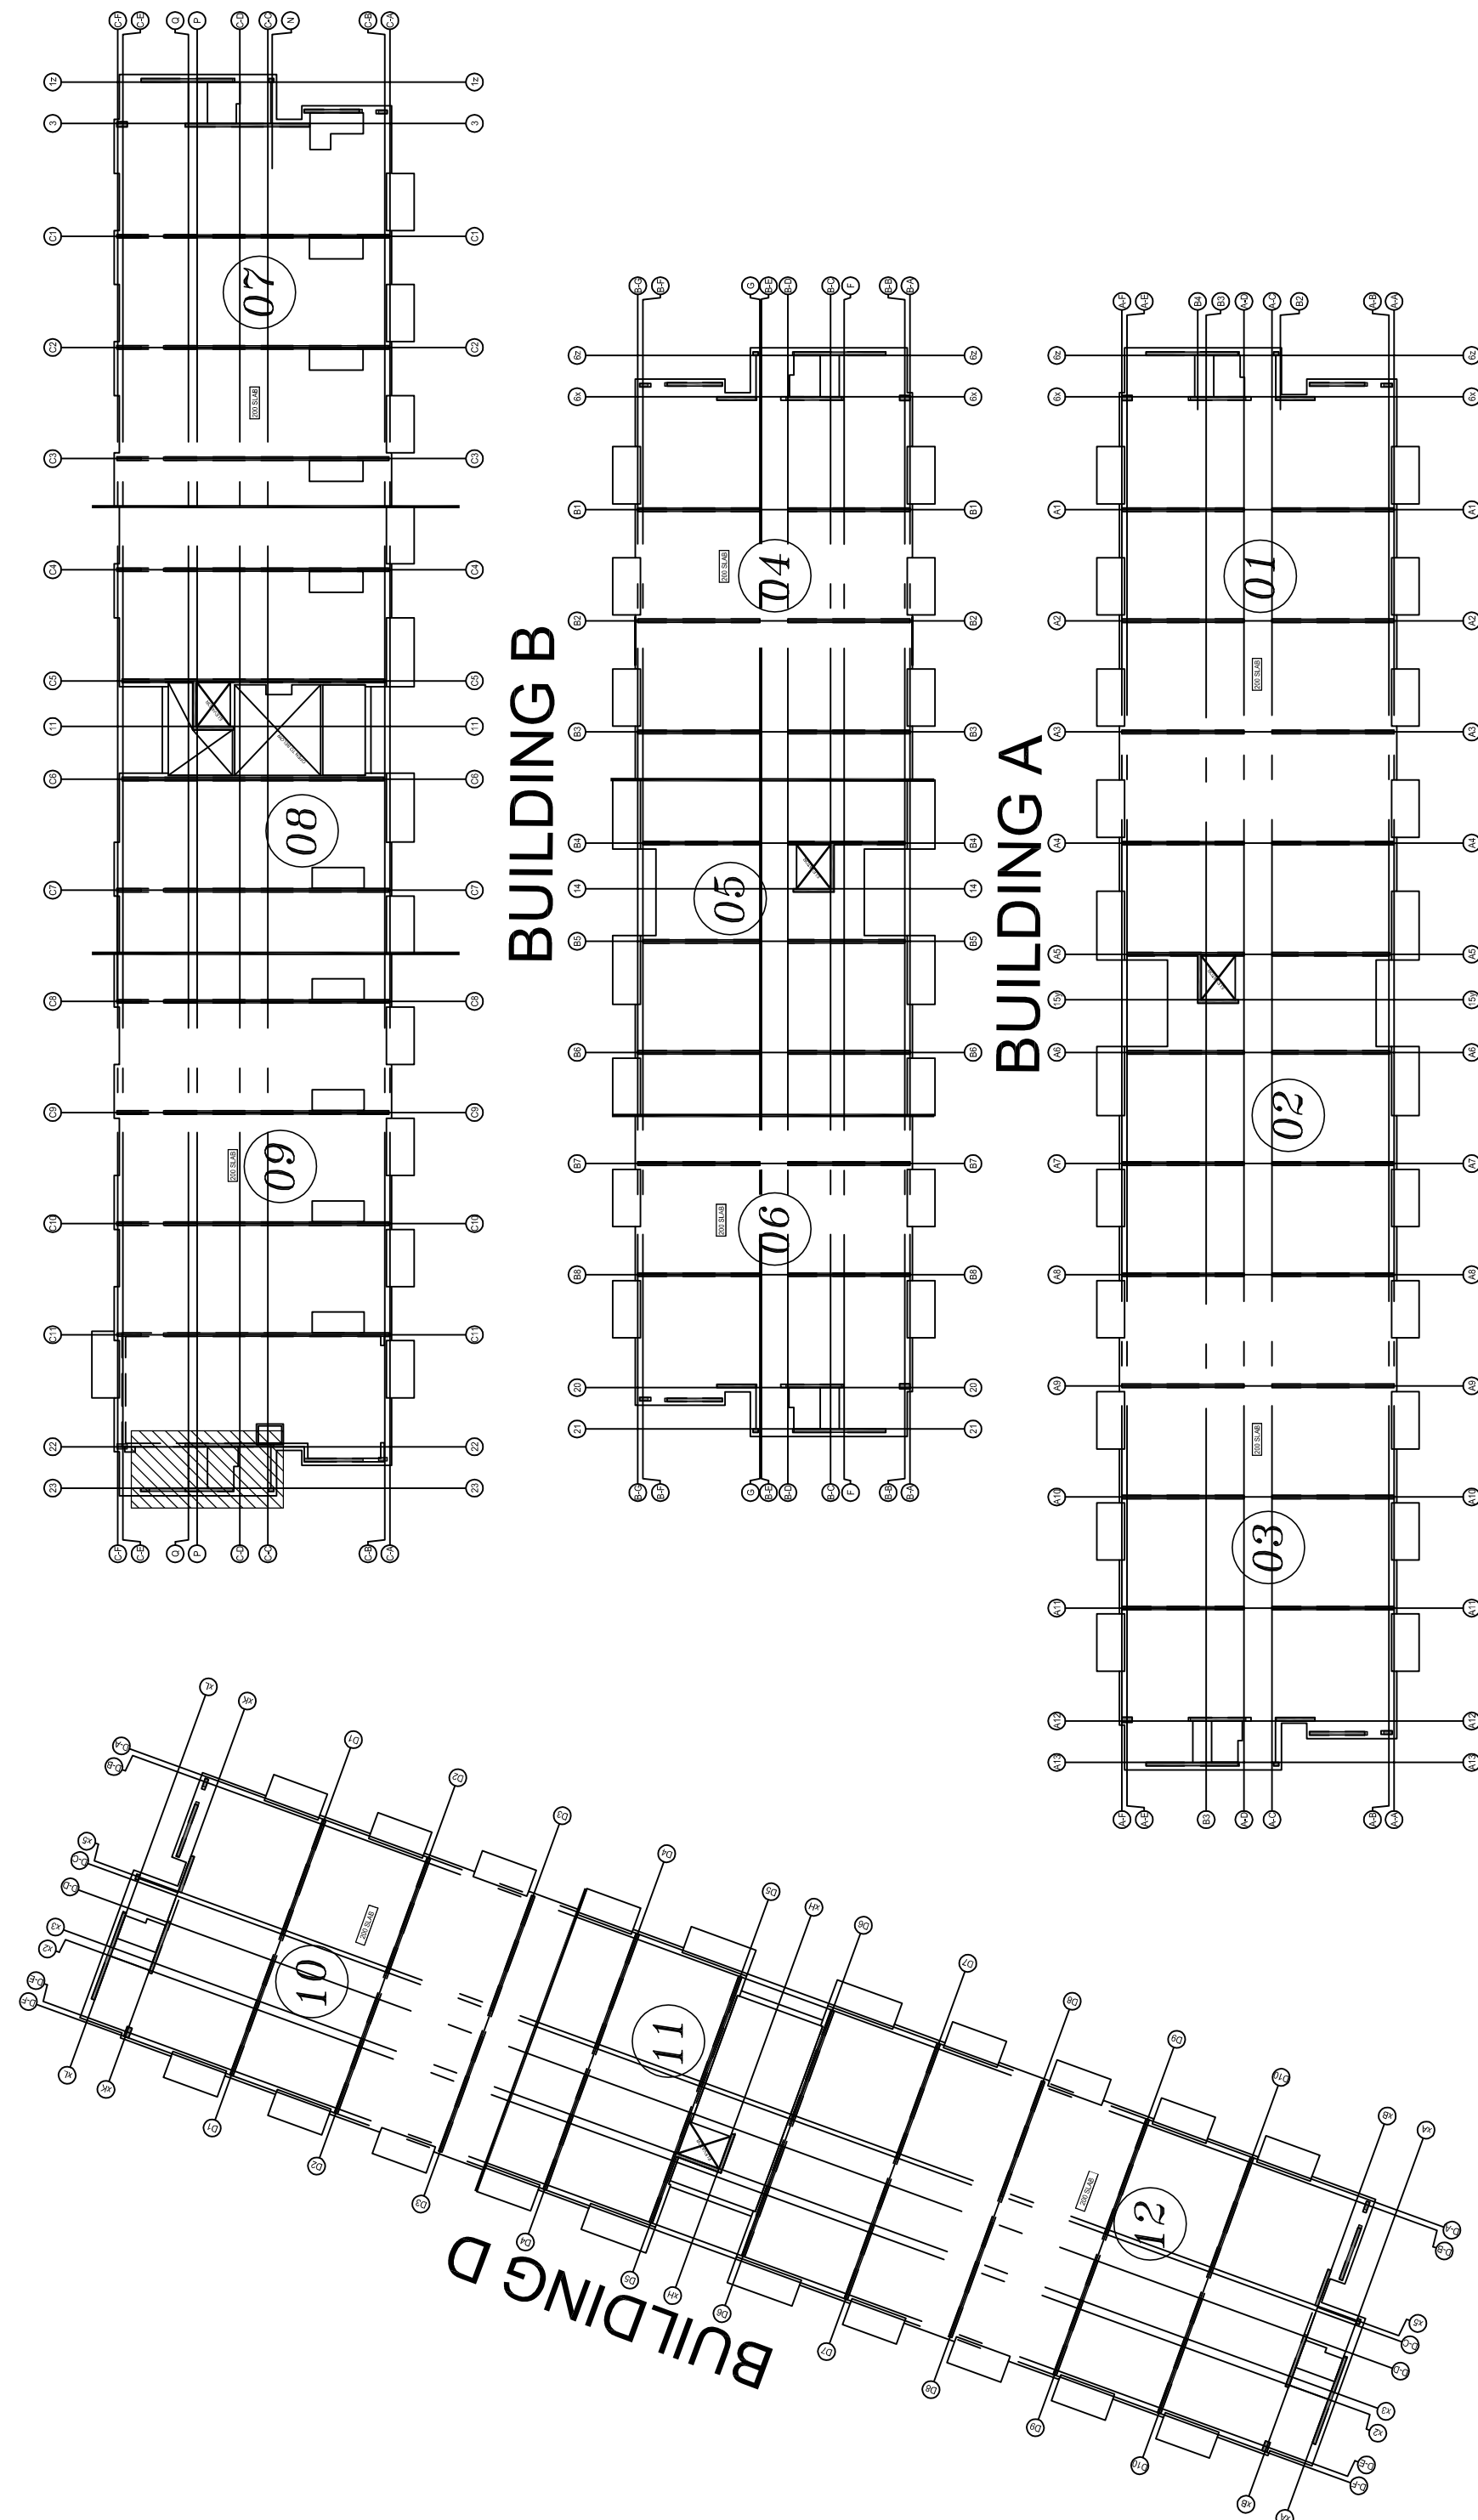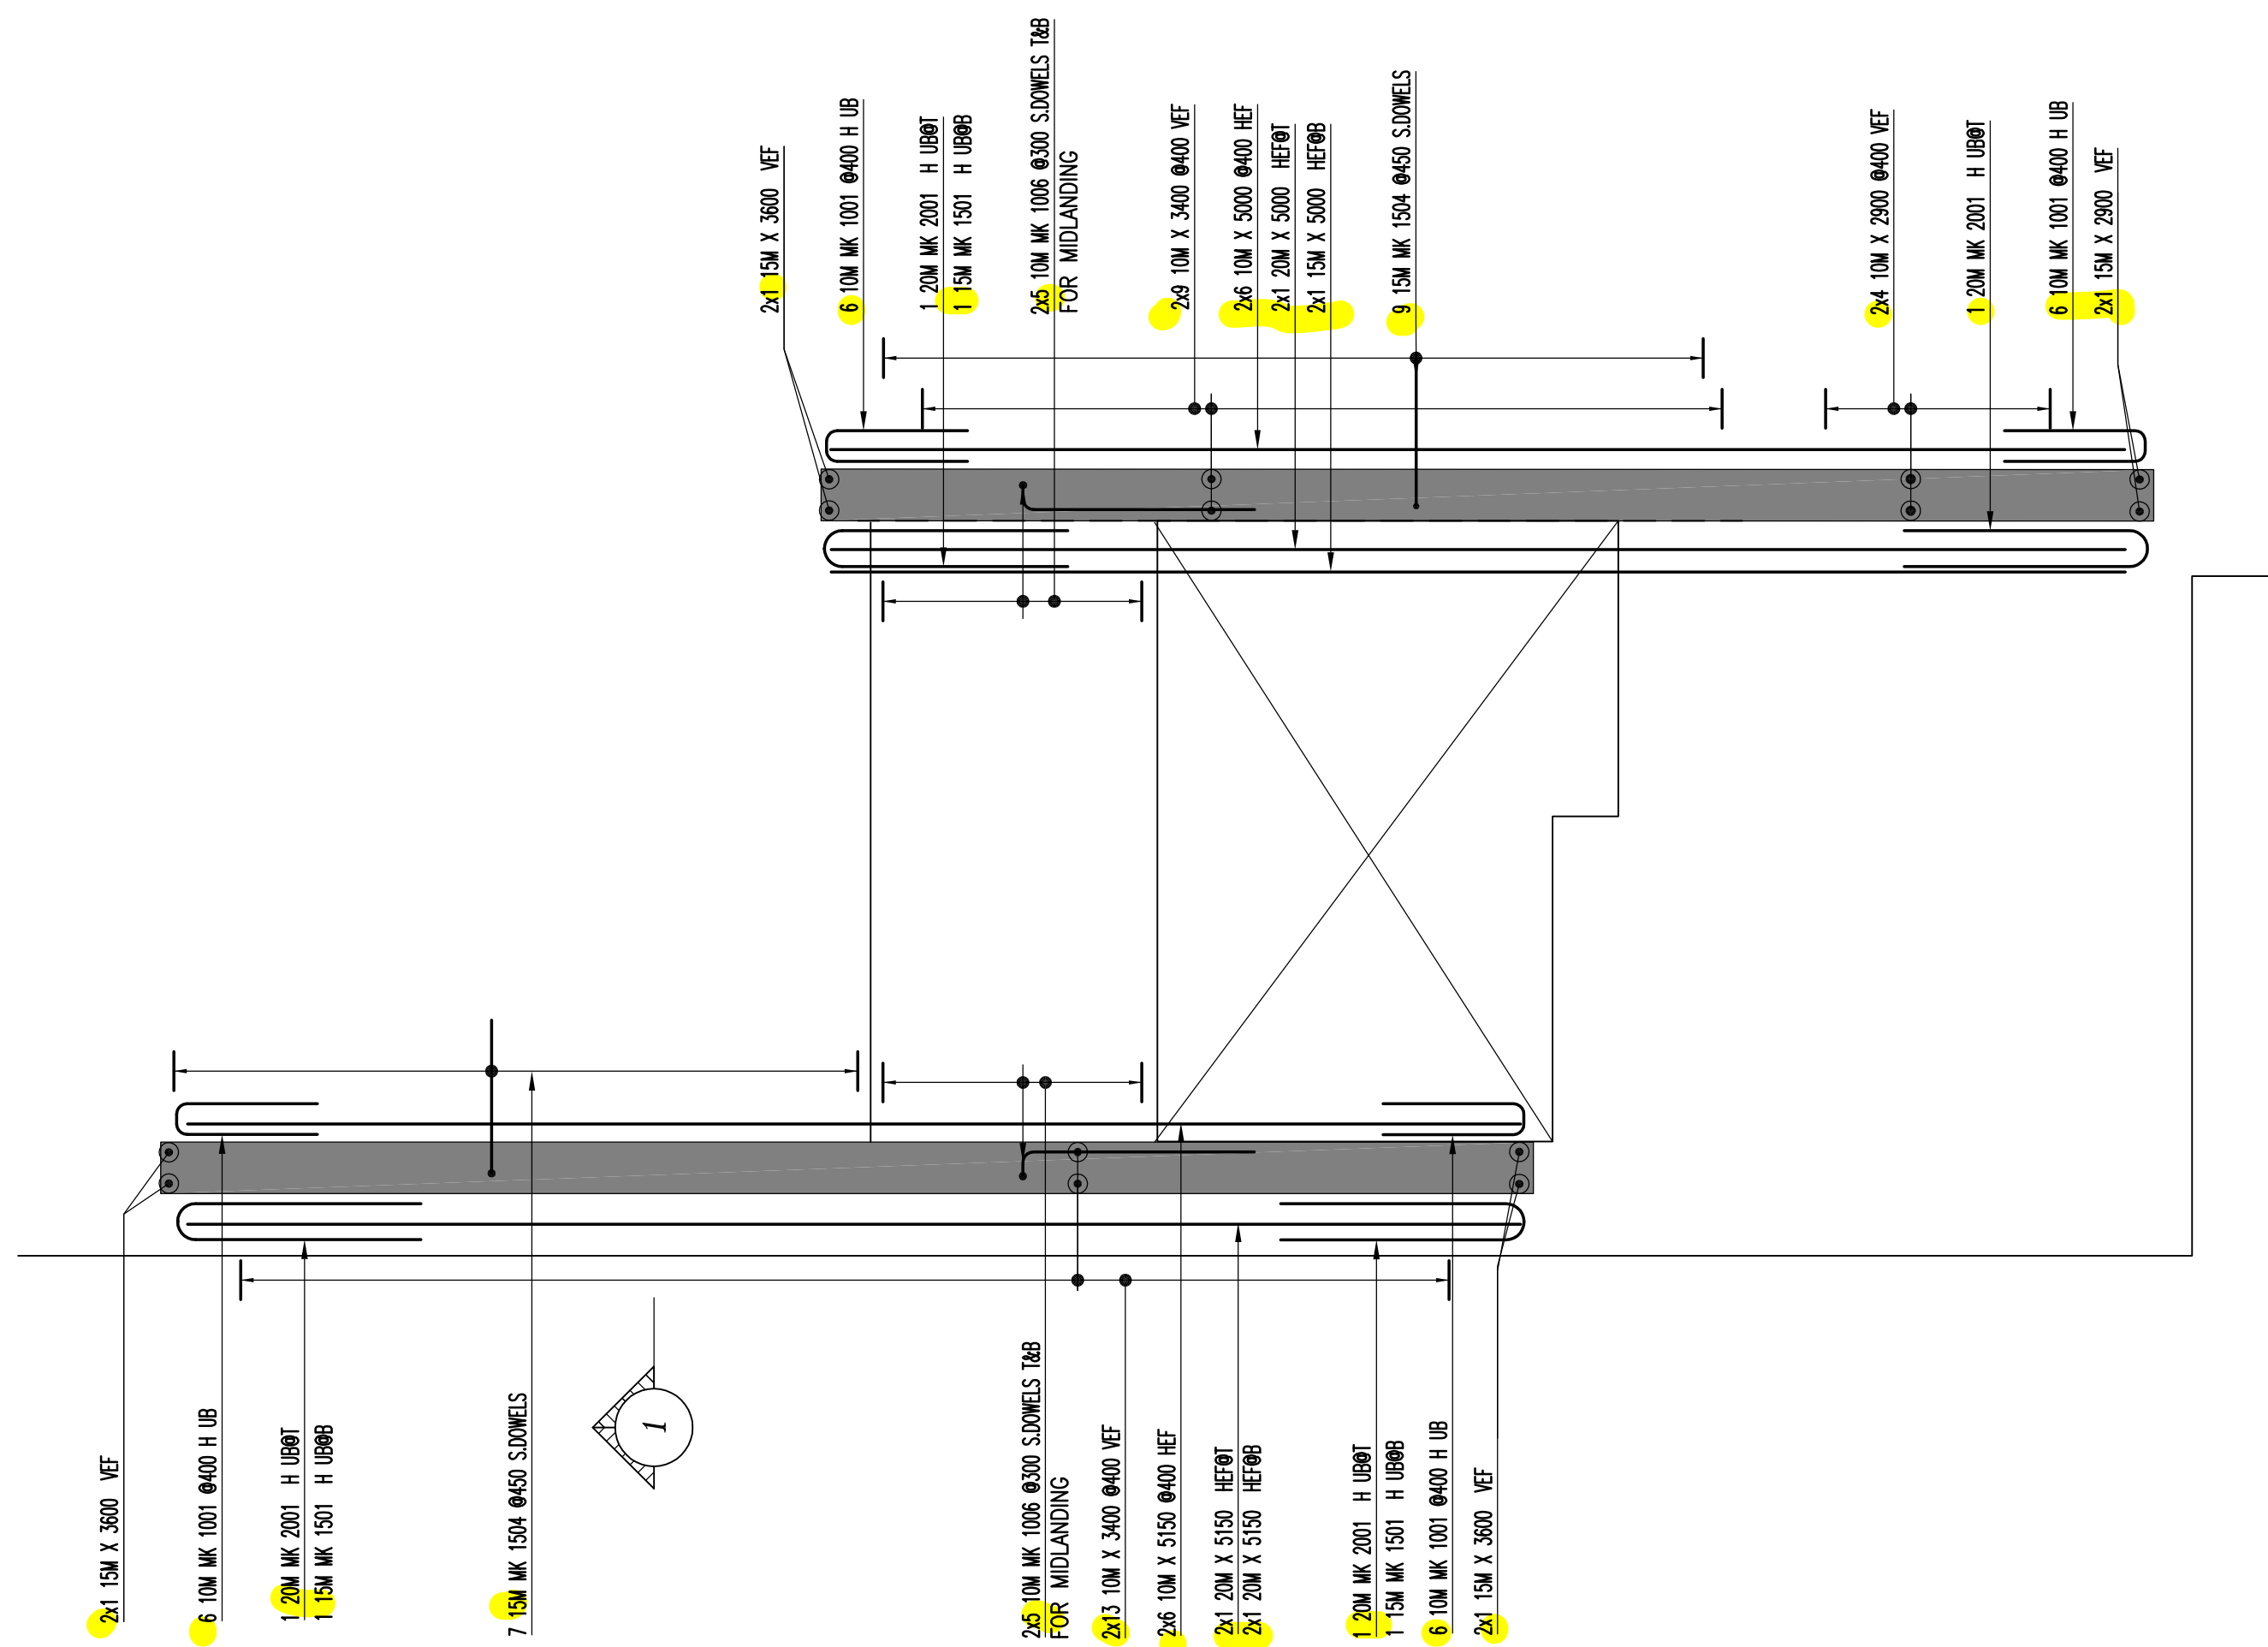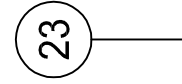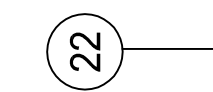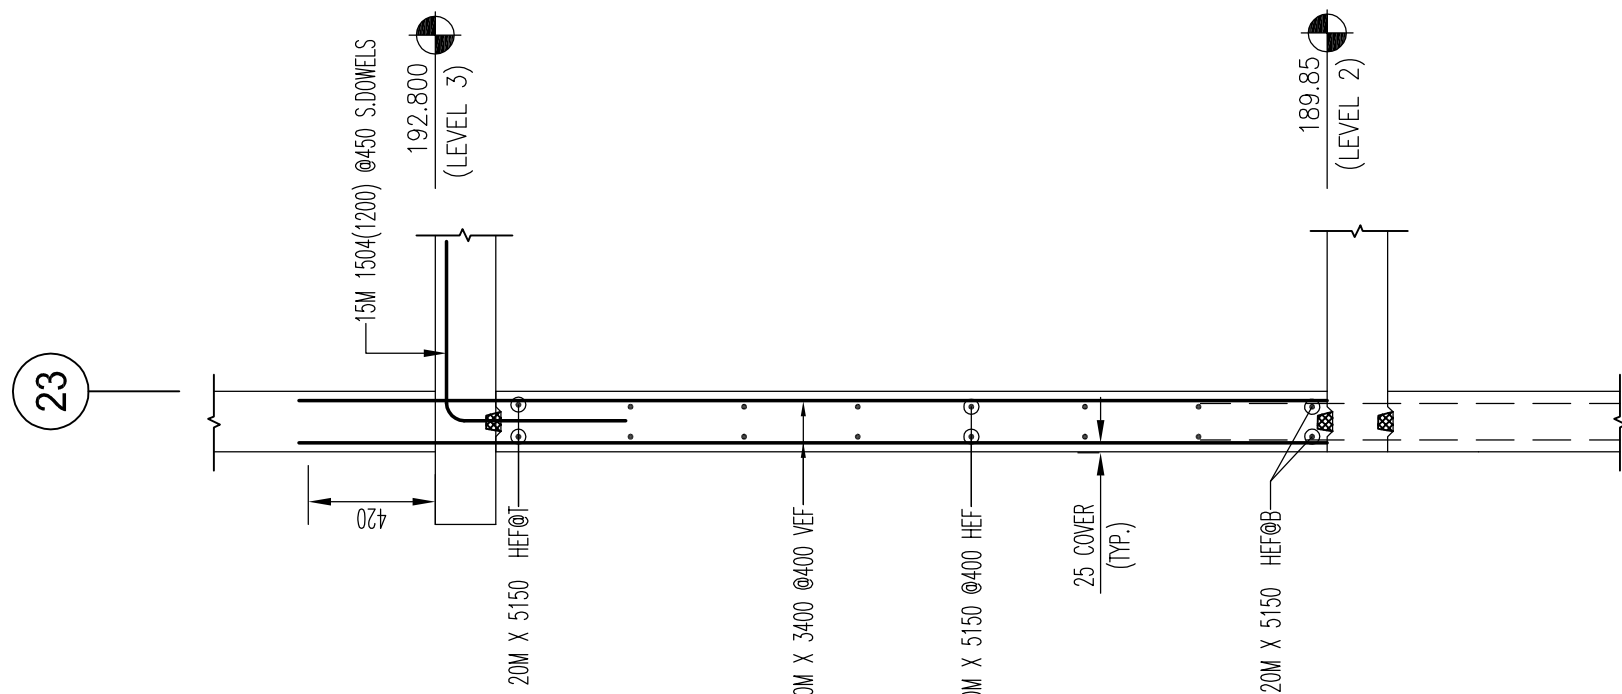[illegible]

☒	No comment	See comment
☐	Amend & Resubmit	Rejected See Remarks

Submission No.	
Project No.	19066
By	MB
Date	01 Dec 2021

JABLONSKY, AST AND PARTNERS
Consulting Engineers
1129 Leslie Street Don Mills, Ont. M3C 2K5

- * ELEVATIONS AND DIMENSIONS SHOWN ARE FOR VERIFICATION PURPOSES ONLY AND ARE NOT TO BE USED FOR CONSTRUCTION
- * ALL CONFIRMS/VERIFIES WILL BE ASSUMED CORRECT AND APPROVED AS IS UNLESS COMMENTED ON THE APPROVAL DWGMS

[illegible][illegible]

ISSUE	REMARKS	DATE	BY
0	FOR APPROVAL	NOV/29/21	JJ

MANSTEEL REBAR
105 Industrial Road, Richmond Hill,
Ontario L4C 2Y4 Canada
Phone: 905-737-9797
Fax: 905-737-9704
Email: info@mansteelrebar.com

PROJECT
FORESTSIDE TOWNHOUSES
-BRAMPTON, ON

PART OF STRUCTURE
STAIR SHEAR WALLS -L2-L3 P#9


CUSTOMER :	ROYAL PINE HOMES		BAR LIST NO.	DRAWING No. R10.11
Project no.	2177			
SCALE	AS SHOWN			

NOTES
1, ALL STEEL TO BE GRADE 400W


2, STRENGTH OF CONCRETE
35MPa - INTERIOR COLUMNS & WALLS

3, CONCRETE COVER:
VERTICALS

— 25mm

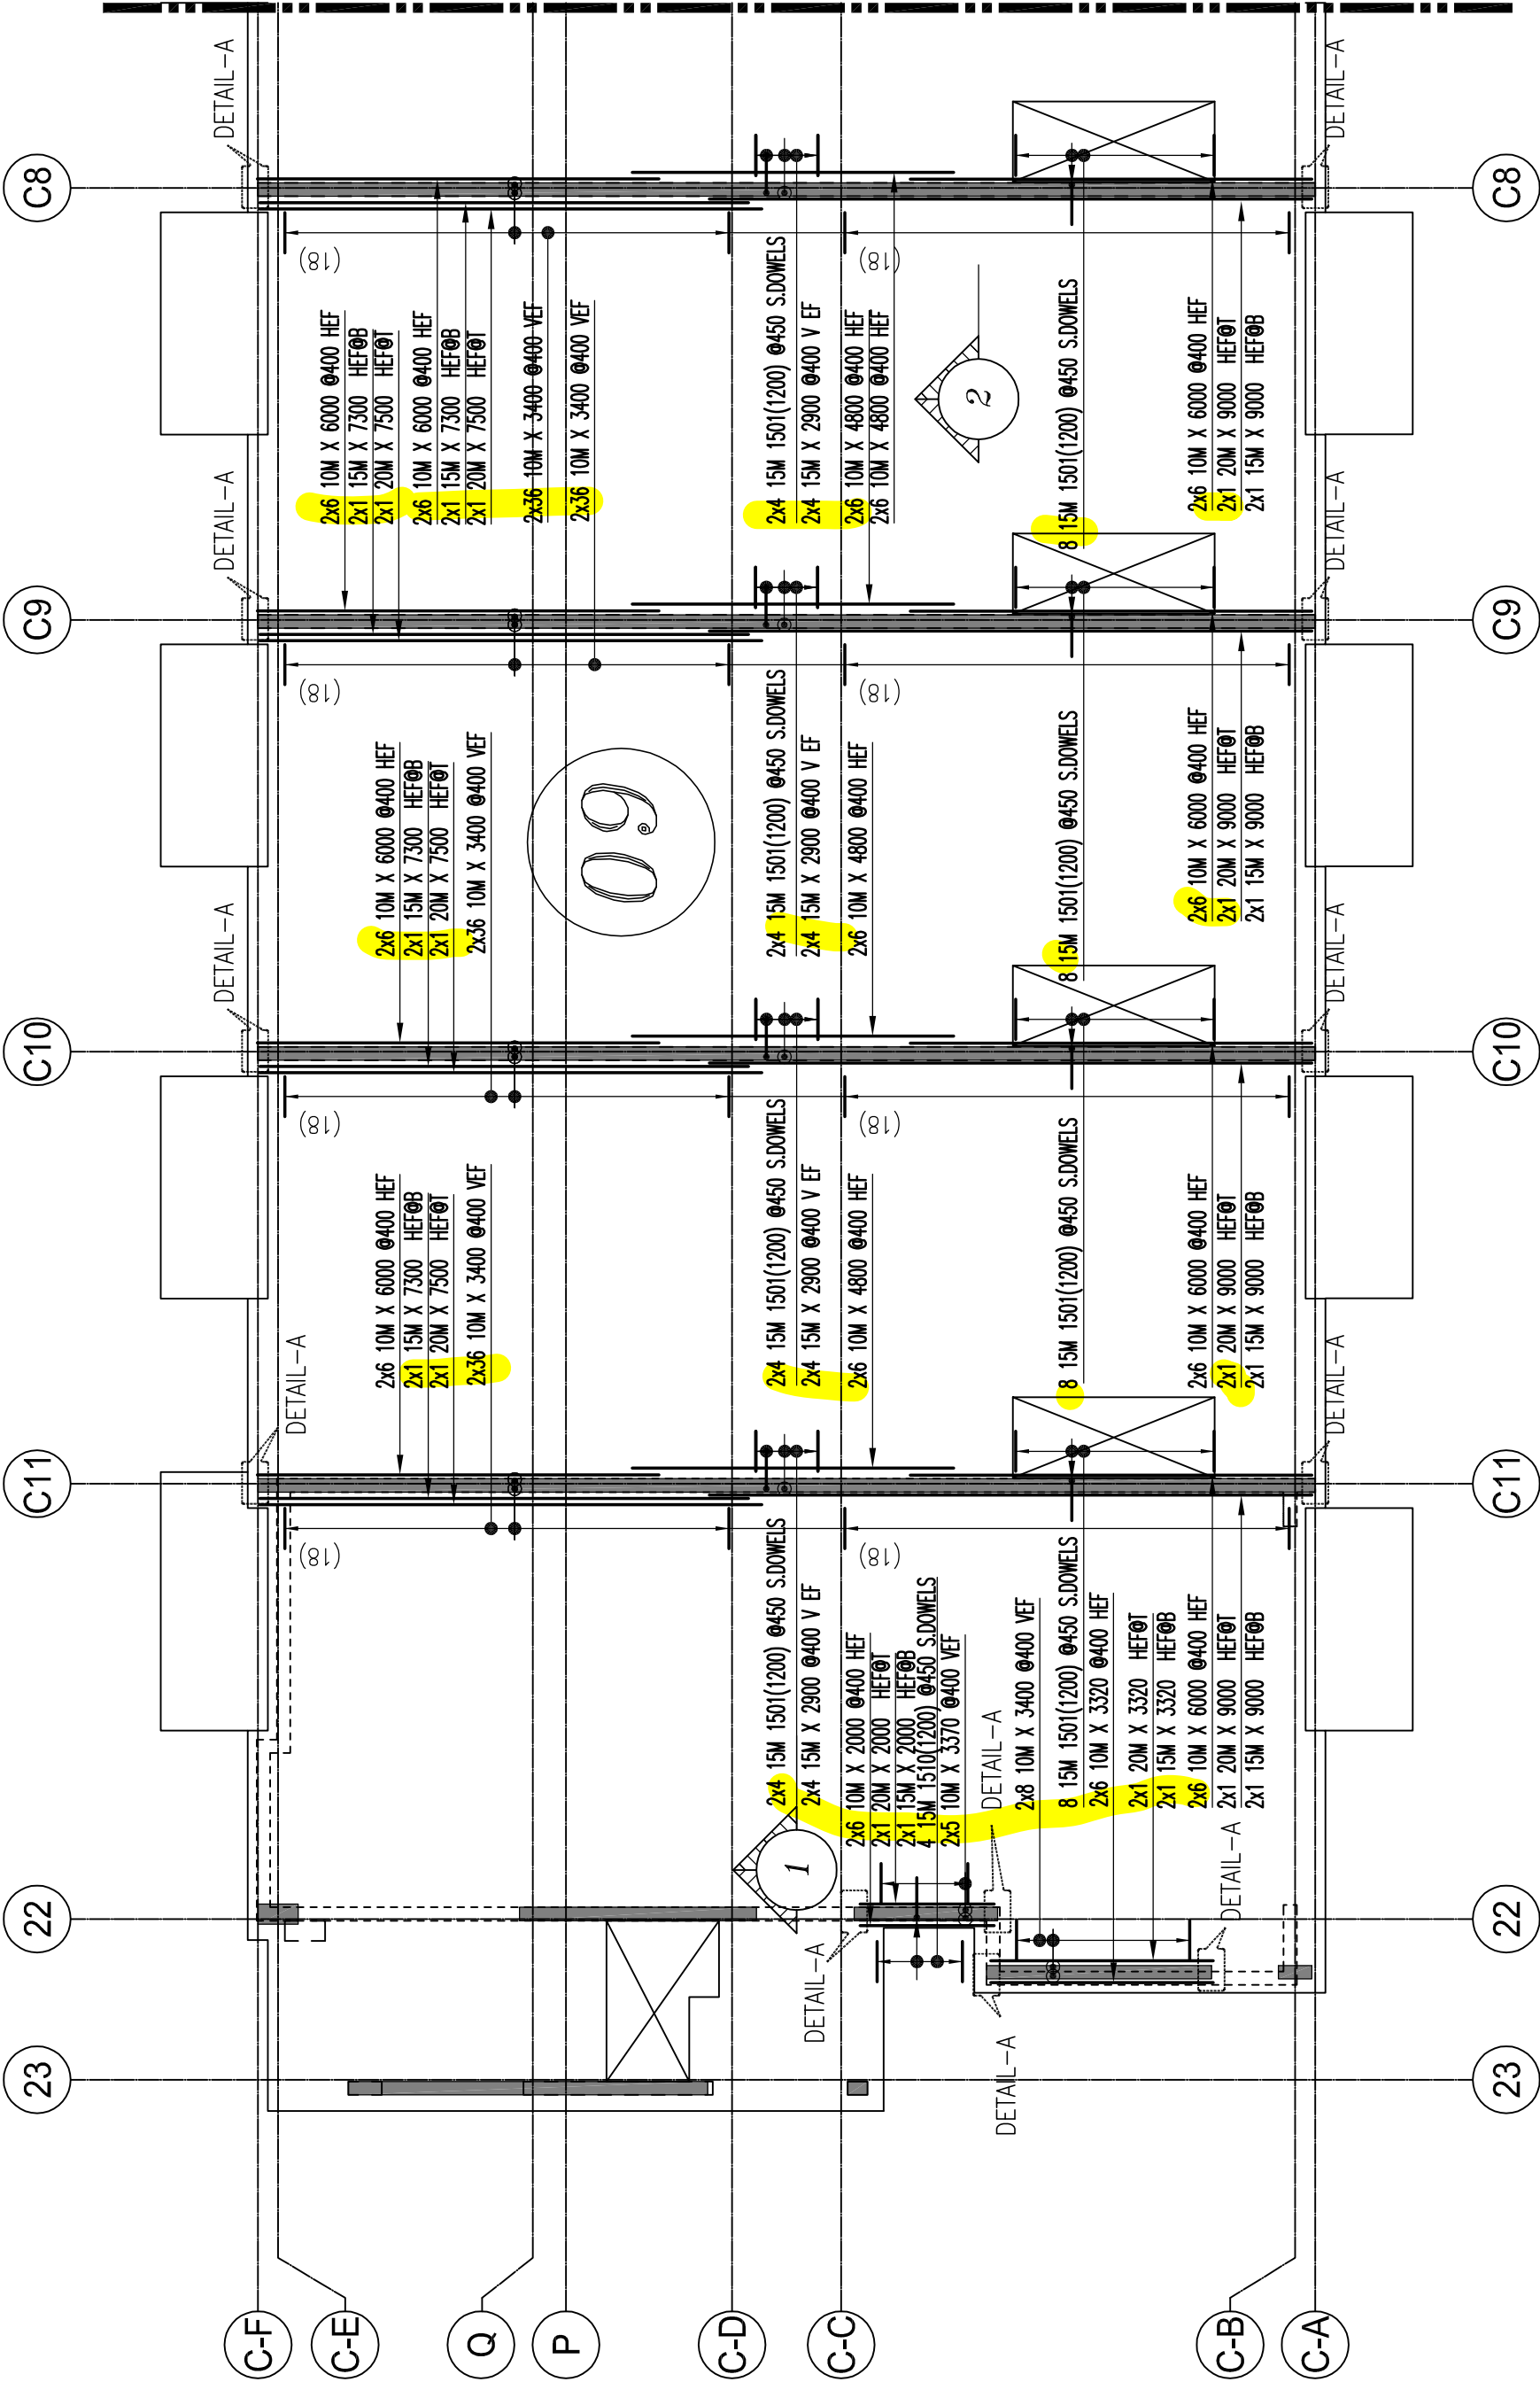


BUILDING-C WALL PLAN
SCALE: 1:100
(POUR-g)

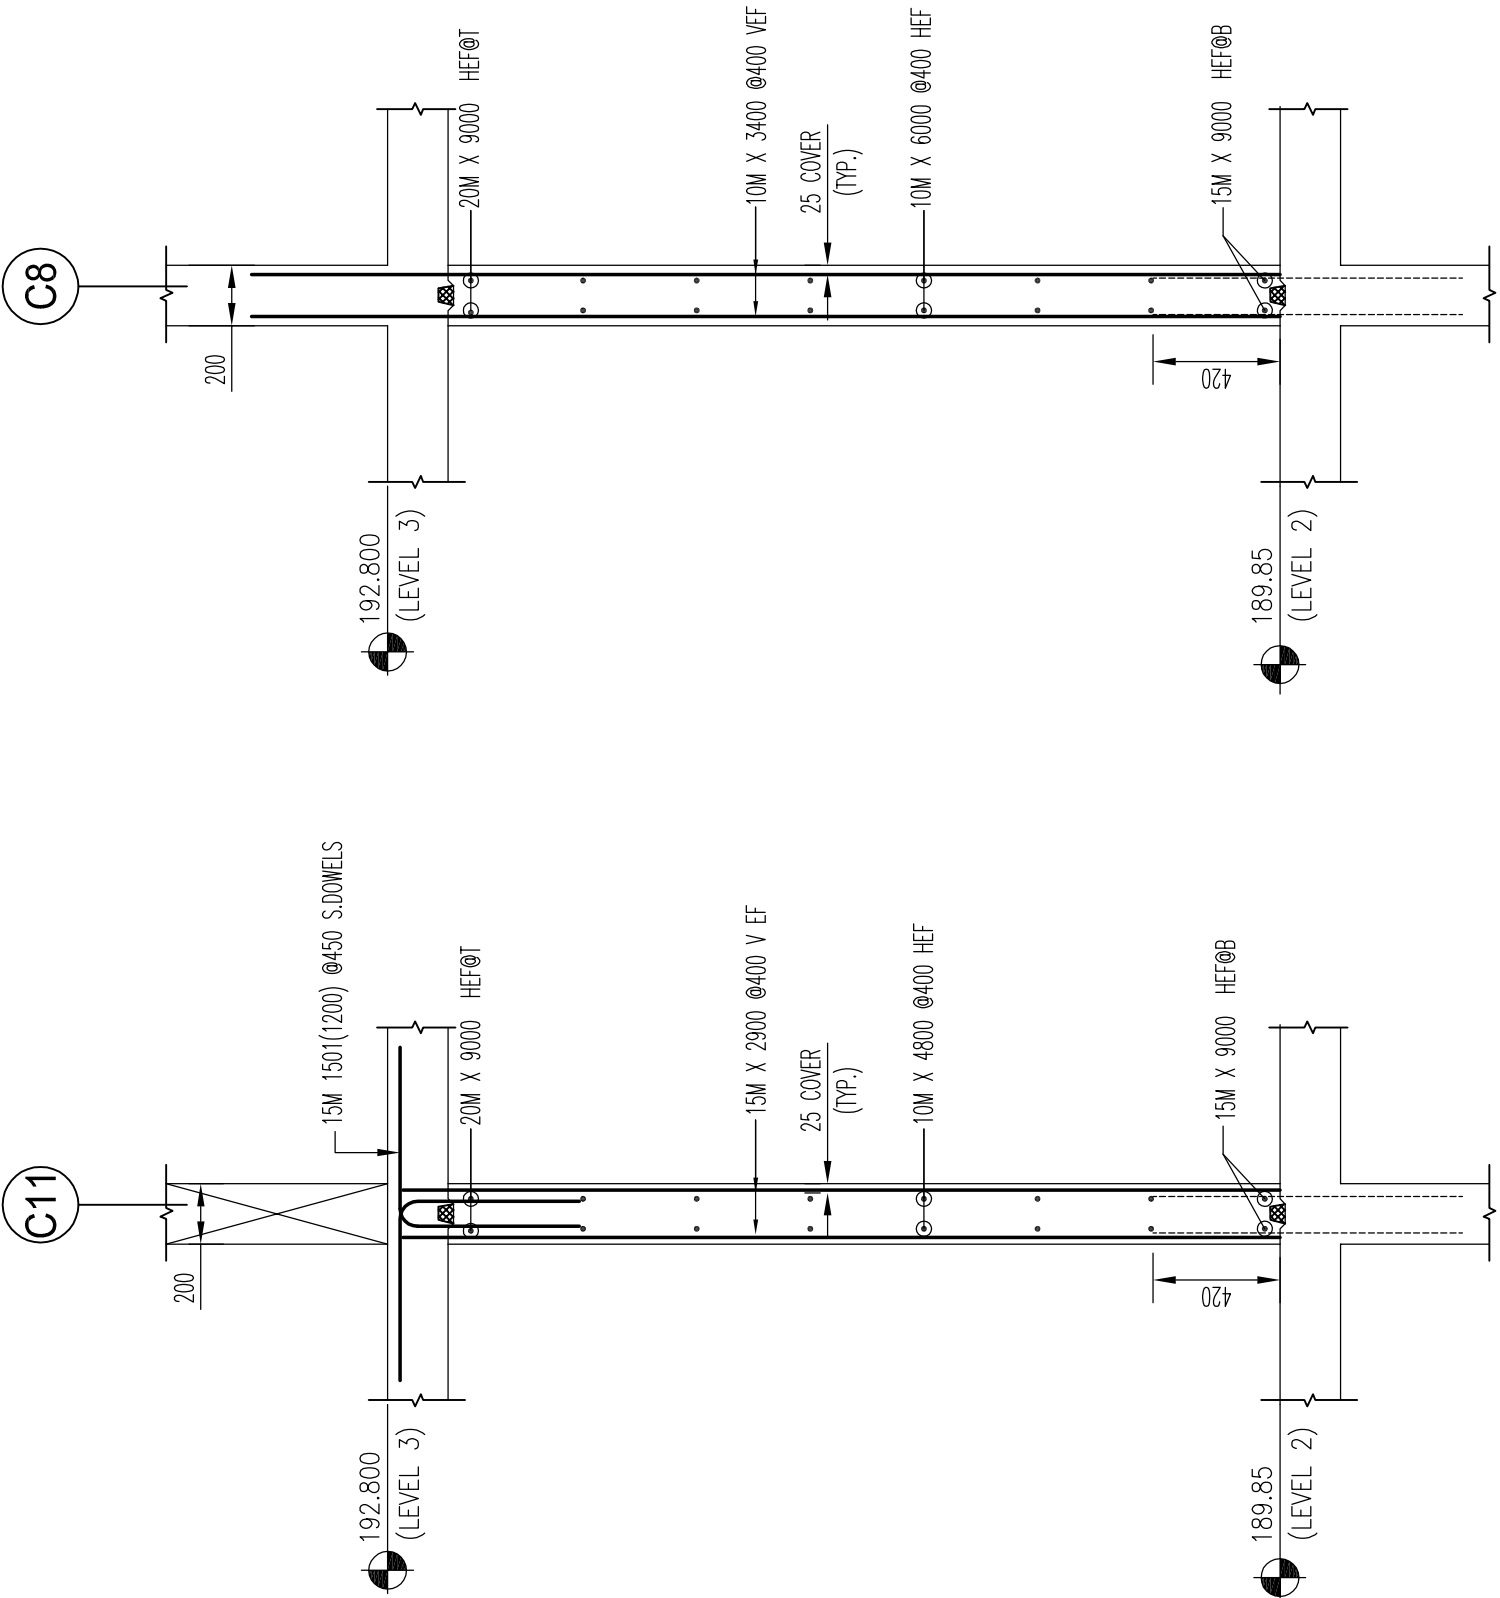




SECTION 1
SCALE: 1:25

SECTION 2
SCALE: 1:25

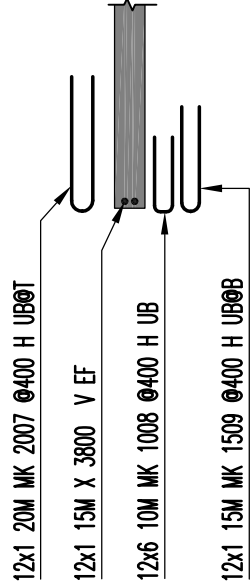

DETAIL-A
SCALE: 1:50
(POUR-g)
(12 NO'S REQUIRED)

Reinforcement Schedule Table with columns for Bar Size, Length, and Quantity.

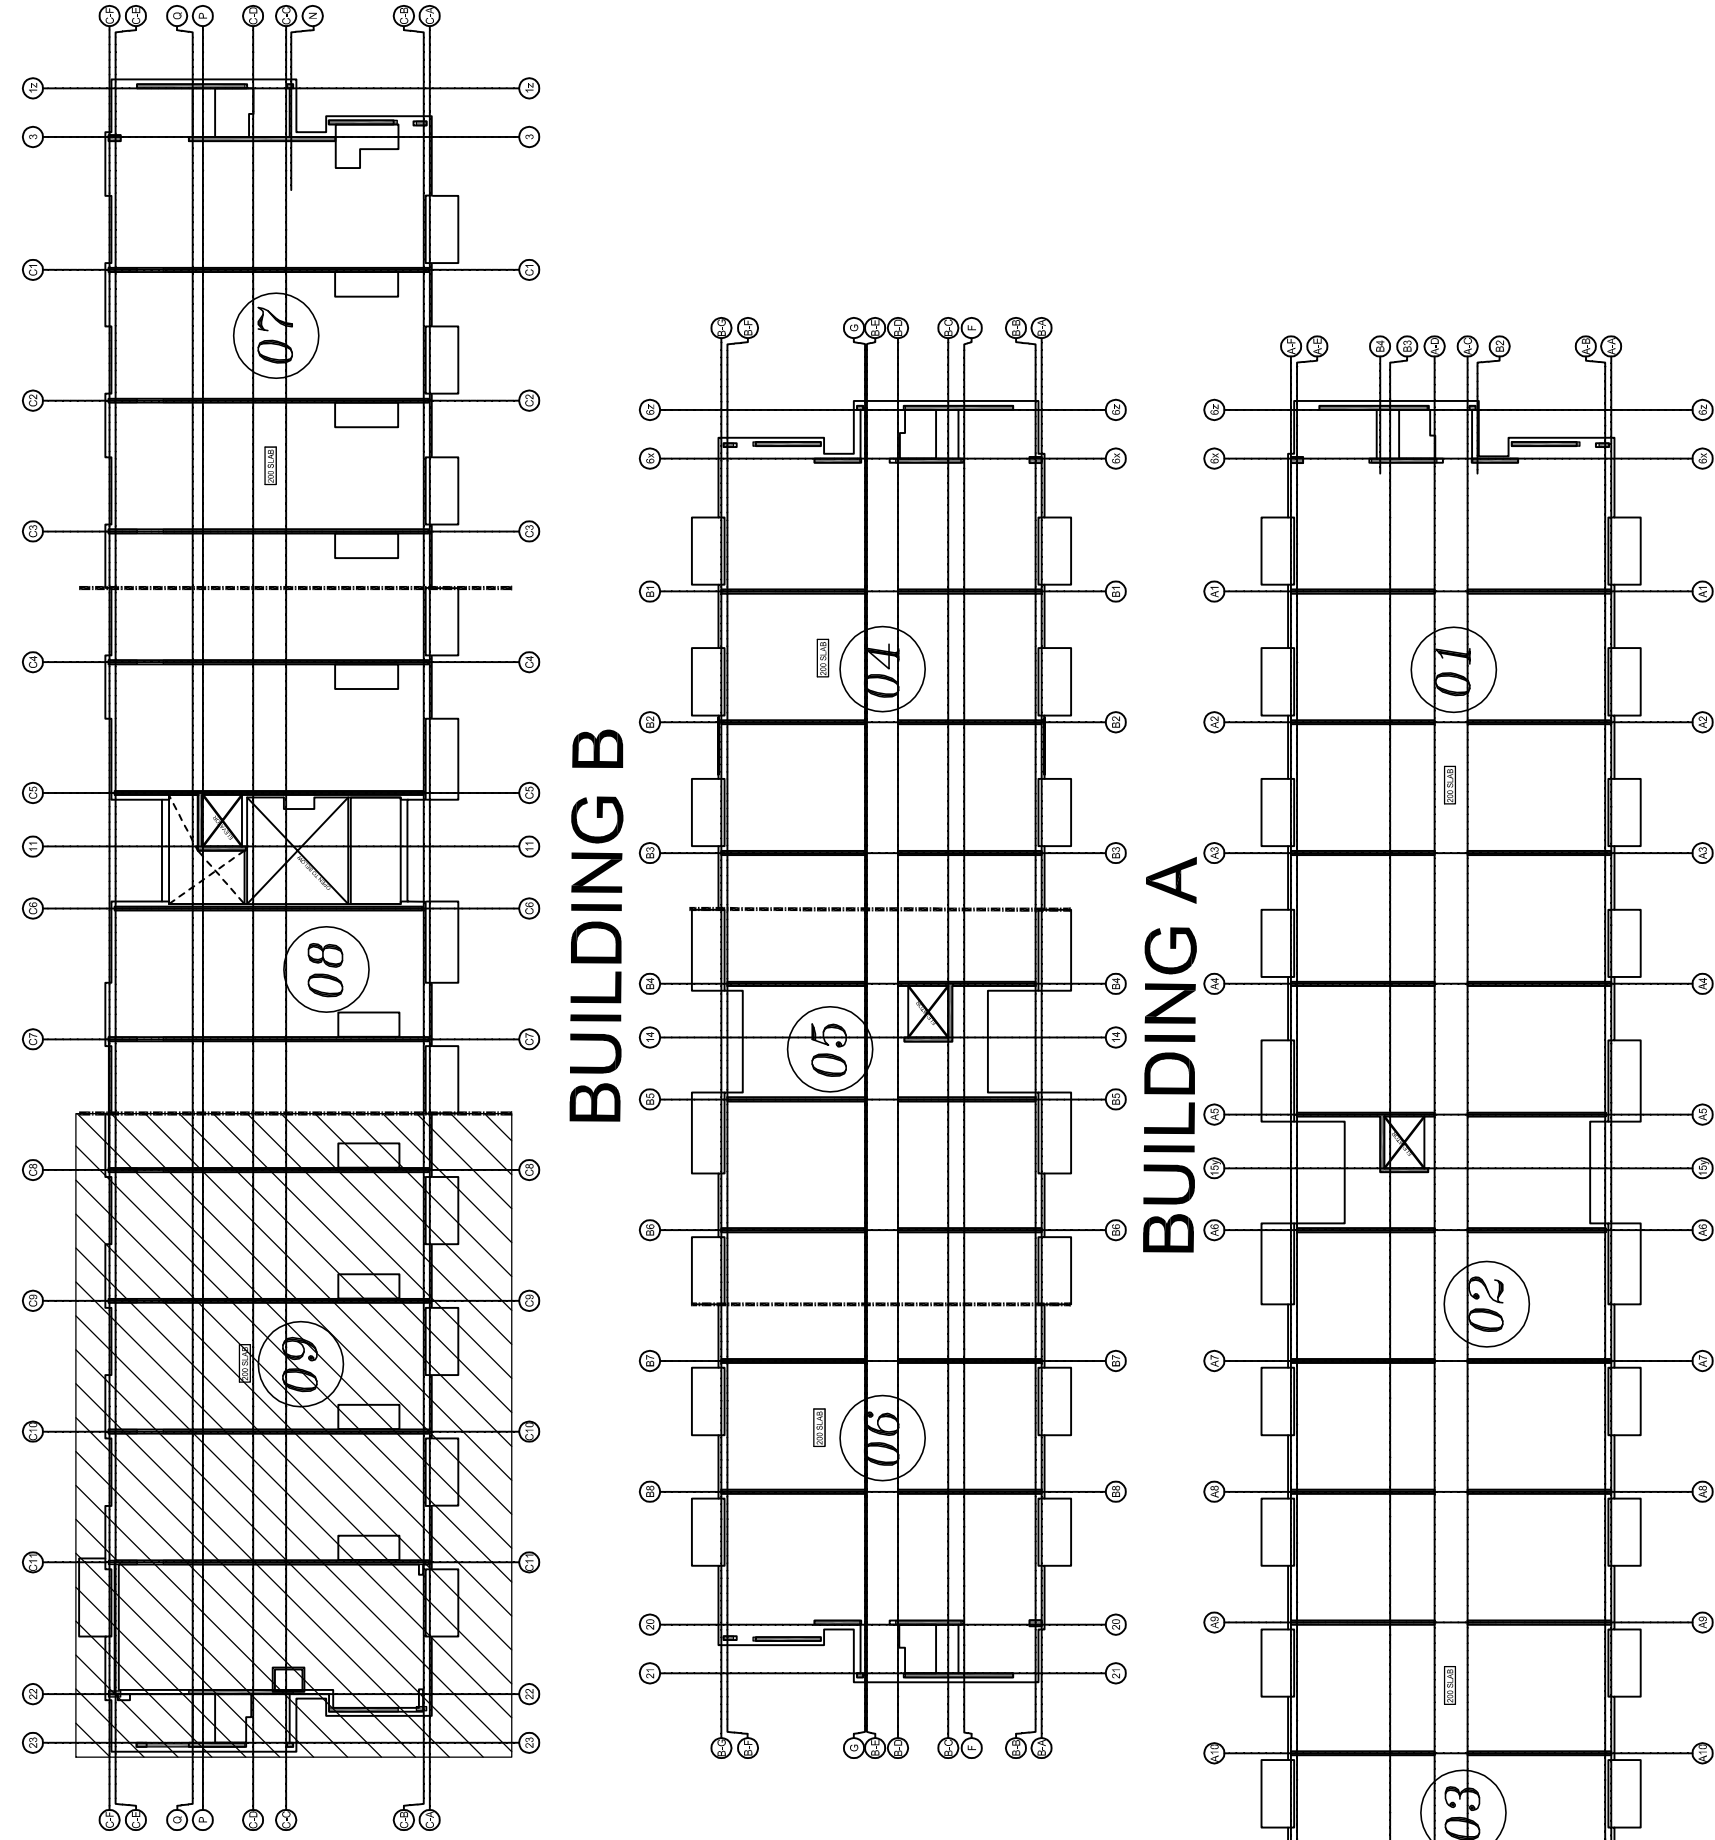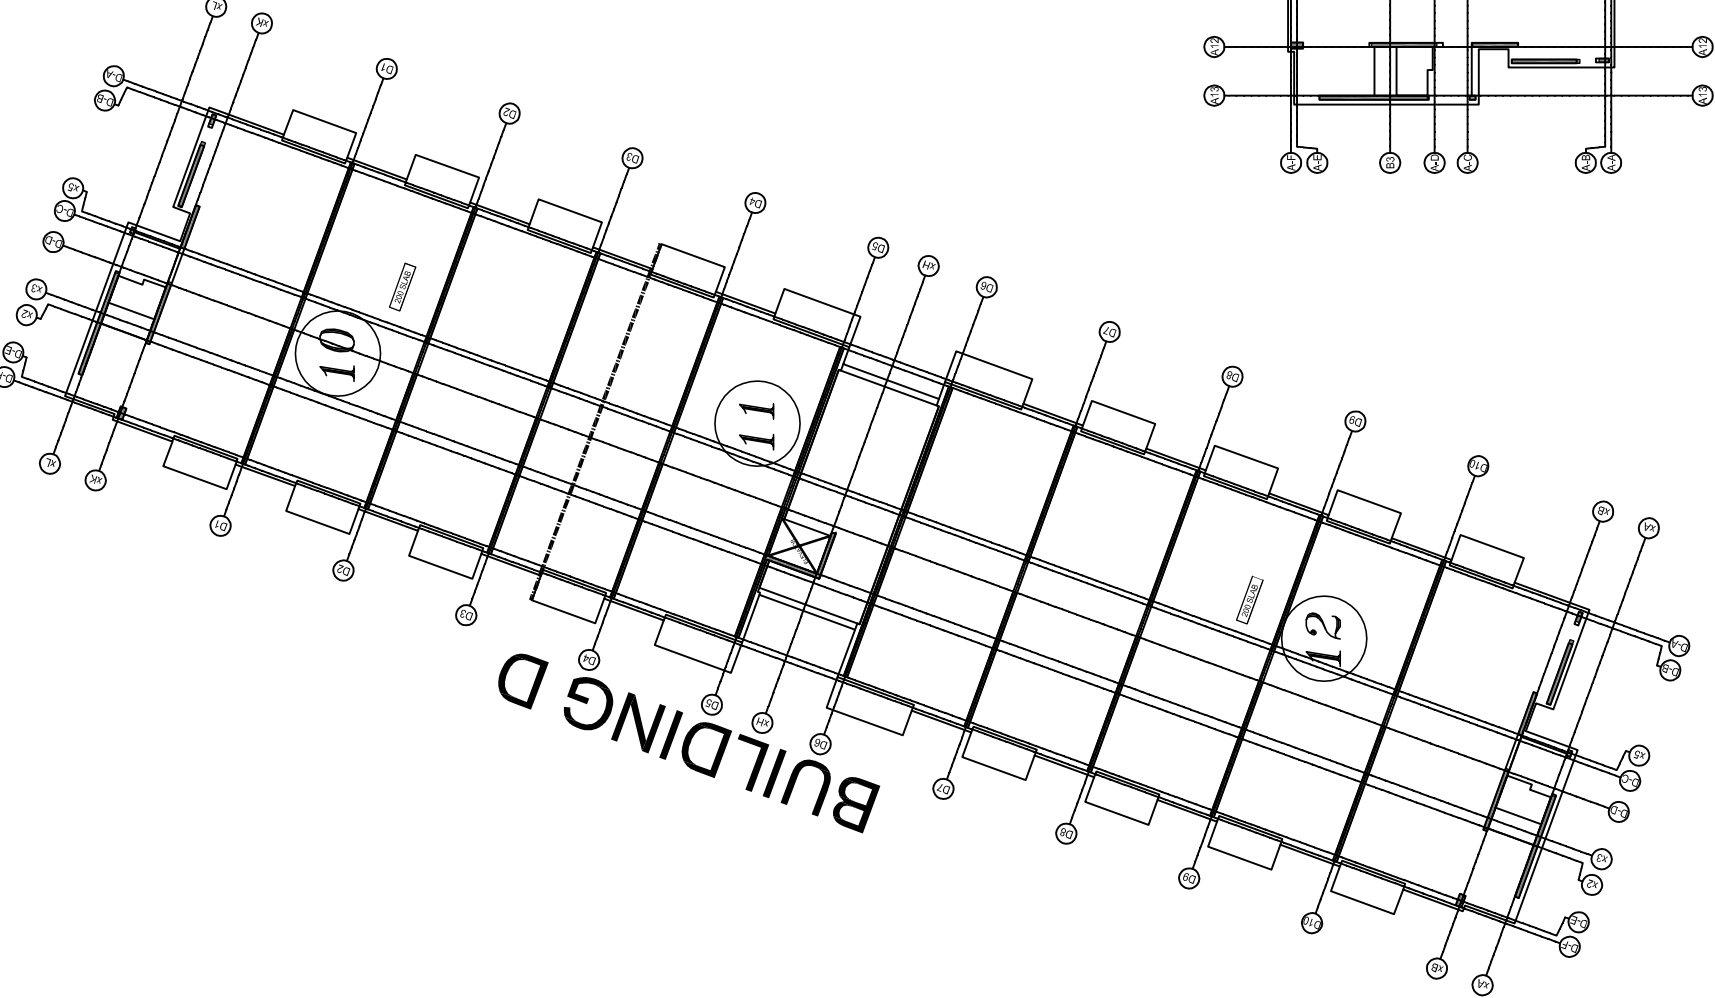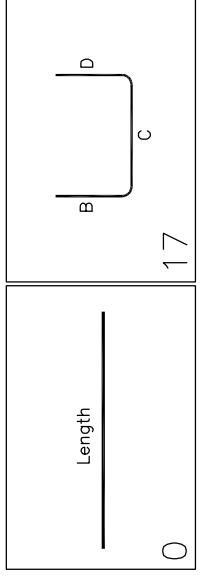

DRAWING REVIEW section with approval table and project details.

LEGEND and GRADES OF STEEL section with material specifications and standards.

MANSTEEL R&B and PROJECT information section including company details and project name.

NOTES section with 5 points regarding steel reinforcement and development length.



This review of this drawing does not in any way relieve the contractor of responsibility for its accuracy or for compliance with the contract documents.

Submission No.	19066
Project No.	MB
By	01 Dec 2021
Date	


Consulting Engineers
11129 Leslie Street Don Mills, Ont. M3C 2K5

MENT LENGTH (Ld)
-TG.)

BAR SIZE	STANDARD CAP (mm)
10M	300

40mm

Year	100	150	200	250	300	350	400	450	500	550	600	650	700	750	800	850	900	950	1000
1992	13	104	320	19	100	120													
1993	13	104	420	19	100	220													
1994	13	104	420	19	100	220													
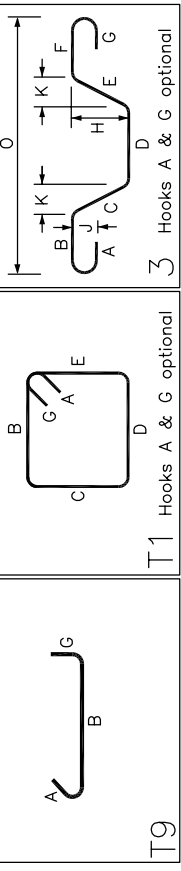

* ALL CONFIRMS/VERIFIES WILL BE ASSUMED CORRECT AND APPROVED ONLY AND ARE NOT TO BE USED FOR CONSTRUCTION AS IS UNLESS COMMENTED ON THE APPROVAL DRWGS

[illegible][illegible]

MANSTEEL.



REBAR

MANSTEEL REBAR

103 Industrial Road, Richmond Hill,
Ontario L4C 2Y4 Canada
Phone: 905-737-9797
Fax: 905-737-9704
Email: info@mansteelrebar.com

FORESTSIDE TOWNHOUSES

-BRAMPTON, ON

COLUMNS L2-L3- P#7

CUSTOMER :

	DRAWING No.
--	-------------

DATE LISTED: 30

CHECKED BY:

RTI.40

