



CONSTRUCTION SUMMARY
Grovetrail Developments Inc.

PURCHASER: NAN TANG,

TEL:

LOT NUMBER	PHASE	HOUSE TYPE	CLOSING DATE
28 Block 60	1	MAJOR MACKENZIE-END Elev B	25-Jan-22

Date Added: 11-Jan-22 Invoice Number: 7684

1 - Standard Cable, Telephone, and Conduit Rough In (See Sketch) Note:
1 - GARAGE DOOR- Install the builders standard garage door handle with lock Note:
1 - KITCHEN & BATHROOMS - Purchaser has DECLINED All Upgrades offered during decor appointment at the decor centre for kitchen & bathroom cabinetry. Standard Kitchen Layout & Standard Bathroom Vanities to be installed as per standard plan. (See Sketch) Note:
1 - APPLIANCE PACKAGE- Install the Standard Appliance Package throughout the home, where applicable. Note:
1 - COUNTER TOPS Purchaser accepts & acknowledges that the Stone slabs vary in size & all seams are visible & the fabricator reserves the right to position the seams as necessary. Note:
321 - MAIN FLOOR- Install a 1st Upgrade floor tile , throughout the main floor tiled areas, in lieu of the builders standard floor tile. Install the 20X20 CALACATTA GRIS, to be installed on the Foyer, Mudroom, Powder Room, Kitchen/Dinette area Note:
1 - UPPER HALL- Install Laminate flooring in lieu of the builders standard carpet on the Upper Hall ONLY. Install the Highland Watson Natural Oak EE-H-292. Note: **PLEASE NOTE** All applicable bedrooms to have standard 40 Oz Carpet
1 - STAIRCASE VS FLOORING WOOD SPECIES DIFFERENCE: STAIRCASE - The purchaser was advised and therefore accepts and acknowledges that the wood species of the staircase and flooring chosen do not match. This difference may result in a stain colour variance. Note: The purchaser agrees that the vendor is to be exempt from any and all claims by the purchaser regarding this colour variance.
1 - STAIRCASE VS FLOORING STAINING DIFFERENCE: STAIRCASE - The purchaser was advised and therefore accepts and acknowledges that the stain of the staircase and flooring chosen do not match. This difference might result in an undesirable colour variance. Note: The purchaser agrees that the vendor is to be exempt from any and all claims by the purchaser regarding this colour variance.
1 - CLARIFICATION- POWDER ROOM/ MASTER ENSUITE / MAIN BATH- Install the Standard 3" Splash throughout all bathroom vanity counter tops, where applicable. Note:
50 - MASTER ENSUITE- Install a 1st Upgrade floor tile , throughout the Master Ensuite floor, in lieu of the builders standard floor tile. Install the 12X24 H-STONE MEDIUM GREY, to be installed on the Master Ensuite floor ONLY. Installed straight/stacked Note: **PLEASE NOTE**Install a builders standard 8x10 wall tile for the master Ensuite shower stall walls
55 - MAIN BATH- Install a 1st Upgrade floor tile , throughout the Main Bath floor, in lieu of the builders standard floor tile. Install the 12X24 H-STONE MEDIUM GREY, to be installed on the Main Bath floor ONLY. Installed straight/stacked Note:
1 - Purchaser to receive TEN (X10) Potlights on Main floor as per their Standard Features and Finishes List **SEE BELOW** Note:



SITE MASTER

CONSTRUCTION SUMMARY
Grovetrail Developments Inc.

PURCHASER: NAN TANG,

TEL:

LOT NUMBER	PHASE	HOUSE TYPE	CLOSING DATE
28 Block 60	1	MAJOR MACKENZIE-END Elev B	25-Jan-22

Date Added: 11-Jan-22 Invoice Number: 7684

1 - GREAT ROOM- In addition to the builders standard ceiling light, Install SIX (X6) standard pot lights. All SIX (X6) pot lights to be on their own separate switch (See Sketch) Note:
1 - MAIN HALL- In addition to the builders standard ceiling lights and switch, Install ONE (X1) standard pot light in the Main hall. pot light to be on the same switch as the builders standard Main Hall ceiling lights (See Sketch) Note:
1 - KITCHEN- In addition to the builders standard ceiling light and switch in the kitchen, Install THREE (X3) standard pot lights. All THREE (X3) pot lights to be on the same switch as the builders standard Kitchen ceiling light (See Sketch) Note:
1 - PURCHASER HAS ATTENDED A COLOR APPOINTMENT AT THE DECOR CENTRE AND HAS DECLINED ANY ADDITIONAL UPGRADES. Note:
1 - PURCHASER AWARE AND ACCEPTS THAT ANY CHANGES MADE TO UPGRADES AFTER SIGNING THIS PURCHASERS EXTRA FORM ARE SUBJECT TO A MINIMUM ADMINISTRATION FEE OF \$1,000 PLUS A 10% HOLDBACK FEE. Note:
1 - BONUS PACKAGE - PURCHASER HAS APPLIED THE REMAINING \$2,980 UPGRADE PROMOTIONAL PACKAGE TOWARDS THE PURCHASE OF UPGRADES IN THIS AGREEMENT. Note:

Date Added: 19-Jul-21 Invoice Number: 7444

1 - GARAGE - Re-locate Central Vac Trunk Rough-In to Garage (In lieu of Basement) Location to be Determined by Vendor Note:
1 - SECOND FLOOR - Install SMOOTH CEILINGS throughout entire 2nd floor, where applicable. To Include; Upper Hall, Master Bedroom, Bedroom #2, Bedroom #3 and Applicable Open to Below Areas (See Sketch) Note:
1 - BONUS PACKAGE - PURCHASER HAS APPLIED \$7,500.00 (Includes Taxes) WORTH OF UPGRADE PROMOTIONAL PACKAGE TOWARDS THE PURCHASE OF STRUCTURAL UPGRADES COMPLETED AT THE DECOR CENTRE. Note: **Remaining Bonus Package of \$2,980.00 (Includes Taxes) will be applied to upgrades completed during decor appointment**
1 - PURCHASER HAS ATTENDED A STRUCTURAL APPOINTMENT AT THE DECOR CENTRE AND HAS DECLINED ANY ADDITIONAL UPGRADES. Purchaser accepts and acknowledges that there will be no further structural changes/additions/deletions to be made upon signing on JULY 13,2021 Note:
1 - PURCHASER AWARE AND ACCEPTS THAT ANY CHANGES MADE TO UPGRADES AFTER SIGNING THIS PURCHASERS EXTRA FORM ARE SUBJECT TO A MINIMUM ADMINISTRATION FEE OF \$1,000 PLUS A 10% HOLDBACK FEE. Note:

This Document is Extremely Time Sensitive - Printed 12 Jan 22 at 15:14



* INTERIOR COLOUR SCHEME *

Purchaser	Decor Consultant	Model and Elevation	Telephone Res. / Bus	Project	Closing Date	Property
NAN TANG,	Stella DiVona	MAJOR MACKENZIE-END Elev B	/	Grovetrail Developments Inc.	25/01/2022	28 Block 60

Page 1 of 3


	Flooring	Wall Tile	Plumbing
	Description	Main Accent/Insert Border / Listello Pattern	
Master Ensuite	✓ 12X24 H Stone Medium Grey-Stacked (Upgd)	8x10 SERPENTINE WHITE (STD) N/A	N/A NONE WHITE
Main Bath	✓ 12X24 H Stone Medium Grey-Stacked (Upgd)	8x10 SERPENTINE WHITE (STD) N/A	N/A NONE WHITE
Laundry (2nd Floor)	13x13 Costa White (Std)	N/A N/A	N/A
Powder Room	✓ 20X20 CALACATTA GRIS (UPGD)	N/A N/A	N/A NONE WHITE
Mud Room	✓ 20X20 CALACATTA GRIS (UPGD)	N/A N/A	N/A NONE N/A
Kitchen/Dinette	✓ 20X20 CALACATTA GRIS (UPGD)	✓ 3X6 C&D Arctic White-Stacked (STD) N/A	N/A NONE STD
Foyer	✓ 20X20 CALACATTA GRIS (UPGD)		
Main Hall	✓ Highland Watson Natural Oak EE-H-292 (STD)		
Great Room	✓ Highland Watson Natural Oak EE-H-292 (STD)		
Upper Hall	✓ Highland Watson Natural Oak EE-H-292 (UPGD)		
Master Bedroom	✓ 400Z OPENING NIGHT #20 (STD)		
Bedroom 2	✓ 400Z OPENING NIGHT #20 (STD)		
Bedroom 3	✓ 400Z OPENING NIGHT #20 (STD)		

Railings and Stairs		Cornice Moulding / Medalion	
Railings	✓ (STD) MIRAGE RED OAK DRIFTWOOD	Landing - Upper	Watson Natural Oak EE-H-292 (std)
Pickets	✓ (STD) PLAIN FLAT BLACK STEEL	Landing - Lower	Watson Natural Oak EE-H-292
Posts	✓ (STD) MIRAGE RED OAK DRIFTWOOD	Ledge - Upper	N/A
Stringers	✓ (STD) MIRAGE RED OAK DRIFTWOOD	Ledge - Lower	N/A
Treads	✓ (STD) MIRAGE RED OAK DRIFTWOOD		
Risers	✓ (STD) MIRAGE RED OAK DRIFTWOOD		
Runner	NONE		

Trim	
Baseboard & Casing	(STD) Step Bevel Modern
Front Door Glass	STANDARD
Interior Doors	(STD) Carrara Smooth
Knobs	STANDARD LEVER
Hinges	STANDARD
Grip Set	STANDARD

Notes
MASTER ENSUITE - INSTALL 2x2 GREY MOSAIC FLOOR TILES with 6" WHITE QUARTZ CURB

Page 1 of 3

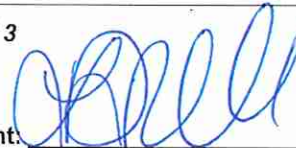Consultant: 
Stella DiVona

Purchaser: 
NAN TANG,

Vendor: 
Grovetrail Developments Inc.
Printed Jan 11, 2022 2:15 pm



* INTERIOR COLOUR SCHEME *

Purchaser

NAN TANG,

Decor Consultant

Stella DiVona

Model and Elevation

MAJOR MACKENZIE-END Elev B

Telephone Res. / Bus

/

Project

Grovetrail Developments Inc.

Closing Date

25/01/2022

Property

28 Block 60

Page 2 of 3

Interior Paint

Description

STANDARD - SILVER BIRCH

STANDARD - SILVER BIRCH

Cabinet

Style

EURO MAPLE SOAPSTONE (STD)

EURO MAPLE SOAPSTONE (STD)

STANDARD

EURO RUSTICA ROVERE CHIOSTRO RU-03 (STD)

N/A

EURO MAPLE SOAPSTONE (STD)

Appliance Opening/Dimension

Fridge Size STANDARD

Range Std 31in Opening

Built-Ins None

Microwave None

Hood Fan Std 30in

Exhaust Opening ☒ 6" ☐ 8"

Dishwasher Cabinet Std 24in Opening

Fireplace

Fireplace N/A

Location Flooring N/A

Style N/A

Finish N/A

Marble N/A

Hearth N/A

Fireplace N/A

Location Flooring N/A

Style N/A

Finish N/A

Marble N/A

Hearth N/A

Countertop

Emmerstone Maple White (STD)

Emmerstone Maple White (STD)

STANDARD

Emmerstone Maple White (STD)

N/A

Emmerstone Maple White (STD)

Counter Edge

"A" EDGE (STD)

"A" EDGE (STD)

N/A

"A" EDGE (STD)

N/A

Handle / Knob

9303 96BSN

9303 96BSN

9303 96BSN

9303 96BSN

N/A

Notes

APPLIANCES - INSTALL STANDARD APPLIANCE PACKAGE THROUGHOUT HOUSE WHERE APPLICABLE

KITCHEN - INSTALL STANDARD S/S HOOD FAN AT KITCHEN

Page 2 of 3

Decor Consultant:

Stella DiVona




Purchaser:

NAN TANG

Vendor:

Grovetrail Developments Inc.

Printed Jan 11, 2022 2:15 pm

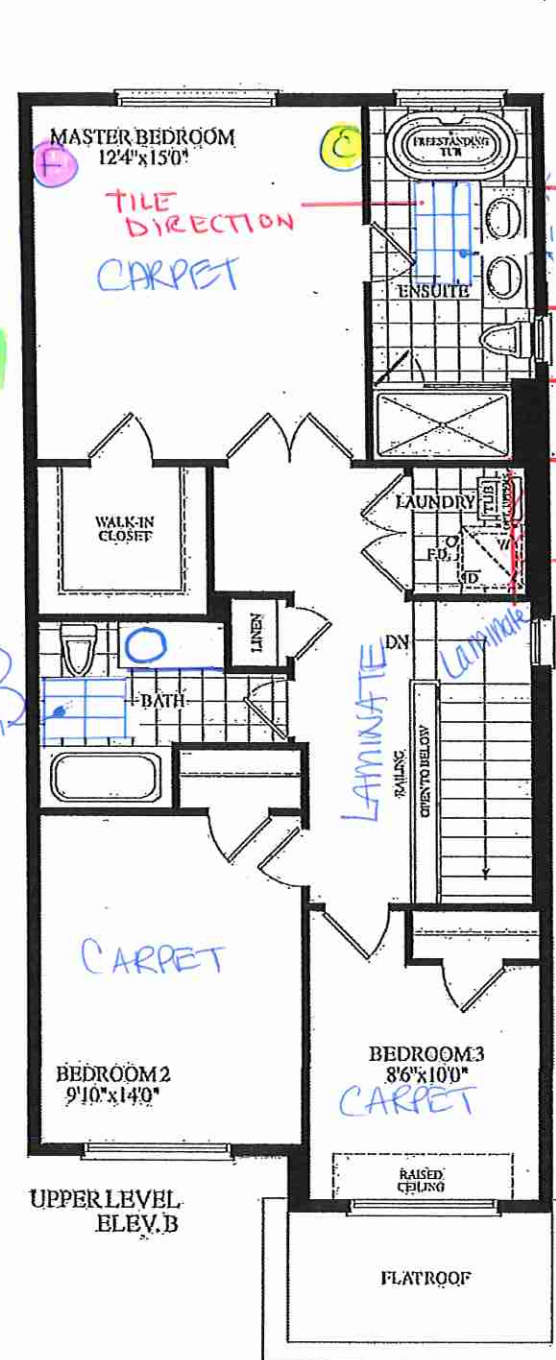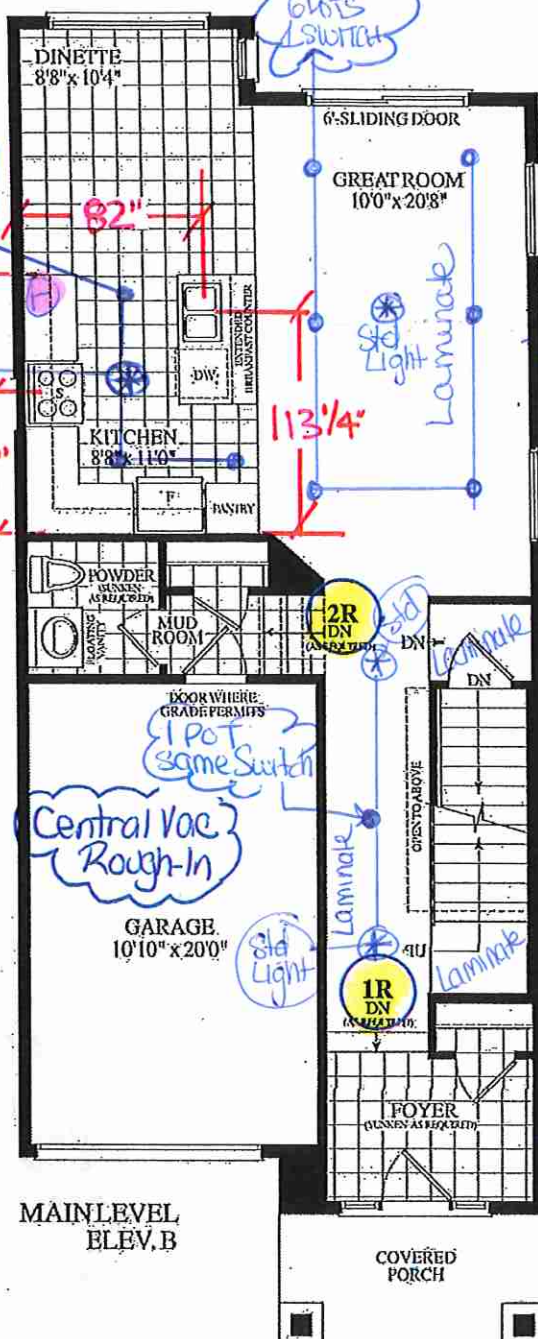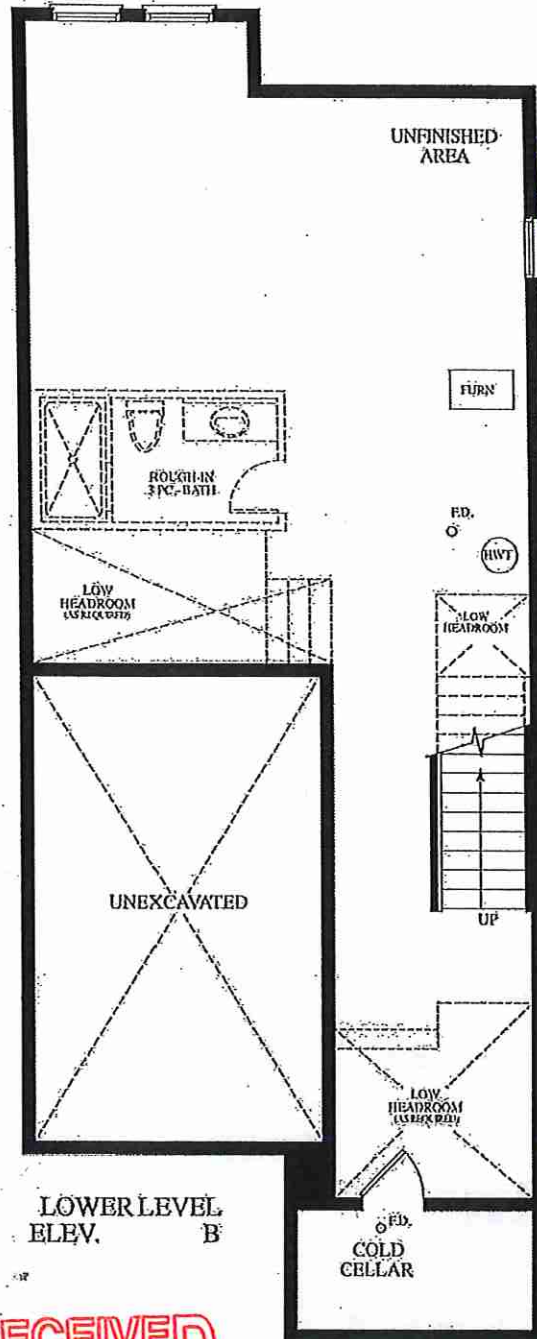


*Smooth Ceilings Throughout Entire 2nd Floor

(C) (x2)
(T) (x2)
CONDUIT

2

Lot 28 / BIK 60 - 20-09 "B"

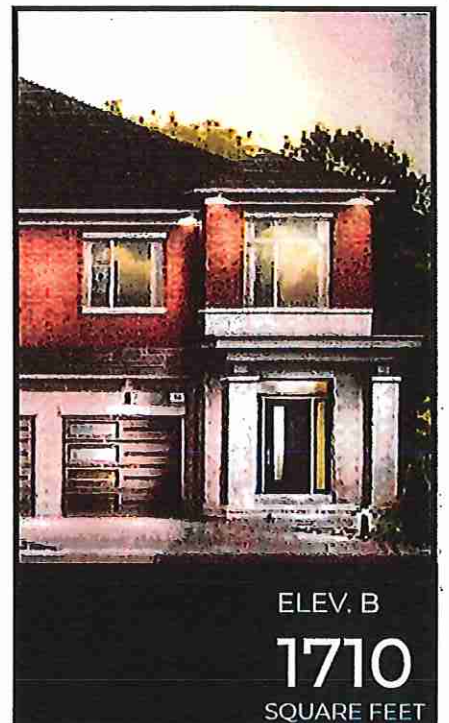

RECEIVED
July 26/21




8111 Jane St. Unit 10
Concord, Ontario L4K 4L7
Tel. (905) 669- 7028
Fax. (905) 669 - 7903
email: designstudio@villakitchens.ca
www.villakitchens.ca

CLIENT: ROYAL PINE HOMES
PROJECT: CENTERFIELD
ADDRESS: RP-CE-MASTER
MODEL: MACKENZIE 2009 END

KITCHEN

NOTE: BULKHEAD IS
BASED ON A FLAT EURO
CROWN

DRAWN BY: DIDI
DATE: SEPT 10/2021
REVISION:
PAGE: 1 OF 2

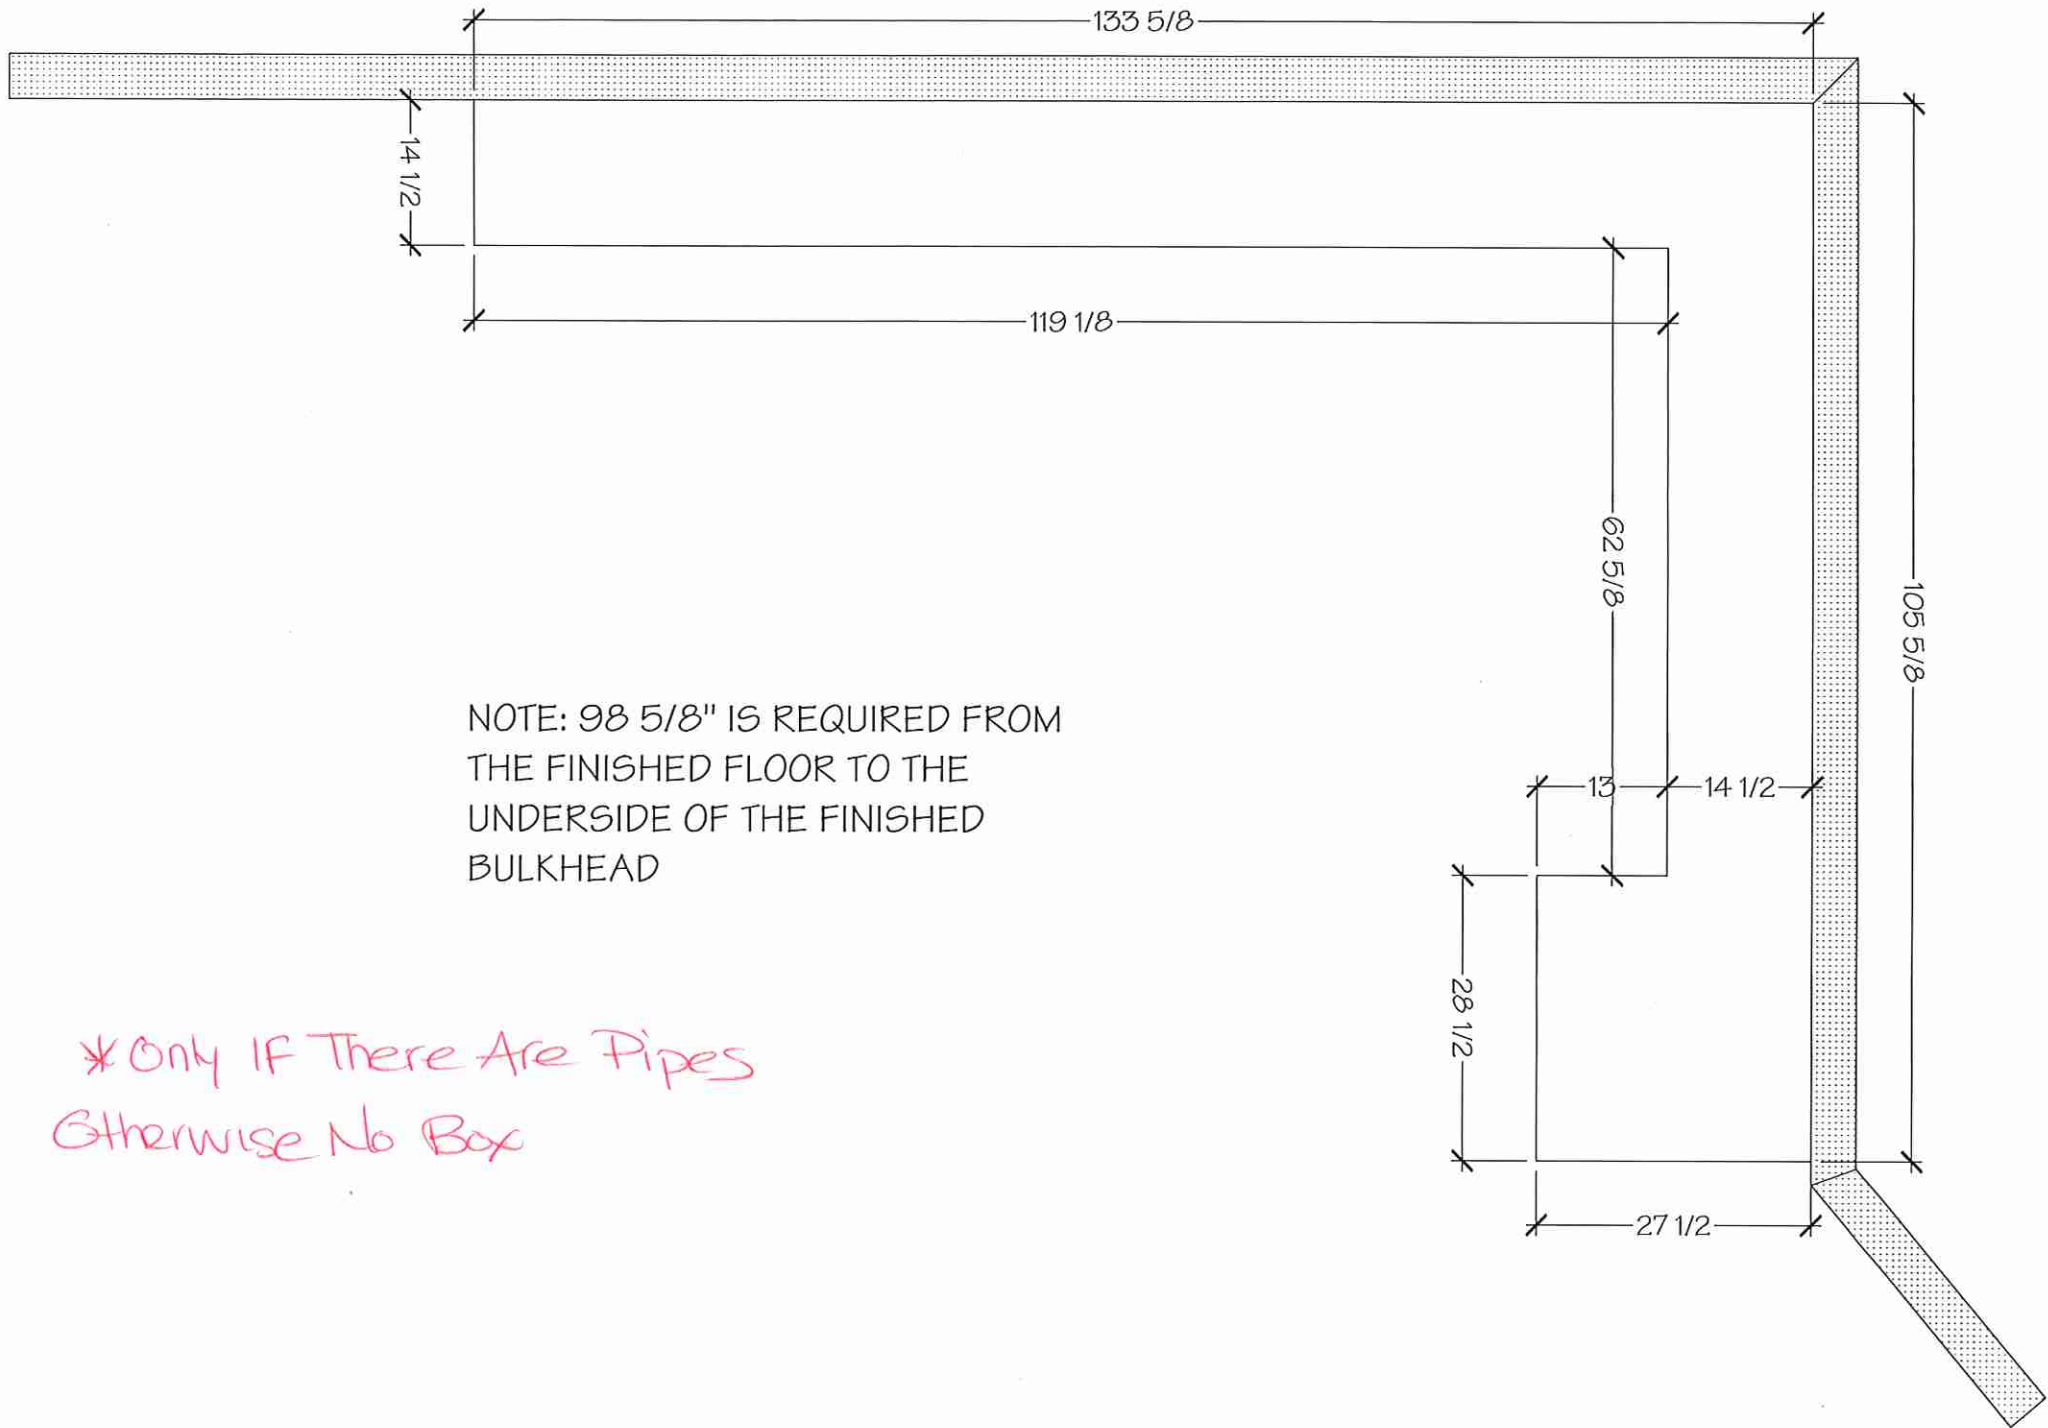

KITCHENS & FINE CABINETRY LTD

8111 Jane St. Unit 10
Concord, Ontario L4K 4L7
Tel. (905) 669- 7028
Fax. (905) 669 - 7903
email: designstudio@villakitchens.ca
www.villakitchens.ca

CLIENT: ROYAL PINE HOMES
PROJECT: CENTERFIELD
ADDRESS: RP-CE-MASTER
MODEL: MACKENZIE 2009 END

KITCHEN


NOTE: THIS SITE GETS STD-CROWN

+ OPTIONAL MAGIC CORNER

LOT 28 BLK 6D

Q 13

DRAWN BY: DIDI
DATE: JUNE 18/2021
REVISION: NOVEMBER 05/2021
PAGE: 1 OF 12

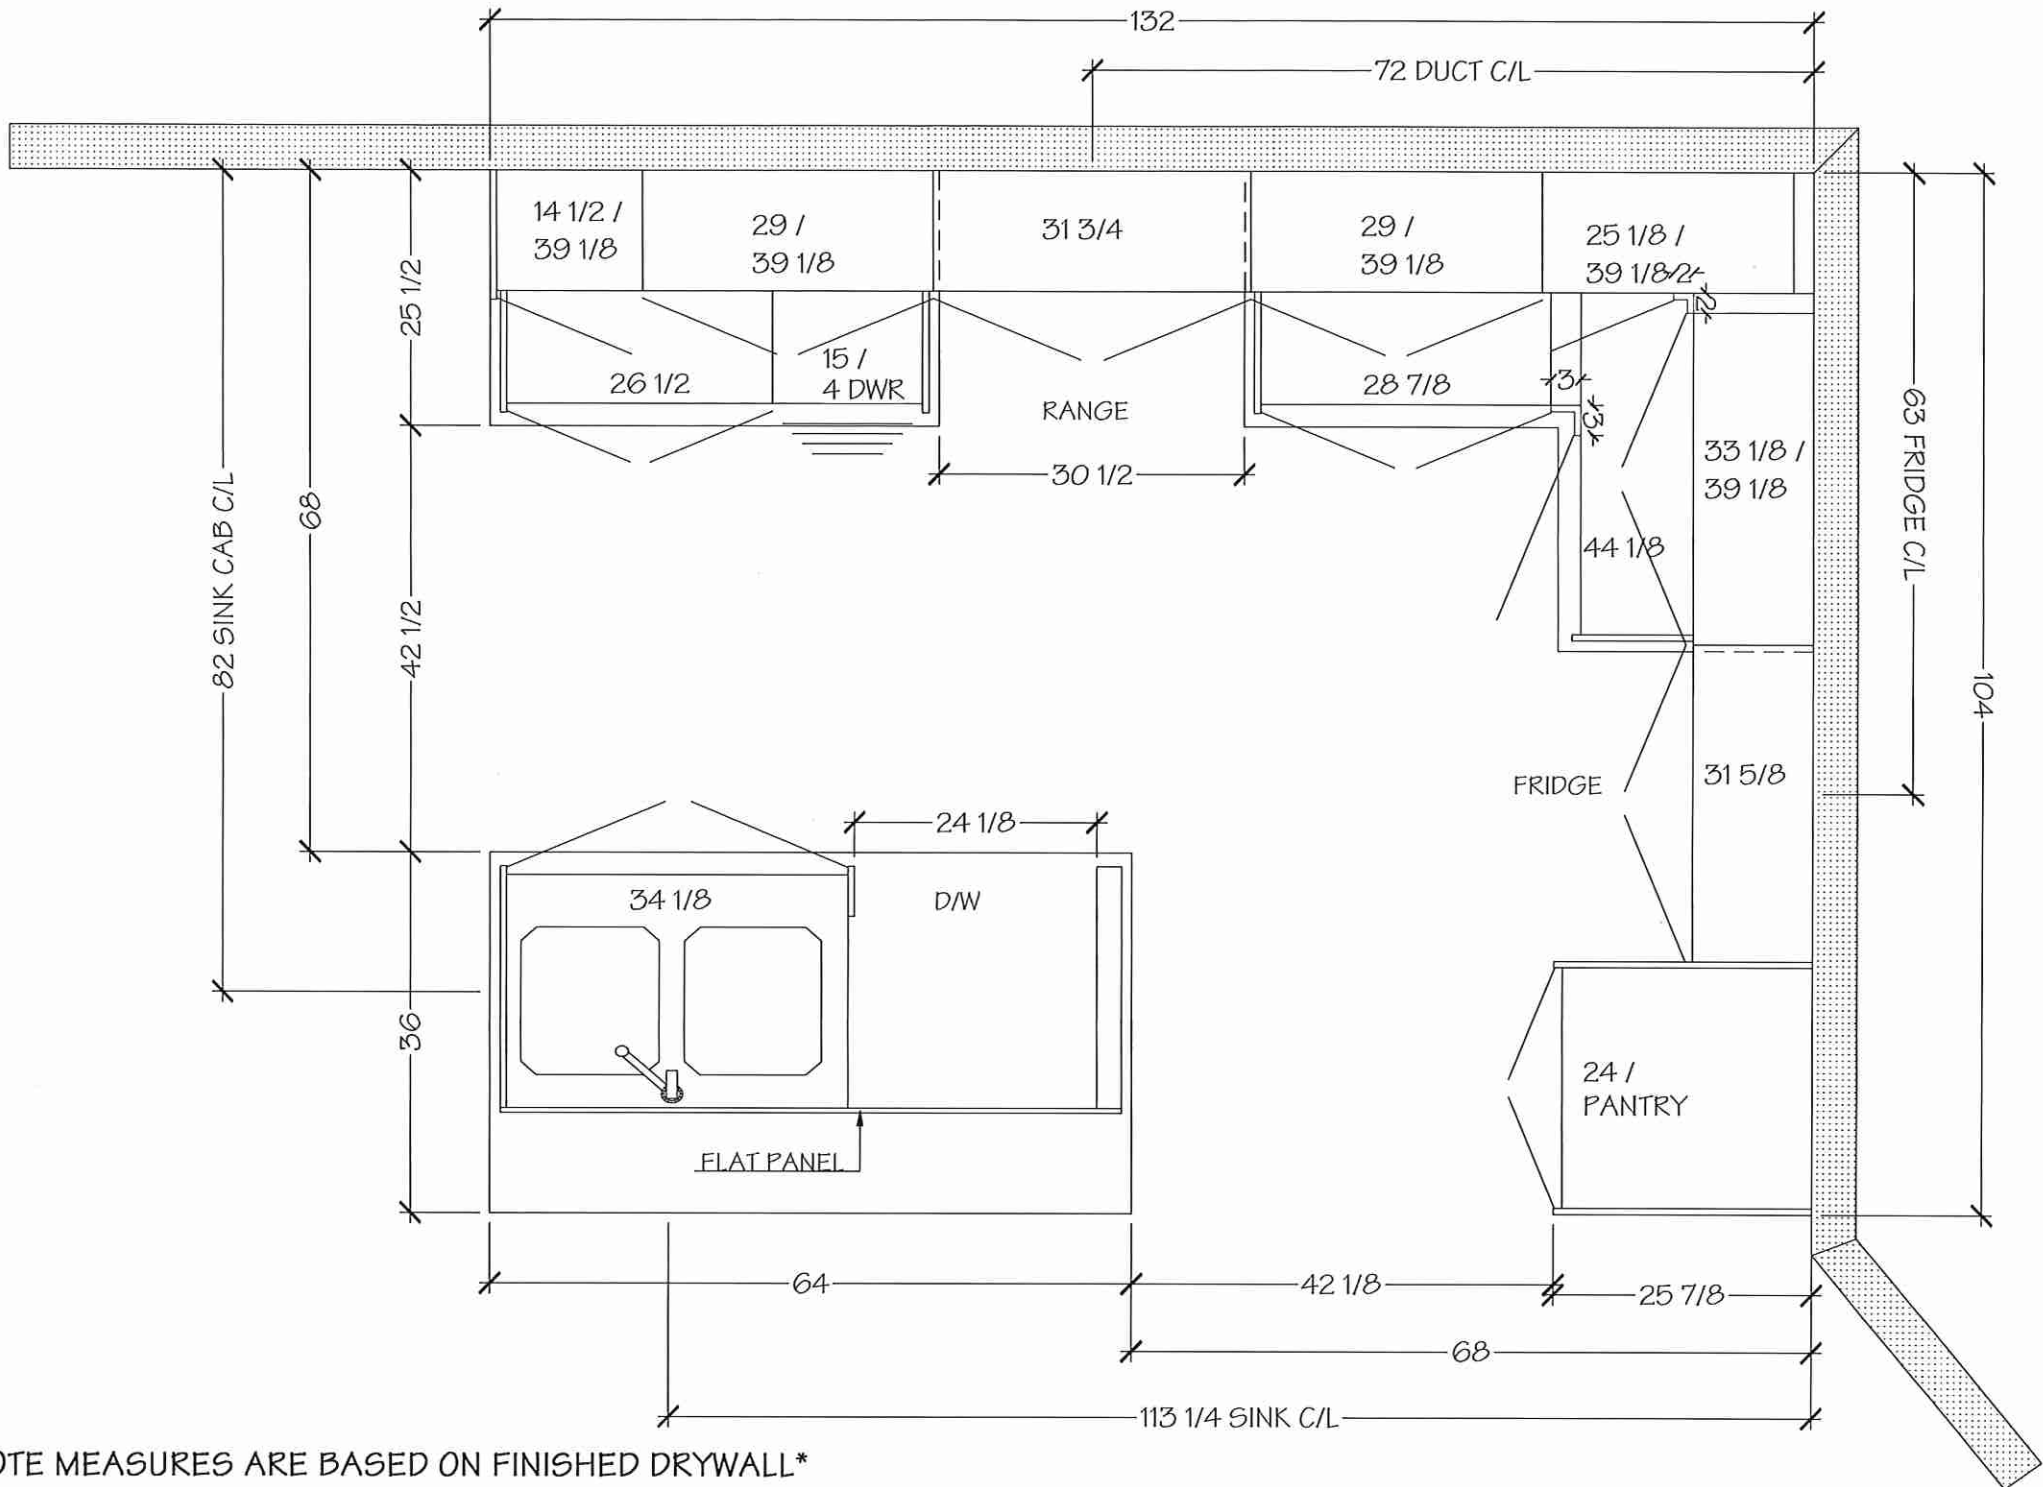

NOTE MEASURES ARE BASED ON FINISHED DRYWALL



KITCHENS & FINE CABINETRY LTD

8111 Jane St. Unit 10
Concord, Ontario L4K 4L7
Tel. (905) 669-7028
Fax. (905) 669-7903
email: designstudio@villakitchens.ca
www.villakitchens.ca

CLIENT: ROYAL PINE HOMES

PROJECT: CENTERFIELD

ADDRESS: RP-CE-MASTER


MODEL: MACKENZIE 2009 END

KITCHEN

NOTE: THIS SITE GETS STD-CROWN

OPTIONAL MAGIC CORNER

lot 28 BLK 60

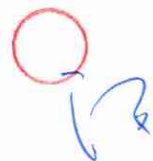


DRAWN BY: DIDI

DATE: JUNE 18/2021

REVISION: NOVEMBER 05/2021

PAGE: 2 OF 12

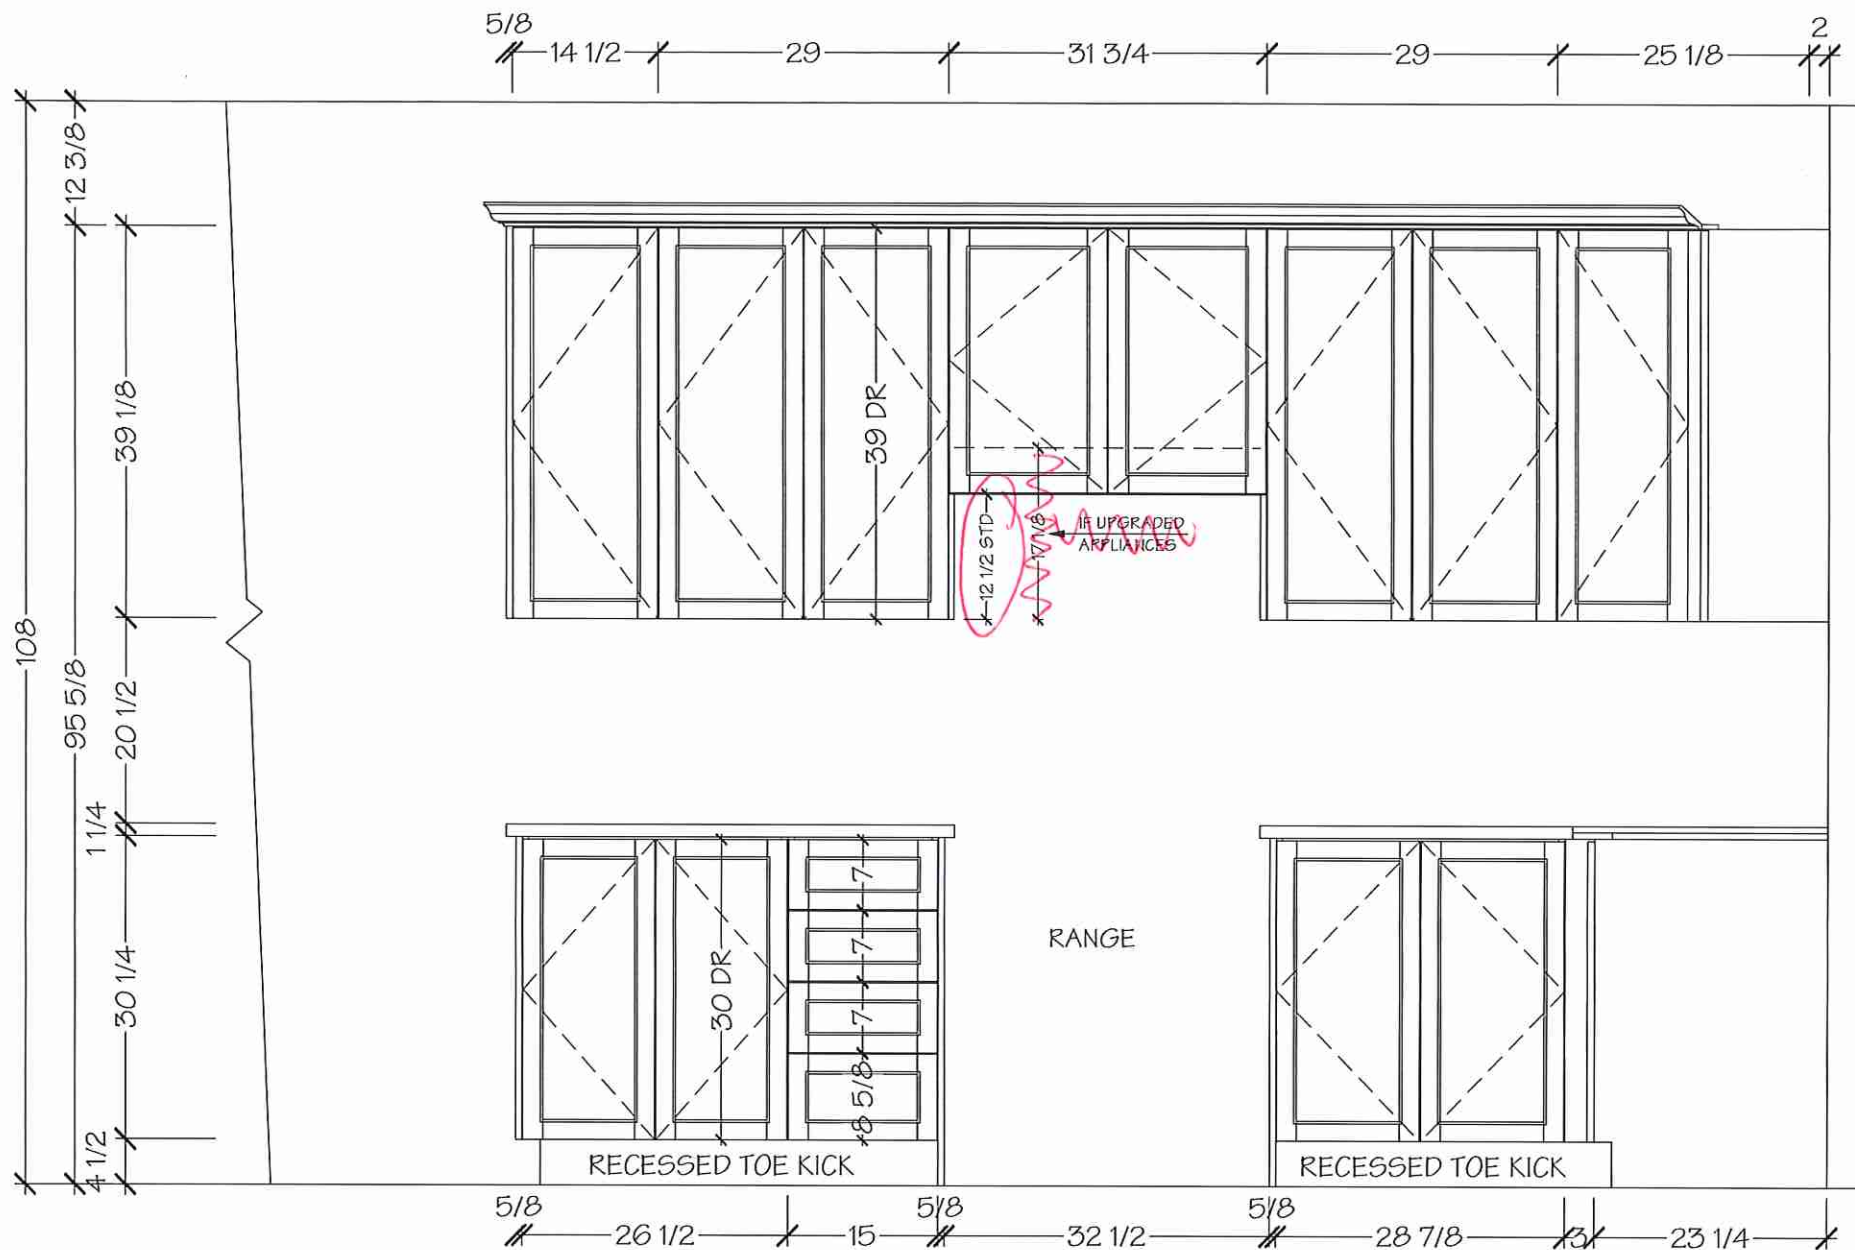

NOTE MEASURES ARE BASED ON FINISHED DRYWALL

Villa

KITCHENS & FINE CABINETRY LTD

8111 Jane St. Unit 10
Concord, Ontario L4K 4L7
Tel. (905) 669- 7028
Fax. (905) 669 - 7903
email: designstudio@villakitchens.ca
www.villakitchens.ca

CLIENT: ROYAL PINE HOMES

PROJECT: CENTERFIELD

ADDRESS: RP-CE-MASTER

MODEL: MACKENZIE 2009 END

KITCHEN

NOTE: THIS SITE GETS STD-CROWN

OPTIONAL MAGIC CORNER

LOT 28 BLK 60




DRAWN BY: DIDI

DATE: JUNE 18/2021

REVISION: NOVEMBER 05/2021

PAGE: 3 OF 12

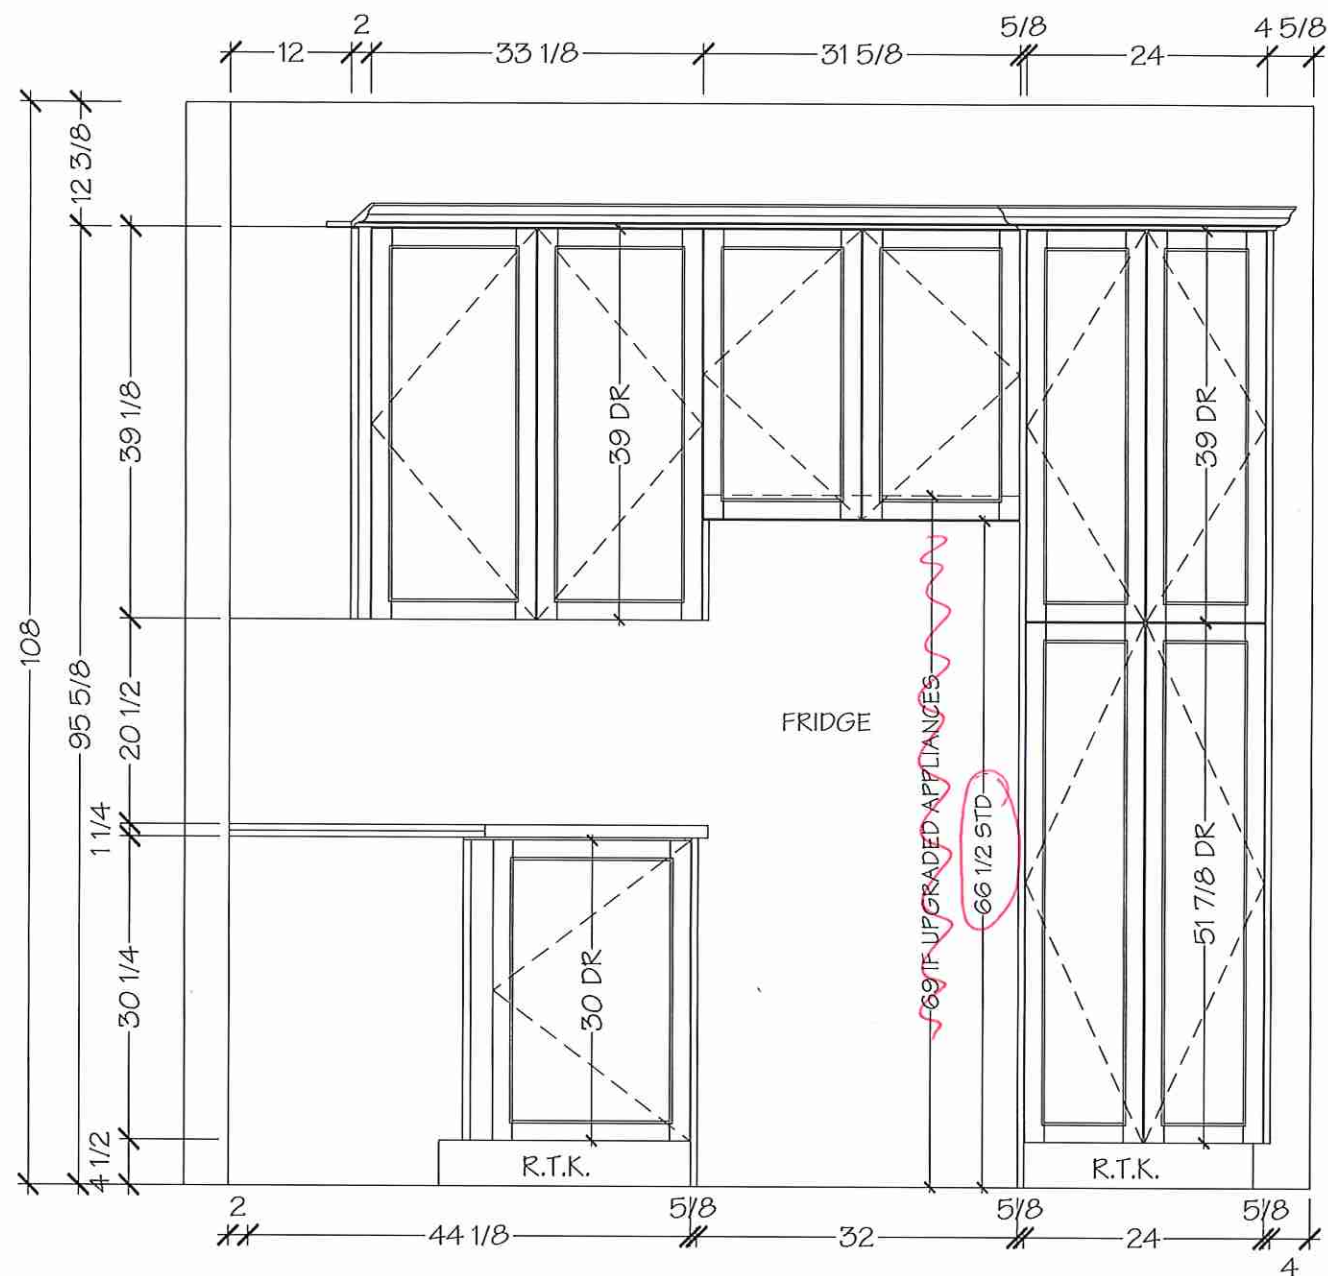

NOTE MEASURES ARE BASED ON FINISHED DRYWALL



8111 Jane St. Unit 10
Concord, Ontario L4K 4L7
Tel. (905) 669- 7028
Fax. (905) 669 - 7903
email: designstudio@villakitchens.ca
www.villakitchens.ca


CLIENT: ROYAL PINE HOMES
PROJECT: CENTERFIELD
ADDRESS: RP-CE-MASTER
MODEL: MACKENZIE 2009 END

KITCHEN



NOTE: THIS SITE GETS STD-CROWN

~~OPTIONAL MAGIC CORNER~~

LOT 28 BLK 60

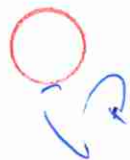

DRAWN BY: DIDI
DATE: JUNE 18/2021
REVISION: NOVEMBER 05/2021
PAGE: 4 OF 12

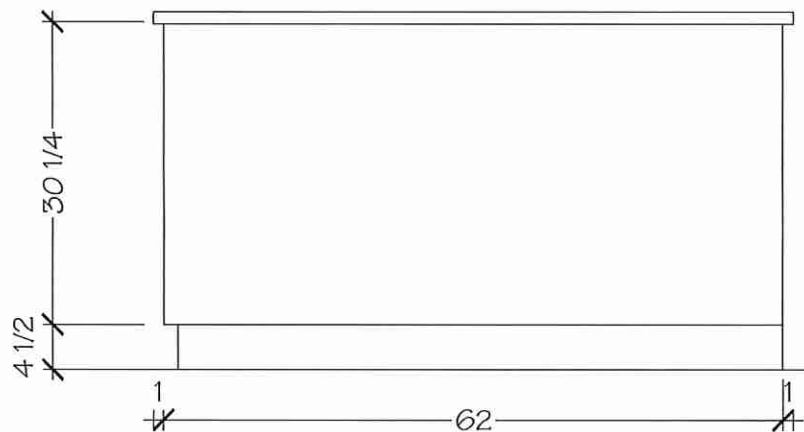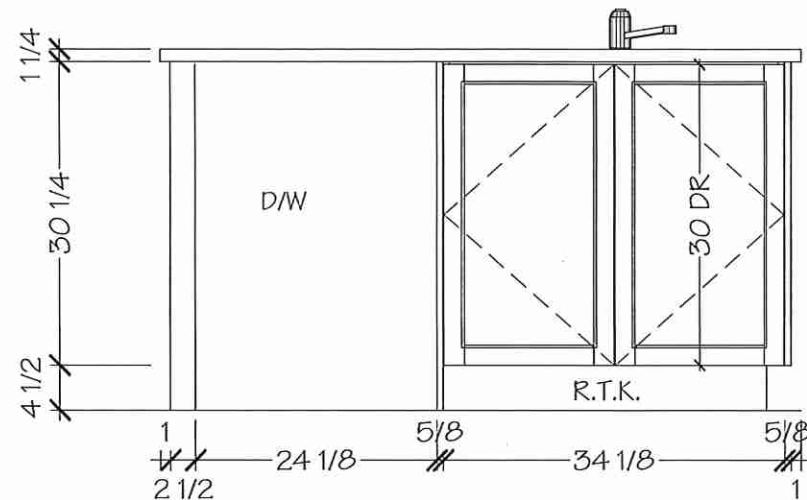

NOTE MEASURES ARE BASED ON FINISHED DRYWALL

Villa


KITCHENS & FINE CABINETRY LTD

8111 Jane St. Unit 10
Concord, Ontario L4K 4L7
Tel. (905) 669-7028
Fax. (905) 669-7903
email: designstudio@villakitchens.ca
www.villakitchens.ca


CLIENT: ROYAL PINE HOMES
PROJECT: CENTERFIELD
ADDRESS: RP-CE-MASTER
MODEL: MACKENZIE 2009 END

POWDER ROOM

LOT 28 BLK 60

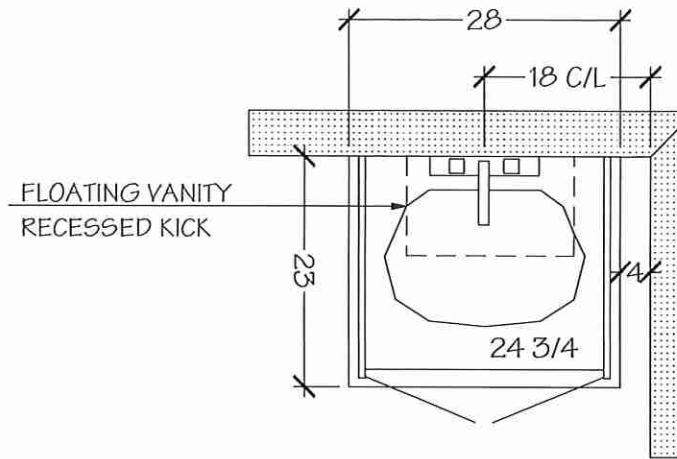

POWDER ROOM

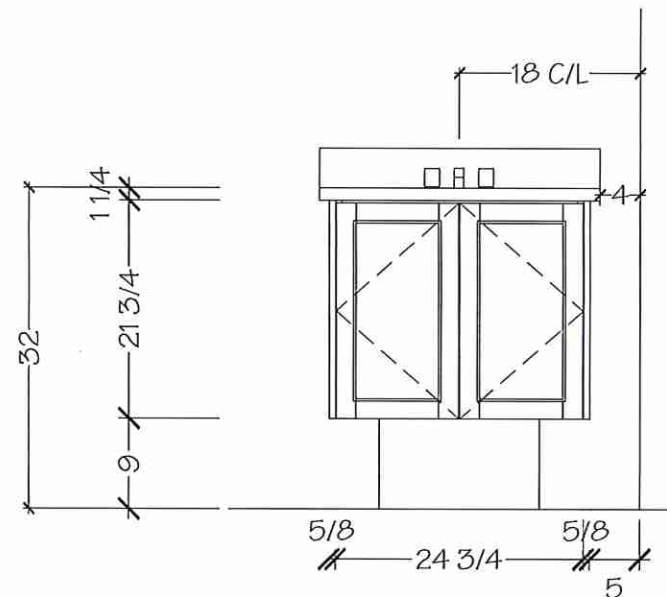


NOTE MEASURES ARE BASED ON FINISHED DRYWALL


DRAWN BY: DIDI
DATE: JUNE 18/2021
REVISION: NOVEMBER 05/2021
PAGE: 8 OF 12

MAIN BATH

LOT 28 BLK 60

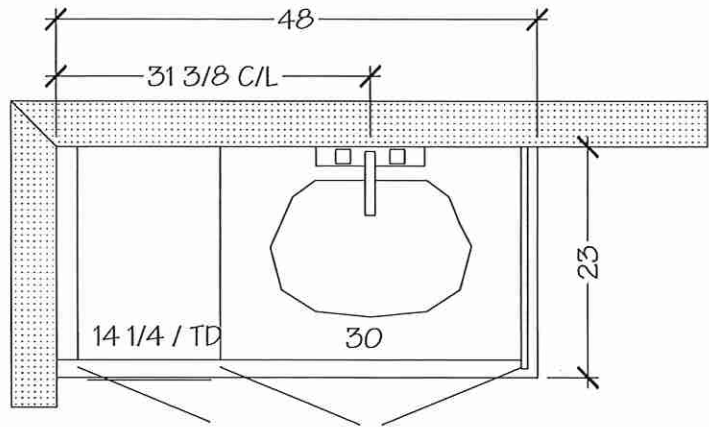

MAIN BATH

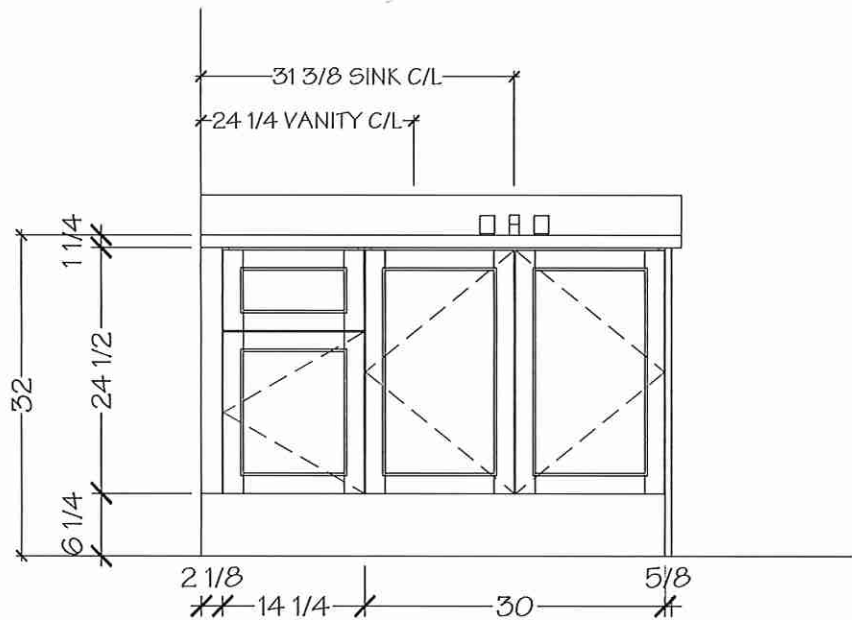

NOTE MEASURES ARE BASED ON FINISHED DRYWALL

LOT 28 BLOCK 60


EDGE
DETAILS

004

- * Kitchen
- * Powder Room
- * Master Ensuite
- * Main Bath



STRAIGHT EDGE
(STANDARD - 3/4")

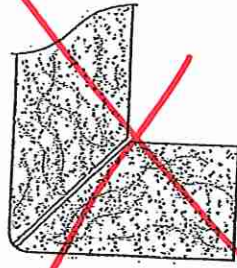

MITER WITH SKIRT EDGE
(MEDIUM - 1 1/2")



OGREE-SQUARE EDGE
(MED./HIGH - 1 1/2")

EDGING UP-GRADE OPTIONS

RECEIVED
RICK S. D.