



SITE COPY

CONSTRUCTION SUMMARY

Grovetrail Developments Inc.

PURCHASER: SOUHEIL KNEIFATI

TEL:

LOT NUMBER	PHASE	HOUSE TYPE	CLOSING DATE
6	1	CHADWICK-OPT Main-Lndry on Main-Den on 2nd Elev A	06-Dec-22

Date Added: 06-Apr-22

Invoice Number: 7854

1 - Install Standard Cable Rough-Ins (x2) and Install Standard Telephone Rough-Ins (x2) (See Sketch) Note:
1 - FAMILY ROOM - Install Standard Conduit Pipe at family room above fireplace mantle. To accommodate future installation of wall mount TV. Conduit installed beside electrical plug (See Sketch) Note:
1 - FAMILY ROOM - Install ONE (1) ADDITIONAL ELECTRICAL PLUG at family room. To be installed above fireplace, to accommodate future installation of wall mount TV. Plug to be installed Approx. 60" AFF (See Sketch) Note:
1 - MAIN HALL - Delete builders standard ceiling lights, Install FOUR (4) LED POT LIGHTS with ONE (1) Seperate Switch at main hall (See Sketch) Note: **TEN (10) Pot Lights with ONE (1) Switch Included in Standard Features and Finishes**
1 - KITCHEN - Relocate builders standard ceiling light at kitchen. To be installed centred above kitchen island (See Sketch) Note:
1 - KITCHEN - In addition to builders standard ceiling light, Install SIX (6) LED POT LIGHTS with ONE (1) Seperate Switch at kitchen (See Sketch) Note: **TEN (10) Pot Lights with ONE (1) Switch Included in Standard Features and Finishes** - Purchaser Paying for Additional Switch Only
1 - CLARIFICATION; EXTERIOR - GARAGE DOORS - Install STANDARD Exterior Handle with Lock on Garage Doors Note:
1 - FAMILY ROOM - MANTLE - Install UPGRADE STONE HEARTH 1.25" (Bevelled) - To be installed at family room fireplace standard mantle (See Sketch) Note: (National 1.25" Hearth)
1 - KITCHEN / BATHROOMS & LAUNDRY ROOM - SEE QUALITY TOPS & KITCHENS FOR ALL KITCHEN /BATHROOMS & LAUNDRY ROOM UPGRADES / LAYOUTS (See Attached QTK Paperwork) Note:
1 - KITCHEN - Install WATER LINE ROUGH-IN ONLY To Fridge Area of Kitchen (See Sketch) Note:
1 - KITCHEN - COUNTERTOP - Install Builders Standard Stone Countertop - EMMERSTONE VANILLA WHITE - To be installed throughout kitchen, where applicable (does not include stone backsplash) (See Sketch) Note:
1 - KITCHEN - COUNTERTOP EDGE - Install UPGRADE " L " EDGE PROFILE - To be installed throughout kitchen countertop, where applicable (See Sketch) Note:
1 - KITCHEN - BACKSPLASH - Install FULL HEIGHT STONE BACKSPLASH (Emmerstone Vanilla White) - To be installed throughout kitchen, where applicable (Does not include behind the fridge or stove) (See Sketch) Note:
1 - DISCLAIMER - STONE COUNTERTOP & FULL HEIGHT BACKSPLASH; KITCHEN - Stone slabs vary in size & all seams are visible & the fabricator reserves the right to position the seams as necessary. Note:
1 - KITCHEN - KITCHEN SINK - Install Builders Standard Undermount Sink - Blanco Horizon U2 (7" Deep) Undermount Sink - Model #401022 Note:



SITE COPY

CONSTRUCTION SUMMARY

Grovetrail Developments Inc.

PURCHASER: SOUHEIL KNEIFATI

TEL:

LOT NUMBER	PHASE	HOUSE TYPE	CLOSING DATE	
6	1	CHADWICK-OPT Main-Lndry on Main-Den on 2nd Elev A	06-Dec-22	

Date Added: 06-Apr-22

Invoice Number: 7854

1 - KITCHEN - KITCHEN FAUCET - Install Builders Standard Faucet - DELTA Osler Single Handle Pull-Down (Single Hole) Kitchen Faucet - Model # 976LF - Chrome Note:
90 - MASTER ENSUITE - FLOORING - UPGRADE #1 - PORCELAIN TILES - 20x20 PULPIS GRIS - To be installed throughout master ensuite floor, where applicable (To be Installed Straight) (See Sketch) Note:
1 - POWDER ROOM - COUNTERTOP - Install Builders Standard Stone Countertop - EMMERSTONE MAPLE WHITE with STANDARD " A " EDGE PROFILE - To be installed throughout powder room vanity, where applicable (Includes 3" Splash) (See Sketch) Note:
1 - MASTER ENSUITE - COUNTERTOP - Install UPGRADE #2 Stone Countertop - EMMERSTONE BORGHINI ARABESCATO with STANDARD " A " EDGE PROFILE - To be installed throughout master ensuite vanity, where applicable (Includes 3" Splash) (See Sketch) Note:
1 - TWIN BATH 3/4 - COUNTERTOP - Install UPGRADE #1 Stone Countertop - EMMERSTONE CALACATTA GOLD with STANDARD " A " EDGE PROFILE - To be installed throughout twin bath 3/4 vanity, where applicable (Includes 3" Splash) (See Sketch) Note:
1 - ENSUITE #2 - COUNTERTOP - Install UPGRADE #1 Stone Countertop - EMMERSTONE CALACATTA GOLD with STANDARD " A " EDGE PROFILE - To be installed throughout ensuite #2 vanity, where applicable (Includes 3" Splash) (See Sketch) Note:
1 - DISCLAIMER - STONE COUNTERTOP; POWDER ROOM, MASTER ENSUITE, ENSUITE #2 & TWIN BATH 3/4 - Stone slabs vary in size & all seams are visible & the fabricator reserves the right to position the seams as necessary. Note:
1 - BONUS PACKAGE - REFER TO PE #7661, ITEM #5 - PURCHASER HAS APPLIED REMAINING \$12,203.00 (Incudes Taxes) WORTH OF UPGRADE PROMOTIONAL PACKAGE TOWARDS THE PURCHASE OF DECOR UPGRADES COMPLETED AT THE DECOR CENTRE Note:
1 - PURCHASER HAS ATTENDED A COLOR APPOINTMENT AT THE DECOR CENTRE AND HAS DECLINED ANY ADDITIONAL UPGRADES.Purchaser accepts and acknowledges that there will be no further changes/additions/deletions to be made upon signing on APRIL 1,2022 Note:
1 - PURCHASER AWARE AND ACCEPTS THAT ANY CHANGES MADE TO UPGRADES AFTER SIGNING THIS PURCHASERS EXTRA FORM ARE SUBJECT TO A MINIMUM ADMINISTRATION FEE OF \$1,000 PLUS A 10% HOLDBACK FEE. Note:

Date Added: 20-Dec-21

Invoice Number: 7661

1 - GARAGE - Re-locate Central Vac Trunk Rough-In to Garage in lieu of Basement (Vendor to Determine Location) Note:
1 - FRONT EXTERIOR - In addition to builders standard coach light, Install ONE (1) ADDITIONAL EXTERIOR COACH LIGHT - To be installed beside front doors (See Sketch) Note: **Front Doors to have TWO (2) Exterior Coach Lights**
1 - SECOND FLOOR - CEILING - Install UPGRADE SMOOTH CEILINGS Throughout 2nd Floor BEDROOMS & DEN ONLY, where applicable - (DETACHED) To Include; Master Bedroom, Bedroom #2, Bedroom #3, Bedroom #4 and Den (See Sketch) Note:
1 - MASTER ENSUITE - Install SHOWER NICHE (Approx. 10" x 14") **INCLUDES WHITE QUARTZ** - To be installed at master ensuite shower stall, exterior wall with 4" dummywall to accommodate (See Sketch) Note:

* INTERIOR COLOUR SCHEME *

	Purchaser SOUHEIL KNEIFATI	Decor Consultant Melissa Di Marino	Model and Elevation ADWICK-OPT Main-Lndry on Main-Den on 2nd Ele	Telephone Res. / Bus /	Project Grovetrail Developments Inc.	Closing Date 06/12/2022	Property 6
--	--------------------------------------	--	--	----------------------------------	--	-----------------------------------	----------------------

Page 2 of 3

Master Ensuite

Ensuite #2

Twin Bath 3/4

Powder Room

Mud Room

Laundry Room

Kitchen/Dinette

Foyer

Main Hall

Family Room

Upper Hall

Den

Master Bedroom

Bedroom 2

Bedroom 3

Bedroom 4

Interior Paint

Description

STANDARD - SILVER BIRCH

STANDARD - SILVER BIRCH

Cabinet

Style

SEE ATTACHED QTK PAPERWORK

SEE ATTACHED QTK PAPERWORK

SEE ATTACHED QTK PAPERWORK

SEE ATTACHED QTK PAPERWORK

N/A

SEE ATTACHED QTK PAPERWORK

SEE ATTACHED QTK PAPERWORK

STANDARD - SILVER BIRCH

STANDARD - SILVER BIRCH

Countertop

Emmerstone Borghini Arabescato (Upg)

Emmerstone Calacatta Gold (Upg)

Emmerstone Calacatta Gold (Upg)

Emmerstone Maple White (STD)

N/A

SEE QTK PAPERWORK

Emmerstone Vanilla White (STD)

Emmerstone Maple White (STD)

Emmerstone Maple White (STD)

Counter Edge

A * EDGE (STD)

A * EDGE (STD)

A * EDGE (STD)

A * EDGE (STD)

N/A

SEE QTK PAPERWORK

L * EDGE (UPG)

Emmerstone Maple White (STD)

Emmerstone Maple White (STD)

Handle / Knob

SEE QTK

SEE QTK

SEE QTK

SEE QTK

N/A

SEE QTK

SEE QTK

Emmerstone Maple White (STD)

Emmerstone Maple White (STD)

Appliance Opening/Dimension

Fridge Size SEE QTK LAYOUT

Range SEE QTK LAYOUT

Built-Ins None

Microwave None

Hood Fan Std 30in

Exhaust Opening 6" 8"

Dishwasher Cabinet Std 24in Opening

Fireplace

Fireplace FAMILY ROOM

Location Flooring 3 1/4" HARDWOOD

Style VILLA NOVA

Finish STONE

Marble N/A

Hearth UPG - BEVELLED 1.25"

Fireplace N/A

Location Flooring N/A

Style N/A

Finish N/A

Marble N/A

Hearth N/A

Notes

KITCHEN - INSTALL BUILDERS STANDARD STAINLESS STEEL EXHAUST FAN

Page 2 of 3

Decor Consultant:

Melissa Di Marino

Purchaser:

DocuSigned by:

Souheil Kneifati

22A45786B52F5491...
SOUHEIL KNEIFATI

Vendor:


Grovetrail Developments Inc.

Printed Apr 01, 2022 1:44 pm

DEC. 20, 2021


SK

Cable - (XZ)
Telephone - (XZ)
Electrical - (X)
Conduit (X)

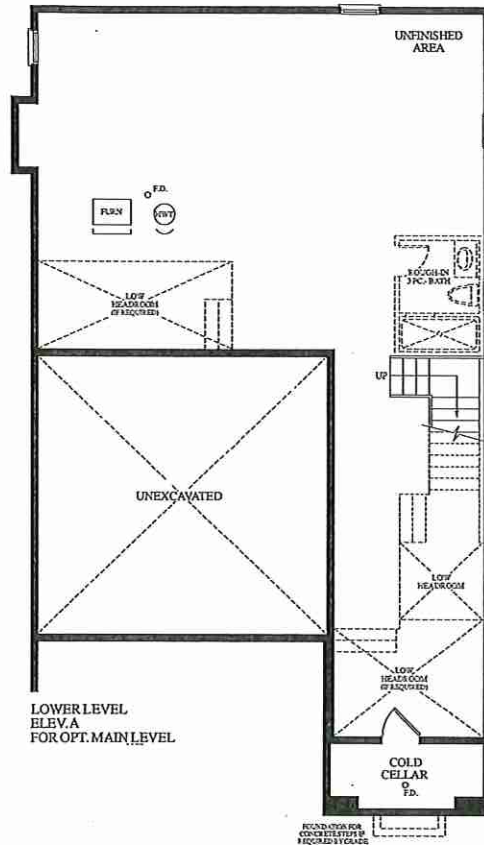

LOWER LEVEL
ELEV.A
FOR OPT.MAIN LEVEL

NOV. 22

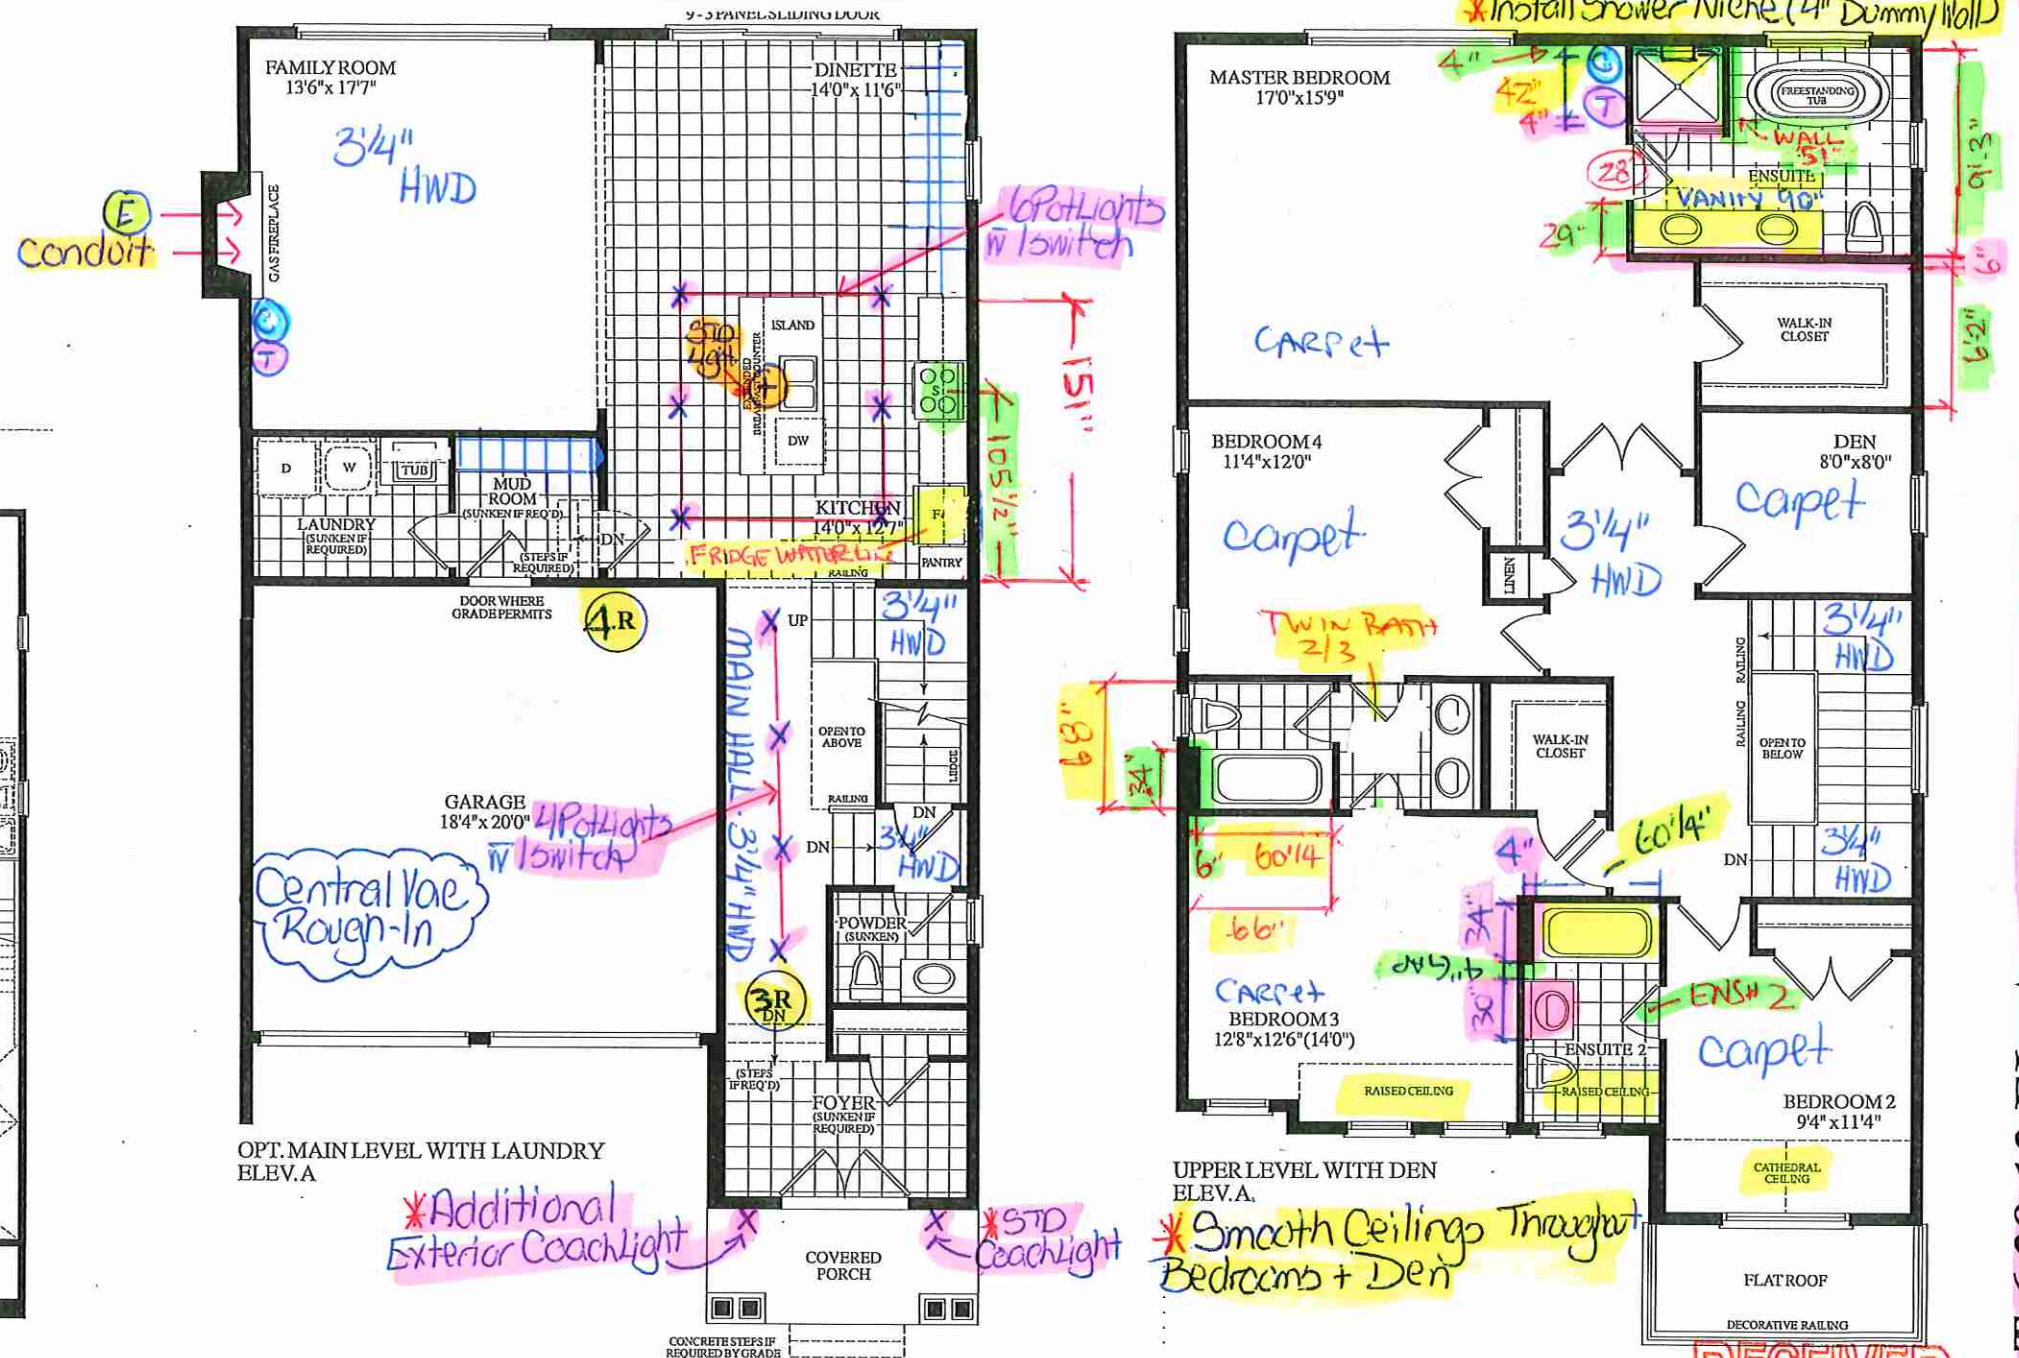

Dimensions, specifications, layouts, window sizes, and materials are approximate only, may vary, and are subject to change as provided in the Agreement of Purchase & Sale. Plans may be reversed. Illustrations are artist's concept. E&O.E.

RECEIVED
NOV. 22/21

LOT 6 38-13 EL. A Optional Main With Laundry/ Upper Lever with Den



Quality Tops & Kitchens Ltd.
80 Sante Drive, Vaughan, ON L4K 3C4
T 416.746.1811 F 905.761.5901
www.QTK.ca info@qtk.ca

PURCHASE AGREEMENT FORM

PURCHASER:	SOULHEIL KNEIFATI Ani	CONTRACTOR:	Grovetrail Developments Inc.
ADDRESS:		SITE:	CENTERFIELD
EMAIL:	smk80@hotmail.com y-ani@hotmail.com	MODEL TYPE:	38-13
PHONE #:		LOT #:	LOT 6 CTF
PHONE #:	(416) 546-0395	DATE:	Mar 11, 2022 Q9126

The purchaser agrees to buy and Quality Tops & Kitchens Ltd. (QTK) agrees to sell and provide for the purchaser the following articles listed herein and with attached drawing in accordance to the terms and conditions described on the reverse of this agreement form.

ROOM	DESCRIPTION	CATEGORY
KITCHEN	DOOR STYLE: QT 1203 NONE FINISH: WHITE SPECIES: FIBERBOARD DOOR HARDWARE: DRW HARDWARE: COUNTER TOP: Counter Top by Others	Category 1

ITEM #	QTY	DESCRIPTION	PRICE
BGB4	1	3 BIN PULL-OUT RECYCLE UNIT - 24" WIDE CABINET. 2 x 35 L BINS FOR GARBAGE & RECYCLING + 1 x 21 L COMPOST BIN.	
4BD	1	1 SET KITCHEN DRWS w/ BLUM ANTARO WHITE (4 EQ DRWS) - (OPTION PAID FOR BY BUILDER)	
CUST-1	1	26" DEEP FRIDGE ENCLOSURE w/ 2 GABLES (OPTION PAID BY BUILDER)	
CUST-5	1	CATEGORY 1 DOOR STYLE AND FINISH: QTF 1201 WHITE	
CUST-6	1	CATEGORY 1 HARDWARE: DH01010	
CUST-7	1	CM X42 (OPTION PAID FOR BY BUILDER)	
ROOM SUMMARY:			

ROOM	DESCRIPTION	CATEGORY
ENSUITE VANITY	DOOR STYLE: QT 1022 NONE FINISH: BLACKWOOD SPECIES: LP LAMINATE DOOR HARDWARE: DRW HARDWARE: COUNTER TOP: Counter Top by Others	Category 1

ITEM #	QTY	DESCRIPTION	PRICE
CUST-1	1	RAISE VANITY HEIGHT TO 34-1/2" - PER VANITY	
CUST-2	1	CONVERT TOP DRAWER INTO 1 SET OF 3 DRAWERS w/ PREMIUM MOTION SLIDES	
CUST-3	1	CATEGORY 1 DOOR STYLE AND FINISH: QTS 1022 BLACKWOOD	
CUST-4	1	CATEGORY 1 HARDWARE: DH00010	
ROOM SUMMARY:			

ROOM	DESCRIPTION	CATEGORY
ENSUITE # 2 VANITY	DOOR STYLE: QT 1022 NONE FINISH: BLACKWOOD SPECIES: LP LAMINATE DOOR HARDWARE: DRW HARDWARE: COUNTER TOP: Counter Top by Others	Category 1

ITEM #	QTY	DESCRIPTION	PRICE
CUST-1	1	RAISE VANITY HEIGHT TO 34-1/2" - PER VANITY	
CUST-2	1	CATEGORY 1 DOOR STYLE AND FINISH: QTS 1022 BLACKWOOD (TX)	
CUST-3	1	CATEGORY 1 HARDWARE: DH00010	
ROOM SUMMARY:			



Quality Tops & Kitchens Ltd.
 80 Sante Drive, Vaughan, ON L4K 3C4
 T 416.746.1811 F 905.761.5901
 www.QTK.ca info@qtk.ca

PURCHASE AGREEMENT FORM

PURCHASER:		SOULHEIL KNEIFATI Ani		CONTRACTOR:		Grovetrail Developments Inc.	
ADDRESS:				SITE:		CENTERFIELD	
EMAIL:		smk80@hotmail.com y-ani@hotmail.com		MODEL TYPE:		38-13	
PHONE #:				LOT #:		LOT 6 CTF	
PHONE #:		(416) 546-0395		DATE:		Mar 11, 2022 Q9126	

ROOM	DESCRIPTION		CATEGORY
Twin Bath 3/4	DOOR STYLE: QT 1022 FINISH: BLACKWOOD SPECIES: LP LAMINATE DOOR HARDWARE: DRW HARDWARE: COUNTER TOP: Counter Top by Others	NONE	Category 1

ITEM #	QTY	DESCRIPTION	PRICE
CUST-1	1	RAISE VANITY HEIGHT TO 34-1/2" - PER VANITY	
CUST-2	1	CATEGORY 1 DOOR STYLE AND FINISH: QTS 1022 BLACKWOOD (TX)	
CUST-3	1	CATEGORY 1 HARDWARE: DH00010	
ROOM SUMMARY:			

ROOM	DESCRIPTION		CATEGORY
POWDER ROOM VANITY	DOOR STYLE: QT 1022 FINISH: OLMO CARISMA SPECIES: LP LAMINATE DOOR HARDWARE: DRW HARDWARE: COUNTER TOP: Counter Top by Others	NONE	Category 1

ITEM #	QTY	DESCRIPTION	PRICE
CUST-1	1	FLOATING VANITY BASE CABINET 21"D x 31"H w/ 1 DRAWER - OPTION PAID FOR BY BUILDER	
CUST-2	1	CATEGORY 1 DOOR STYLE AND FINISH: QTS 1022 OLMO CARISMA	
CUST-3	1	CATEGORY 1 HARDWARE: DH00010	
ROOM SUMMARY:			

ROOM	DESCRIPTION		CATEGORY
LAUNDRY ROOM	DOOR STYLE: QT 1022 FINISH: BLACKWOOD SPECIES: LP LAMINATE DOOR HARDWARE: DRW HARDWARE: COUNTER TOP: Laminate Top by QTK	NONE D354-60	Category 1

ITEM #	QTY	DESCRIPTION	PRICE
CUST-2	1	CATEGORY 1 DOOR STYLE AND FINISH: QTS 1022 BLACKWOOD (TX)	
CUST-3	1	CATEGORY 1 HARDWARE: DH00010	
ROOM SUMMARY:			



Quality Tops & Kitchens Ltd.
80 Sante Drive, Vaughan, ON L4K 3C4
T 416.746.1811 F 905.761.5901
www.QTK.ca info@qtk.ca

PURCHASE AGREEMENT FORM

PURCHASER:	SOULHEIL KNEIFATI Ani	CONTRACTOR:	Grovetrail Developments Inc.
ADDRESS:		SITE:	CENTERFIELD
EMAIL:	smk80@hotmail.com y-ani@hotmail.com	MODEL TYPE:	38-13
PHONE #:		LOT #:	LOT 6 CTF
PHONE #:	(416) 546-0395	DATE:	Mar 11, 2022 Q9126

EXPECTED DELIVERY DATE	TBD	SUB-TOTAL:	
Customers please note all garbage bins, spice baskets, magic corner baskets and other accessories will only be delivered AFTER you move in the house. Please call us to request delivery of these items after you move in. Thank you. ALL CHANGES FINAL UPON SIGNING		TOTAL:	
PLEASE READ ALL THE TERMS AND CONDITIONS ON THE ACCOMPANYING QTK TERMS & CONDITIONS DOCUMENT. BY SIGNING BELOW YOU AGREE TO RECEIVE THE ITEMS LISTED HEREIN AND PAY (ACCORDING TO QTK'S PAYMENT POLICY), AND HAVE READ AND UNDERSTOOD THE TERMS & CONDITIONS AS OUTLINED IN THE QTK TERMS & CONDITIONS DOCUMENT.		HST	
		GRAND TOTAL:	
DEPOSIT 1 DATE:		DEPOSIT 1:	
DEPOSIT 2 DATE:		DEPOSIT 2:	
BALANCE TO BE PAID IN FULL BY DUE DATE:		CUSTOMER INITIAL(S):	SK

CUSTOMER SIGNATURE: Soulheil DATE: 11 Mar 2022

CUSTOMER SIGNATURE: _____ DATE: _____

SALES REP NAME: _____ - apD QTK AUTHORIZED SIGNATURE: _____




80 Sante Drive, Vaughan, ON L4K 3C4
T 416.746.1811 F 905.761.5901
www.QTK.ca info@qtk.ca

CLIENT: ROYAL PINE HOMES	JOB NAME: LOT 6 CTF (38-13)	ROOM: KITCHEN	DRAWN BY: AA
SITE: CENTREFIELD	DOOR STYLE: __	DOOR HANDLE: __	SCALE: 1/2" = 1'-0"
PHONE: __	FINISH: __	DRW HANDLE: __	DATE: MAR 16 2022
EMAIL: __	SPECIES: __	TOP: __	PAGE:
COMMENTS:			

Customer Agrees and Accepts the following conditions: 1. The Drawing is a representation only and the installed cabinetry may vary slightly in product size, measurements, handle appearance and location and other details. Although Quality Tops & Kitchens Ltd. (QTK) does it's best to manufacture exactly what is shown here outside factors may prevent that and some variance is to be expected and accepted by the customer. 2. These drawings represent the intellectual property of QTK and as such the customer understands and accepts that all deposits given by the customer to QTK are non-refundable after QTK has supplied drawings (either physically or electronically) to the customer. If the customer decides to cancel the order after QTK has submitted drawings to the customer, the deposit will then be considered a design fee and no money will be returned to the customer.

KITCHEN PLAN

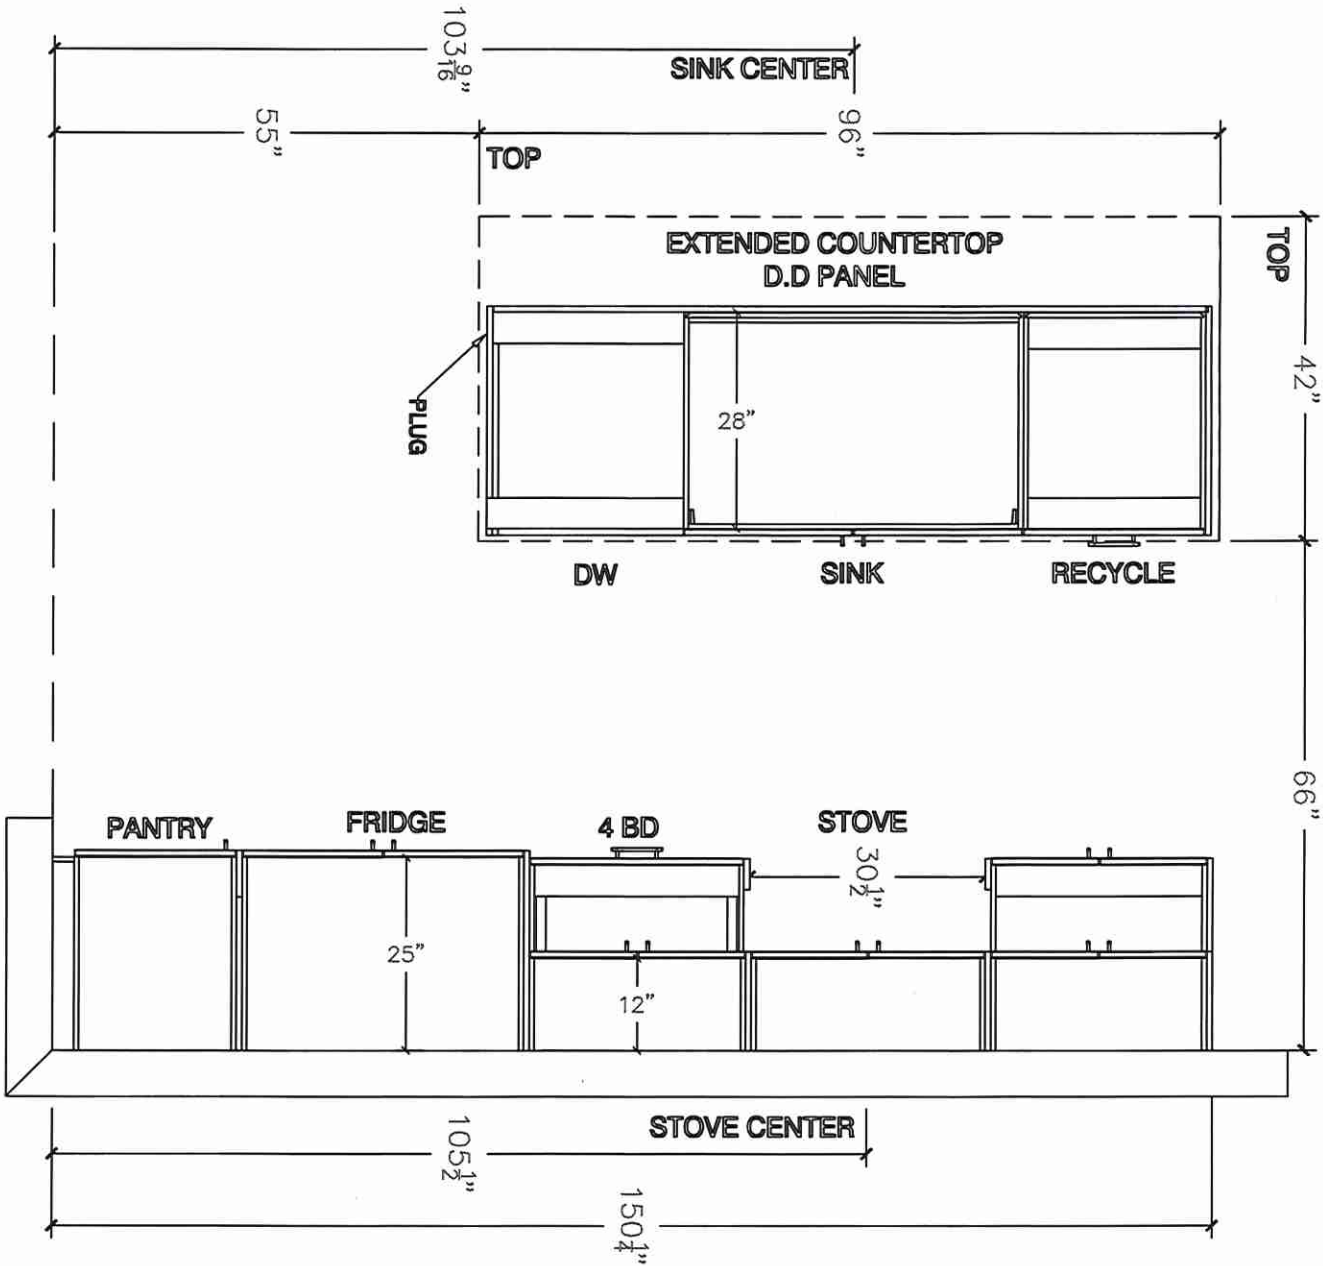

Souheil

18 Mar 2022




80 Sante Drive, Vaughan, ON L4K 3C4
T 416.746.1811 F 905.761.5901
www.QTK.ca info@qtk.ca

CLIENT: ROYAL PINE HOMES	JOB NAME: LOT 6 CTF (38-13)	ROOM: KITCHEN	DRAWN BY: AA
SITE: CENTREFIELD	DOOR STYLE: —	DOOR HANDLE: —	SCALE: 1/2" = 1'-0"
PHONE: —	FINISH: —	DRW HANDLE: —	DATE: MAR 16 2022
EMAIL: —	SPECIES: —	TOP: —	PAGE:
COMMENTS:			

Customer Agrees and Accepts the following conditions: 1. The Drawing is a representation only and the installed cabinetry may vary slightly in product size, measurements, handle appearance and location and other details. Although Quality Tops & Kitchens Ltd. (QTK) does it's best to manufacture exactly what is shown here outside factors may prevent that and some variance is to be expected and accepted by the customer. 2. These drawings represent the intellectual property of QTK and as such the customer understands and accepts that all deposits given by the customer to QTK are non-refundable after QTK has supplied drawings (either physically or electronically) to the customer. If the customer decides to cancel the order after QTK has submitted drawings to the customer, the deposit will then be considered a design fee and no money will be returned to the customer.

FRIDGE/STOVE WALL - ELEVATION

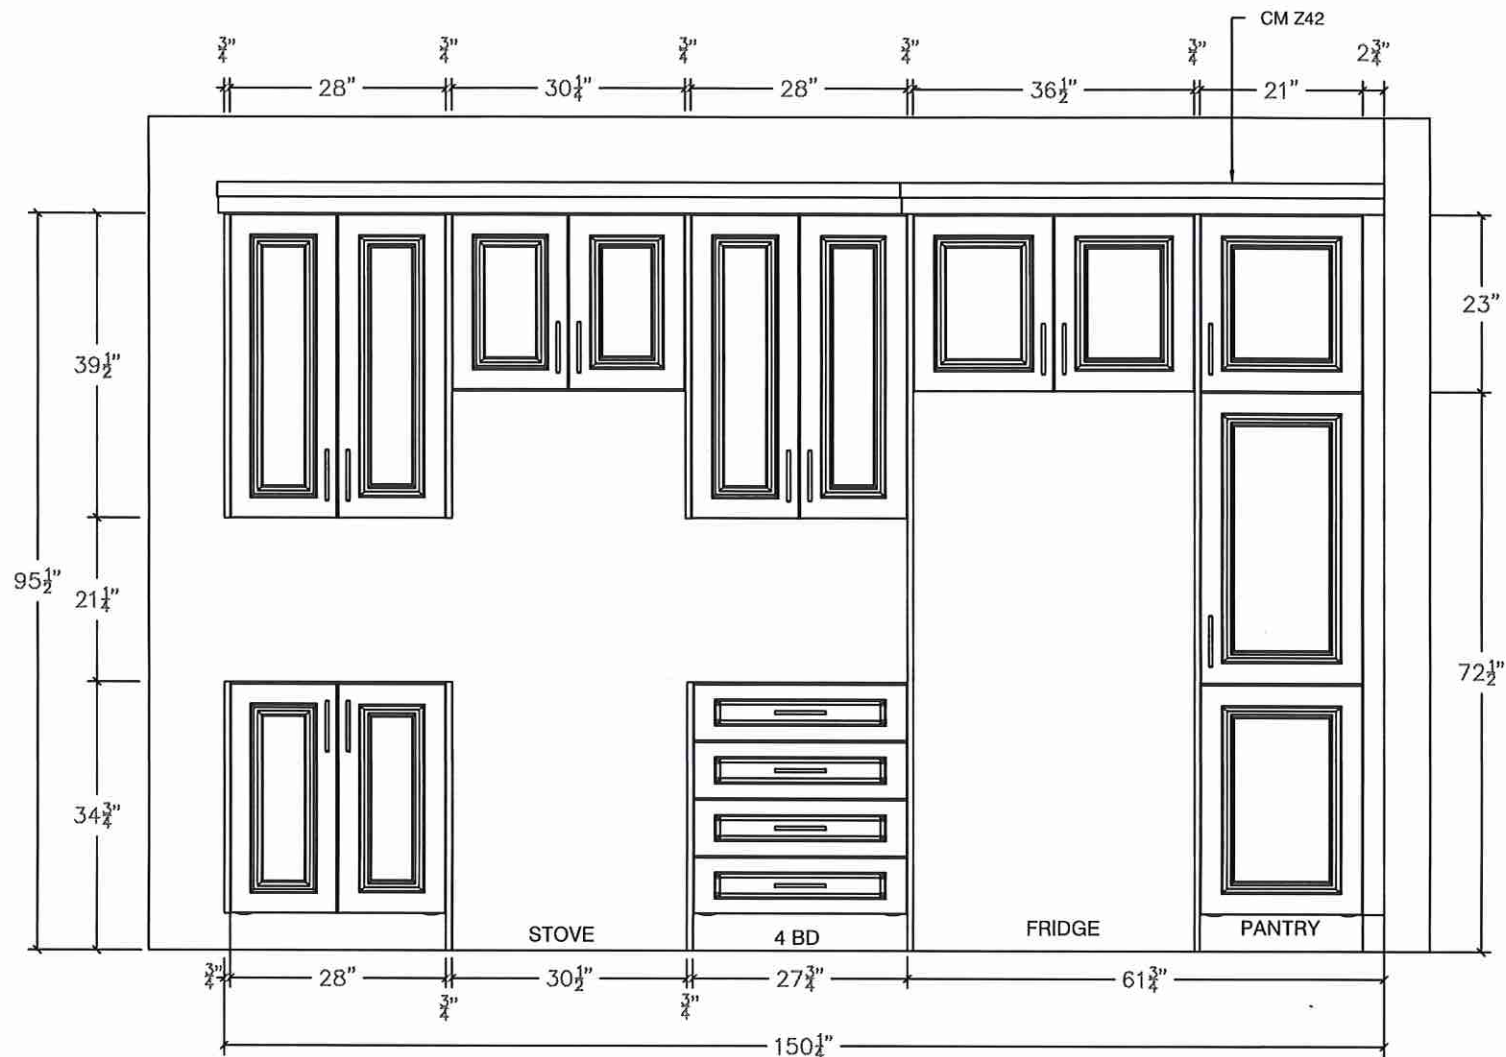

Souheil
18 Mar 2022




80 Sante Drive, Vaughan, ON L4K 3C4
T 416.746.1811 F 905.761.5901
www.QTK.ca info@qtk.ca


CLIENT: ROYAL PINE HOMES	JOB NAME: LOT 6 CTF (38-13)	ROOM: KITCHEN	DRAWN BY: AA
SITE: CENTREFIELD	DOOR STYLE: —	DOOR HANDLE: —	SCALE: 1/2" = 1'-0"
PHONE: —	FINISH: —	DRW HANDLE: —	DATE: MAR 16 2022
EMAIL: —	SPECIES: —	TOP: —	PAGE:
COMMENTS:			

Customer Agrees and Accepts the following conditions: 1. The Drawing is a representation only and the installed cabinetry may vary slightly in product size, measurements, handle appearance and location and other details. Although Quality Tops & Kitchens Ltd. (QTK) does it's best to manufacture exactly what is shown here outside factors may prevent that and some variance is to be expected and accepted by the customer. 2. These drawings represent the intellectual property of QTK and as such the customer understands and accepts that all deposits given by the customer to QTK are non-refundable after QTK has supplied drawings (either physically or electronically) to the customer. If the customer decides to cancel the order after QTK has submitted drawings to the customer, the deposit will then be considered a design fee and no money will be returned to the customer.


ISLAND FRONT - ELEVATION

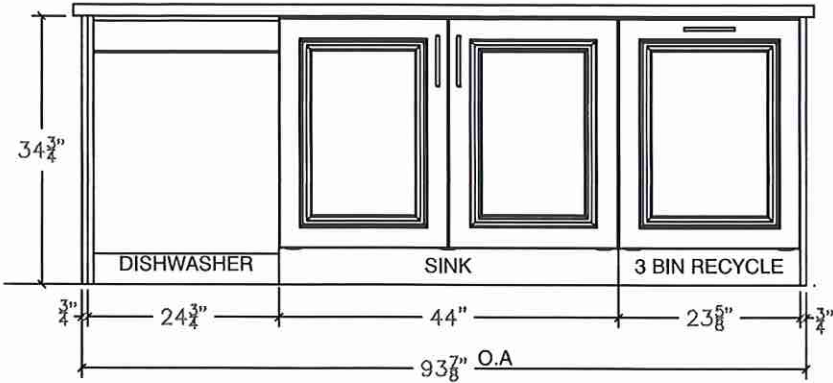

ISLAND REAR - ELEVATION

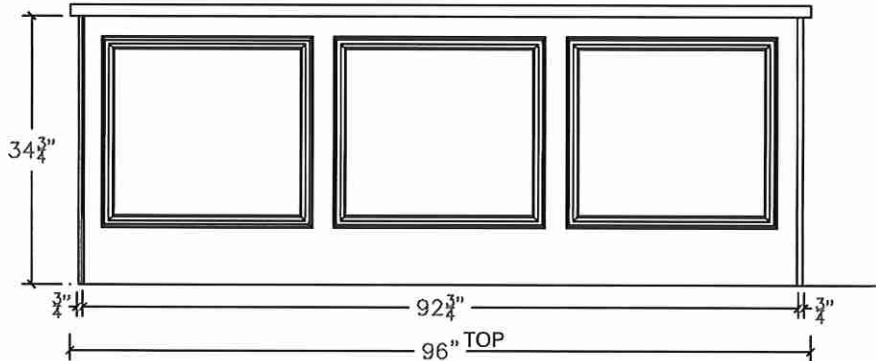

ISLAND SIDE - ELEVATION

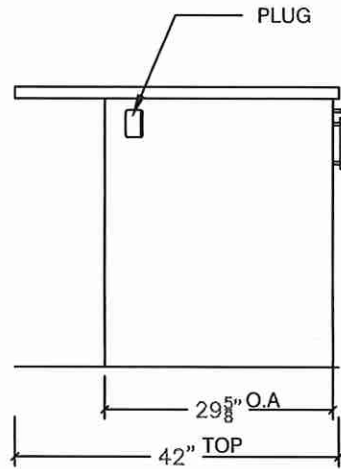

Souheil

18 Mar 2022




80 Sante Drive, Vaughan, ON L4K 3C4
T 416.746.1811 F 905.761.5901
www.QTK.ca info@qtk.ca

CLIENT: ROYAL PINE HOMES	JOB NAME: LOT 6 CTF (38-13)	ROOM: KITCHEN	DRAWN BY: AA
SITE: CENTREFIELD	DOOR STYLE: —	DOOR HANDLE: —	SCALE: 1/2" = 1'-0"
PHONE: —	FINISH: —	DRW HANDLE: —	DATE: MAR 16 2022
EMAIL: —	SPECIES: —	TOP: —	PAGE:
COMMENTS:			

Customer Agrees and Accepts the following conditions: 1. The Drawing is a representation only and the installed cabinetry may vary slightly in product size, measurements, handle appearance and location and other details. Although Quality Tops & Kitchens Ltd. (QTK) does it's best to manufacture exactly what is shown here outside factors may prevent that and some variance is to be expected and accepted by the customer. 2. These drawings represent the intellectual property of QTK and as such the customer understands and accepts that all deposits given by the customer to QTK are non-refundable after QTK has supplied drawings (either physically or electronically) to the customer. If the customer decides to cancel the order after QTK has submitted drawings to the customer, the deposit will then be considered a design fee and no money will be returned to the customer.

KITCHEN ISOMETRIC

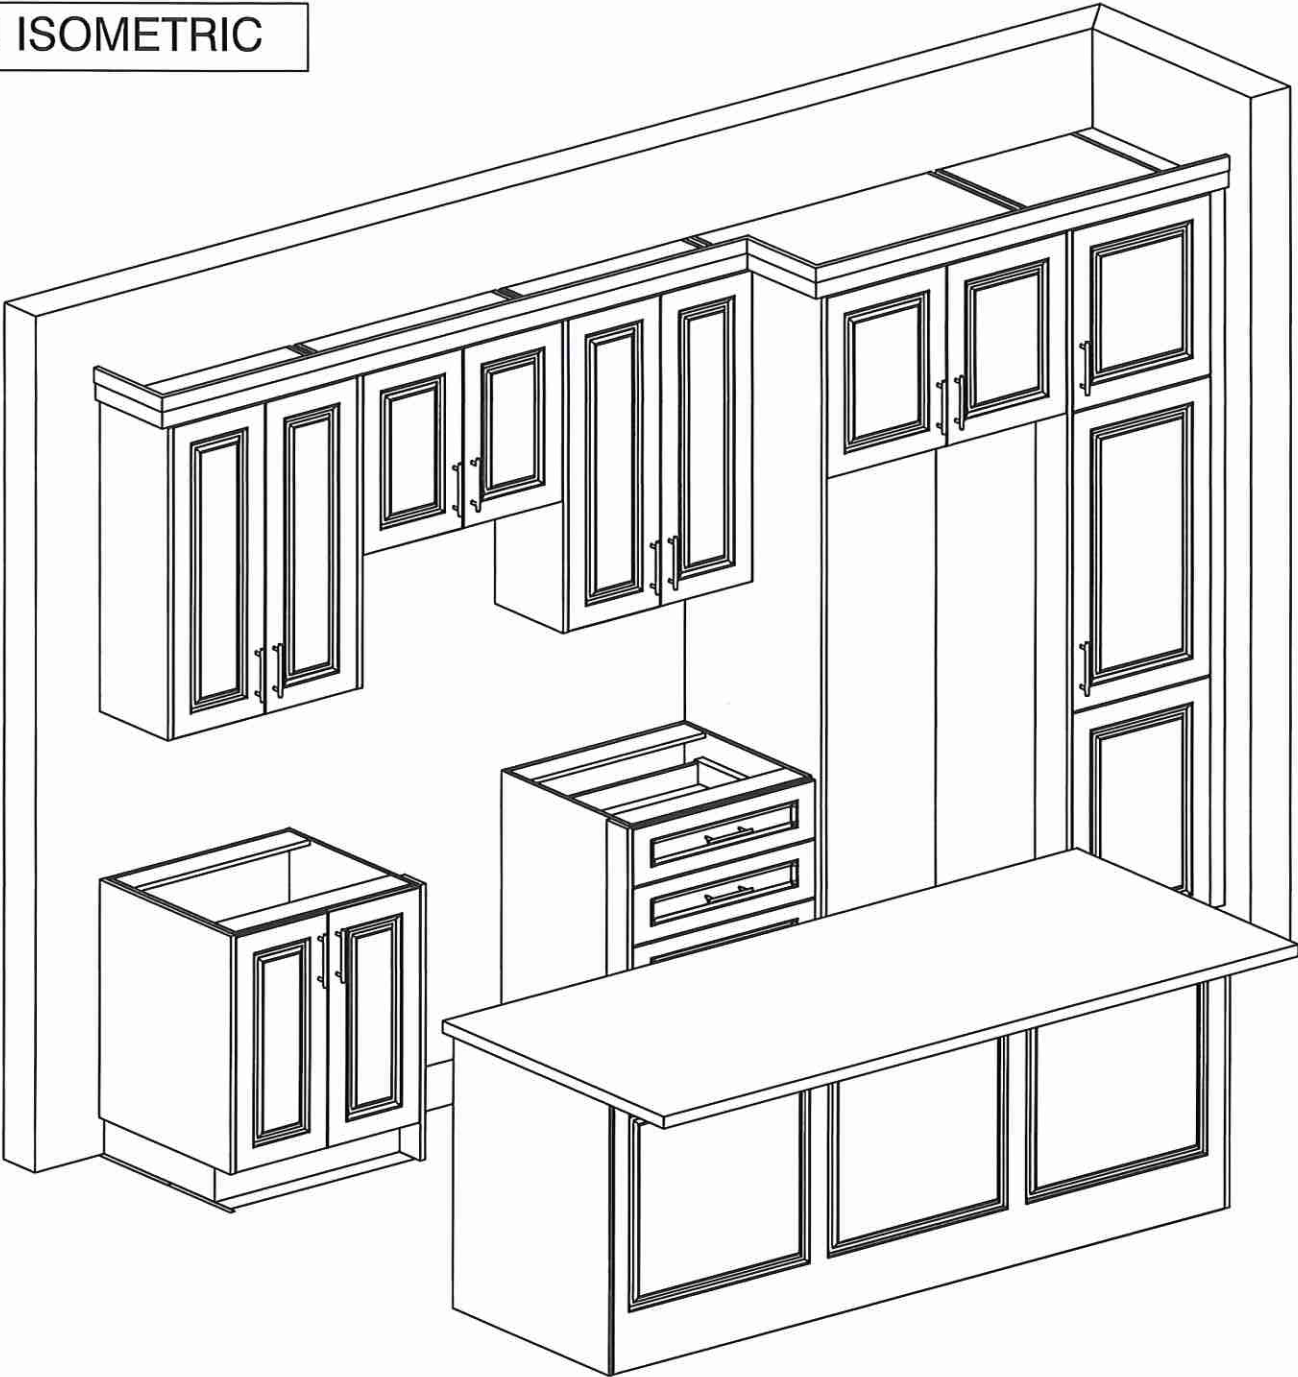



Souheil
18 Mar 2022



80 Sante Drive, Vaughan, ON L4K 3C4
T 416.746.1811 F 905.761.5901
www.QTK.ca info@qtk.ca

CLIENT: ROYAL PINE HOMES	JOB NAME: LOT 6 CTF (38-13)	ROOM: VANITY	DRAWN BY: AA
SITE: CENTREFIELD	DOOR STYLE: —	DOOR HANDLE: —	SCALE: 1/2" = 1'-0"
PHONE: —	FINISH: —	DRW HANDLE: —	DATE: MAR 16 2022
EMAIL: —	SPECIES: —	TOP: —	PAGE: —
COMMENTS:			

Customer Agrees and Accepts the following conditions: 1. The Drawing is a representation only and the installed cabinetry may vary slightly in product size, measurements, handle appearance and location and other details. Although Quality Tops & Kitchens Ltd. (QTK) does it's best to manufacture exactly what is shown here outside factors may prevent that and some variance is to be expected and accepted by the customer. 2. These drawings represent the intellectual property of QTK and as such the customer understands and accepts that all deposits given by the customer to QTK are non-refundable after QTK has supplied drawings (either physically or electronically) to the customer. If the customer decides to cancel the order after QTK has submitted drawings to the customer, the deposit will then be considered a design fee and no money will be returned to the customer.

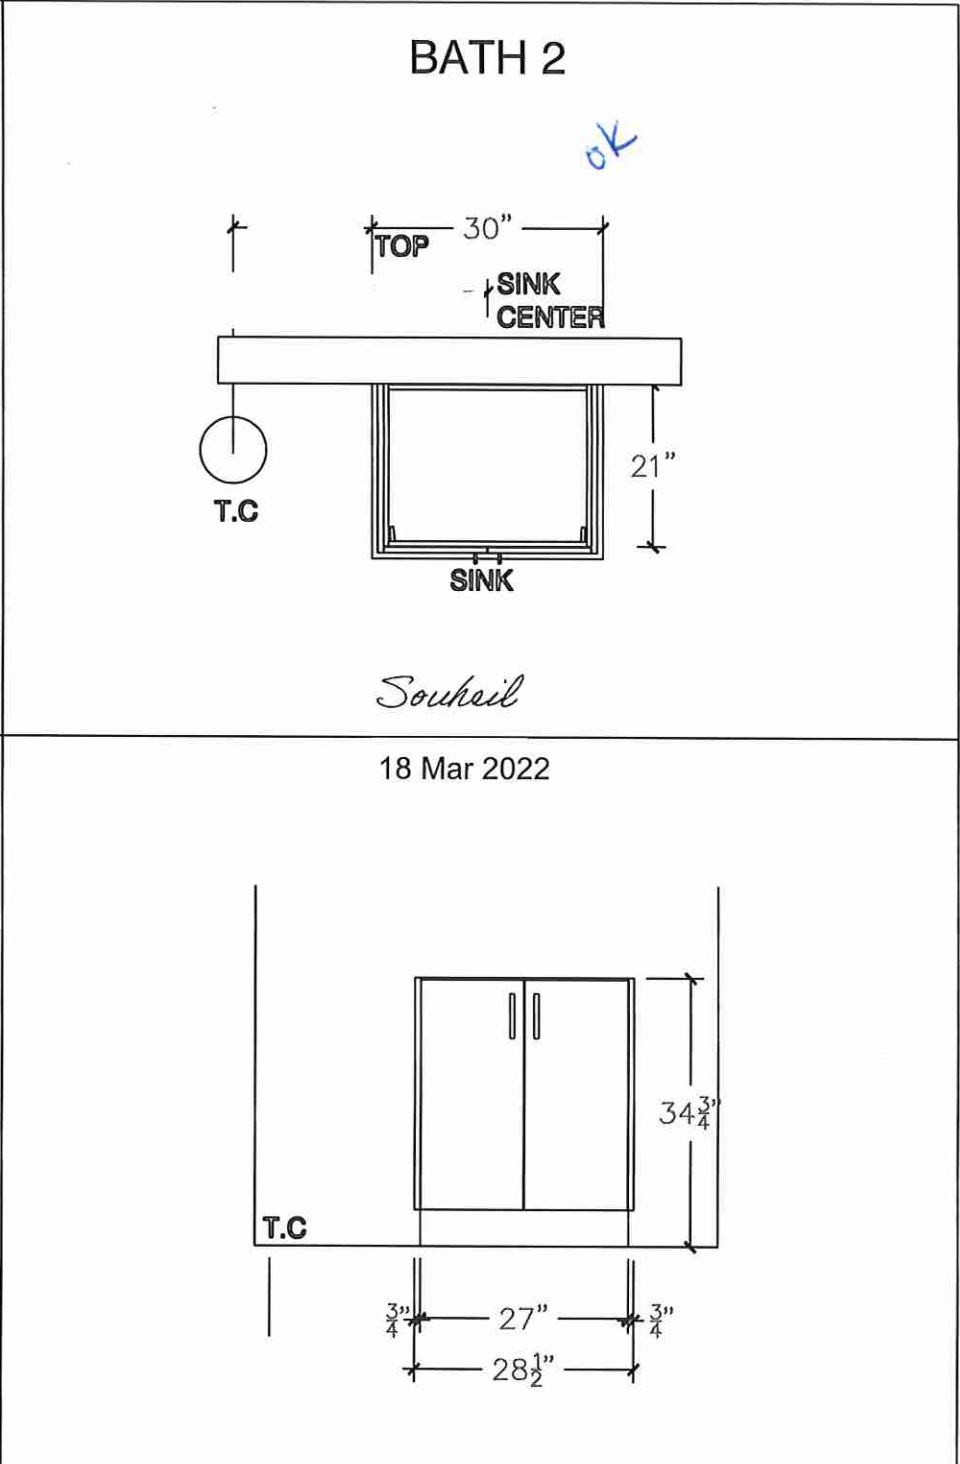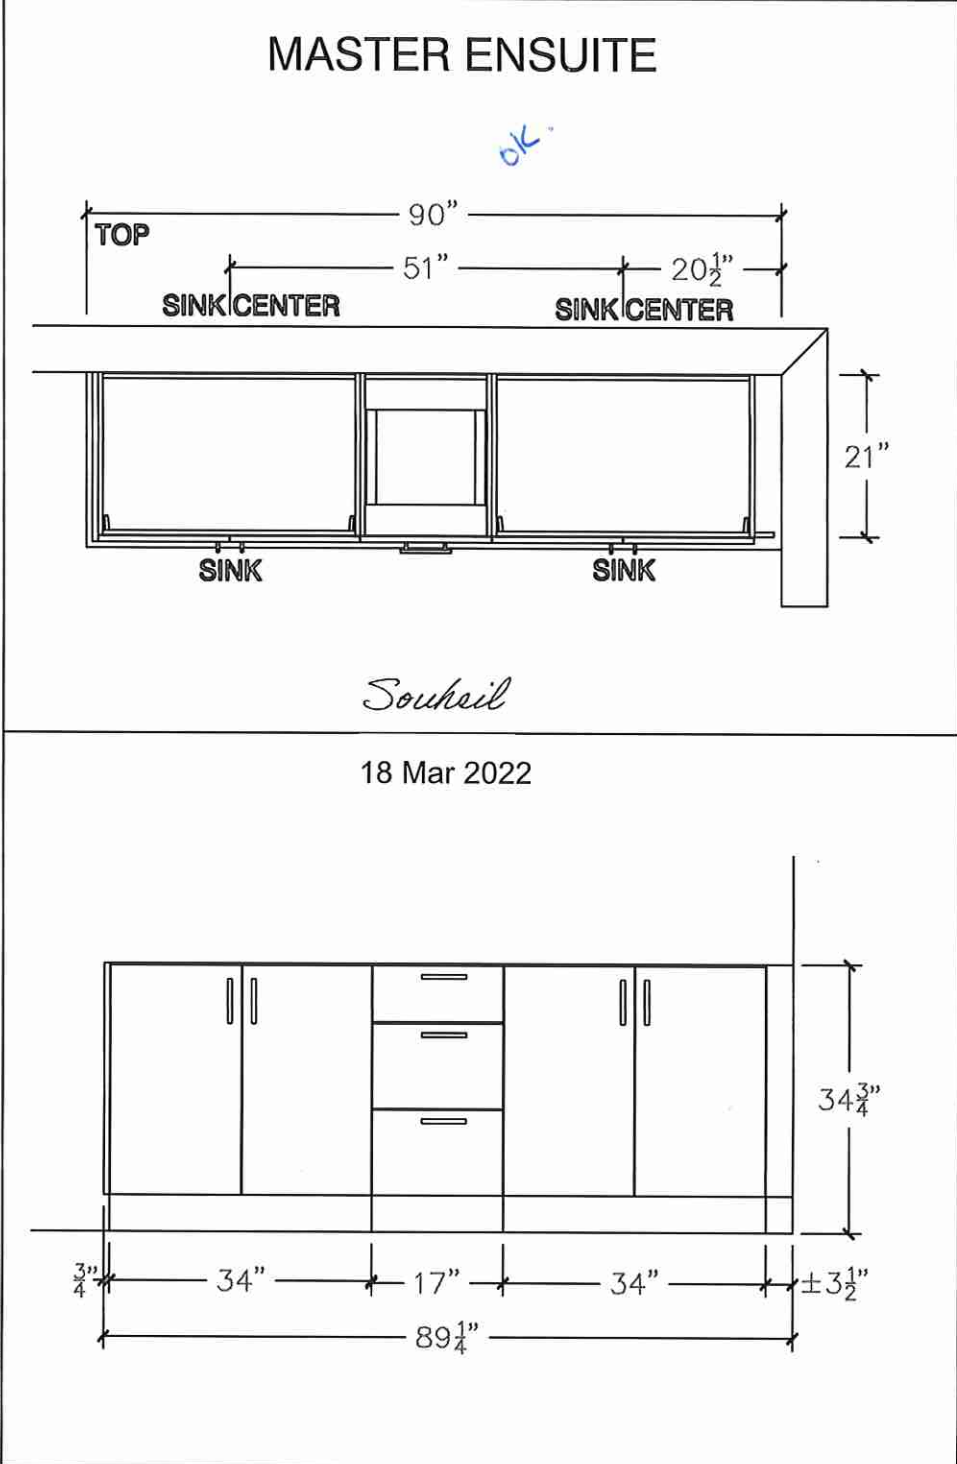




80 Sante Drive, Vaughan, ON L4K 3C4
T 416.746.1811 F 905.761.5901
www.QTK.ca info@qtk.ca



CLIENT: ROYAL PINE HOMES	JOB NAME: LOT 6 CTF (38-13)	ROOM: VANITY	DRAWN BY: AA
SITE: CENTREFIELD	DOOR STYLE: —	DOOR HANDLE: —	SCALE: 1/2" = 1'-0"
PHONE: —	FINISH: —	DRW HANDLE: —	DATE: MAR 16 2022
EMAIL: —	SPECIES: —	TOP: —	PAGE: —
COMMENTS:			

Customer Agrees and Accepts the following conditions: 1. The Drawing is a representation only and the installed cabinetry may vary slightly in product size, measurements, handle appearance and location and other details. Although Quality Tops & Kitchens Ltd. (QTK) does it's best to manufacture exactly what is shown here outside factors may prevent that and some variance is to be expected and accepted by the customer. 2. These drawings represent the intellectual property of QTK and as such the customer understands and accepts that all deposits given by the customer to QTK are non-refundable after QTK has supplied drawings (either physically or electronically) to the customer. If the customer decides to cancel the order after QTK has submitted drawings to the customer, the deposit will then be considered a design fee and no money will be returned to the customer.

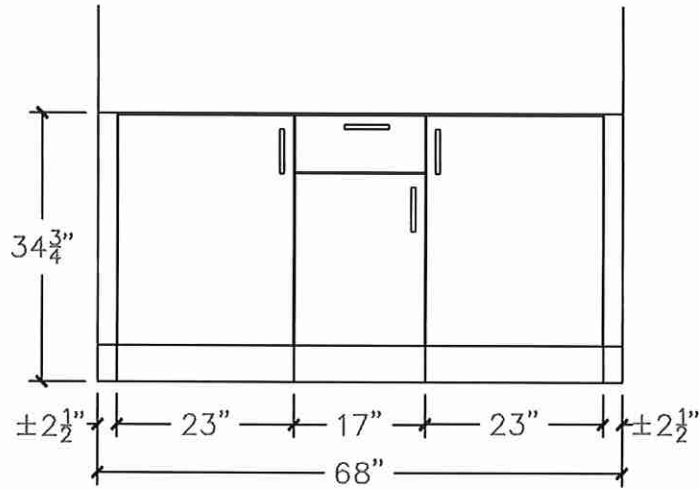


18 Mar 2022

Souheil

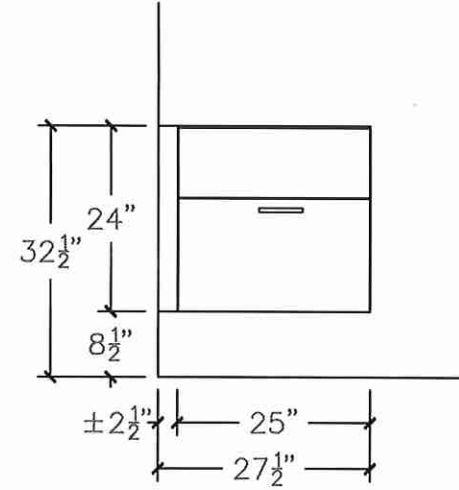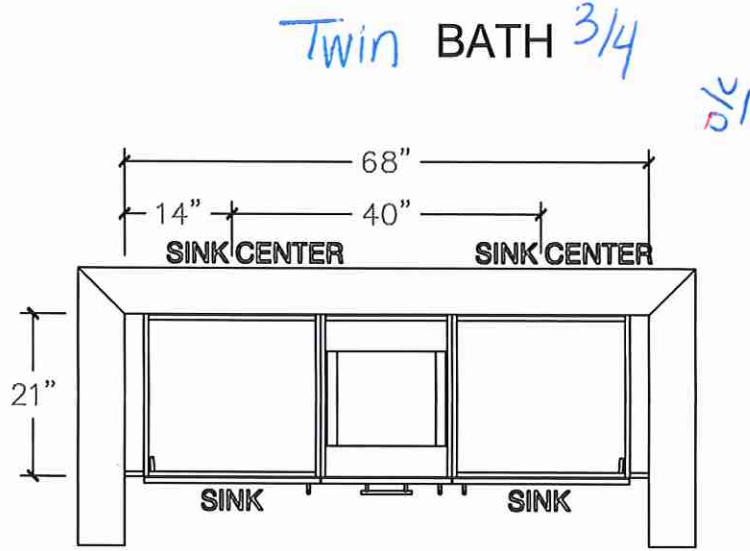

18 Mar 2022

Souheil

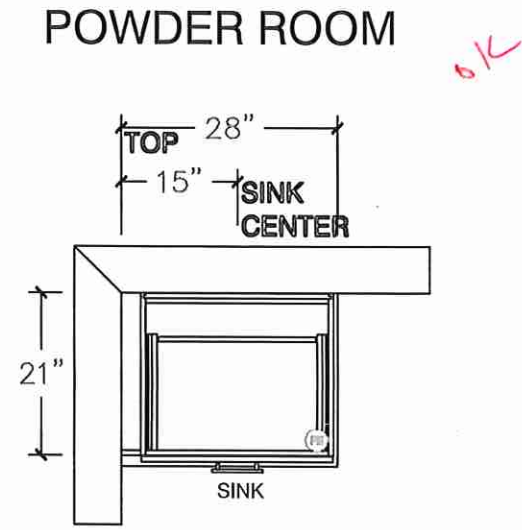

POWDER ROOM





80 Sante Drive, Vaughan, ON L4K 3C4
T 416.746.1811 F 905.761.5901
www.QTK.ca info@qtk.ca

CLIENT: ROYAL PINE HOMES	JOB NAME: LOT 6 CTF (38-13)	ROOM: LAUNDRY	DRAWN BY: AA
SITE: CENTREFIELD	DOOR STYLE: —	DOOR HANDLE: —	SCALE: 1/2" = 1'-0"
PHONE: —	FINISH: —	DRW HANDLE: —	DATE: MAR 16 2022
EMAIL: —	SPECIES: —	TOP: —	PAGE:
COMMENTS:			

Customer Agrees and Accepts the following conditions: 1. The Drawing is a representation only and the installed cabinetry may vary slightly in product size, measurements, handle appearance and location and other details. Although Quality Tops & Kitchens Ltd. (QTK) does it's best to manufacture exactly what is shown here outside factors may prevent that and some variance is to be expected and accepted by the customer. 2. These drawings represent the intellectual property of QTK and as such the customer understands and accepts that all deposits given by the customer to QTK are non-refundable after QTK has supplied drawings (either physically or electronically) to the customer. If the customer decides to cancel the order after QTK has submitted drawings to the customer, the deposit will then be considered a design fee and no money will be returned to the customer.

LAUNDRY

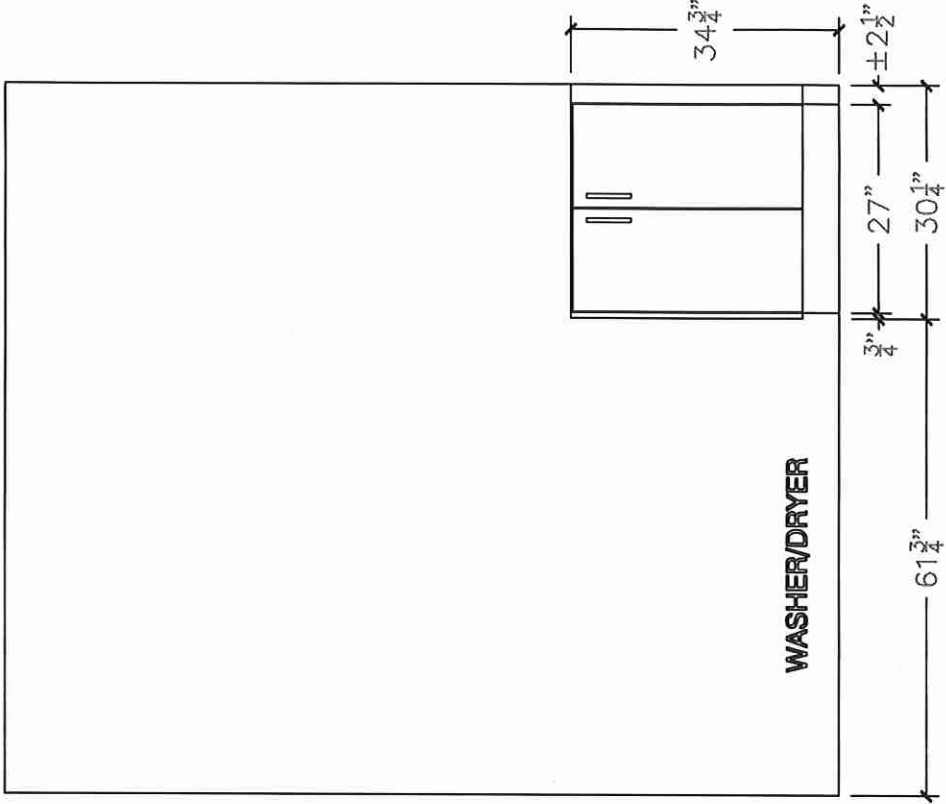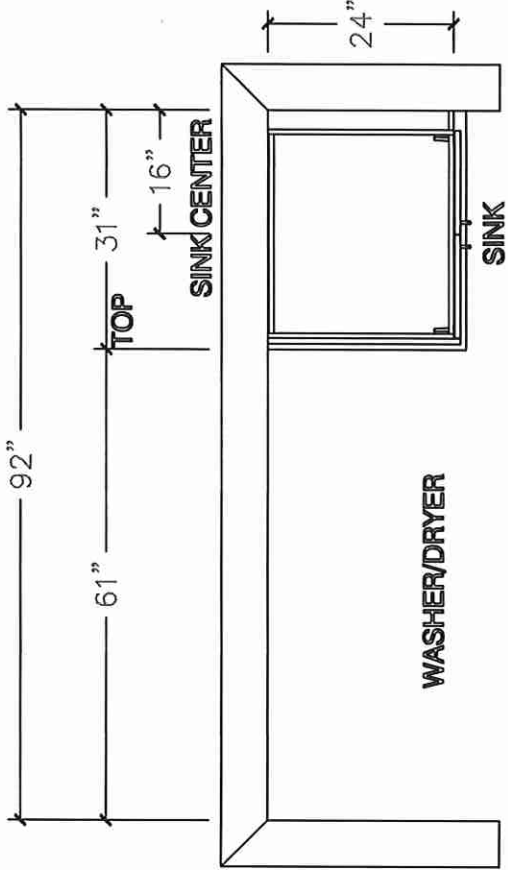


Souhail
18 Mar 2022

Lot 6 Oak Ridge

CONNOLLY Marble & Granite Ltd.

EDGE
DETAILS

004

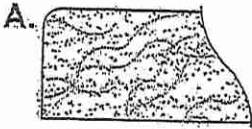


STRAIGHT EDGE
(STANDARD - 3/4")

Powder Room
Master Ensuite
Twin Bath 3/4


Ensuite #2

DS
SK

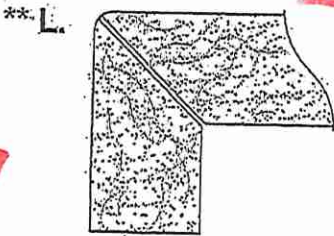

MITER WITH SKIRT EDGE
(MEDIUM - 1 1/2")

Kitchen

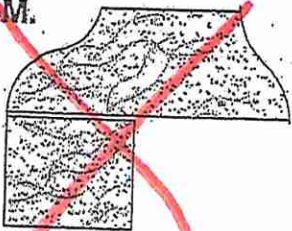

OGEE - SQUARE EDGE
(MED./HIGH - 1 1/2")

EDGING UP-GRADE OPTIONS

RECEIVED
2015-11-17